


SANITARY SEWER - STA. 1+00 - 6+00



SEE CONTINUATION ON SHEET 4

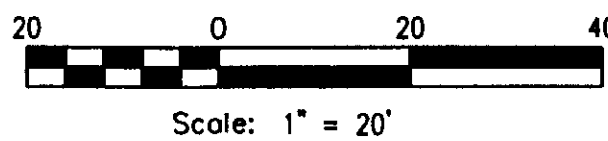

CALL 2 BUSINESS DAYS IN ADVANCE BEFORE YOU DIG, GRADE, OR EXCAVATE FOR THE MARKING OF UNDERGROUND MEMBER UTILITIES

NO.	DATE	BY	DESCRIPTION

SANITARY SEWER STA. 1+00 - 6+00
HARRY WALL SEWER MAIN EXTENSION
PORT OF LEWISTON, 1626 6TH AVE. N
LEWISTON, ID 83501

KELTIC ENGINEERING, INC.
 315 Adams Lane • Lewiston, Idaho 83501 • (208) 743-2135 • (208) 743-2136 fax
 9425 North Nevada Street, Ste 204 • Spokane, WA 99218 • (509) 464-3000 • (509) 464-3005 fax
 • Development • Planning • Design • Construction Management

PROFESSIONAL ENGINEER
 REGISTERED
 6064
 10/12/14
 STATE OF IDAHO
 ERIC HASENGRUBER

DRAWN BY: JDM	CHECKED BY: EFH
DESIGNED BY: EFH	
DATE: 10/15/14	
LAST REV: 10/15/14	
PROJECT NO: 14-1302	
SHEET NO: 3	OF 5