
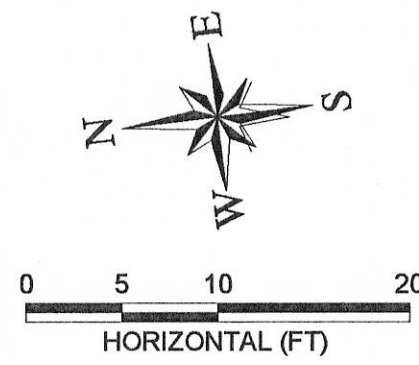


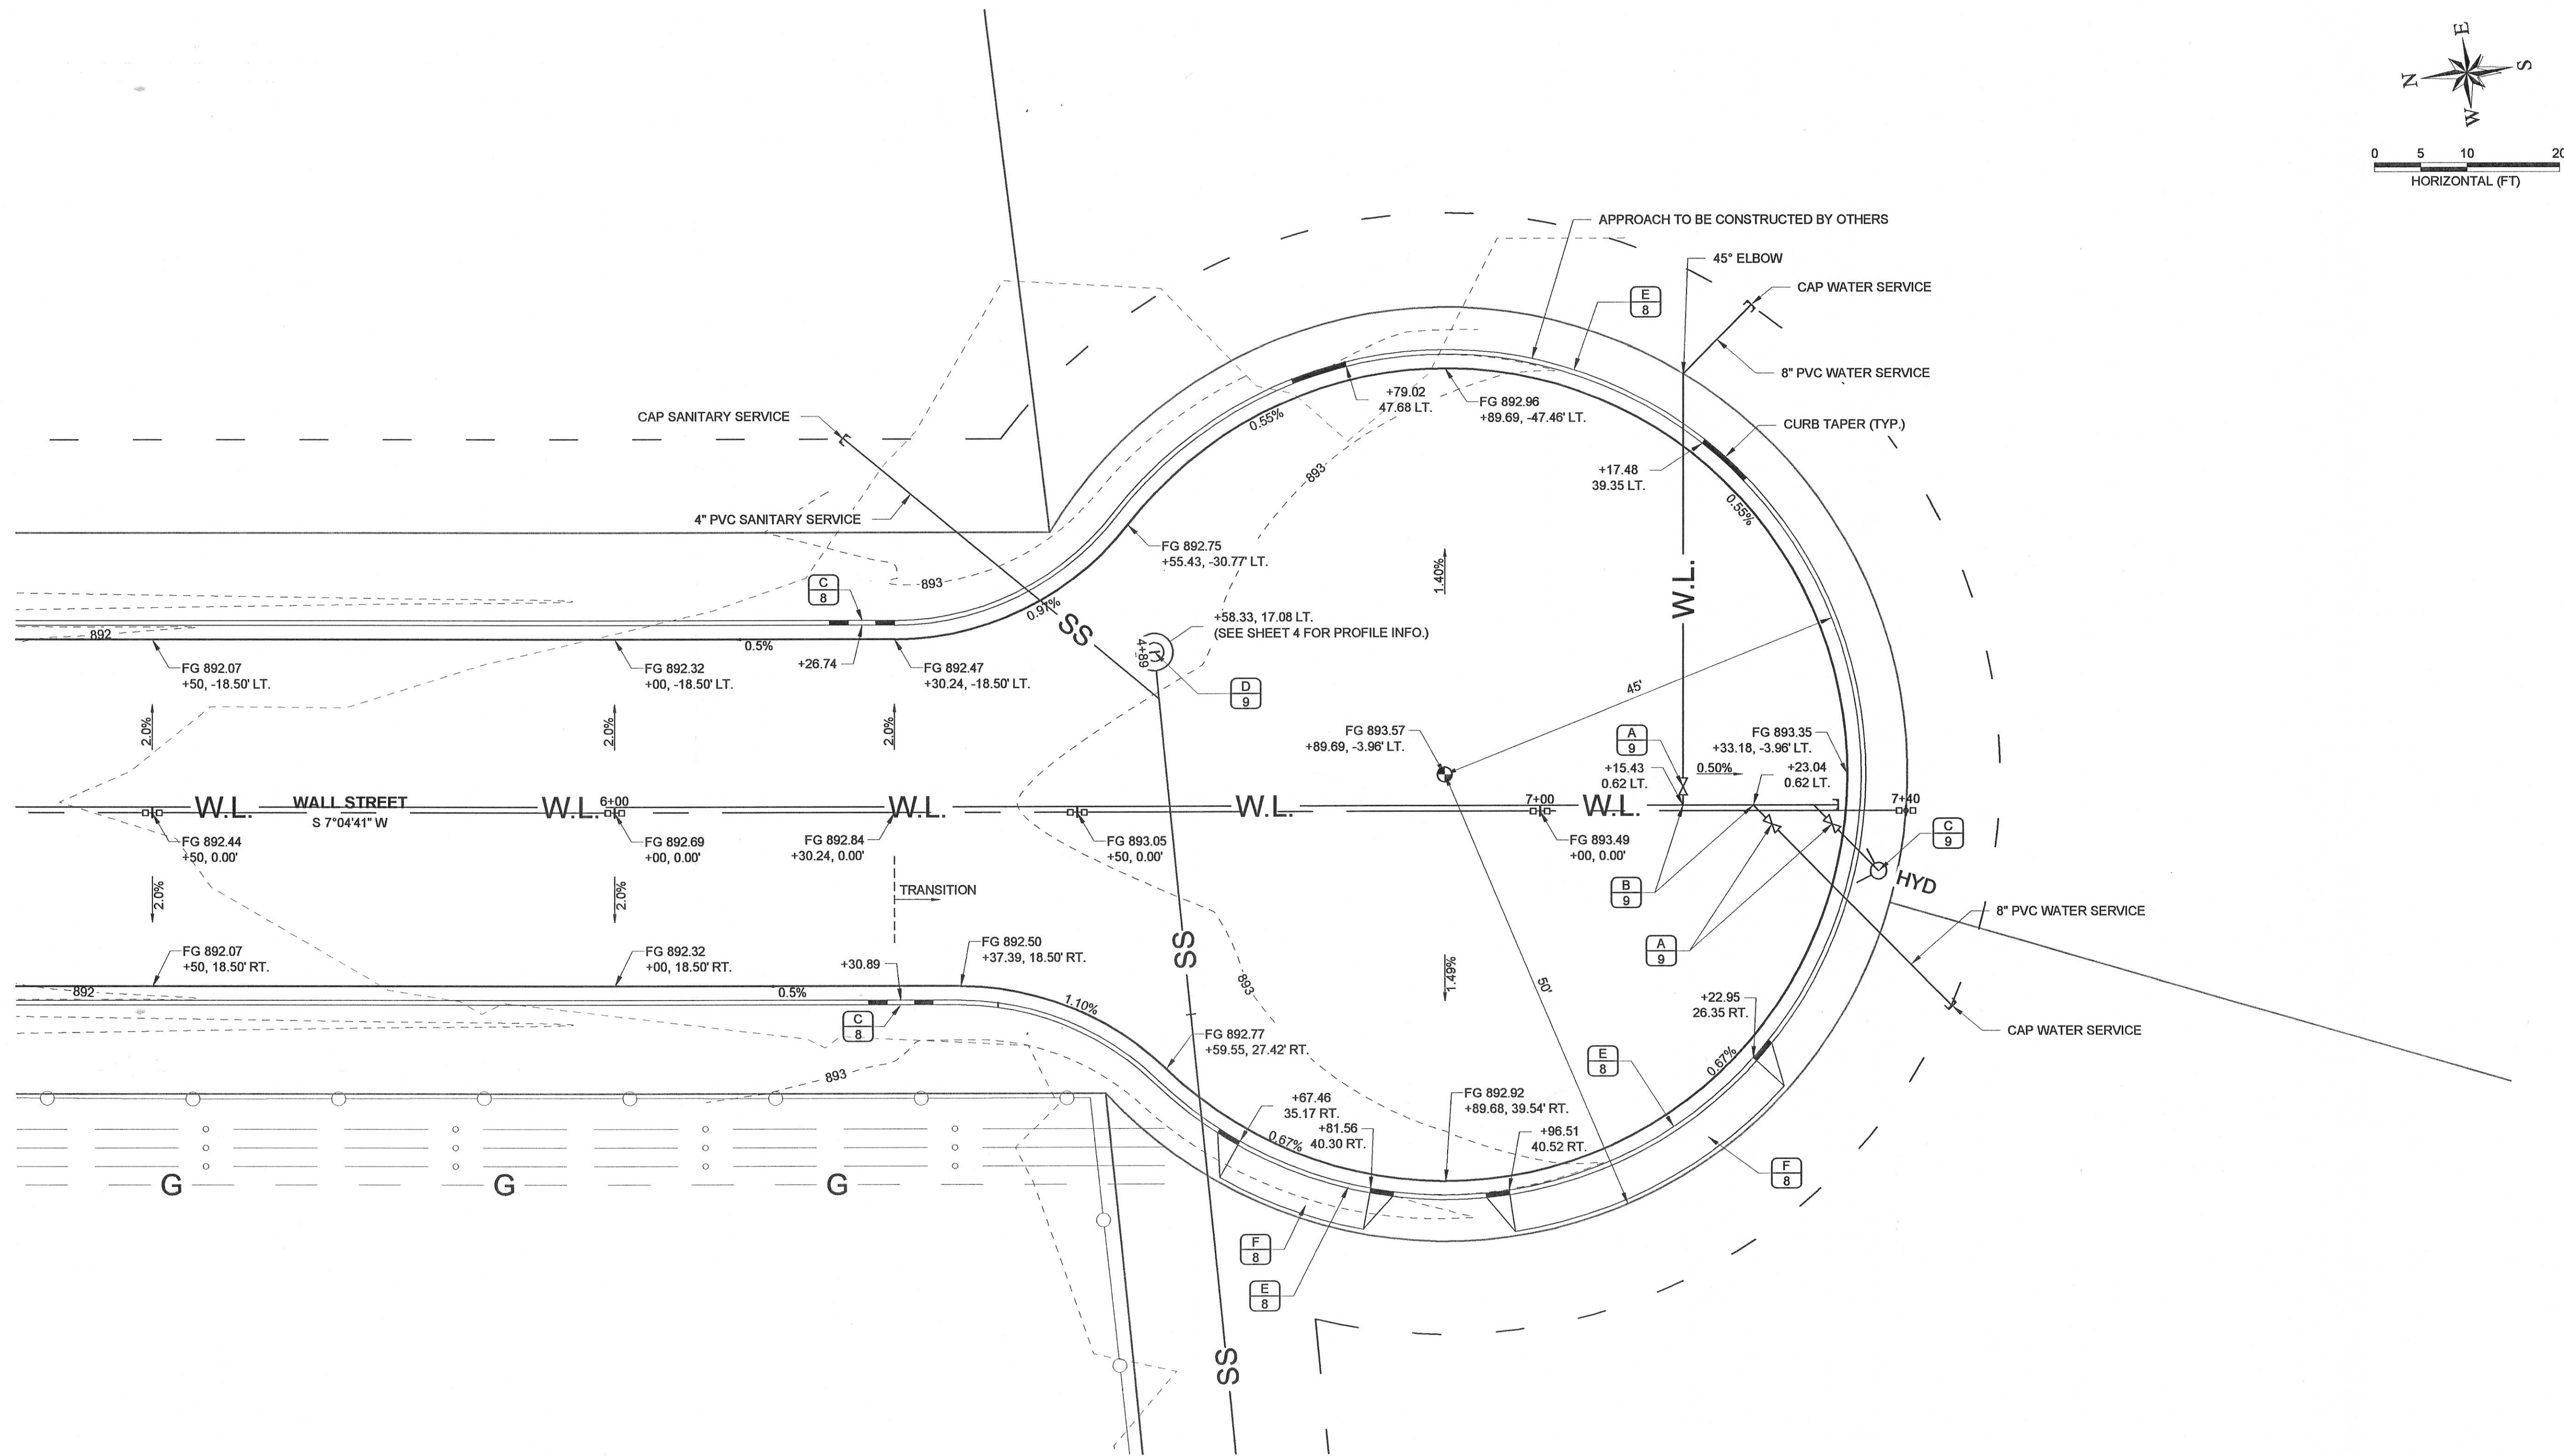

77 Southway, Suite C
Lewiston, Id. 83501
Phone: (208) 743-3818
Fax: (208) 743-3819

RIEDEL
Engineering

THE QUALITY AND TECHNICAL ACCURACY OF THIS DRAWING IS AN INDICATOR OF PROFESSIONAL SERVICE. IT IS THE PROPERTY OF RIEDEL ENGINEERING, INC. AND IS NOT TO BE USED, IN WHOLE OR IN PART, FOR ANY OTHER PROJECT, OR THE EXTENSION OF THE PROJECT WITHOUT THE WRITTEN AUTHORIZATION OF RIEDEL ENGINEERING, INC.

REVISIONS		DESCRIPTION
NO	DATE BY	
1	12/14/12	BJW
2	12/14/12	JRW/JPM
3	12/14/12	BJW
4	12/14/12	JRW/JPM
5	12/14/12	BJW
6	12/14/12	JRW/JPM

HARRY WALL INDUSTRIAL PARK
INFRASTRUCTURE EXTENSION PROJECT
2013

CUL-DE-SAC GRADING DETAILS

DESIGNED
BJW
DESIGN CHECKED
JRW/JPM
DETAILED
BJW
DRAWING CHECKED
JRW/JPM
FILE NAME
2060-GRD-DTL.dwg
DRAWING DATE
12/14/12
DRAWING SCALE
AS SHOWN

PROFESSIONAL ENGINEER
13055
STATE OF IDAHO
P. MORTEISON

SHEET 6 OF 10