




A
9

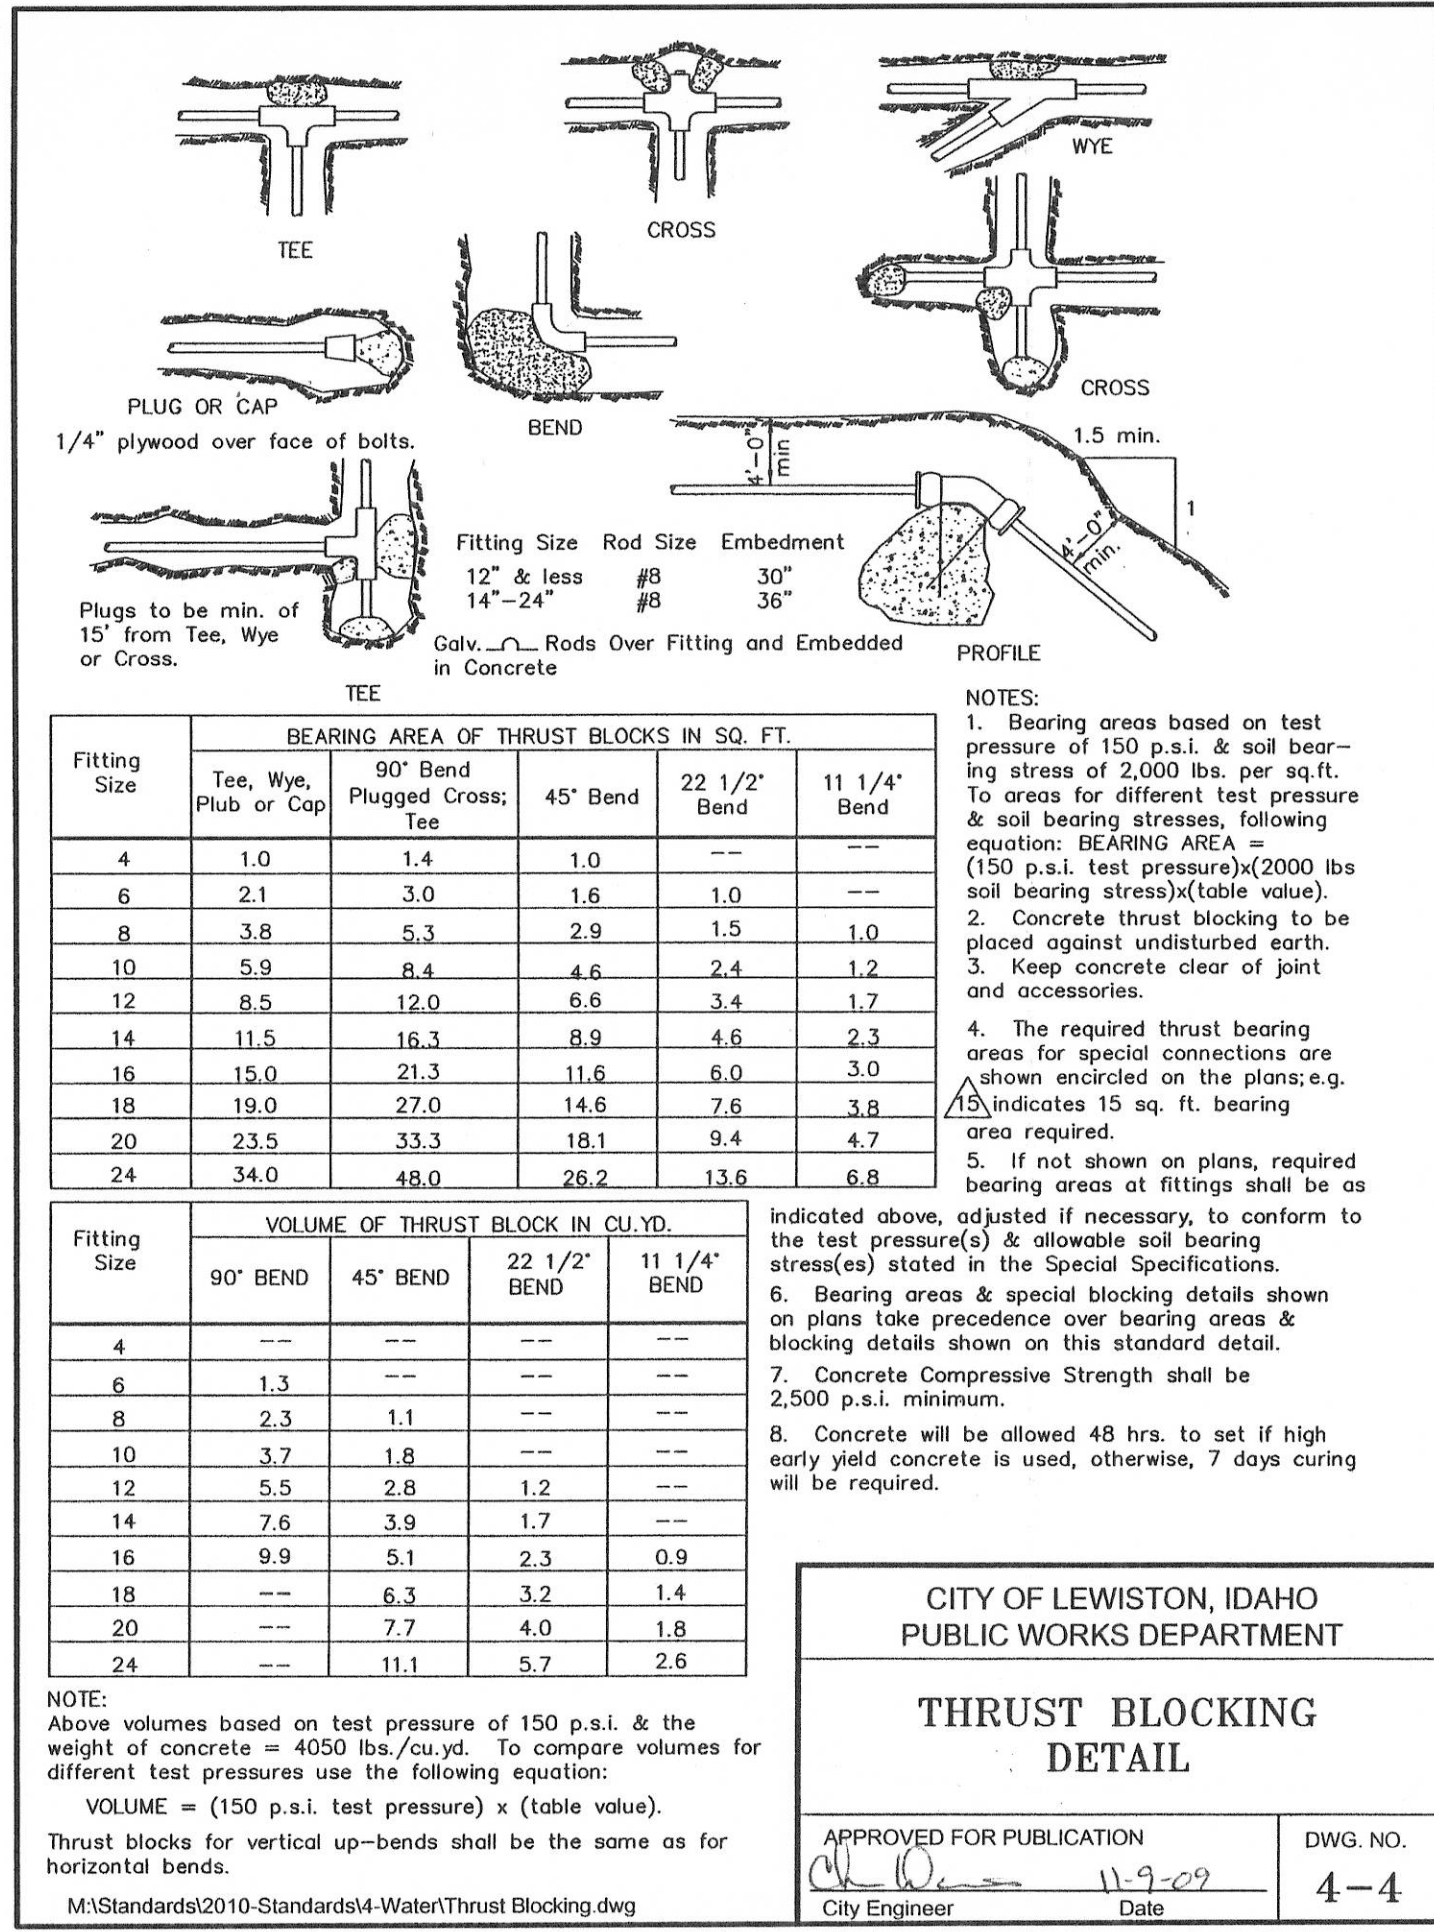

B
9

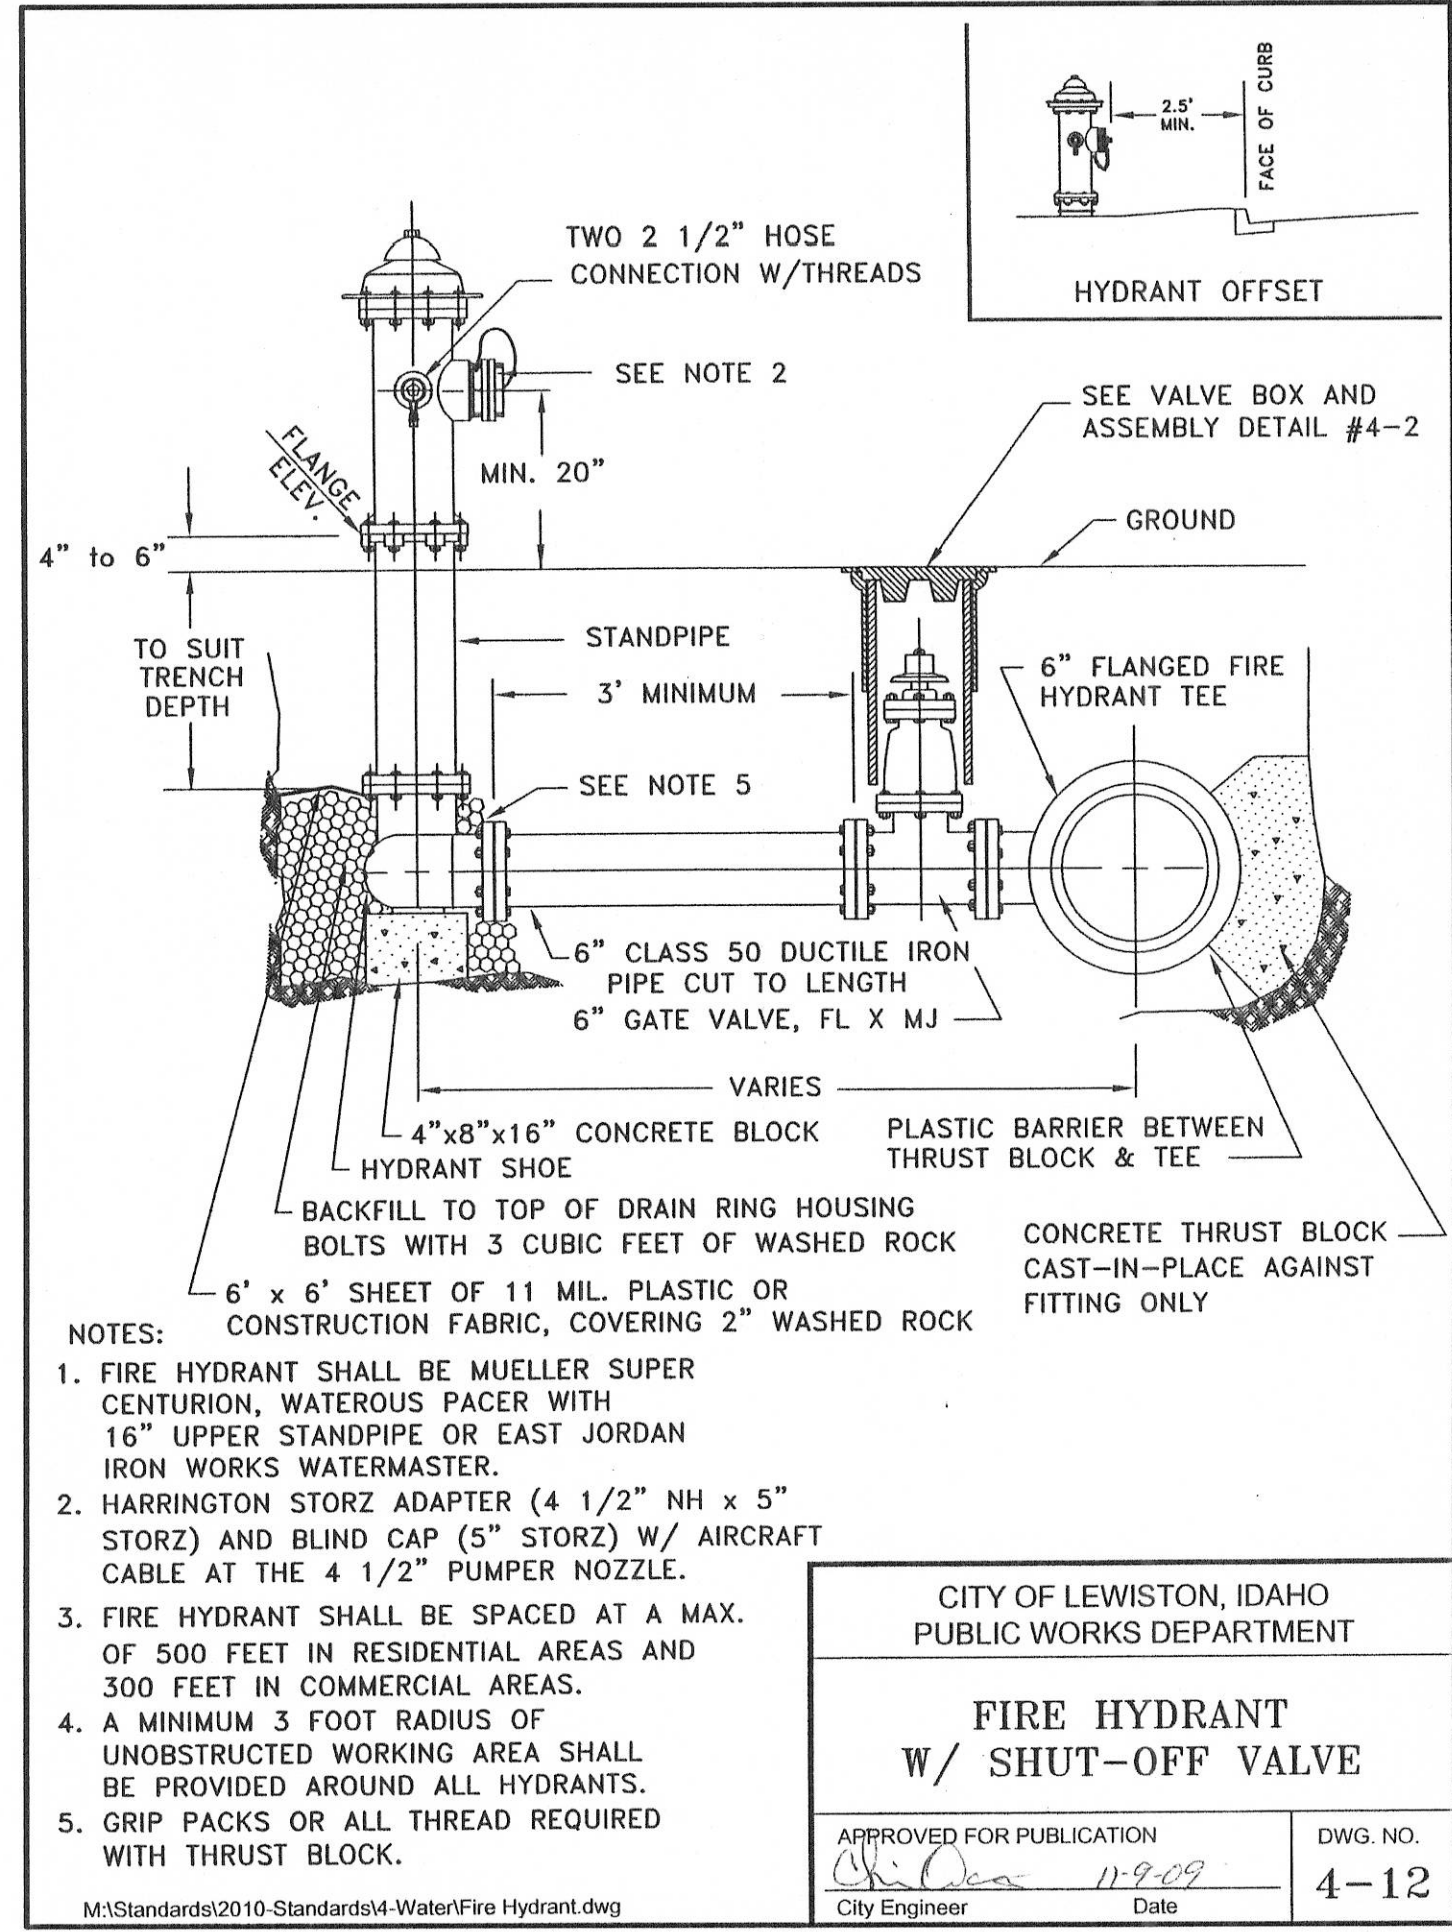

C
9

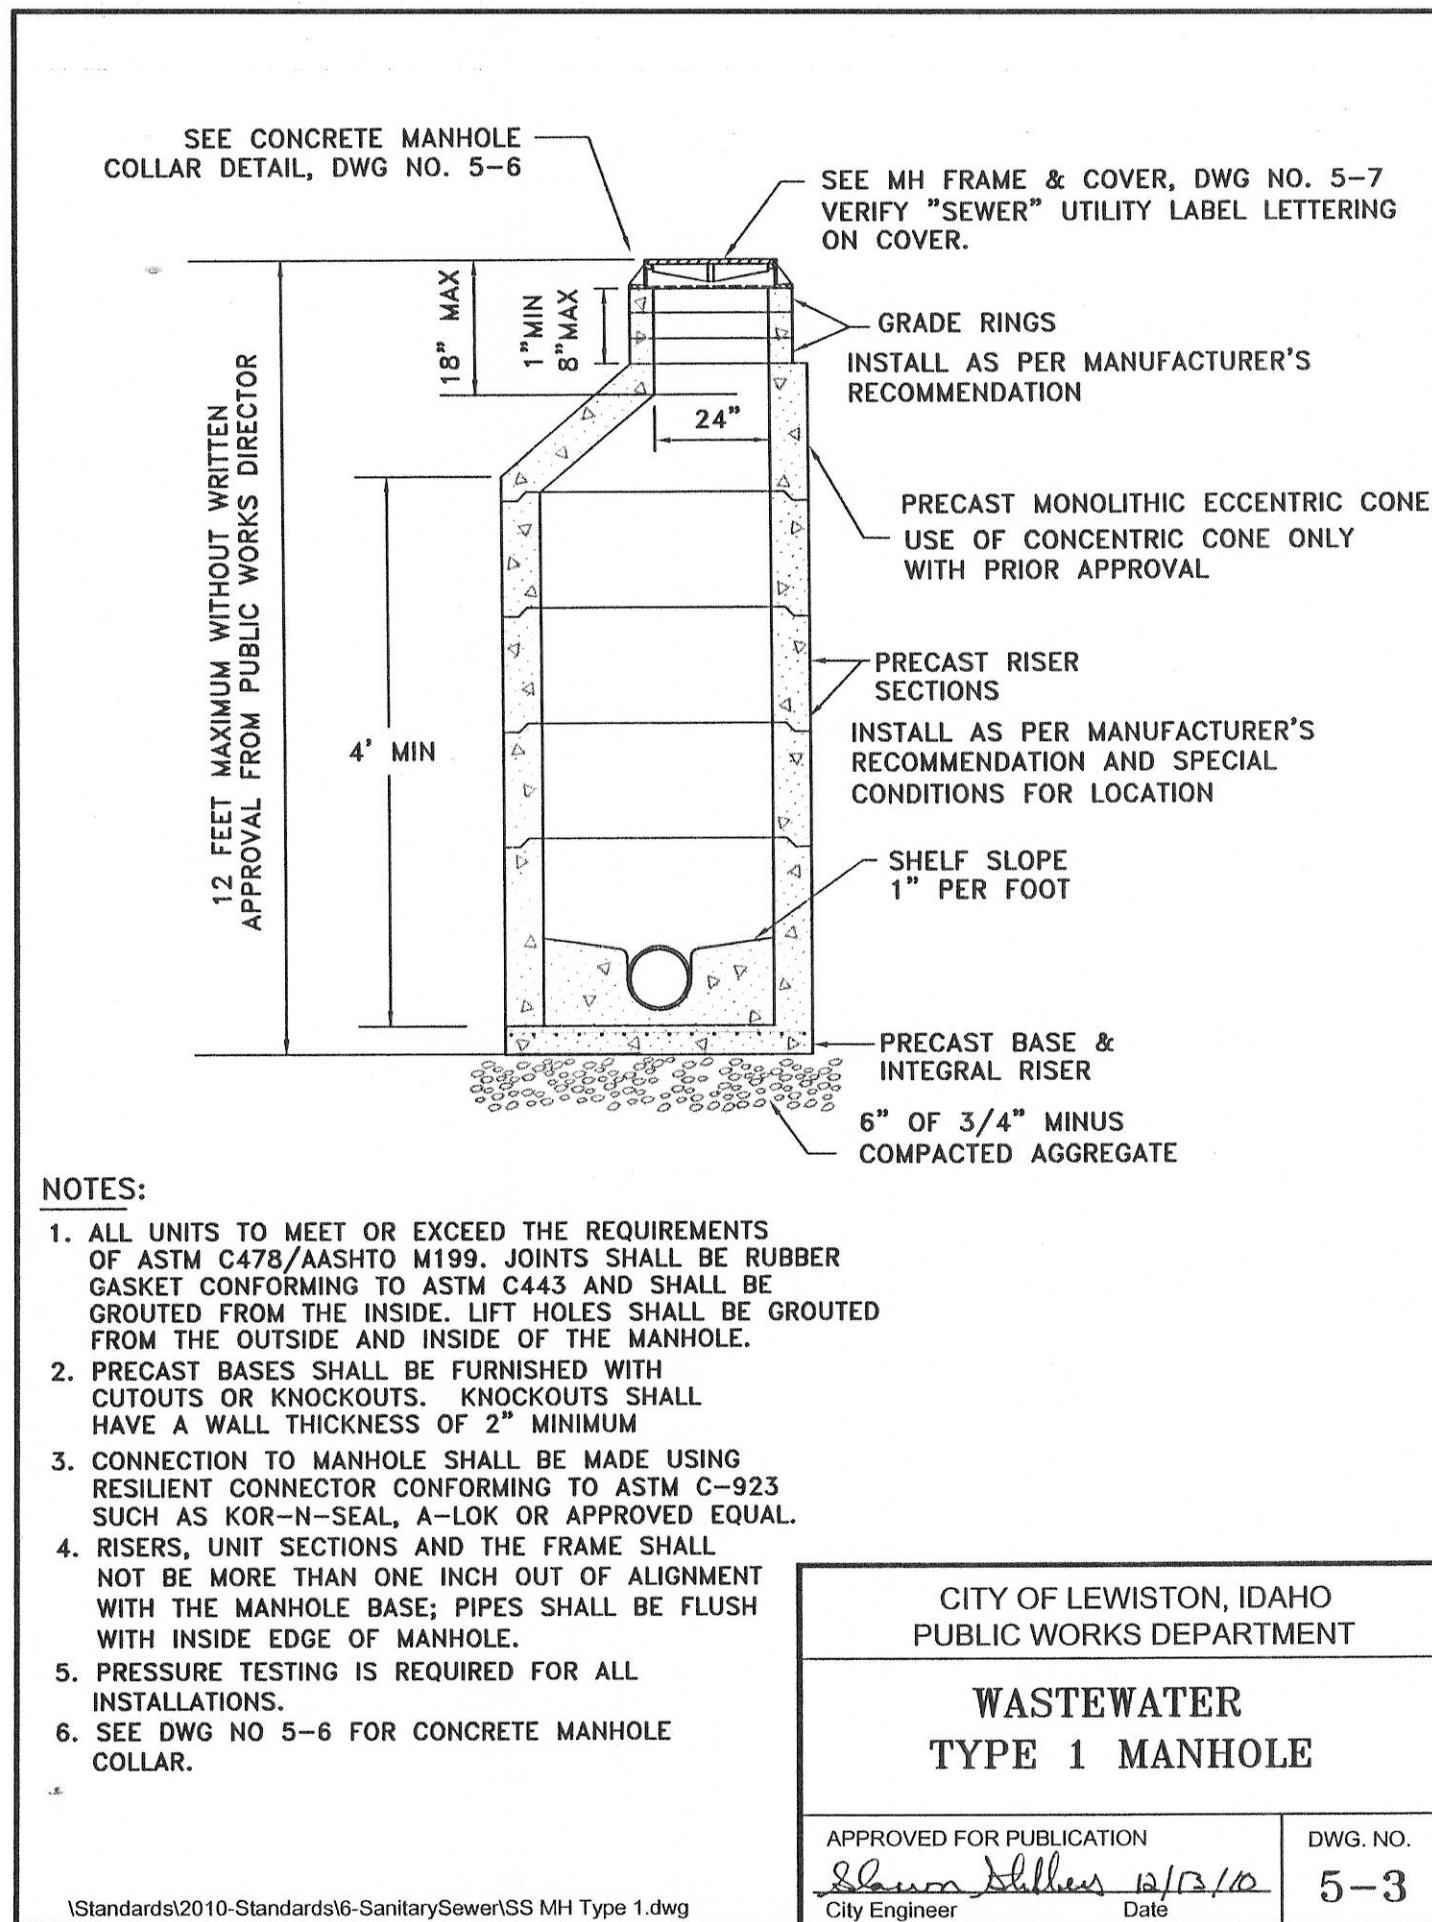

D
9

| REVISIONS | DESCRIPTION | DATE | BY | CHKD | APP'D |
|-----------|-------------|------|----|------|-------|
| 1 | | | | | |
| 2 | | | | | |
| 3 | | | | | |
| 4 | | | | | |
| 5 | | | | | |
| 6 | | | | | |
| 7 | | | | | |
| 8 | | | | | |
| 9 | | | | | |