




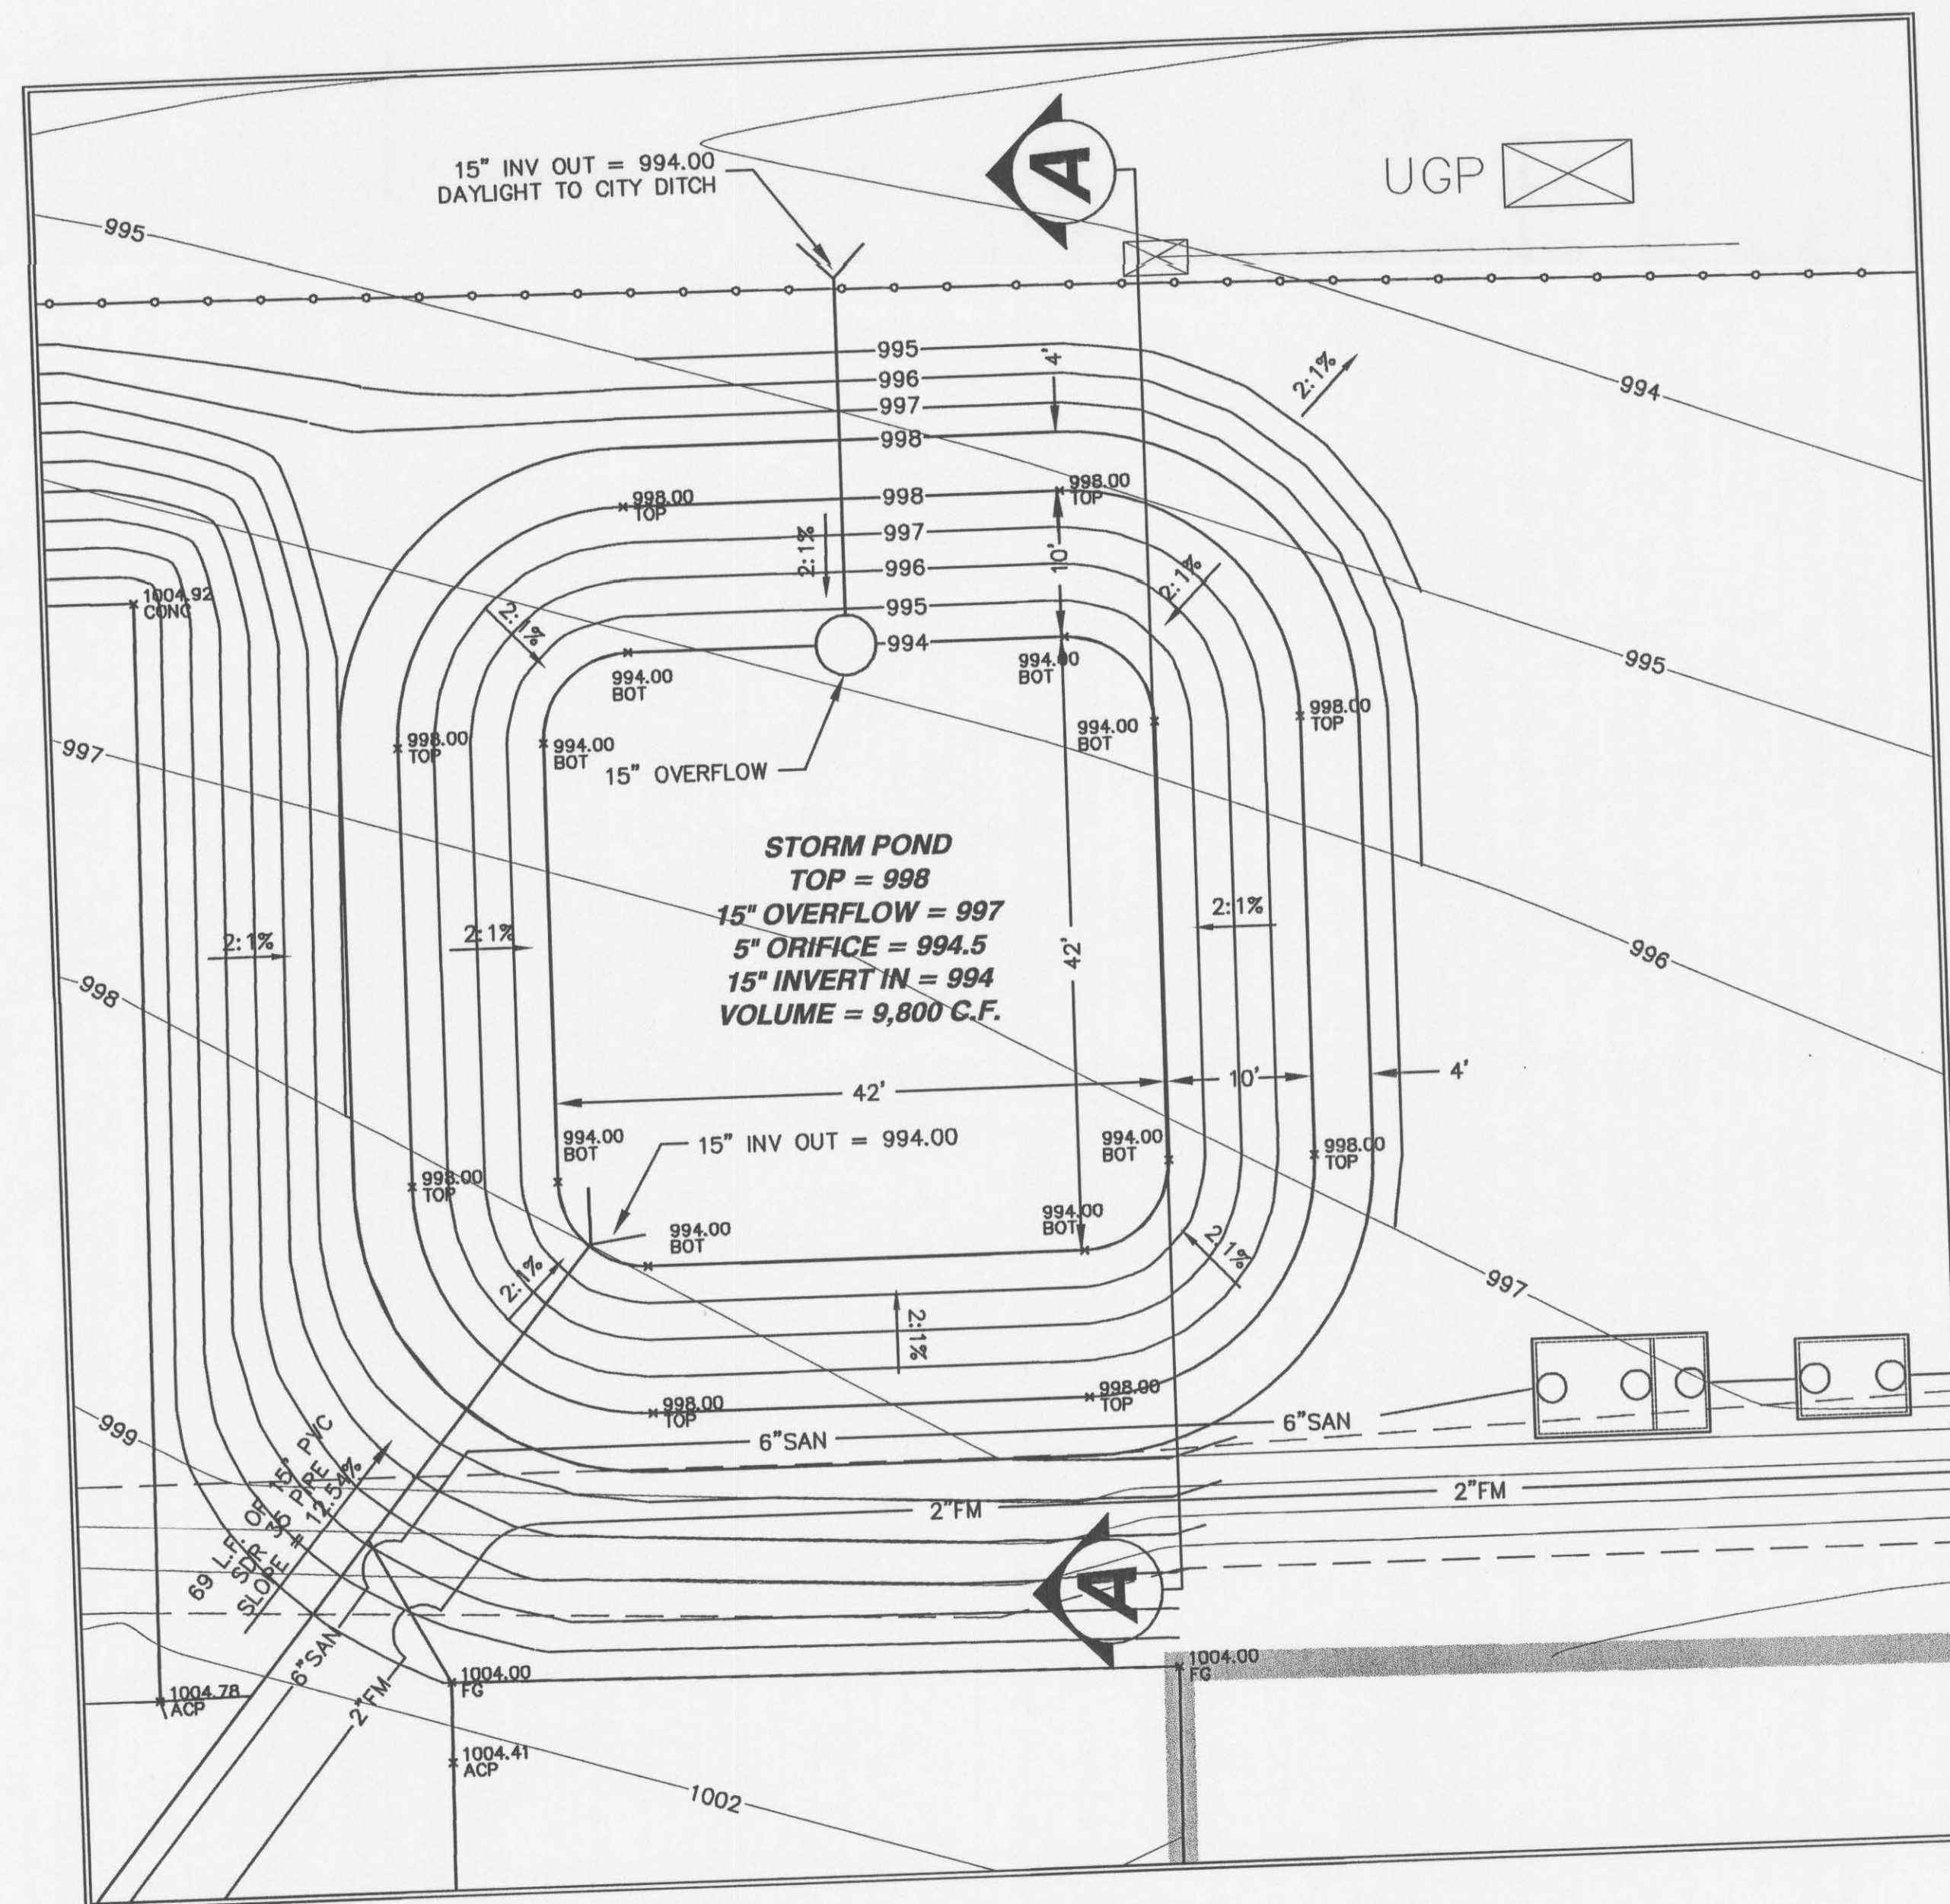


POND PLAN VIEW
NO SCALE

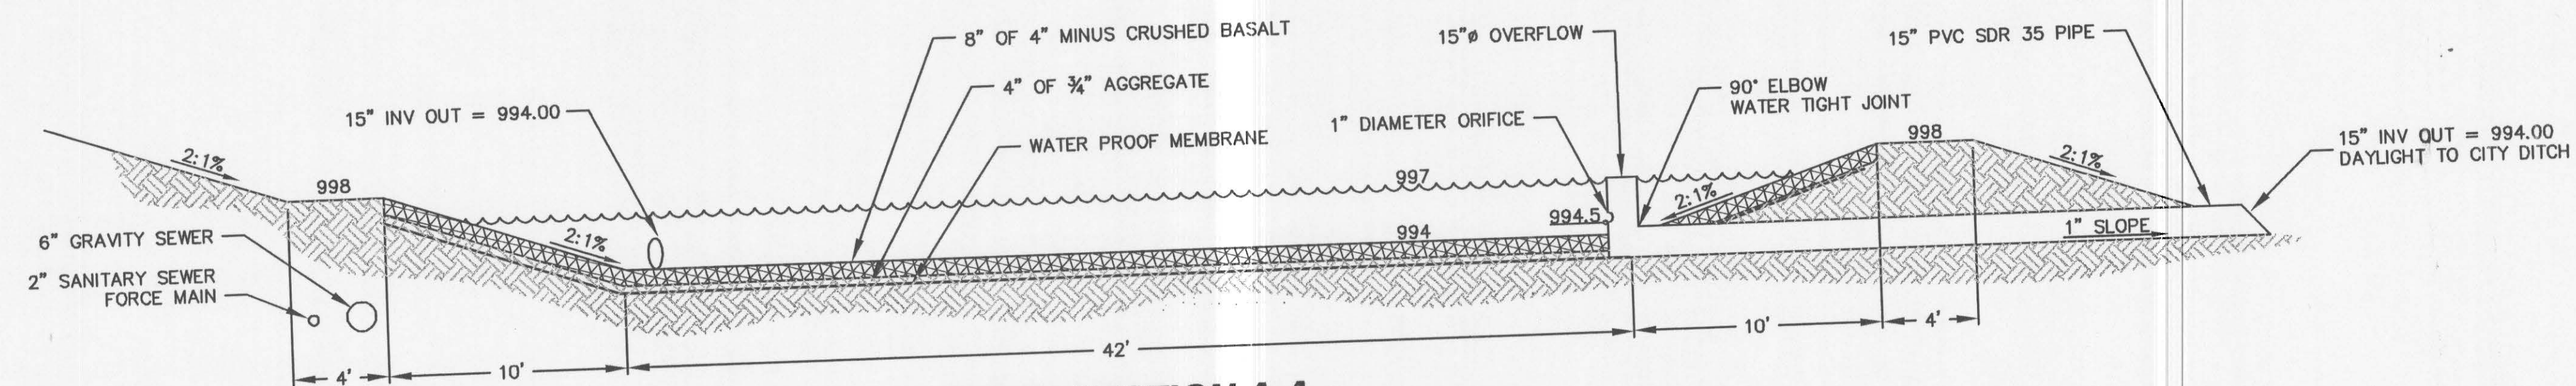

POND SECTION A-A
NO SCALE

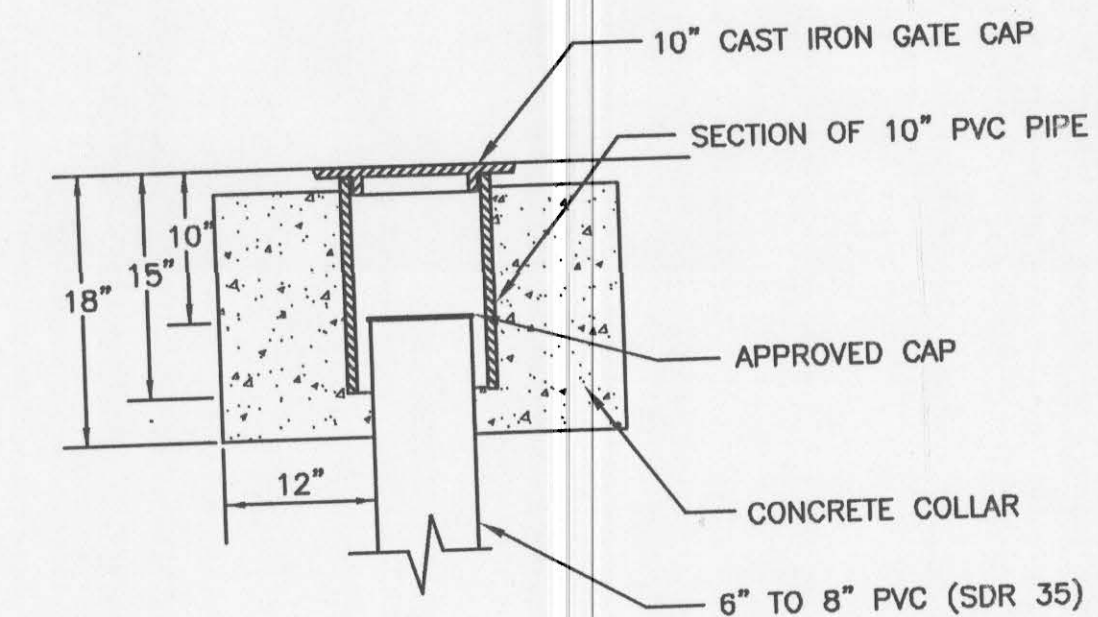

SERVICE LEAD CLEANOUT DETAIL
NO SCALE

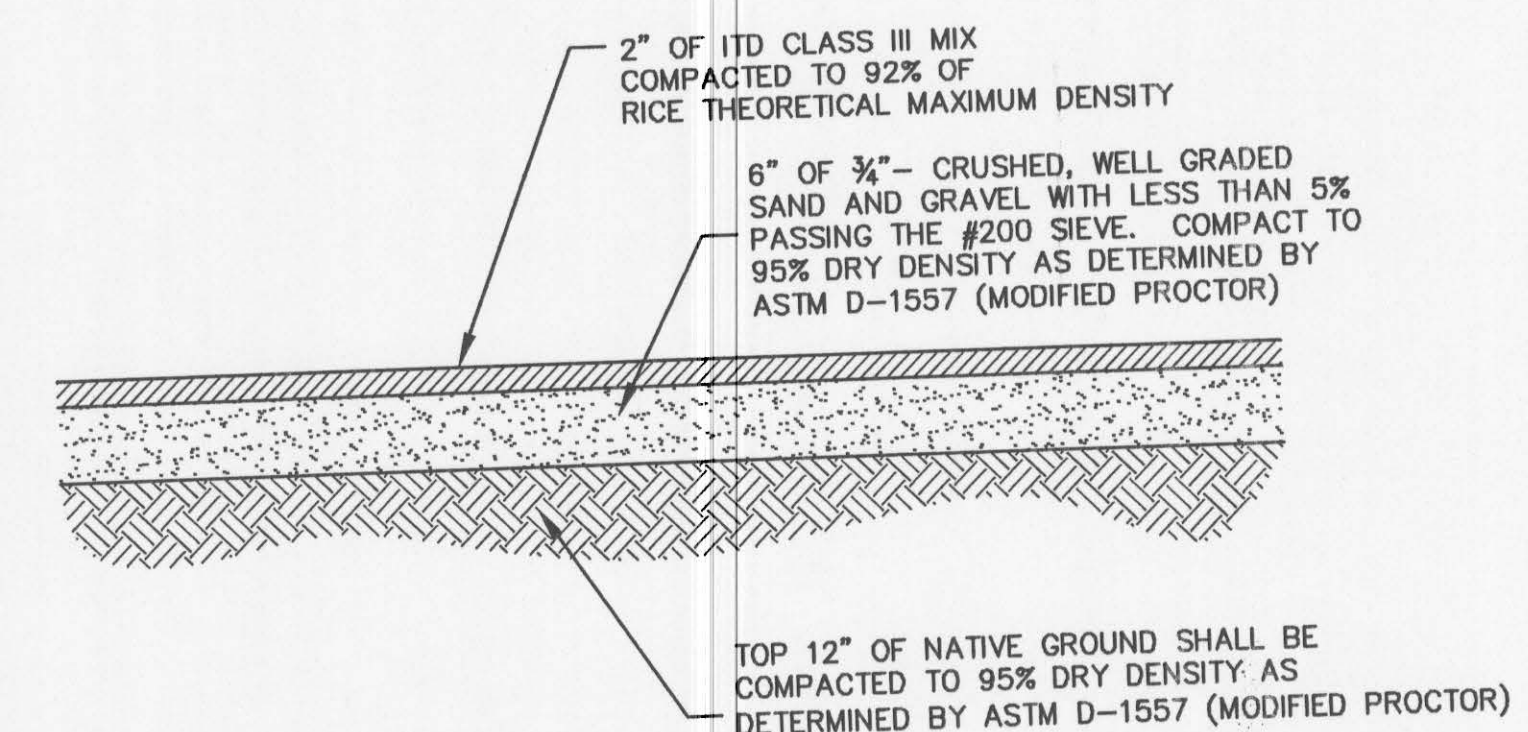

PAVEMENT SECTION DETAIL
NO SCALE

NO.	DATE	BY	FILENAME	REVISIONS
1	3-18-07	CRF		ORIFICE REDUCED TO 1"

4025 EAGLE COURT LEWIS (208) 750-1032 (208) 791-8055	
--	--

HILLCREST AIRCRAFT HANGER PROJECT 2007	SECTION & DETAILS
---	-------------------

DRAWN BY: CRF	CHECKED BY: CRF
DESIGNED BY: CRF	
SCALE: 1" = 5'	
DATE: 2/5/07	
PROJECT NO.: 00071	
SHEET C10 OF 11	