


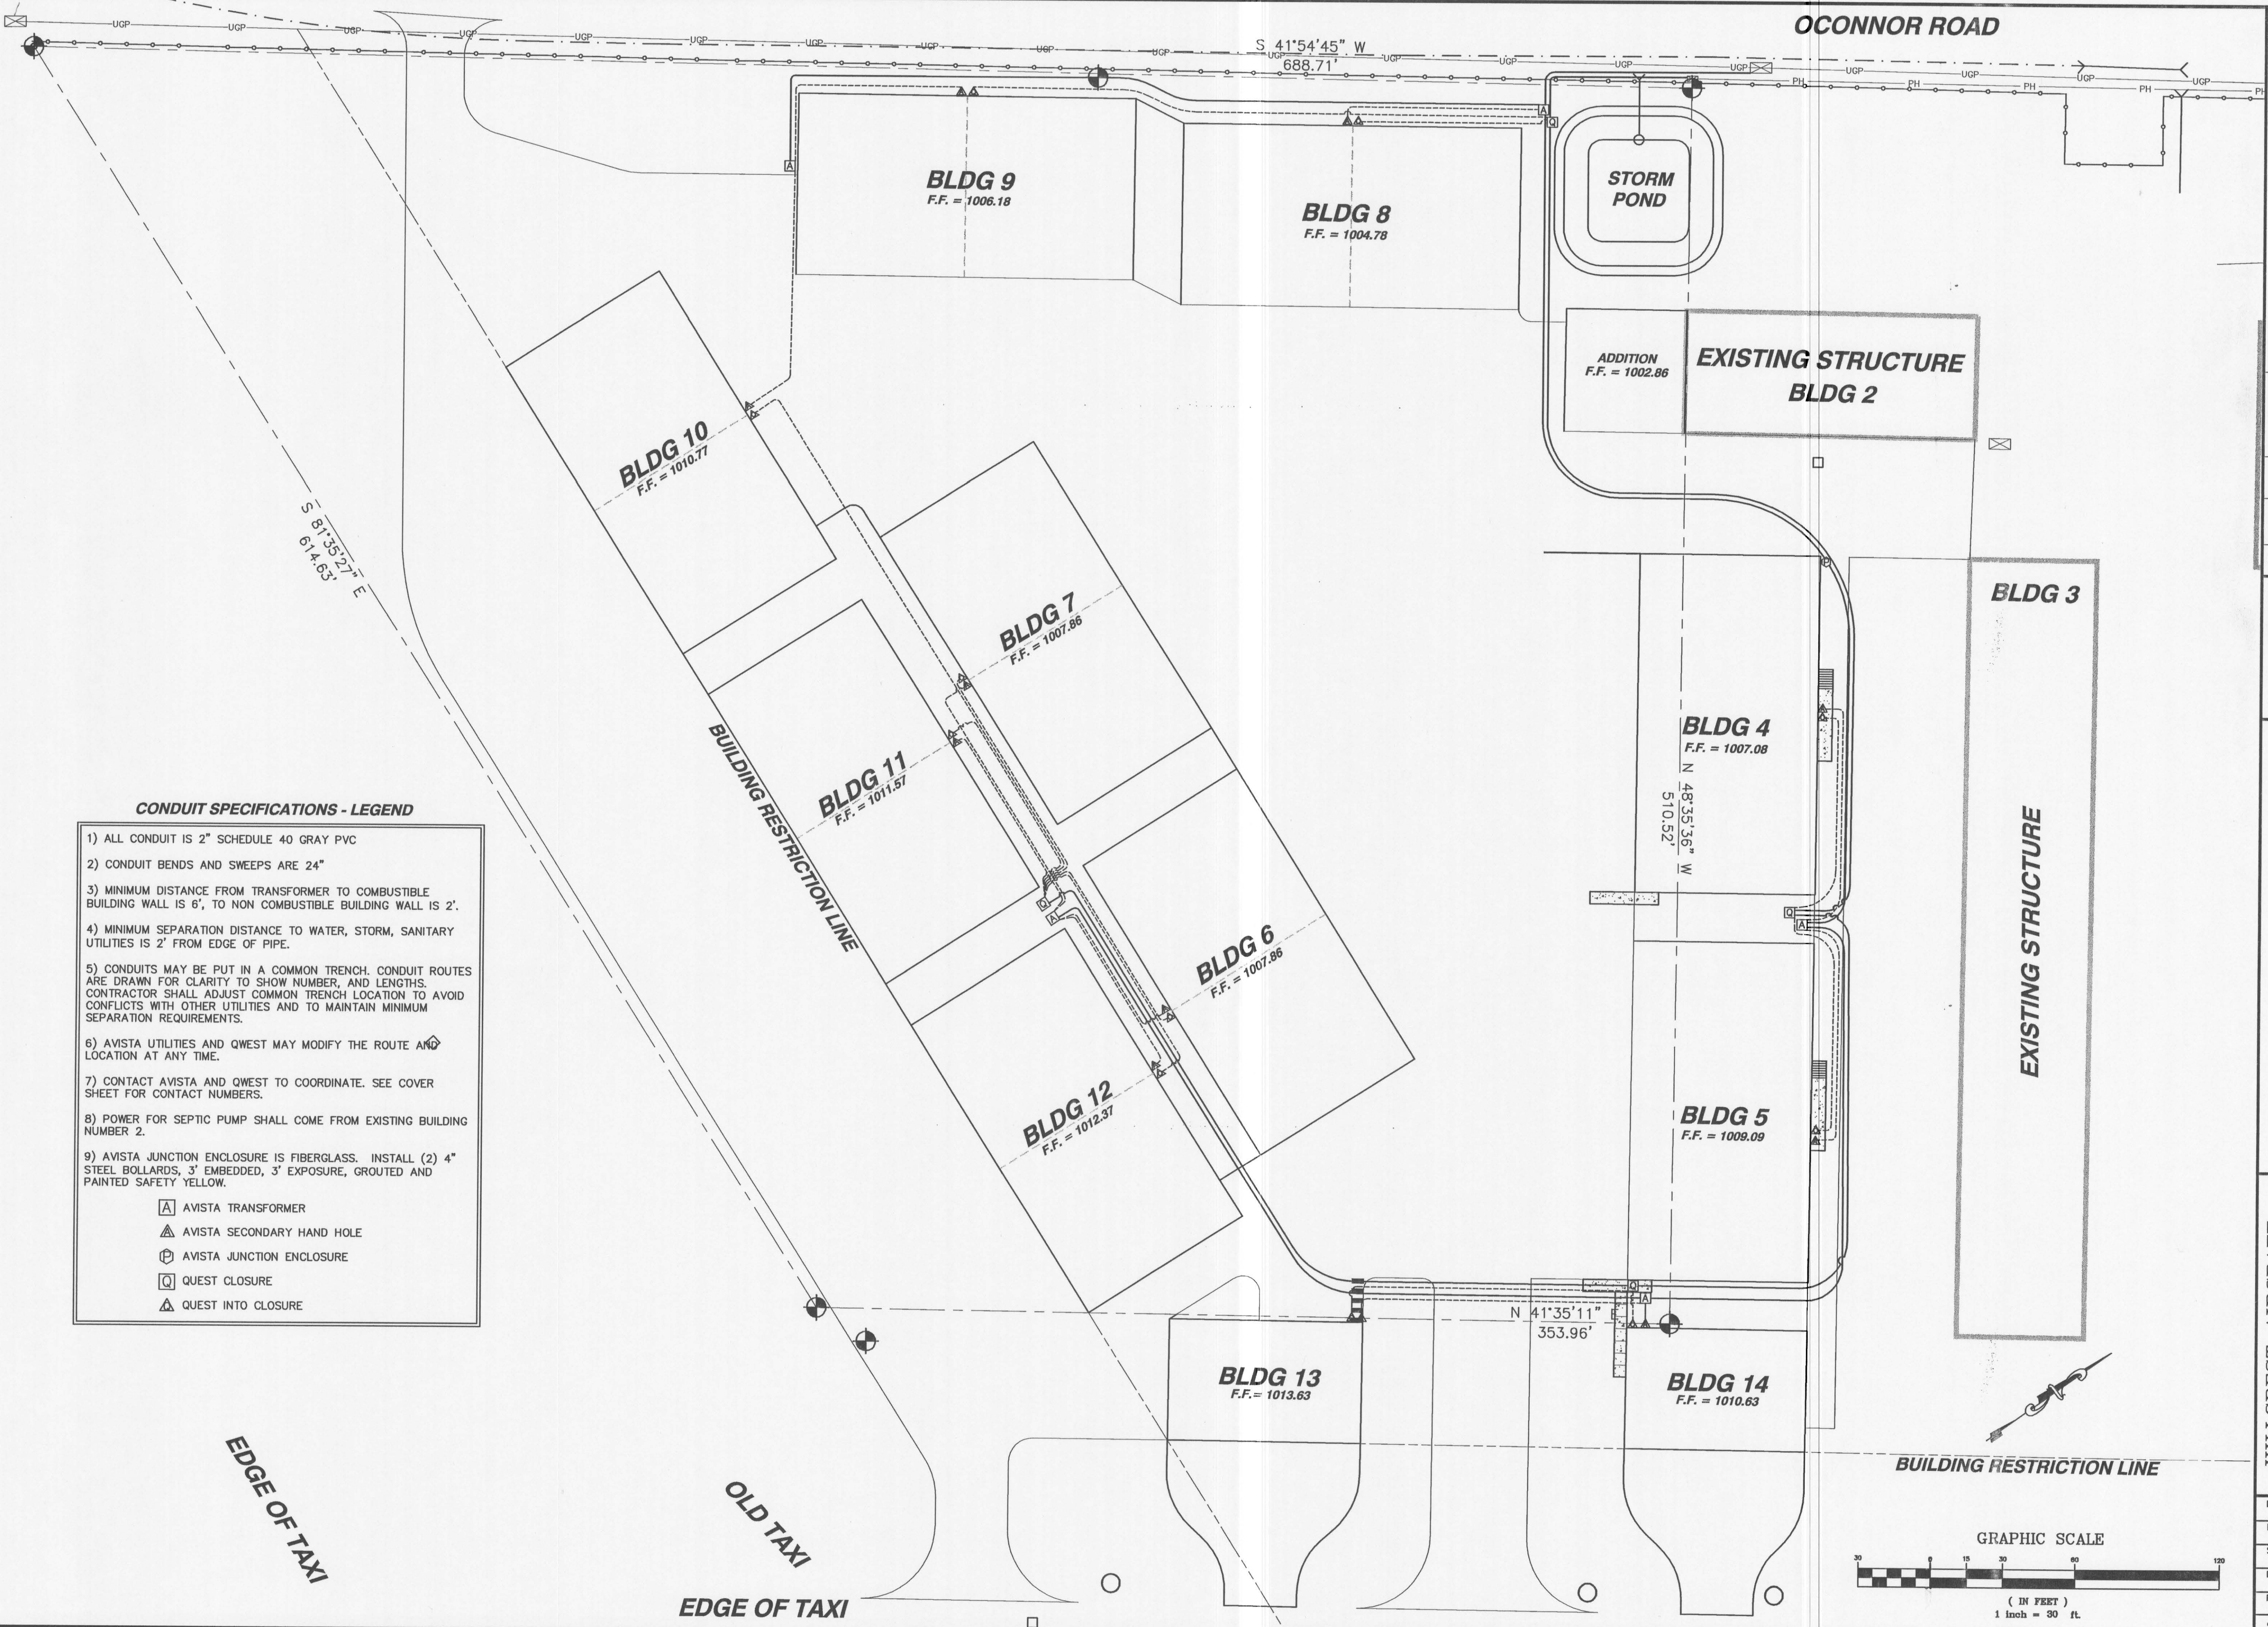

CONDUIT SPECIFICATIONS - LEGEND

- 1) ALL CONDUIT IS 2" SCHEDULE 40 GRAY PVC
 - 2) CONDUIT BENDS AND SWEEPS ARE 24"
 - 3) MINIMUM DISTANCE FROM TRANSFORMER TO COMBUSTIBLE BUILDING WALL IS 6', TO NON COMBUSTIBLE BUILDING WALL IS 2'.
 - 4) MINIMUM SEPARATION DISTANCE TO WATER, STORM, SANITARY UTILITIES IS 2' FROM EDGE OF PIPE.
 - 5) CONDUITS MAY BE PUT IN A COMMON TRENCH. CONDUIT ROUTES ARE DRAWN FOR CLARITY TO SHOW NUMBER, AND LENGTHS. CONTRACTOR SHALL ADJUST COMMON TRENCH LOCATION TO AVOID CONFLICTS WITH OTHER UTILITIES AND TO MAINTAIN MINIMUM SEPARATION REQUIREMENTS.
 - 6) AVISTA UTILITIES AND QWEST MAY MODIFY THE ROUTE AND LOCATION AT ANY TIME.
 - 7) CONTACT AVISTA AND QWEST TO COORDINATE. SEE COVER SHEET FOR CONTACT NUMBERS.
 - 8) POWER FOR SEPTIC PUMP SHALL COME FROM EXISTING BUILDING NUMBER 2.
 - 9) AVISTA JUNCTION ENCLOSURE IS FIBERGLASS. INSTALL (2) 4" STEEL BOLLARDS, 3' EXPOSURE, GROUTED AND PAINTED SAFETY YELLOW.
- [A] AVISTA TRANSFORMER
 - [△] AVISTA SECONDARY HAND HOLE
 - [□] AVISTA JUNCTION ENCLOSURE
 - [Q] QWEST CLOSURE
 - [△] QWEST INTO CLOSURE

REVISIONS	
NO.	DESCRIPTION
1	NOT INCLUDED IN FIRST SUBMITTAL

1025 EAGLE COURT
LAKE NASSAU, FL 33401
TEL: (208) 791-8032
FAX: (208) 791-8035
(208) 791-8035

NACLINE
ENGINEERING & DRAFTING
"an affordable alternative"

HILLCREST AIRCRAFT
HANGER PROJECT 2007
CONDUIT PLAN
POWER & PHONE

DRAWN BY:	CRF	CHECKED BY:	CRF
DESIGNED BY:	CRF		
SCALE:	1" = 30'		
DATE:	3/19/07		
PROJECT NO.:	00071		
SHEET C4.1 OF 11			

