




NO.	DATE	BY	FILENAME	REVISIONS
1	3-19-07	CRF		INCLUDED H.C. STALLS
0				ORIGINAL DRAWING



4025 EAGLE COURT
LEWISTON, IDAHO 83501
FAX (208) 750-1082
(208) 791-8055

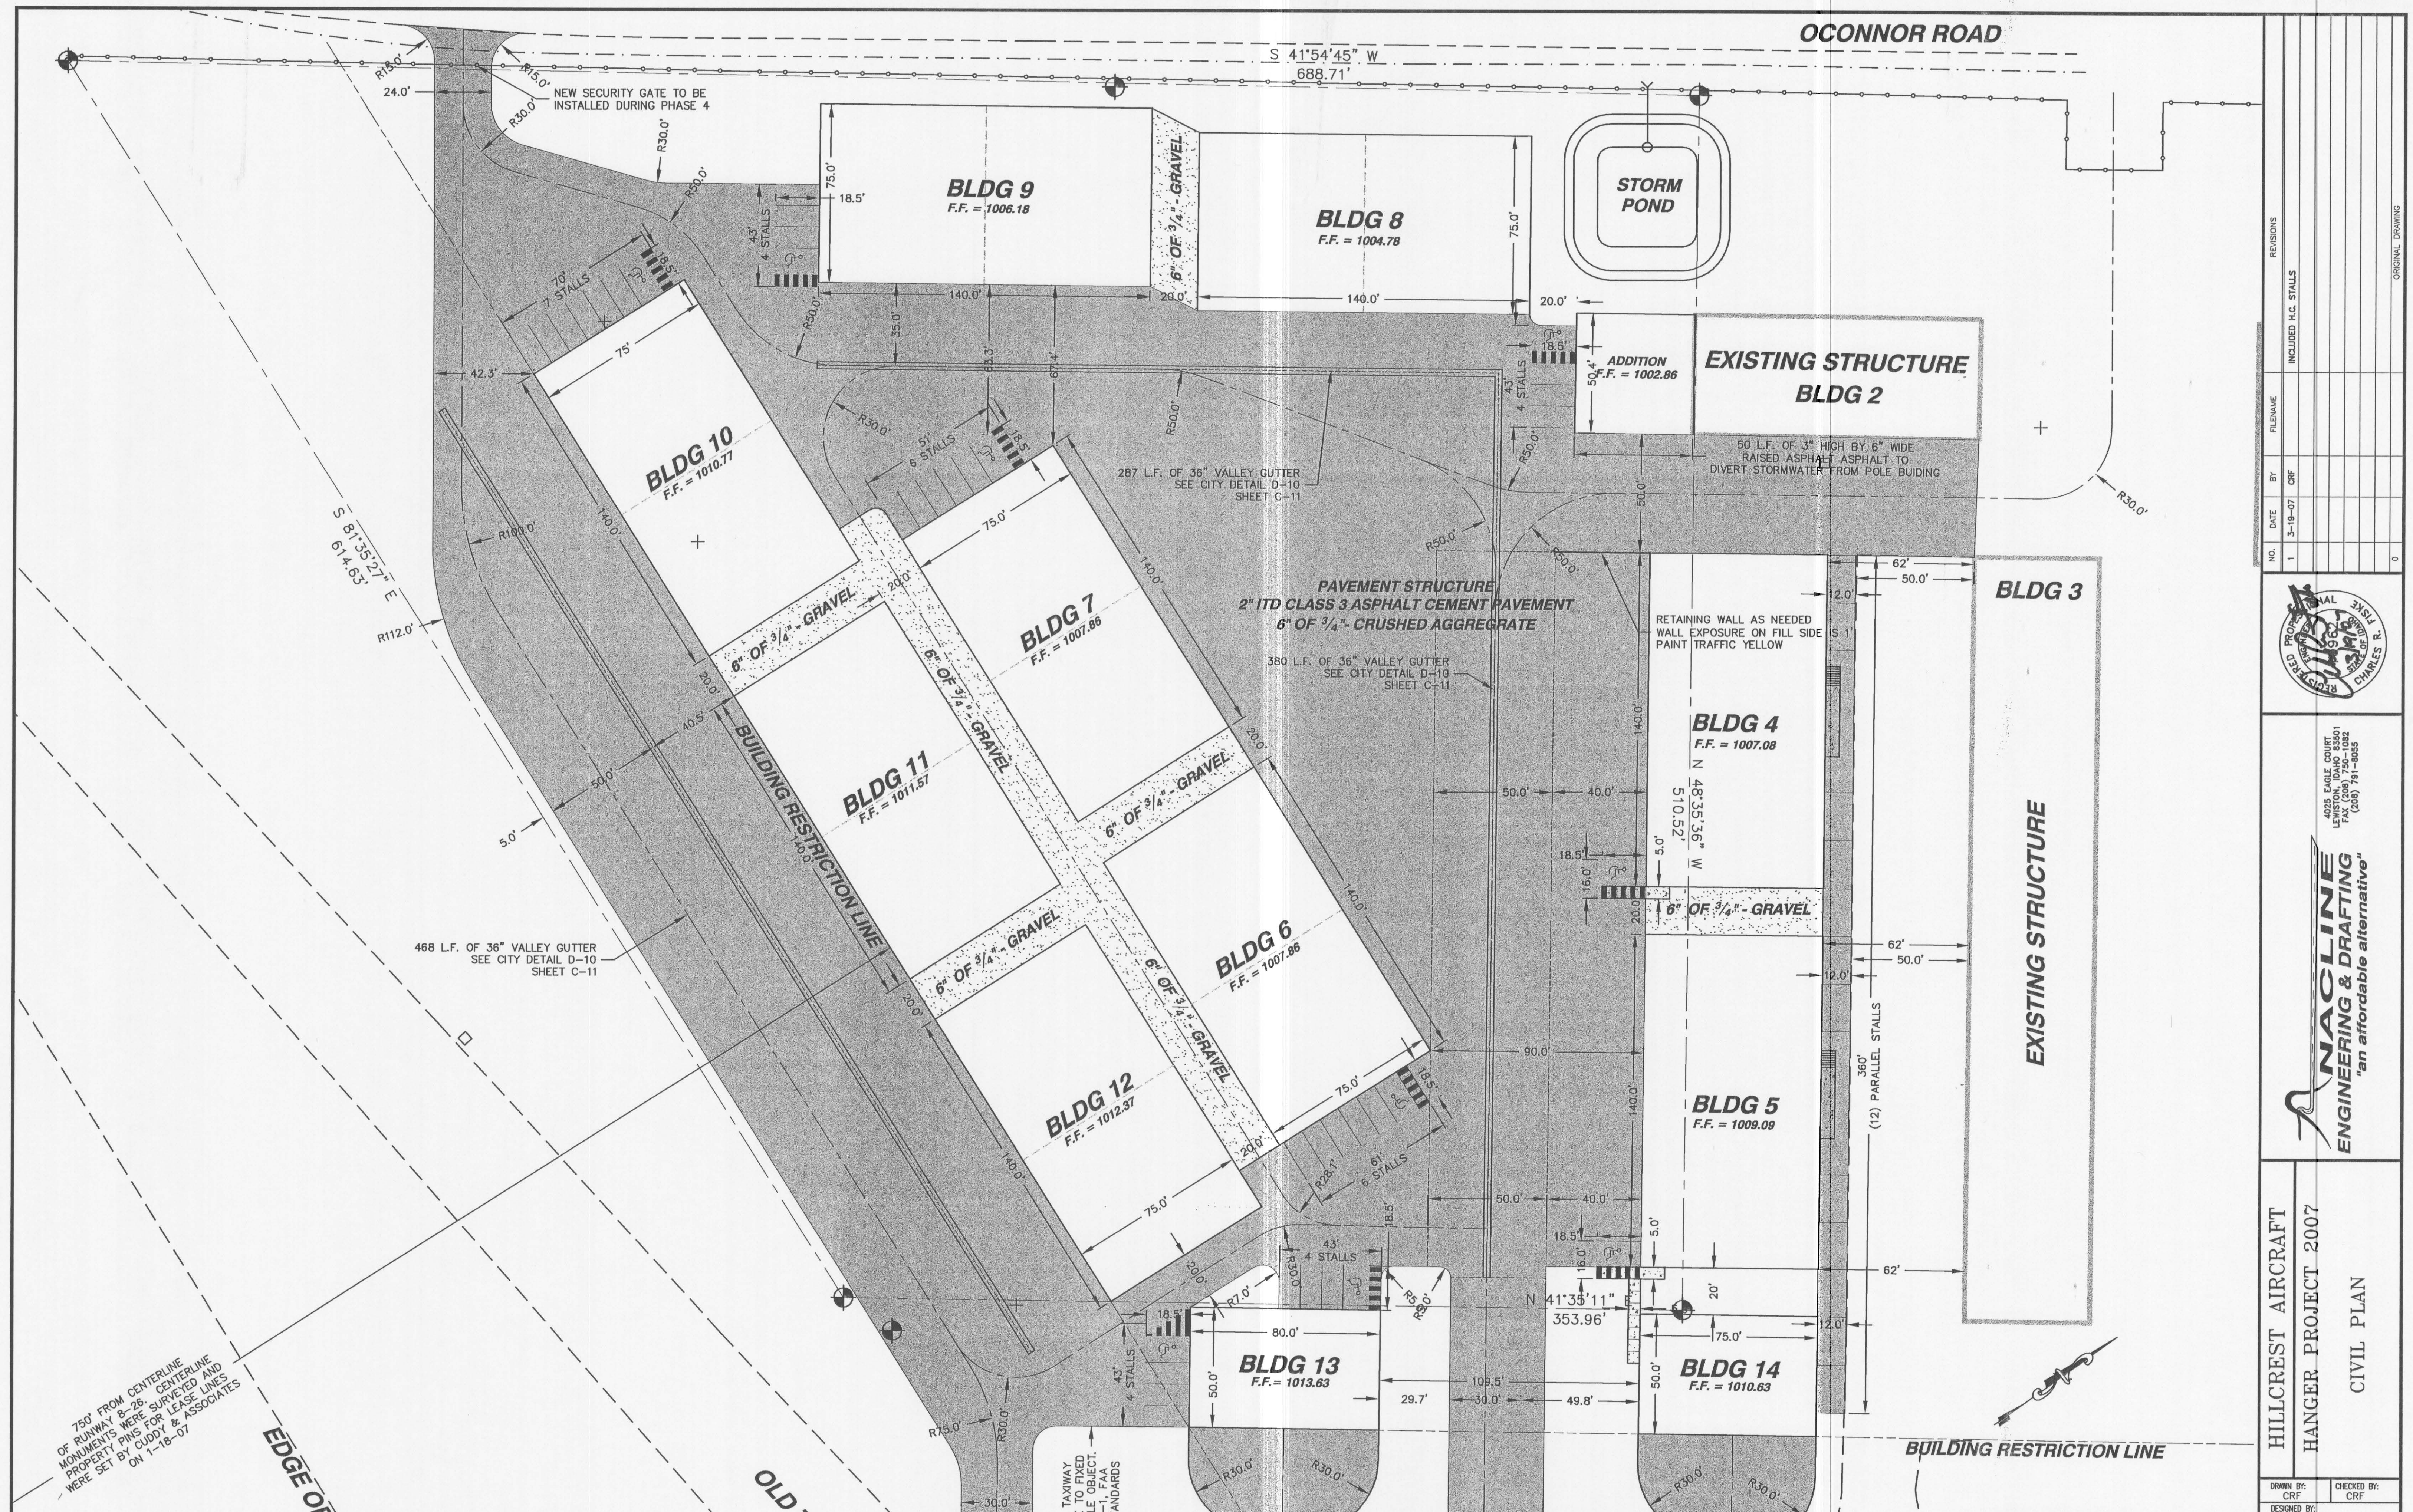

NACLINE
ENGINEERING & DRAFTING
"an affordable alternative"

HILLCREST AIRCRAFT
HANGER PROJECT 2007
CIVIL PLAN

DESIGNED BY:	
DRAWN BY: CRF	CHECKED BY: CRF