

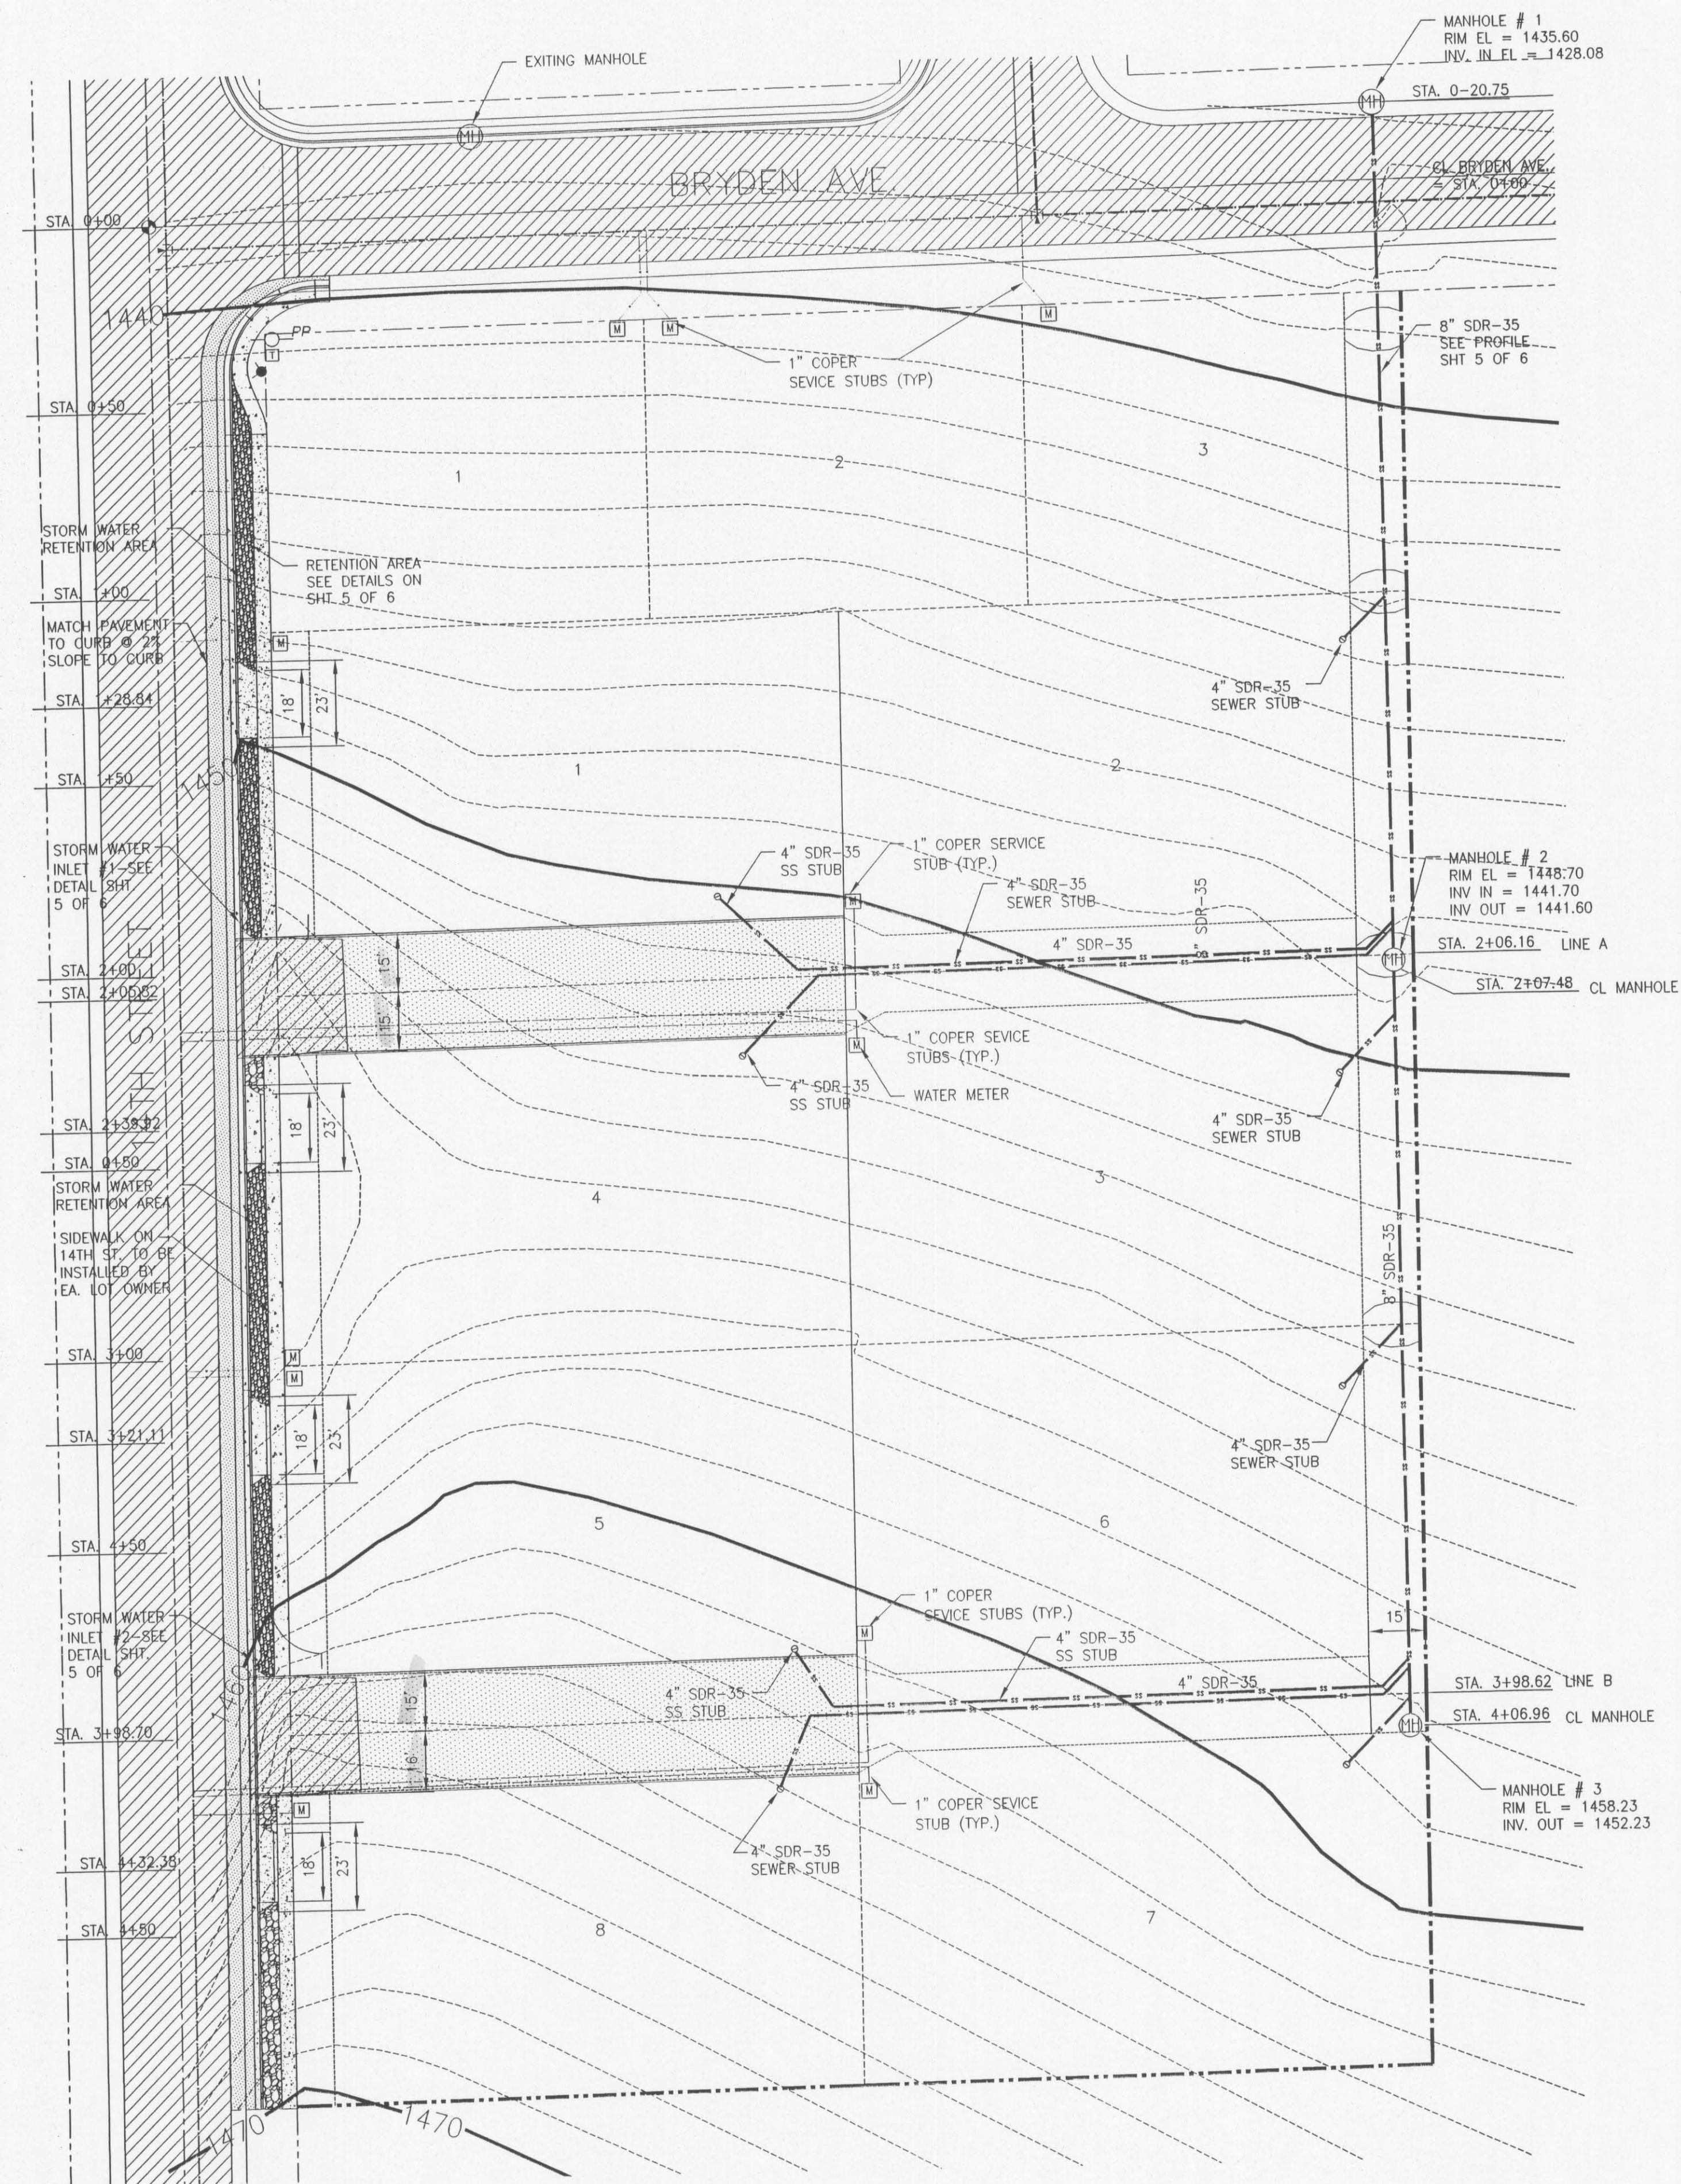


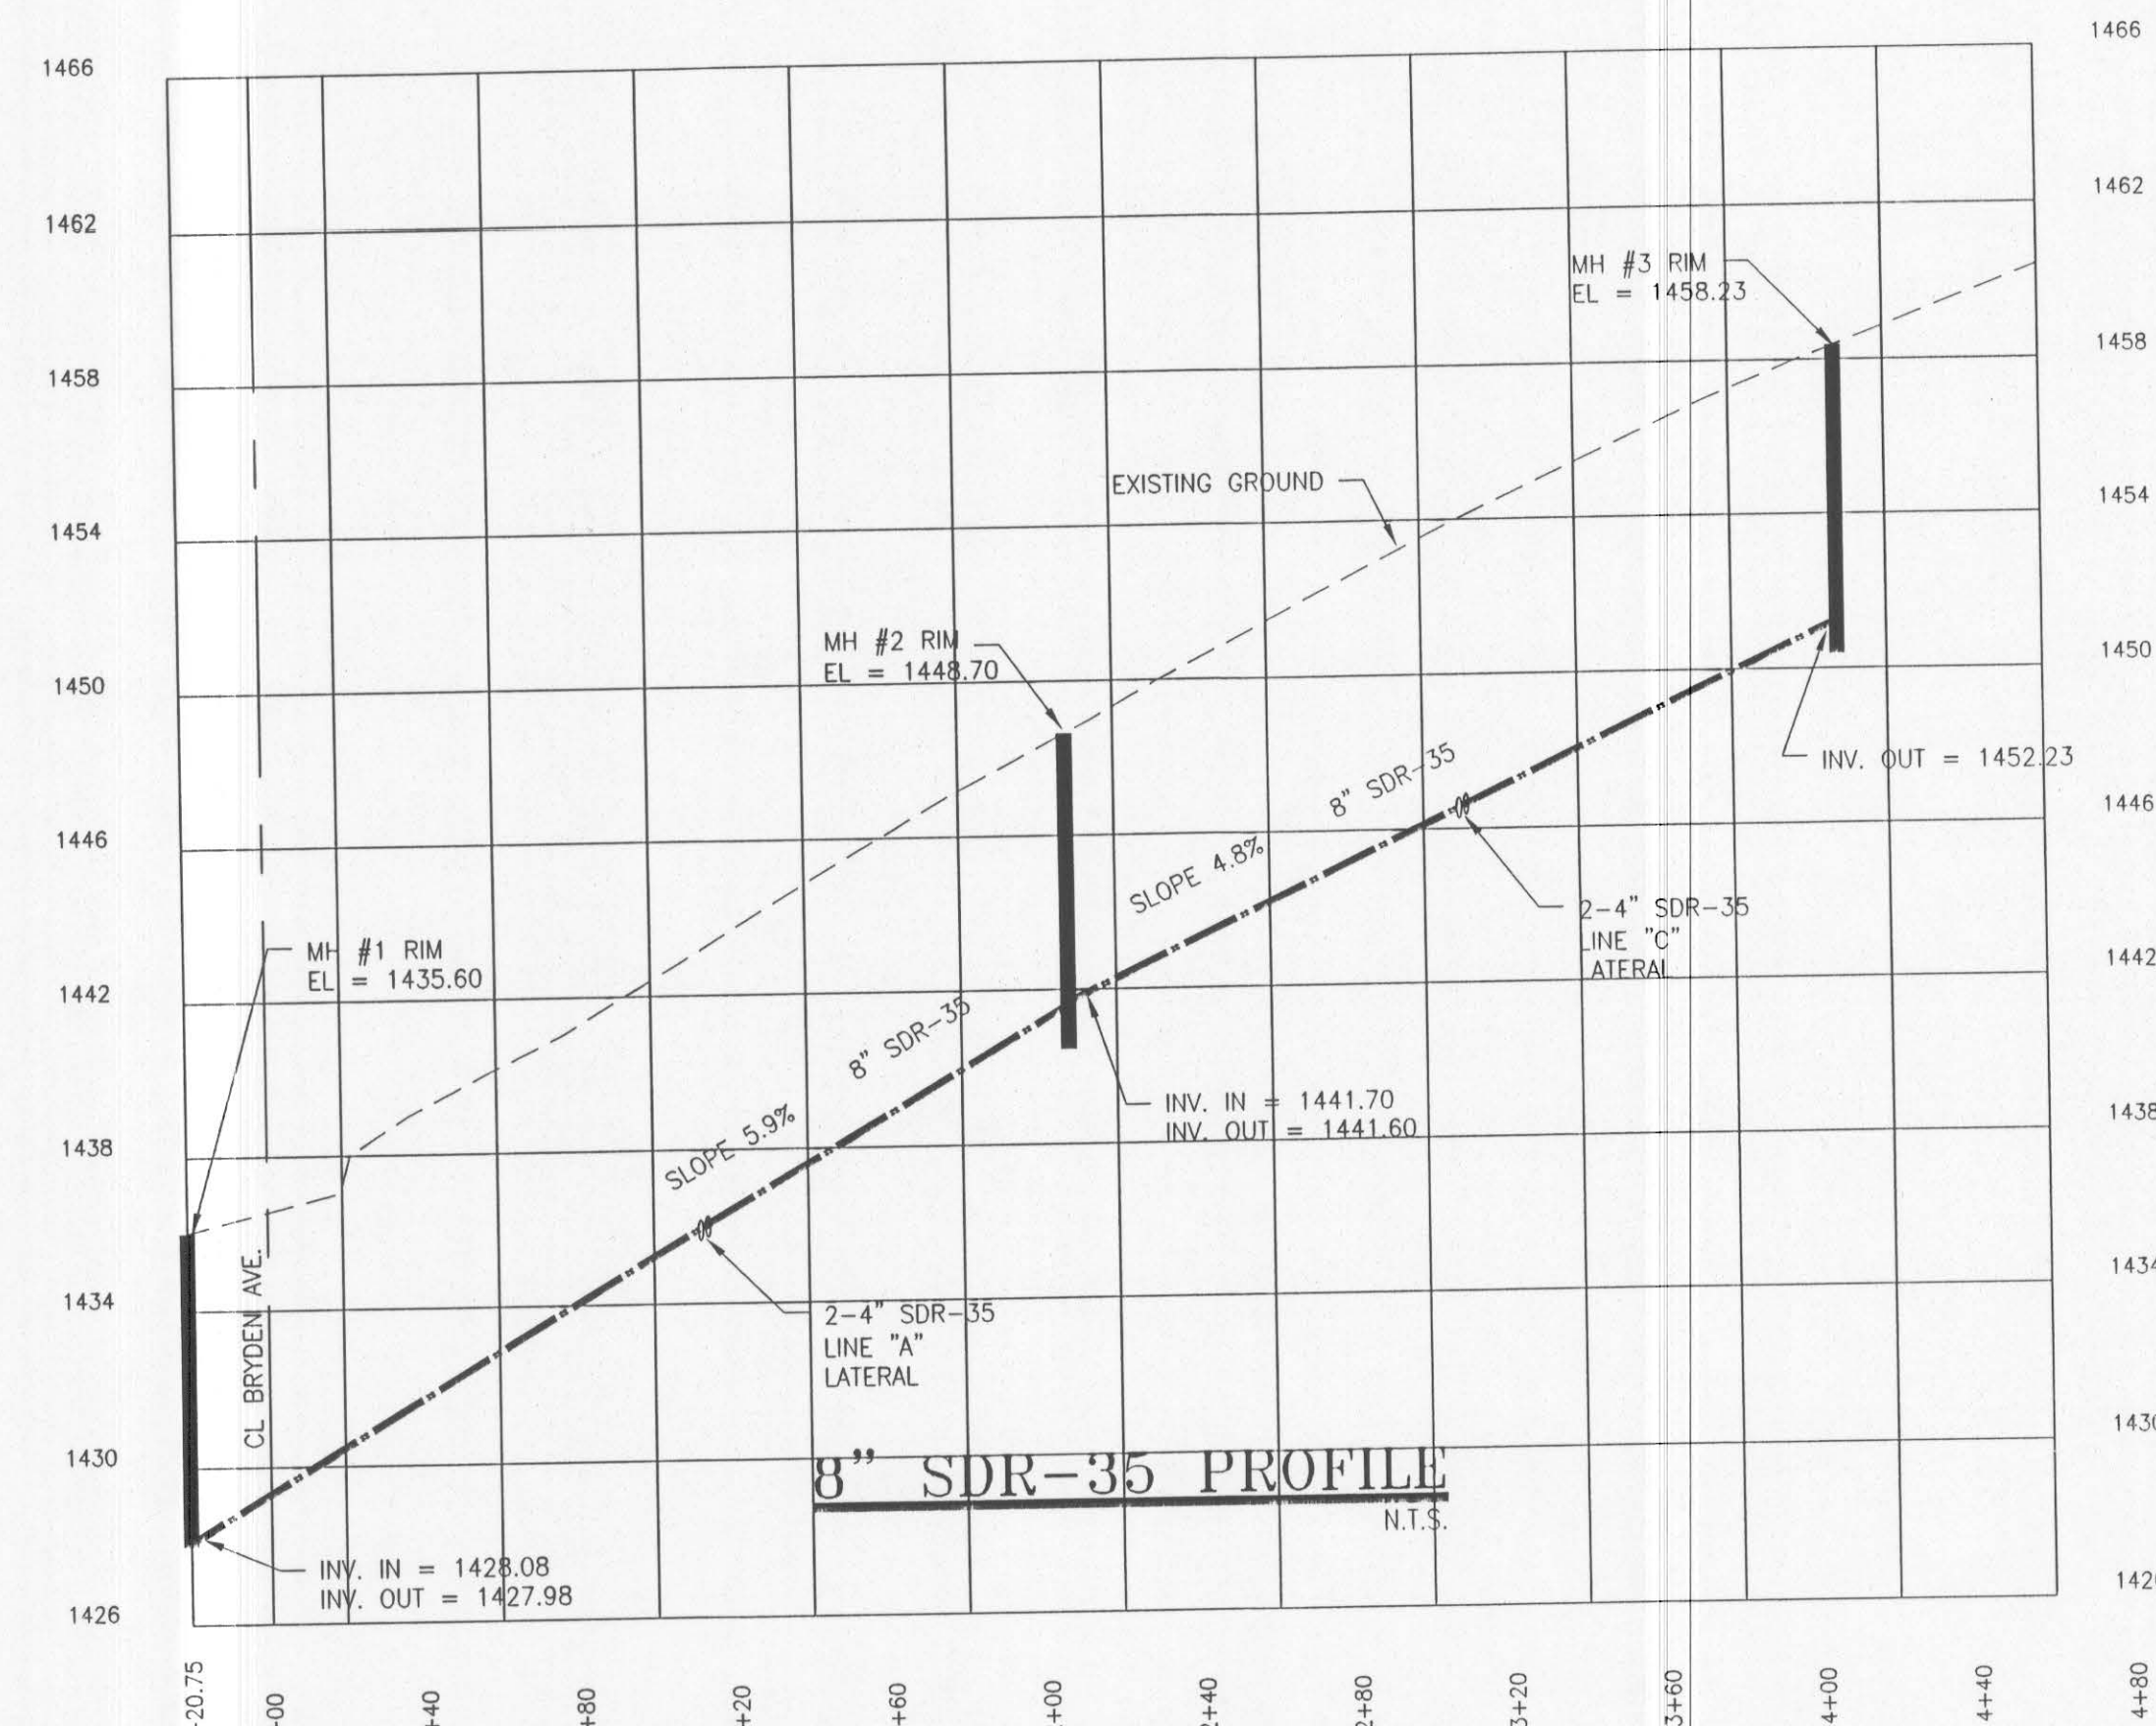

UTILITIES & PROFILES

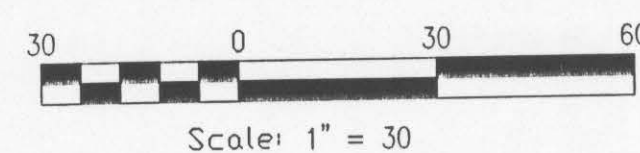

14TH AVE. PROFILE

N.T.S.

