

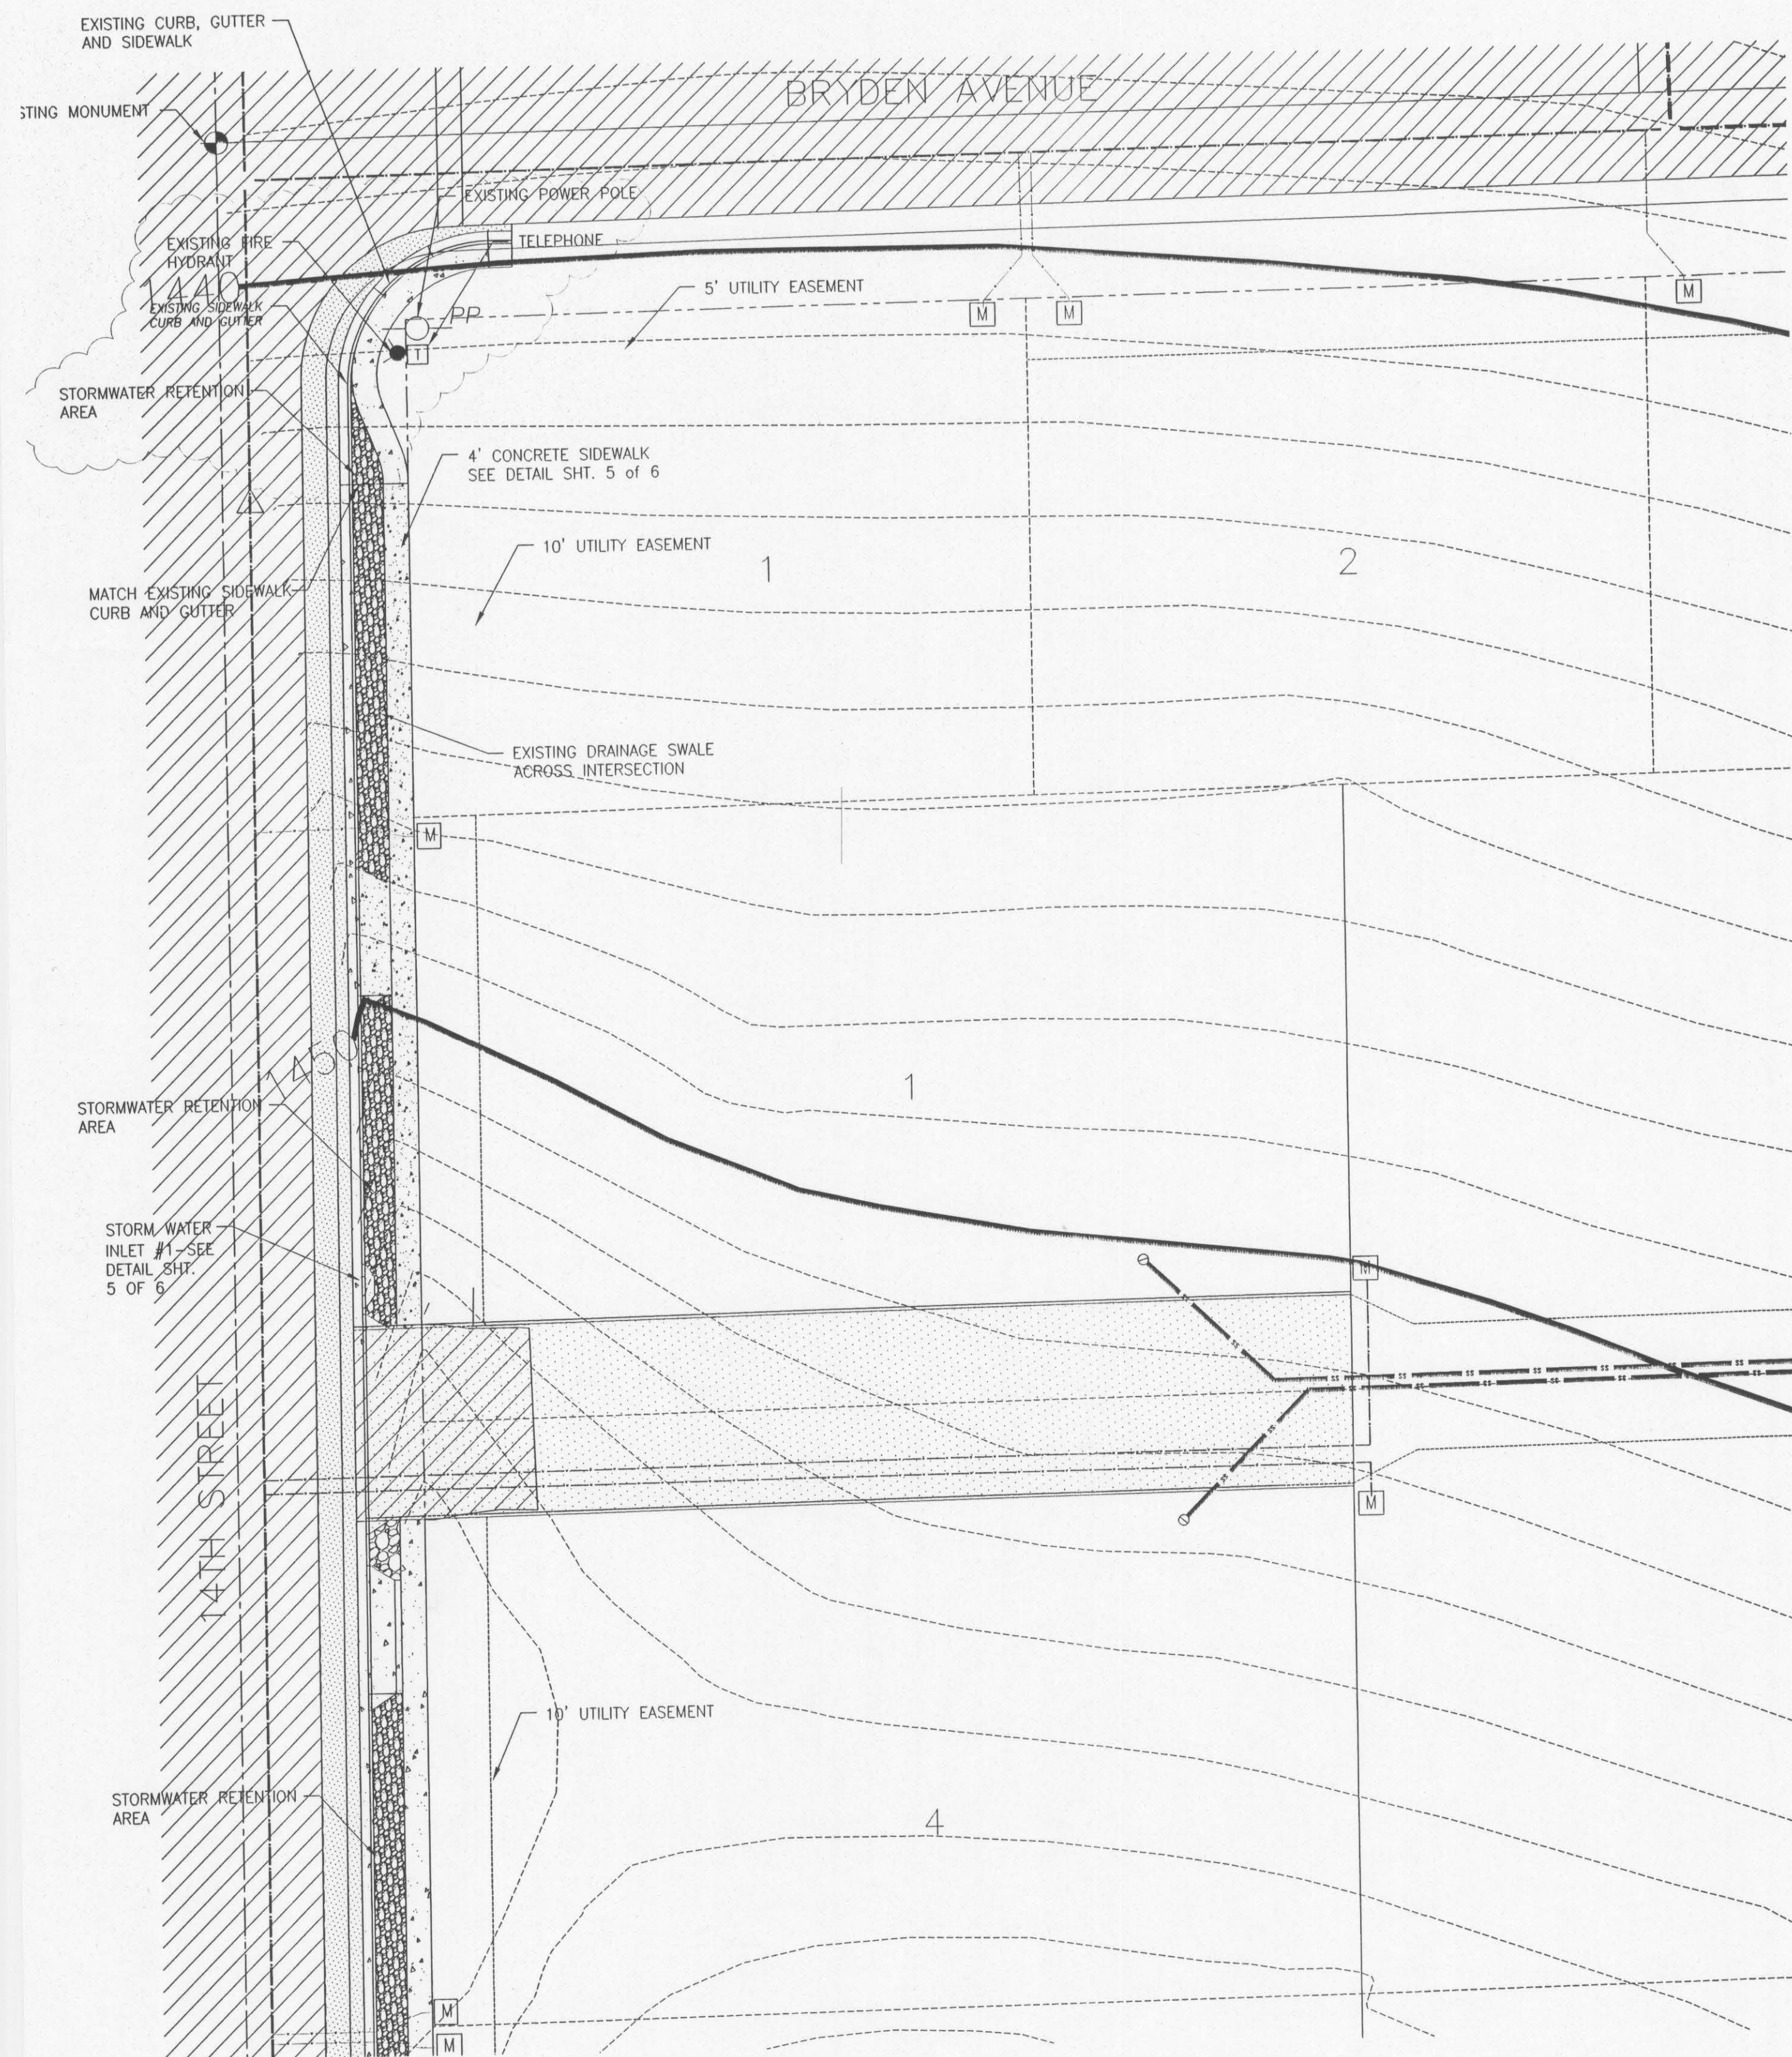


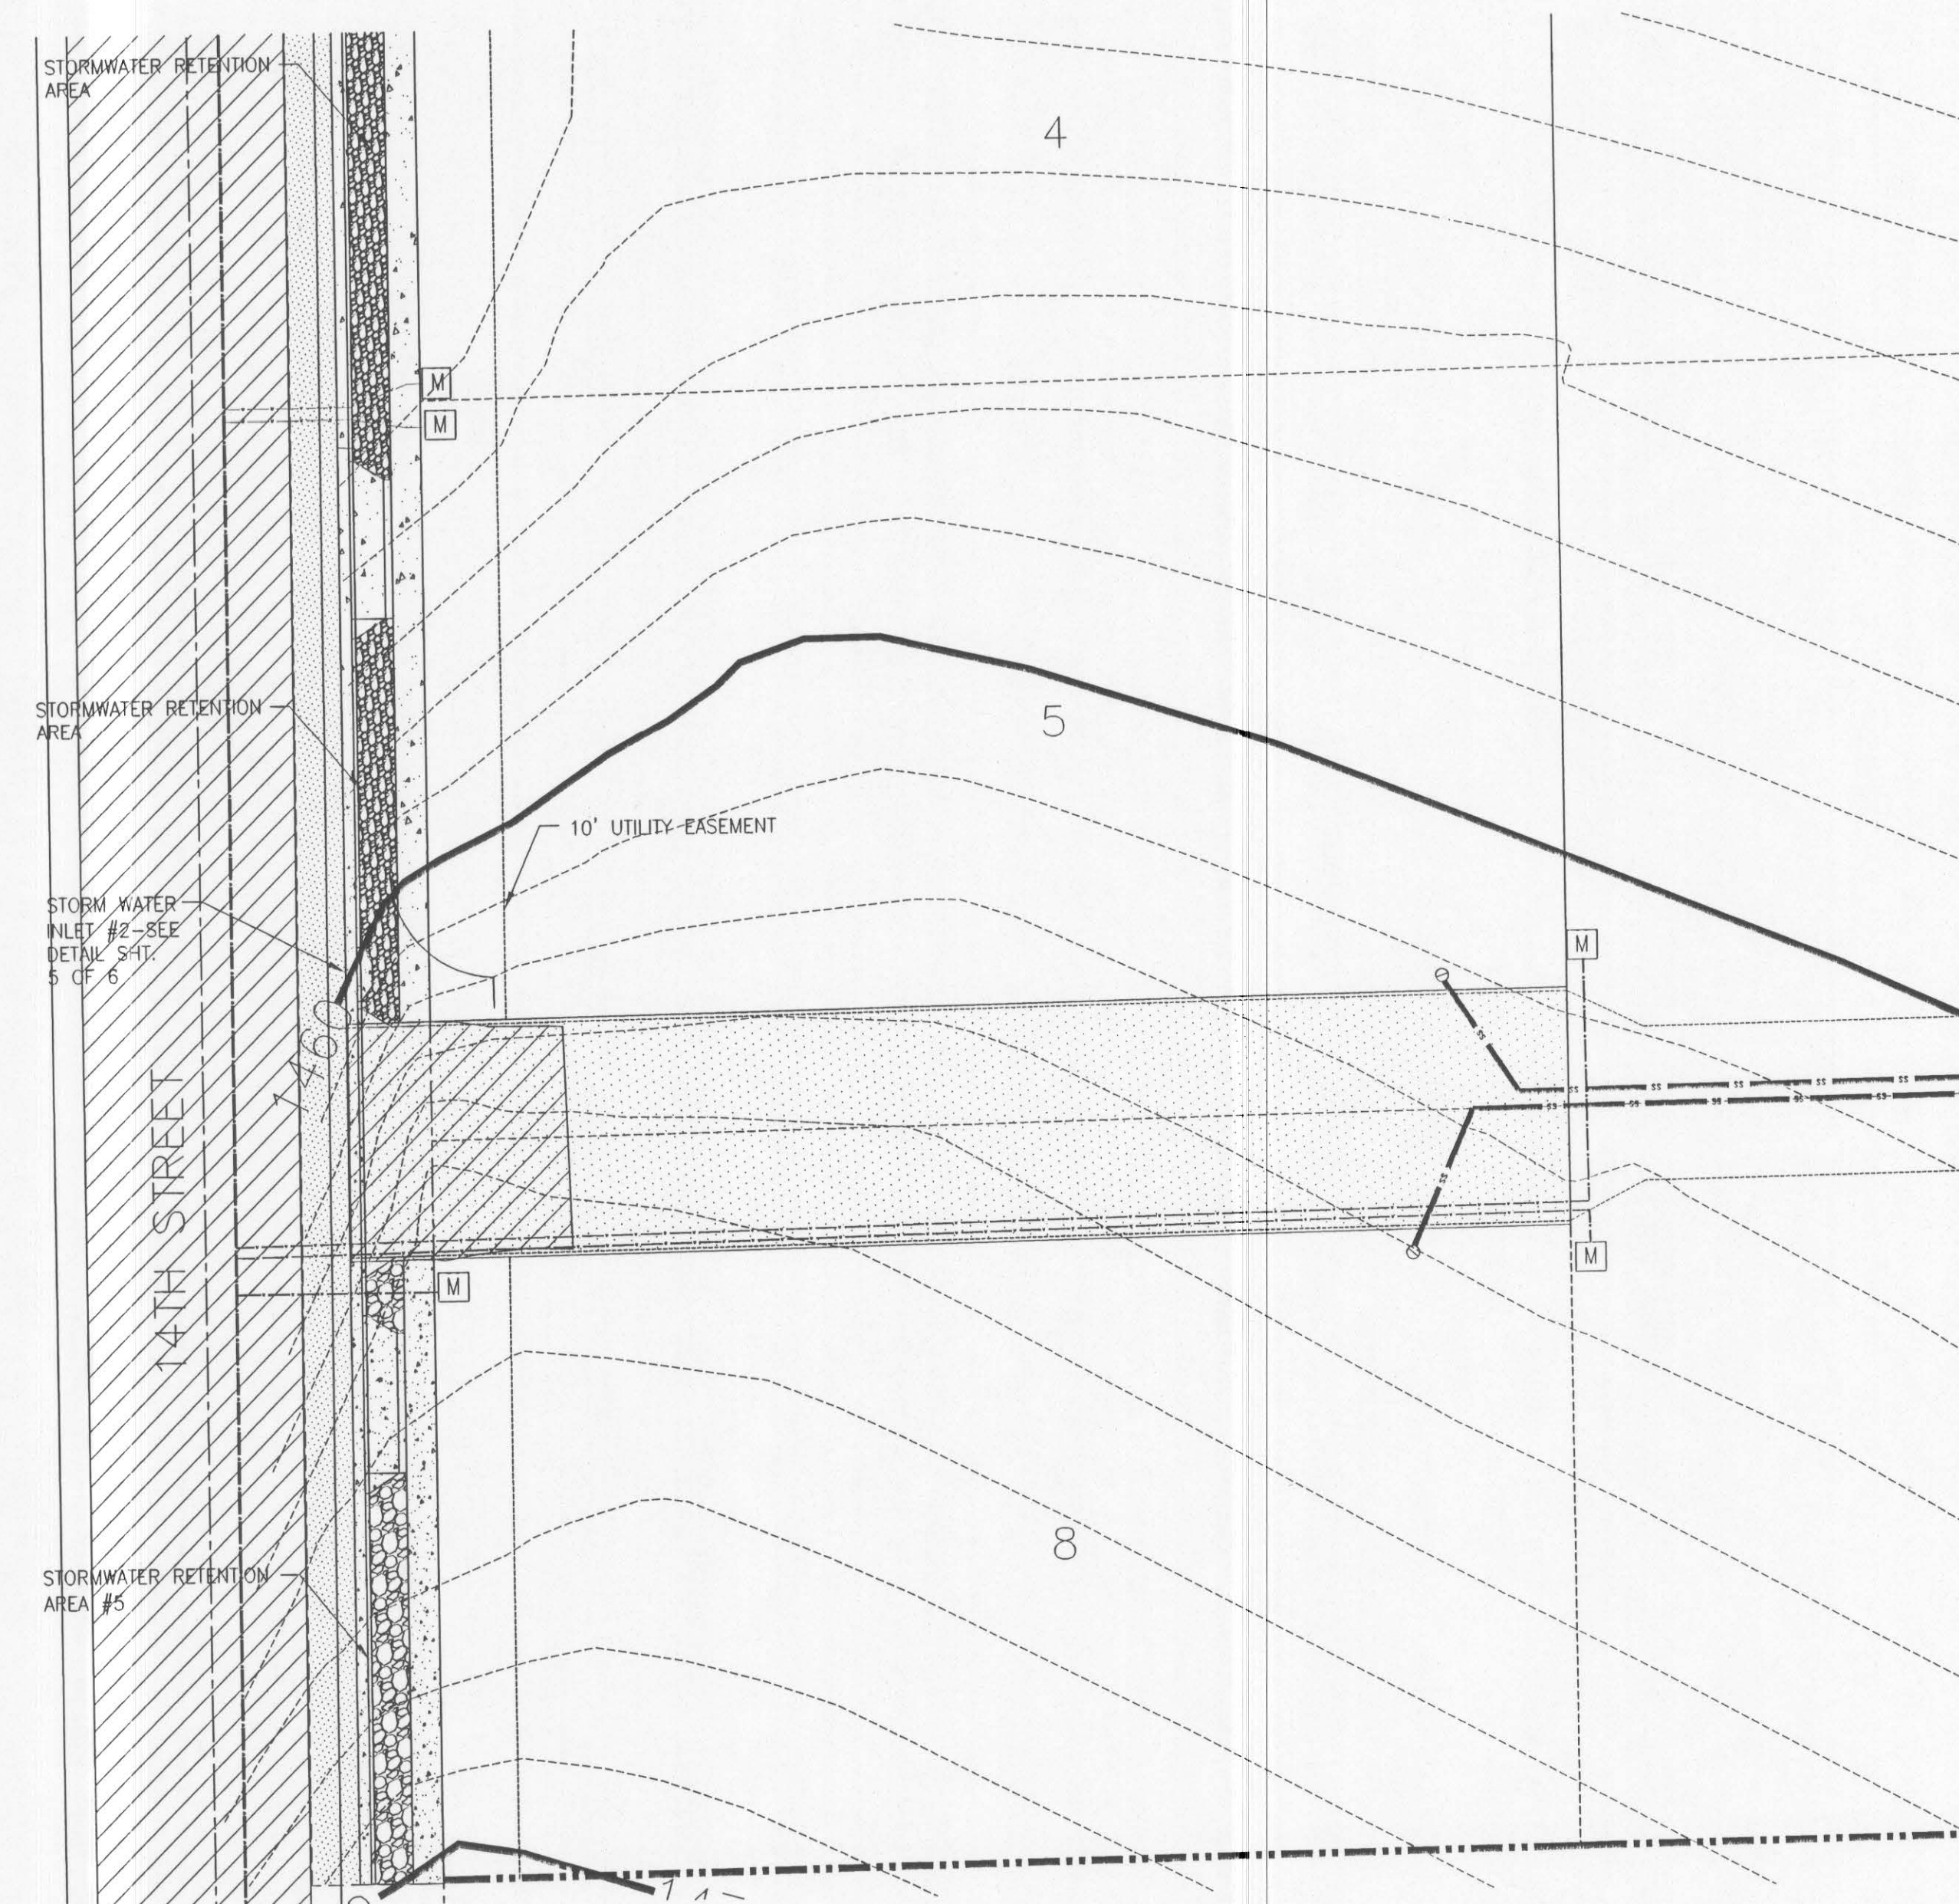

STORMWATER RETENTION AREA #1&2
SCALE: 1" = 20'-0"

STORMDRAIN PLAN N.T.S.

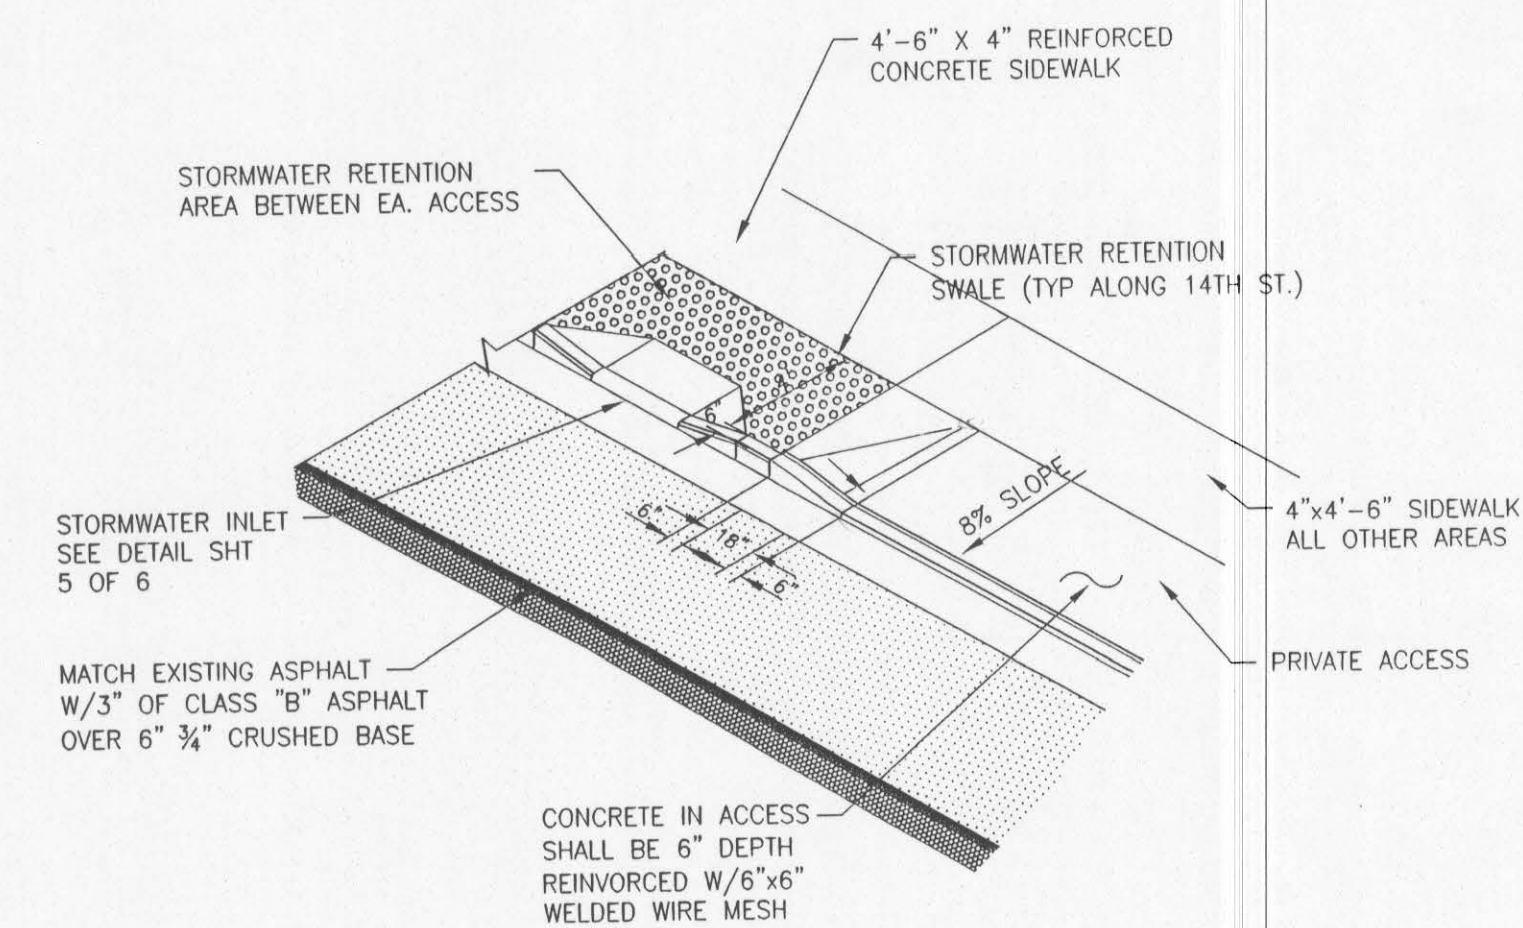

STORMWATER RETENTION AREA # 3&4
SCALE: 1" = 20'-0"

HILLVIEW ADDITION #2
TOM HILL
3525 6TH STREET
LEWISTON, ID 83501
STORMDRAIN PLAN

CIVIL ENGINEERING
* PLANNING
* DESIGN
* RESIDENTIAL & COMMERCIAL DEV
* WATER & SEWER SYSTEM DESIGN
* ROAD DESIGN
* ENVIRONMENTAL SERVICES
PHONE (509) 780 9725
WARREN WATTS ENGINEERING



REV.	DATE	BY	REVISIONS

DRAWN BY: WSW	CHECKED BY: WSW
DESIGNED BY: WSW	
DATE: 4/28/08	
LAST REV: 10/30/08	
PROJECT NO.: 08-032	
SHEET 4 OF 6	