


AS CONSTRUCTED *11/14/16 JSH*
 Hedco, Inc.
 528 Bryden Ave
 Lewiston, ID 83501

Village Centre Cinemas Parking

Rosouers Supermarket Parking

Rosouers Supermarket

10TH STREET

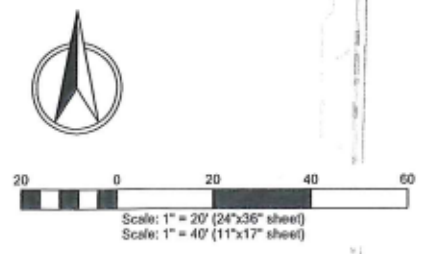

NO.	DATE	REVISION DESCRIPTION
A	11-04-16	Release as per City Review Comments since 11/03/15
B	11-25-16	Revised Catch Basin @ Truck Ramp
C	12-05-16	Revised Catch Basin @ Truck Ramp & Access Easement

SCALE	1"=20'
DATE	10-30-16
PROJECT	1516-C4
DRAWING BY	JSH
CHECKED BY	ME
DATE	10-30-16
PROJECT	1516
PROJECT	1516-C4
DRAWING NO.	1516-C4

**THE IDAHO FOODBANK WAREHOUSE
 LEWISTON FACILITY
 10TH ST & LINDEN AVE
 SITE DEVELOPMENT PLAN - DETAILED
 LEWISTON, IDAHO**

HEDCO
 HAMMOND ENGINEERING & DEVELOPMENT CO.
 528 BRYDEN AVENUE LEWISTON, IDAHO 83501
 (208) 798-6422

SHEET **C4**