

RECEIVED  
JUN 16 2008  
CITY OF LEWISTON  
BUILDING SERVICES

# ITALIANNA GASLITE VILLAGE No. 1


(12 UNIT TOWNHOME DEVELOPMENT)

SOUTHWEST CORNER OF

ELEVENTH AVENUE & 29TH STREET

DEVELOPER: RICHARD AND ANNA ANDERSON

## CITY OF LEWISTON, IDAHO NEZ PERCE COUNTY

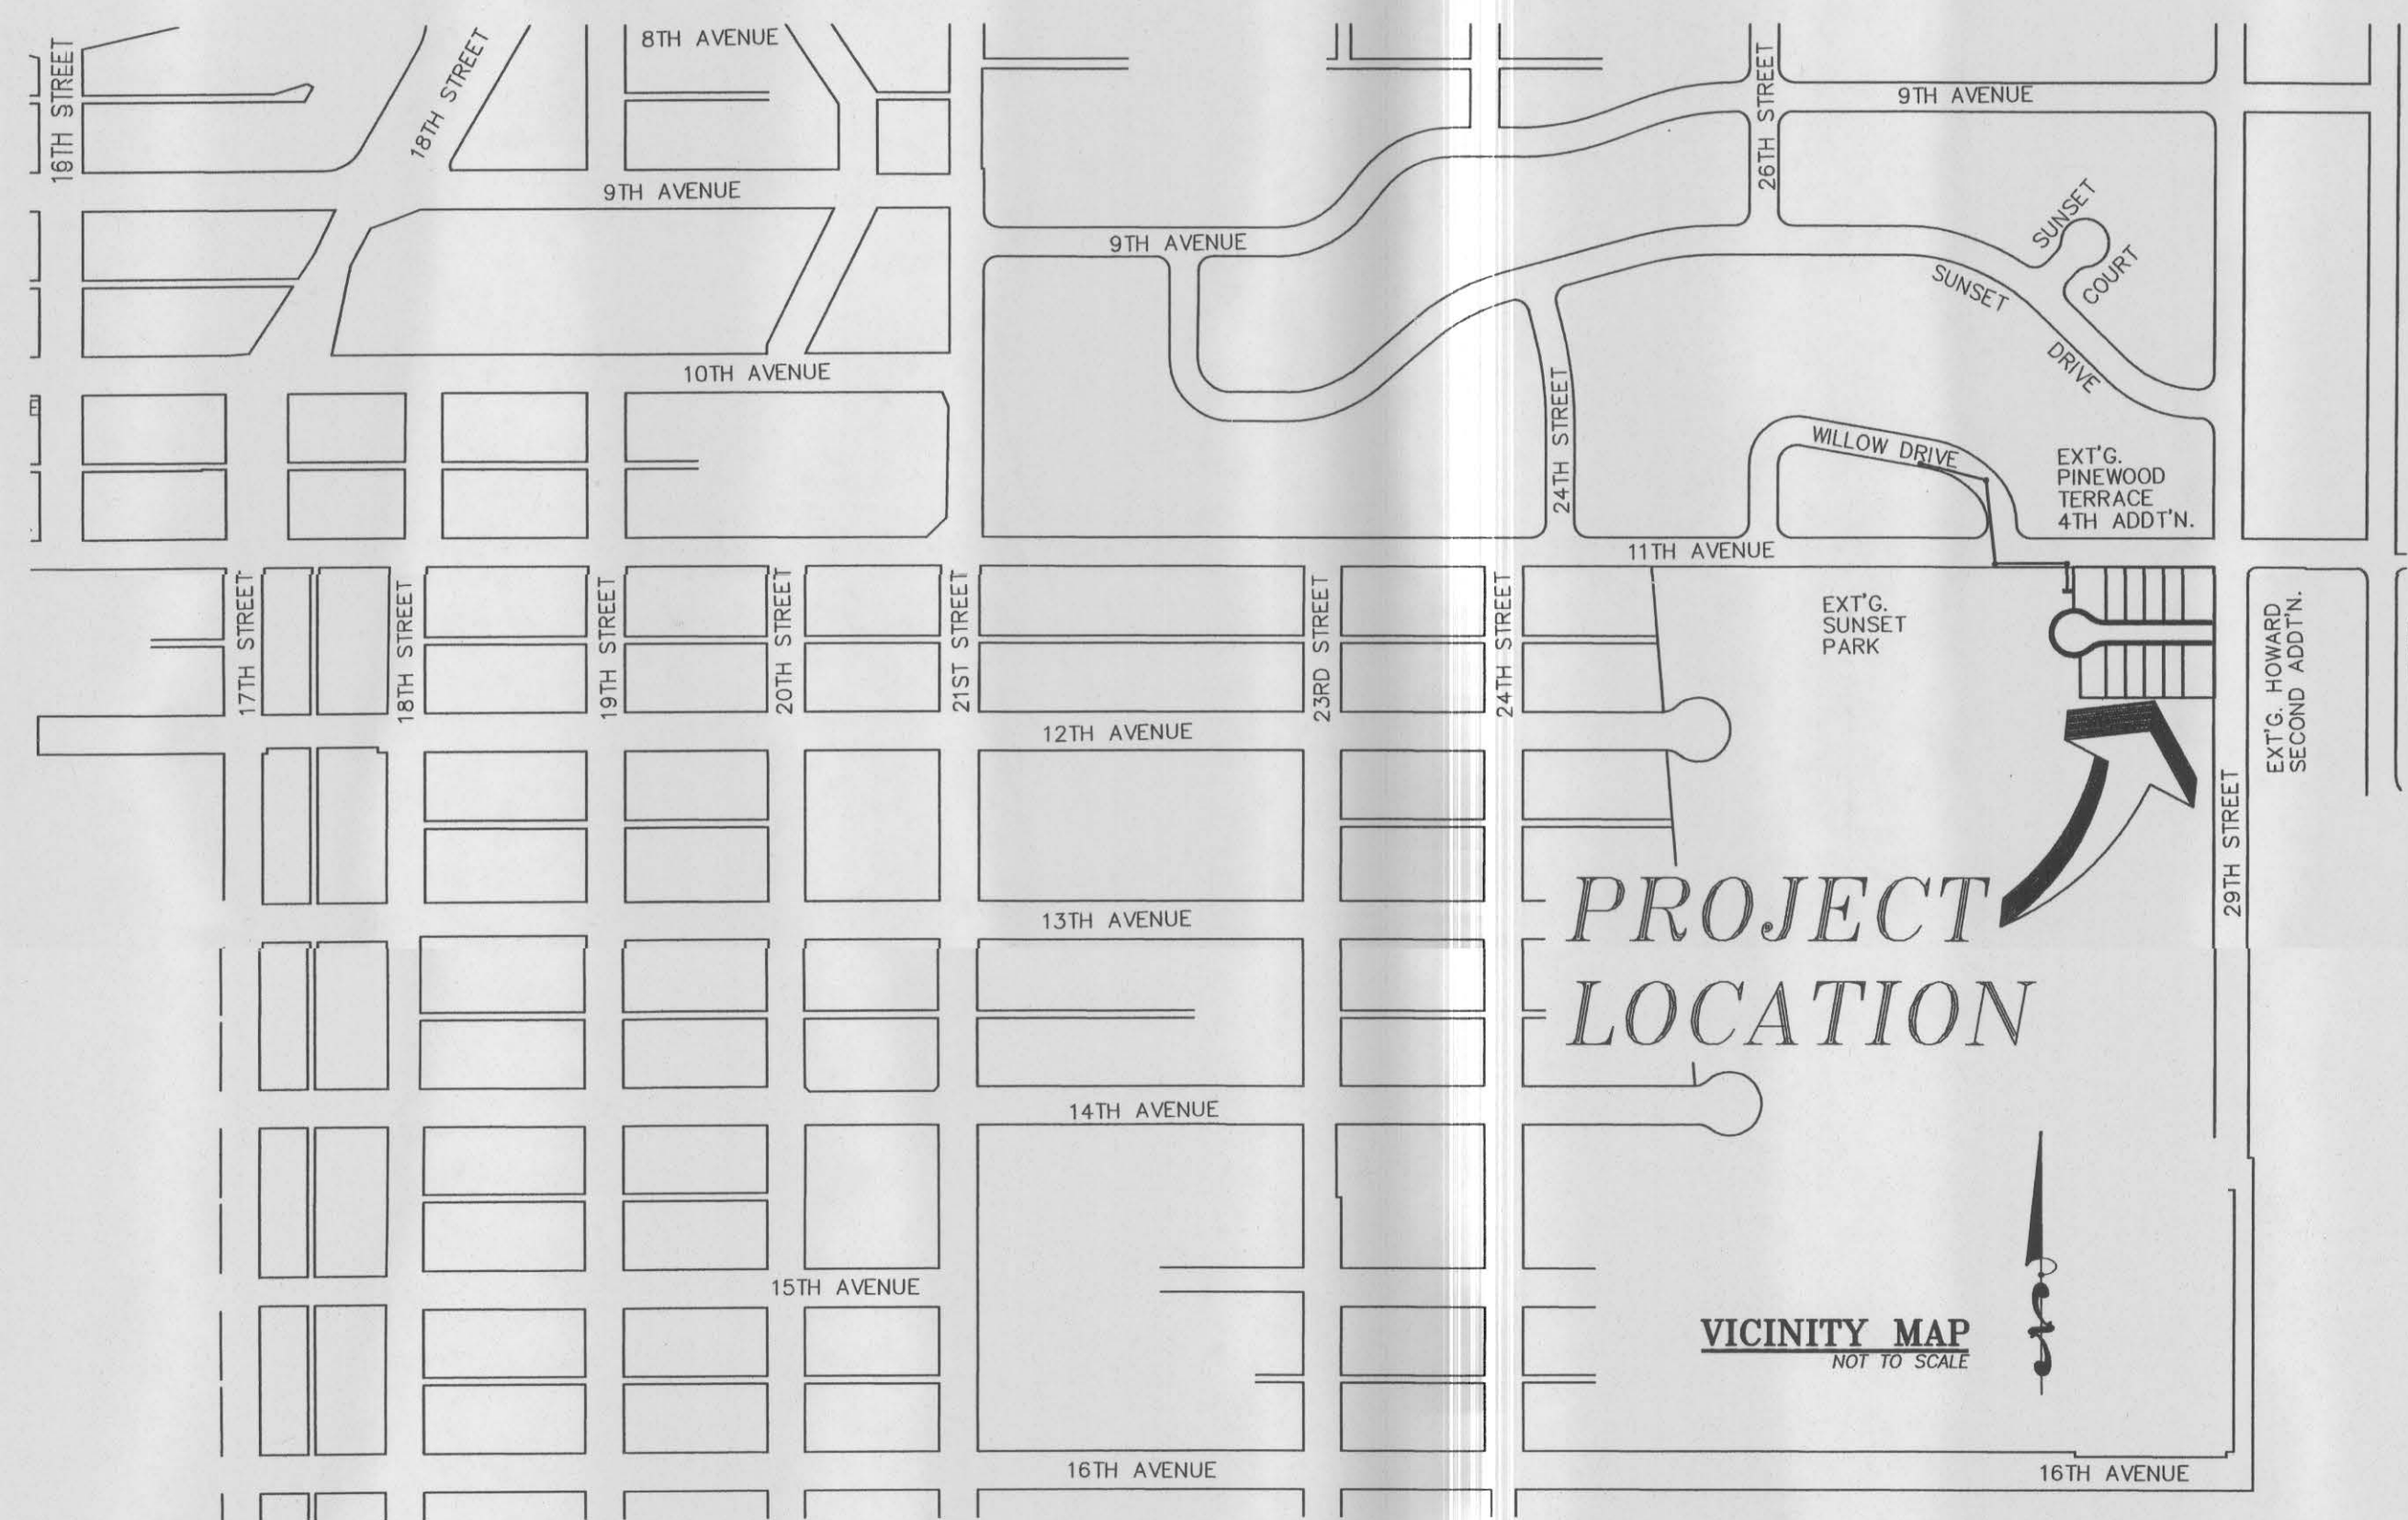

**PROGRESSIVE  
ENGINEERING GROUP, INC**

PLANNING DESIGN CONSTRUCTION MANAGEMENT

1208 IDAHO STREET  
LEWISTON, IDAHO 83501  
PH (208) 746-5406 FAX (208) 746-9732

RECORD DRAWING 10/14/08

SHEET A

As-Builts

2810 Gaslite Ct.  
Italianna Gaslite Village No. 1

U10-000014