


DPW PROJECT NO. 07150 - LCSC 4TH STREET PARKING

SHEET INDEX	
NO.	DESCRIPTION
1	COVER SHEET
2,3	EXISTING SITE & DEMOLITION PLAN
4,5	PROPOSED SITE PLAN
6-8	GRADING & STORM DRAINAGE PLAN
9,10	UTILITY PLAN - N.I.C.
11,12	LANDSCAPE PLAN
13	TRAFFIC CONTROL PLAN
14	EROSION & SEDIMENT CONTROL PLAN
15-17	DETAILS

SCHEDULE OF ABBREVIATIONS	
ABBREVIATION	DESCRIPTION
AASHTO	AMERICAN ASSOCIATION OF STATE HIGHWAY & TRANSPORTATION OFFICIALS
ADA	AMERICAN DISABILITY ACT
ANSI	AMERICAN NATIONAL STANDARDS INSTITUTE
ASTM	AMERICAN SOCIETY FOR TESTING AND MATERIALS
AWG	AMERICAN WIRE GAUGE
AWWA	AMERICAN WATER WORKS ASSOCIATION
AUX.	AUXILIARY
BMP	BEST MANAGEMENT PRACTICE
CAL.	CALIPER
CL	CENTER LINE
CL	CLASS
CP	CONTROL POINT
CY	CUBIC YARD
D.I.	DUCTILE IRON
DIA.	DIAMETER
DR	DIMENSION RATIO
DWG.	DRAWING
E	EAST, EASTING
ELEC	ELECTRICAL
ELEV	ELEVATION
FL	FLOWLINE
GAL.	GALLON
I.E.	INVERT ELEVATION
L.F.	LINEAR FEET
LT.	LEFT
MAX.	MAXIMUM
MIN.	MINIMUM
N	NORTH, NORTHING
N.I.C.	NOT IN CONTRACT
NO.	NUMBER
N.S.F.	NATIONAL SCIENCE FOUNDATION
O.C.	ON CENTER
O.D.	OUTSIDE DIAMETER
O.S.H.A.	OCCUPATIONAL SAFETY AND HEALTH ADMINISTRATION
P/L	PROPERTY LINE
PSI	POUNDS PER SQUARE INCH
PVC	POLYVINYL CHLORIDE
PVI	POINT OF VERTICAL INTERSECTION
R	RADIUS
RT.	RIGHT
S	SOUTH
SCH.	SCHEDULE
SD	STORM DRAIN
SDR	STANDARD DIMENSION RATIO
SF	SQUARE FEET
SS	SANITARY SEWER
STA.	STATION
STD.	STANDARD
SY	SQUARE YARD
TYP.	TYPICAL
UG	UNDERGROUND
W	WEST

AGENCIES	
CALL BEFORE YOU DIG	1-800-342-1585
QWEST COMMUNICATIONS LOCATE	1-800-553-4344
AVISTA UTILITIES	1-208-798-1473
CABLE ONE	1-208-746-3325
CITY OF LEWISTON PUBLIC WORKS	1-208-746-3671
THOMAS, DEAN & HOSKINS - ENGINEER	1-208-746-0938
SCOTT BROWN - LCSC FACILITIES	1-208-792-2247

LEWISTON, IDAHO
SECTION 1, TOWNSHIP 35 N, RANGE 6 W
DATE: FEBRUARY 22, 2008

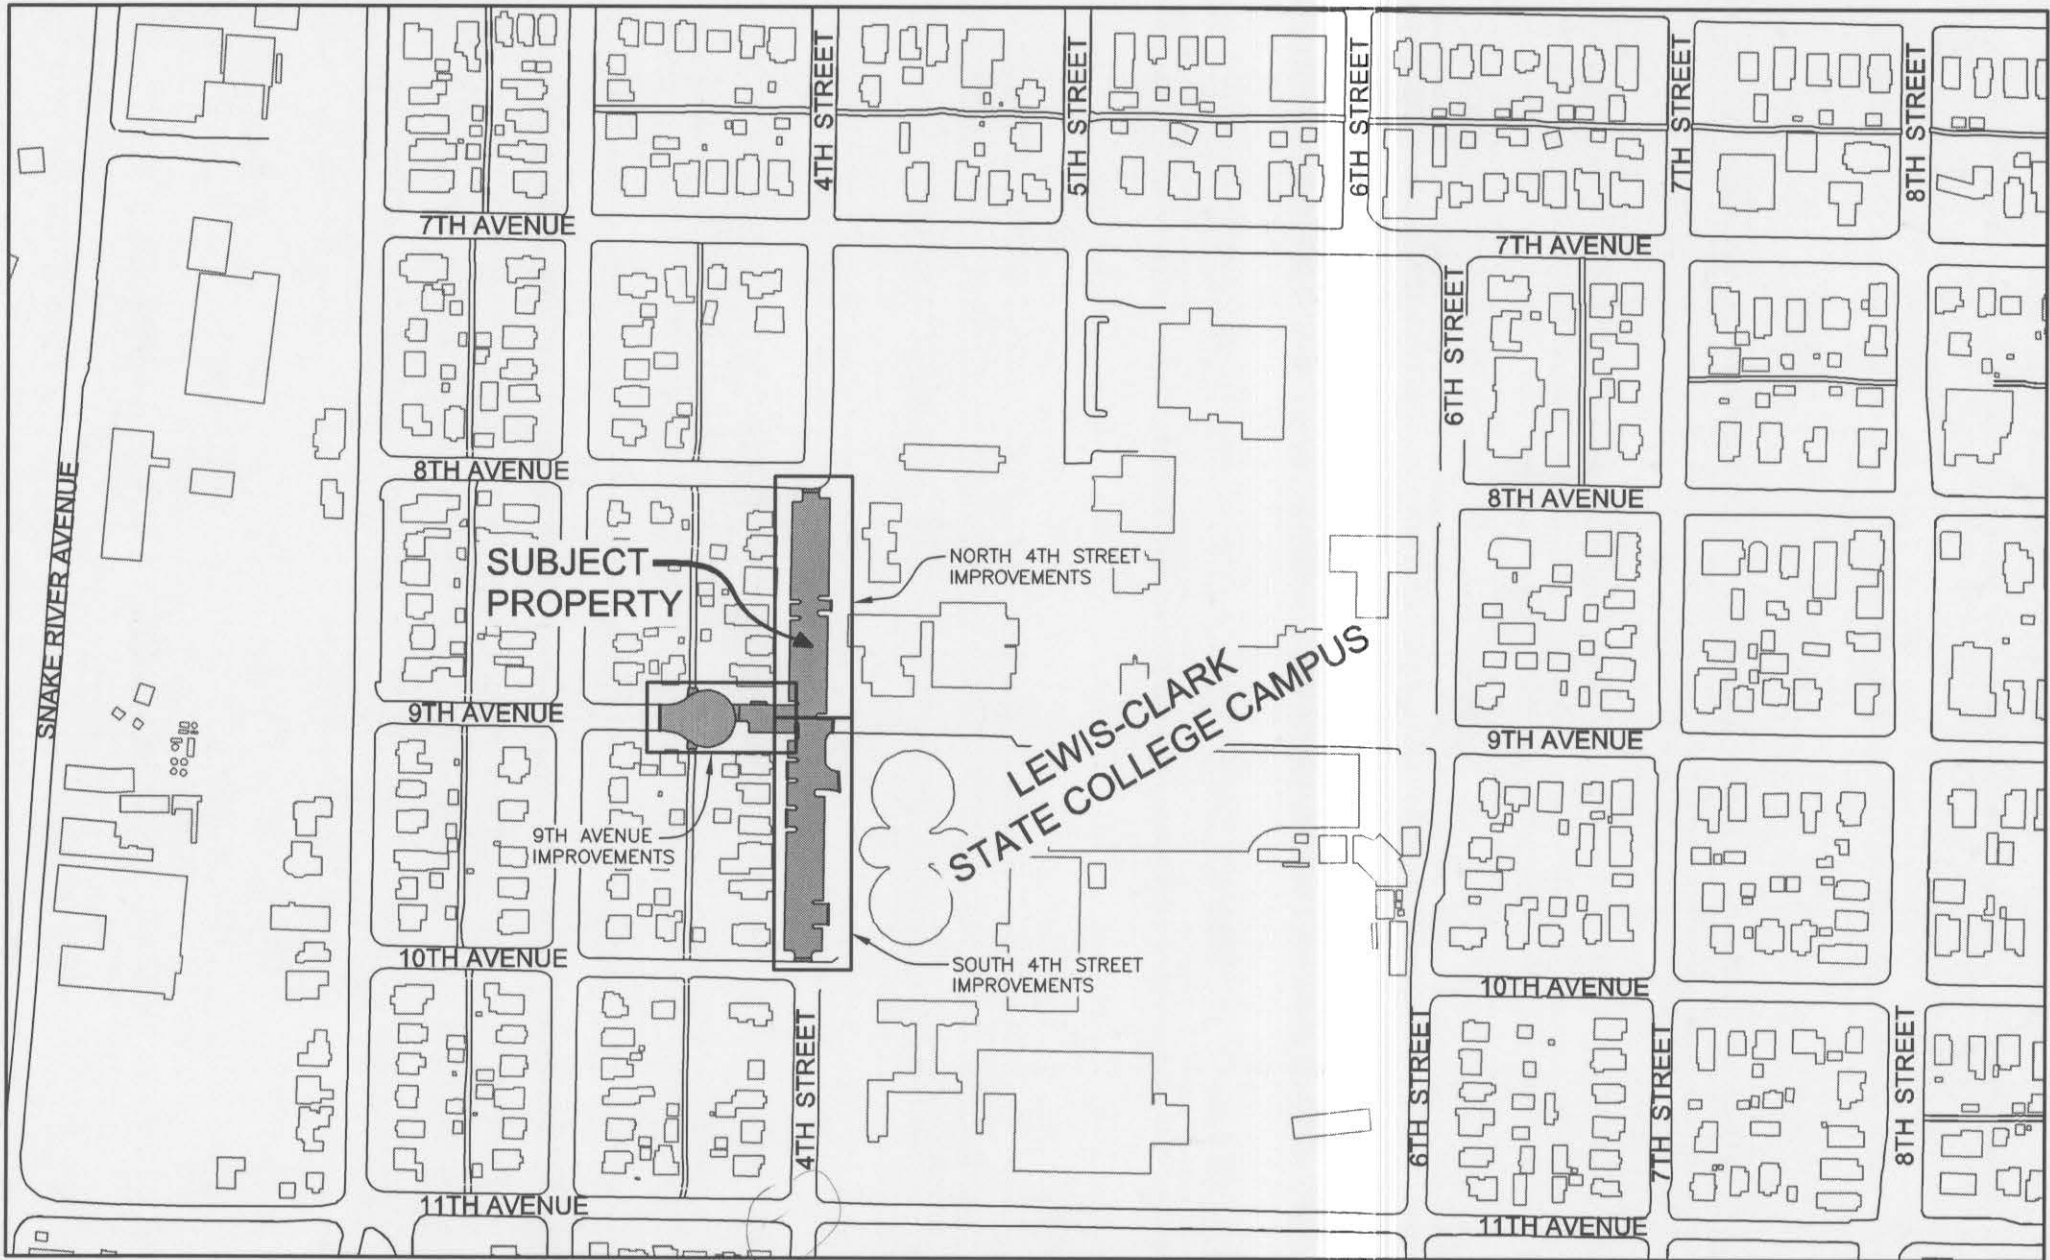

VICINITY MAP
NOT TO SCALE

GENERAL NOTES

- 1) THE CONTRACTOR SHALL INVESTIGATE ON SITE AND VERIFY ALL CONDITIONS AND DIMENSIONS OF THE PROJECT AND SHALL NOTIFY THE ENGINEER OF ANY DISCREPANCY IN THE CONTRACT DOCUMENTS REQUIRING MODIFICATION PRIOR TO PROCEEDING.
- 2) THE CONTRACTOR SHALL COORDINATE THE WORK SCHEDULE SO AS TO HAVE A MINIMUM IMPACT ON THE EXISTING TRAFFIC.
- 3) SITE DISTANCES FOR ABUTTING PROPERTIES, DRIVEWAYS, AND INTERSECTIONS MUST BE MAINTAINED.
- 4) THE CONTRACTOR SHALL TAKE ALL NECESSARY PREVENTATIVE MEASURES TO PROTECT THE EXISTING IMPROVEMENTS. ANY DAMAGE SHALL BE REPLACED AT NO COST TO THE OWNER.
- 5) OWNER'S PROPERTY CORNERS SHALL BE PROTECTED AT ALL TIMES AND THE CONTRACTOR SHALL RETAIN THE SERVICES OF A PROFESSIONAL LAND SURVEYOR REGISTERED IN THE STATE OF IDAHO TO REFERENCE ALL CORNERS. UPON COMPLETION OF THE PROJECT, ANY EXISTING CORNERS DAMAGED BY CONSTRUCTION SHALL BE REPLACED BY A PROFESSIONAL LAND SURVEYOR AT THE EXPENSE OF THE CONTRACTOR.
- 6) IMPROVEMENTS CONSTRUCTED ON RIGHT-OF-WAY REQUIRE A RIGHT-OF-WAY PERMIT OBTAINED AT THE CONSTRUCTION MANAGEMENT SECTION OF THE PUBLIC WORKS DEPARTMENT.
- 7) THE CONTRACTOR SHALL PAY FOR AND SECURE ALL NECESSARY PERMITS AND FEES.
- 8) ALL WORK SHALL CONFORM TO STATE AND LOCAL CODES AND CONFORM TO THE CITY OF LEWISTON STANDARD DRAWINGS AND STANDARD TECHNICAL SPECIFICATIONS EXCEPT AS OTHERWISE SPECIFIED OR APPROVED BY THE ENGINEER.
- 9) UPON COMPLETION, CONTRACTOR SHALL PROVIDE AS-BUILT DRAWINGS, COMPLETE WITH ELEVATIONS, TO THE ENGINEER OF RECORD.
- 10) THIS PROJECT SHALL BE GUARANTEED BY THE CONTRACTOR FOR A PERIOD OF ONE (1) YEAR FROM THE DATE OF FINAL ACCEPTANCE OF ALL WORK. ANY DEFECTS IN MATERIAL OR WORKMANSHIP WITHIN THIS PERIOD SHALL BE IMMEDIATELY CORRECTED BY THE CONTRACTOR AT NO COST TO THE OWNER.

UTILITY LOCATION

THE LOCATIONS OF UNDERGROUND UTILITIES REPRESENTED ON THIS DRAWING HAVE BEEN DETERMINED FROM A FIELD SURVEY AND FROM RECORDS OBTAINED FROM THE VARIOUS UTILITY COMPANIES. THE NUMBER AND LOCATIONS OF ALL UNDERGROUND UTILITIES SHOWN ARE FOR INFORMATIONAL PURPOSES ONLY. FOR YOUR SAFETY, STATE LAW REQUIRES THAT YOU CALL THE LOCAL "ONE-CALL" UNDERGROUND UTILITY LOCATING CENTER AT LEAST TWO WORKING DAYS BEFORE BEGINNING ANY EXCAVATION: 1-800-342-1585

"CALL BEFORE YOU DIG"

Authorization to Bid	
DPW Project No. 07150	
<i>Chris Hunter</i>	Responsible Chief Officer
<i>[Signature]</i>	Administrator of Public Works
Authorization to Bid	
DPW Project No. 07150	
<i>Chris Hunter</i>	Responsible Chief Officer
<i>[Signature]</i>	Administrator of Public Works



LEGEND

EXISTING

DESCRIPTION

ASPHALT	
CABLE TV RISER	□TV
CLEANOUT	⊙
CONCRETE	
CONTOUR	--- 825 ---
CURB (STRAIGHT)	=====
CURB & GUTTER	=====
DRYWELL	⊙
ELECTRICAL BOX	□
FIRE HYDRANT	⊙
GAS LINE	— G —
GUY WIRE	— GUY —
INLET	⊙
IRRIGATION VALVE	⊙
LIGHT	⊙
MANHOLE	⊙
POWER POLE	⊙
RIGHT-OF-WAY / PROPERTY LINE	P/L
SANITARY SEWER LINE	S
SPOT ELEVATIONS	825.00
STORM DRAIN LINE	SD
TRAFFIC SIGN	⊙
TREE - CONIFEROUS	★
TREE - DECIDUOUS	⊙
UNDERGROUND ELECTRICAL	E
WATER LINE	W
ABANDONED WATER LINE	-W-
WATER METER	⊙
VALVE	⊙
YARD HYDRANT	⊙

ITEM	INSPECTOR / CO.	DATE INSPECTED	INITIAL
1. SOILS COMPACTION - TRENCH BACKFILLING - STRUCTURAL FILLS			
2. WATER MAINS - ALIGNMENT AND GRADE - JOINTS ALIGNMENT - THRUST BLOCKS - HYDROSTATIC PRESSURE - CHLORINATION/BACTERIA			
3. SEWER MAINS - ALIGNMENT AND GRADE - JOINTS ALIGNMENT - MANHOLES - PRESSURE TEST			
4. STREET - SUBGRADE COMPACTION - BASE COMPACTION - ASPHALT COMPACTION			

DPW PROJECT NO. 07150 - LCSC 4TH STEET PARKING
LEWISTON, ID

COVER SHEET