
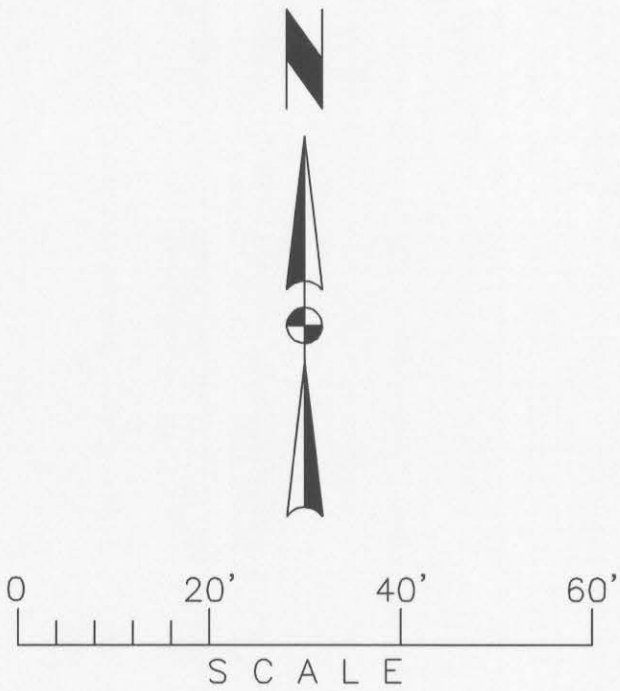
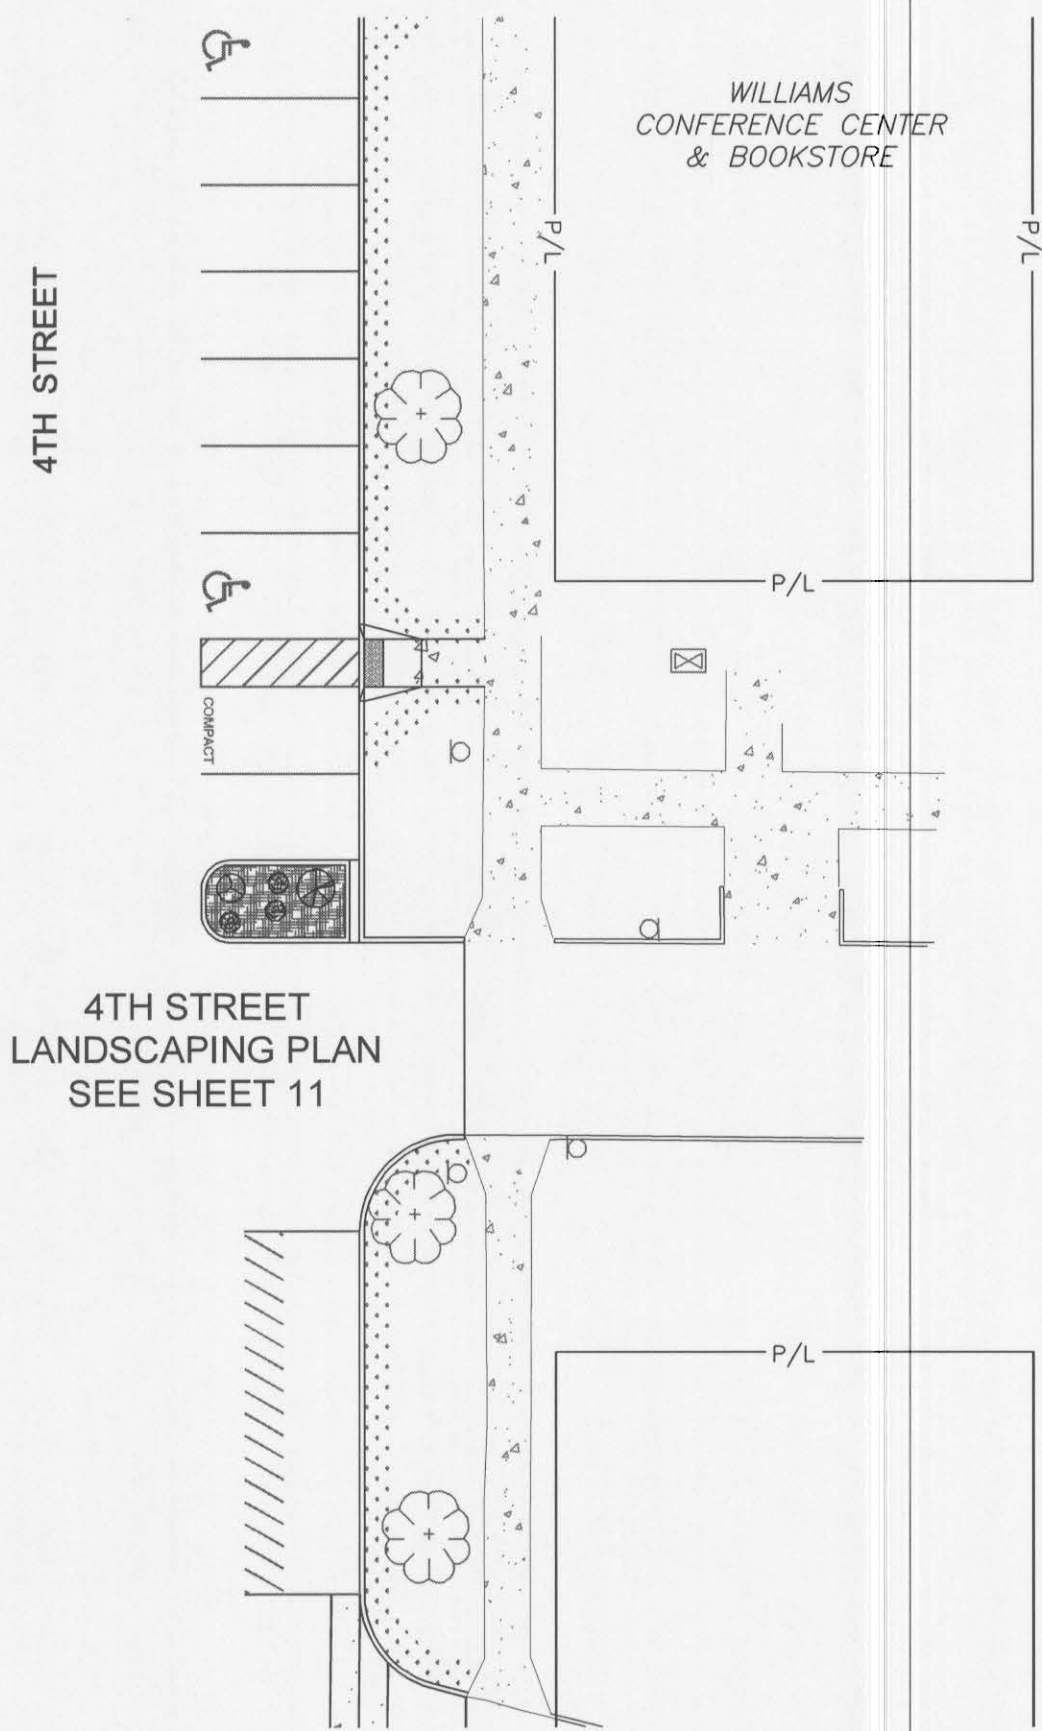


9TH AVENUE LANDSCAPE PLAN

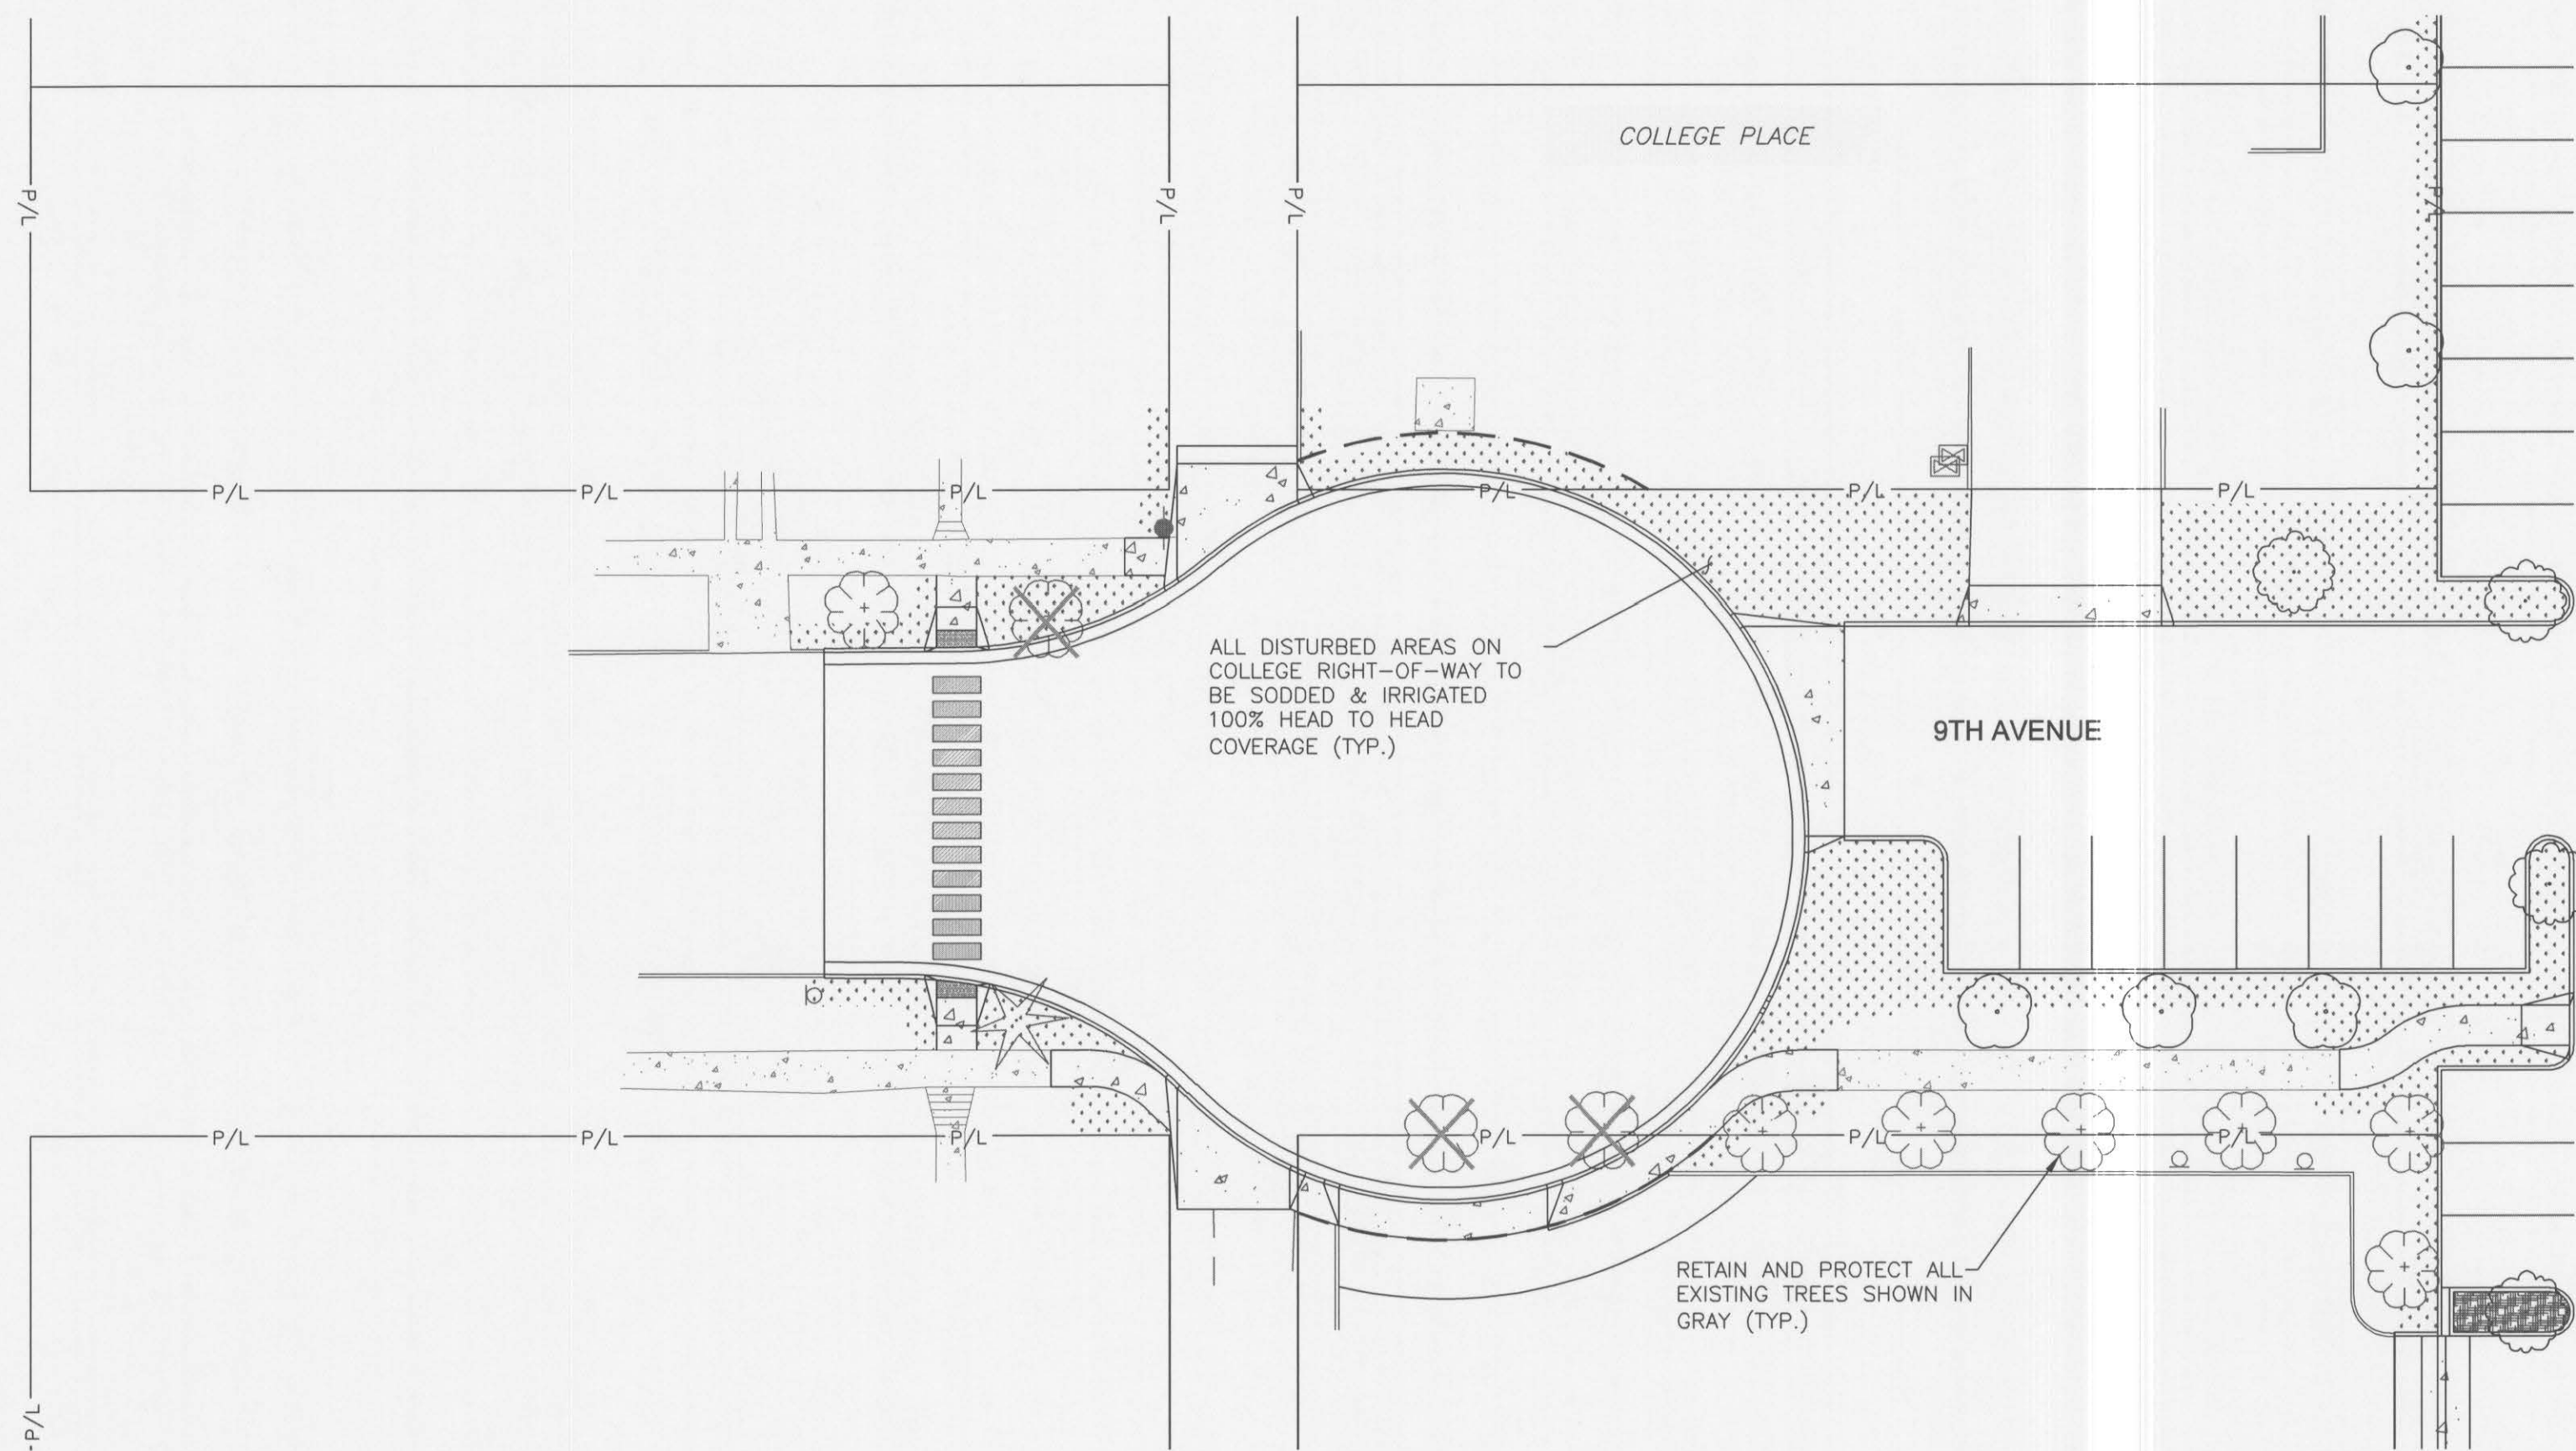

LANDSCAPE SCHEDULE			
SYMBOL	QUANTITY	COMMON NAME	SIZE
	1	CRIMSON KING	3" CAL.
	3	DEBORAH MAPLE	3" CAL.
	3	(TREE TO BE REMOVED)	VARIES
GROUND COVER SCHEDULE			
	233 SY	SOD	N/A
	11 SY	MULCH BARK	FINE

PROFESSIONAL ENGINEER
REGISTERED
JULIAN NETZ, OFF.

REVISIONS
BY HRF DATE 8.03.07 DESC. PER CITY & DPW REVIEW
BY DATE DESC.
BY DATE DESC.

THOMAS, DEAN & HOSKINS, INC.
ENGINEERING CONSULTANTS
GREAT FALLS-BOZEMAN-KALISPELL
SPOKANE 2517 7TH STREET SUITE B
LEWISTON, ID 83501 (208) 46-0938

TD&H

DESIGNED BY: TJP
QUALITY CHECK: JLN
DATE: 2.22.08
JOB NO. L06-020
FIELDBOOK

DPW PROJECT NO. 07150 - LCSC 4TH STREET PARKING
LEWISTON, IDAHO

9TH AVENUE
LANDSCAPE PLAN

CAD NO. L06020-12.DWG
SHEET 12 OF 17