



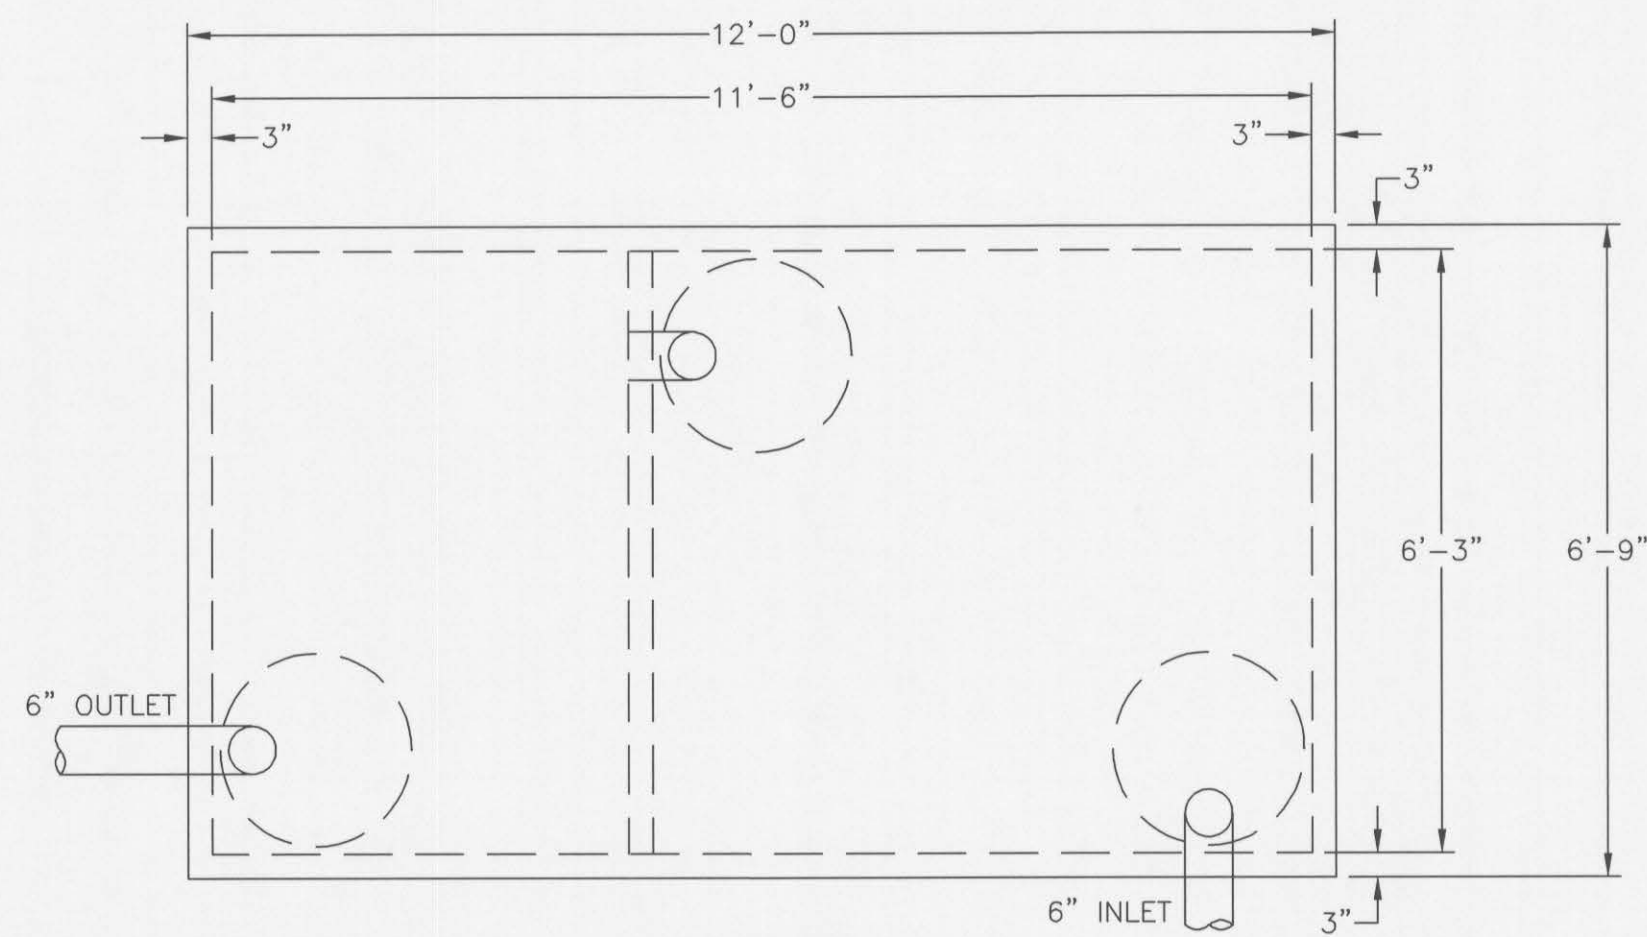

PLAN VIEW

CONCRETE GRADE RINGS, COLLAR
AND COVER CONFORMING TO CITY
OF LEWISTON STD. DWG. NO. S-4

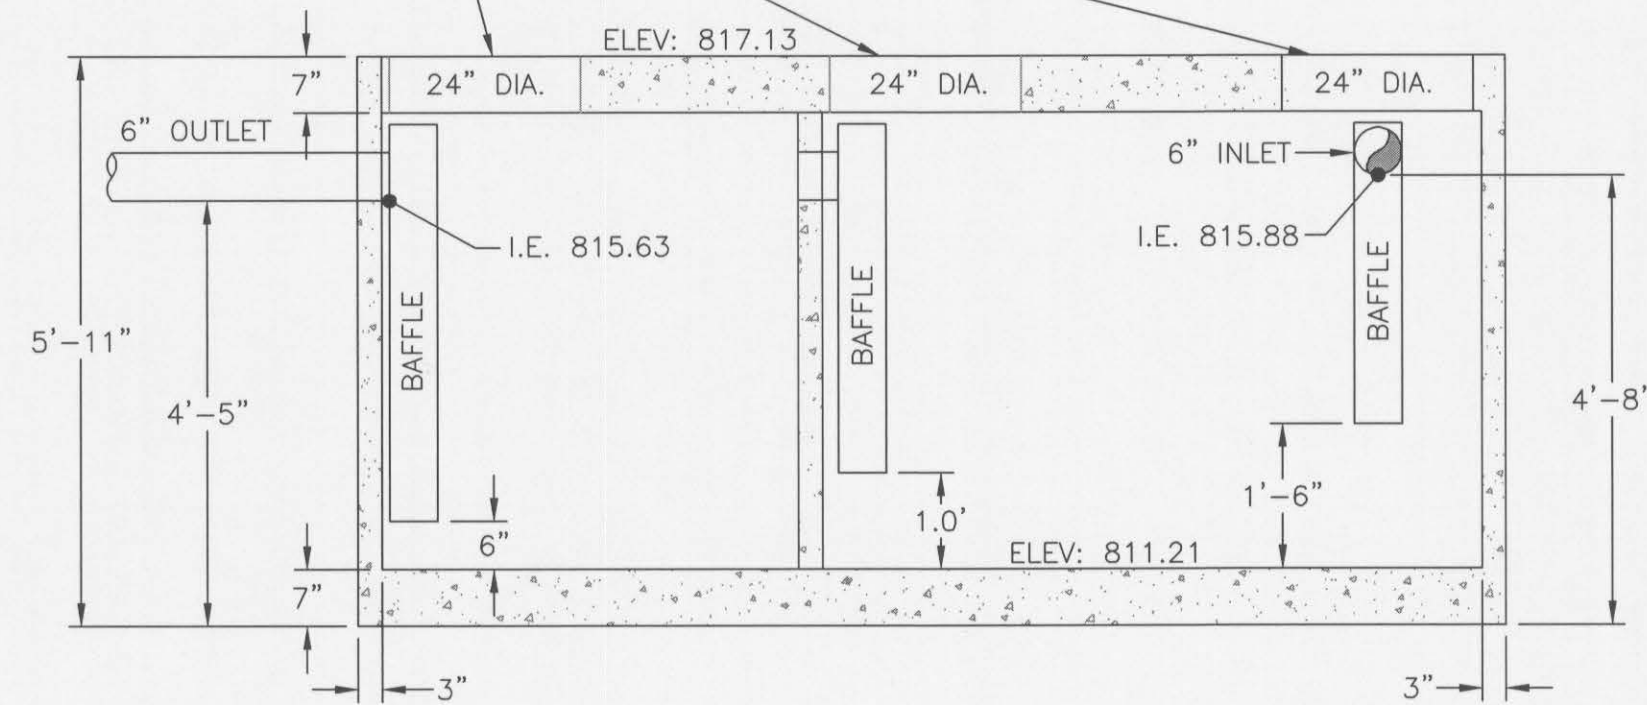

SECTION VIEW


2000 GALLON TRAFFIC RATED OIL/WATER SEPARATOR DETAIL

NOT TO SCALE


1
15

OIL/WATER SEPARATOR NOTES:

- 2-PIECE CONSTRUCTION WITH BUTYL TAPE SEAL
- REINFORCEMENT:
TOP & BOTTOM:
#4 BARS AT 12" O.C. LENGTHWISE
#5 BARS AT 9" O.C. WIDTHWISE
SIDES: 6x6-10/10 WIRE MESH
- 6" PVC. AT INLET/OUTLET AND BAFFLES

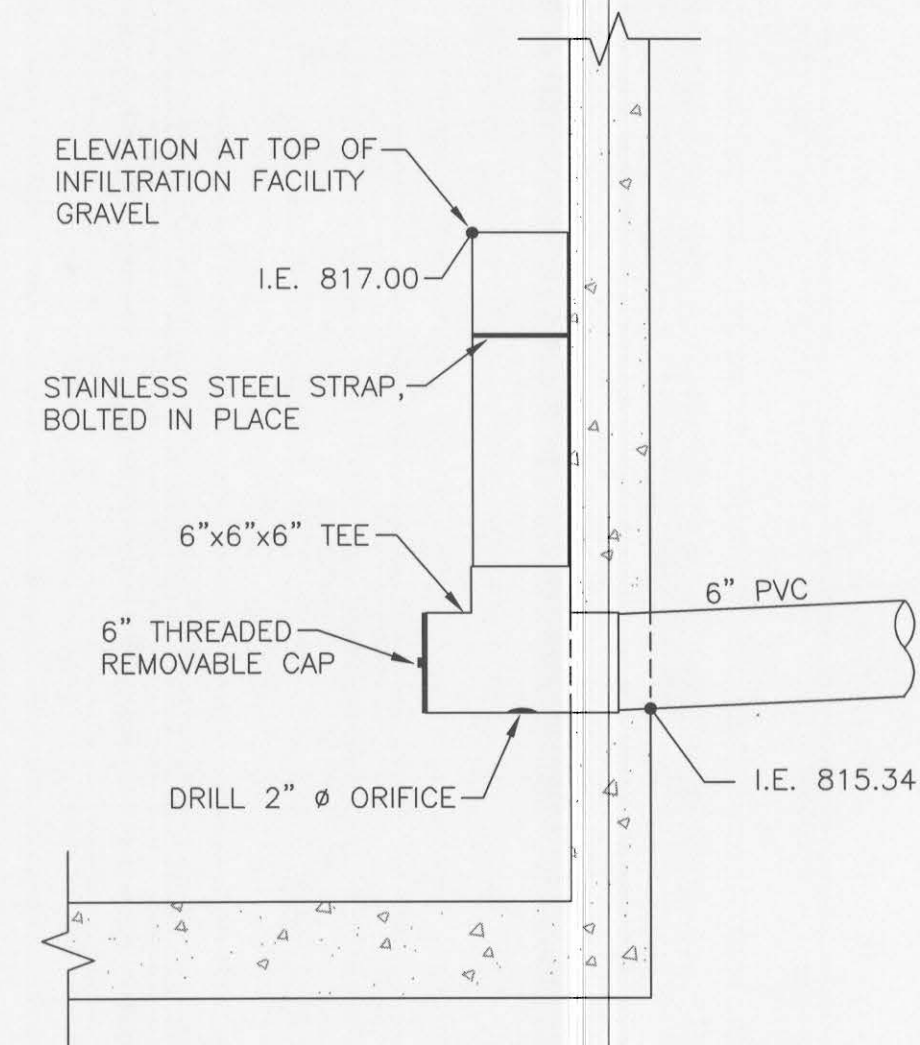

SECTION A-A

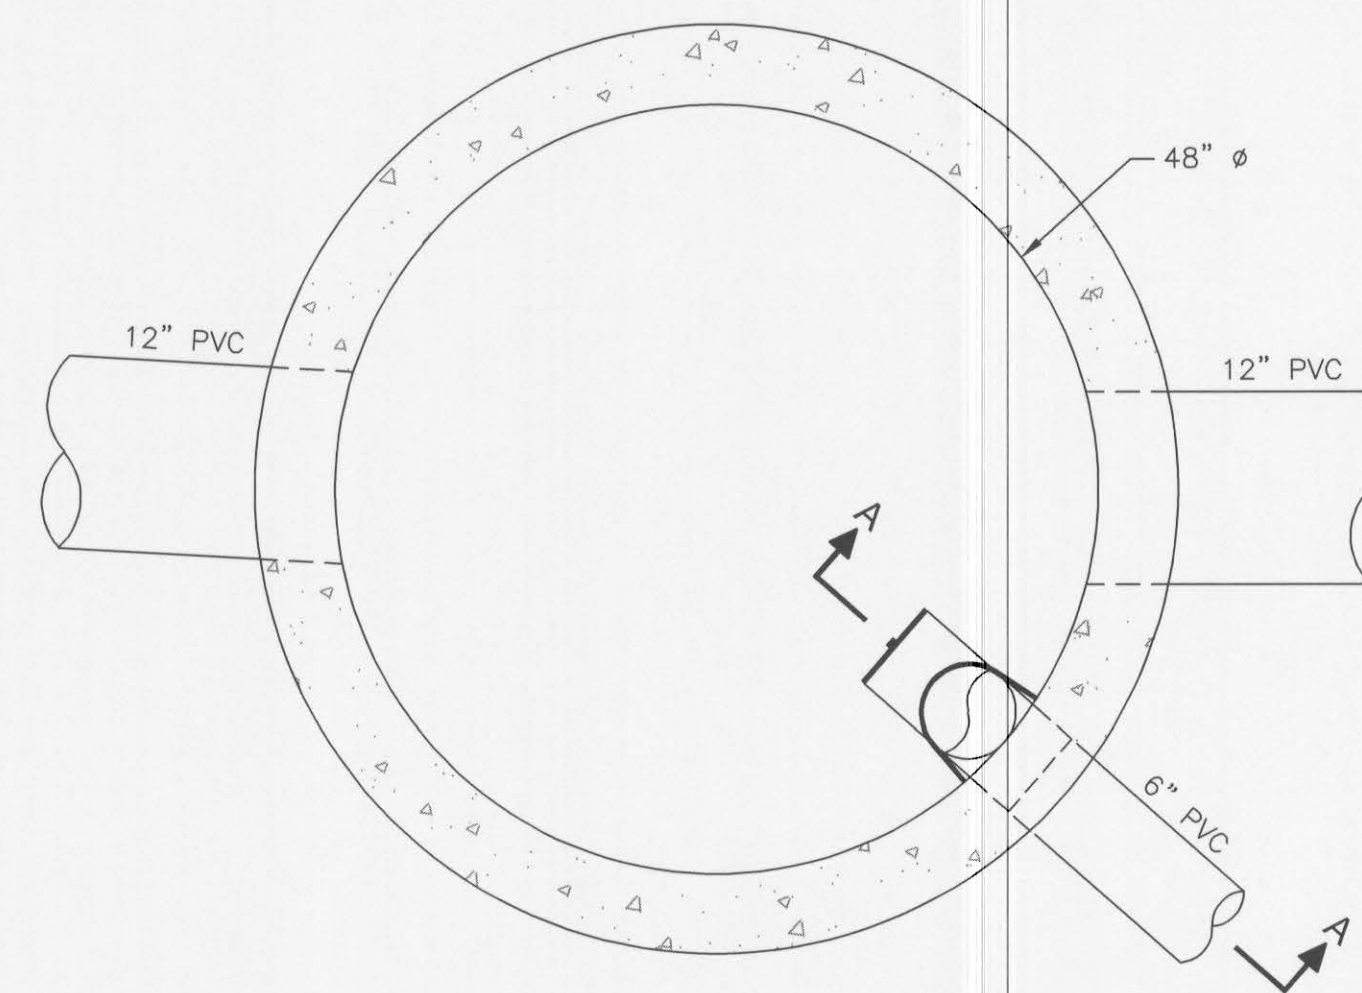

PLAN VIEW

STORM DRAIN MANHOLE WITH ORIFICE WALL

NOT TO SCALE

2
15



REVISIONS
BY TJP/HRF DATE 8.03.07 DESCR PER CITY & DPW REVIEW
BY DATE DESCR
BY DATE DESCR

THOMAS, DEAN & HOSKINS, INC.
ENGINEERING CONSULTANTS
GREAT FALLS-BOZEMAN-KALISPELL
SPOKANE-LEWISTON
MONTANA
WASHINGTON
IDaho



DRAWN BY: TJP
DESIGNED BY: JLN
QUALITY CHECK: JLN
DATE: 2.22.08
JOB NO. L06-020
FIELDBOOK

DPW PROJECT NO. 07150 - LCSC 4TH STREET PARKING
LEWISTON, ID

DETAILS