



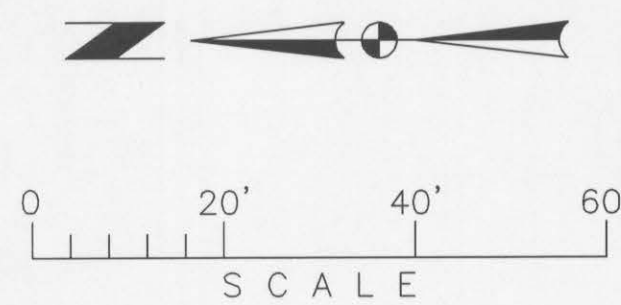


NORTH 4TH STREET EXISTING SITE & DEMOLITION PLAN

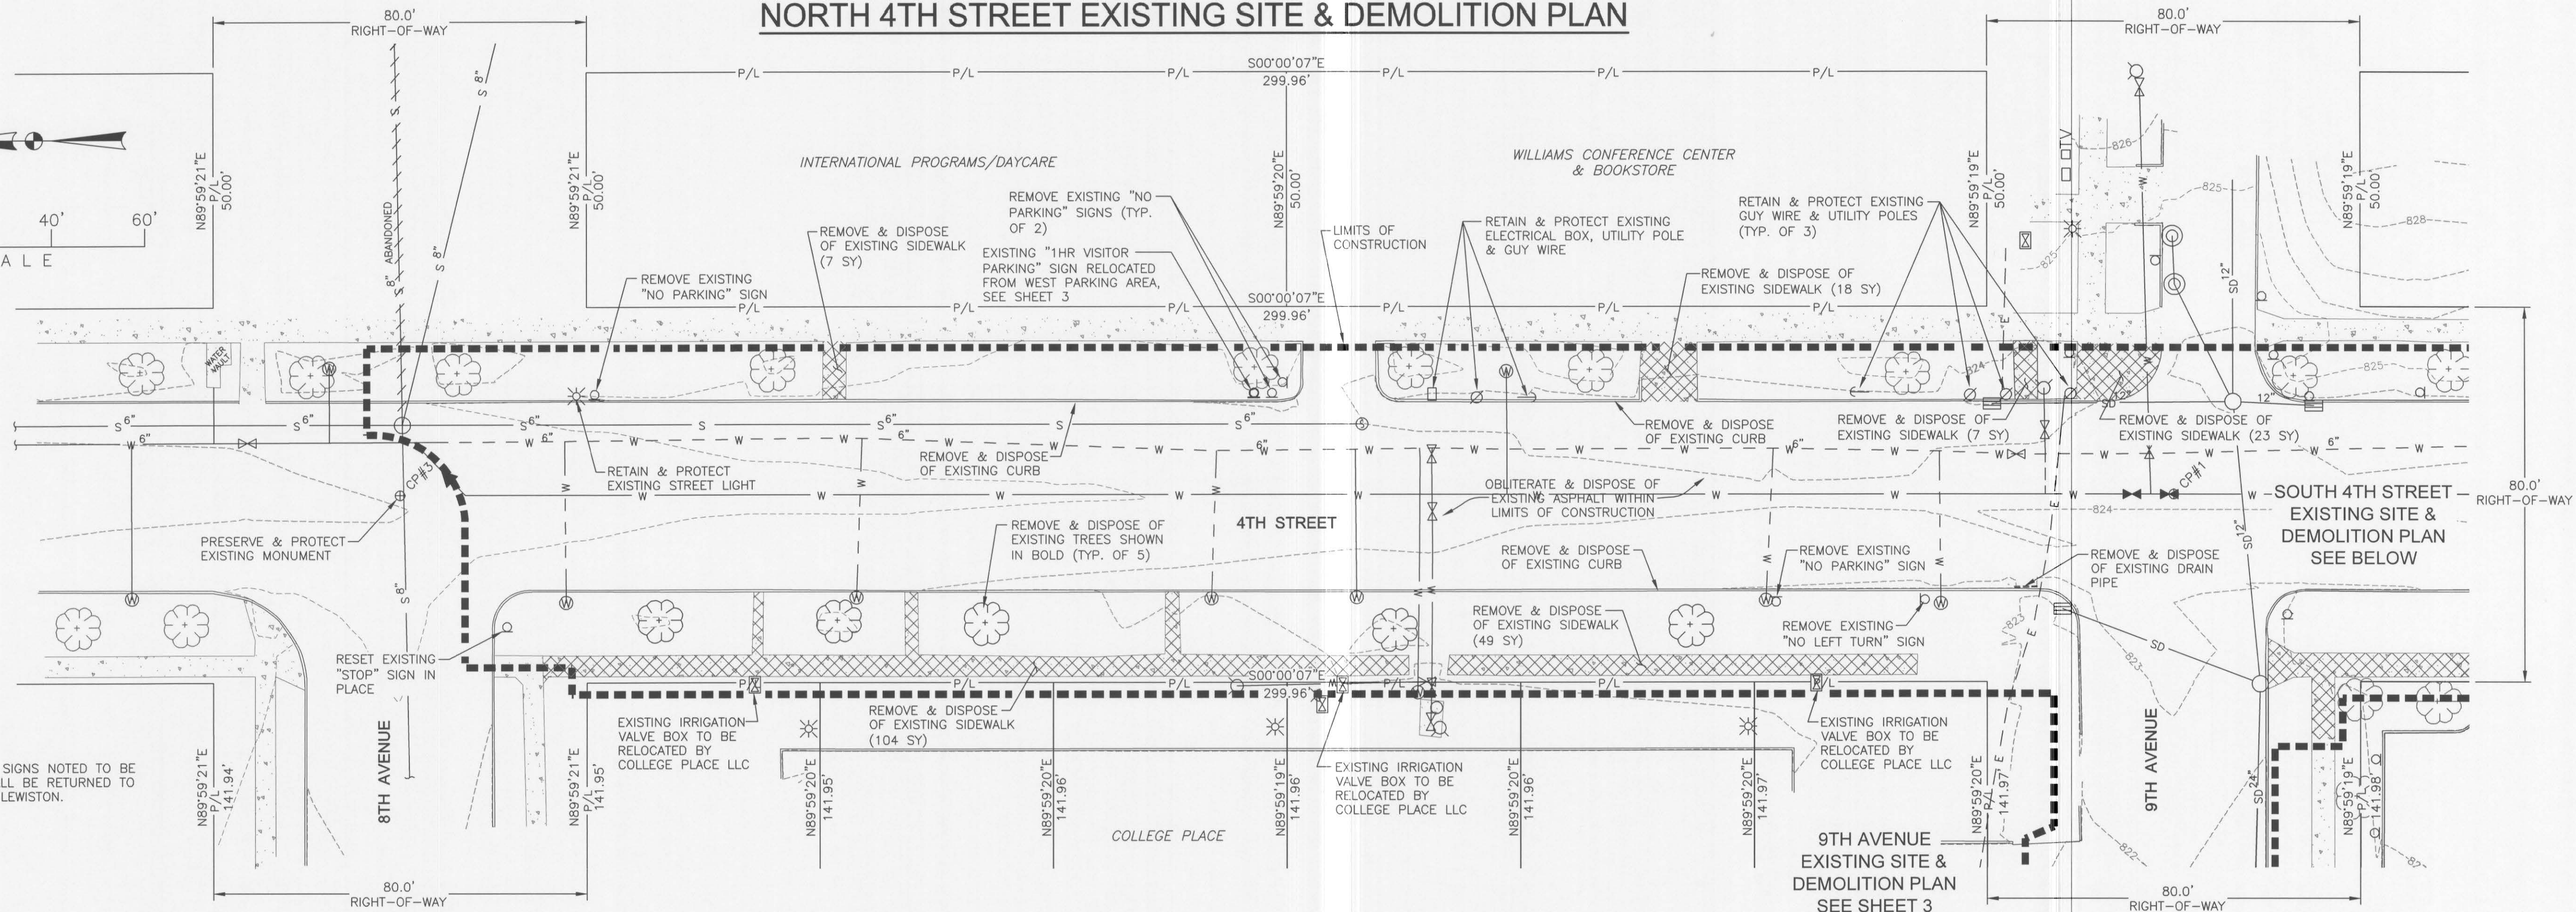


NOTE:
ALL EXISTING SIGNS NOTED TO BE
REMOVED SHALL BE RETURNED TO
THE CITY OF LEWISTON.

SOUTH 4TH STREET EXISTING SITE & DEMOLITION PLAN

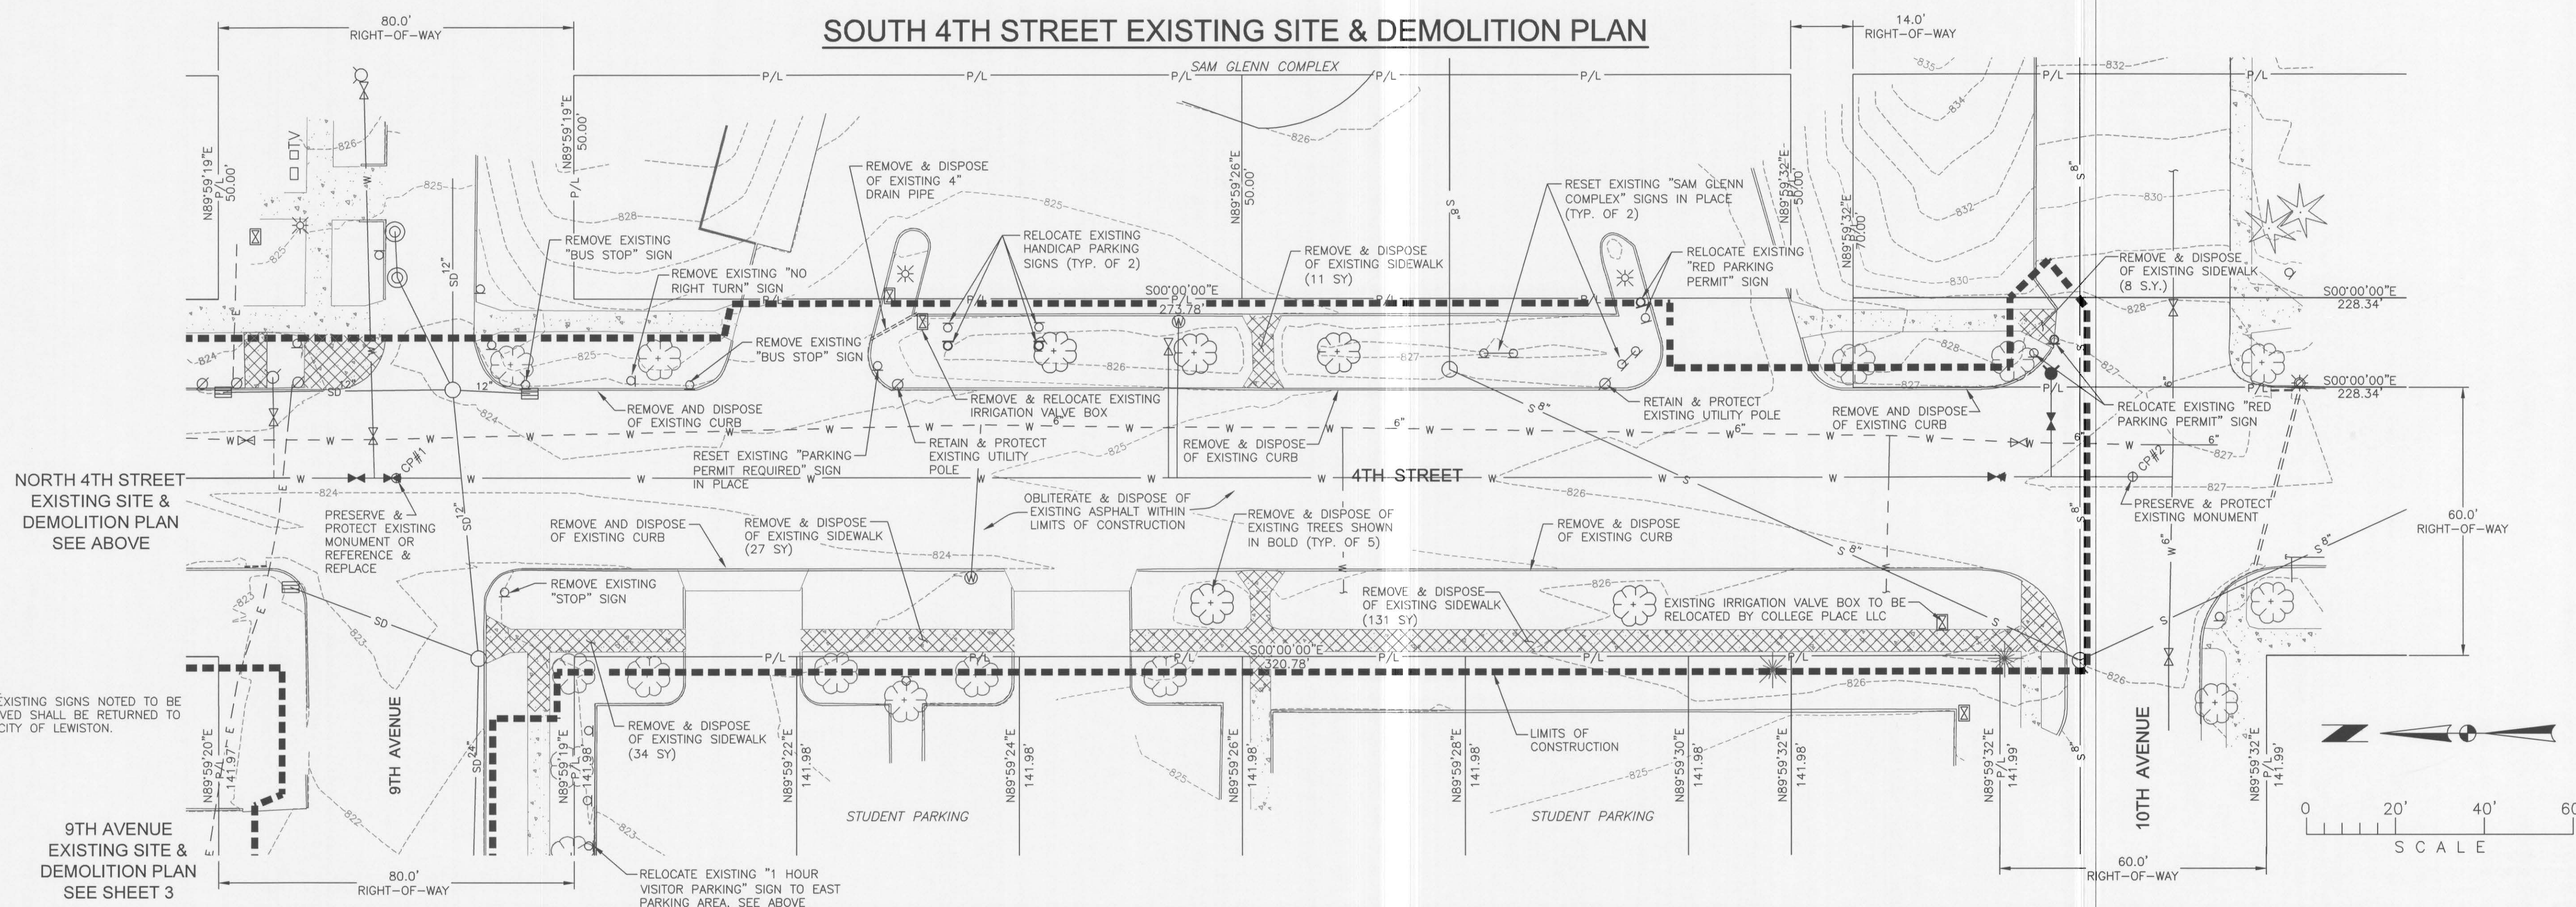

NOTE:
ALL EXISTING SIGNS NOTED TO BE
REMOVED SHALL BE RETURNED TO
THE CITY OF LEWISTON.

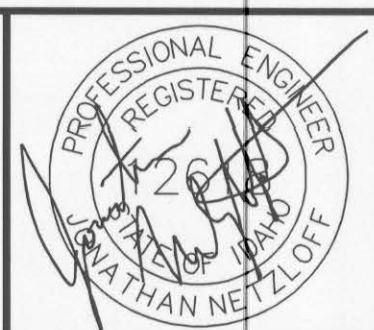

THOMAS, DEAN & HOSKINS, INC.
ENGINEERING CONSULTANTS
GREAT FALLS-BOZEMAN-KALISPELL
SPOKANE-LEWISTON, ID 83501 (208) 746-0938

BY	DATE	REVISIONS
HRF	8.03.07	DESIGN PER CITY & DPW REVIEW
BY	DATE	DESCR
BY	DATE	DESCR

TD&H

DRAWN BY: HRF/TJP
DESIGNED BY: JLN
QUALITY CHECK: 2.22.08
DATE: L06-020
JOB NO.
FIELDBOOK

DPW PROJECT NO. 07150 - LCSC 4TH STREET PARKING
LEWISTON, IDAHO

4TH STREET

EXISTING SITE & DEMOLITION PLAN