



SOUTH 4TH STREET  
CUT & FILL VOLUMES  
CUT: 875 CY  
FILL: 19 CY  
NET: 856 CY CUT

NOTE:  
ELEVATIONS AT CURB LOCATIONS  
ARE TO FLOWLINE OF CURB.



SOUTH 4TH STREET  
GRADING & STORM  
DRAINAGE PLAN  
SEE SHEET 6

9TH AVENUE  
GRADING & STORM  
DRAINAGE PLAN  
SEE SHEET 8


PROFILE SCALE  
HORIZONTAL 1" = 20'  
VERTICAL 1" = 2'

NOTE:  
PROFILE SCALE IS FOR FULL  
SIZE PLANS ONLY. PLEASE  
ACCOUNT FOR WHEN USING  
HALF SIZE PLANS.

## SOUTH 4TH STREET GRADING & STORM DRAINAGE PLAN

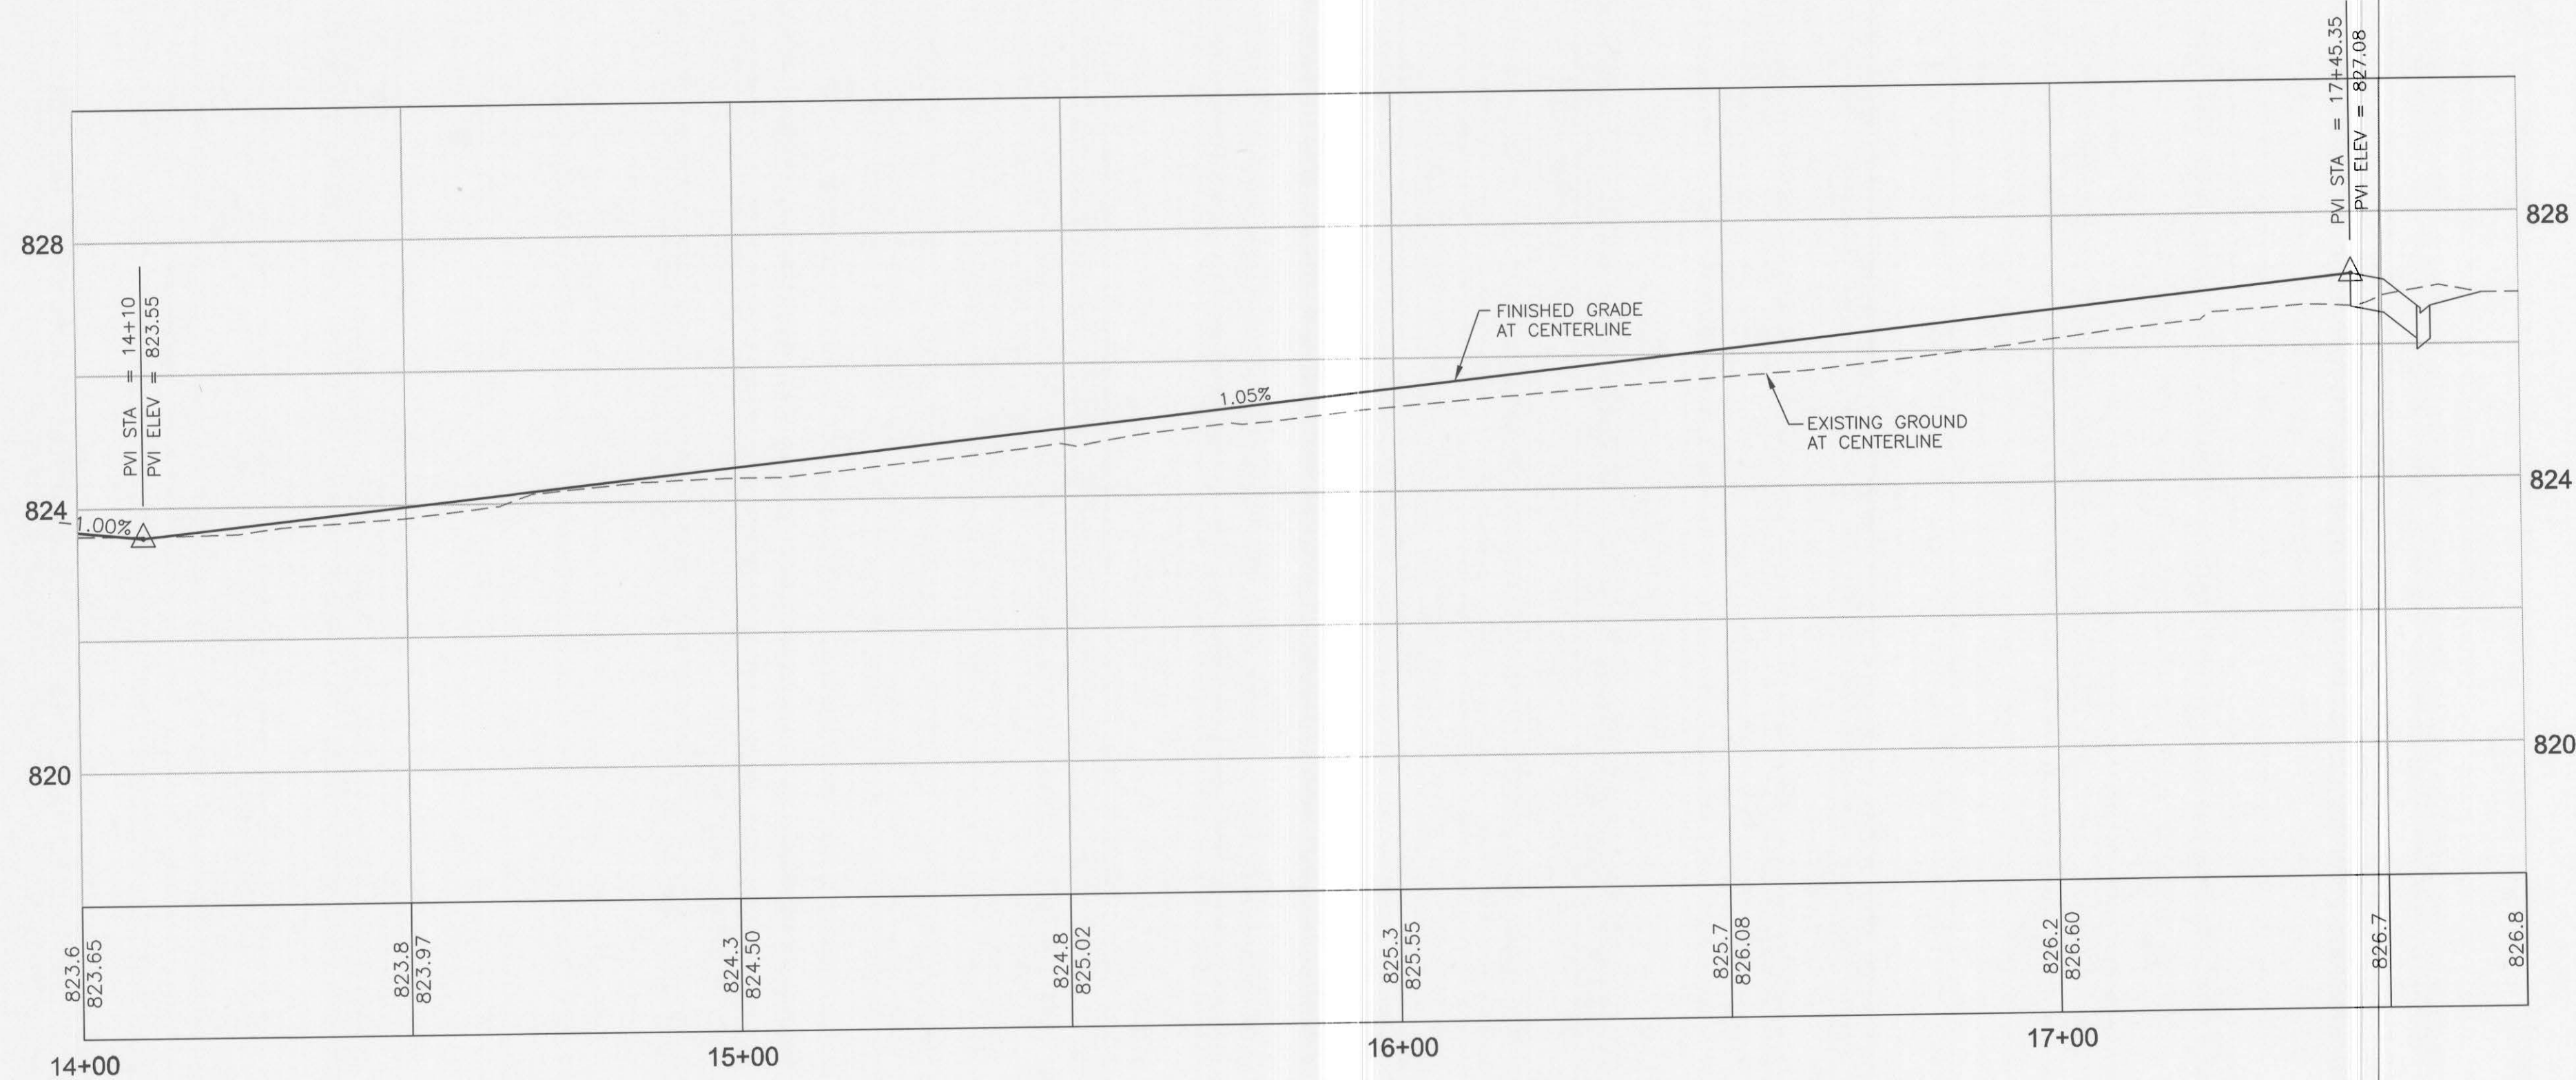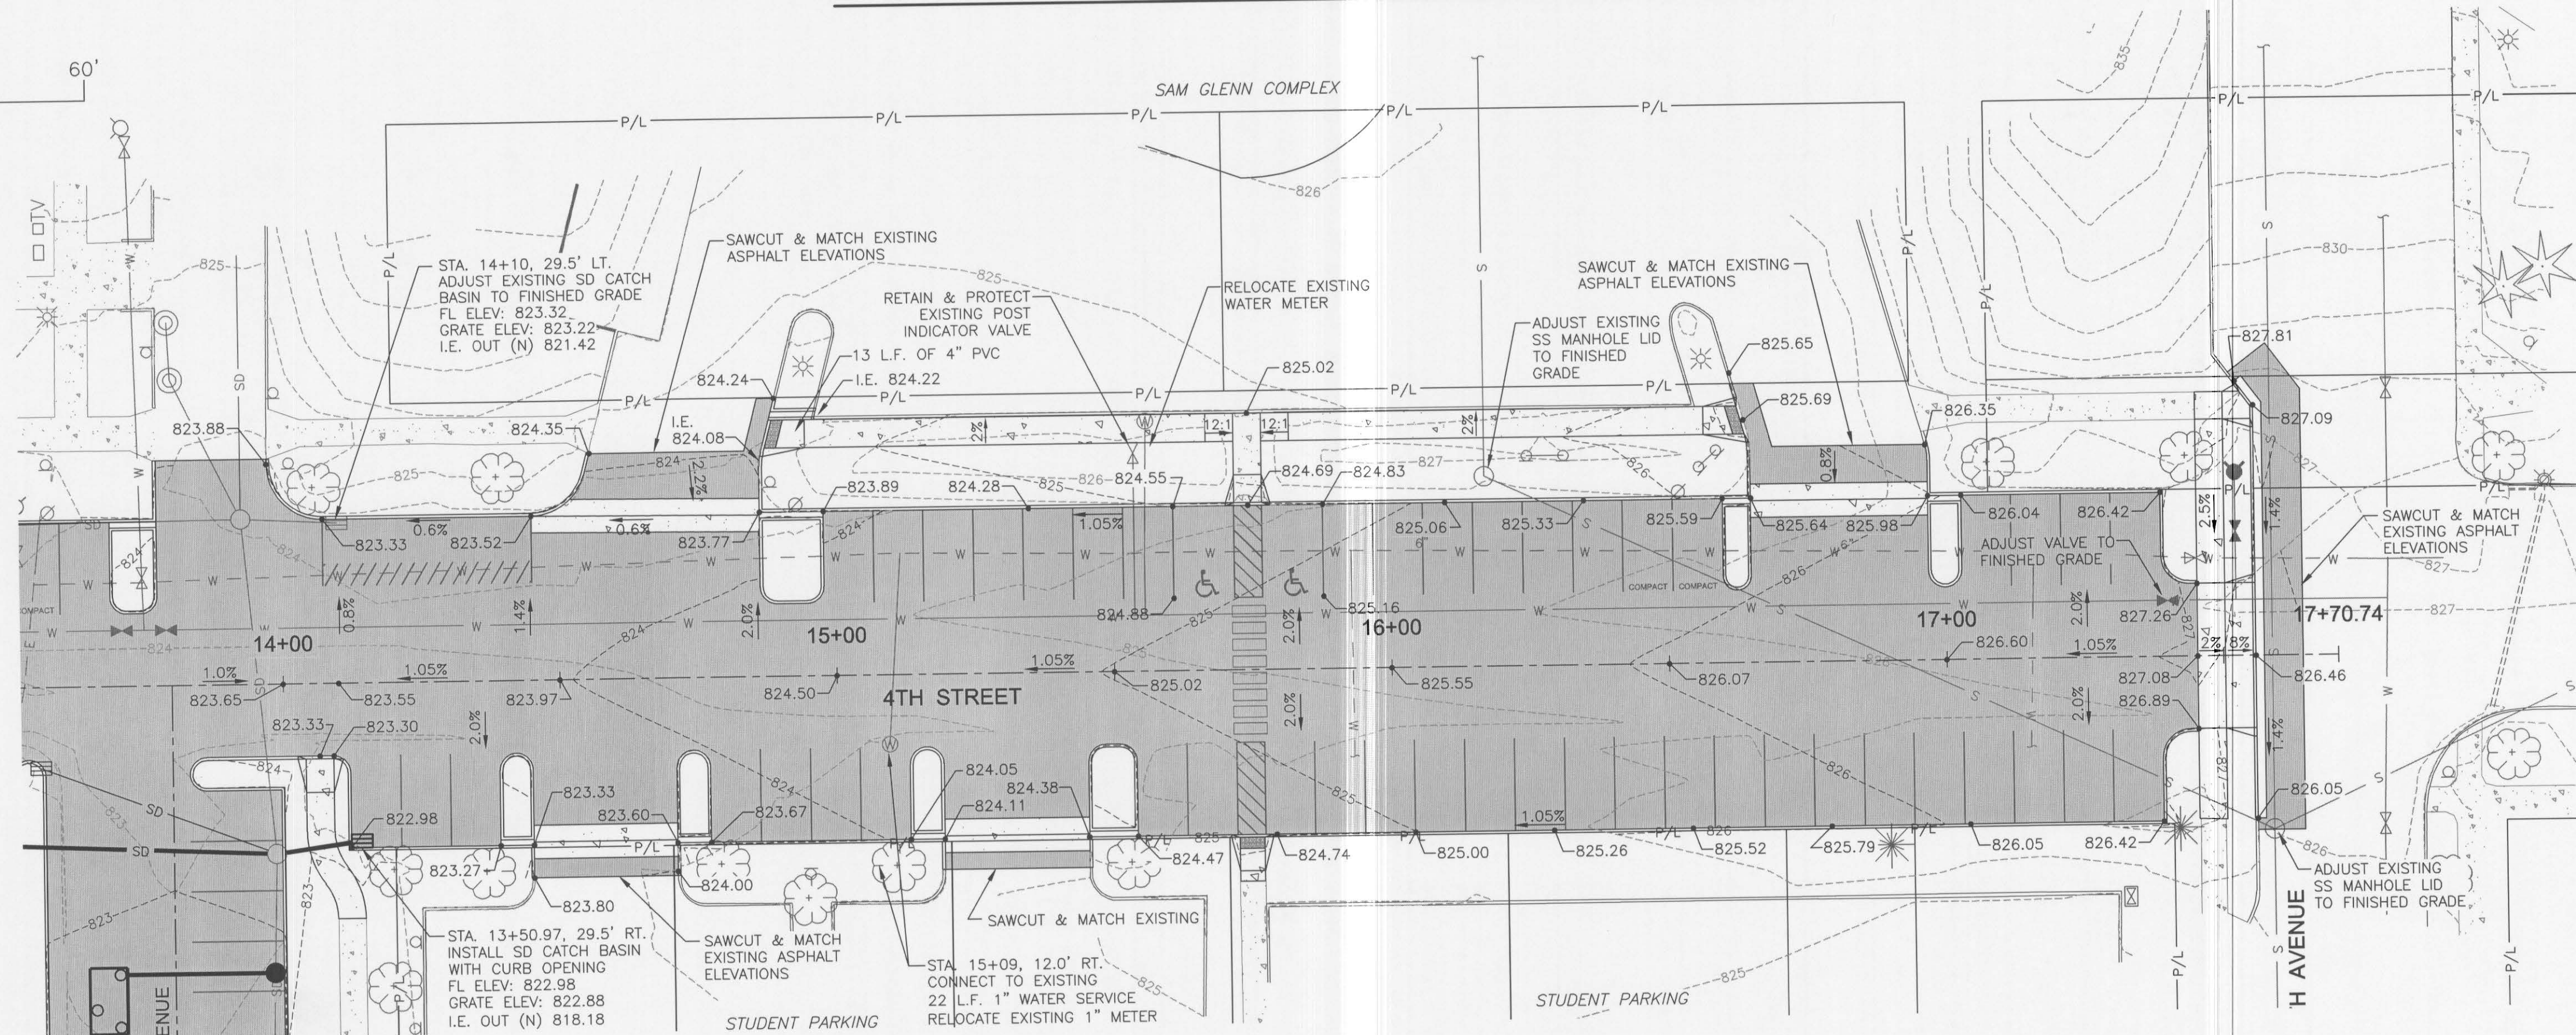

## SOUTH 4TH STREET CENTERLINE PROFILE

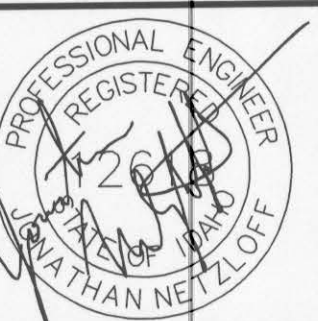

| BY | HRF | DATE | DESCR    | PER   | CITY | &         | DPW   | REVIEW |
|----|-----|------|----------|-------|------|-----------|-------|--------|
| BY | JLN | DATE | 12-19-07 | DESCR | ADD  | WATERLINE | NOTES |        |
| BY |     | DATE |          | DESCR |      |           |       |        |

**THOMAS, DEAN & HOSKINS, INC.**  
ENGINEERING CONSULTANTS  
GREAT FALLS - BOZEMAN - KALISPELL  
SPOKANE - LEWISTON - IDAHO  
2517 17TH STREET, SUITE B  
LEWISTON, ID 83501 (208) 746-0938

|                |         |
|----------------|---------|
| DRAWN BY:      | HRF/TJP |
| DESIGNED BY:   | JLN     |
| QUALITY CHECK: |         |
| DATE:          | 2.22.08 |
| JOB NO.        | L06-020 |
| FIELDBOOK      |         |

DPW PROJECT NO. 07150 - LCSC 4TH STREET PARKING  
LEWISTON, IDAHO

4TH STREET SOUTH  
GRADING & UTILITY PLAN