


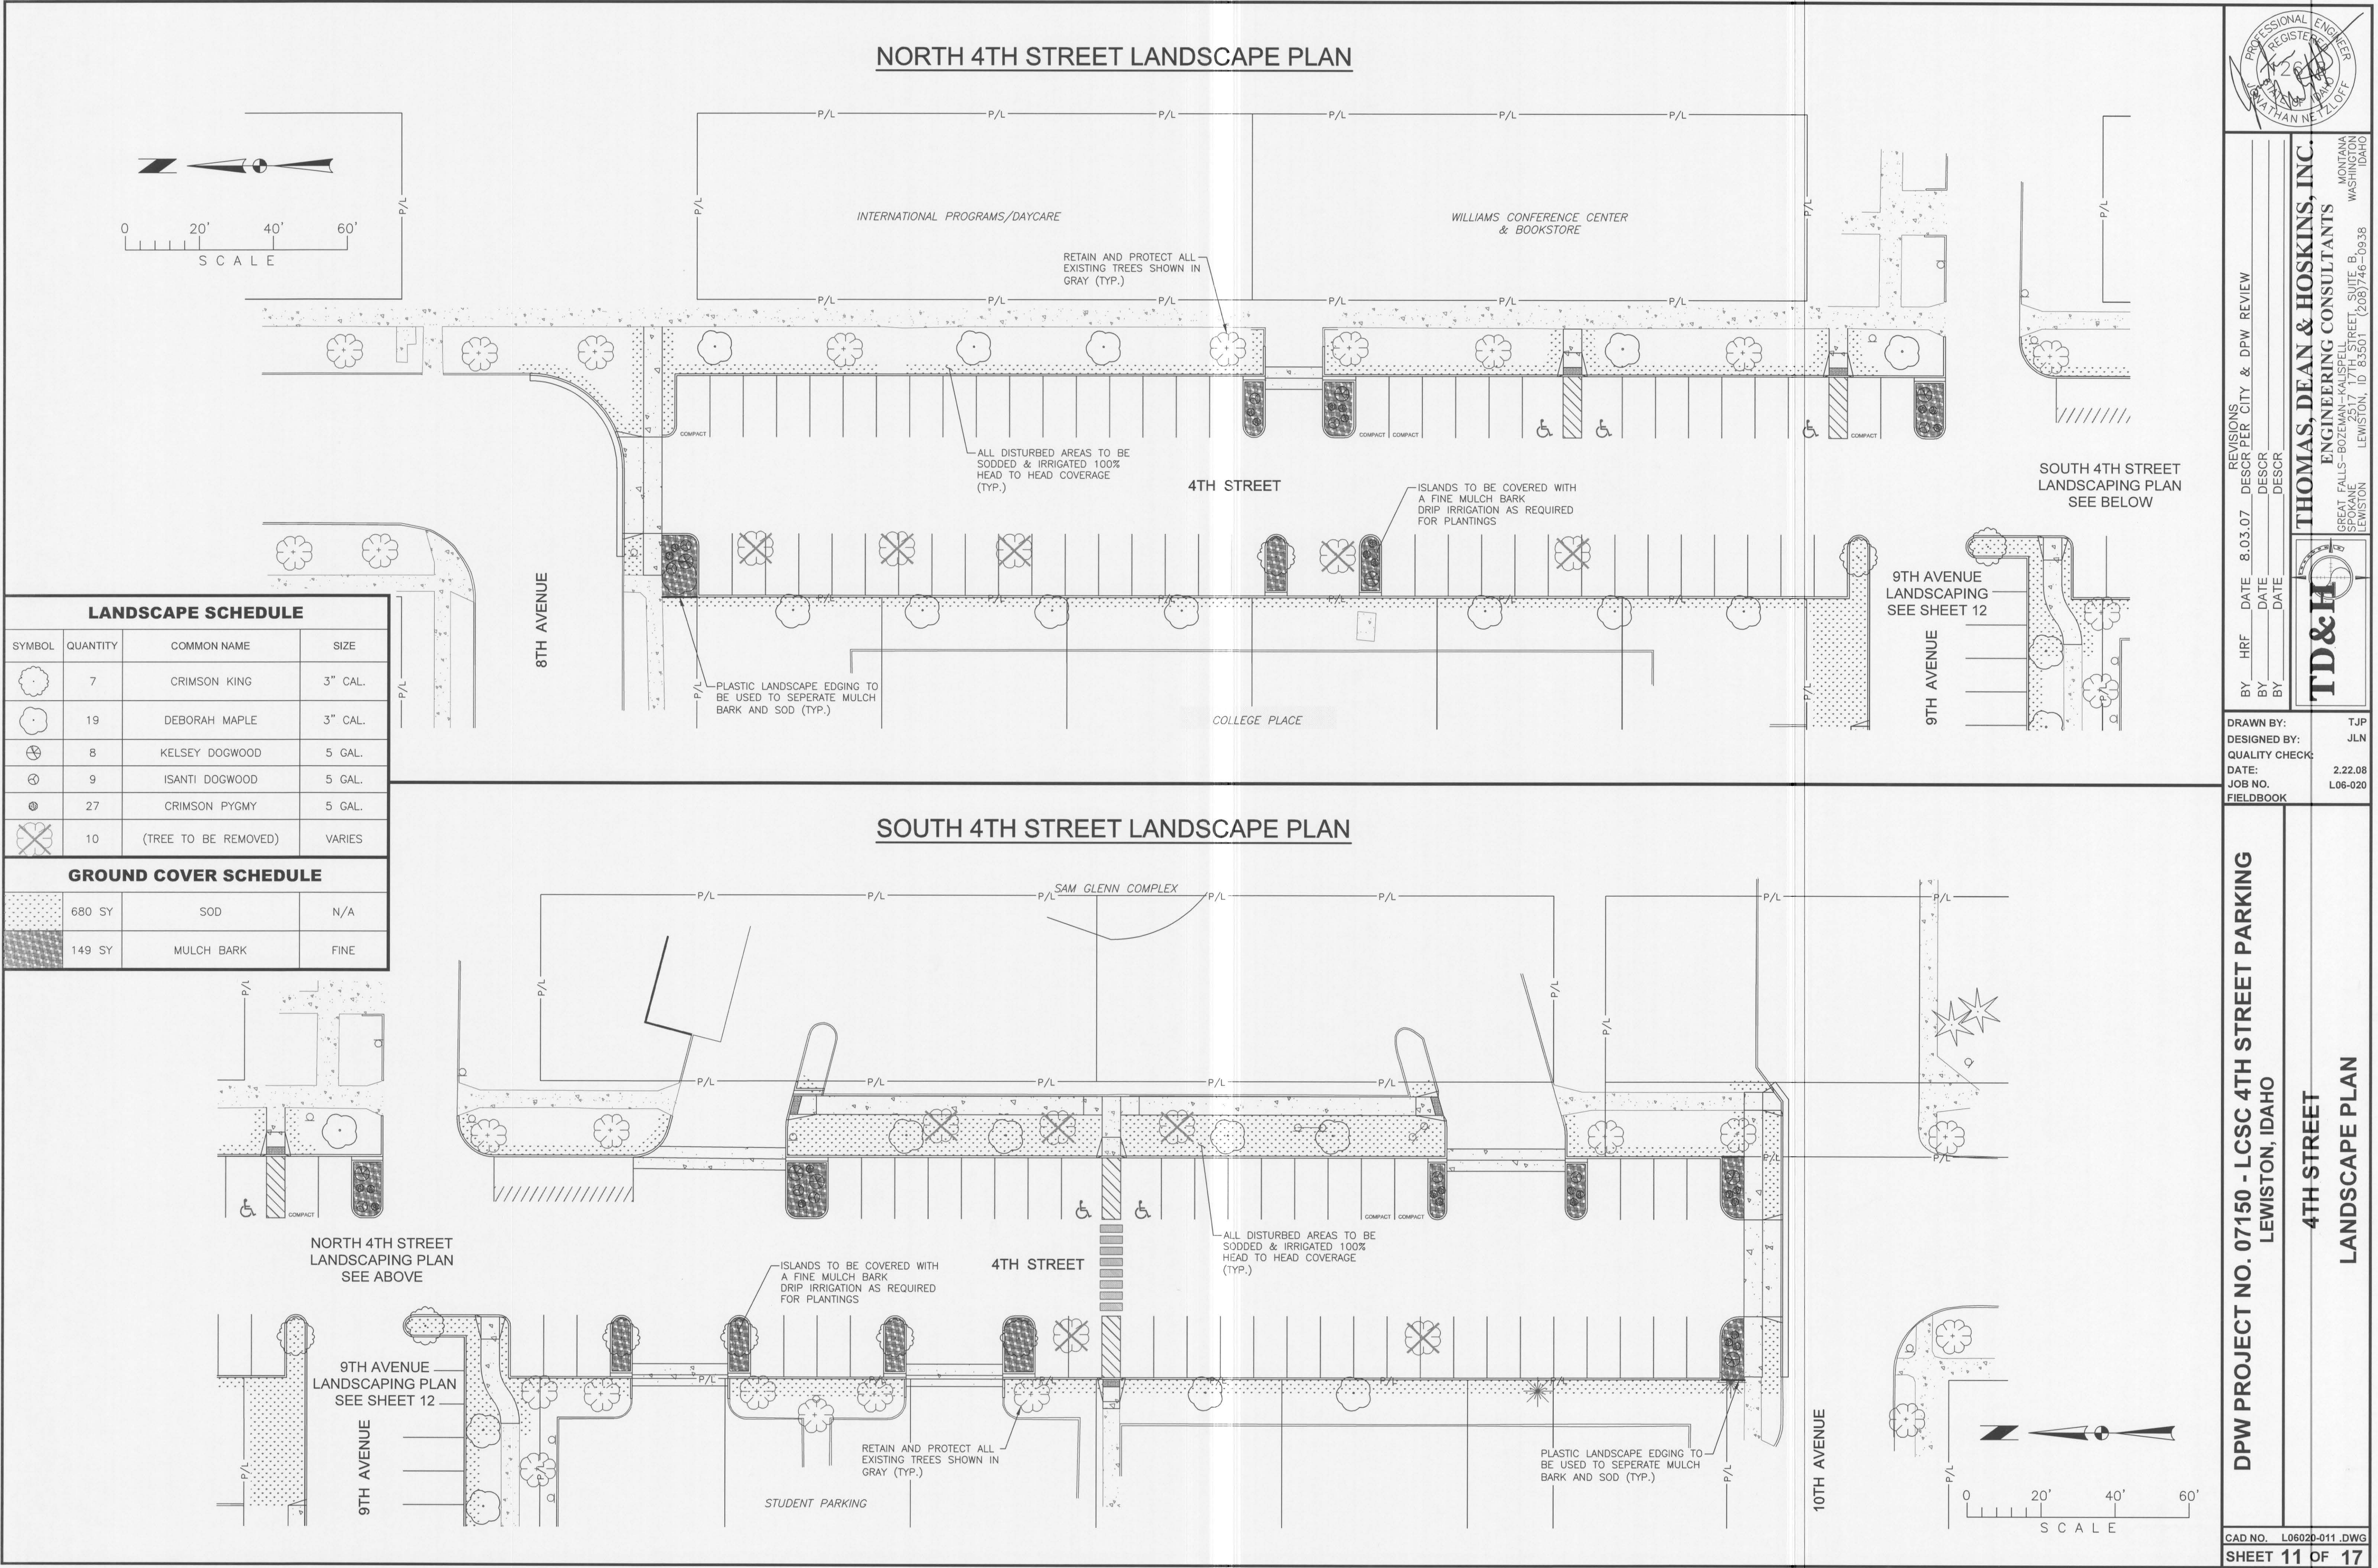

LANDSCAPE SCHEDULE			
SYMBOL	QUANTITY	COMMON NAME	SIZE
	7	CRIMSON KING	3" CAL.
	19	DEBORAH MAPLE	3" CAL.
	8	KELSEY DOGWOOD	5 GAL.
	9	ISANTI DOGWOOD	5 GAL.
	27	CRIMSON PYGMY	5 GAL.
	10	(TREE TO BE REMOVED)	VARIES

GROUND COVER SCHEDULE			
	680 SY	SOD	N/A
	149 SY	MULCH BARK	FINE

PROFESSIONAL ENGINEER
REGISTERED
NATHAN NETZLOFF

REVISIONS
BY HRF DATE 8.03.07 DESCR PER CITY & DPW REVIEW
BY DATE DESCR
BY DATE DESCR

THOMAS, DEAN & HOSKINS, INC.
ENGINEERING CONSULTANTS
GREAT FALLS-BOZEMAN-KALISPELL
SEWASTON, ID 83501 (208)746-9938

TD&H

DRAWN BY: TJP
DESIGNED BY: JLN
QUALITY CHECK:
DATE: 2.22.08
JOB NO. L06-020
FIELDBOOK

DPW PROJECT NO. 07150 - LCSC 4TH STREET PARKING
LEWISTON, IDAHO

4TH STREET
LANDSCAPE PLAN

CAD NO. L06020-011.DWG
SHEET 11 OF 17