


LEWIS - CLARK STATE COLLEGE STORMWATER SYSTEM IMPROVEMENTS 2005


LEWISTON, IDAHO

DPW 04-150

08-12-05

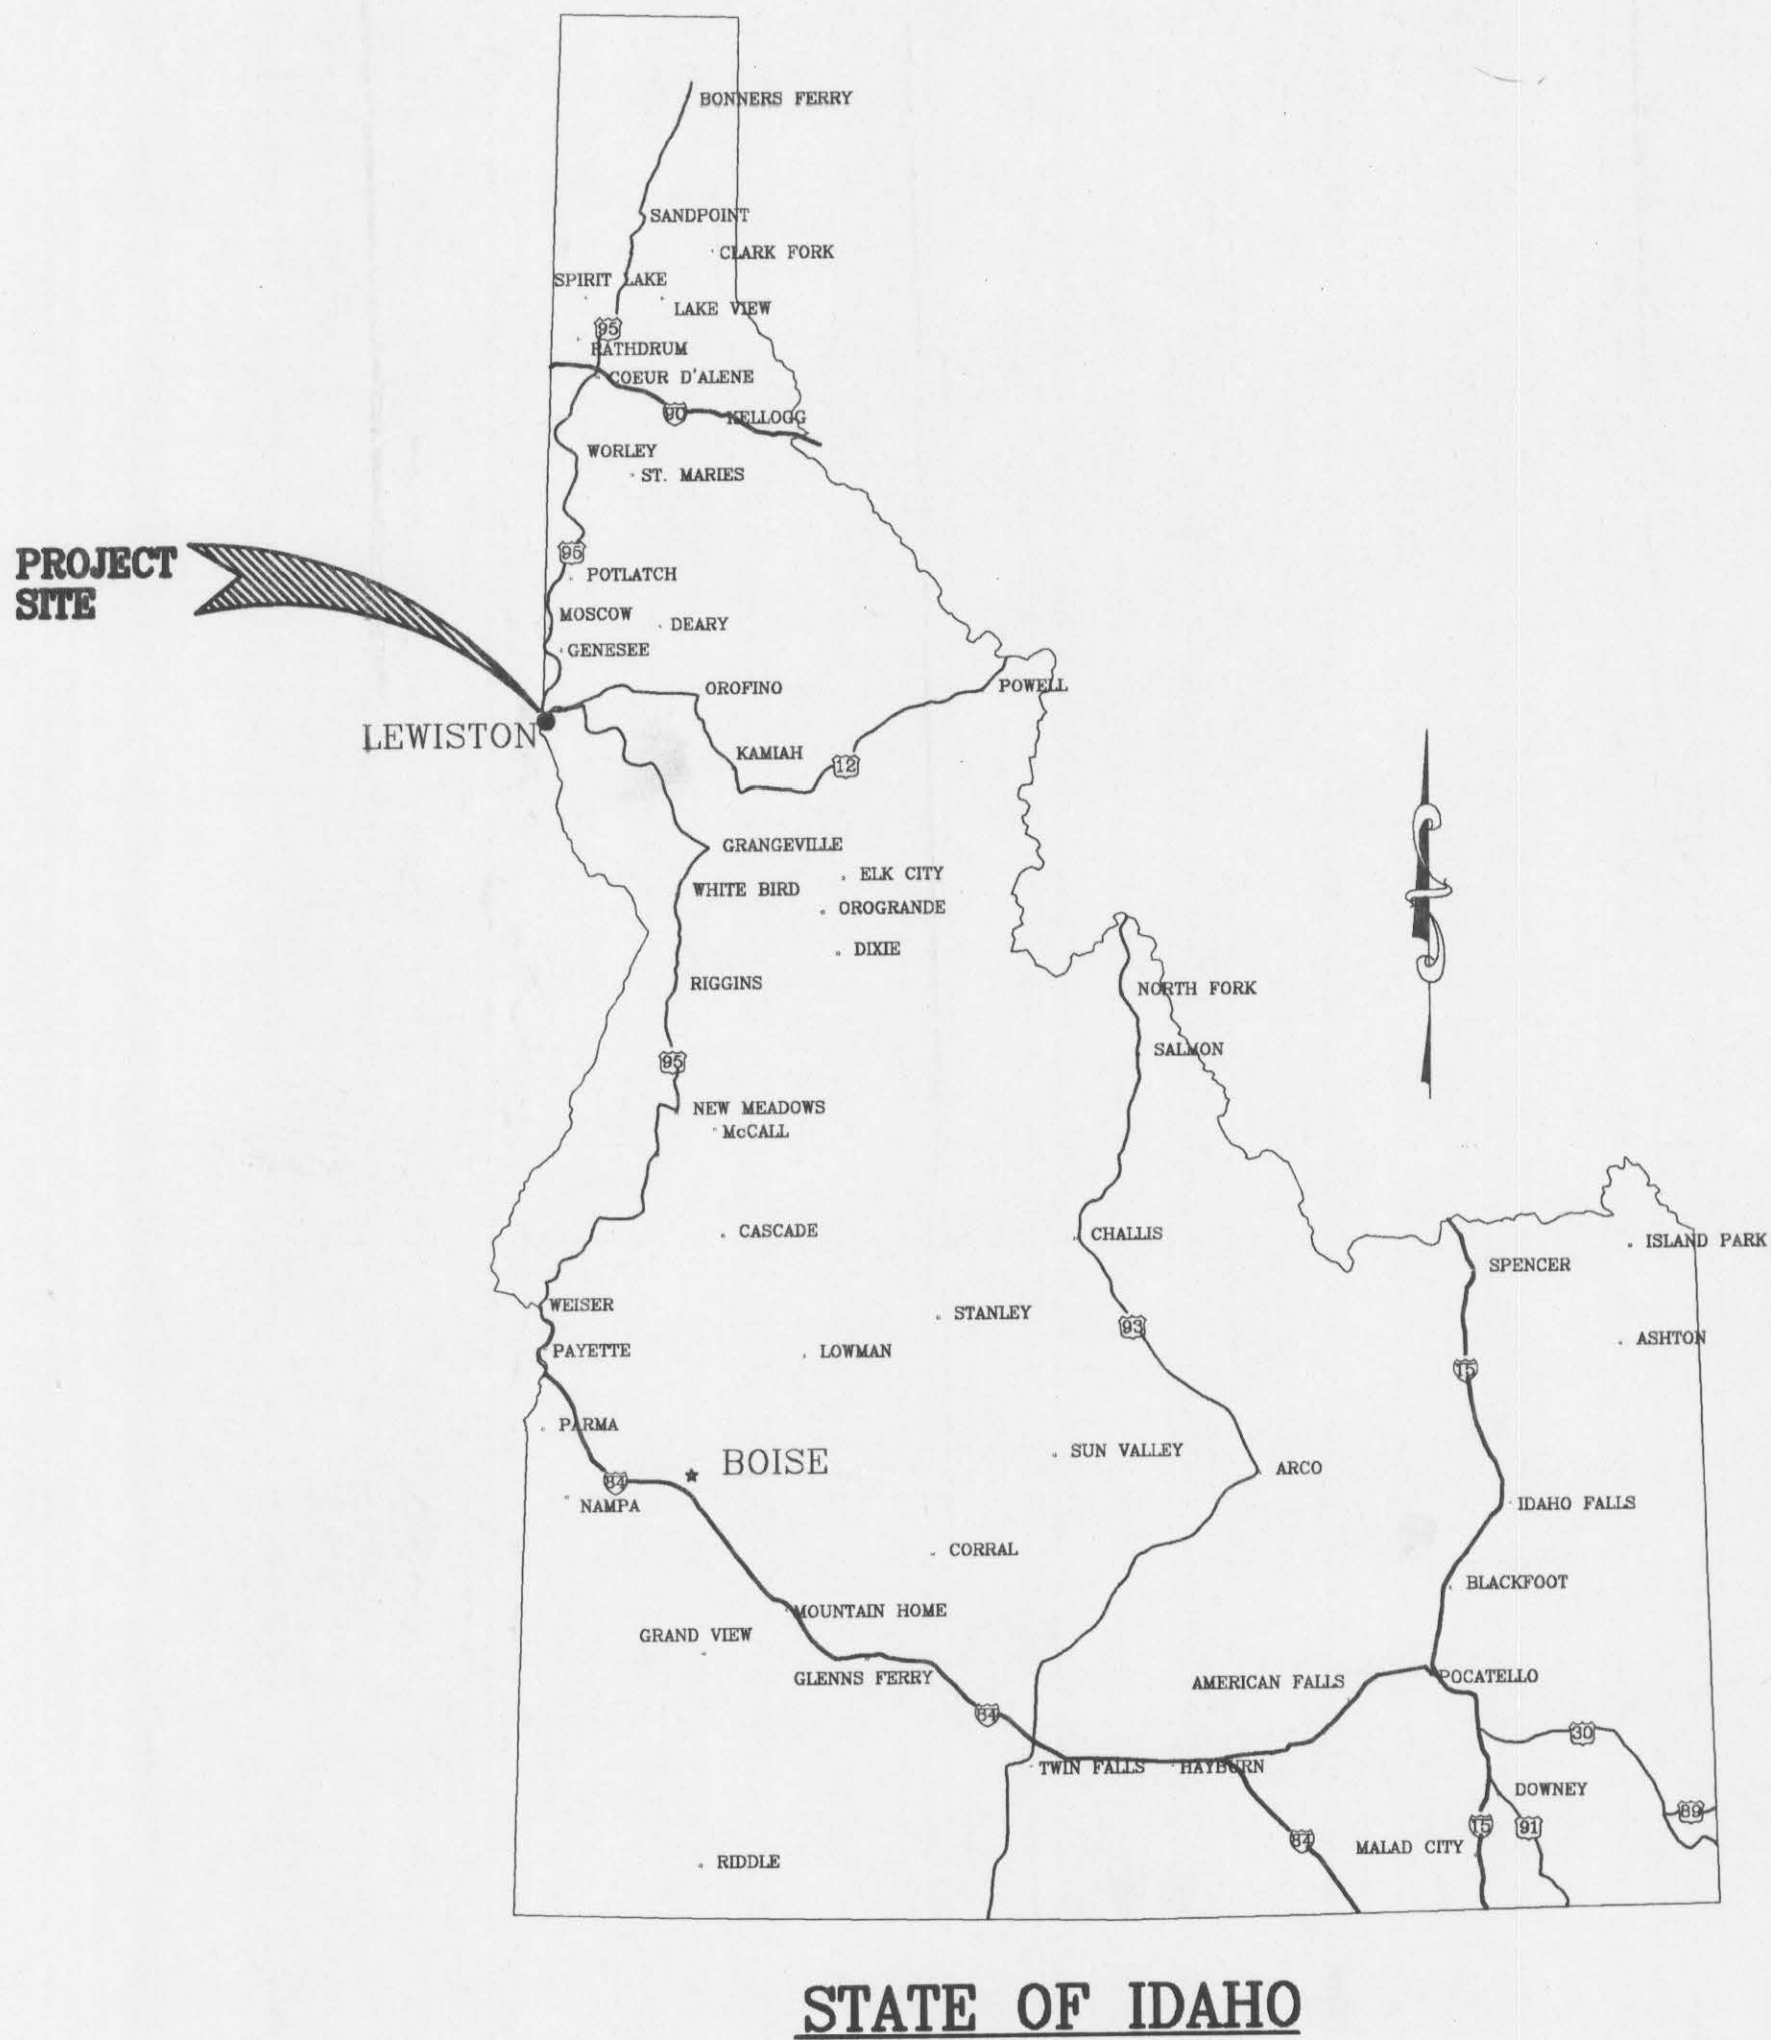

STATE OF IDAHO

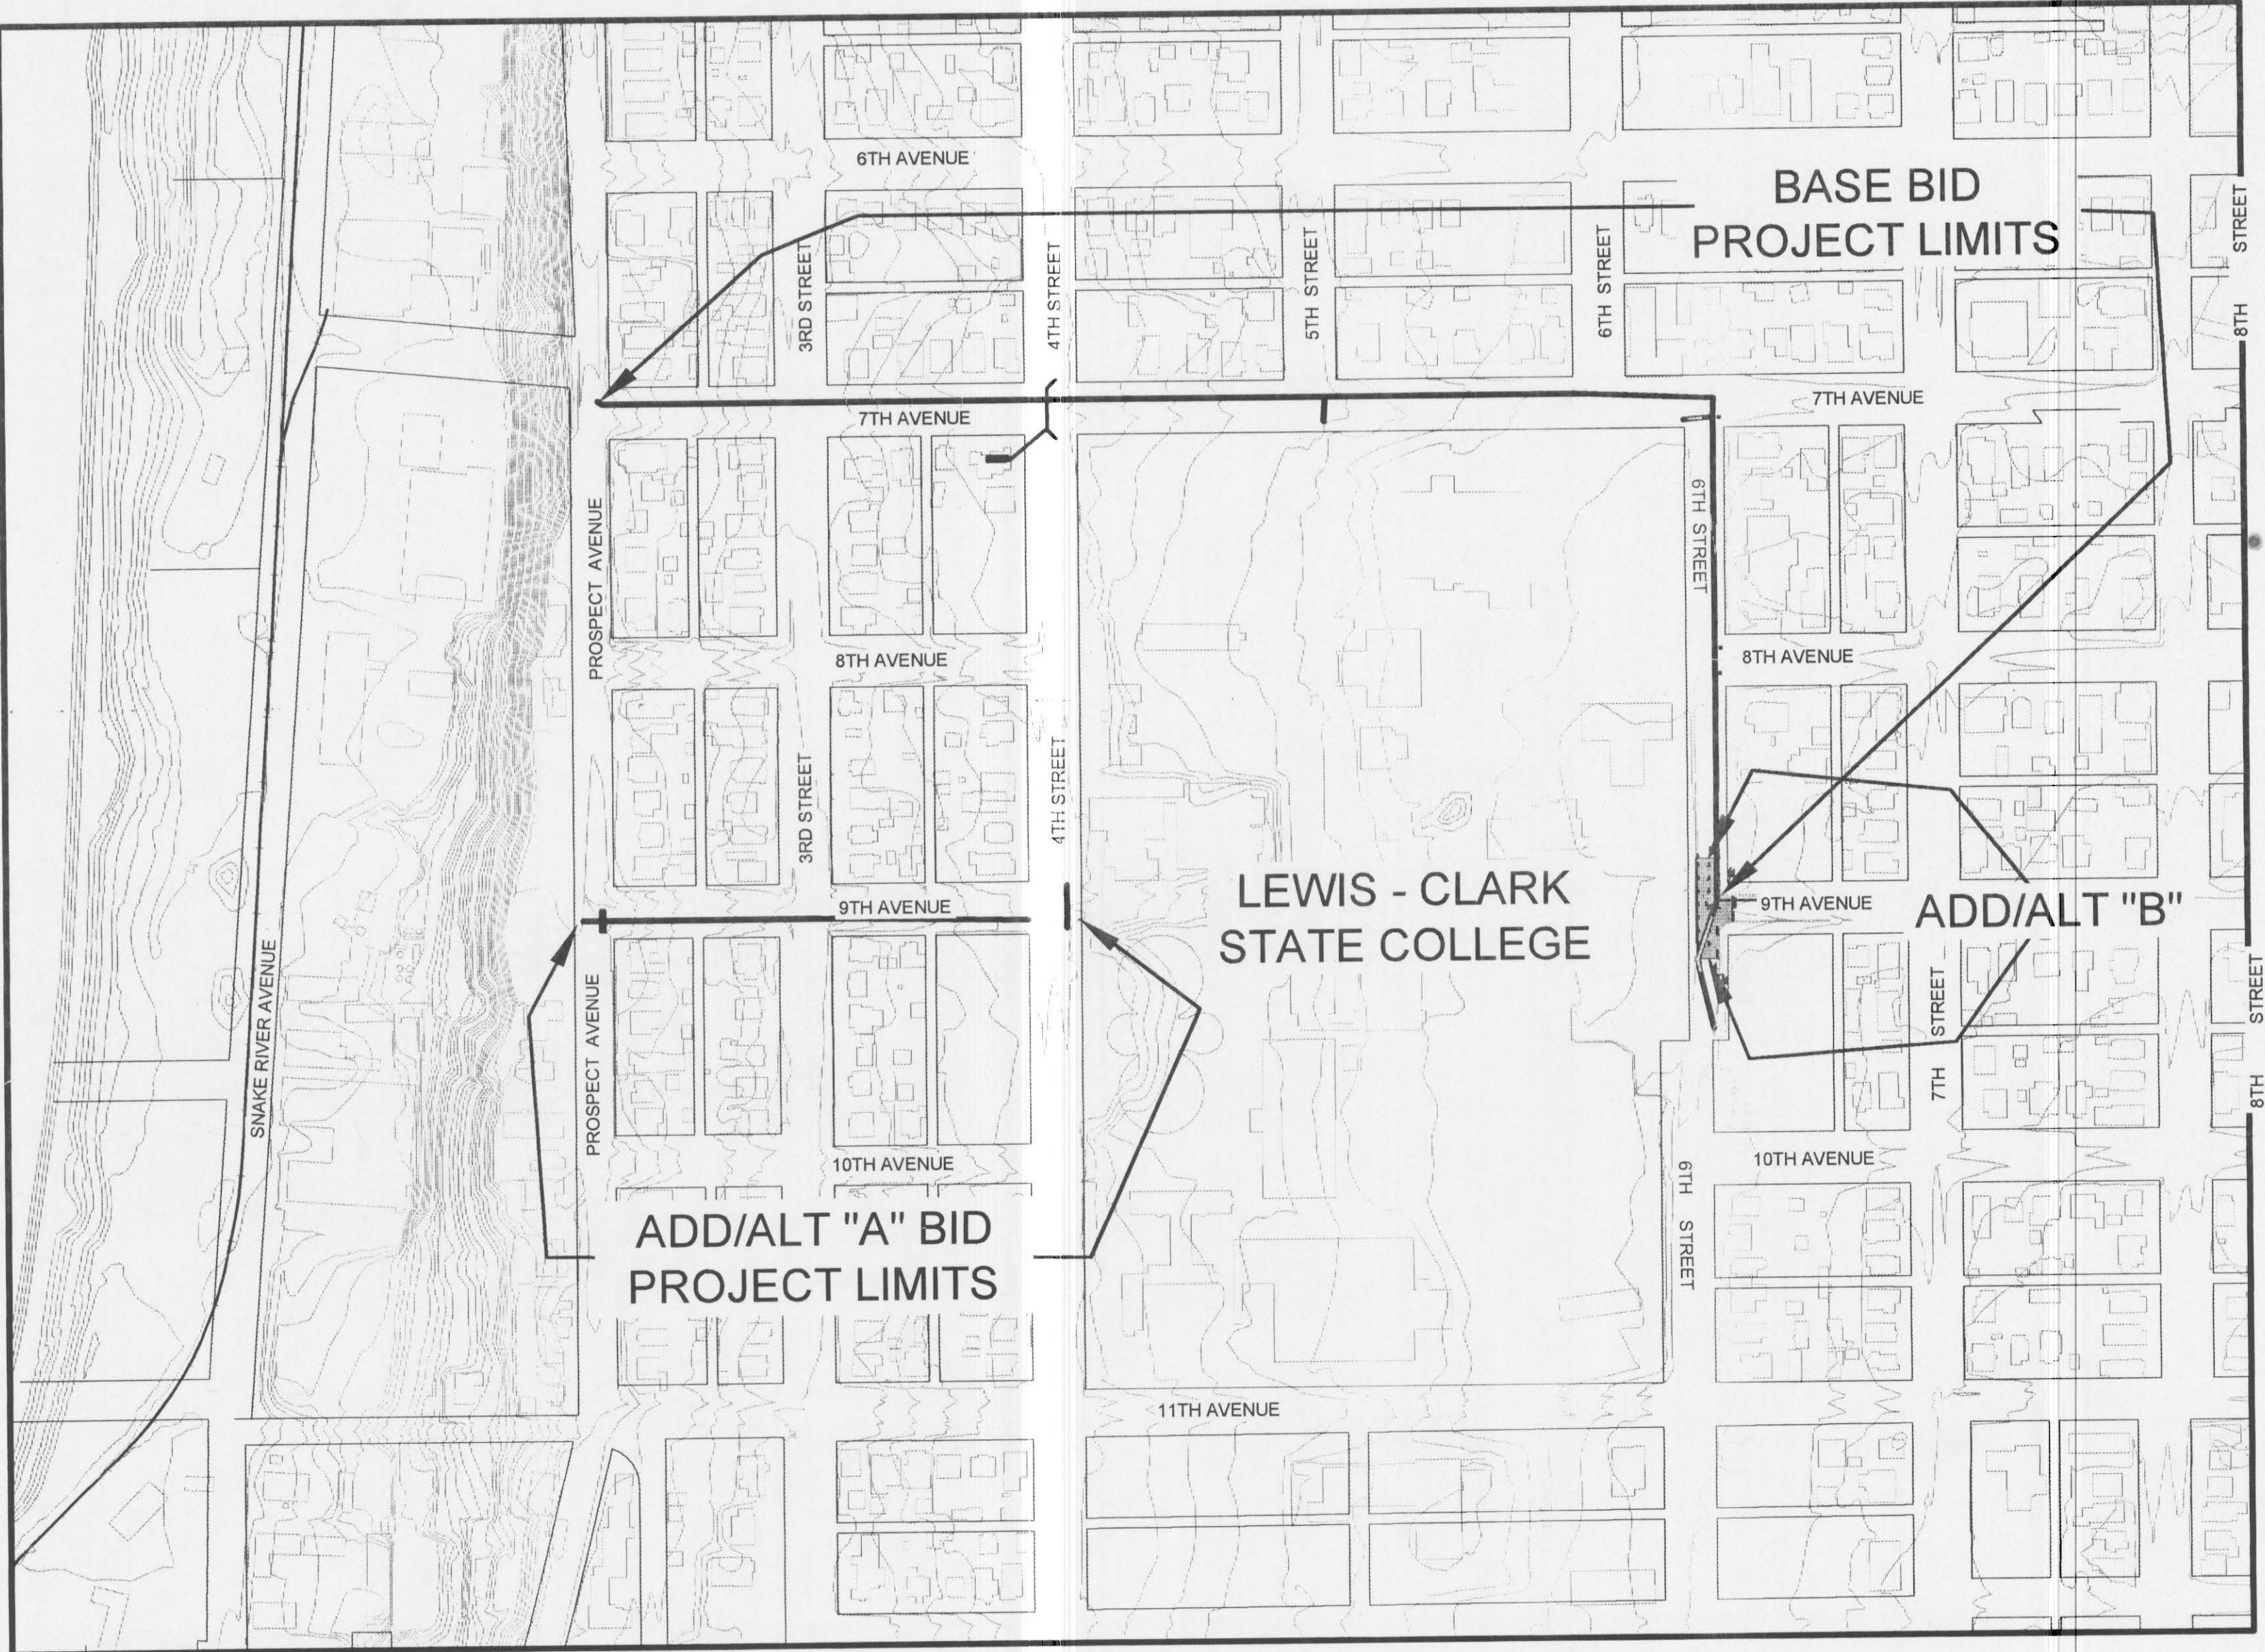

VICINITY MAP

TABLE OF CONTENTS

SHEET #	DESCRIPTION
C 1.0	COVER SHEET
C 1.1	PLAN AND PROFILE 7TH AVENUE
C 1.2	PLAN AND PROFILE 7TH AVENUE
C 1.3	PLAN AND PROFILE 6TH STREET
C 1.4	PLAN AND PROFILE 9TH AVENUE (ADD ALT. "A")
C 1.5	ADD ALT. "B"
C 1.6	CONSTRUCTION DETAILS
C 1.7	CONSTRUCTION DETAILS



CONTRACTOR SHALL CALL (800) 342-1585 & HAVE ALL UNDERGROUND UTILITIES LOCATED AT LEAST TWO WORKING DAYS PRIOR TO THE START OF ANY CONSTRUCTION.

NOTE:
THE LOCATION OF UNDERGROUND UTILITIES AND STRUCTURES SHOWN HEREON ARE BASED ON OBSERVED EVIDENCE AND INFORMATION FROM A VARIETY OF SOURCES. THEY SHOULD BE CONSIDERED APPROXIMATE AND POSSIBLY INCOMPLETE. OTHER UTILITIES AND STRUCTURES MAY EXIST.

CONSTRUCTION NOTES

THIS PROJECT SHALL BE CONSTRUCTED PER THE LATEST EDITION OF THE IDAHO STANDARD FOR PUBLIC WORKS CONSTRUCTION (ISPC) AS AMENDED AND SUPPLEMENTED BY THE PROJECT TECHNICAL SPECIFICATIONS AND THESE DRAWINGS.

WORK SHALL CONFORM TO STATE AND LOCAL CODES.

THE CONTRACTOR SHALL TAKE NECESSARY PREVENTATIVE MEASURES TO PROTECT EXISTING IMPROVEMENTS. ANY DAMAGE SHALL BE REPLACED BY THE CONTRACTOR AT NO ADDITIONAL COST TO THE OWNER.

THIS SITE IS CROSSED BY UNDERGROUND UTILITIES. THE ENGINEER DOES NOT GUARANTEE EITHER THE ACCURACY OR THE COMPLETENESS OF THE SHOWN UTILITIES. THE CONTRACTOR SHALL CALL FOR UTILITY LOCATES PRIOR TO EXCAVATION.

THE CONTRACTOR SHALL PROVIDE STORM WATER MANAGEMENT DURING CONSTRUCTION, PREVENTING THE MOBILIZATION OF SEDIMENTS BY WATER RUNOFF.

PUBLIC LAND CORNERS FOR WHICH ADEQUATE EVIDENCE EXISTS IS SHOWN ON THIS PLAN. THE CONTRACTOR SHALL RETAIN AND PROTECT THE CORNERS. IF CORNERS INTERFERE WITH THE PROGRESS OF THIS PROJECT, THE CONTRACTOR SHALL HAVE THE CORNERS REFERENCED BY OR UNDER THE DIRECTION OF A PROFESSIONAL LAND SURVEYOR PRIOR TO THE TIME WHEN ACTIVITIES MAY DISTURB THEM. SUCH CORNERS SHALL BE REESTABLISHED AND REMONUMENTED UNDER THE SUPERVISION OF A PROFESSIONAL LAND SURVEYOR.

THE CONTRACTOR SHALL COORDINATE THE WORK SCHEDULE SO AS TO HAVE A MINIMUM IMPACT TO EXISTING TRAFFIC. A TRAFFIC CONTROL PLAN IS INCLUDED WITH THIS DRAWING SET. THE CITY WILL REVIEW AND APPROVE THE TRAFFIC CONTROL PLAN BEFORE THE CONTRACTOR WILL BE ALLOWED TO WORK WITHIN THE RIGHT-OF-WAY.

APPROVAL STICKERS

SPECIFIED MATERIALS AND CONSTRUCTION PROCESSES

TYPE "A-1" COMPACTION IS SPECIFIED

CLASS 3,000 CONCRETE IS SPECIFIED


CLASS II PLANT MIX IS SPECIFIED, THE CONTRACTOR IS ALLOWED TO USE A SINGLE STOCKPILE FOR AGGREGATE. USE 1/2" NOMINAL MAXIMUM SIZE AGGREGATE

STORM DRAIN PIPE SHALL BE EITHER SOLID WALL PIPE (ASTM F-899) OR CORRUGATED POLYETHYLENE PIPE (AASHTO M-294 AND AASHTO M-297-97), TYPE S

RECORD DRAWINGS

THESE RECORD DRAWINGS WERE PREPARED FROM DATA AND MARKED UP DRAWINGS FURNISHED BY THE CONTRACTOR AND OTHER SOURCES, INCLUDING THE REPORT FURNISHED, AND REPRESENT THE CONSTRUCTED WORKS TO OUR BEST INFORMATION AND BELIEF.

EXISTING	PROPOSED

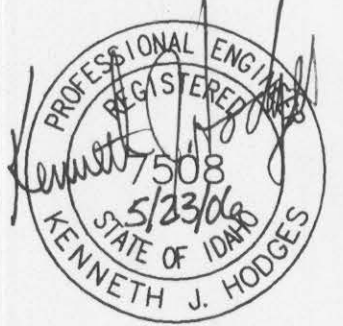

101 Thain Road
Lewiston, ID 83501
Phone: (208) 746-2661
Fax: (208) 746-6825

1220 North Howard Street
Spokane, WA 99201
Phone: (509) 328-5139
Fax: (509) 328-0423