
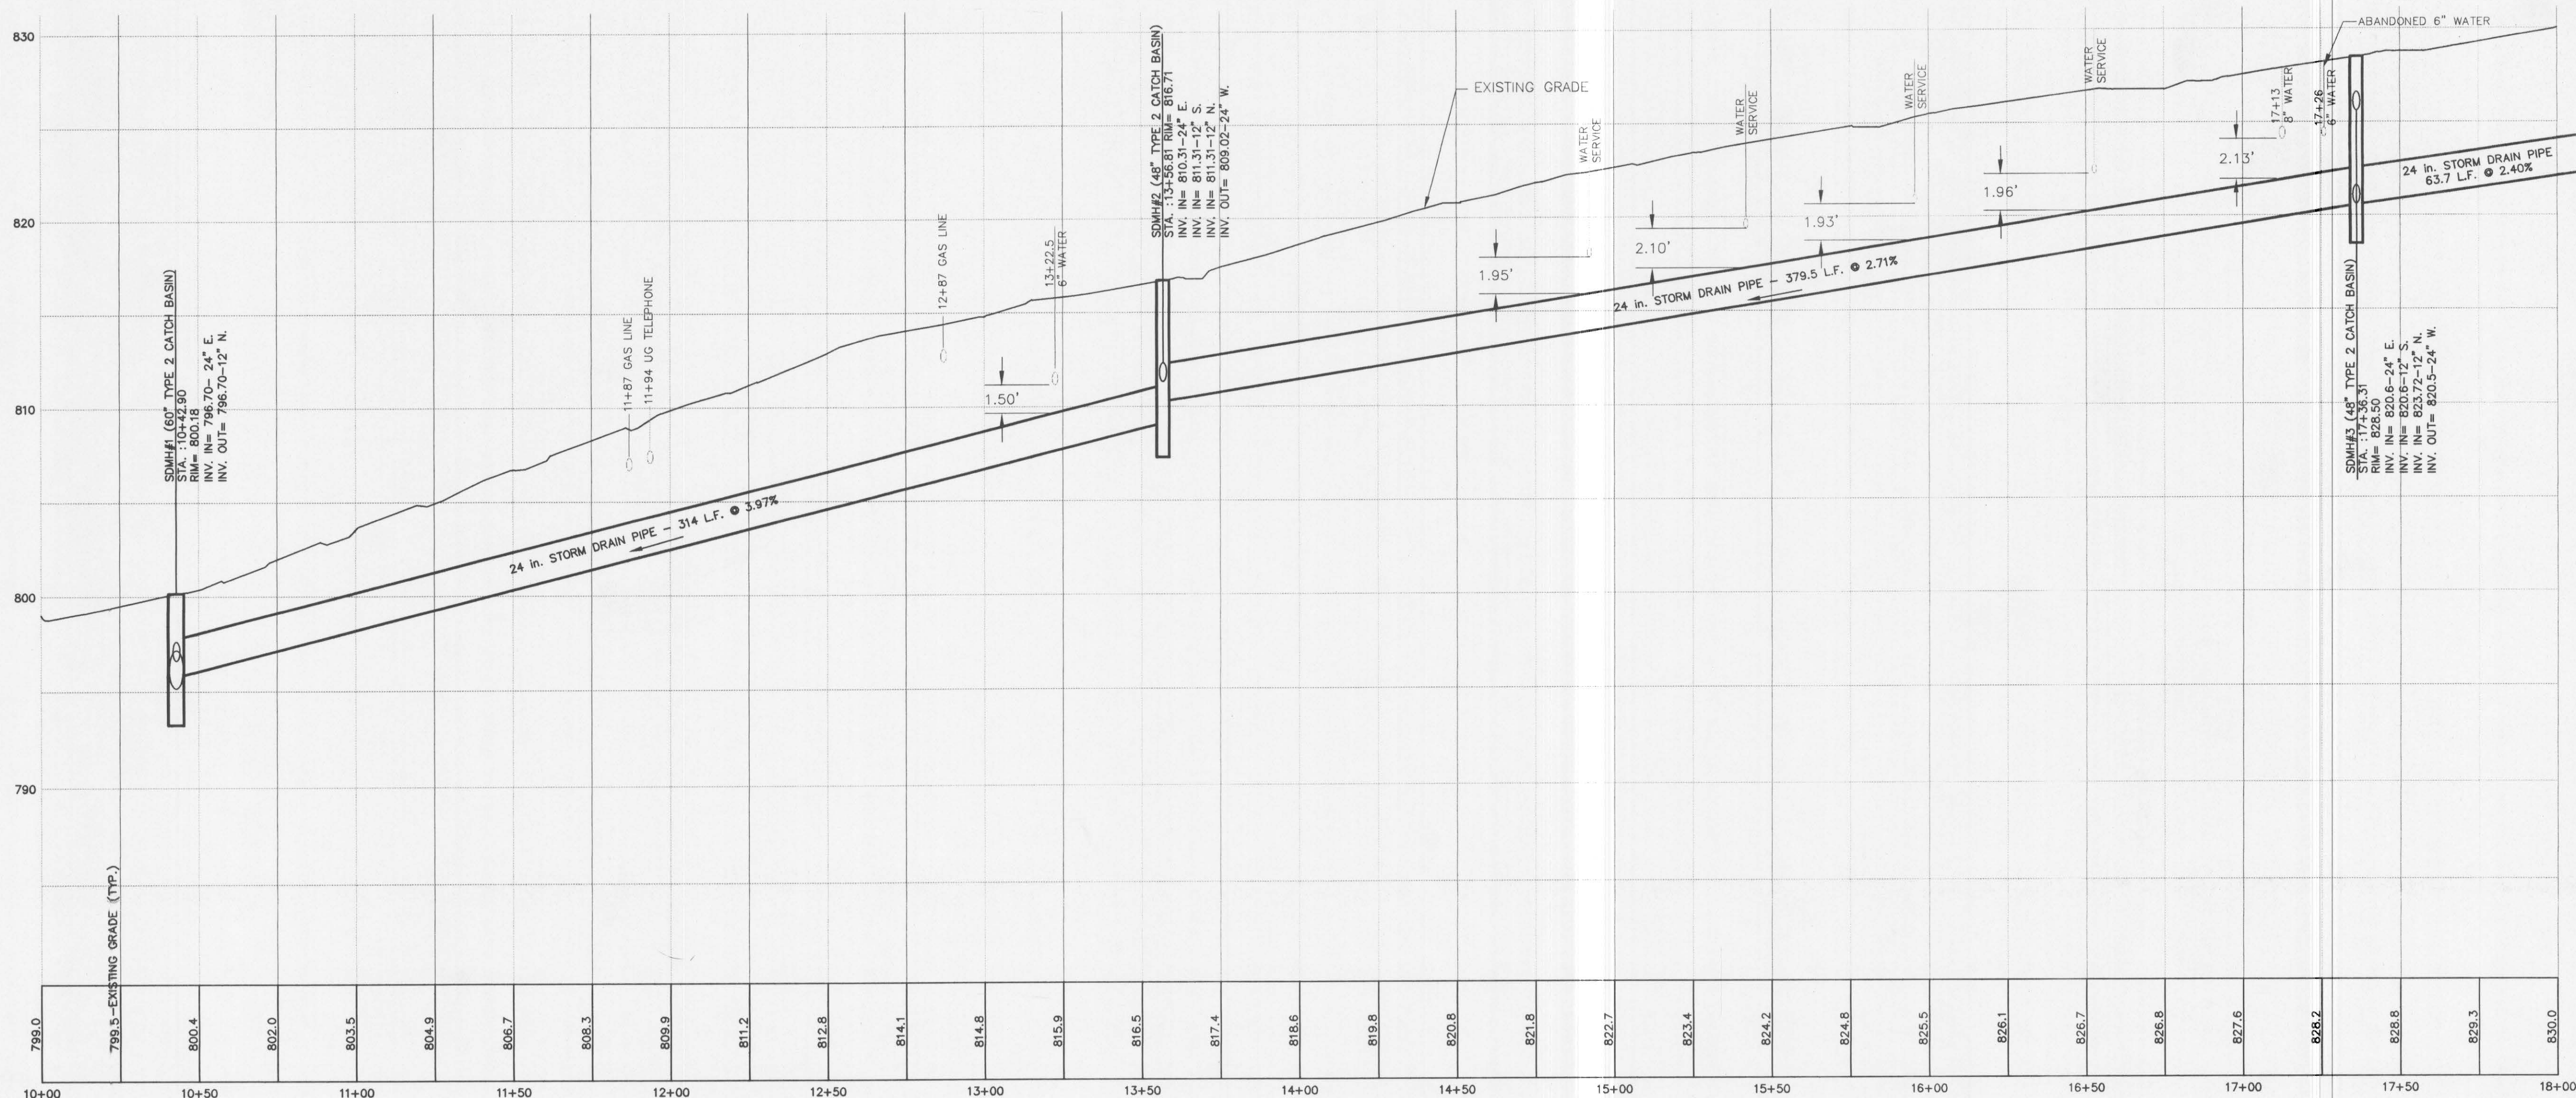
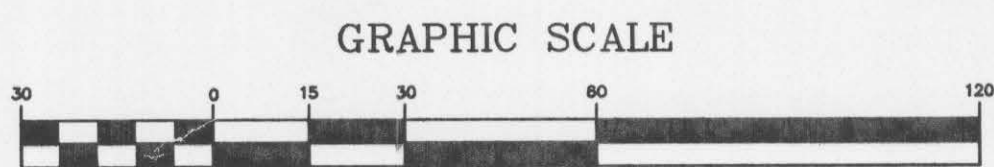


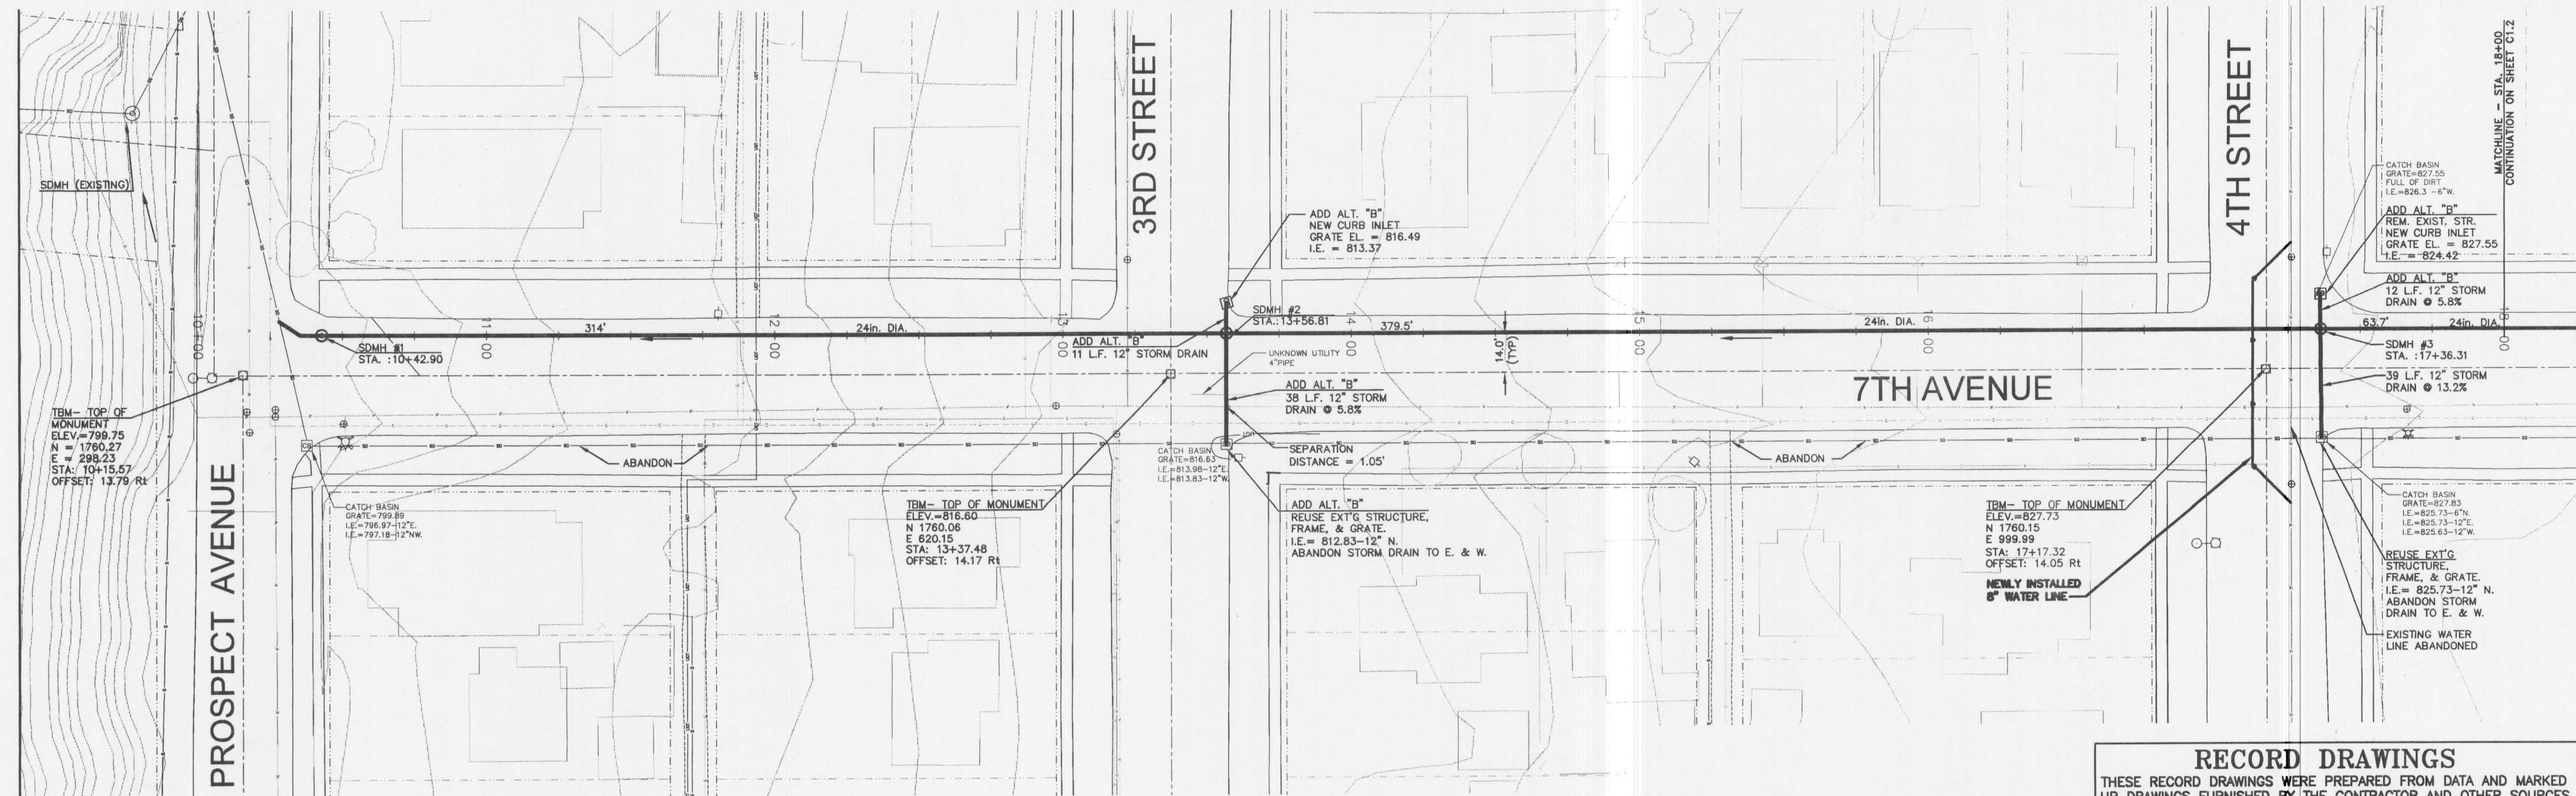

ELEVATIONS OF CROSSING UTILITIES ARE ASSUMED AT 4' COVER. ACTUAL SEPARATION DISTANCES MAY DIFFER FROM THOSE SHOWN ON THIS SHEET.

RECORD DRAWINGS
THESE RECORD DRAWINGS WERE PREPARED FROM DATA AND MARKED UP DRAWINGS FURNISHED BY THE CONTRACTOR AND OTHER SOURCES, INCLUDING THE REPORT FURNISHED, AND REPRESENT THE CONSTRUCTED WORKS TO OUR BEST INFORMATION AND BELIEF.

By		Date		Revision	

Engineering • Land Surveying
Planning • Materials Testing

313 D Street, Ste 200
Lewiston, ID 83501
Phone: (208) 746-2661
Fax: (208) 746-6825

LEWIS - CLARK STATE COLLEGE
STORM WATER SYSTEM IMPROVEMENTS 2005
DPW No. 04-150
PLAN AND PROFILE
7TH AVENUE
10+00 - 18+00

Project Mgr.	RLL
Drawn	RLL
Drawn	BDS
Checked	AG
Date	04-17-06
Sheet No.:	

C 1.1

USKH W.O. 737602