

A

B

C

D

E


F

G

H

TYPICAL FIELD SECTION

NOTE: CONTRACTOR SHALL ADHERE TO ALL RECOMMENDATIONS OF THE GEOTECHNICAL REPORT PREPARED BY TDAH ENGINEERING DATED APRIL 2016.

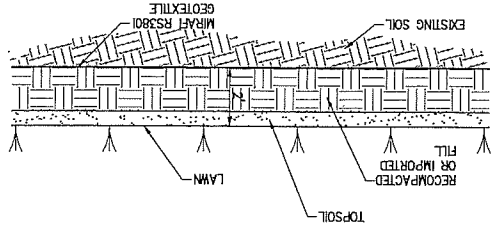


SCALE: NTS

1

FIELD SECTION OVER EXISTING BASEMENT

NOTE: CONTRACTOR SHALL ADHERE TO ALL RECOMMENDATIONS OF THE GEOTECHNICAL REPORT PREPARED BY TDAH ENGINEERING DATED APRIL 2016.

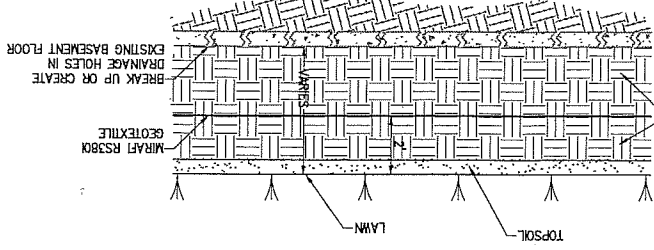

SCALE: NTS


2

FOR PERMIT

THESE DRAWINGS ARE SUFFICIENTLY COMPLETE FOR SUBMISSION TO THE JURISDICTION HAVING AUTHORITY FOR PERMIT. THE CONTRACTOR SHALL NOT USE THESE DRAWINGS FOR CONSTRUCTION UNTIL THE CONTRACTOR RECEIVES WRITTEN APPROVAL FOR USE IN CONSTRUCTION BY THE JURISDICTION HAVING AUTHORITY AND DO ENGINEERS.

CONTRACTOR NOTE:

ALL EXISTING UTILITIES SHOWN ON PLANS ARE TO BE VERIFIED HORIZONTALLY AND VERTICALLY PRIOR TO ANY CONSTRUCTION. ALL EXISTING FEATURES INCLUDING BURIED UTILITIES ARE SHOWN AS FURNISHED BY OTHERS. WE ASSUME NO LIABILITY FOR THE ACCURACY OF THOSE RECORDS AND SURVEYS. CONTACT THE UTILITY OWNER/AGENCY FOR THE FINAL LOCATION OF EXISTING UTILITIES IN AREAS CRITICAL TO CONSTRUCTION.

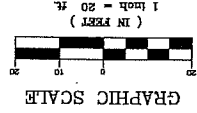


UNDERGROUND SERVICE ALERT
ONE-CALL NUMBER
811
CALL TWO BUSINESS DAYS
BEFORE YOU DIG

ENGINEER'S NOTE:
1. LOCATIONS OF EXISTING BASEMENTS WERE DRAWN BASED ON HISTORICAL IMAGES OF PROPERTY AND PRIOR HOUSE LOCATIONS. ACTUAL BASEMENT LOCATIONS MAY BE DIFFERENT THAN DRAWN. CONTRACTOR TO VERIFY HORIZONTAL AND VERTICAL LOCATIONS OF BASEMENTS. CONTRACTOR TO LOCATE AND REMOVE ALL BASEMENTS AND FILL SOILS THAT MEET GEOTECHNICAL REPORT REQUIREMENTS MAYBE KEPT. ALL OTHER SOILS AND DEBRIS SHALL BE REMOVED AND LEGALLY DISPOSED OF.

- ① REPLACE EXISTING ASPHALT/CONCRETE PAVEMENT PER CITY OF LEWISTON STANDARD DRAWING 1-1.7. SEE DETAIL 2/C5.2.
- ② PROVIDE NEW POWER SERVICE TO SITE.
- ③ COORDINATE WITH ELECTRICAL CONTRACTOR AND AVISTA UTILITIES TO PROVIDE NEW POWER SERVICE TO SITE.
- ④ NOT USED.
- ⑤ NOT USED.
- ⑥ NOT USED.
- ⑦ NOT USED.
- ⑧ NOT USED.

- ① EXISTING CONCRETE SIDEWALK TO REMAIN. ALL TRIP HAZARDS SHALL BE REPAIRED PRIOR TO PROJECT COMPLETION. CITY OF LEWISTON TO PROVIDE INFORMATION ON LOCATIONS REQUIRING REPAIR.
- ② EXISTING CHAIN LINK FENCE TO REMAIN.
- ③ PROVIDE NEW NATURAL GRASS FIELD PER DETAILS 1 AND 2 THIS SHEET AND LANDSCAPE PLANS.
- ④ REMOVE EXISTING BUILDING BASEMENTS AND RE-COMPACT SOILS PER DETAIL 2 THIS SHEET.
- ⑤ REPLACE EXISTING TYPE A CONCRETE CURB PER CITY OF LEWISTON STANDARD DRAWING 2-6. SEE DETAIL 2/C5.1.
- ⑥ REPLACE EXISTING CONCRETE SIDEWALK PER CITY OF LEWISTON STANDARD DRAWING 2-8. SEE DETAIL 3/C5.1.
- ⑦ NOT USED.
- ⑧ NOT USED.

REFERENCE NOTES:

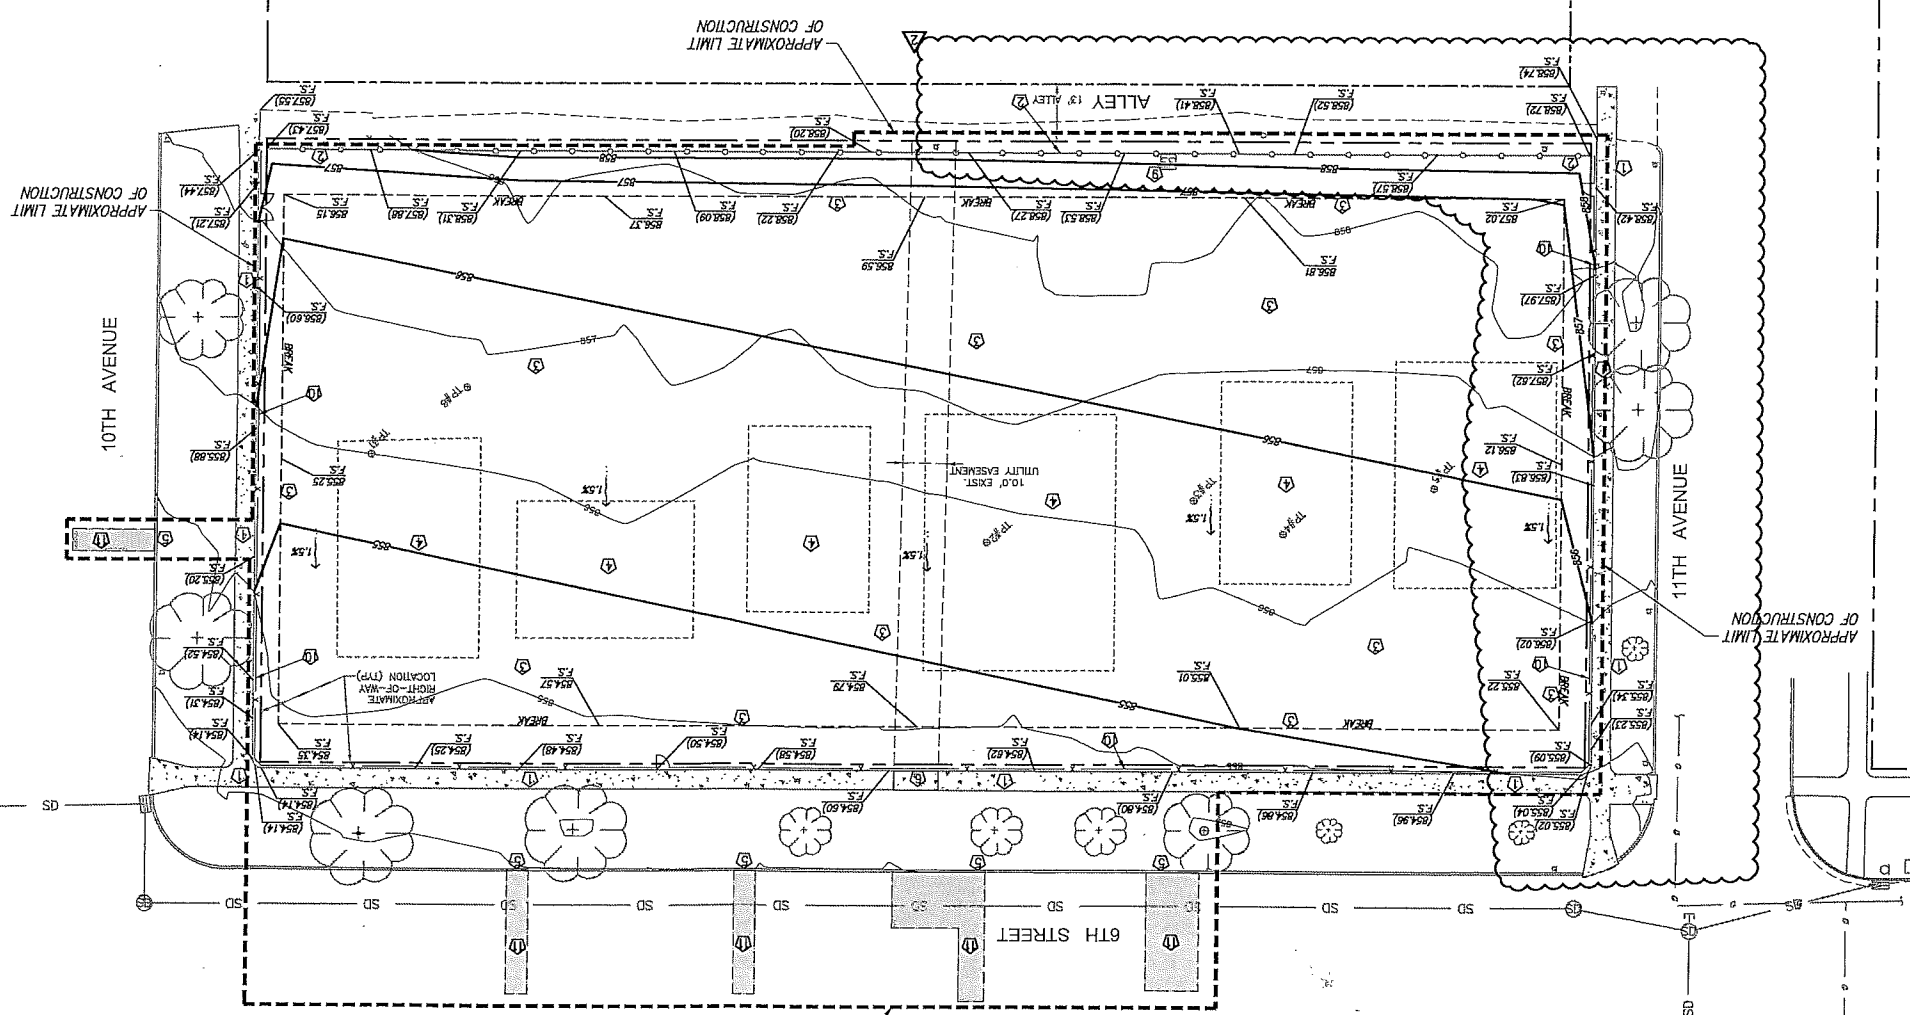

SHEET TITLE: GRADING PLAN
SHEET NO. C1.2

LEWIS-CLARK STATE COLLEGE MULTI-USE FIELD LEWISTON, IDAHO

APPROVALS:
Job No.: 16-42-0026
Proj Manager: SR
Drawn: JRS
Reviewed: SSS
Date: 11-15-16
Scale: 1" = 20'

REVISIONS:
12-8-16 CITY COMMENTS
2-3-17 WE REVISIONS

SIGNATURE:
PROFESSIONAL ENGINEER
STATE OF IDAHO
DATE: 2/3/2017

PREPARED BY:
ENGINEERS
707 W. 2ND AVENUE
SPOKANE, WASHINGTON 99201
PHONE: (509) 455-4446 • FAX: (509) 455-7492
WEBSITE: www.dci-engineers.com
CIVIL / STRUCTURAL