



LINDEN AVENUE - LEFT FLOWLINE PROFILE

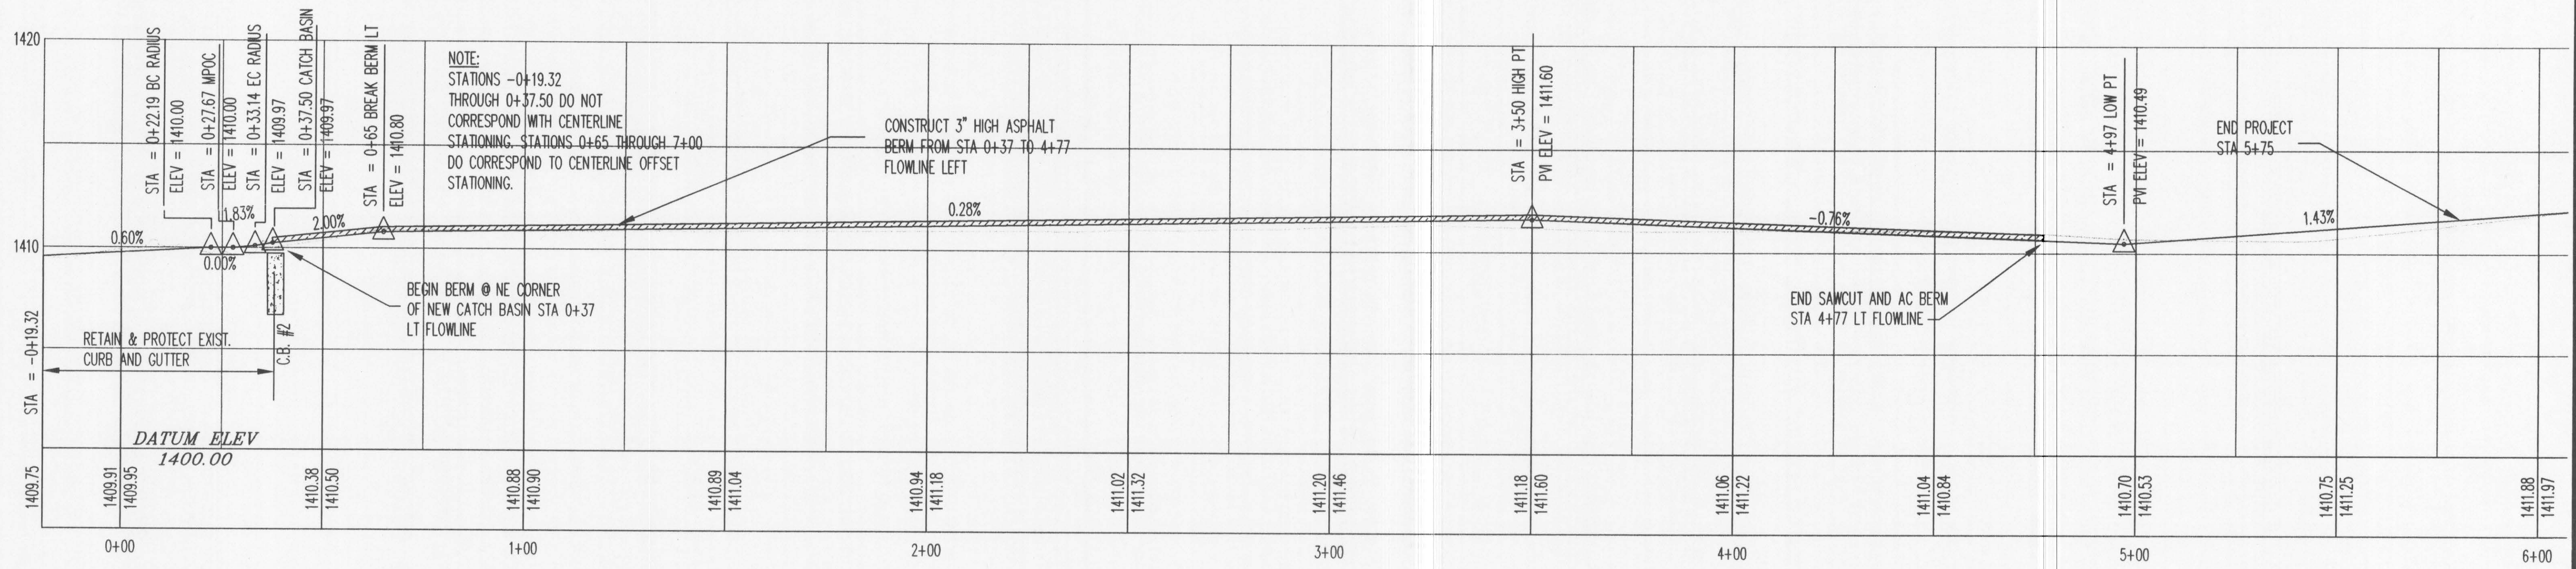

SCALE: HORIZ 1" = 20'
VERT 1" = 4'


LINDEN AVENUE - RIGHT FLOWLINE PROFILE

SCALE: HORIZ 1" = 20'
VERT 1" = 4'

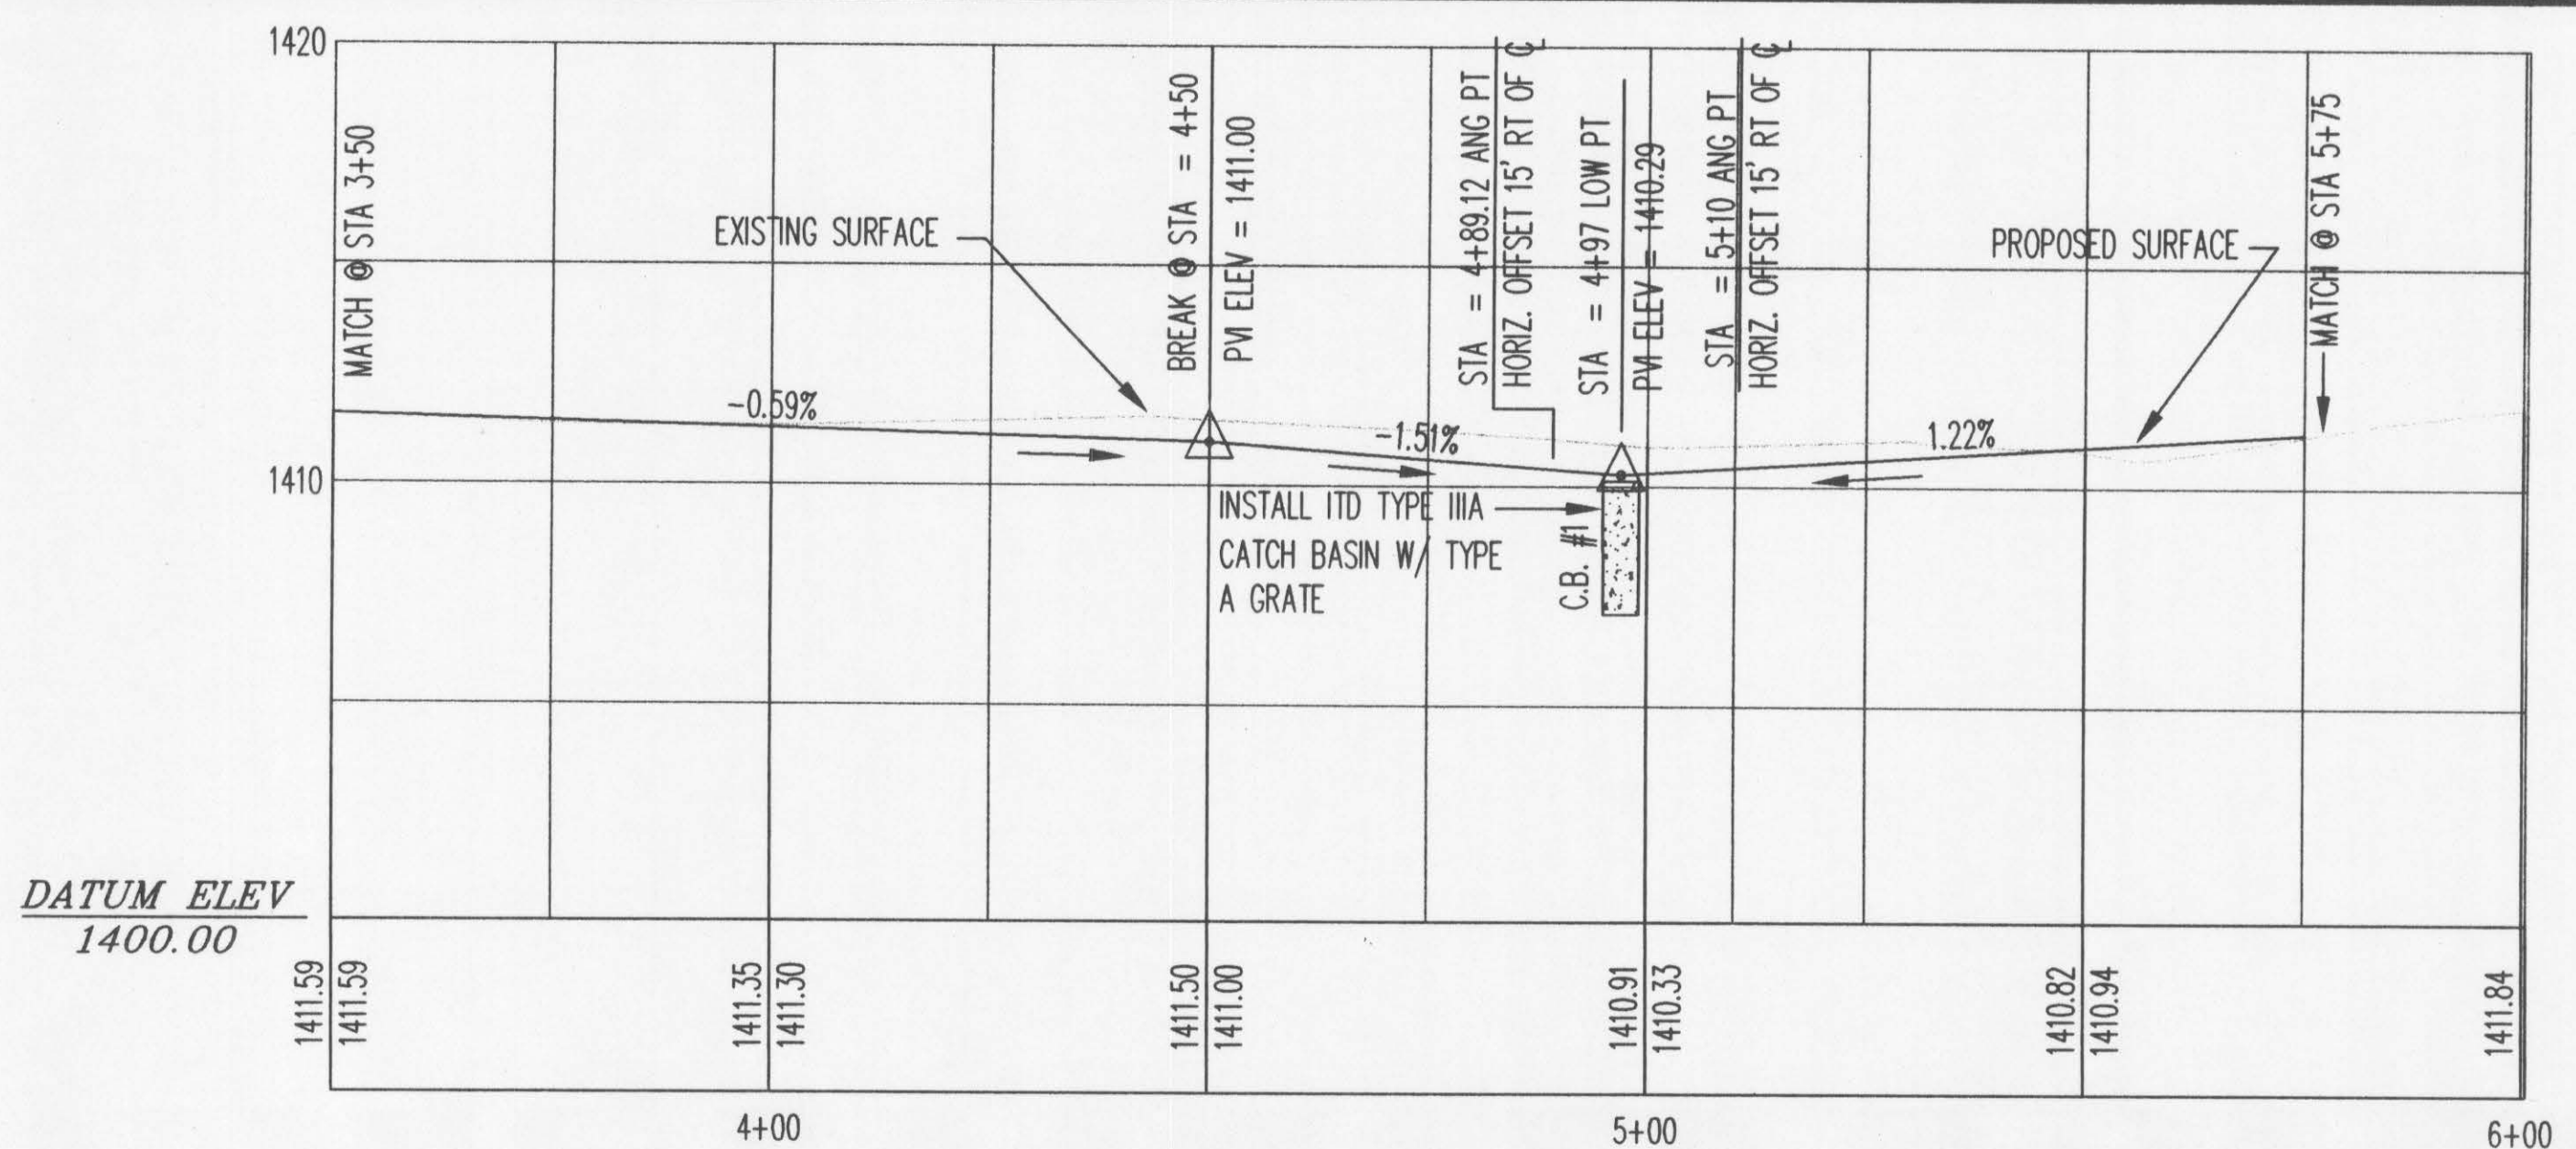

LINDEN AVENUE
CATCH BASIN DETAIL - STA 4+97 LOW POINT

SCALE: 1" = 4'

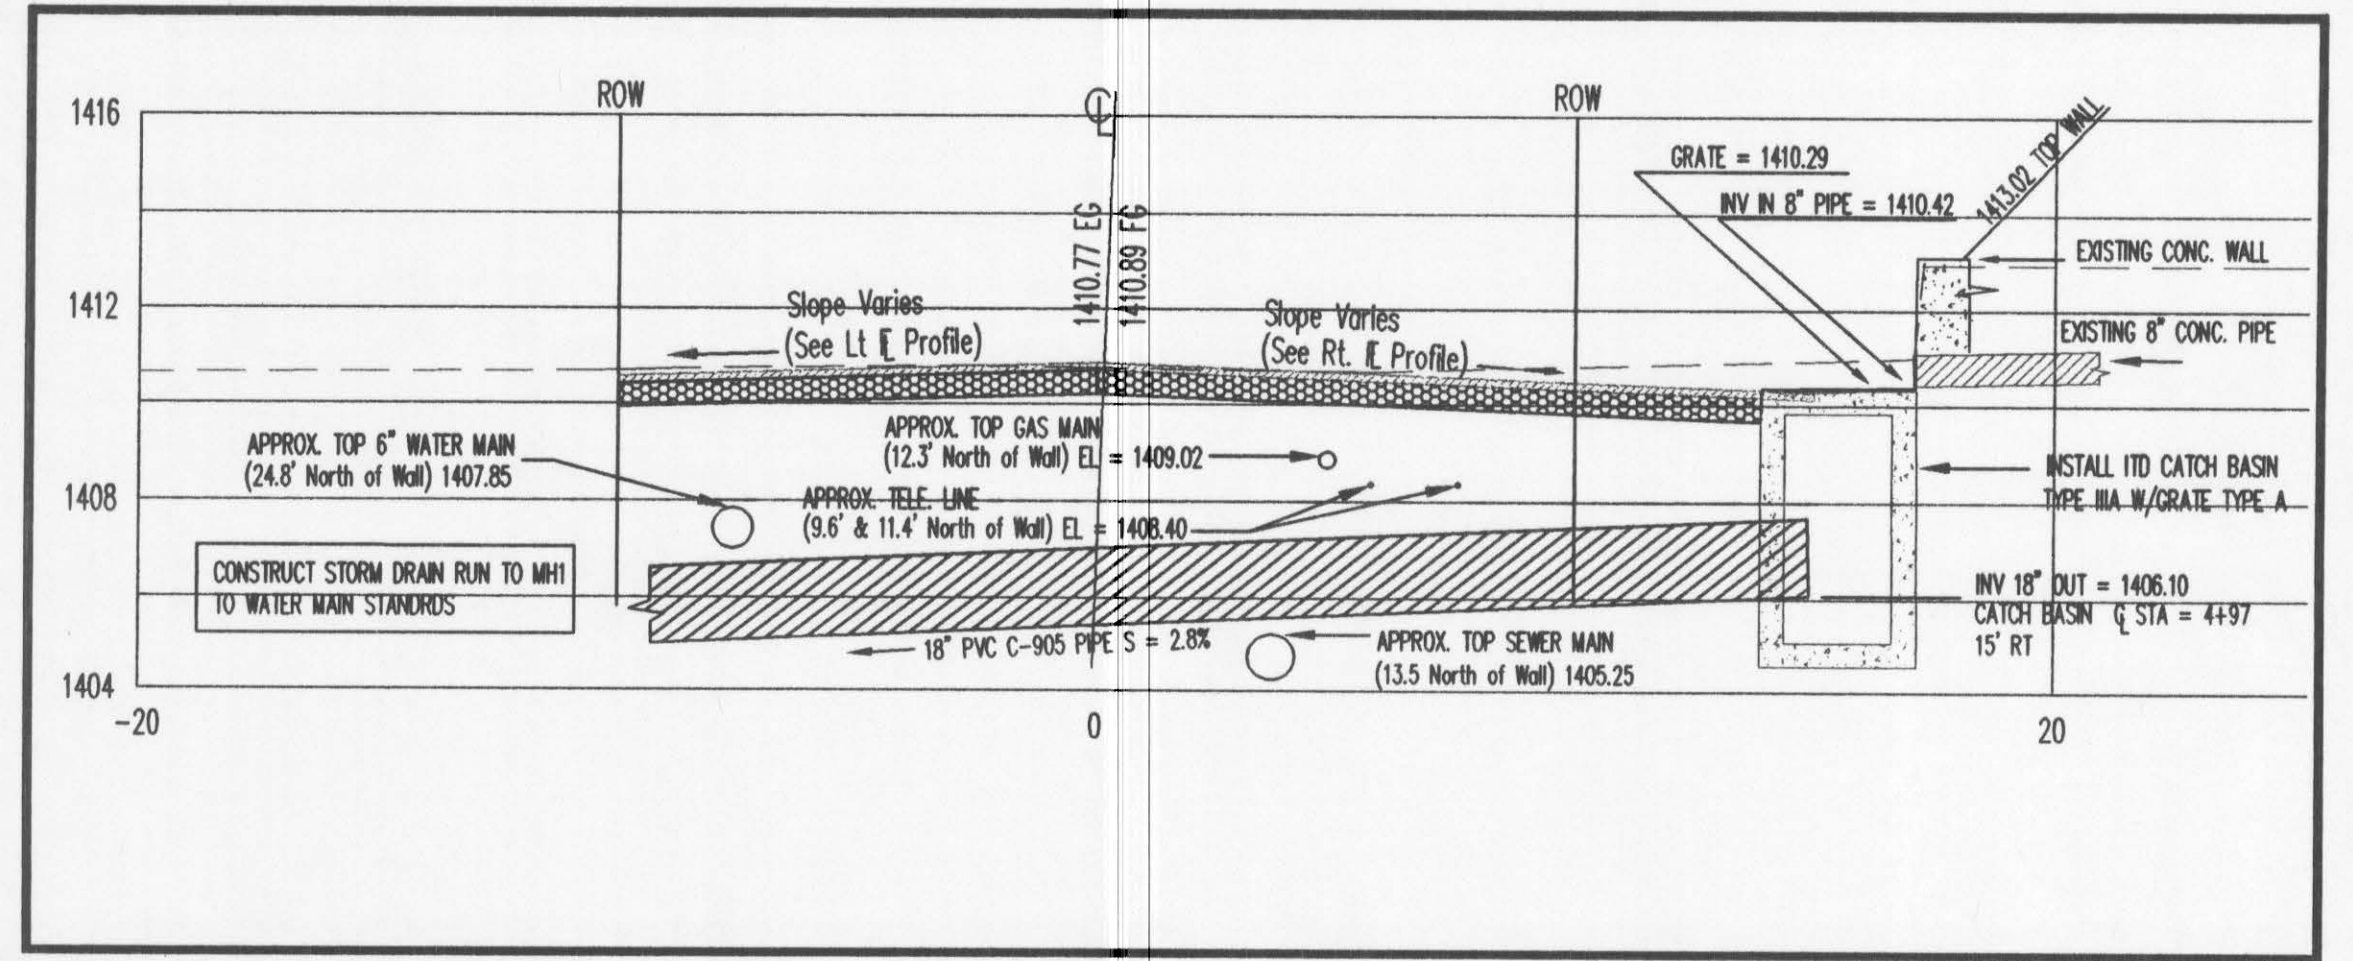

DESIGNED BY: M.H.	SCALE: 1" = 20'
DRAWN BY: M.H.	DATE: 5/15/2000
CHECKED BY: T.R.	DRAWING NO.: L5B
BY: 8-5	SHEET 3 OF 6

NO.	DATE	FILENAME	DESCRIPTION

LINDEN AVENUE
FLOWLINE PROFILES
AND
DETAILS

CITY OF LEWISTON
ENGINEERING DEPARTMENT
1034 1ST STREET, LEWISTON, ME 04201
207-746-1316

PROFESSIONAL ENGINEER
REGISTERED IN THE STATE OF MAINE
6593
TIMOTHY J. LEWISTON