

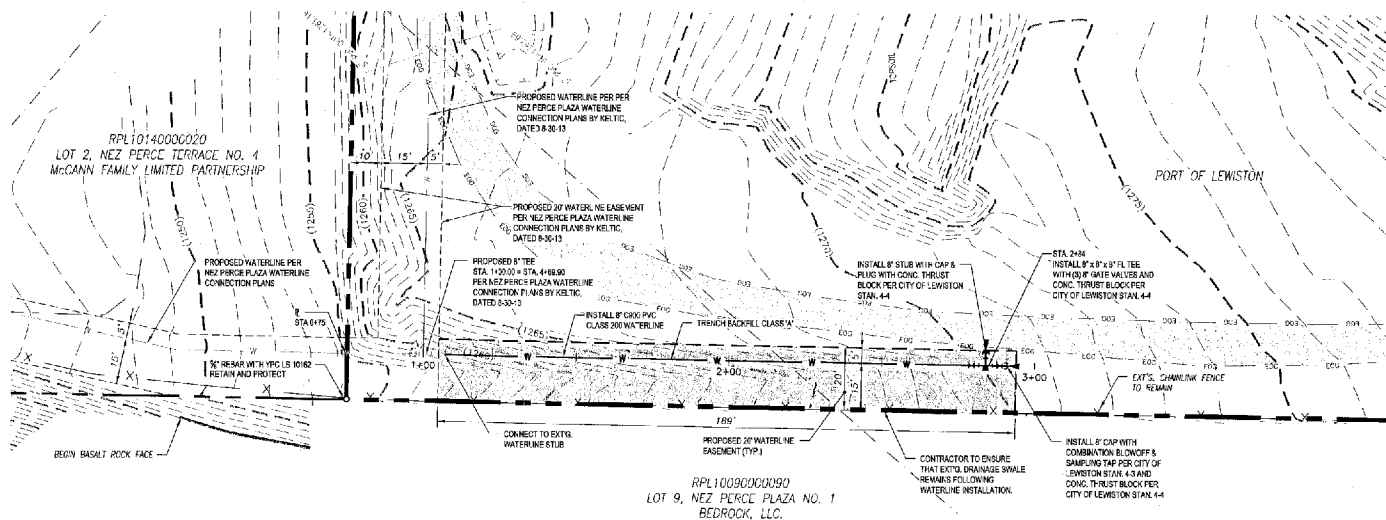


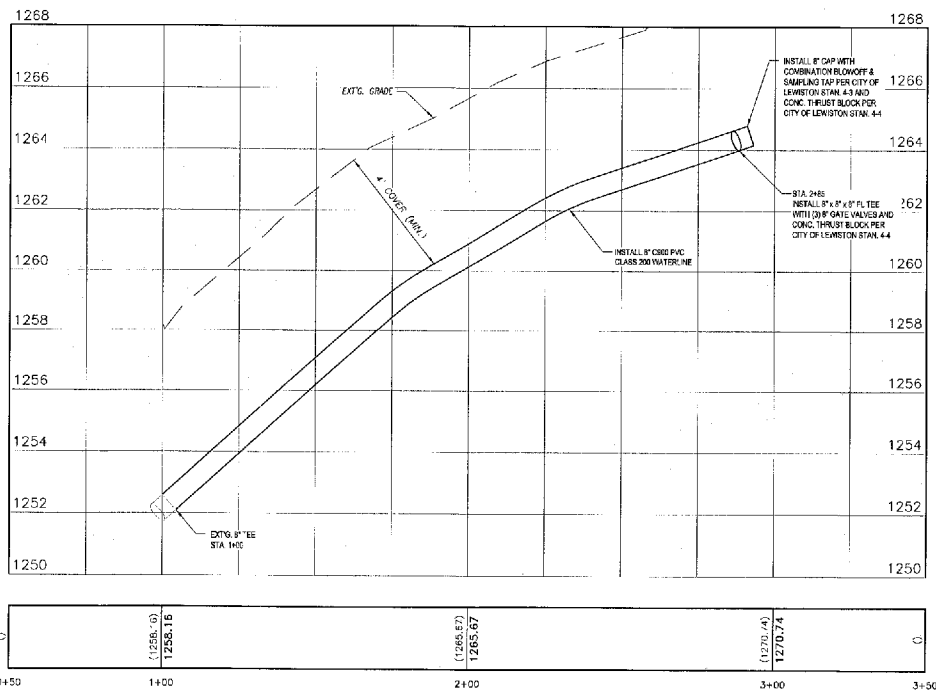

WATERLINE STA. 1+00 TO 2+90

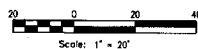

Know what's below.
Call before you dig.

CALL 2 BUSINESS DAYS IN ADVANCE BEFORE
YOU DIG, GRADE, OR EXCAVATE FOR THE
MARKING OF UNDERGROUND MEMBER
UTILITIES

WATERLINE PLAN & PROFILE

PORT OF LEWISTON

1626 6TH AVE. NORTH

LEWISTON, ID. 83501

KELTIC ENGINEERING, INC.

311 Adams Lane • Lewiston, Idaho 83501 • (208) 743-2175 • (208) 743-2136 fax

9251 North Nevada Street, Ste 204 • Spokane, WA 99218 • (509) 444-2000 • (509) 444-0025 fax

• Development • Planning • Design • Construction Management



DRAWN BY: KRW
DESIGNED BY: EPH
DATE: 12-23-13
LAST REV: 02-12-14 (JDM)
PROJECT NO.: 15-180
SHEET NO.: 4 OF 4