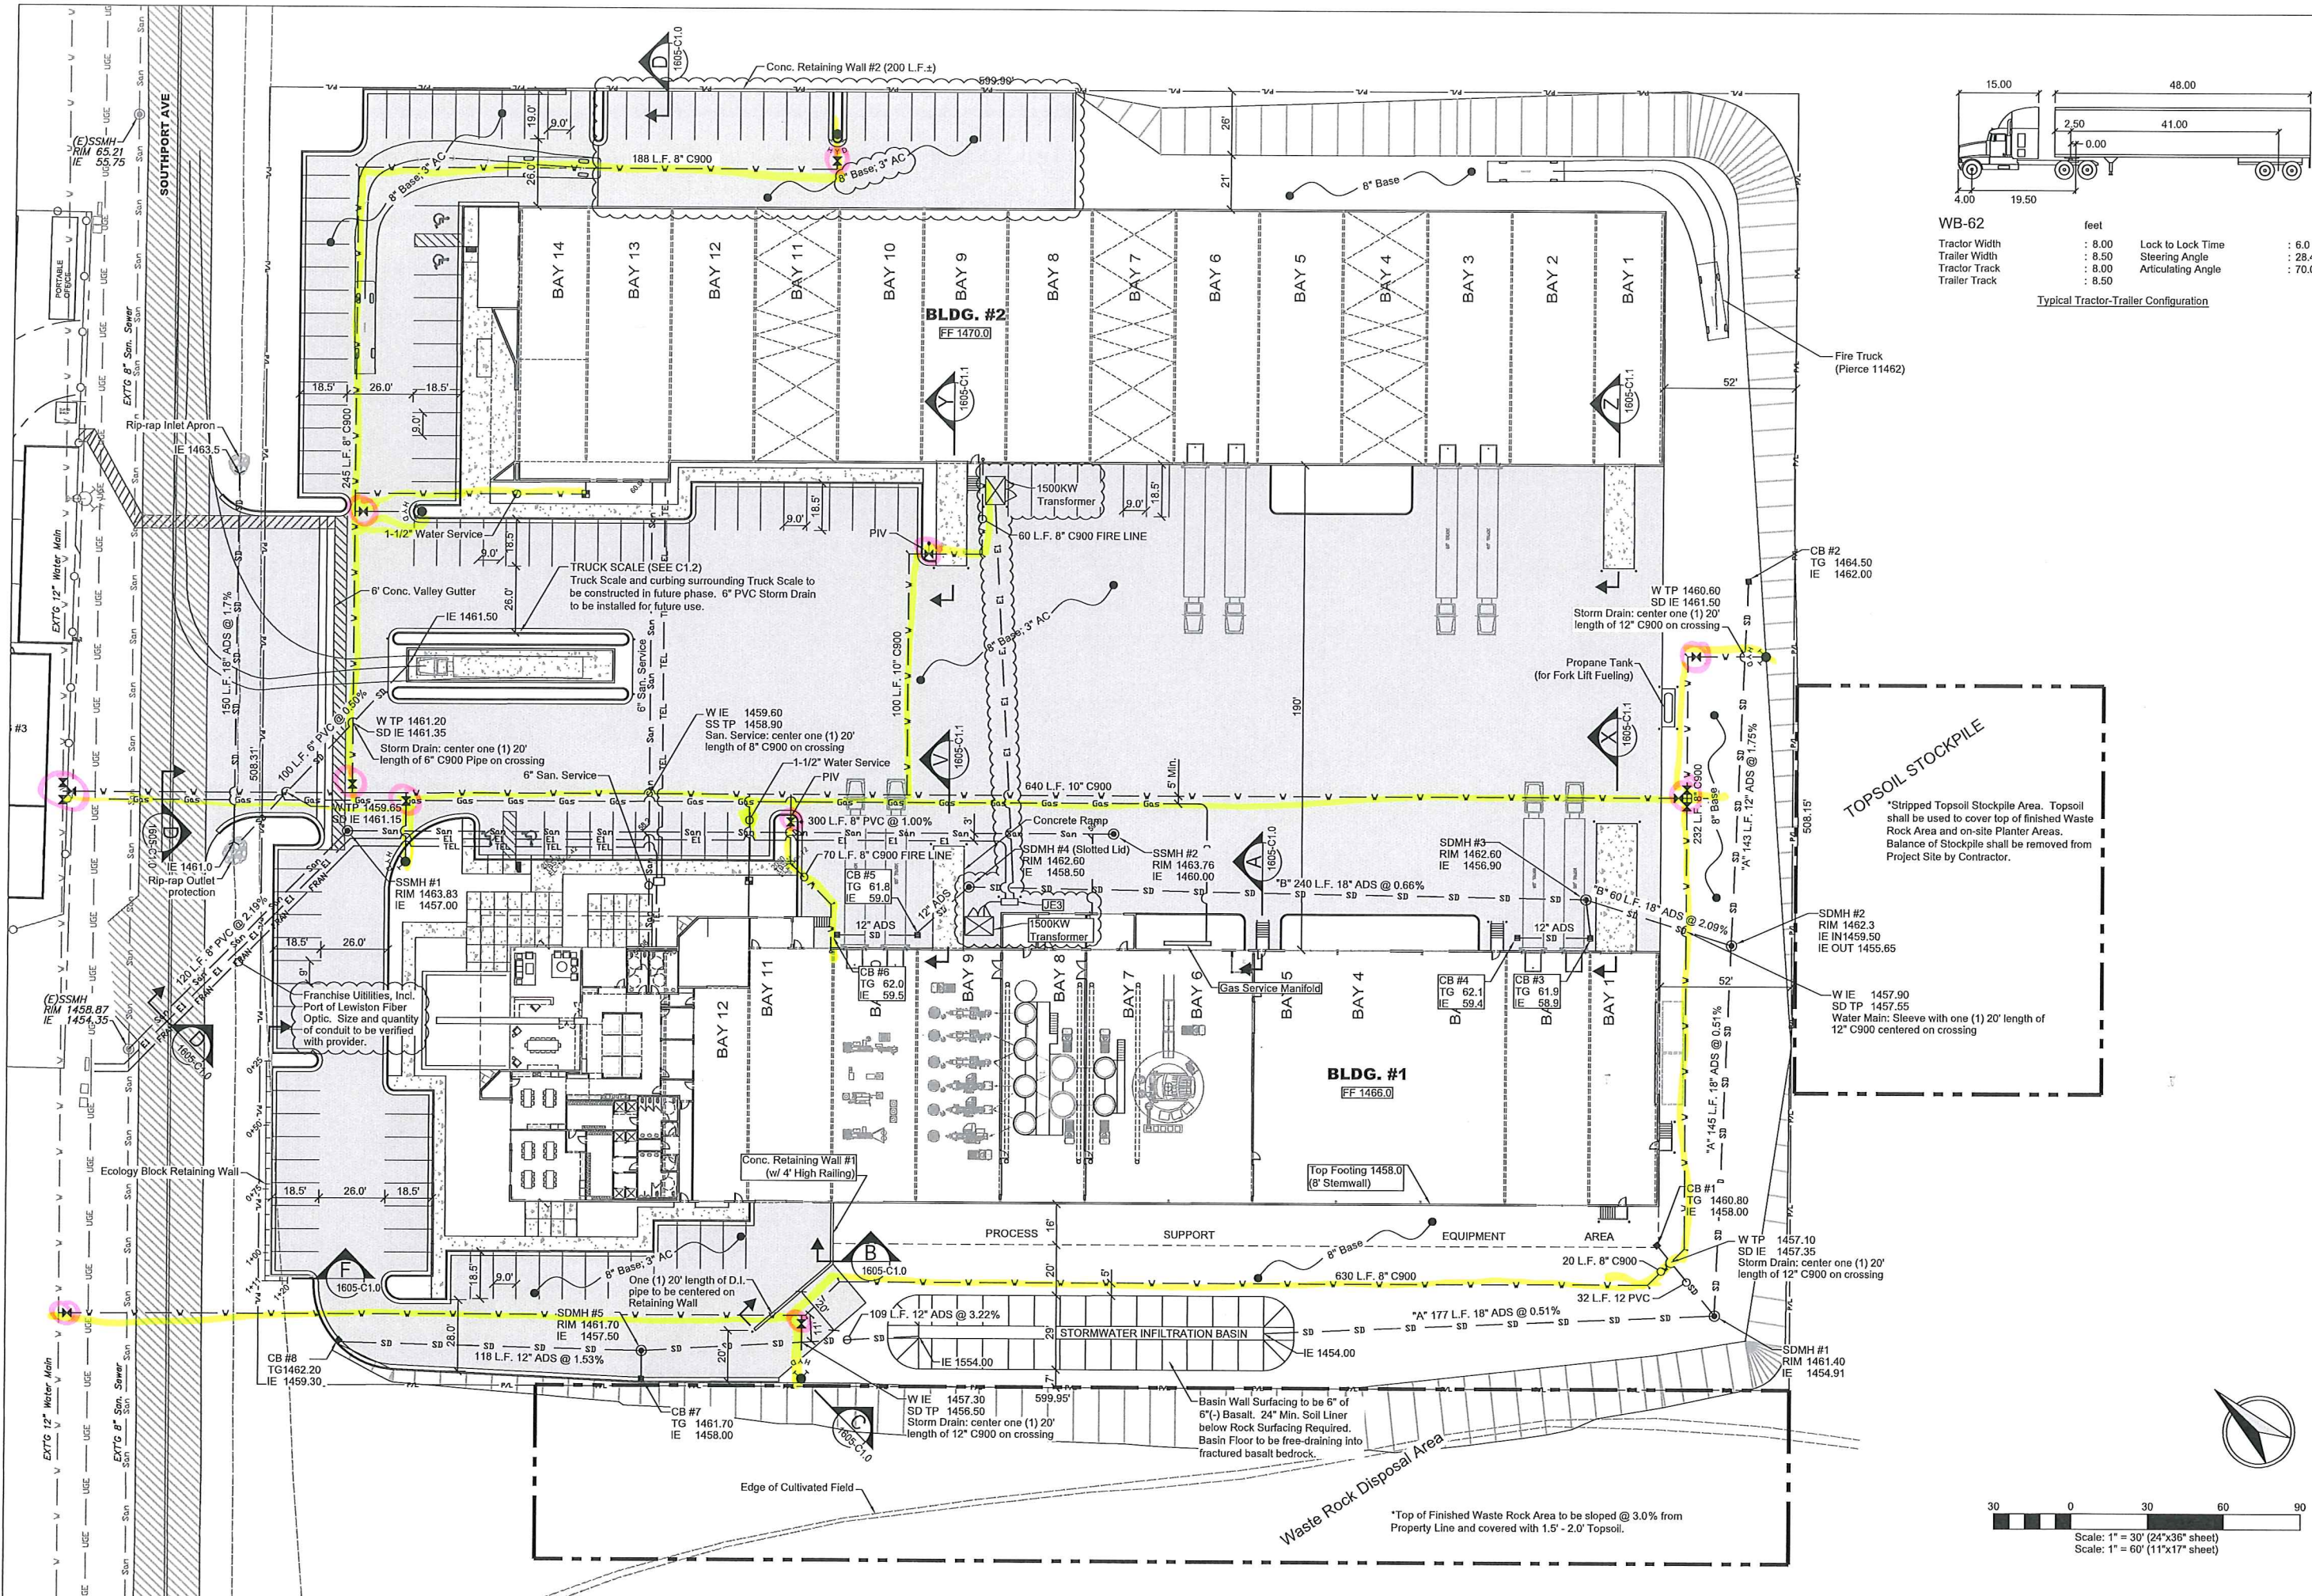


REVISION

DESCRIPTION

DATE

BY

1

04-22-16

JSH

2

04-27-16

JSH

Revised as per City Review Comments dated 4-16-16

3

04-27-16

JSH

Add. 19' Parking Stalls adjacent to Bldg. #2

4

06-06-16

JSH

Add. A.C. Paving behind Bldg. #2

5

08-27-16

JSH

Rev. Transformer and E3 locations

ENGINEER

REGISTERED

PROFESSIONAL

#2102

3/25/16

SHEET

C4.0

DRAWING #

1605-C4.0

SCALE

1"=30'

CHECKED BY

JSH

DATE

03-25-16

SHEET

C4.0

DRAWING #

1605-C4.0

PROJECT

P-KAY METAL - SOUTHPORT PROJECT

SITE DEVELOPMENT PLAN

SOUTHPORT AVENUE

LEWISTON, IDAHO

HEDCO

ENGINEERING & DEVELOPMENT CO.

528 BRYDEN AVENUE

LEWISTON, IDAHO 83501

(208) 796-3422

SHEET

C4.0