


# City of Lewiston



1 inch = 25 feet

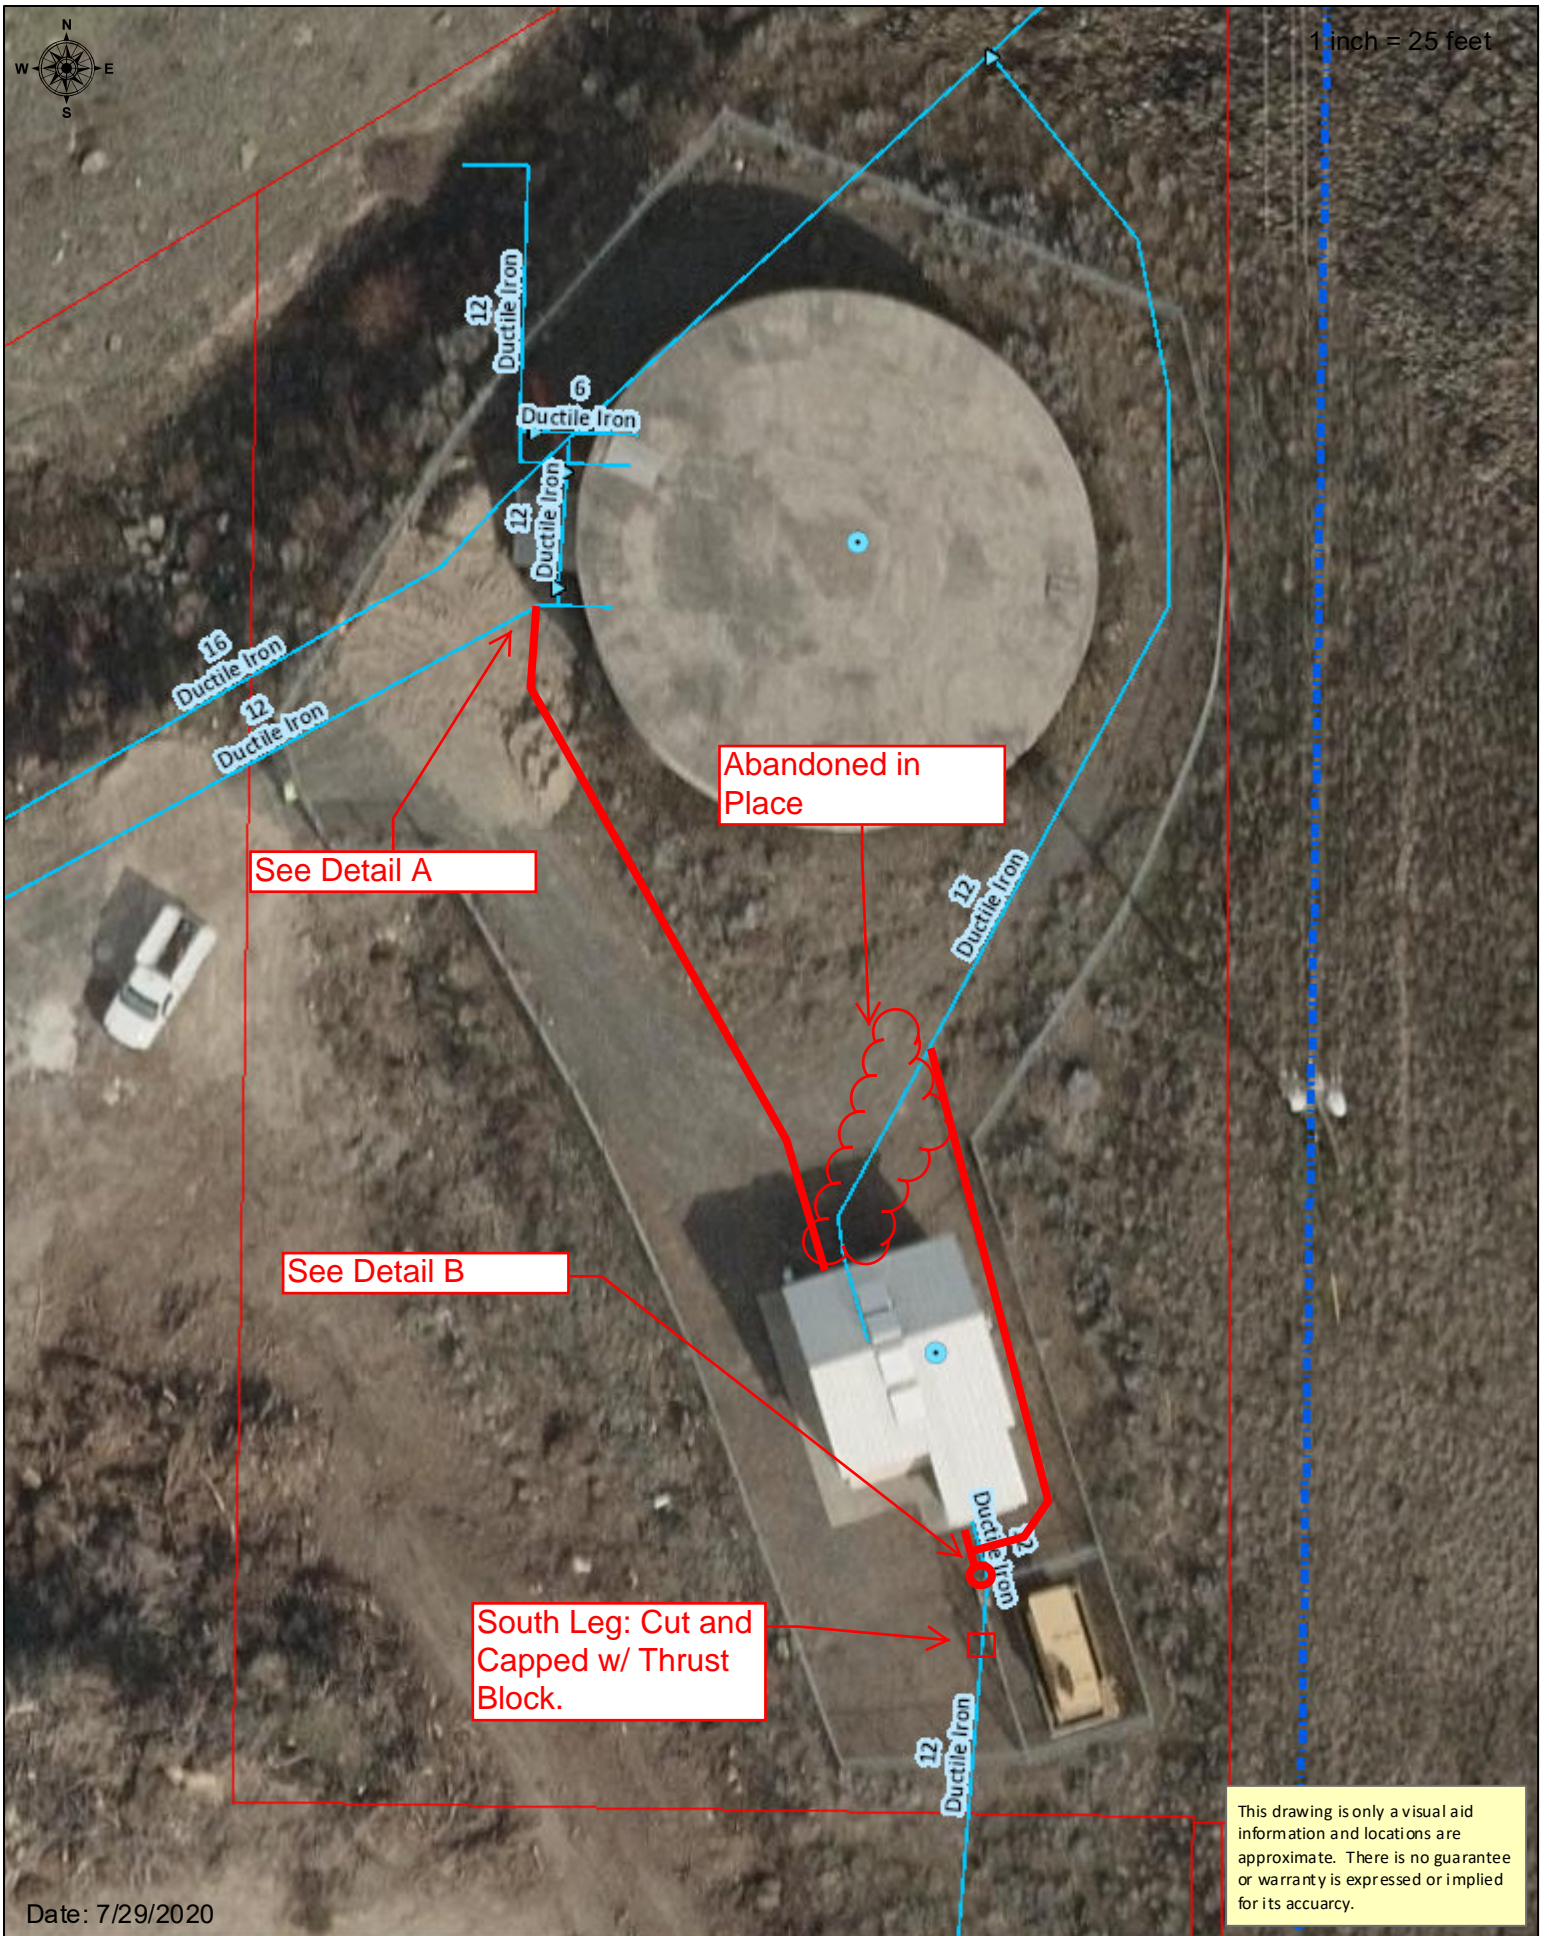

See Detail A

Abandoned in Place

See Detail B

South Leg: Cut and Capped w/ Thrust Block.

This drawing is only a visual aid information and locations are approximate. There is no guarantee or warranty is expressed or implied for its accuracy.