
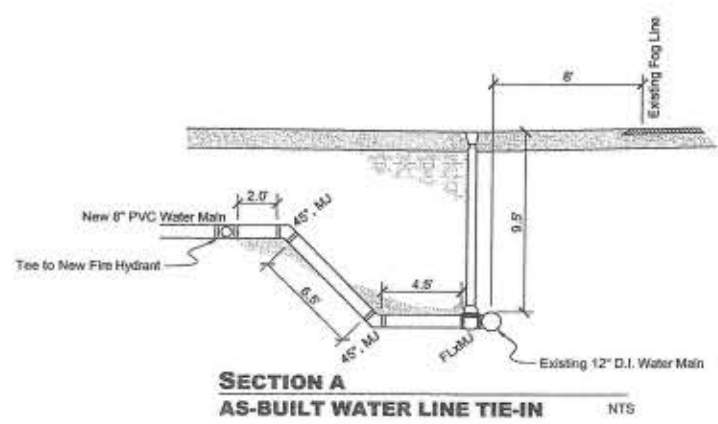
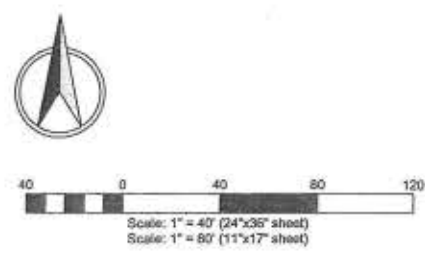


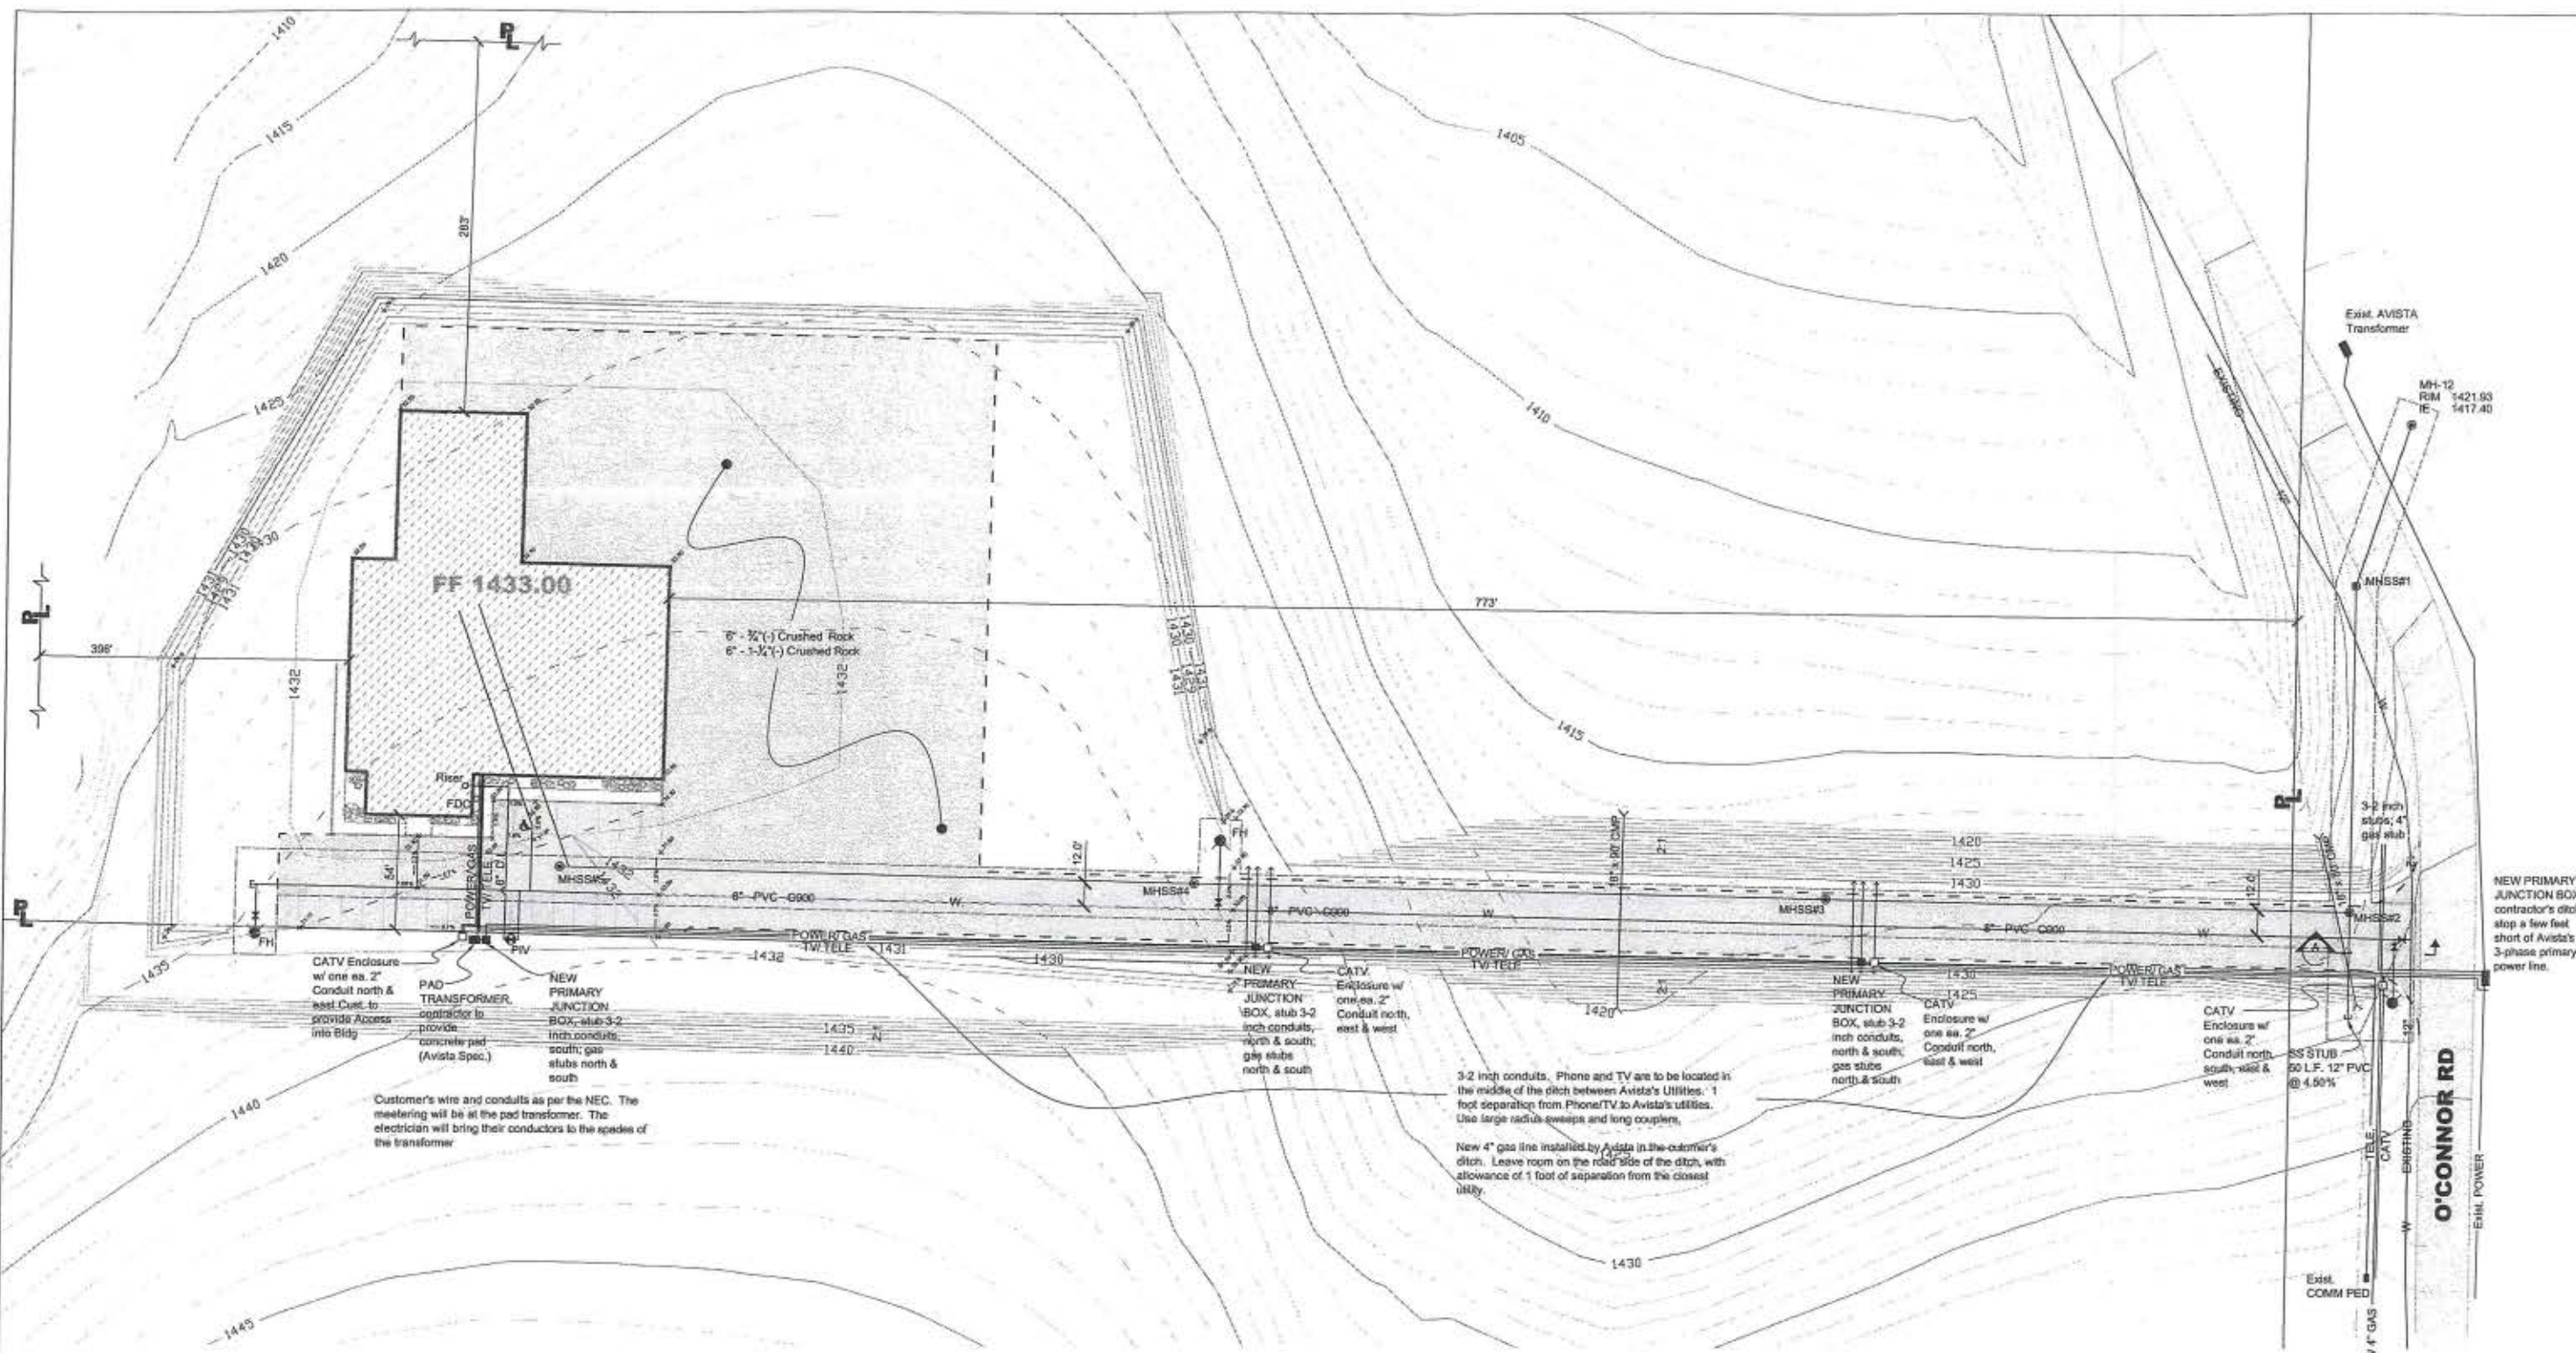

- NOTES**
1. Water Main Piping, Fire Hydrants and Valves shall be furnished and installed in accordance with City of Lewiston standards.
 2. Sanitary Sewer Piping and Manholes shall be furnished and installed in accordance with City of Lewiston standards.
 3. All Avista conduits will be schedule 40 gray electrical conduit. Large radius sweep, long couplers.
 4. 36\" cover on all gas pipe and electrical conduit.
 5. Gas pipe to be sand padded 6\" above and below.

AS CONSTRUCTED 1/23/14 JSH
Hedco, Inc.
 529 Brylen Ave
 Lewiston, ID 83501

SEEKINS PRECISION, LLC

SITE PLAN

159 AMERICAN WAY

LEWISTON, IDAHO

HEDCO

HAMMOND ENGINEERING & DEVELOPMENT CO.
 528 BRYDEN AVENUE LEWISTON, IDAHO 83501
 (208) 798-6422

REVISION

NO.	DATE	DESCRIPTION
A	8-20-13	Revised Plan 1.00 Inl
B	8-20-13	Sanitary Sewer & Waterline routing
C	8-20-13	Utility & Stormwater Overlap Updates
D	10-18-13	CATV Network
E	01-25-14	As-built data

SCALE

1"=40'

CHECKED BY

JSH

DATE

06-14-13

SHEET

1

DRAWING

1330-1