
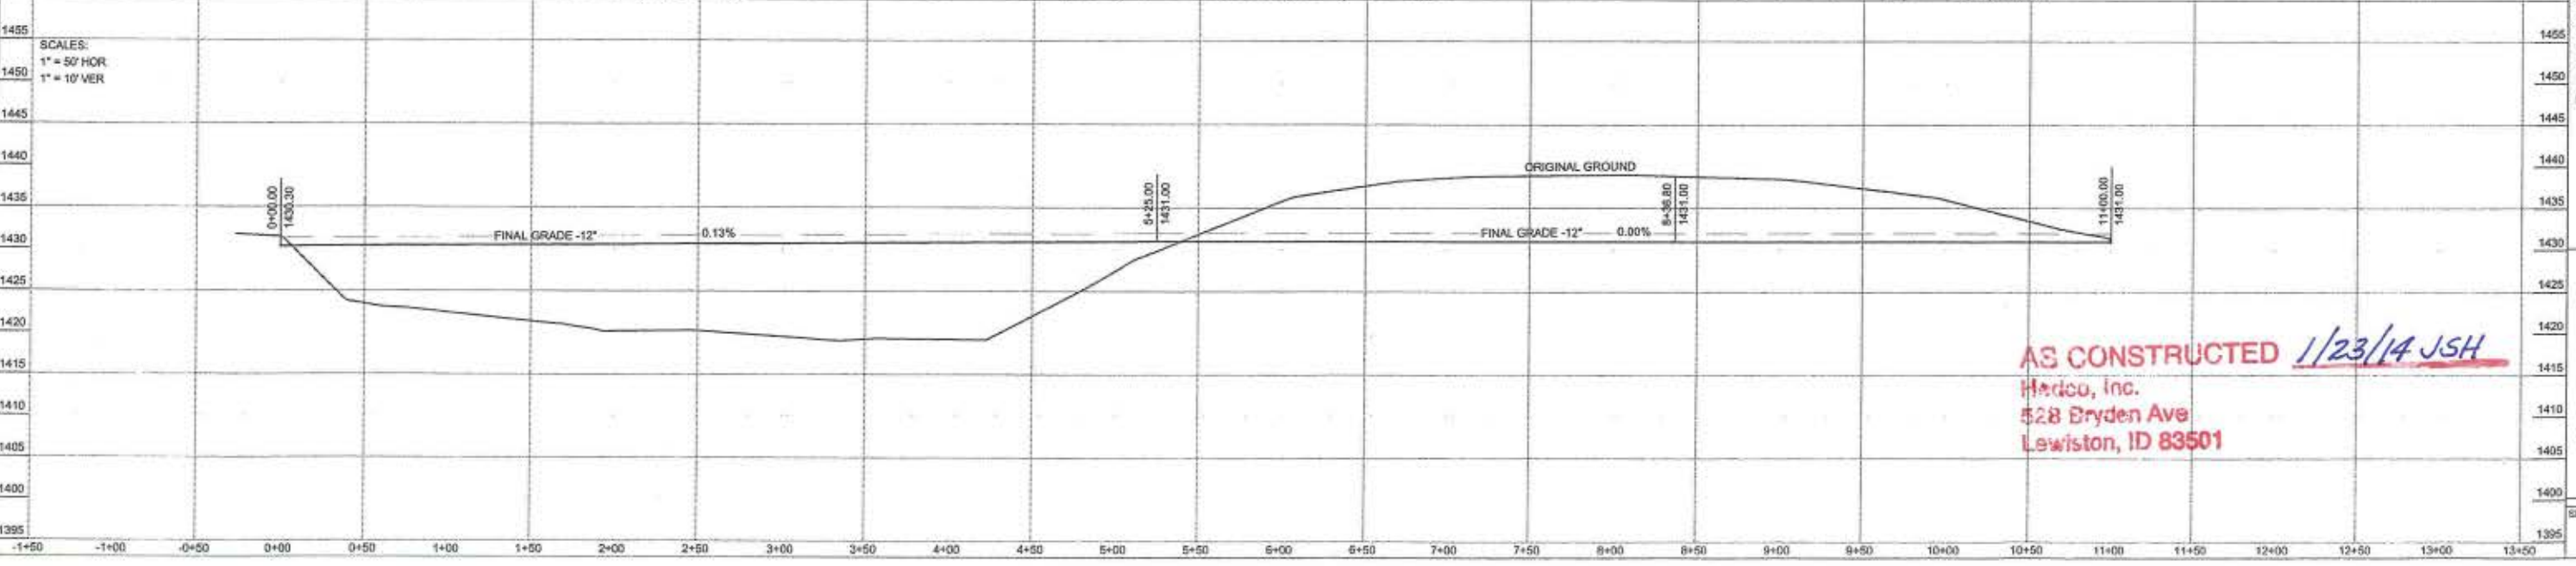


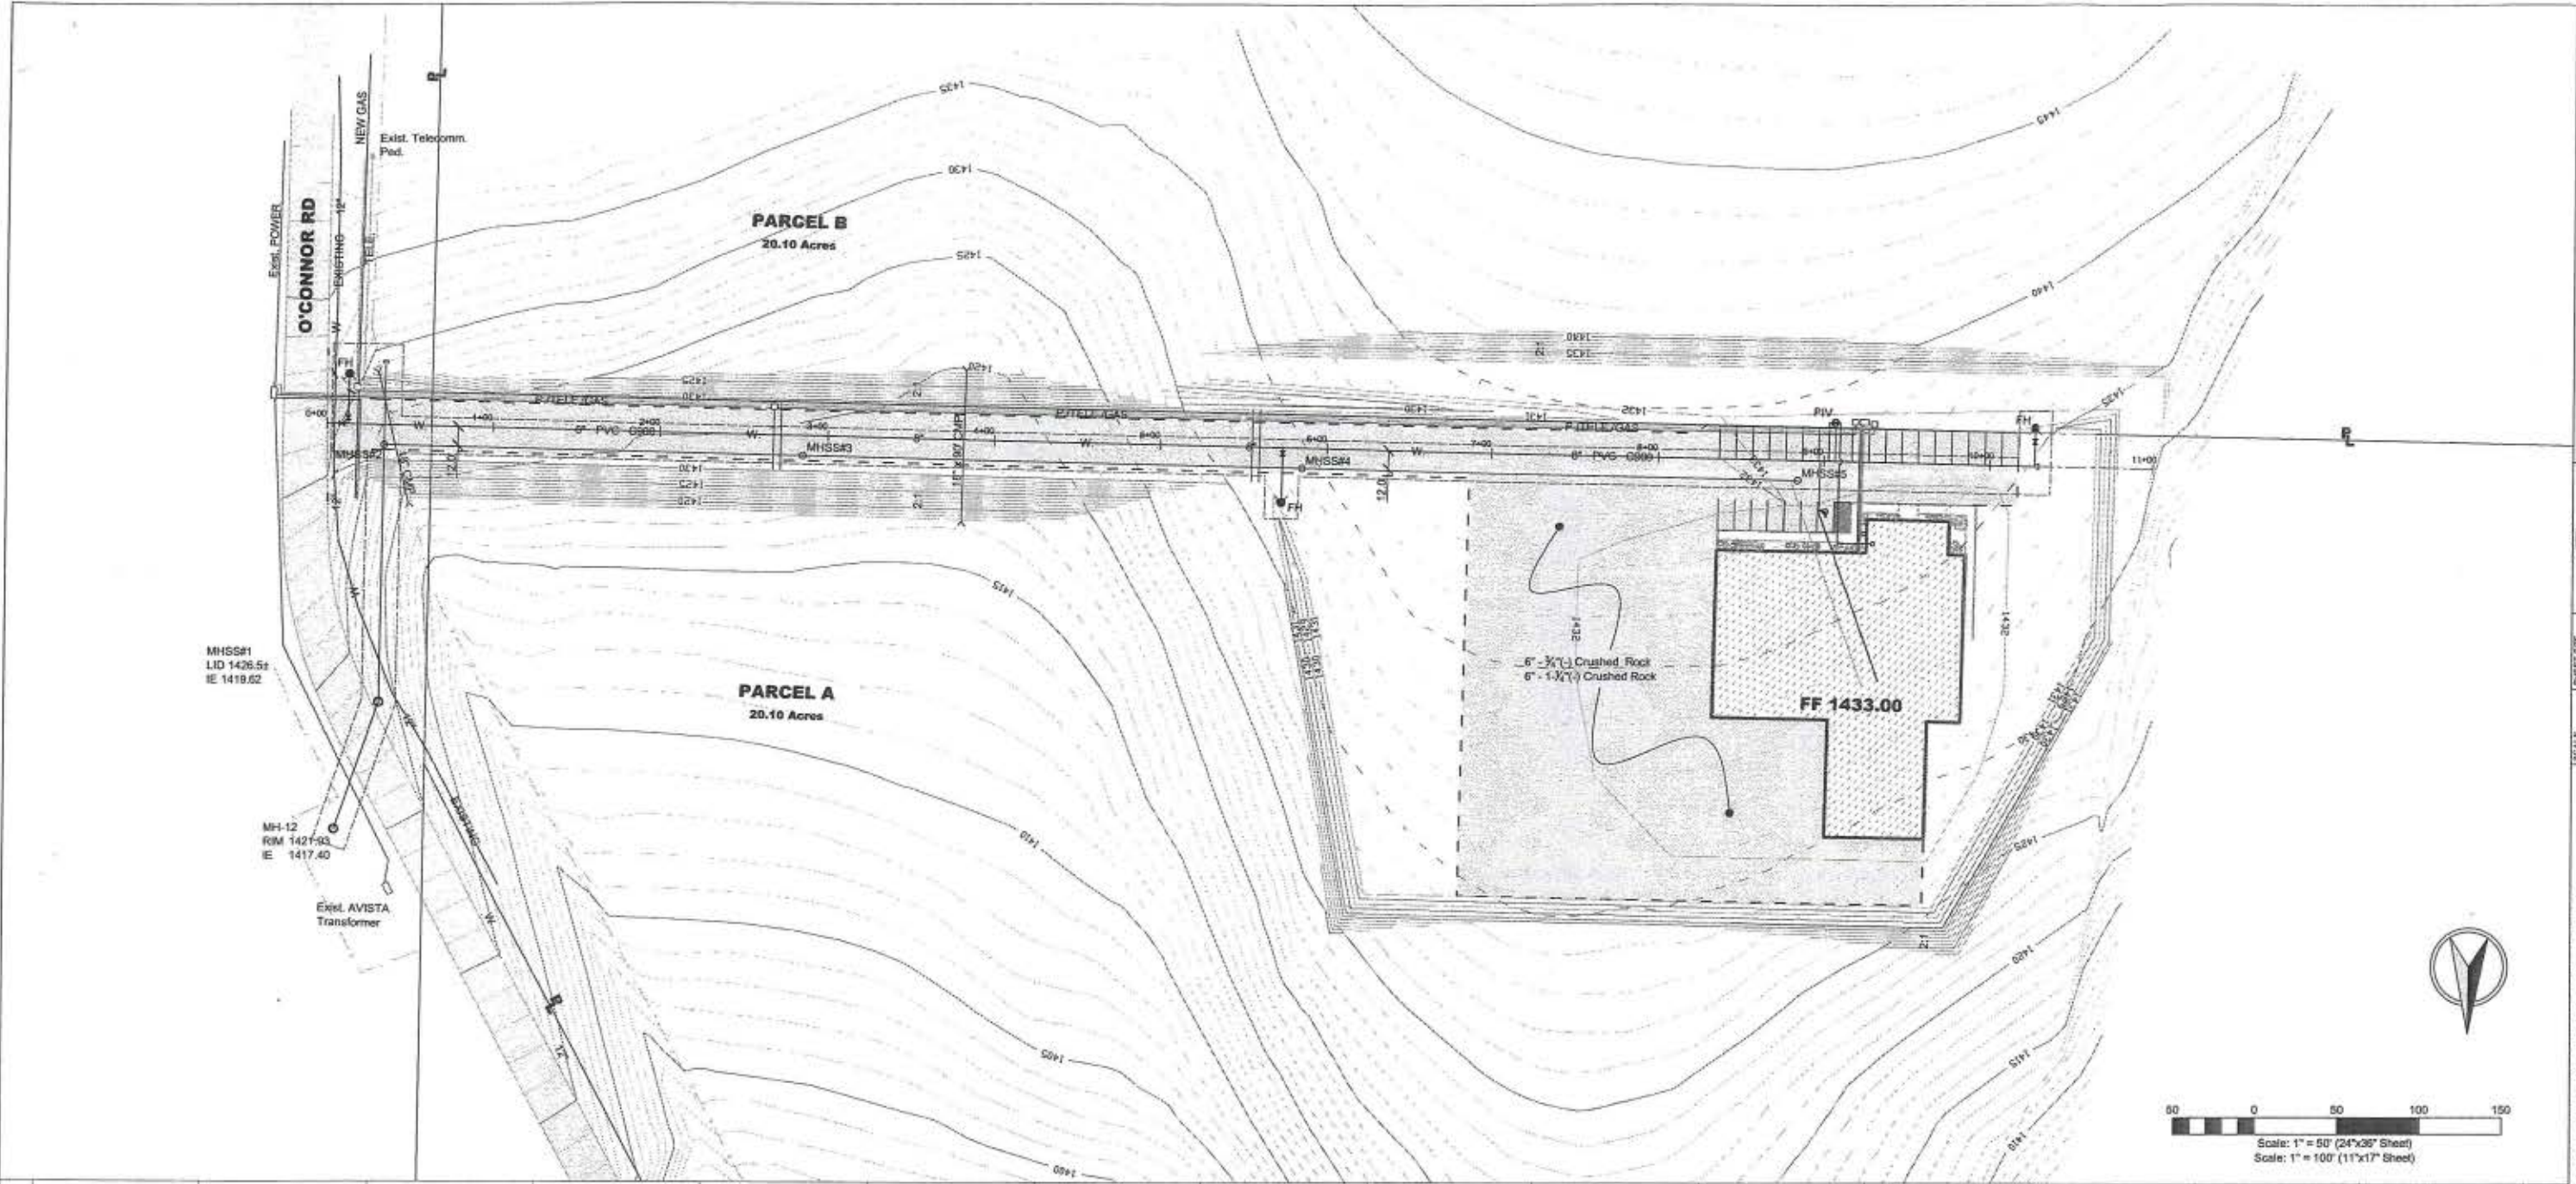

AS CONSTRUCTED 1/23/14 JSH
Hedco, Inc.
528 Bryden Ave
Lewiston, ID 83501

SEEKINS PRECISION, LLC
ACCESS ROAD
159 AMERICAN WAY
LEWISTON, IDAHO

HEDCO

HAMMOND ENGINEERING & DEVELOPMENT CO.
128 BRYDEN AVENUE LEWISTON, IDAHO 83501
(208) 798-9422

SHEET

2

DATE	REVISION	DESCRIPTION	APPROVED
8-20-13	A	Initial P&I & Road Right of Way	JSH
8-21-13	B	Initial P&I & Road Right of Way	JSH
8-22-13	C	Initial P&I & Road Right of Way	JSH
8-23-13	D	Initial P&I & Road Right of Way	JSH
8-24-13	E	Initial P&I & Road Right of Way	JSH

SCALE: 1" = 50' (24"x36" Sheet)

Scale: 1" = 100' (11"x17" Sheet)

1330-2