
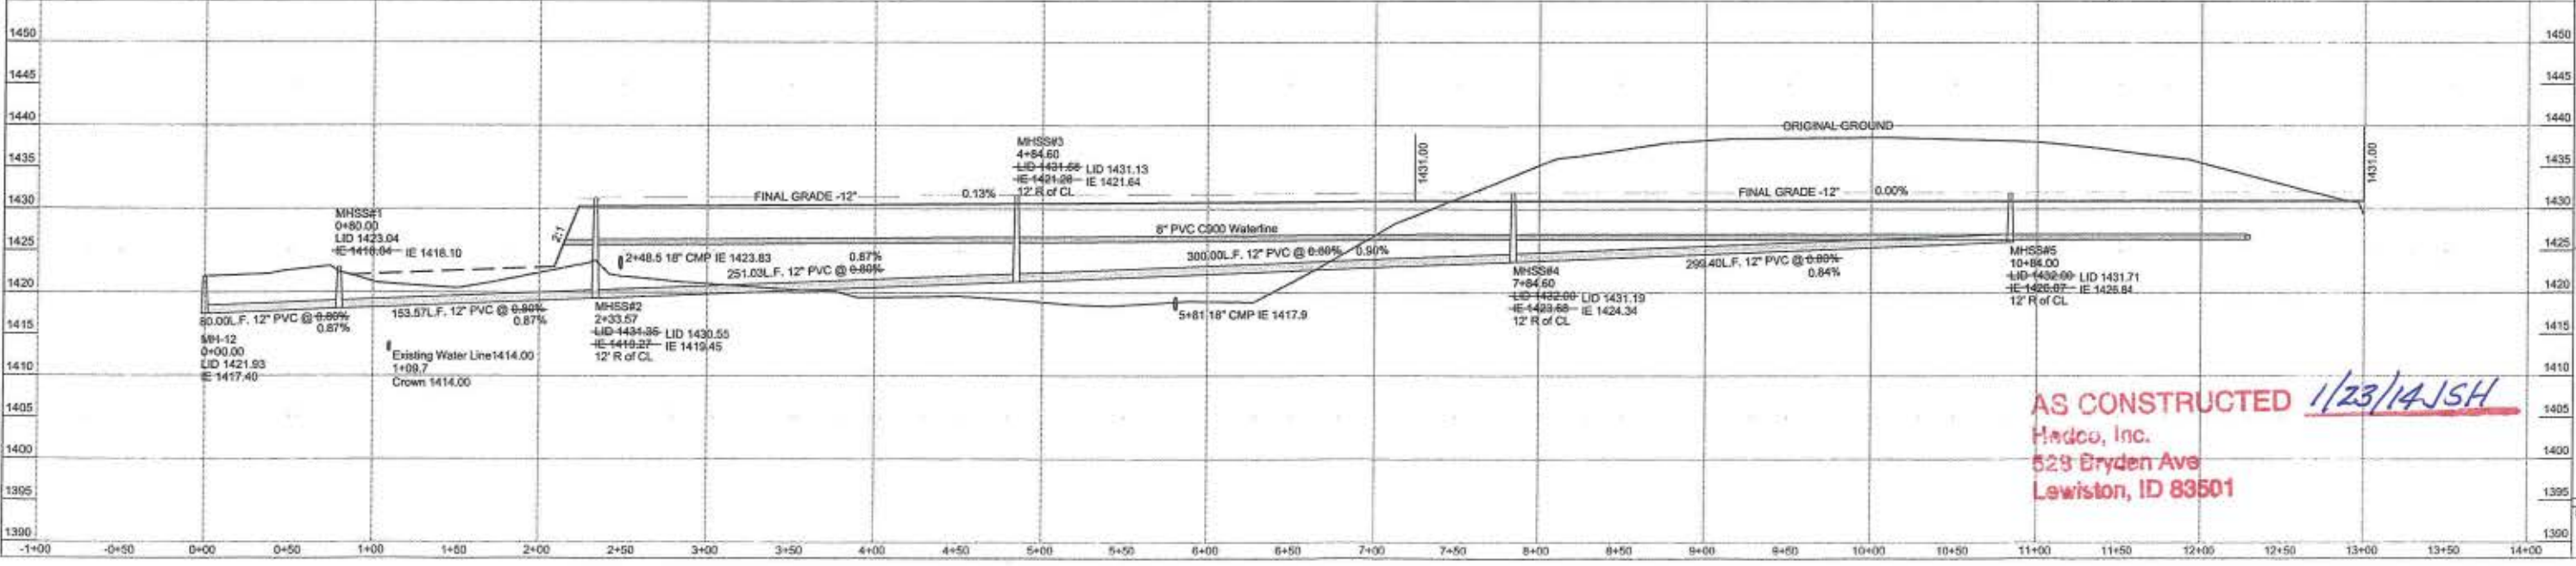
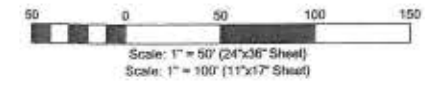


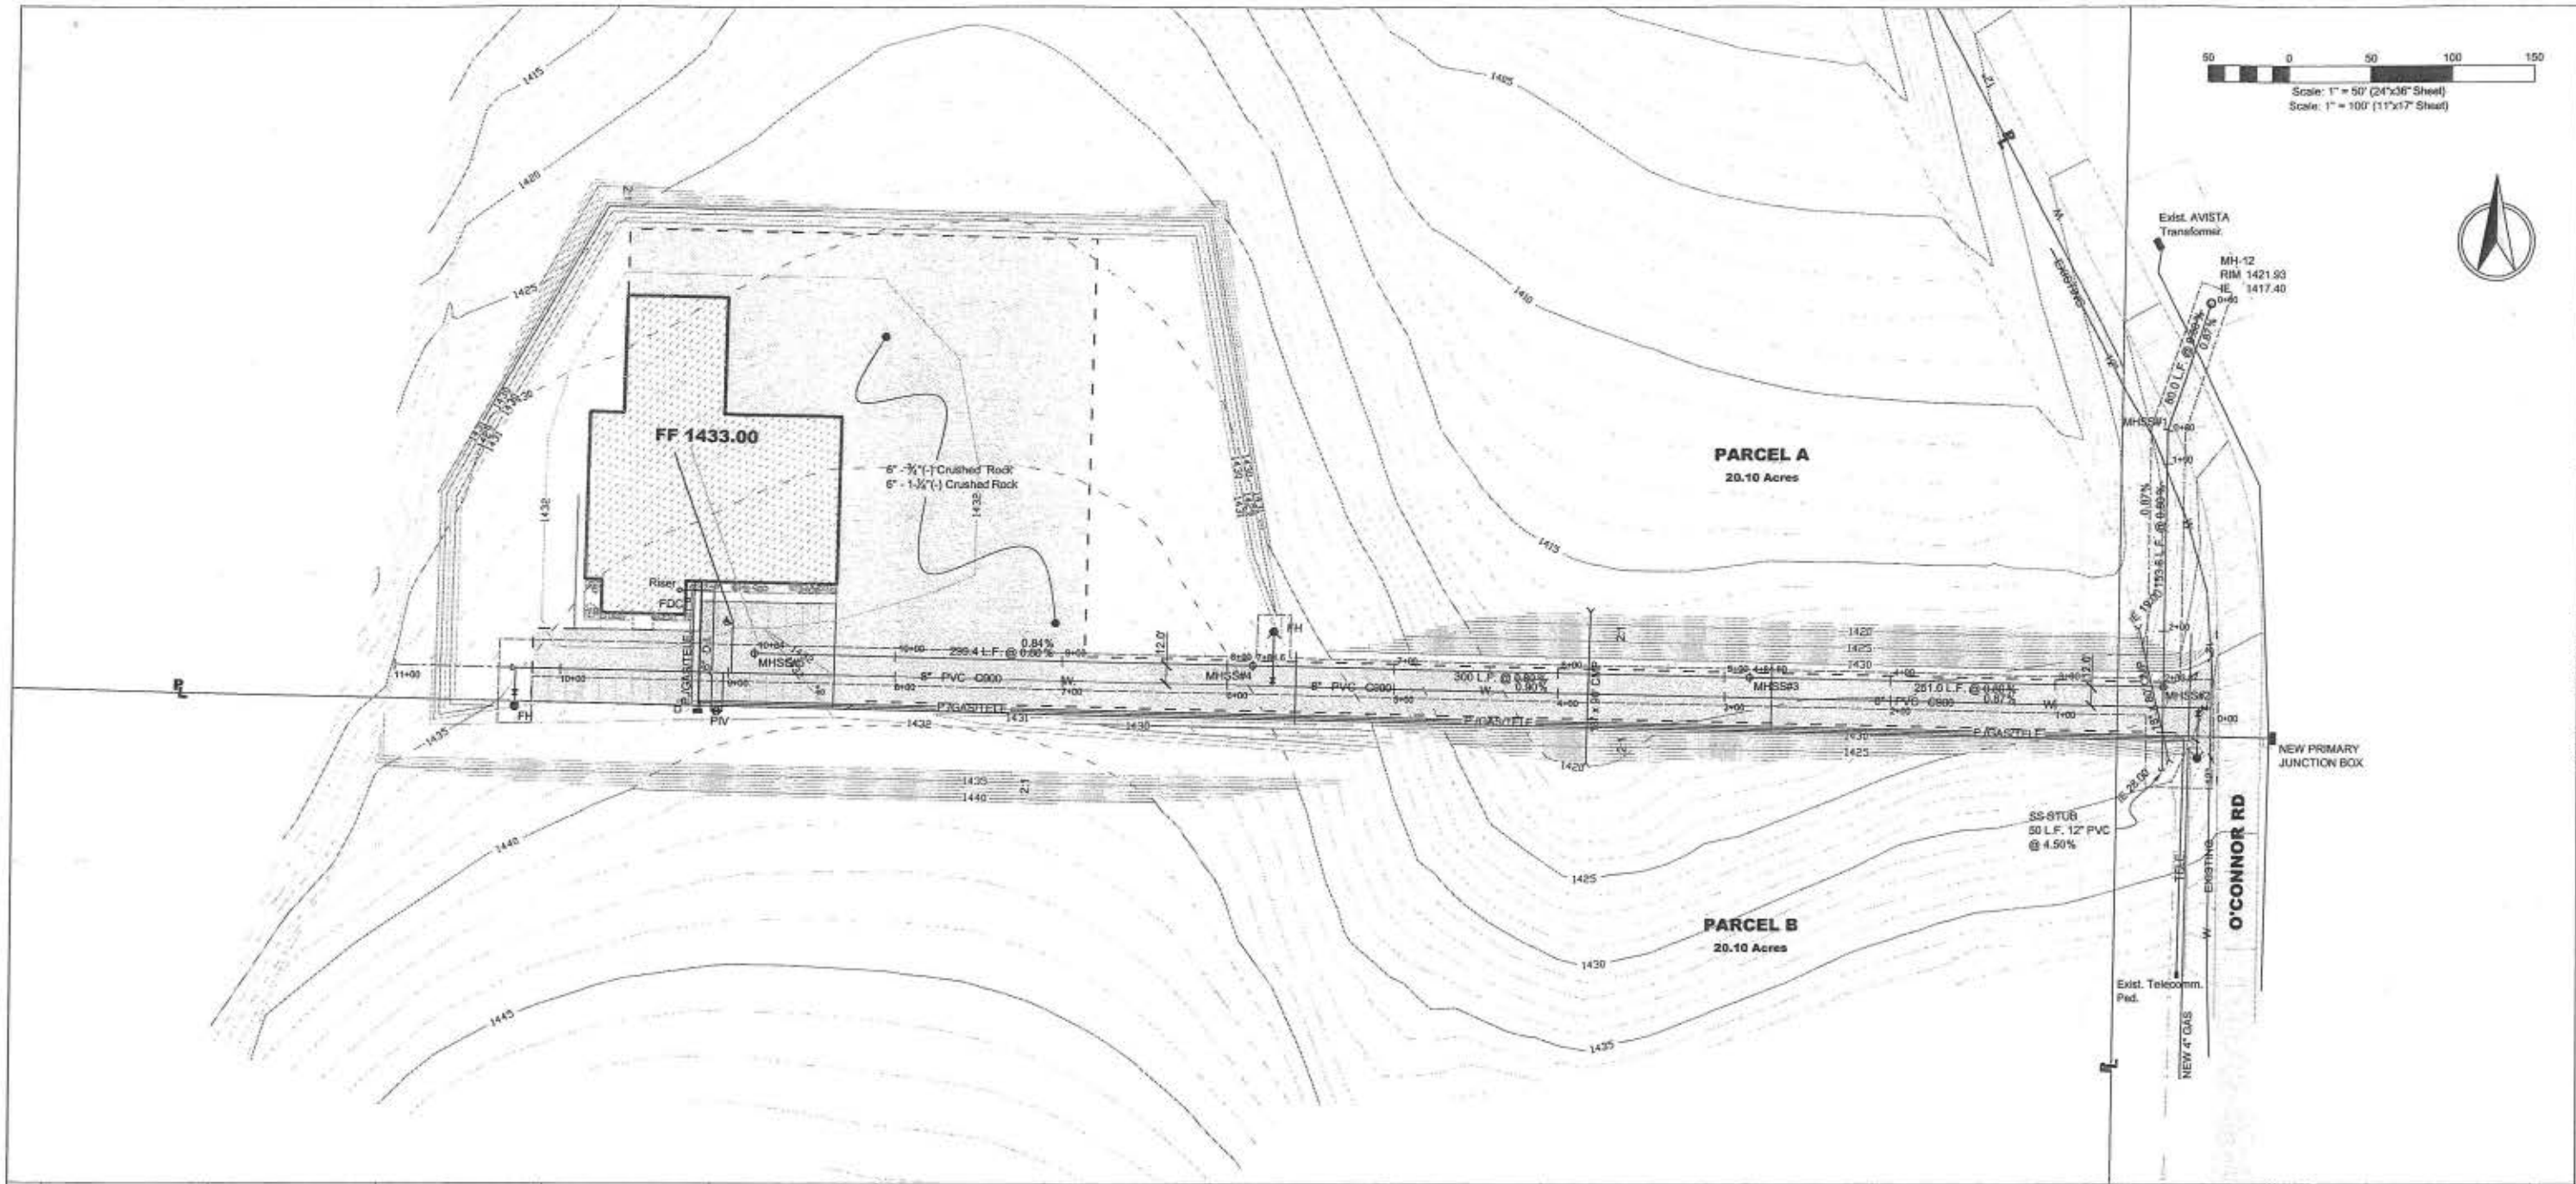

REVISION	DESCRIPTION	DATE	BY	CHECKED	APPD.
1	Final Flow and PVI location; moved west 100 ft. 24" x 36" sheet	10-15-13	JSH		
2	Utility & Stormwater Drainage Update	10-23-13	JSH		
3	AS-BUILT 20" x 36" sheet	1-17-14	JSH		

PROJECT NO.	1330-3
DATE	1/23/14
BY	JSH
CHECKED	JSH
APPD.	JSH

PROJECT NO.	1330-3
DATE	1/23/14
BY	JSH
CHECKED	JSH
APPD.	JSH

SEEKINS PRECISION, LLC
SANITARY SEWER PLAN & PROFILE
159 AMERICAN WAY
LEWISTON, IDAHO

HEDCO
 HAMMOND ENGINEERING & DESIGN, INC.
 508 BRYDEN AVENUE, LEWISTON, IDAHO 83501
 (208) 738-2422

AS CONSTRUCTED 1/23/14 JSH
 Hedco, Inc.
 529 Bryden Ave
 Lewiston, ID 83501