


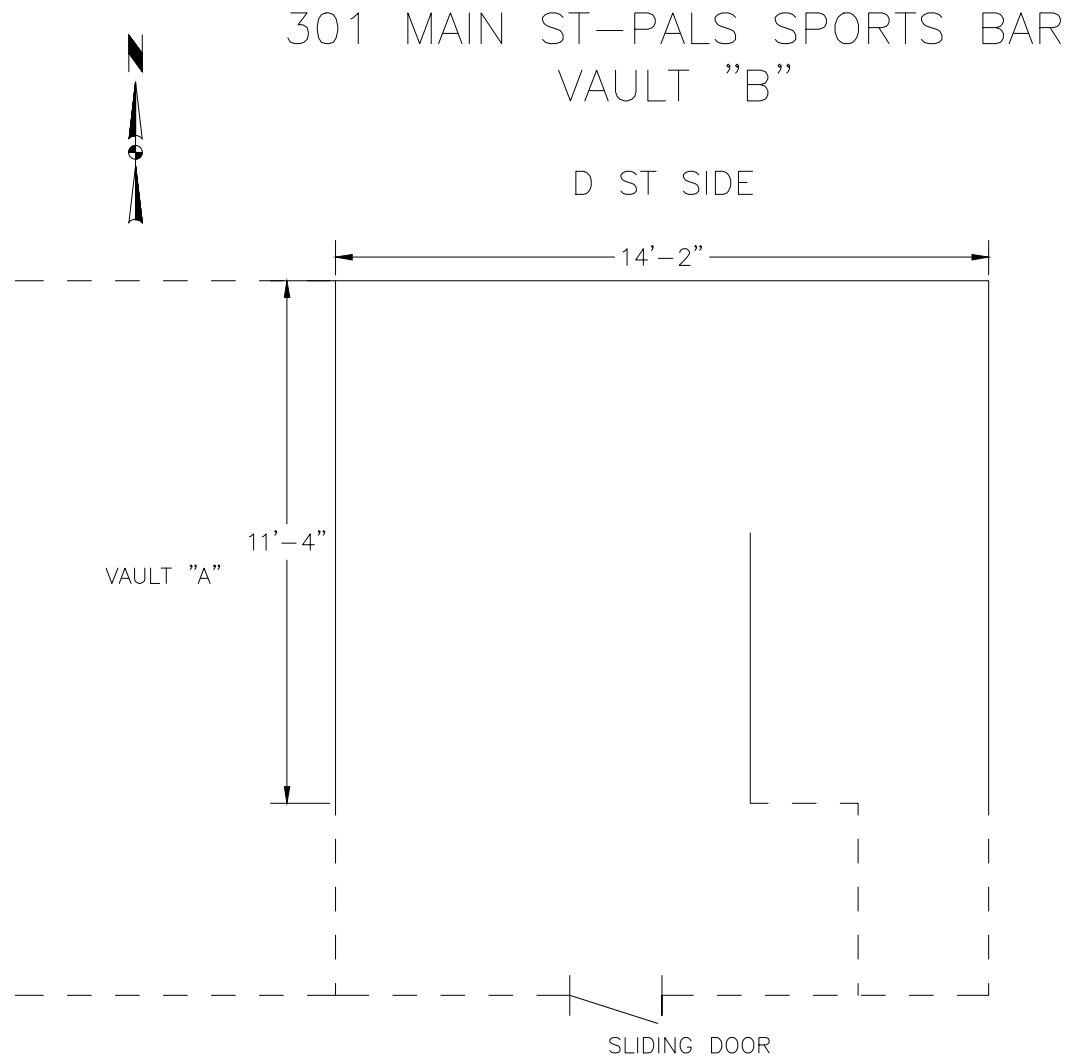

\*DIMENSIONS TAKEN ON SITE ARE APPROXIMATE

**LEWISTON DOWNTOWN VAULT INVENTORY**  
LEWISTON, IDAHO

**VAULT SCHEMATIC**



tdhengineering.com  
GREAT FALLS-BOZEMAN-KALISPELL-SHELBY MONTANA  
SPOKANE WASHINGTON  
LEWISTON IDAHO  
WATFORD CITY NORTH DAKOTA

|                |               |
|----------------|---------------|
| DRAWN BY:      | DLR           |
| DESIGNED BY:   |               |
| QUALITY CHECK: | JLB           |
| DATE:          | 08/18/16      |
| JOB NO.        | L16-028       |
| CAD NO.        | VAULT DRAWING |