


311 MAIN ST-BOJACKS VAULT "A"

D ST SIDE

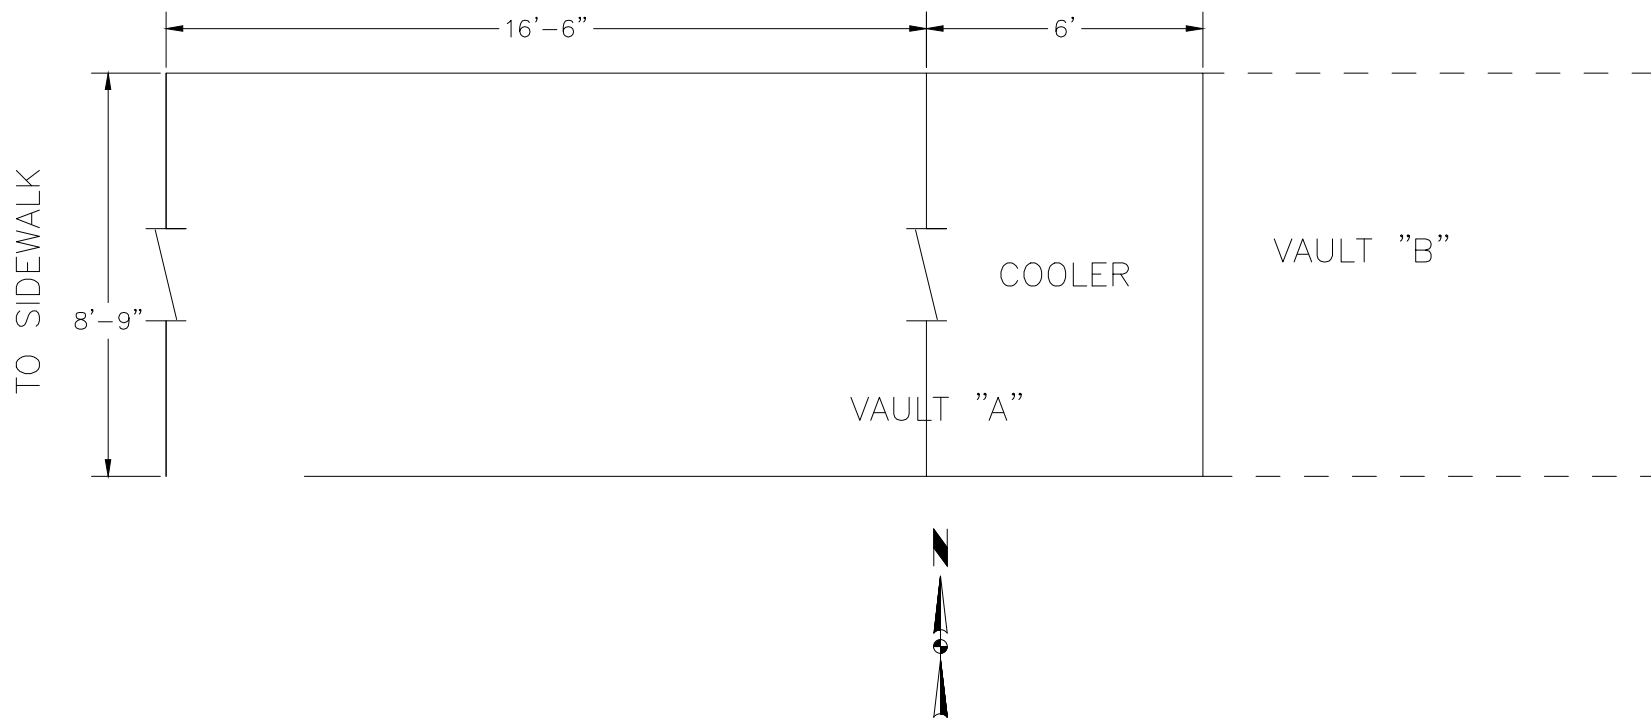

*DIMENSIONS TAKEN ON SITE ARE APPROXIMATE

LEWISTON DOWNTOWN VAULT INVENTORY
LEWISTON, IDAHO

VAULT SCHEMATIC



GREAT FALLS-BOZEMAN-KALISPELL-SHELBY
SPOKANE
LEWISTON
WATFORD CITY

tdhengineering.com

MONTANA
WASHINGTON
IDAHO
NORTH DAKOTA

DRAWN BY:	DLR
DESIGNED BY:	
QUALITY CHECK:	JLB
DATE:	08/18/16
JOB NO.	L16-028
CAD NO.	VAULT DRAWING