


# 311 MAIN ST-BOJACKS VAULT "B"

D ST SIDE

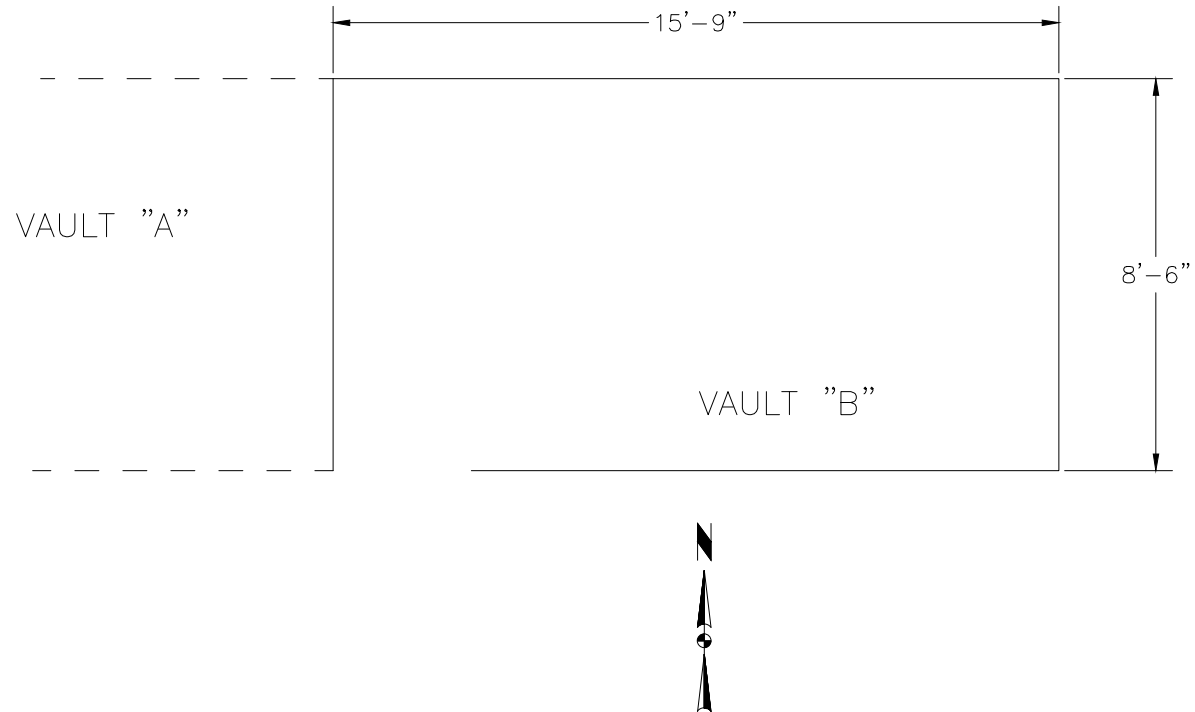

\*DIMENSIONS TAKEN ON SITE ARE APPROXIMATE

**LEWISTON DOWNTOWN VAULT INVENTORY**  
LEWISTON, IDAHO

**VAULT SCHEMATIC**



tdhengineering.com  
MONTANA  
WASHINGTON  
IDAHO  
NORTH DAKOTA

DRAWN BY:	DLR
DESIGNED BY:	
QUALITY CHECK:	JLB
DATE:	08/18/16
JOB NO.	L16-028
CAD NO.	VAULT DRAWING