


# 611 MAIN ST-LIBERTY THEATER

MAIN ST SIDE

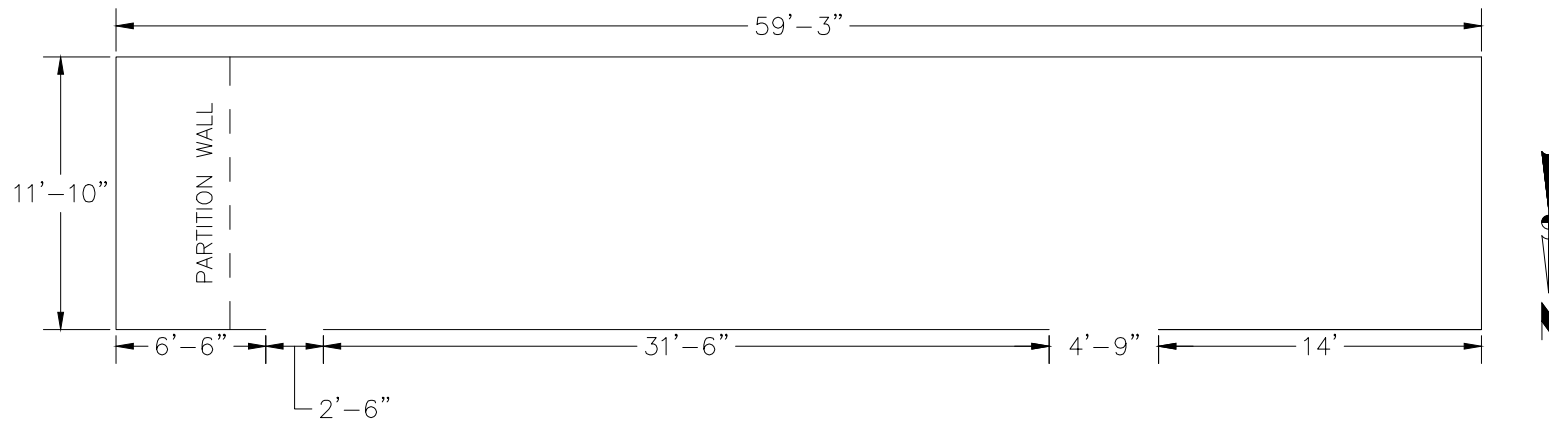

\*DIMENSIONS TAKEN ON SITE ARE APPROXIMATE

**LEWISTON DOWNTOWN VAULT INVENTORY**  
LEWISTON, IDAHO

**VAULT SCHEMATIC**



tdhengineering.com  
GREAT FALLS-BOZEMAN-KALISPELL-SHELBY MONTANA  
SPOKANE WASHINGTON  
LEWISTON IDAHO  
WATFORD CITY NORTH DAKOTA

DRAWN BY:	DLR
DESIGNED BY:	
QUALITY CHECK:	JLB
DATE:	08/18/16
JOB NO.	L16-028
CAD NO.	VAULT DRAWING