




800 MAIN ST—MILL END BUILDING  
VAULT "C"

MAIN ST SIDE

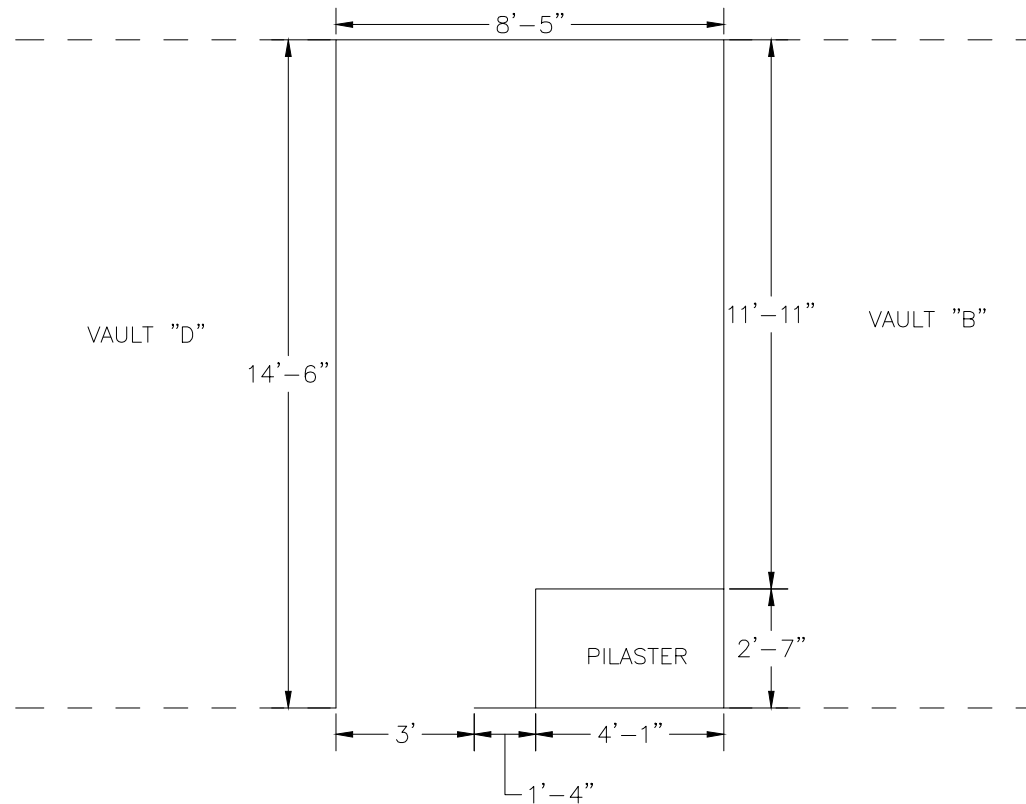

\*DIMENSIONS TAKEN ON SITE ARE APPROXIMATE

LEWISTON DOWNTOWN VAULT INVENTORY  
LEWISTON, IDAHO

VAULT SCHEMATIC



tdhengineering.com  
GREAT FALLS-BOZEMAN-KALISPELL-SHELBY  
SPOKANE  
LEWISTON  
WATFORD CITY  
MONTANA  
WASHINGTON  
IDAHO  
NORTH DAKOTA

DRAWN BY:	DLR
DESIGNED BY:	
QUALITY CHECK:	JLB
DATE:	08/18/16
JOB NO.	L16-028
CAD NO.	VAULT DRAWING