


832 MAIN ST-ART UNCORKED VAULT "A"

MAIN ST SIDE

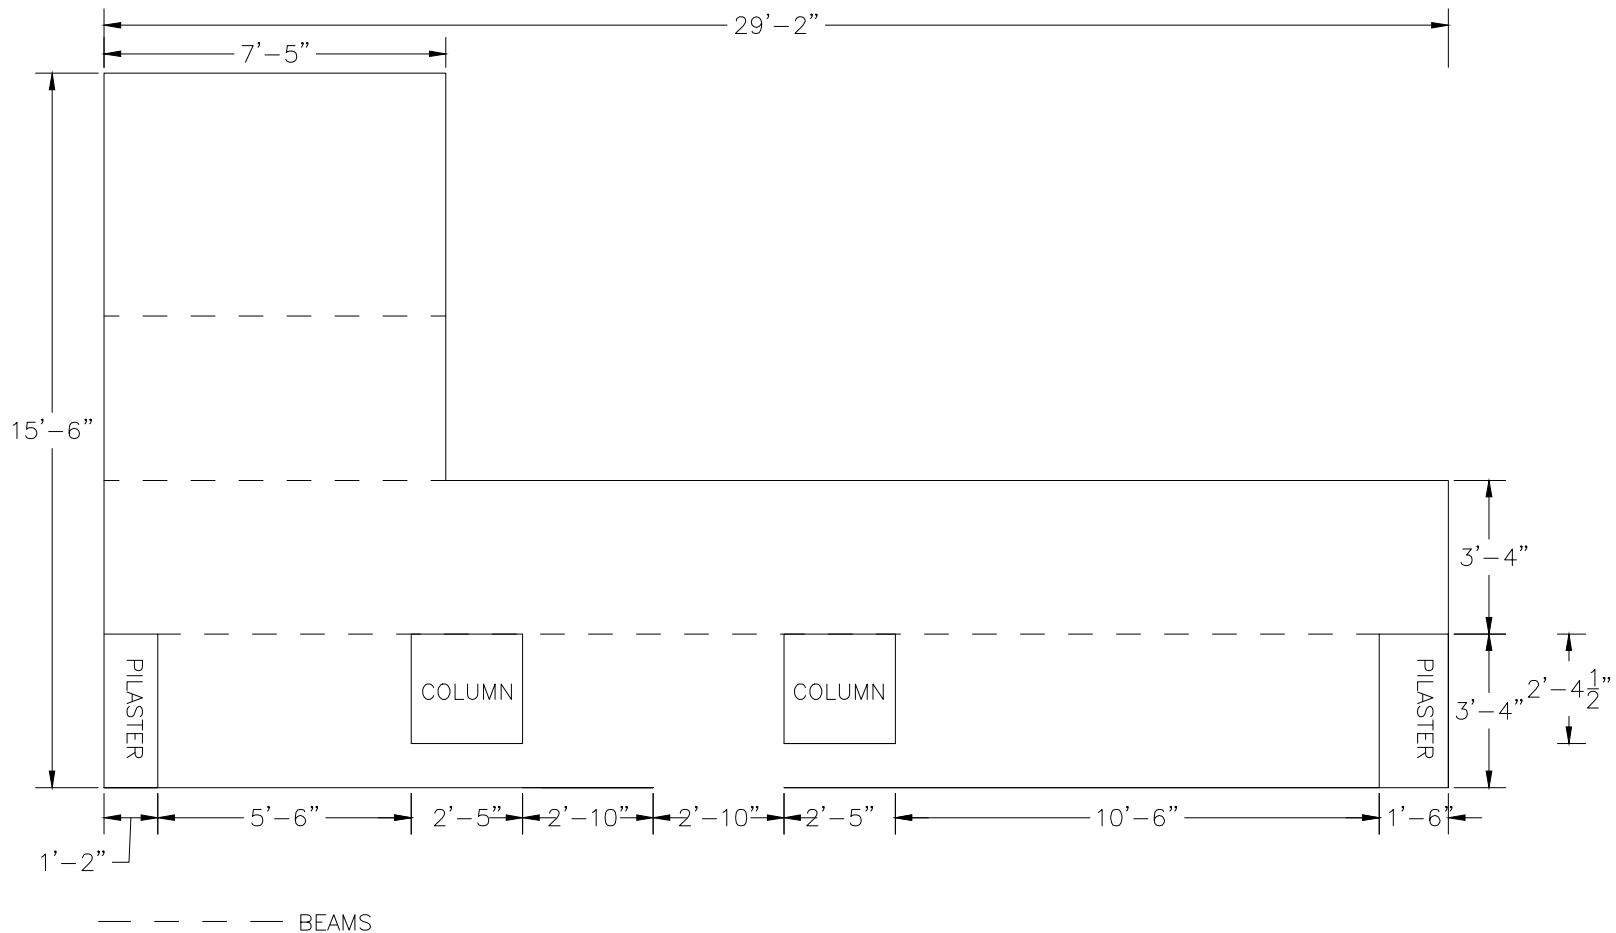

*DIMENSIONS TAKEN ON SITE ARE APPROXIMATE

LEWISTON DOWNTOWN VAULT INVENTORY
LEWISTON, IDAHO

VAULT SCHEMATIC



tdhengineering.com
GREAT FALLS-BOZEMAN-KALISPELL-SHELBY
SPOKANE
LEWISTON
WATFORD CITY
MONTANA
WASHINGTON
IDAHO
NORTH DAKOTA

DRAWN BY:	DLR
DESIGNED BY:	
QUALITY CHECK:	JLB
DATE:	08/18/16
JOB NO.	L16-028
CAD NO.	VAULT DRAWING