


846 MAIN ST-ZEN READINGS

MAIN ST SIDE

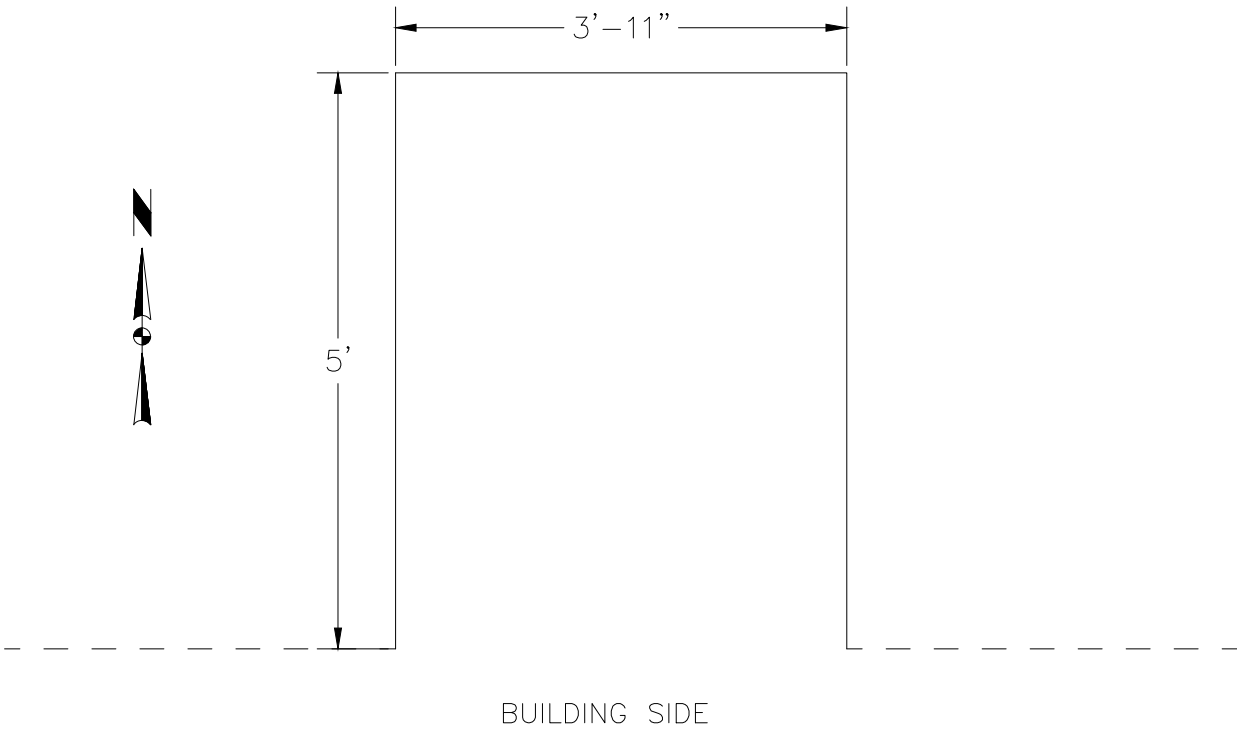

\*DIMENSIONS TAKEN ON SITE ARE APPROXIMATE

LEWISTON DOWNTOWN VAULT INVENTORY LEWISTON, IDAHO	
VAULT SCHEMATIC	

**TD&H**  
Engineering

GREAT FALLS-BOZEMAN-KALISPELL-SHELBY  
SPOKANE  
LEWISTON  
WATFORD CITY

MONTANA  
WASHINGTON  
IDAHO  
NORTH DAKOTA

tdhengineering.com

DRAWN BY:	DLR
DESIGNED BY:	
QUALITY CHECK:	JLB
DATE:	08/18/16
JOB NO.	L16-028
CAD NO.	VAULT DRAWING