

CONTACTS:

AVISTA:
TODD ELLSWORTH -509-495-2773

CENTURY LINK:
JULIO MENDEZ- 208-798-8390

CABLE ONE:
DAN SMITH -208-791-5031

X O COMMUNICATIONS:
STEVE STYERN – 509-444-8547

AVISTA	#
DIST. POLES	6
TXM. POLES	0
CONDUITS	0
ANCHORS	0
MGN'S	5

A copy of this document and attachments must be provided to the crew installing the cable and hardware along with accompanying audit noting additional requirements. This paperwork must be in possession of the crew doing the work and made available to any Avista employee on demand. Applicant shall obtain, from public authorities and private owners of real property any and all permits or easements required for lawful exercise of the permission granted by this approved application. Applicant shall defend Avista from all claims and injuries, as to the applicants right to be on Avista facilities. This route application is approved based on noted conditions. All Make Ready (MR) costs shall be at the requestors expense unless stated otherwise. Any field changes to the design must be noted by your construction foreman on an asbuilt drawing and sent to Avista Joint Use Dept no later than two weeks after construction is complete.

APPROVED
By Todd Ellsworth at 7:10 am, Oct 16, 2017

Signed copies of the Avista Make Ready cost approval and the joint use make ready signoff sheets must be submitted to Avista Joint Use Department prior to construction. All make ready work needed to ensure attachment of new facilities at the heights called out in this document must be completed prior to construction of new attachments.

Drawing Name:Port of Lewiston		Drawn By: Ron Glessner 10-02-17		REV.	Revised	10-13-17	RG	Contact Information		State: ID County:Nez Perce City:Lewiston	
1024 F ST PACIFIC CABINETS				REV.	DESCRIPTION	DATE	BY	Port of Lewiston Dave Doeringsfeld 208-743-5531 Outside Plant Maintenance,llc Ron Glessner208-661-5648		Section: Township: Range: Legal:	
				REV.	DESCRIPTION	DATE	BY				
SIZE	FSCMNO	DWG NO	REV	REV.	DESCRIPTION	DATE	BY				
SCALE		SHEET 1		REV.	DESCRIPTION	DATE	BY				



GENERAL CONSTRUCTION NOTES

CONTRACTOR IS RESPONSIBLE FOR ALL PERMITS EXCEPT STATE HWY., COUNTY ROAD,RAILROAD OR WATER CROSSINGS.

RESTORATION OF ALL RIGHT OF WAY GROUND WILL BE RESTORED TO ORIGINAL CONDITION OR BETTER.

CONTRACTOR WILL COORDINATE WITH OSP MANAGER 24 HRS. PRIOR TO BEGINNING CONSTRUCTION.

OSP MANAGER WILL CONTACT BUILDING OWNER/TENANT 24 HRS. PRIOR TO BEGINNING CONSTRUCTION TO COORDINATE ACCESS TO BUILDINGS.


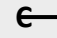



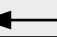
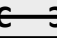
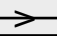





CONTRACTOR IS RESPONSIBLE FOR CALLING LOCATES AND IS RESPONSIBLE FOR REPAIR AND RESTORATION OF DAMAGED UTILITIES.

FOLLOW ALL NESC CONSTRUCTION GUIDELINES.

CONTRACTOR WILL HAVE ON SITE THE APPROVED DRAWINGS FROM THE UTILITY AND OR STATE,COUNTY,CITY,RAILROAD.

CONTRACTOR WILL PROVIDE CONDUIT , HAND HOLES , ANCHORS, AERIAL HARDWARE , LOCATE WIRE

PORT OF LEWISTON (POL) WILL PROVIDE , FIBER OPTIC CABLE , AERIAL MARKERS , AND LINE ROUTE MARKERS.

	JOINT USE POLE
	EXISTING ANCHOR
	AERIAL CABLE
	BURIED CABLE
	NEW ANCHOR
	SIDEWALK ANCHOR
	FIBER SLACK LOOP
	OVERHEAD GUY
	ATTACH TO POLE GROUND
	CABLE CHANGE
	BURIED ROUTE MARKER
	EXISTING HAND HOLE
	NEW HAND HOLE


APPROVED
By Todd Ellsworth at 7:10 am, Oct 16, 2017

Drawing Name:Port of Lewiston	Drawn By:Ron Glessner 10-03-17				REV.	Revised	10-13-17	RG	Contact Information	State:ID. County:Nez Perce City: Lewiston
	1024 F ST. PACIFIC CABINETS				REV.	DESCRIPTION	DATE	BY		
	SIZE	FSCMNO	DWG NO	REV	REV.	DESCRIPTION	DATE	BY	Port of Lewiston Dave Doeringsfeld 208-743-5531 Outside Plant Maintenance,llc Ron Glessner208-661-5648	Section: Township: Range: Legal:
	SCALE	No scale		SHEET 2	REV.	DESCRIPTION	DATE	BY		




	CULVERT
	DIRECTIONAL BORE
	AERIAL CABLE
	BURIED CABLE
	NEW ANCHOR
	SIDEWALK ANCHOR
	EXISTING ANCHOR
	OVERHEAD GUY
	ATTACH TO POLE GROUND
	FIBER SLACK LOOP
	JOINT USE POLE
	CABLE CHANGE
	BURIED ROUTE MARKER
	EXISTING HAND HOLE
	NEW HAND HOLE

AVISTA	#
DIST. POLES	6
TXM. POLES	0
CONDUITS	0
ANCHORS	0
MGN'S	5

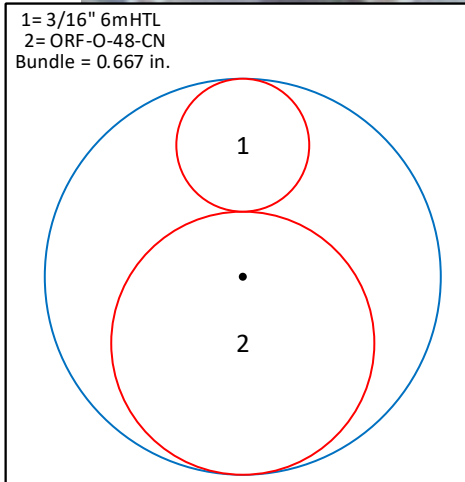

(1) AERIAL 48 STRAND SINGLE MODE FIBER OPTIC CABLE ON 3/16" EHS MESSENGER BUNDLE= 0.667in. Weight= .171 lb/ft

PLACE AERIAL MARKER AT EACH POLE

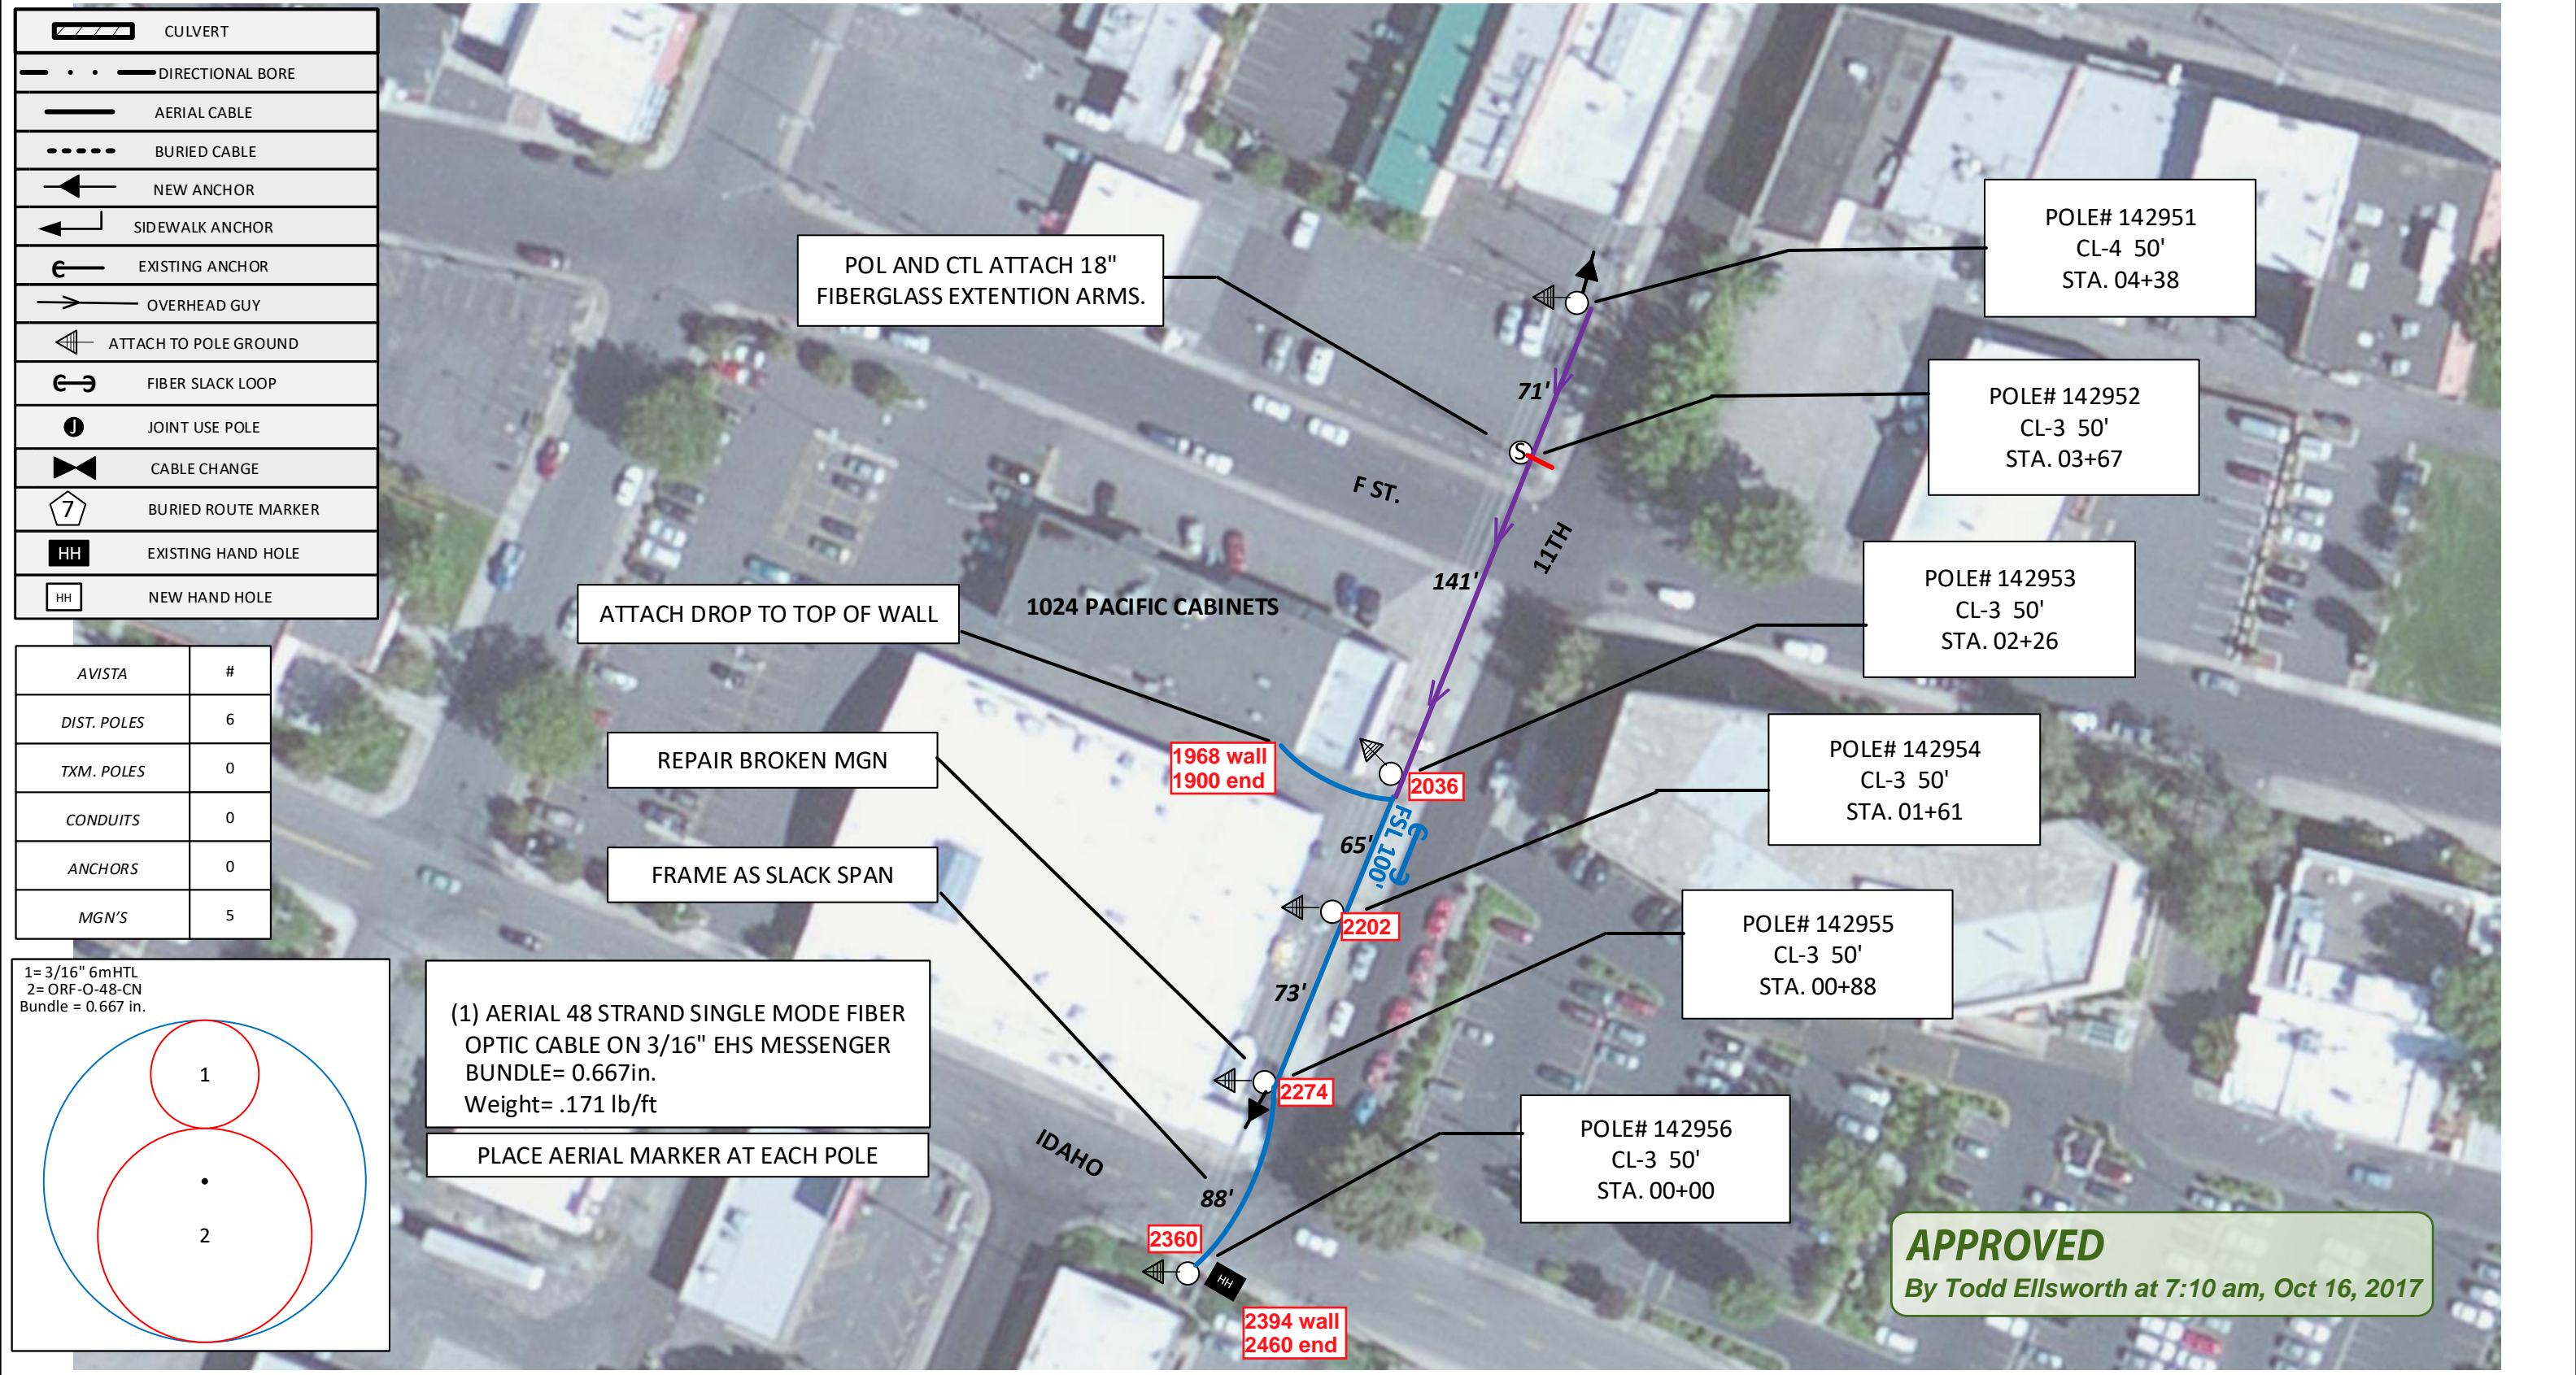

APPROVED
By Todd Ellsworth at 7:10 am, Oct 16, 2017

Drawing Name: Port of Lewiston			
SIZE	FSCMNO	DWG NO	REV
SCALE		SHEET 3	

Drawn By: Ron Glessner 10-03-17			
1024 F ST. PACIFIC CABINETS			
SIZE	FSCMNO	DWG NO	REV
SCALE		SHEET 3	




REV.	Revised	10-13-17	RG
REV.	DESCRIPTION	DATE	BY
REV.	DESCRIPTION	DATE	BY
REV.	DESCRIPTION	DATE	BY
REV.	DESCRIPTION	DATE	BY

Contact Information
Port of Lewiston
Dave Doeringsfeld
208-743-5531
Outside Plant Maintenance, llc
Ron Glessner 208-661-5648

State: ID
County: Nez Perce
City: Lewiston

Section:
Township:
Range:
Legal:



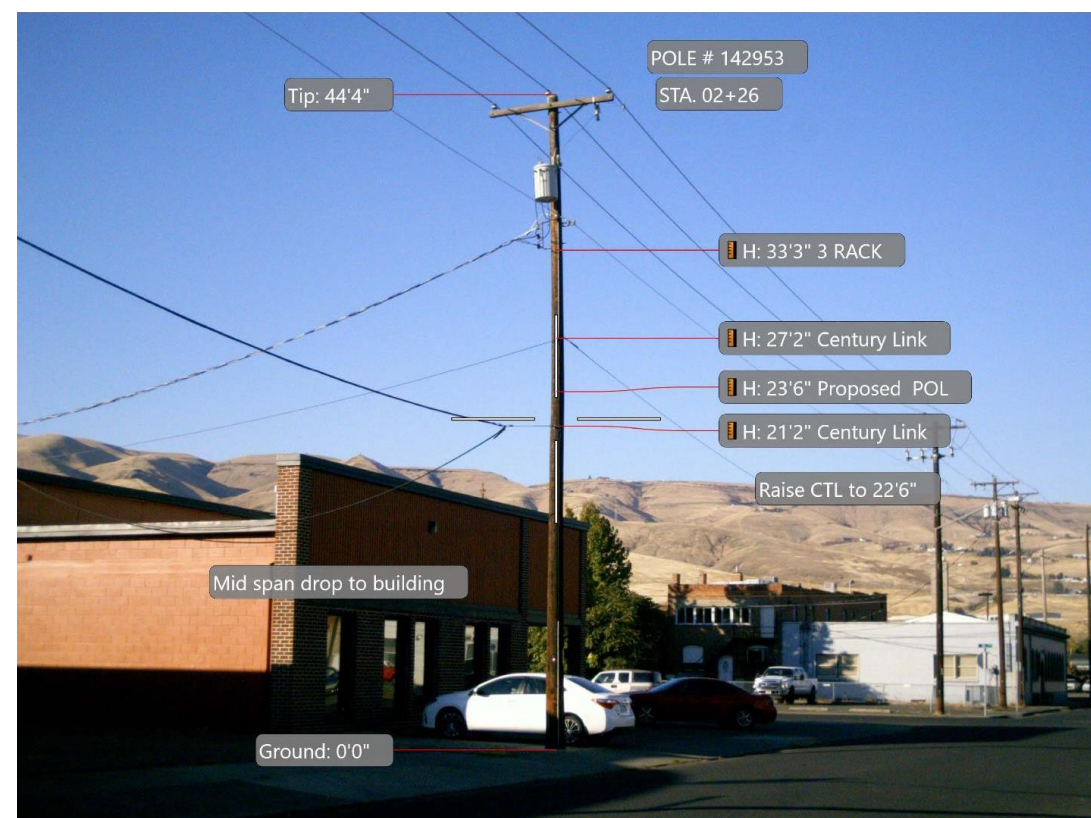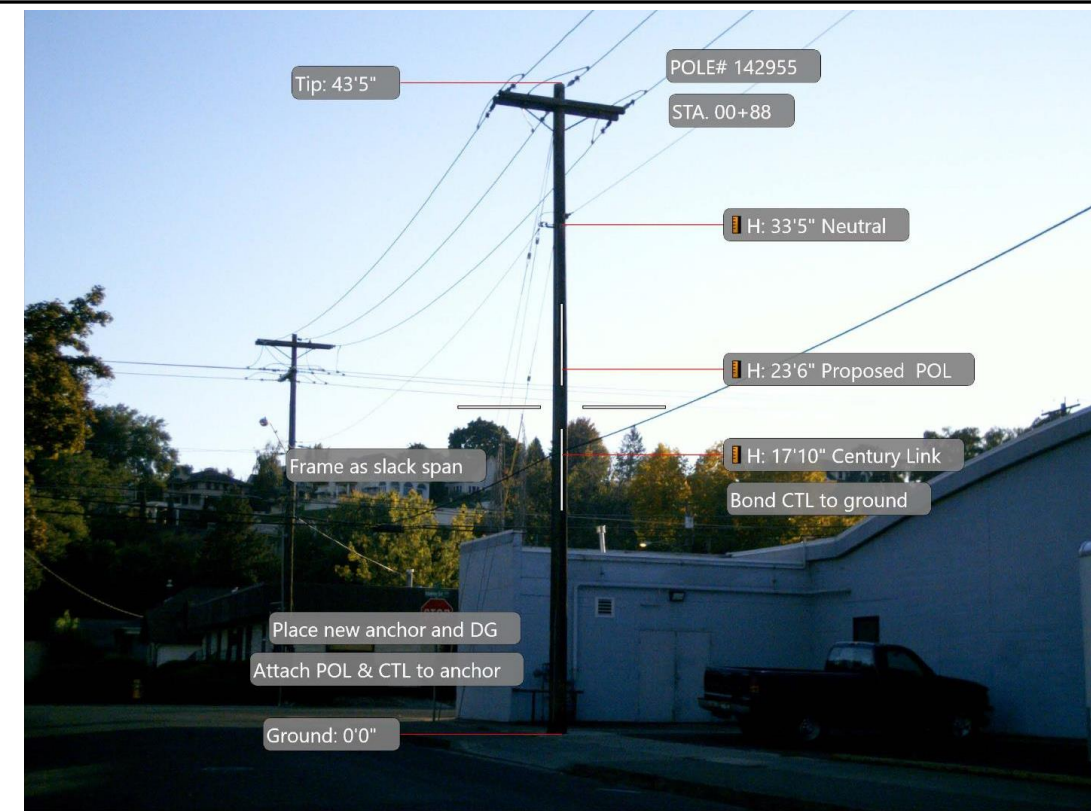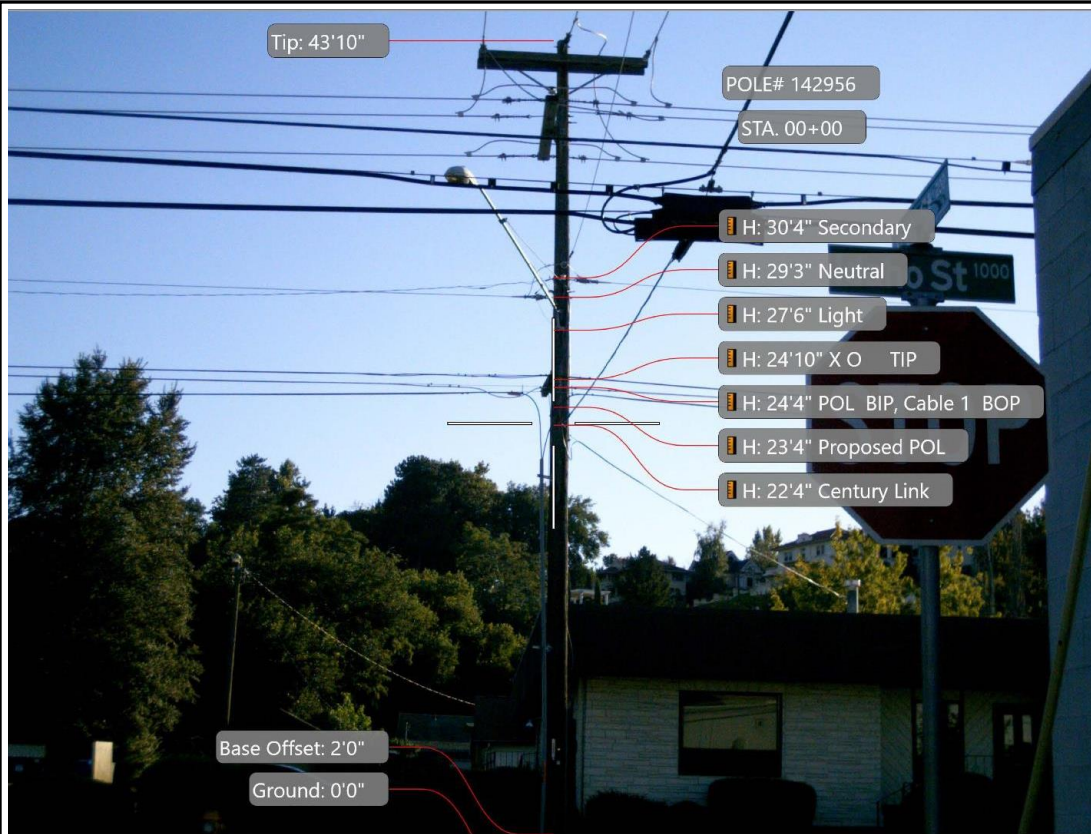

APPROVED
By Todd Ellsworth at 7:10 am, Oct 16, 2017

Drawing Name: Port of Lewiston		Drawn By: Ron Glessner 10-03-17	
1024 F ST. PACIFIC CABINETS			
SIZE	FSCMNO	DWG NO	REV
SCALE		SHEET 4	

REV.	REVISED	10-13-17	RG
REV.	DESCRIPTION	DATE	BY
REV.	DESCRIPTION	DATE	BY
REV.	DESCRIPTION	DATE	BY
REV.	DESCRIPTION	DATE	BY


Contact Information

Port of Lewiston
Dave Doeringsfeld
208-743-5531
Outside Plant Maintenance, llc
Ron Glessner 208-661-5648


State: ID
County: Nez Perce
City: Lewiston

Section:
Township:
Range:
Legal:



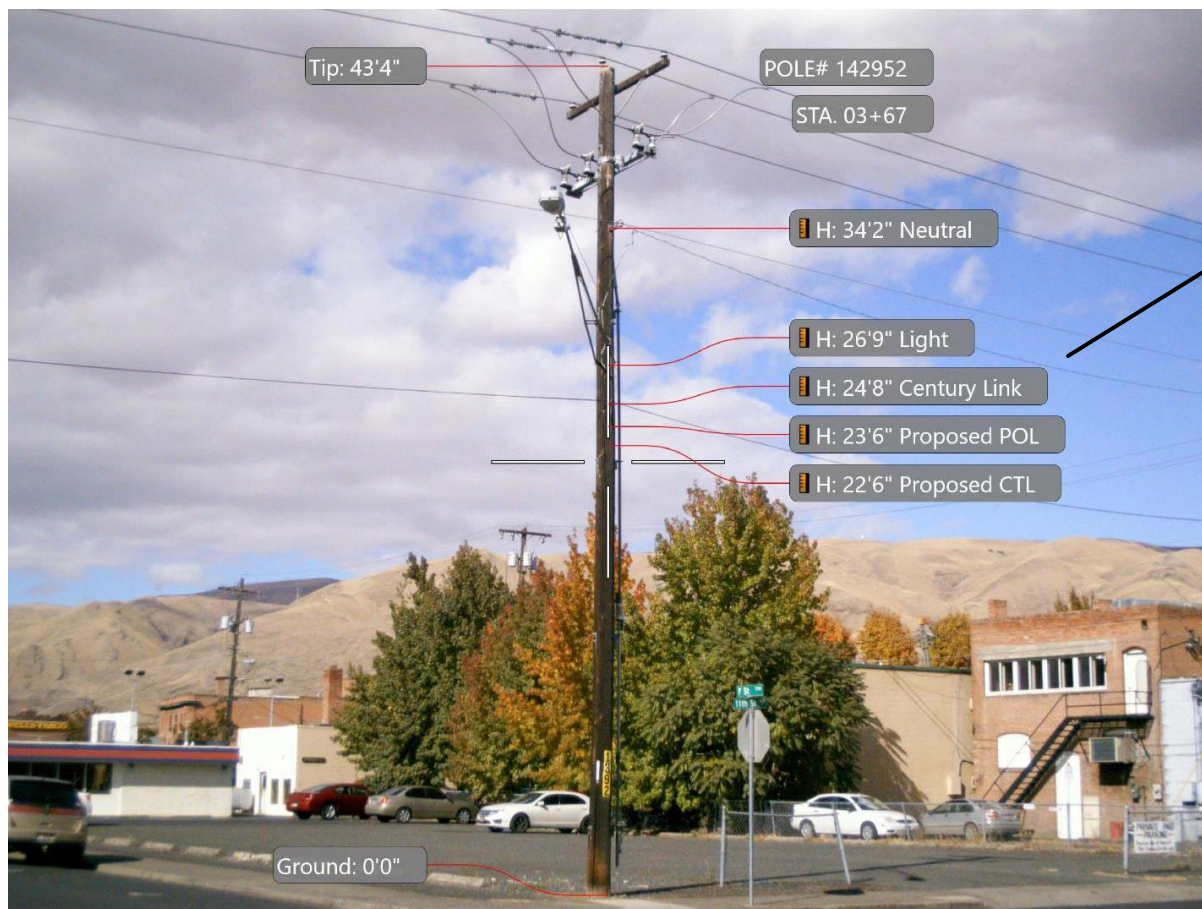

POL AND CTL ATTACH 18" FIBERGLASS EXTENTION ARMS.

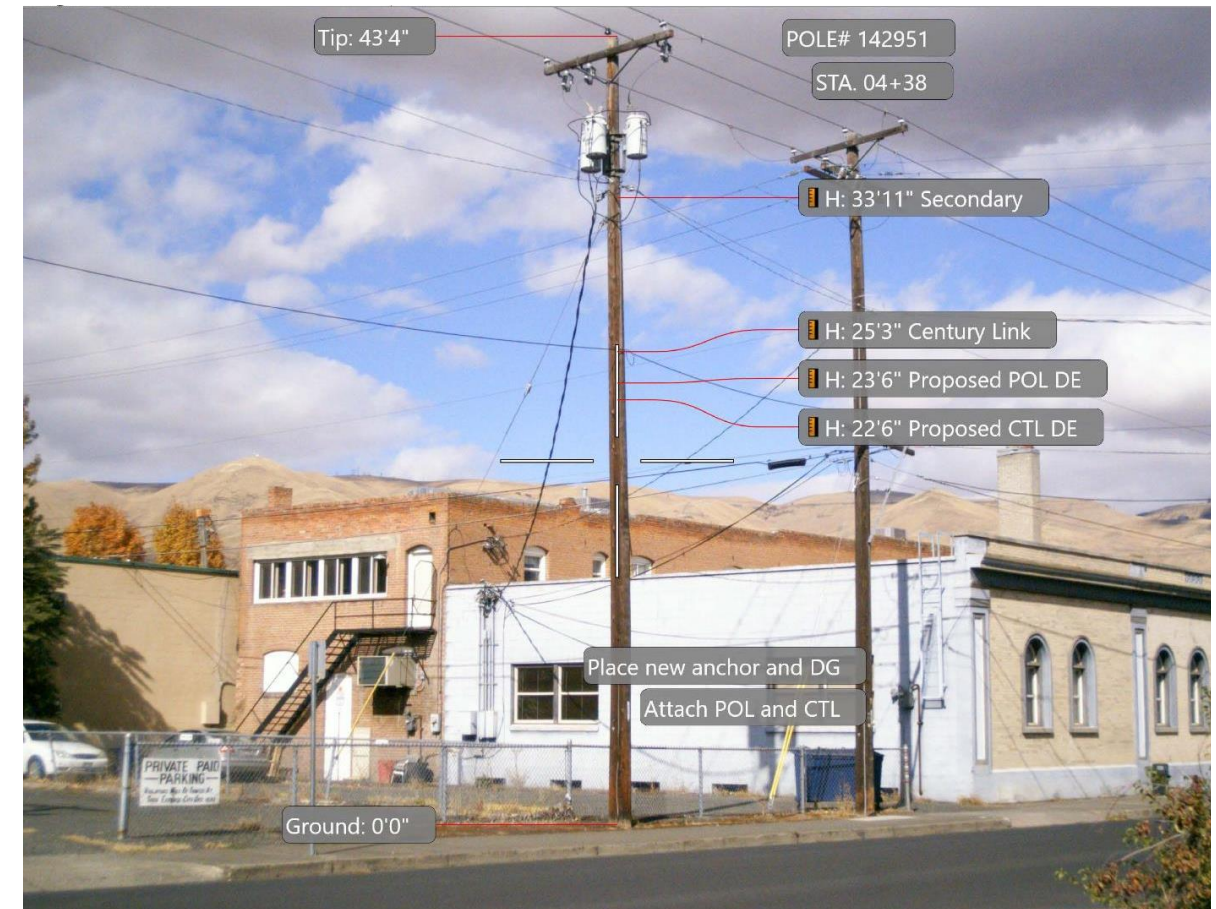

APPROVED
By Todd Ellsworth at 7:10 am, Oct 16, 2017


Drawing Name: Port of Lewiston	Drawn By: Ron Glessner 10-03-17				REV.	Revised	10-13-17	RG	Contact Information Port of Lewiston Dave Doeringsfeld 208-743-5531 Outside Plant Maintenance, llc Ron Glessner 208-661-5648	State: ID County: Nez Perce City: Lewiston
	1024 F ST. PACIFIC CABINETS				REV.	DESCRIPTION	DATE	BY		
	SIZE	FSCM NO	DWG NO	REV	REV.	DESCRIPTION	DATE	BY	Section: Township: Range: Legal:	
	SCALE		SHEET 5		REV.	DESCRIPTION	DATE	BY		





STA. 00+00
POLE#142956

ROUTE NEW CABLE THROUGH EXISTING RISER.
LEAVE 50' SLACK IN EXISTING HH

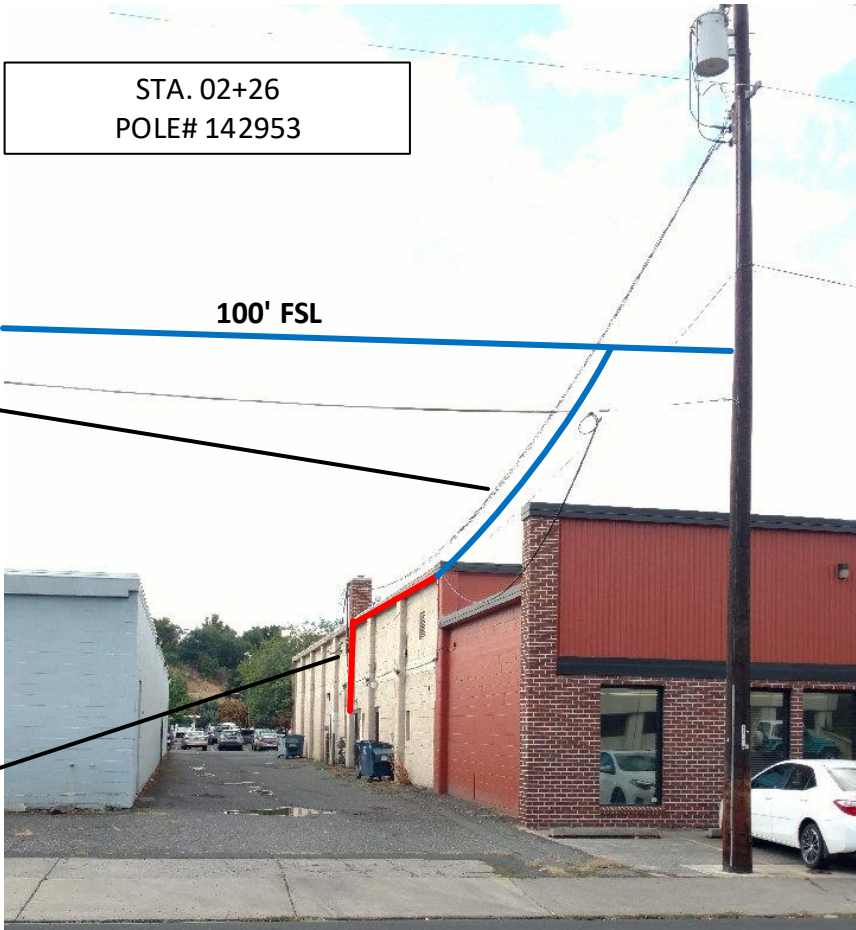

STA. 02+26
POLE# 142953

MAINTAIN MIN. 30" SEPERATION FROM SERVICE.

100' FSL

ATTACH DROP TO TOP OF WALL.
ROUTE CABLE ALONG BUILDING IN 1 1/4" SCH.40 PVC

APPROVED
By Todd Ellsworth at 7:10 am, Oct 16, 2017

Drawing Name: Port of Lewiston		Drawn By: Ron Glessner 10-03-17			
1024 F ST. PACIFIC CABINETS					
SIZE	FSCMNO	DWG NO		REV	
SCALE		SHEET 6			

REV.	Revised	10-13-17	RG
REV.	DESCRIPTION	DATE	BY
REV.	DESCRIPTION	DATE	BY
REV.	DESCRIPTION	DATE	BY
REV.	DESCRIPTION	DATE	BY

Contact Information

Port of Lewiston
Dave Doeringsfeld
208-743-5531
Outside Plant Maintenance, llc
Ron Glessner 208-661-5648

State: ID
County: Nez Perce
City: Lewiston

Section:
Township:
Range:
Legal:



Make Ready Summary	
Cable One	
Stationing	Description of work

Make Ready Summary	
Century Link	
Stationing	Description of Work
00+88	Attach down guy to anchor
02+26	Raise HOA from 21'2" to 22'6"
02+26	Attach messenger at 22'6"
03+67	Attach messenger at 22'6"
04+38	Attach messenger at 22'6"
04+38	Attach down guy to anchor

Make Ready Summary	
X O Communications	
Stationing	Description of Work

Make Ready Summary	
Avista	
Stationing	Description of Work
00+88	Repair broken MGN

Make Ready Summary	
Lewiston School District	
Stationing	Description of Work

APPROVED
By Todd Ellsworth at 7:10 am, Oct 16, 2017

Drawing Name:Port of Lewiston	10-13-17								Contact Information	State:ID County:Nez Perce City:Lewiston	
	1024 F ST. LEWISTON									Section: Township: Range: Legal:	
	SIZE	FSCM NO	DWG NO	REV	REV.	DESCRIPTION	DATE	BY	Port of Lewiston Dave Doeringsfeld 208-743-5531 Outside Plant Maintenanc,Ilc Ron Glessner208-661-5648		
	SCALE			SHEET 7	REV.	DESCRIPTION	DATE	BY			

