

#RPL10090000090

N50°54'25"E 281.90'

S39°05'35"E 406.66'


N39°05'35"W 547.55'

#RPL02440010010

ADVANCED HEALTH CARE

0020

□ = OUTFALL CURB

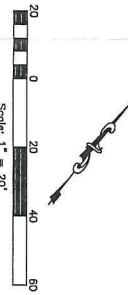

AS-BUILT: 1/22/2018

PROPOSED SITE PLAN

C4

**Advanced Health Care of Lewiston**  
 Lot 1 & Partial Lot 2, B & T Park Addition  
 Lewiston, ID 83501

**Boyer Lewiston SNF, L.C.**  
 Project: 101 South 200 East, Suite 200  
 Salt Lake City, UT 84111

date: 16 March 2016  
 project no.: 09.0240

OWNER



STAMP

The analysis shown and described herein including graphic representations & models thereof, are prepared by a person duly licensed and are not to be construed as a guarantee of results or as a representation of the actual results to be achieved. The design is based on the information provided by the client and is not to be construed as a representation of the actual results to be achieved. The design is based on the information provided by the client and is not to be construed as a representation of the actual results to be achieved.

**black PARTNERS**



**RA Reeve & Associates, Inc.**  
 820 CHAMBERS STREET, SUITE 14,  
 COSENT, UTAH 84403  
 TEL: (801) 521-2855  
 FAX: (801) 521-2855  
 WWW.RA-REEVE.COM

PROJECT NUMBER: 022234  
 DRAWN BY: JRP  
 ENGINEER: JRP