


NOTES
1. Franchise Utilities: All franchise utility lines to be in same trench with Power, as shown.

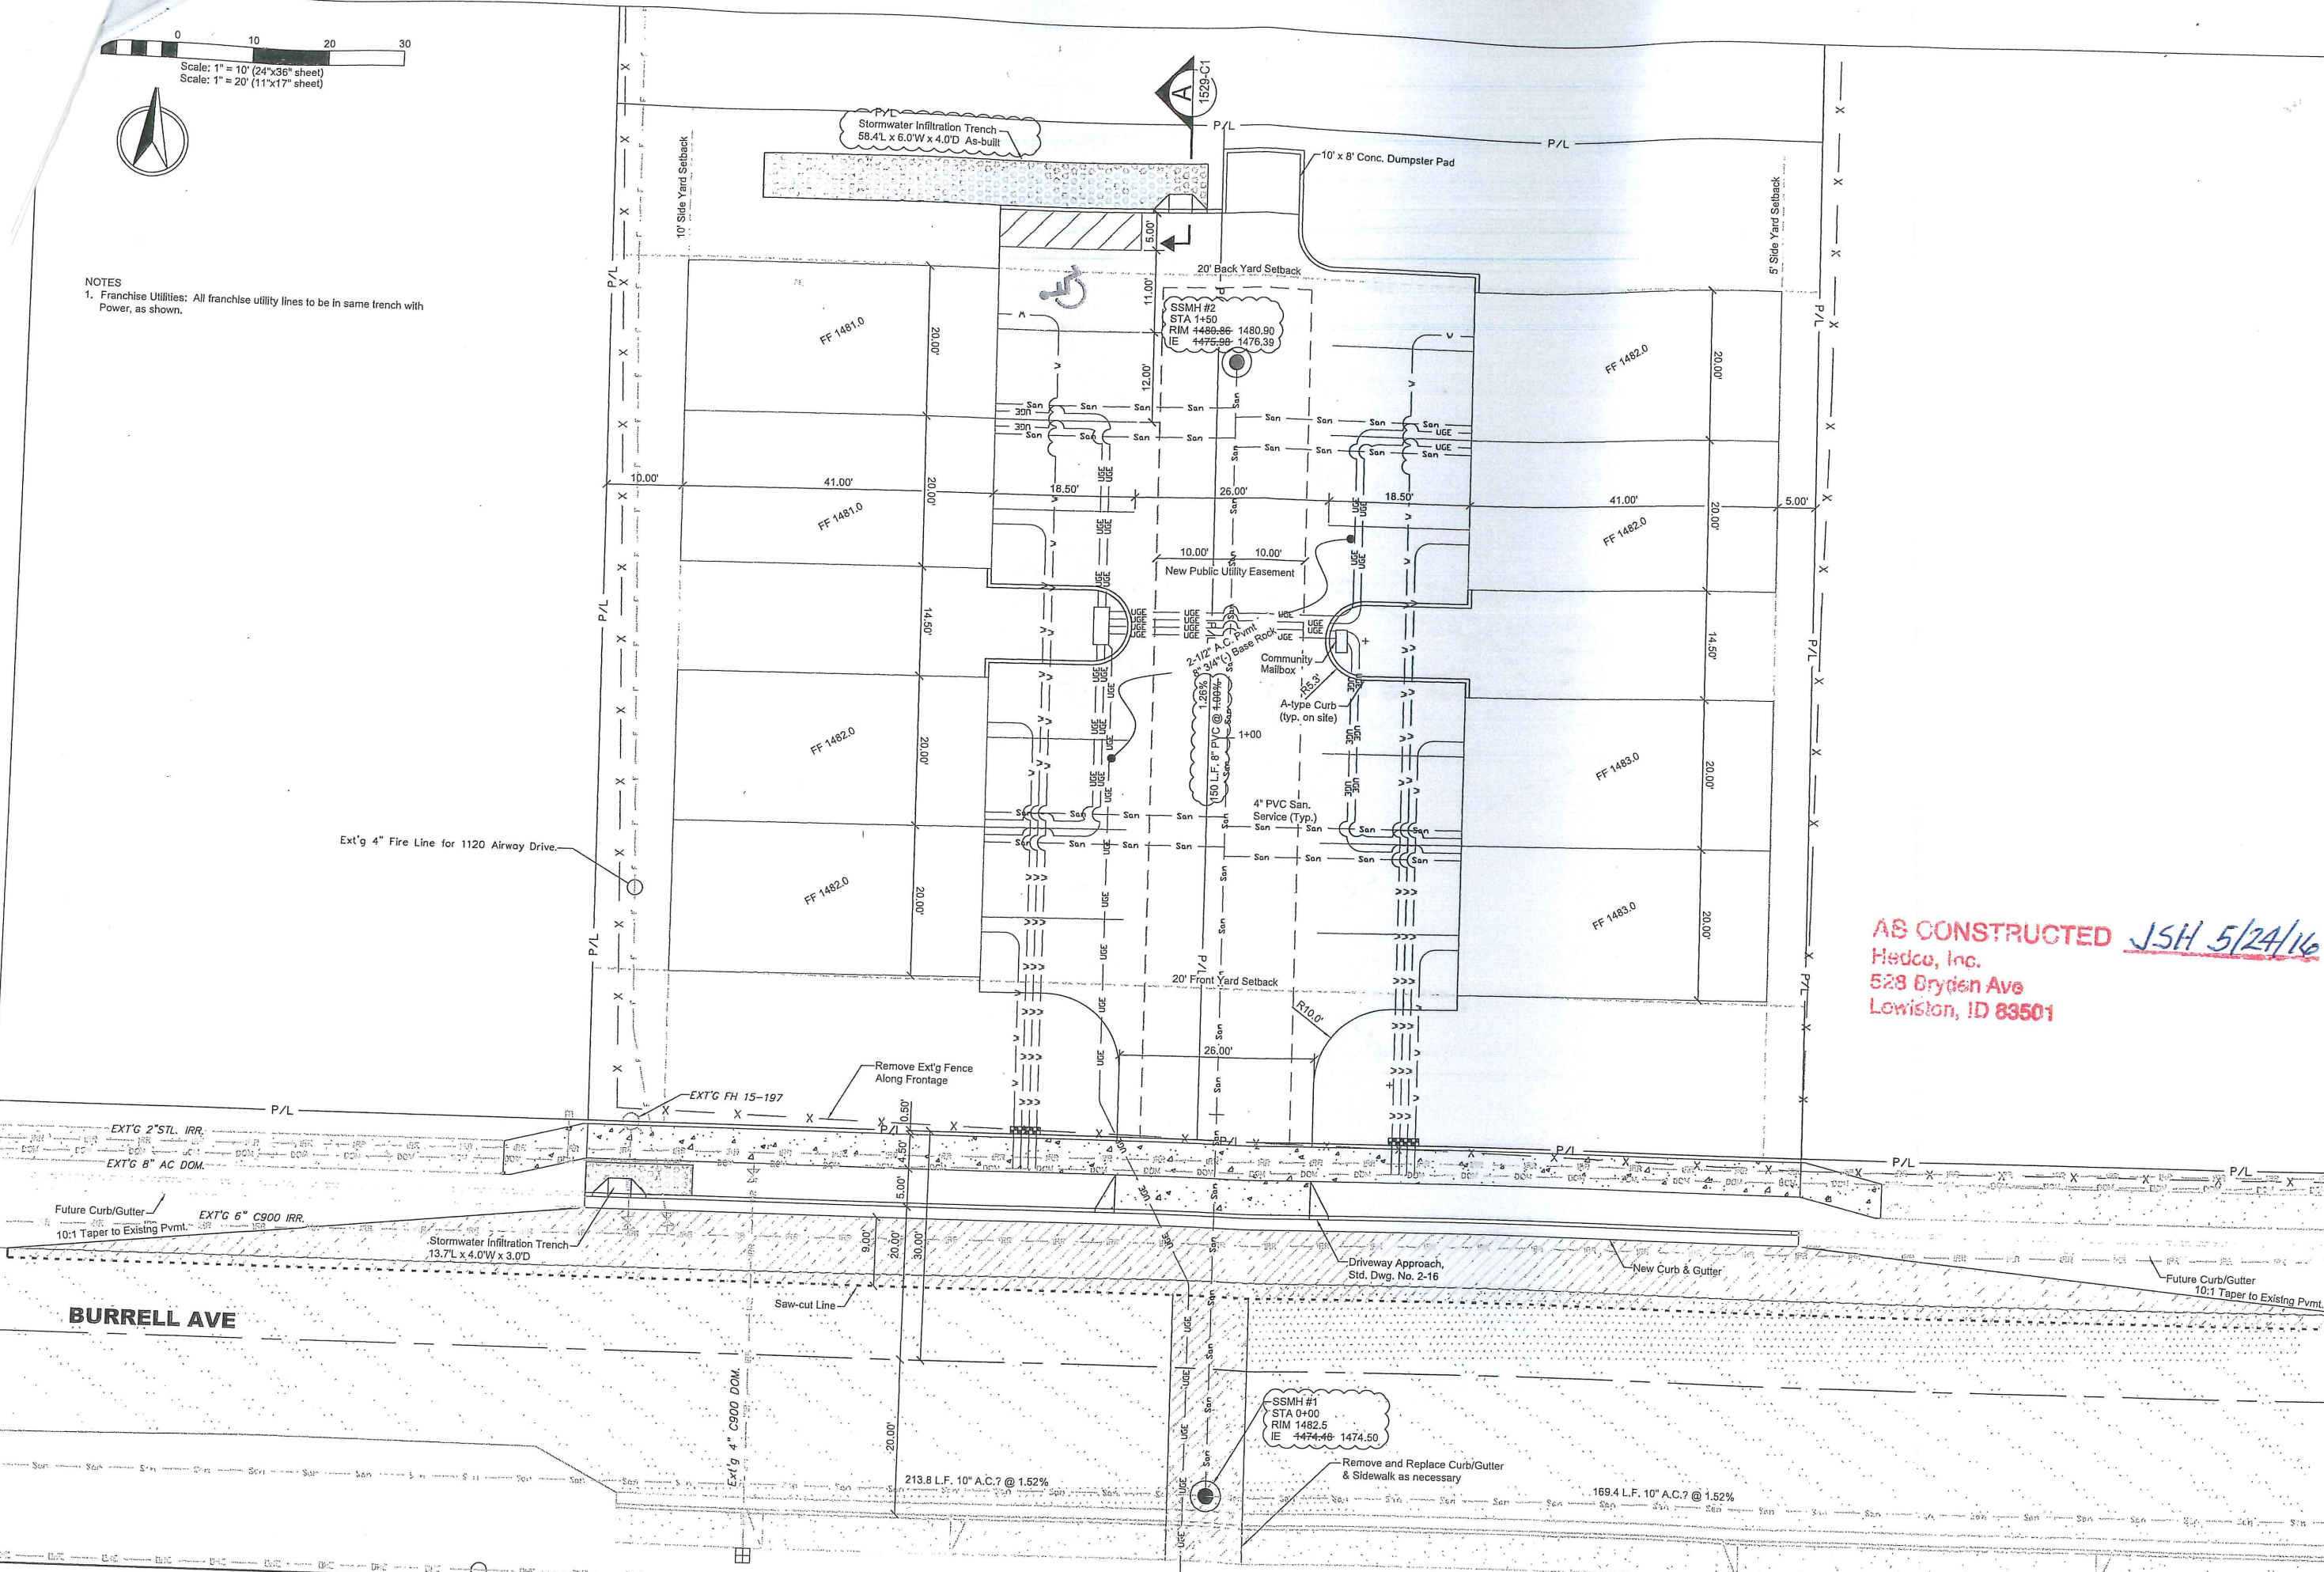


AS CONSTRUCTED JSH 5/24/16
Hedco, Inc.
528 Bryden Ave
Lewiston, ID 83501

BLUM - BURRELL AVENUE
SITE DEVELOPMENT PLAN
LEWISTON, IDAHO



HAMMOND ENGINEERING & DEVELOPMENT CO.
528 BRYDEN AVENUE LEWISTON, IDAHO 83501
(208) 796-5422

REV	DATE	DESCRIPTION	CHECKED	APPD.
A	01-15-16	Revised as per City Review Comments dated 01-11-16; Electrical layout		
B	05-24-16	As-built info.		

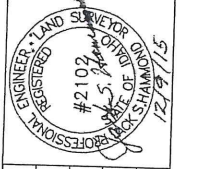

SCALE	SHEET SIZE	DRAWN BY	CHECKED BY	DATE	SHEET	DRAWING #
1"=10'	D	MEE	JSH	12-09-15	1529	C3

1529-C3