


WELL NO. 7
WELL COMPLETION (WR059)(IFB-21-014)
JUNE 2021
VOLUME III OF III
PLANS




CITY OF LEWISTON
NEZ PERCE COUNTY, IDAHO

1134 F ST. Add. 2
215 D STREET, STE B
LEWISTON, IDAHO 83501
PHONE: 208-746-1316
FAX: 888-397-8634

CITY OF LEWISTON	
PUBLIC WORKS DEPARTMENT.....	(208) 746-1316
STREETS/TRAFFIC.....	(208) 791-2311
WASTEWATER (CITY).....	(208) 791-0986
WATER (CITY).....	(208) 790-1712
WATER (LOID).....	(208) 746-8235
AVISTA UTILITIES.....	(208) 798-1473
SPARKLIGHT.....	(208) 746-3325
LUMEN.....	(208) 798-8380
DIGLINE.....	811
SHERIFF.....	911 or (208) 799-3131
AMBULANCE.....	911
FIRE DEPARTMENT(LEWISTON FIRE DEPARTMENT).....	911 or (208) 743-3554
IDAHO DEPARTMENT OF ENVIRONMENTAL QUALITY	
(NICOLAS HIEBERT, P.E.).....	(208) 799-4370

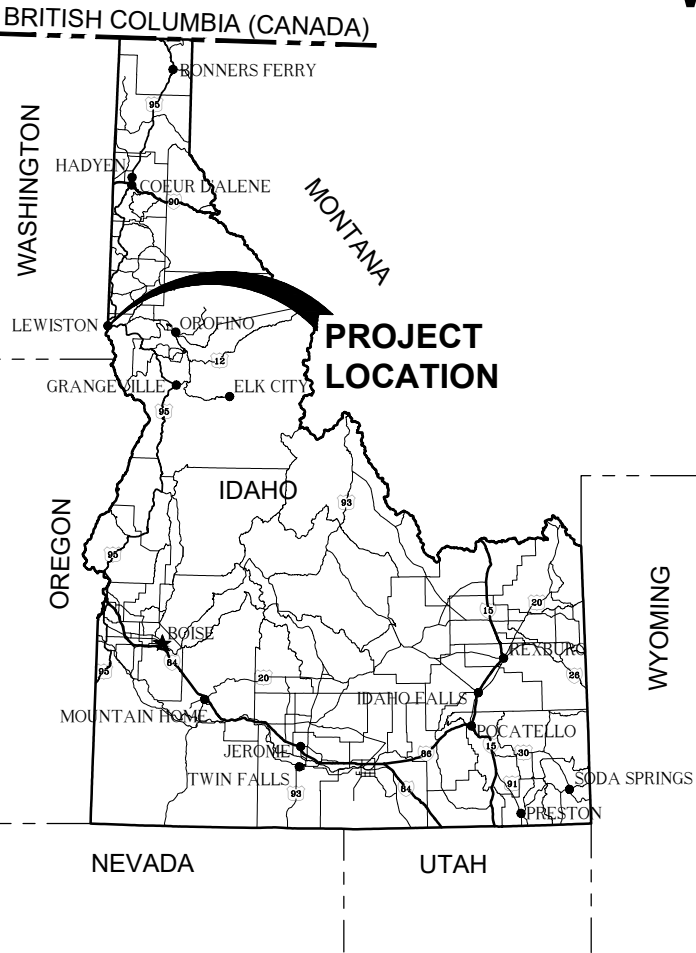



LOCATION MAP
NOT TO SCALE

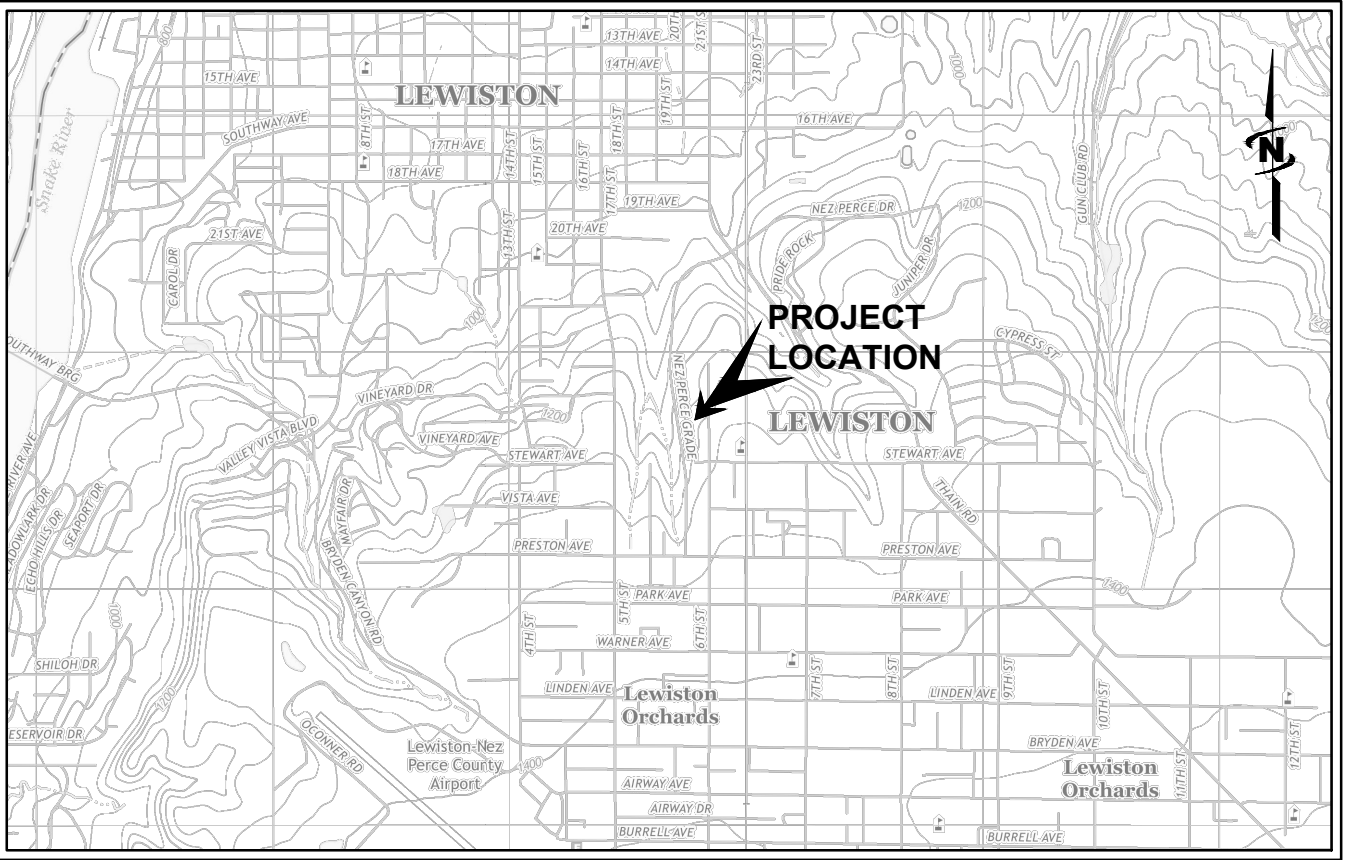

AREA MAP
PROJECT NO 21-20-007

MARK-UP LEGEND:
ORANGE - ITEMS MODIFIED DURING BIDDING IN ADDENDUM
BLUE - RECORD DRAWING CLARIFYING NOTE
RED - RECORD DRAWING ADDITION
GREEN - RECORD DRAWING DELETION

RECORD DRAWINGS:
These record documents have been prepared based on information gathered during field observations as well as information provided by others. The accuracy or completeness of information provided by others has not been verified by J-U-B. If these record drawings are a public record, J-U-B grants the public entity with jurisdiction the right to copy and disseminate the hard copy or digital image to those who legitimately request the information in writing. Any release, use, or reuse by the public entity, any individual, or organization, shall be at the public entity's, individual's, and/or organization's sole risk and without liability or legal exposure to J-U-B.
Any seals of the registrants included hereon represent that the drafting of the record drawing information was completed by staff under the registrants' responsible charge.

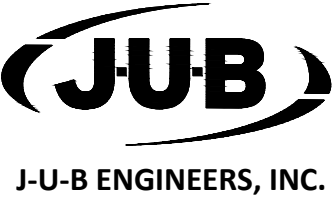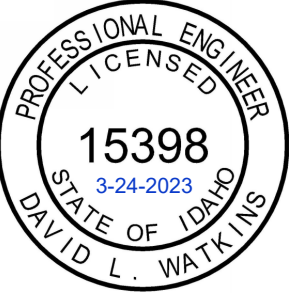

201 South Jackson Street, Moscow, ID 83843
p 208 746 9010 w www.jub.com



Know what's below.
Call before you dig.

CALL 2 BUSINESS DAYS IN ADVANCE BEFORE
YOU DIG, GRADE, OR EXCAVATE FOR THE
MARKING OF UNDERGROUND MEMBER
UTILITIES

OTHER J-U-B COMPANIES



THE
LANGDON
GROUP



GATEWAY
MAPPING
INC.

Plot Date: 5/27/2021 9:58 AM Plotted By: Allen Boehm
Date Created: 5/25/2021 JUB.COM\CENTRAL\CLIENTS\LEWISTON\GITY\PROJECTS\21-20-007 WELL\NOT DESIGN\03- WELL COMPLETION\GAS\ SHEET 12-20-007 G-001.DWG

GENERAL NOTES

1.

ALL WORK SHALL CONFORM TO THE "IDAHO STANDARDS FOR PUBLIC WORKS CONSTRUCTION" ISPMC 2017 EDITION.
2.

FOUND MONUMENTS SHOWN ON PLANS. ANY MONUMENTS (IRON PINS, BRASS CAPS, ALUMINUM CAPS, IRON PIPES, ETC.) ENCOUNTERED DURING THE COURSE OF CONSTRUCTION WHICH ARE NOT SHOWN ON THE PLANS SHALL BE RETAINED AND PROTECTED UNTIL THEY ARE REFERENCED BY THE LICENSED SURVEYOR IN STATE OF IDAHO.
3.

RETAIN AND PROTECT ALL UTILITIES, LANDSCAPE, TREES, AND SITE ITEMS UNLESS OTHERWISE CALLED OUT IN PLANS.
4.

THE CITY OF LEWISTON (CITY) AND THE ENGINEER HAVE JURISDICTION OVER THIS PROJECT. CONTRACTOR SHALL OBTAIN ALL NECESSARY PERMITS AND BUSINESS LICENSES PRIOR TO CONSTRUCTION.
5.

CONTRACTOR IS RESPONSIBLE FOR DUST ABATEMENT AND ANY LIABILITY ISSUES RELATED TO DUST AT ANY LOCATION WHICH MAY BE CAUSED BY THIS PROJECT.
6.

THE CONTRACTOR IS RESPONSIBLE FOR TRAFFIC CONTROL AND PROTECTION OF PEDESTRIANS IN AND AROUND THIS WORK. REFERENCE THE MANUAL ON UNIFORM TRAFFIC CONTROL DEVICES (MUTCD LATEST EDITION FOR WORK ZONE TRAFFIC CONTROL).
7.

ANY WORK DONE WITHIN A PUBLIC RIGHT-OF-WAY SHALL BE COORDINATED AND APPROVED BY THE CITY. RIGHT-OF-WAY USE PERMIT WILL BE REQUIRED. ALL WORK SHALL MEET CURRENT OSHA REQUIREMENTS.
8.

WHERE WORK IS PERFORMED ON EASEMENTS, THE CONTRACTOR SHALL TAKE EVERY PRECAUTION TO ELIMINATE ANY ADVERSE EFFECTS ON THE ADJACENT PROPERTY AND/OR TO RESTORE IT TO ITS ORIGINAL CONDITION.
9.

ALL DISTANCES AND DATA SHALL BE CHECKED BY THE CONTRACTOR PRIOR TO THE START OF CONSTRUCTION. IN CASE OF CONFLICT THE ENGINEER SHALL BE NOTIFIED IMMEDIATELY SO THAT CLARIFICATION MAY BE MADE PRIOR TO THE START OF THE WORK.
10.

THE CONTRACTOR SHALL ARRANGE FOR, SECURE AND PAY FOR DIRECTLY, ANY AND ALL TEMPORARY UTILITY SUPPLIES (E.G. WATER POWER, AND TELEPHONE) IT MAY REQUIRE FOR PROSECUTION OF ITS WORK. THE COST OF SUCH UTILITIES SHALL BE INCLUDED IN THE APPROPRIATE BID ITEM WITH WHICH IT IS ASSOCIATED.
11.

SHOULD CONSTRUCTION BE HALTED BECAUSE OF INCLEMENT WEATHER CONDITIONS, THE CONTRACTOR WILL COMPLETELY CLEAN UP ALL AREAS AND MAINTAIN THE SURFACE IN GOOD CONDITION DURING THE SHUT-DOWN PERIOD.
12.

THE CONTRACTOR'S PERSONNEL, EQUIPMENT, AND OPERATIONS SHALL COMPLY FULLY WITH ALL APPLICABLE STANDARDS, REGULATIONS, AND REQUIREMENTS OF EXISTING FEDERAL, IDAHO STATE, AND LOCAL GOVERNMENTAL AGENCIES.
13.

THE CONTRACTOR SHALL BE RESPONSIBLE FOR OBTAINING ALL LOCAL, STATE, AND FEDERAL PERMITS REQUIRED FOR STORMWATER POLLUTION PREVENTION AS A RESULT OF CONSTRUCTION ACTIVITIES. THE CONTRACTOR SHALL PREPARE A STORMWATER POLLUTION PREVENTION PLAN FOR APPROVAL BY THE ENGINEER. CONSTRUCTION IS NOT ANTICIPATED TO DISTURB MORE THAN ONE ACRE. IF THE CONSTRUCTION DOES DISTURB MORE THAN ONE ACRE, THE CONTRACTOR SHALL OBTAIN A COPY OF THE U.S. ENVIRONMENTAL PROTECTION AGENCY'S NPDES GENERAL PERMIT FOR STORM WATER DISCHARGES ASSOCIATED WITH CONSTRUCTION ACTIVITY (OTHERWISE KNOWN AS THE CONSTRUCTION GENERAL PERMIT OR CGP) AND SUBMIT A "NOTICE OF INTENT" (NOI)EPA FORM 3510-9 (6/03) FOR PERMIT COVERAGE UNDER THE GENERAL PERMIT. THE CGP MAY BE FOUND ON THE INTERNET AT <HTTPS://WWW.EPA.GOV/NPDES/2017-CONSTRUCTION-GENERAL-PERMIT-CGP> OR BY CONTACTING THE U.S. EPA OFFICE OF WATER DIRECTLY AT (800) 424-4372. THE NOI MAY BE FILED ELECTRONICALLY AT THE FOLLOWING WEBSITE: <HTTP://HTTPS://WWW.EPA.GOV/NPDES/SUBMITTING-NOTICE-INTENT-NOI-NOTICE-TERMINATION-NOT-OR-LOW-EROSIVITY-WAIVER-LEW-UNDER>. THE CGP DOES NOT RELIEVE THE CONTRACTOR FROM COMPLIANCE WITH OTHER REGULATIONS OR CONTRACT REQUIREMENTS REGARDING STORMWATER POLLUTION PREVENTION INCLUDING BUT NOT LIMITED TO: PROTECTION OF SURFACE WATERS, PREVENTION OF SOIL RUNOFF INTO DRAINS, DUST CONTROL, PREVENTION OF TRACKING SOILS TO ADJACENT STREETS, FUEL CONTAINMENT, SPILL CONTROL, ETC.
14.

A GEO-TECHNICAL REPORT HAS BEEN COMPLETED FOR THIS SITE TITLED "GEOTECHNICAL ENGINEERING EVALUATION, CITY OF LEWISTON WELL #7, JUNE 12, 2020". ALL PROPOSED CUT AND FILL SLOPES MUST BE VERIFIED PRIOR TO CONSTRUCTION.
15.

REMOVE AND DISPOSE OF ALL EXCESS EXCAVATED SOIL MATERIAL PER LOCAL, STATE, AND FEDERAL REGULATIONS. IF CONTRACTOR SEEKS TO REUSE THE EXCAVATED SOIL MATERIAL FOR SITE GRADING, CONTRACTOR SHALL SUBMIT QUALITY CONTROL PLAN TO ENGINEER FOR REVIEW PRIOR TO THE REUSING EXCAVATED SOIL MATERIAL.
16.

IF SITE CONDITIONS DIFFER FROM THAT WHICH IS SHOWN IN THE PLANS, THE CONTRACTOR SHALL COORDINATE WITH ENGINEER.
17.

ANY UNCRUSHED AGGREGATES USED SHALL MEET GRADATION AND COMPACTION REQUIREMENTS AS FOUND IN SECTION 801 OF THE ISPMC.
18.

THE LOCATIONS OF ALL EXISTING UNDERGROUND UTILITIES ARE SHOWN IN AN APPROXIMATE WAY ONLY. NOT ALL UTILITIES ARE SHOWN. CONTRACTOR SHALL DETERMINE THE EXACT LOCATION OF ALL EXISTING UTILITIES BEFORE COMMENCING WORK. CONTRACTOR AGREES TO BE FULLY RESPONSIBLE FOR ANY AND ALL DAMAGES WHICH MIGHT BE OCCASIONED BY HIS FAILURE TO EXACTLY LOCATE AND PRESERVE ANY AND ALL UNDERGROUND UTILITIES. CONTRACTOR SHALL BE RESPONSIBLE FOR COORDINATION WITH AFFECTED UTILITY COMPANIES. CALL DIG LINE AT 811 AT LEAST 48 HOURS PRIOR TO EXCAVATING TO REQUEST LOCATIONS OF UNDERGROUND UTILITIES.
19.

CONTRACTOR SHALL COORDINATE WITH UTILITY COMPANIES TO DISCONNECT, REMOVE, AND/OR CAP OFF EXISTING UTILITY SERVICE LINES, POWER, TELEPHONE, NATURAL GAS, ETC.
20.

CROSS-REFERENCE AND COORDINATE ALL WORK IN THE CONTRACT DOCUMENTS AMONG THE VARIOUS TRADES AND DISCIPLINES.
21.

THESE PLANS ARE SCHEMATIC AND ARE NOT INTENDED TO DEPICT ALL DETAILS OF THE WORK REQUIRED. THE CONTRACTOR IS RESPONSIBLE TO BECOME FAMILIAR WITH ACTUAL SITE CONDITIONS AND FACTORS AFFECTING WORK.
22.

THE CONTRACTOR SHALL COORDINATE ALL WORK WITH CITY OPERATIONS STAFF PRIOR TO COMMENCING WORK. REFERENCE TECHNICAL SPECIFICATION FOR SUGGESTED SEQUENCING OF PROJECT IMPROVEMENTS AND CONTINUITY OF OPERATIONS. IT IS THE CONTRACTOR'S RESPONSIBILITY TO COORDINATE WITH THE OWNER, ENGINEER, AND RESIDENTS AS REQUIRED TO DETERMINE STATUS OF EXISTING SEWER SERVICES AS LIVE OR ABANDONED. CONTRACTOR SHALL PLUG ABANDONED SERVICES IN ACCORDANCE WITH STANDARD DETAILS.
23.

THE CONTRACTOR SHALL BE RESPONSIBLE FOR COMPLIANCE WITH ALL APPLICABLE SAFETY LAWS AND STANDARDS OF ANY JURISDICTIONAL BODY. THE CONTRACTOR SHALL BE RESPONSIBLE FOR ALL BARRICADES, SAFETY DEVICES AND CONTROL OF TRAFFIC WITHIN AND AROUND THE CONSTRUCTION AREA.
24.

THE CONTRACTOR SHALL NOTIFY ENGINEER A MINIMUM OF ONE (1) WEEK PRIOR TO SURVEY NEEDS.
25.

THE CONTRACTOR SHALL BE RESPONSIBLE TO PROTECT ALL STAKES WITHIN THE CONSTRUCTION SITE AT ALL TIMES. ANY LOST OR OBLITERATED STAKES OR PINS WILL BE RE-SET AT CONTRACTOR EXPENSE.
26.

EXISTING PROPERTY CORNERS OR SURVEY MONUMENTS SHALL BE PROTECTED DURING THE COURSE OF CONSTRUCTION. ANY DAMAGED OR OBLITERATED CORNERS OR MONUMENTS SHALL BE

- RE-ESTABLISHED BY PROFESSIONAL SURVEYORS, LICENSED TO WORK IN THE STATE OF IDAHO, PRIOR TO FINAL ACCEPTANCE, AND PAID FOR BY THE CONTRACTOR.
27.

THE CONTRACTOR SHALL LIMIT WORK AREA TO THE LIMITS OF THE CITY PROPERTY, RIGHT OF WAY, AND APPROVED EASEMENTS.
28.

NO REVISIONS SHALL BE MADE TO THESE PLANS WITHOUT THE APPROVAL OF THE OWNER AND ENGINEER.
29.

CONTRACTOR SHALL RETAIN AND PROTECT ACROSS ENTIRE SITE ALL EXISTING FEATURES INCLUDING UTILITIES, ROADS, CANALS, FENCES, STRUCTURES, TREES, LAGOONS, AND OTHER SITE IMPROVEMENTS (AS PRESENT) THAT ARE NOT IN DIRECT CONFLICT WITH THE WORK. DAMAGE BY CONTRACTOR'S OPERATIONS SHALL BE REPAIRED AT THE CONTRACTOR'S EXPENSE.
30.

THE CONTRACTOR IS REQUIRED TO PROPERLY DISPOSE OF ALL DEBRIS REMOVED FOR CONSTRUCTION OF THE WORK.
31.

THE OWNER RESERVES THE RIGHT TO SALVAGE ITEMS NOTED FOR DEMOLITION. CONTRACTOR SHALL DISPOSE OF ALL ITEMS NOT SALVAGED BY THE OWNER.
32.

ALLOW OWNER TO MAINTAIN EXISTING UTILITIES IN OPERATION AT ALL TIMES. OWNER WILL WORK WITH CONTRACTOR TO COORDINATE SHORT PERIODS OF SHUT DOWN, IF NECESSARY. SUCH SHUT DOWNS WILL REQUIRE PRIOR NOTICE. SEE THE TECHNICAL SPECIFICATIONS FOR ADDITIONAL INFORMATION.
33.

CONTRACTOR SHALL PROVIDE, MAINTAIN, AND PAY FOR SUITABLE QUALITY WATER AS REQUIRED FOR PROJECT WORK INCLUDING TESTING, DUST CONTROL, ETC.
34.

CONTRACTOR SHALL COORDINATE WITH STATE AND LOCAL INSPECTION AGENCIES AS REQUIRED FOR INSPECTION AND APPROVAL OF THE WORK (E.G., PLUMBING, MECHANICAL, ELECTRICAL, BUILDING, ETC.).
35.

FINISH GRADE SLOPE AWAY FROM BUILDINGS/STRUCTURES AT A MINIMUM OF 2% OR A MAXIMUM OF 25% FOR A MINIMUM DISTANCE OF 10' OR TO THE CATCH POINT WITH EXISTING GRADE (WHICH EVER IS GREATER) UNLESS INDICATED OTHERWISE ON THE DRAWINGS.
36.

SITE SHALL BE CLEANED AND RESTORED TO ORIGINAL CONDITION UPON COMPLETION OF WORK. UNLESS NOTED OTHERWISE, PROVIDE FINAL SURFACE REPAIR TO ALL AREAS IMPACTED DURING THE COURSE OF THE WORK TO A CONDITION EQUAL TO OR BETTER THAN THAT PRESENT PRIOR TO BEGINNING WORK. ALL DISTURBED GRASSY AREAS SHALL BE RE-SEEDED AND MULCHED IMMEDIATELY AFTER CONSTRUCTION AND GROOMED TO ORIGINAL OR BETTER CONDITION.
37.

THE CONTRACTOR SHALL MAINTAIN THE STREETS, SIDEWALKS, AND ALL OTHER PUBLIC RIGHTS-OF-WAY IN A CLEAN, SAFE AND USEABLE CONDITION. ALL SOIL, ROCK, OR CONSTRUCTION DEBRIS SHALL BE PROMPTLY REMOVED FROM THE PUBLICLY OWNED PROPERTY DURING CONSTRUCTION, AND UPON COMPLETION OF THE PROJECT. ALL ADJACENT PROPERTY, PRIVATE OR PUBLIC, SHALL BE MAINTAINED IN A CLEAN, SAFE AND USEABLE CONDITION.
38.

ALL UNDERGROUND UTILITY LATERALS SHALL BE INSTALLED AND APPROVED BEFORE CONSTRUCTION OF CURBS, CROSS GUTTERS, SIDEWALKS OR THE SURFACING OF STREETS.
39.

ALL OPERATIONS CONDUCTED ON THE PREMISES SHALL BE RESTRICTED TO THE HOURS BETWEEN 7:00 AM TO 7:00 PM, MONDAY THROUGH FRIDAY, UNLESS OTHERWISE APPROVED BY THE CITY. THIS INCLUDES THE WARMING UP, REPAIR, ARRIVAL, DEPARTURE OR RUNNING OF TRUCKS, EARTHMOVING EQUIPMENT, CONSTRUCTION EQUIPMENT OR ANY OTHER ASSOCIATED EQUIPMENT. NO WORK SHALL BE PERFORMED ON WEEKENDS UNLESS REQUESTED BY CONTRACTOR IN WRITING WITH 48 HOURS NOTICE AND SUBSEQUENTLY AUTHORIZED IN WRITING BY THE OWNER.
40.

THE CONTRACTOR SHALL BE RESPONSIBLE FOR ALL TRAFFIC CONTROL, IN ACCORDANCE WITH THE M.U.T.C.D., CURRENT EDITION. AT LEAST 24 HOURS PRIOR TO DISRUPTION OF ANY TRAFFIC, TRAFFIC CONTROL PLANS SHALL BE PREPARED AND SUBMITTED FOR APPROVAL. NO WORK SHALL COMMENCE UNTIL A PERMIT IS ISSUED AND ALL APPROVED TRAFFIC CONTROL IS IN PLACE.
41.

IF ANY ITEMS OF SUSPECTED HISTORICAL OR ARCHAEOLOGICAL VALUE ARE UNCOVERED DURING CONSTRUCTION THE CONTRACTOR WILL BE REQUIRED TO STOP WORK AND CONTACT THE IDAHO STATE HISTORIC PRESERVATION OFFICE.
42.

GENERAL CONTRACTOR SHALL BE RESPONSIBLE FOR OBTAINING ALL REQUIRED PERMITS ASSOCIATED WITH DEWATERING. DEWATERING DISCHARGE TO ADJACENT STREAMS OR DRAINS SHALL NOT BE ALLOWED UNTIL CONTRACTOR HAS SECURED NECESSARY PERMITS FOR DEWATERING. SEE CONTRACT DOCUMENTS AND SPECIFICATIONS FOR ADDITIONAL REQUIREMENTS ASSOCIATED WITH DEWATERING.

EXISTING UTILITIES

1.

APPROXIMATE LOCATIONS OF UTILITIES ARE SHOWN ON THE PLANS. THEY ARE TO BE USED FOR GENERAL INFORMATION ONLY. IT IS THE RESPONSIBILITY OF THE CONTRACTOR TO NOTIFY THE APPROPRIATE UTILITY COMPANIES WHEN CONSTRUCTION MIGHT INTERFERE WITH NORMAL OPERATION OF ANY UTILITIES. IT SHALL ALSO BE THE CONTRACTOR'S RESPONSIBILITY TO HAVE THE APPROPRIATE UTILITY COMPANY FIELD-LOCATE ANY UTILITY INSTALLATIONS WHICH MIGHT BE AFFECTED BY CONSTRUCTION PRIOR TO BEGINNING WORK IN THAT AREA. THE CONTRACTOR SHALL BE RESPONSIBLE FOR MAINTAINING SERVICE OF EXISTING UTILITIES AND FOR RESTORING ANY UTILITIES DAMAGED DUE TO CONSTRUCTION AT NO ADDITIONAL COST TO THE OWNER. DEPTHS AND ELEVATIONS OF UTILITIES ARE UNKNOWN UNLESS OTHERWISE SHOWN. CONTRACTOR SHALL FIELD VERIFY UTILITY DEPTHS, ELEVATIONS, ANY DISCREPANCIES AND/OR CONFLICTS SHALL BE BROUGHT TO THE ATTENTION OF THE ENGINEER IMMEDIATELY.
2.

CONTRACTORS SHALL BE RESPONSIBLE FOR COORDINATING WITH AFFECTED FRANCHISE UTILITIES DURING CONSTRUCTION AND PROPERTIES WITH WATER AND SEWER SERVICES IMPACTED BY CONSTRUCTION ACTIVITIES SHALL BE NOTIFIED OF CONSTRUCTION ACTIVITIES A MINIMUM OF TWO (2) DAYS PRIOR TO DISRUPTING THEIR SERVICE(S) .

MECHANICAL NOTES

1.

MECHANICAL MATERIAL/EQUIPMENT SHOWN IS FOR SCHEMATIC PURPOSES. CONTRACTOR IS RESPONSIBLE FOR CORRECT QUANTITIES AND DIMENSIONS. CONSULT MANUFACTURER'S DETAIL DRAWINGS FOR DIMENSIONS AND INSTALLATION DETAILS.
2.

CONTRACTOR SHALL VERIFY ALL EQUIPMENT DIMENSIONS AND ELEVATIONS AND CROSS REFERENCE THESE WITH ALL OTHER EQUIPMENT AND TRADES ASSOCIATED WITH THE WORK TO ENSURE PROPER INSTALLATION, OPERATION, ALIGNMENT, MOUNTING REQUIREMENTS, CONNECTION DETAILS, ETC. SUBMIT MANUFACTURERS CONNECTION DETAILS AND SHOP DRAWINGS PER THE SPECIFICATIONS.
3.

ALL THRUST BLOCKING SHALL BE FORMED IN PLACE AGAINST UNDISTURBED OR COMPACTED SOIL, AND CONFORM TO THE MINIMUM DIMENSIONS SHOWN IN THE CITY STANDARD DETAIL 4-4. THE USE OF PRE-CAST THRUST BLOCKS IS PROHIBITED. ALL BOLTS AND NUTS SHALL BE FREE OF CONCRETE AND ACCESSIBLE BY WRENCH.
4.

ALL SANITARY SEWER MAINS SHALL BE SEPARATED AT LEAST 10 FEET HORIZONTALLY FROM DOMESTIC WATER LINES. CROSSINGS OF WATER MAINS AND SEWER SYSTEMS SHALL HAVE A MINIMUM 18-INCH VERTICAL SEPARATION WITH THE WATER MAIN BEING CENTERED OVER THE SANITARY SEWER. ANY ANTICIPATED SEPARATION DIFFERING FROM THE MINIMUM STANDARDS CONTAINED HEREIN SHALL CONFORM TO THE IDAHO RULES FOR PUBLIC DRINKING WATER, (IDAPA 58.01.16).

PAVEMENT NOTES

1.

PRIOR TO PLACING BASE MATERIAL, THE FOLLOWING SHALL BE COMPLETED:
A. ALL PUBLIC UTILITIES SHALL BE INSTALLED, TESTED AND APPROVED.
B. THE CONTRACTOR SHALL CERTIFY AND PROVIDE COPIES OF COMPACTION TEST RESULTS TO THE ENGINEER, FOR ALL TRENCHES, SUB-GRADE, AND AREAS UNDER CURB AND GUTTER.
C. THE LINE AND GRADE OF THE SUB-GRADE SHALL BE INSPECTED AND APPROVED BY THE ENGINEER OF RECORD.
D. A PROOF-ROLL OF THE SUB-GRADE SHALL BE PERFORMED AND OBSERVED BY THE ENGINEER OF RECORD AND CITY ENGINEERING INSPECTOR.
2.

CRUSHED AGGREGATE BASE SHALL CONFORM TO THE IDAHO STANDARDS FOR PUBLIC WORKS CONSTRUCTION, SECTION 802, (TYPE 1) ¾-INCH MAXIMUM AGGREGATE SIZE, AND SHALL BE COMPACTED TO THE FOLLOWING SPECIFICATIONS:
A. ROADWAY: 95%-MODIFIED PROCTOR.
B. CURB BASE AND DRIVEWAY APPROACHES: 95%-MODIFIED PROCTOR.
C. SIDEWALKS OR TRAILS: 95%-MODIFIED PROCTOR.
3.

PRIOR TO PLACING ASPHALT CONCRETE, THE FOLLOWING SHALL BE COMPLETED:
A. THE CONTRACTOR SHALL PROVIDE QUALITY CONTROL COMPACTION TEST AND PROVIDE RESULTS TO THE ENGINEER OF RECORD. THE ENGINEER WILL PROVIDE QUALITY ASSURANCE TESTING AS DEEMED NECESSARY.
B. ALL UTILITIES SHALL BE ADJUSTED TO GRADE AND ASPHALT COLLARS INSTALLED.
C. OBTAIN AUTHORIZATION FROM THE CITY TO PROCEED WITH ASPHALT PAVING. THE CITY INSPECTOR SHALL BE NOTIFIED AT LEAST FORTY- EIGHT (48) HOURS PRIOR TO PLACEMENT OF ASPHALT PAVEMENT.
4.

NO ASPHALT SHALL BE PLACED ON WET OR FROZEN SURFACES, OR WHEN THE AIR OR GROUND TEMPERATURE IS LESS THAN 40°F. TOP COURSES OR PAVEMENT THICKNESS LESS THAN 2.5 INCHES SHALL NOT BE PLACED WHEN AIR OR GROUND TEMPERATURE IS LESS THEN 50°F, WITHOUT APPROVAL BY THE ENGINEER OF RECORD.
5.

A TACK COAT SHALL BE APPLIED TO ALL ADJACENT CURBS AND JOINTS, PRIOR TO PLACEMENT OF ASPHALTIC CONCRETE.
6.

EXTRACTION AND GRADATION TESTS MAY BE REQUIRED AT THE DISCRETION OF THE CITY ENGINEER. ADDITIONALLY, CORING OF THE ASPHALT PAVEMENT MAY BE REQUESTED TO VERIFY PAVEMENT THICKNESS AND/OR COMPACTION AT NO COST TO THE OWNER.
7.

FORMS, SUB-GRADE AND STRING-LINE INSPECTION IS REQUIRED PRIOR TO POURING CONCRETE. A MINIMUM NOTICE OF 24 HOURS IS REQUIRED PRIOR TO INSPECTION.
8.

CONCRETE SHALL NOT BE PLACED ON FROZEN SURFACES, ICE OR SNOW, OR SURFACES WITH A TEMPERATURE GREATER THAN 90°F. UNLESS OTHERWISE AUTHORIZED BY THE CITY ENGINEER OR ENGINEER OF RECORD, CONCRETE PLACEMENT SHALL BE DISCONTINUED WHEN AIR TEMPERATURES REACH 35°F AND FALLING UNLESS OTHERWISE APPROVED BY THE ENGINEER OF RECORD AND A COLD WEATHER CONCRETE POURING PLAN SUBMITTED BY THE CONTRACTOR AND HAS BEEN APPROVED BY THE CITY.
9.

CURB AND GUTTER SHALL BE CONSTRUCTED WITH FULL DEPTH CONSTRUCTION EXPANSION JOINTS ADJACENT TO CATCH BASINS, AND AT ALL RETURNS. WEAKENED PLANE JOINTS ARE REQUIRED EVERY 10 FEET.
10.

SIDEWALKS SHALL BE CONSTRUCTED WITH FULL DEPTH EXPANSION JOINTS EVERY 20 FEET, AND WEAKENED PLANE JOINTS EVERY 5 FEET. JOINTS IN THE SIDEWALK SHALL BE ALIGNED WITH CURB JOINTS, AS NEARLY AS PRACTICAL.
11.

ALL EXISTING IMPROVEMENTS INCLUDING CURB AND GUTTER, SIDEWALKS, ASPHALT, CONCRETE OR P.C.C. PAVING, WHICH ARE BEING JOINED OR MATCHED IN CONNECTION WITH THIS PROJECT, SHALL BE JOINED OR MATCHED IN A MANNER SATISFACTORY TO THE ENGINEER, INCLUDING NECESSARY SAW CUTTING, REMOVAL, REPLACEMENT AND CAPPING.
12.

SURFACE REPAIR ASPHALT SHALL BE A PLANTMIX PAVEMENT, SP-3, 1/2-INCH NOMINAL SIZE, ASPHALT CEMENT SHALL BE PG 64-28 MEETING THE REQUIREMENTS OF ISPMC SECTION 805 OR APPROVED HIGHER GRADE OIL.
13.

ALL CONTRACTORS WORKING IN THE RIGHT-OF-WAY ARE REQUIRED TO SECURE A RIGHT-OF-WAY (ROW) CONSTRUCTION PERMIT FROM THE CITY OF LEWISTON AT LEAST TWENTY FOUR (24) HOURS PRIOR TO ANY CONSTRUCTION.
14.

THE CITY OF LEWISTON WILL INSPECT ALL WORK WITHIN THE PUBLIC RIGHT-OF-WAY TO INCLUDE UTILITY TRENCHES. THE CITY WILL INSPECT ALL CONNECTIONS TO EXISTING INFRASTRUCTURE.
15.

IT SHALL BE THE CONTRACTOR'S RESPONSIBILITY TO COORDINATE CHANGES TO TRAFFIC WITH THE CITY OF LEWISTON STREET MAINTENANCE DIVISION.

WATER SYSTEM NOTES

1.

CONSTRUCTION OF POTABLE WATER LINES SHALL CONFORM TO THE STANDARDS IN THE "IDAHO RULES FOR PUBLIC DRINKING WATER SYSTEMS (IDAPA 58.01.08)" AS WELL AS ISPMC. PROPERTIES SHALL BE NOTIFIED AS OUTLINED IN EXISTING UTILITIES NOTE NO. 2.
2.

THE HORIZONTAL SEPARATION OF POTABLE WATER MAINS AND NON-POTABLE WATER MAINS (SANITARY SEWER, STORM DRAIN, AND IRRIGATION) SHALL BE A MINIMUM OF TEN (10) FEET. WHERE IT IS NECESSARY FOR POTABLE WATER MAIN AND NON-POTABLE WATER MAIN TO CROSS WITH LESS THAN EIGHTEEN (18) INCHES OF VERTICAL SEPARATION, THE CROSSING SHALL BE CONSTRUCTED IN ACCORDANCE WITH SECTION 542.07 OF THE IDAHO RULES FOR PUBLIC DRINKING WATER SYSTEMS (IDAPA 58.01.08) AND SECTION 430.02 OF THE WASTEWATER RULES (IDAPA 58.01.16).
3.

THE CONTRACTOR SHALL BE RESPONSIBLE FOR NOTIFYING EXISTING WATER USERS PRIOR TO DISRUPTING SERVICE IN ACCORDANCE WITH EXISTING UTILITIES NOTE NO. 2. NO USER SHALL BE WITHOUT WATER OR SEWER SERVICE OVERTIME. NO USER SHALL BE WITHOUT WATER AND SEWER FOR MORE THAN 4 HOURS DURING NORMAL BUSINESS HOURS.
4.

ALL WATER WORKS COMPONENTS SHALL BE ANSINSF 61 CERTIFIED, AND MUST MEET ALL AMERICAN WATER WORKS ASSOCIATION (AWWA) AND STANDARD REQUIREMENTS OF THE IDAHO RULES FOR PUBLIC DRINKING WATER SYSTEMS (IDAPA 58.01.08).
5.

THE DESIGN, CONSTRUCTION, INSTALLATION, MAINTENANCE AND MATERIALS TO COMPLETE A TEMPORARY DEWATERING SYSTEM TO PROVIDE ADEQUATE DEWATERING DURING CONSTRUCTION WILL NOT BE MEASURED AND PAID FOR SEPARATELY BUT INCLUDED IN THE PROJECT.
6.

ALL UTILITY CROSSINGS SHOWN ON THE PLANS ARE INCIDENTAL TO THE PROJECT UNLESS OTHERWISE NOTED WITH A SPECIFIC PAY ITEM.
7.

THE NEW WATER MAIN SHALL BE CONSTRUCTED IN ACCORDANCE WITH THESE PLANS AND THE CITY OF LEWISTON STANDARD DRAWINGS. ALL WORK SHALL ALSO BE IN ACCORDANCE WITH THE SPECIFICATIONS OF ISPMC. ALL WORK SHALL BE SUBJECT TO ACCEPTANCE BY THE CITY OF LEWISTON PURSUANT TO THE ENGINEERING DEPARTMENT'S CURRENT INSPECTION CHECKLIST.
8.

THE CONTRACTOR SHALL PRESSURE TEST THE NEW WATER MAIN IN ACCORDANCE WITH ISPMC SECTION 401.
9.

THE CITY'S WATER DISTRIBUTION SUPERVISOR (208-791-2032) SHALL BE CONTACTED 2 BUSINESS DAYS PRIOR TO ANY PRESSURE TESTING/DISINFECTION OF THE PUBLIC MAIN. THE DISINFECTION PROCEDURES CAN ONLY BE SCHEDULED ON MONDAY, TUESDAY OR WEDNESDAY. HE SHALL ALSO BE CONTACTED 2 BUSINESS DAYS PRIOR TO ANY TIE IN. TIE INS CAN OCCUR ON ANY WEEKDAY BUT MUST OCCUR BEFORE NOON ON FRIDAY. ANY ALTERATIONS TO THESE NOTIFICATIONS OR WORK SCHEDULES MUST BE APPROVED BY THE ENGINEER. THE CITY RESERVES THE RIGHT TO BILL THE CONTRACTOR FOR OVERTIME FOR IF WORK IS REQUESTED TO BE AFTERHOURS OR ON WEEKENDS.
10.

CONNECTION TO EXISTING MAINS SHALL BE IN THE PRESENCE OF CITY WATER DEPT PERSONNEL.
11.

THE CITY OF LEWISTON SHALL HAVE THE FIRST RIGHT OF REFUSAL TO ANY REMOVED/SALVAGED WATER SYSTEM COMPONENTS (HYDRANTS, VALVES, ETC)..
12.

ALL FITTINGS AND VALVES SHALL HAVE MJ JOINTS UNLESS MULTIPLE FITTINGS AND/OR VALVES ARE TOGETHER IN A SINGLE ASSEMBLY, IN WHICH CASE, COMMON JOINTS BETWEEN THEM SHALL BE FLANGED. MJ TO MJ CONNECTIONS SHALL INCLUDE A FOSTER ADAPTER IN BETWEEN. AL HORIZONTAL FITTINGS, VERTICAL FITTINGS, AND VALVES SHALL BE FULLY RESTRAINED BY THRUST BLOCKS PER CITY STANDARD DRAWINGS AND ISPMC DIVISION 400.

CONSTRUCTION STAKING NOTES

1.

CONTRACTOR SHALL PROVIDE ALL CONSTRUCTION LAYOUT FROM ESTABLISHED CONTROL POINTS, PER SPECIFICATION SECTION 01039.1.3.
2.

CONTRACTOR RESPONSIBLE FOR PROTECTING SURVEY STAKES. RESTAKING WILL BE AT THE CONTRACTOR'S EXPENSE.



J-U-B ENGINEERS, INC.

J-U-B ENGINEERS, INC.
201 South Jackson Street
Moscow, ID 83843

Phone: 208.748.9010
www.jub.com

JUB SHALL RETAIN ALL COMMON LAW, STATUTORY, COPYRIGHT AND OTHER RIGHTS IN THIS DESIGN AND DRAWING. NO PART OF THIS DESIGN OR DRAWING SHALL BE REPRODUCED, COPIED, OR TRANSMITTED IN ANY FORM OR BY ANY MEANS, WITHOUT WRITTEN CONSENT BY JUB. ANY REUSE WITHOUT WRITTEN CONSENT BY JUB WILL BE AT CLIENT'S SOLE RISK AND WITHOUT LIABILITY OR LEGAL EXPOSURE TO JUB-B.

REVISION

NO.	DESCRIPTION	BY	DATE

WELL NO. 7
WELL COMPLETION

GENERAL (G)
GENERAL NOTES



Know what's below.
Call before you dig.

CALL 2 BUSINESS DAYS IN ADVANCE BEFORE
YOU DIG, GRADE, OR EXCAVATE FOR THE
MARKING OF UNDERGROUND MEMBER
UTILITIES

FILE: 21-20-007_G-001X
JUB PROJ. #: 21-20-007
DRAWN BY: ARB
DESIGN BY: BK
CHECKED BY: DLW
AT FULL SIZE, IF NOT ONE
INCH, SCALE ACCORDINGLY
LAST UPDATED: 5/27/2021

SHEET NUMBER:


G-002

Plot Date: 5/27/2021 9:38 AM Plotted By: Allen Boehm
Date Created: 5/25/2021 J:\B.COM\GENERAL\CLIENTS\LEWISTON\GITY\PROJECTS\21-20-007 WELL NO.7\DESIGN\103-WELL\COMPLETION\GASHEET\21-20-007_G-001.DWG

INSPECTION AND TESTING

1. THE CONTRACTOR SHALL BE RESPONSIBLE FOR MATERIALS AND COMPACTION TESTING. ALL TESTS SHALL MEET MINIMUM ENGINEER REQUIREMENTS. SEE THE CONTRACT DOCUMENTS (GEOTECHNICAL REPORT) AND DRAWINGS FOR FREQUENCY OF TESTING. RESULTS ARE TO BE DELIVERED TO SPECIAL INSPECTOR, OWNER AND ENGINEER.
2. THE CONTRACTOR IS RESPONSIBLE TO COORDINATE WITH ENGINEER AND SPECIAL INSPECTOR FOR INSPECTIONS OF WORK AT APPROPRIATE INTERVALS. IT SHALL BE THE CONTRACTOR'S RESPONSIBILITY TO PAY FOR ADDITIONAL INSPECTIONS THAT ARE THE RESULT OF HIS WORKMANSHIP.
3. THIS TABLE IS PROVIDED FOR CONVENIENCE AND MAY NOT BE ALL INCLUSIVE.

ITEM	MATERIAL	TEST / STANDARD	ACCEPTANCE	TEST FREQUENCY	INSPECTOR/CO.
1. ALL UTILITY TRENCHES & STRUCTURES					
TRENCH SUBGRADE	NATIVE (6" TO 8" LIFTS MAX.)	MOISTURE DENSITY RELATIONSHIP OF SOILS (AASHTO T 180) IN-PLACE DENSITY AND MOISTURE CONTENT (AASHTO 310 METHOD B)	90% MAX. DRY DENSITY	ONE IN-PLACE DENSITY TEST EVERY LIFT PER 100 LINEAR FEET. IF PROJECT IS LESS THAN 100 LINEAR FEET, ONE IN-PLACE DENSITY TEST PER DAY OR PER LIFT [WHICHEVER TEST FREQUENCY IS MORE RESTRICTIVE].	BY TESTING SUBCONTRACTOR
PIPE BEDDING	3/4" MINUS CRUSHED AGGREGATE (6" TO 8" MAX. LIFT) (CURRENT ITD SPEC 703.04) OR 5/8" MINUS CRUSHED AGGREGATE (6" TO 8" MAX. LIFT) (CURRENT WDOT/M41-10 SPEC 9-03.9)	MOISTURE DENSITY RELATIONSHIP OF SOILS (AASHTO T 180) IN-PLACE DENSITY AND MOISTURE CONTENT (AASHTO 310 METHOD B)	95% MAX. DRY DENSITY	ONE IN-PLACE DENSITY TEST EVERY LIFT PER 100 LINEAR FEET. IF PROJECT IS LESS THAN 100 LINEAR FEET, ONE IN-PLACE DENSITY TEST PER DAY OR PER LIFT [WHICHEVER TEST FREQUENCY IS MORE RESTRICTIVE]. TEST TOP 6" OF 12" COVER.	BY TESTING SUBCONTRACTOR
1ST FOOT [12"] OF FILL OVER PIPE	3/4" MINUS CRUSHED AGGREGATE (6" TO 8" MAX. LIFT) (CURRENT ITD SPEC 703.04) OR 5/8" MINUS CRUSHED AGGREGATE (6" TO 8" MAX. LIFT) (CURRENT WDOT/M41-10 SPEC 9-03.9)	MOISTURE DENSITY RELATIONSHIP OF SOILS (AASHTO T 180) IN-PLACE DENSITY AND MOISTURE CONTENT (AASHTO 310 METHOD B)	95% MAX. DRY DENSITY	ONE IN-PLACE DENSITY TEST EVERY LIFT PER 100 LINEAR FEET. IF PROJECT IS LESS THAN 100 LINEAR FEET, ONE IN-PLACE DENSITY TEST PER DAY OR PER LIFT [WHICHEVER TEST FREQUENCY IS MORE RESTRICTIVE].	BY TESTING SUBCONTRACTOR
TRENCH BACKFILL IN NATURAL SURFACE AREA	CITY APPROVED EXCAVATED MATERIAL	AASHTO T 180	90% MODIFIED PROCTOR	ONE IN-PLACE DENSITY TEST EVERY LIFT PER 100 LINEAR FEET. IF PROJECT IS LESS THAN 100 LINEAR FEET, ONE IN-PLACE DENSITY TEST PER DAY OR PER LIFT [WHICHEVER TEST FREQUENCY IS MORE RESTRICTIVE].	BY TESTING SUBCONTRACTOR
TRENCH BACKFILL UNDER PROPOSED ROAD & SIDEWALK	3/4" MINUS CRUSHED AGGREGATE (6" TO 8" MAX. LIFT) (CURRENT ITD SPEC 703.04) OR 5/8" MINUS CRUSHED AGGREGATE (6" TO 8" MAX. LIFT) (CURRENT WDOT/M41-10 SPEC 9-03.9)	MOISTURE DENSITY RELATIONSHIP OF SOILS (AASHTO T 180) IN-PLACE DENSITY AND MOISTURE CONTENT (AASHTO 310 METHOD B)	95% MAX. DRY DENSITY	ONE IN-PLACE DENSITY TEST EVERY LIFT PER 100 LINEAR FEET. IF PROJECT IS LESS THAN 100 LINEAR FEET, ONE IN-PLACE DENSITY TEST PER DAY OR PER LIFT [WHICHEVER TEST FREQUENCY IS MORE RESTRICTIVE].	BY TESTING SUBCONTRACTOR
STRUCTURAL FILLS	AS SPEC'D BY ENGINEER	AS SPEC'D BY ENGINEER	95% MAX. DRY DENSITY	AS SPEC'D BY ENGINEER	BY TESTING SUBCONTRACTOR
2. STORM DRAIN MAINS					
GASKETED STORM SEWER PIPE	PVC SDR-35	ISPPWC SECTION 601	CERTIFIED & VISUAL BY CITY	DURING INSTALLATION	BY OWNER/ENGINEER
ALIGNMENT AND GRADE	N/A	PER MANUFACTURER'S INSTRUCTIONS	PER PLANS	DURING INSTALLATION	BY OWNER/ENGINEER
JOINTS (DEFLECTION/PROPER PIPE IMBEDMENT)	N/A	PER MANUFACTURER'S INSTRUCTIONS	PER PLANS	DURING INSTALLATION	BY OWNER/ENGINEER
PRESSURE TEST	N/A	ISPPWC SECTION 501	PER ISPPWC SECTION 501 TABLE 1	PRIOR TO COMMISSIONING	BY OWNER/ENGINEER
MANHOLES	N/A	N/A			
VIDEO INSPECTION	N/A	N/A			
3. WATER MAINS					
DUCTILE IRON WATER MAIN	AWWA C-151	ISPPWC SECTION 401	CERTIFIED & VISUAL BY CITY	DURING INSTALLATION	BY OWNER/ENGINEER
ALIGNMENT AND GRADE	N/A	ISPPWC SECTION 401	VISUAL BY CITY OR ENGINEER	DURING INSTALLATION	
JOINTS (DEFLECTION/PROPER PIPE IMBEDMENT)	N/A	ISPPWC SECTION 401	VISUAL BY CITY OR ENGINEER	DURING INSTALLATION	
THRUST BLOCKS	CONCRETE, 2500 PSI MAX	CITY STANDARD DRAWING 4-4 OR ISPPWC SECTION 401, WHICHEVER IS MORE STRINGENT	PER SUBMITTAL, VISUAL BY CITY OR ENGINEER	PER PLAN	BY OWNER/ENGINEER
HYDROSTATIC PRESSURE	N/A	2 HOURS, NOT TO EXCEED ALLOWABLE LEAKAGE PER ISPPWC SECTION 401	150 PSI FOR WORKING PRESSURES LESS THAN OR EQUAL TO 100 PSI, OR AS DETERMINED BY THE ENGINEER	PRIOR TO CONNECTION TO EXISTING SYSTEM	BY OWNER/ENGINEER
FLUSHING	N/A	ISPPWC SECTION 401	MINIMUM VELOCITY OF 2.5 FT/S	PRIOR TO CONNECTION TO EXISTING SYSTEM	BY OWNER/ENGINEER
CHLORINATION/BACTERIA	N/A	ISPPWC SECTION 401	BACTERIA TESTING: TWO NEGATIVE TESTING SAMPLES 24 HOURS APART	PRIOR TO CONNECTION TO EXISTING SYSTEM	BY OWNER/ENGINEER
THRUST CONTROL/FITTINGS	N/A	PER PLAN AND SUBMITTAL(S)	VISUAL INSPECTION BY CITY OR ENGINEER	PRIOR TO BACKFILLING TIE IN LOCATIONS	BY OWNER/ENGINEER
4. CONCRETE CURB, GUTTER & SIDEWALK					
CONCRETE	CLASS 35B - APPROVED MIX DESIGN REQUIRED WITH MIN. CEMENT CONTENT OF 560 LB/CY, MAX WATER/ CEMENT RATIO OF .44, A WRA, AND AN AEA	AASHTO T-22 COMPRESSIVE STRENGTH OF CONCRETE AASHTO T-23 MAKING TEST SPECIMENS AASHTO T-119 SLUMP OF HYDRAULIC CEMENT CONCRETE AASHTO T-152 AIR CONTENT OF FRESHLY MIXED CONCRETE WAQTC TM-2 SAMPLING FRESHLY MIXED CONCRETE	MIN. 28 DAY COMPRESSIVE STRENGTH = 3000 PSI; WATER/CEMENT RATION SHALL BE 0.5 LB/LB MAX. SLUMP = 5 INCHES AIR CONTENT PERCENT = 6.5% ± 1.5 TEMPERATURE = 50°F - 80°F	1 OF EACH TEST MINIMUM PER DAY, OR 1 OF EACH TEST PER 50 CY	BY TESTING SUBCONTRACTOR
CRUSHED AGGREGATE BASE COURSE	3/4" MINUS CRUSHED AGGREGATE (4" MAX. LIFT) (CURRENT ITD SPEC 703.04) OR 5/8" MINUS CRUSHED AGGREGATE (4" MAX. LIFT) (CURRENT WDOT/M41-10 SPEC 9-03.9)	MOISTURE DENSITY RELATIONSHIP OF SOILS (AASHTO T 180) IN-PLACE DENSITY AND MOISTURE CONTENT (AASHTO 310 METHOD B)	95% MAX. DRY DENSITY	1 TESTS PER 500 LF-MIN. 2 TESTS	BY TESTING SUBCONTRACTOR
ALIGNMENT AND GRADE	N/A	VISUAL	± 0.02' FROM DESIGN GRADE/ALIGNMENT	PER 10' SECTION	BY OWNER/ENGINEER
JOINTS/FLATNESS/STRAIGHTNESS	N/A	VISUAL	± 0.02'/10' SEGMENT	PER 10' SECTION	BY OWNER/ENGINEER
FINISH	N/A	VISUAL	FLOATED, UNIFORM, LIGHT BROOM FINISH	ENTIRE SURFACE AREA	BY OWNER/ENGINEER
5. ASPHALTIC CONCRETE PAVING					
SUPERPAVE HOT MIX ASPHALT	PLANTMIX PAVEMENT, SP-3. 1/2-INCH NOMINAL SIZE. ASPHALT CEMENT SHALL BE PG 64-28 MEETING THE REQUIREMENTS OF SECTION 805 OR APPROVED HIGHER GRADE OIL.	ISPPWC SECTION 805	ITD SECTION 405.03 ASPHALT CONTENT - CJMF VALUE ±0.3& SIEVE ANALYSIS - TABLE 405.03-5 VOIDS IN MINERAL AGGREGATES, AT N DESIGN - 703.05 MINIMUM VALUE 0.05 B ALL PROJECTS REGARDLESS OF TONNAGE IN-PLACE DENSITY - 92-96% OF MAXIMUM THEORETICAL (WHEN ACCEPTANCE WILL BE FROM CORRELATED GAUGE, CONTRACTOR MUST SUBMIT DOCUMENTATION SHOWING GAUGE CORRELATION TO PROPOSED BITUMINOUS MIXTURE USED.)	PROJECT 200 TONS OR LESS - MINIMUM OF 1 TEST (ASPHALT CONTENT, AND GRADATION) PER PROJECT. A MINIMUM OF 2 CORES WILL BE TAKEN TO DETERMINE FINAL THICKNESS AND/OR DENSITY. PROJECTS 200 TONS OR MORE - MINIMUM OF 1 TEST (ASPHALT CONTENT, GRADATION, VOIDS, AND VMA) PER 750 TONS OR, ONE PER DAY. A MINIMUM OF 5 CORES WILL BE TAKEN TO DETERMINE FINAL THICKNESS AND/OR DENSITY. RANDOM SAMPLING LOCATIONS DETERMINED BY THE CITY OF LEWISTON. THE CITY OF LEWISTON RESERVES THE RIGHT FOR 3RD PARTY VERIFICATION, INSPECTIONS, AND/OR TESTING PRIOR TO INFRASTRUCTURE ACCEPTANCE.	BY TESTING SUBCONTRACTOR
CRUSHED AGGREGATE BASE COURSE	SAME TEST REQUIREMENTS AS UNDER 4. CONCRETE CURB, GUTTER & SIDEWALK				
6. EROSION & SEDIMENT CONTROLS					
	PER APPROVED PLAN	PER PLAN AND MANUFACTURER'S INSTRUCTIONS		1/WEEK OR AFTER EVERY RAINFALL	BY OWNER/ENGINEER
7. TRAFFIC CONTROL					
	PER APPROVED PLAN	CURRENT ADOPTED MUTCD/ATSSA		CONTINUOUS	BY OWNER/ENGINEER
8. RECORD DRAWINGS					
	PDF OR PAPER COPY OF CONTRACTOR MARKED UP RECORD DRAWINGS	PER SPECIFICATIONS	COMPLETE SET OF RECORD DRAWINGS	BEFORE PUBLIC IMPROVEMENTS ACCEPTED	BY OWNER/ENGINEER
9. CONCRETE					
	AS SPEC'D BY ENGINEER	AS SPEC'D BY ENGINEER	AS SPEC'D BY ENGINEER	AS SPEC'D BY ENGINEER	AS SPEC'D BY ENGINEER
10. SOILS					
	AS SPEC'D BY ENGINEER	AS SPEC'D BY ENGINEER	AS SPEC'D BY ENGINEER	AS SPEC'D BY ENGINEER	AS SPEC'D BY ENGINEER



J-U-B ENGINEERS, INC.

J-U-B ENGINEERS, INC.
201 South Jackson Street
Moscow, ID 83843
Phone: 208.748.9010
www.jub.com

REUSE OF DRAWINGS
J-U-B SHALL RETAIN ALL COMMON LAW, STATUTORY, COPYRIGHT AND OTHER RIGHTS IN ALL DRAWINGS, SPECIFICATIONS AND OTHER DOCUMENTS. NO PART OF ANY DRAWING, SPECIFICATION OR OTHER DOCUMENT SHALL BE REPRODUCED OR TRANSMITTED IN ANY FORM OR BY ANY MEANS, ELECTRONIC OR MECHANICAL, INCLUDING PHOTOCOPYING, RECORDING, OR BY ANY INFORMATION STORAGE AND RETRIEVAL SYSTEM, WITHOUT THE WRITTEN CONSENT OF J-U-B ENGINEERS, INC. ANY REUSE WITHOUT WRITTEN CONSENT BY J-U-B WILL BE AT CLIENT'S SOLE RISK AND WITHOUT LIABILITY OR LEGAL EXPOSURE TO J-U-B.

REVISION
NO. DESCRIPTION BY DATE

WELL NO. 7
WELL COMPLETION

GENERAL (G)
SPECIAL INSPECTION TABLE

FILE: 21-20-007_G-001X
JUB PROJ. #: 21-20-007
DRAWN BY: ARB
DESIGN BY: BK
CHECKED BY: DLW
AT FULL SIZE, IF NOT ONE INCH SCALE ACCORDINGLY
LAST UPDATED: 5/27/2021

SHEET NUMBER:
G-003

Plot Date:5/27/2021 5:38 AM Plotted By: Allen Bealrnm
Date Created:5/25/2021 JUB.COM\CENTRAL\CLIENT\JULIEWESTON\CITY\PROJECT\21-20-007_WELL\NOT DESIGN\138-WELL\COMPLETION\CAD\SHEET\17-20-007_G-001X.DWG


SYMBOL DESCRIPTION	EXISTING SYMBOL	PROPOSED SYMBOL
SURVEY		
CAP (ALUMINUM)		
CAP (BRASS)		
CHISELED X		
CTRL PT GENERIC		
CTRL PT ½" REBAR		
CTRL PT ⅝" REBAR		
CTRL PT 60D NAIL		
CTRL PT HUB & TACK		
CTRL PT PK NAIL		
CTRL PT TEMP BENCH MARK		
NAIL		
NAIL AND TAG		
NAIL (PK)		
BOLT		
DRILL STEEL		
REBAR (½")		
REBAR (⅝")		
STAINLESS STEEL ROD		
IRON PIPE		
RAILROAD SPIKE		
R/W MONUMENT		
STONE		
SECTION CORNER. MON.		
SECTION QUARTER MON.		
SITE		
BOLLARD		
BOULDER		
DRINKING FOUNTAIN		
FLAGPOLE		
GATE		
MAIL BOX		
PARKING METER		
POST		
SIGN		
SPOT ELEVATION		
TREE (SHRUB)		
TREE (STUMP)		
TREE (CONIFEROUS)		
TREE (DECIDUOUS)		
TEST HOLE		
WELL		
WELL (MONITORING)		

SYMBOL DESCRIPTION	EXISTING SYMBOL	PROPOSED SYMBOL
UTILITIES		
MANHOLE (GENERIC)		
PRESSURE CLEAN OUT AT GRADE		
THRUST BLOCK		
VAULT		
COMMUNICATION		
TELE. MANHOLE		
TELE. PEDASTAL		
TELE. POLE		
TV PEDASTAL		
GUY WIRE		
DOMESTIC WATER		
FIRE HYDRANT		
SPIGOT		
YARD HYDRANT		
WATER MANHOLE		
WATER METER		
WATER VALVE		
ELECTRIC		
ELEC. MANHOLE		
ELEC. METER		
ELEC. TRANS.		
JUNCTION BOX		
POWER POLE		
POWER STUB		
STREET LIGHT		
TRAFFIC SIGNAL POLE		
IRRIGATION		
IRRIGATION VALVE		
IRRIGATION VALVE BOX		
SPRINKLER		
NATURAL GAS		
GAS METER		
GAS VALVE		
SANITARY SEWER		
CLEANOUT		
SEWER STUB		
SS MANHOLE		
STORM DRAIN		
CATCH BASIN		
DRY WELL		
FLARE END		
GREASE TRAP		
SD MANHOLE		

SYMBOL DESCRIPTION	EXISTING SYMBOL	PROPOSED SYMBOL
FITTINGS		
BEND (11.25°)		
BEND (22.5°)		
BEND (45°)		
BEND (90°)		
CAP		
COUPLING		
CROSS		
REDUCER (CONCENTRIC)		
REDUCER (ECCENTRIC)		
TEE		
TRUE UNION		
WYE		
VALVES		
AIR VALVE		
BLOW OFF		
COMBO VALVE		
BALL VALVE (N.C.)		
BALL VALVE (N.O.)		
BUTTERFLY VALVE		
CHECK VALVE		
CHECK VALVE (FLANGE)		
CHECK VALVE (MJ)		
GATE VALVE		
PLUG VALVE (N.C.)		
PLUG VALVE (N.O.)		

ABBREVIATIONS	
ASSY	ASSEMBLY
>	ANGLE
@	AT (MEASUREMENTS)
BLDG	BUILDING
BM	BENCH MARK
BSC	BITUMINOUS SURFACE COURSE
BSW	BACK OF SIDEWALK
BW	BOTH WAYS
C	CHANNEL (STRUCTURAL)
C/L	CENTER LINE
CMP	CORRUGATED METAL PIPE
CO	CLEANOUT
CONC	CONCRETE
CONT	CONTINUOUS
CPLG	COUPLING
CU FT	CUBIC FEET
CU YD	CUBIC YARD
DEG OR °	DEGREE
DET	DETAIL
DIA OR Ø	DIAMETER
DIP	DUCTILE IRON PIPE
DIST	DISTRIBUTION
DWG	DRAWING
EA	EACH
ELB	ELBOW
ELEV	ELEVATION
EW	EACH WAY
EXIST	EXISTING
FG	FINISH GRADE
FH	FIRE HYDRANT
FLG	FLANGE
FT OR '	FEET
GV	GATE VALVE
HORIZ	HORIZONTAL
ID	INSIDE DIAMETER
IN OR "	INCH
LB OR #	POUND
LF	LINEAL FEET
LN	LINEAL
MAX	MAXIMUM
MIN	MINIMUM
NO OR #	NUMBER
PE	POLYETHYLENE
PL	PLATE
PL	PROPERTY LINE
PVC	POLYVINYL--CHLORIDE
R	RADIUS
RP	RADIUS POINT
R&R	REMOVE & REPLACE
REM	REMOVE
REQ'D	REQUIRED
REV	REVISION
R/W	RIGHT--OF--WAY
S	SLOPE
SPEC	SPECIFICATION
STA	STATION

STD	STANDARD
STL	STEEL
ST STL	STAINLESS STEEL
TBC	TOP BACK OF CURB
TYP	TYPICAL
TFC	TOP FACE OF CONCRETE
W/	WITH
W/O	WITHOUT
W/REQ'D	WHERE REQUIRED



J-U-B ENGINEERS, INC.

J-U-B ENGINEERS, INC.
201 South Jackson Street
Moscow, ID 83843
Phone: 208.746.9010
www.jub.com

REUSE OF DRAWINGS
J-U-B SHALL RETAIN ALL COMMON LAW, STATUTORY, COPYRIGHT AND OTHER RIGHTS IN ALL INFORMATION, DESIGN, DRAWINGS AND DOCUMENTS. NO PART OF ANY INFORMATION, DESIGN, DRAWING OR DOCUMENT SHALL BE REUSED WITHOUT J-U-B'S PRIOR WRITTEN CONSENT. ANY REUSE WITHOUT WRITTEN CONSENT BY J-U-B WILL BE AT CLIENT'S SOLE RISK AND WITHOUT LIABILITY OR LEGAL EXPOSURE TO J-U-B.

REVISION		NO.	DESCRIPTION	BY	DATE

WELL NO. 7
WELL COMPLETION
ABBREVIATIONS AND SYMBOLS

FILE : 21-20-007_G-001X
JUB PROJ. # : 21-20-007
DRAWN BY: ARB
DESIGN BY: BK
CHECKED BY: DLW
AT FULL SIZE, IF NOT ONE INCH, SCALE ACCORDINGLY

LAST UPDATED: 5/27/2021

SHEET NUMBER:
G-005

Plot Date: 7/7/2021 2:08 PM, Plotted By: Brandon Kline
Date Created: 7/7/2021 C:\USERS\BKA\AS\ONE\DRIVE - J-U-B ENGINEERS, INC\LEWISTON\WELL721-20-007_F-001.DWG



COMMERCIAL PLAN REVIEW COMMENTS

PROJECT ADDRESS: 2817 NEZ PERCE GRADE, LEWISTON, ID 83501 DATE: JULY 8, 2021

THE FOLLOWING ITEMS SHALL BE INCLUDED ON ALL PLANS SUBMITTED. THE INFORMATION PROVIDED BELOW MUST BE ADDED VERBATIM TO PLANS. APPLICABLE EMPTY FIELDS SHALL BE EITHER CHECKED OR FILLED IN WITH THE REQUESTED INFORMATION. PROVISION OF THIS INFORMATION ON DOCUMENTS SEPARATE FROM THE PLANS IS NOT ACCEPTABLE.

- All plans shall conform to the IBC, IFC and the most current NFPA standards. (City of Lewiston Code Section 15-1 & 15-1.1)

CODE ANALYSIS

- Provide a full code analysis for this project; plan check cannot be performed without one.
- This plan has been reviewed as the following occupancy type:

<input type="checkbox"/> A-1	<input type="checkbox"/> A-2	<input type="checkbox"/> A-3	<input type="checkbox"/> A-4	<input type="checkbox"/> A-5	<input type="checkbox"/> B	<input type="checkbox"/> E
<input type="checkbox"/> F-1	<input type="checkbox"/> F-2	<input type="checkbox"/> H-1	<input type="checkbox"/> H-2	<input type="checkbox"/> H-3	<input type="checkbox"/> H-4	<input type="checkbox"/> H-5
<input type="checkbox"/> I-1	<input type="checkbox"/> I-2	<input type="checkbox"/> I-3 Condition: 1 2 3 4 5	<input type="checkbox"/> I-4	<input type="checkbox"/> M	<input type="checkbox"/> R-1	
<input type="checkbox"/> R-2	<input type="checkbox"/> R-3	<input type="checkbox"/> R-4	<input type="checkbox"/> S-1	<input type="checkbox"/> S-2	<input checked="" type="checkbox"/> U	

- Actual use(s) (i.e. office, storage, restaurant, etc.) - PUMP EQUIPMENT AND ELECTRICAL BUILDING
- Total Building Occupant Load (all areas combined per Chapter 10 of the IBC and IFC) 4
- Total Fire Area: 950 SF square feet. (Includes basement / useable attic space / horizontal projections). (IFC Table 8105.1)
- Type of Construction: VB
- Fire Sprinklers Required: ☐ -Yes ☒ -No ☐ -Proposed
- Automatic Fire Alarm System: ☐ -Yes ☒ -No ☐ -Proposed

FIRE FLOW REQUIREMENTS - (NOTE: This information is required only for new structures, additions to existing structures and changes to the occupancy classification of an existing building.)

- The minimum required fire flow is 1500 gpm @ 20 psi for a duration of 2 hours. (IFC Table 8105.1)
- Records indicate that the existing water system is capable of providing 1500 gpm @ 20. This estimate is based upon actual flow tests conducted at hydrant # on. 75% reduction allowed due to addition of an approved fire sprinkler system. (IFC Appendix B) 25% reduction allowed due to addition of an approved monitored automatic fire alarm system. (City of Lewiston Ordinance)
- The adjusted fire flow (based on the reductions above) is gpm. N/A TO THIS PROJECT, NO FIRE SPRINKLER OR AUTOMATIC SYSTEM
- hydrants are required, based on square footage, type of construction and req. water flow. (IFC Table 8105.1)
- Maximum distance from any point on street frontage to hydrant: 250 FT (IFC Table C105.1) feet and provide 400 foot reach.
- Fire flow of 3,000 gpm or greater. (Requires Fire Sprinklers per NFPA 13 (Lewiston City Code Section 15-1.1 (IFC Amendments).

FIRE DEPARMENT ACCESS

- 1. ADD NOTE: Approved numbers and/or letters shall be placed on all buildings to be visible from the street, color contrasting to background. Address posting is required on building, Fire Department access and on all rear doors. (IFC 505)
 - "Project requires an illuminated directory at main entrance."
 - "Individual room/suite numerals to be minimum 4 inches high X 1/2" stroke."
 - "6 inches high X 3/4" stroke"
 - "9 inches high X 1 1/4" stroke when 36-50 feet from access"
 - "12 inches high X 1 1/2" stroke when over 50 feet from access"
- 2. ADD NOTE: All required access roadways shall be completed to a minimum width of 20 feet, shall not exceed 11% in grade, be capable of supporting 78,000 lbs. with an all-weather surface and extended into within 150 feet of all stockpiles and all sides of building prior to Fire Department approval of a building permit. Access roadways to be posted "NO STOPPING/FIRE LANE" (see IFC D103.6 for sign specifications) and shall not be used for the storage of materials. (IFC 501.4, 503.4) N/A TO THIS PROJECT
- 3. ADD NOTE: "FIRE LANE" signs are required to be installed along interior access roadways where vehicle parking would encroach on the required 20 foot clear width of roadway (see IFC D103.6 for sign specifications). (IFC 503.3)
- 4. ADD NOTE: Due to the limited width of on-site roadways, it is required that no trees or high-growing shrubs shall be closer than 6' from any of the required access roadways and shall be maintained clear up to 13'6". (IFC 503.2.1)
- 5. ADD NOTE: "If security gates are desired at any entrances to the site, they shall be provided with a Fire Department approved key entry system (keybox or approved lock). The completed gates shall remain open and not obstruct the Fire Department access until inspected and approved by the Fire Prevention Bureau. Begin application processing with the Fire Department prior to the building permit being issued." (IFC 503.6) N/A TO THIS PROJECT
- 6. ADD NOTE: This project requires emergency key box (es) in a location approved by the Fire Department. Key box locations must be indicated on the plans for Fire Department approval. Key box shall be mounted five feet above the ground (floor) level, readily visible and not more than 5 feet from the main entry to the premises. Additional key boxes shall be provided adjacent to exterior riser room entry doors where said doors are more than 50 feet from the main entrance and/or the riser room is not located on the same side of the structure as the main front entry. All tenant keys shall conform to a master key system. Master keys shall be tagged and labeled. (IFC 506) Begin application process for Knox Box at www.knoxbox.com prior to building permit being issued. The following keys shall be provided in the Knox Box:
 - grand master key; ☐ -elevator key; ☐ -fire alarm cabinet key; ☐ -other: _____
- 7. Access to a fire sprinkler riser equipped with control valves shall be provided by 3-0/6-8 door directly accessible from the exterior. (IFC 509)
- 8. Where a fire sprinkler system is to be installed, the Fire Department Connection (FDC) and Post Indicator Valve (PIV) locations must be indicated on the architectural and/or civil drawings.
- 9. ADD NOTE: "ELECTRICAL ROOM" sign required on electrical room door." Sign shall be constructed of durable material, red in color with white lettering no less than 1 1/2 inches tall. Stickers and other paper type signs are not acceptable. (IFC 509.1) N/A TO THIS PROJECT
- 10. ADD NOTE: "F.A.C.P. ROOM" sign required on alarm control panel room door." Sign shall be constructed of durable material, red in color with white lettering no less than 1 1/2 inches tall. Stickers and other paper type signs are not acceptable. (IFC 509.1) N/A TO THIS PROJECT
- 11. ADD NOTE: "FIRE SPRINKLER RISER ROOM" sign required on riser room door. Sign shall be constructed of durable material, red in color with white lettering no less than 1 1/2 inches tall. Stickers and other paper type signs are not acceptable. (IFC 509.1) N/A TO THIS PROJECT
- 12. ADD NOTE: "ELEVATOR EQUIPMENT ROOM" sign required on elevator control room door. Sign shall be constructed of durable material, red in color with white lettering no less than 1 1/2 inches tall. Suckers and other paper type signs are not acceptable. (IFC 509.1)

- 13. ADD NOTE: "MAIN DISCONNECT" sign shall be provided directly adjacent to the buildings main electrical shut-off switch. Sign shall be constructed of durable material, red in color with white lettering no less than 3/4 inch tall. Where an emergency generator is present, a sign stating "GENERATOR EMERGENCY STOP" shall be provided directly adjacent said device. Stickers and other paper signs are not acceptable. (IFC 509.1)

GENERAL FIRE PROTECTION SYSTEM REQUIREMENTS N/A TO THIS PROJECT

- 14. ADD NOTE: Notice to Contractors -Installation of Fire Services Mains, Fire Sprinkler Systems, Fire Alarm Systems or other Fire Protection Systems is not allowed prior to plan approval by the Lewiston Fire Department and subsequent permit issuance from the City of Lewiston Building Department. Fire Sprinkler Systems must be approved by the Idaho State Fire Marshal's Office prior to being submitted to the Lewiston Fire Department. Contractors who engage in installation prior to appropriate approvals may be cited and the project will be red tagged. (IFC 111, 105.4, 105.7, 901.2)
- 15. ADD NOTE: All Underground Fire Service, Fire Sprinkler Systems, Fire Alarm Systems and Commercial Hood and Duct Systems require separate plans, application, review, permit and fee. Any of the above named systems included shown or noted on the building plans are to be used for bid purposes only, Fire Department approval of the building permit or any associated electrical, plumbing, and/or mechanical permit does not constitute approval of any of the above named systems. (IFC 111, 105.4, 105.7, 901.2)
- 16. ADD NOTE: To be sent electronically to: CD@CityofLewiston.org
 - Underground Fire Service Plans
 - Fire Sprinkler System Plans
 - Fire Alarm System Plans
 - Commercial Hood & Duct System Plans

UNDERGROUND FIRE SERVICE N/A TO THIS PROJECT

- 17. ADD NOTE: Underground fire service mains and all components shall conform to NFPA 24 minimum standard. The plans shall be reviewed and approved by the Fire Department prior to installation. Stamped approved plans must be kept on site for the Fire Inspector." IFC 507.2.1
- 18. ADD NOTE: All new fire hydrants shall meet the following requirements:
 - * New hydrant will be Waterson Pacer or Meuller Centurian with Storz adapter(s).
 - * 6" minimum supply for fire hydrant.
 - * If combustible building materials are used (including framing) the water supply (including mains and hydrants) shall be designed, installed, tested and approved by the Fire Department prior to stockpiling combustible building materials.
 - * Water supply systems for phased construction shall provide required fire flows at all phases."
 - * All fire hydrants shall be provided with a 5-inch Harrington HH5 Storz adaptor with the approved attached seal cap and aircraft cable.
 - * The following existing hydrants shall be provided with 5-inch Storz adapters with the approved attached seal cap and aircraft cable.
 - * All new and existing hydrants shall be installed and/or modified so the 5- inch port is facing toward the fire department vehicular access route (i.e.: road, street, lane, etc.).
- 19. Indicate with a note whether the fire sprinkler system supply will be a dedicated water supply or will be in conjunction with domestic water (NFPA 13R and 13D systems only)
- 20. ADD NOTE: Size and type of fire service mains shall be approved by the Fire Department prior to installation.

FIRE SPRINKLER SYSTEMS N/A TO THIS PROJECT

- 21. ADD NOTE: A fully automatic fire sprinkler system is required/ provided due to:
 - fire flow in excess of 3,000 gpm: Lewiston Muni Code
 - limited access on sides of building: (IFC 901.4.4)
 - International Fire Code Req. Sec. 903.2.1.1
 - minimum fire flow is not available: (IFC B105)
 - Basement over 1,500 sq ft (IFC 903.2.11)
- 22. Wet system venting shall be provided in accordance with NFPA 13 Section 7.1.5 and shall be labeled per Section 6.6.4.1.
- 23. ADD NOTE: Fire Sprinkler Systems and alterations of an existing system and all components shall conform to NFPA 13, 13R or 13D (whichever is applicable) minimum standard and shall be reviewed by the Fire Department prior to installation. Stamped, approved plans and permit must be kept on site for Fire Inspector. (IFC 105.3, 105.4, 105.5 and Lewiston City Code)
 - a. FDC/PIV locations shall be approved by the Fire Department. It is recommended that designers contact the Fire Department prior to design to verify approved locations.
 - b. Plans shall be submitted electronically to the Permit Center with all details per NFPA 13, 13R or 13D.
 - c. Contractor is required to submit a set of "as-built" documents/drawings (electronic) for approval prior to final inspection when not installed per plan.
 - d. Test required:
 - New System, 200 psi for 2 hours
 - Addition/Alteration, 150 psi for 2 hours
- 24. A listed check valve shall be provided in each riser not utilizing an alarm check valve and/or backflow detection device.
- 25. ADD NOTE: Fire Department Connection (FDC) threads shall be protected with approved Knox FDC plugs. Begin application process at www.knoxbox.com prior to permit issuance. (IFC 912.3.1)
- 26. ADD NOTE: All control valves shall be listed indicating or listed non-indicating type (NFPA 13). PIV to be located a minimum of 40' from building (NFPA 24). Approved supervised indicating control valves, flow switch and drain for shall be provided for each floor in multi-story buildings, either in the riser room or in an interior stairwell. (Lewiston City Code Section 15-1.1 (IFC Amendments).
- 27. Indicate dumpster location on site plan.
- 28. ADD NOTE: Large trash receptacles, commonly known as dumpsters that are place adjacent to structures or in areas where heavy accumulation of combustibles are expected, shall be protected with at least one automatic fire sprinkler head. If the building is not equipped with a fire sprinkler system, the dumpster shall not be stored in the building or placed within 5 feet of combustible walls, openings or combustible roof eave lines. (IFC 304.3.3) N/A TO THIS PROJECT

FIRE ALARM SYSTEMS

- 29. ADD NOTE: Fire Alarm System is required/ provided due to:
 - 20 or more sprinkler heads per IFC 903.4
 - IFC section
 - 25% reduction of required fire flow (Lewiston City Code Section 15-1.1 (IFC Amendments).
 - Other
- 30. ADD NOTE: The following is required for all Fire Alarm Systems:
 - a. Central Station monitoring of fire control unit (alarm panel). (IFC 907.6)
 - b. Interconnection of the duct detectors to the fire alarm system. Duct smoke detectors shall initiate a supervisory condition at the fire alarm panel and shall be provided with remote annunciator/test switches. Locations of said appliances shall be indicated on the plans and approved by the Fire Department before installation. (IMC 606.2.2, NFPA 72, Section 5.14.5.8 and/or IFC 907.3.1)
 - c. Occupant notification. Activation of any fire suppression or alarm appliance shall activate the premises occupant notification system. (IFC 907.1, 907.5 and NFPA 72) NOTE: Where the occupancy is classified as an "R" or an "I" where the occupants may be sleeping, audible notification shall be provided to the sleeping area in accordance with NFPA 72.
 - d. When two or more visible appliances are present, synchronization of the visible signal is required.
 - e. Audibility and visibility of notification appliances will be field verified at time of acceptance testing to ensure they are located per section above.
 - f. Zone maps and operating instructions shall be provided for all systems at the fire alarm panel and annunciator locations

- g. As-built drawings shall be provided to the Fire Department prior to final acceptance testing. An additional set of as-built drawings shall be provided in an approved location within the protected premises.
- 31. Indicate location of the fire alarm control panel and remote annunciator(s) on the architectural drawings. Annunciators shall be provided within 10 feet of the main front entrance, at the fire sprinkler riser controls, at each Fire Department keybox location and where necessary for fire-fighting or life safety purposes as determined by the Fire Department. The fire alarm control panel may be utilized in one of the locations defined above, to substitute the installation of a remote annunciator. (IFC 907.6.3.1, NFPA 72)
- 32. ADD NOTE: "Fire Alarm System and all components shall conform to NFPA 72 minimum standards and shall be reviewed and approved by the Fire Department prior to installation. Stamped, approved plans and permit must be kept on site for the Fire Inspector. All systems shall comply with the most recently published edition of NFPA 72. (IFC 907, 105.3, 105.4, 105.5 and Lewiston City Code)
 - a. Fire Alarm contractor must obtain a Fire Alarm System Application from Fire Dept prior to submittal.
 - b. Completed Fire Alarm System Application must be included with all Fire Alarm plan submittals."
 - c. Fire Alarm to be monitored by an approved and UL listed central station.
- 33. ADD NOTE: Detectors shall not be installed until after the construction cleanup of all trades is complete and final. (NFPA 72)
- 34. ADD NOTE: Duct Detectors shall be required in the return air supply for all systems where required by the International Mechanical Code (IMC).
- 35. ADD NOTE: Install smoke alarms(s) per IBC, IFC and applicable NFPA 72. Detectors shall be interconnected in all residential occupancies. (NFPA 72, section 11.5.1.2 (B), IFC 907.2.10.3)

OTHER FIRE PROTECTION SYSTEMS

- 36. Indicate hand portable fire extinguisher rating and location on plan. Fire extinguishers shall be in conspicuous locations, at least one shall be within 5 feet of the main entrance/exit and all extinguishers shall be unobstructed and unobscured. (IFC 906.3, 906.5 and 906.6)
 - 2A:10BC; one per 3000 square feet or fraction thereof; maximum travel distance 75'; mounted on a wall 3-5 feet above finished floor. (IFC 906)
 - "K" for Commercial Kitchen (IFC 904.11.5)
 - 40BC Located for use at flammable liquid storage and/or use locations (including motor vehicles).
 - OTHER: N/A TO THIS PROJECT
- 37. ADD NOTE: Type I Hood Required (IFC 609)
 - An automatic fire extinguishing system is required for the protection of commercial cooking equipment and all hood, duct, plenum and cooking surfaces.
 - a. Hood & Duct requires separate application, plans, specs, approval, fee and permit.
 - b. System shall comply with current U.L. 300 standards per manufacturer's installation requirements and specs.
 - c. System shall meet all NFPA 17A, IFC, IBC and IMC requirements.
- 38. ADD NOTE: Hood system shall initiate a zone alarm at the fire alarm panel in all sprinklered and/or alarmed buildings." (NFPA 72, section 5.11, IFC 907.14) N/A TO THIS PROJECT

OTHER FIRE DEPARTMENT REQUIREMENTS

- 39. ADD NOTE: Emergency escape and rescue openings shall have a minimum net clear opening of 5.7 square feet. Minimum net clear opening height 24", minimum net clear opening width 20". Bottom of clear opening shall not be greater than 44" from the floor. (IFC 1029.2, 1029.2.1, 1029.3)
- 40. Indicate locations of emergency lighting and illuminated exit signage on plans. (IFC 1006, 1011)
- 41. Provide details indicating location and dimensions of fixtures and displays. Dimensions to include height, length and width of fixtures and displays and their distance from adjacent fixtures and displays. (IFC 314, IFC 10, IFC 23)
- 42. ADD NOTE: Occupant load sign shall be posted in every room/space that is an assembly occupancy. The sign shall be posted in a conspicuous place, near the main exit from the room or space. Approved occupant load signs are available from the Lewiston Fire Department Fire Prevention Division. (IFC 1003.2.2.5) N/A TO THIS PROJECT
- 43. ADD NOTE: Attic, under-floor, concealed spaces and basements used for storage of combustible materials shall be protected on the storage side as required for 1-hour fire-resistance-rated construction. Openings shall be protected by assemblies that are self-closing and are of noncombustible construction or solid wood core not less than 1.75 inches in thickness. (IFC 315.2.4, City Code 15-1.1(i)) N/A TO THIS PROJECT
- 44. Provide a Hazardous Materials Management Plan (HMMP) per IFC 5001.5.1, and Hazardous Materials Inventory Statement (HMIS) per IFC 5001.5.2.Examples of qualified preparer may be a Fire Protection Engineer, Professional Engineer of related field, Chemist, Firm or Corporation approved by the Fire Marshal. PROVIDED BY CITY
- * ADD NOTE: "All site inspections require a minimum 24 hours' notice. ALL FIRE DEPARTMENT INSPECTIONS ARE TO BE REQUESTED THROUGH THE FIRE DEPARTMENT (208 743-3554), PLEASE BE SPECIFIC AS TO TYPE OF INSPECTION REQUESTED."
- * ADD NOTE: "Project shall comply with the provisions of IFC 105.3.6 Compliance with code."

- NOTE TO APPLICANT: THE FIRE DEPARTMENT CANNOT APPROVE THE ISSUANCE OF A BUILDING PERMIT UNTIL THE APPLICABLE ITEMS ABOVE ARE CORRECTED AND THE FOLLOWING ITEMS ARE COMPLETED:
 - ACCESS ROADS (approved plans, installation of road and required signage and letter of completion from licensed engineer)
 - FIRE HYDRANTS (approved location(s) on plans, installation, testing and placed into service)
 - KNOX FIRE DEPT. EQUIPMENT (completed application and payment to Knox Corporation)
 - KEY BOX; -FDC PLUGS; -PADLOCK; -DOCUMENT/ KEY CABINET

If you have ANY questions regarding your preliminary plan review comments PLEASE call us directly for clarification prior to submitting your finalized plans, we want to assist you in meeting Fire Code requirements quickly, so your project can move forward to construction. If you would like an electronic version of your comments, please email us at firedept@cityoflewiston.org. Please include your name, address of the project and the reviewers name in your request.



J-U-B ENGINEERS, INC.

J-U-B ENGINEERS, INC.
201 South Jackson Street
Moscow, ID 83843

Phone: 208.746.9010
www.jub.com

REUSE OF DRAWINGS
J-U-B SHALL RETAIN ALL COMMON LAW STATUTORY, COPYRIGHT AND OTHER RESERVED RIGHTS OF THESE DRAWINGS, AND THE SAME SHALL NOT BE REUSED WITHOUT JUB'S PRIOR WRITTEN CONSENT. ANY REUSE OF THESE DRAWINGS WITHOUT JUB'S PRIOR WRITTEN CONSENT SHALL BE AT THE USER'S SOLE RISK AND WITHOUT LIABILITY OR LEGAL EXPOSURE TO JUB.

REVISION		BY		DATE	
NO.	DESCRIPTION	NO.	DESCRIPTION	BY	DATE

WELL NO. 7
WELL COMPLETION

FIRE DEPARTMENT REVIEW COMMENTS FORM

FILE: 21-20-007_F-001
JUB PROJ. #: 21-20-007
DRAWN BY: BK
DESIGN BY: BK
CHECKED BY: DLW
ONE INCH
AT FULL SIZE, IF NOT ONE INCH, SCALE ACCORDINGLY
LAST UPDATED: 7/7/2021
SHEET NUMBER:

F-001

Add. 5

LEGEND

- ⊕ FOUND 2" DIAMETER ALUMINUM CAP
- FOUND BRASS CAP
- △ SURVEY CONTROL POINT
- ⊙ FOUND IRON PIPE
- FOUND 1/2" REBAR
- FOUND 5/8" REBAR

BENCHMARK/DATUM



5/8" REBAR WITH YELLOW PLASTIC CAP MARKED "JUB ENGINEERS" NEAR THE NORTHEAST SIDE OF THE INTERSECTION OF 6TH STREET AND STEWART AVENUE. SHOWN AS SURVEY CONTROL POINT 1.
ELEVATION= 1312.83'
VERTICAL IS NAVD '88.

SURVEY CONTROL

POINT #	NORTHING	EASTING	ELEVATION	DESCRIPTION
1	1724775.21	2308801.96	1312.83	CP5-JUBCAP
2	1725436.39	2308779.15	1275.95	PK
3	1725325.73	2308366.79	1229.40	CP5
4	1725040.14	2308403.52	1243.26	CP5
200	1726073.56	2308774.08	1241.94	BRC 3.5" UNREADABLE
201	1724753.45	2308750.89	1310.08	ALC2" RIMROCK LS10162 YR2008 1\4CORNNER

BASIS OF BEARING

THE BASIS OF BEARINGS FOR THIS SURVEY IS SOUTH 01°00'23" WEST BETWEEN THE MONUMENTED CENTERLINE MONUMENT ALONG 6TH STREET AND THE EAST 1/4 CORNER OF SECTION 7, TOWNSHIP 35 NORTH, RANGE 5 WEST, BOISE MERIDIAN, AS ESTABLISHED BY GPS, IDAHO WEST STATE PLANE COORDINATE SYSTEM, ALL BEARINGS SHOWN ARE AT GRID AZIMUTH, ALL DISTANCES ARE PROJECTED TO GROUND VALUES.

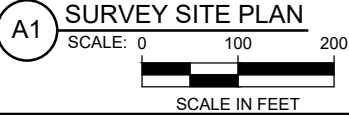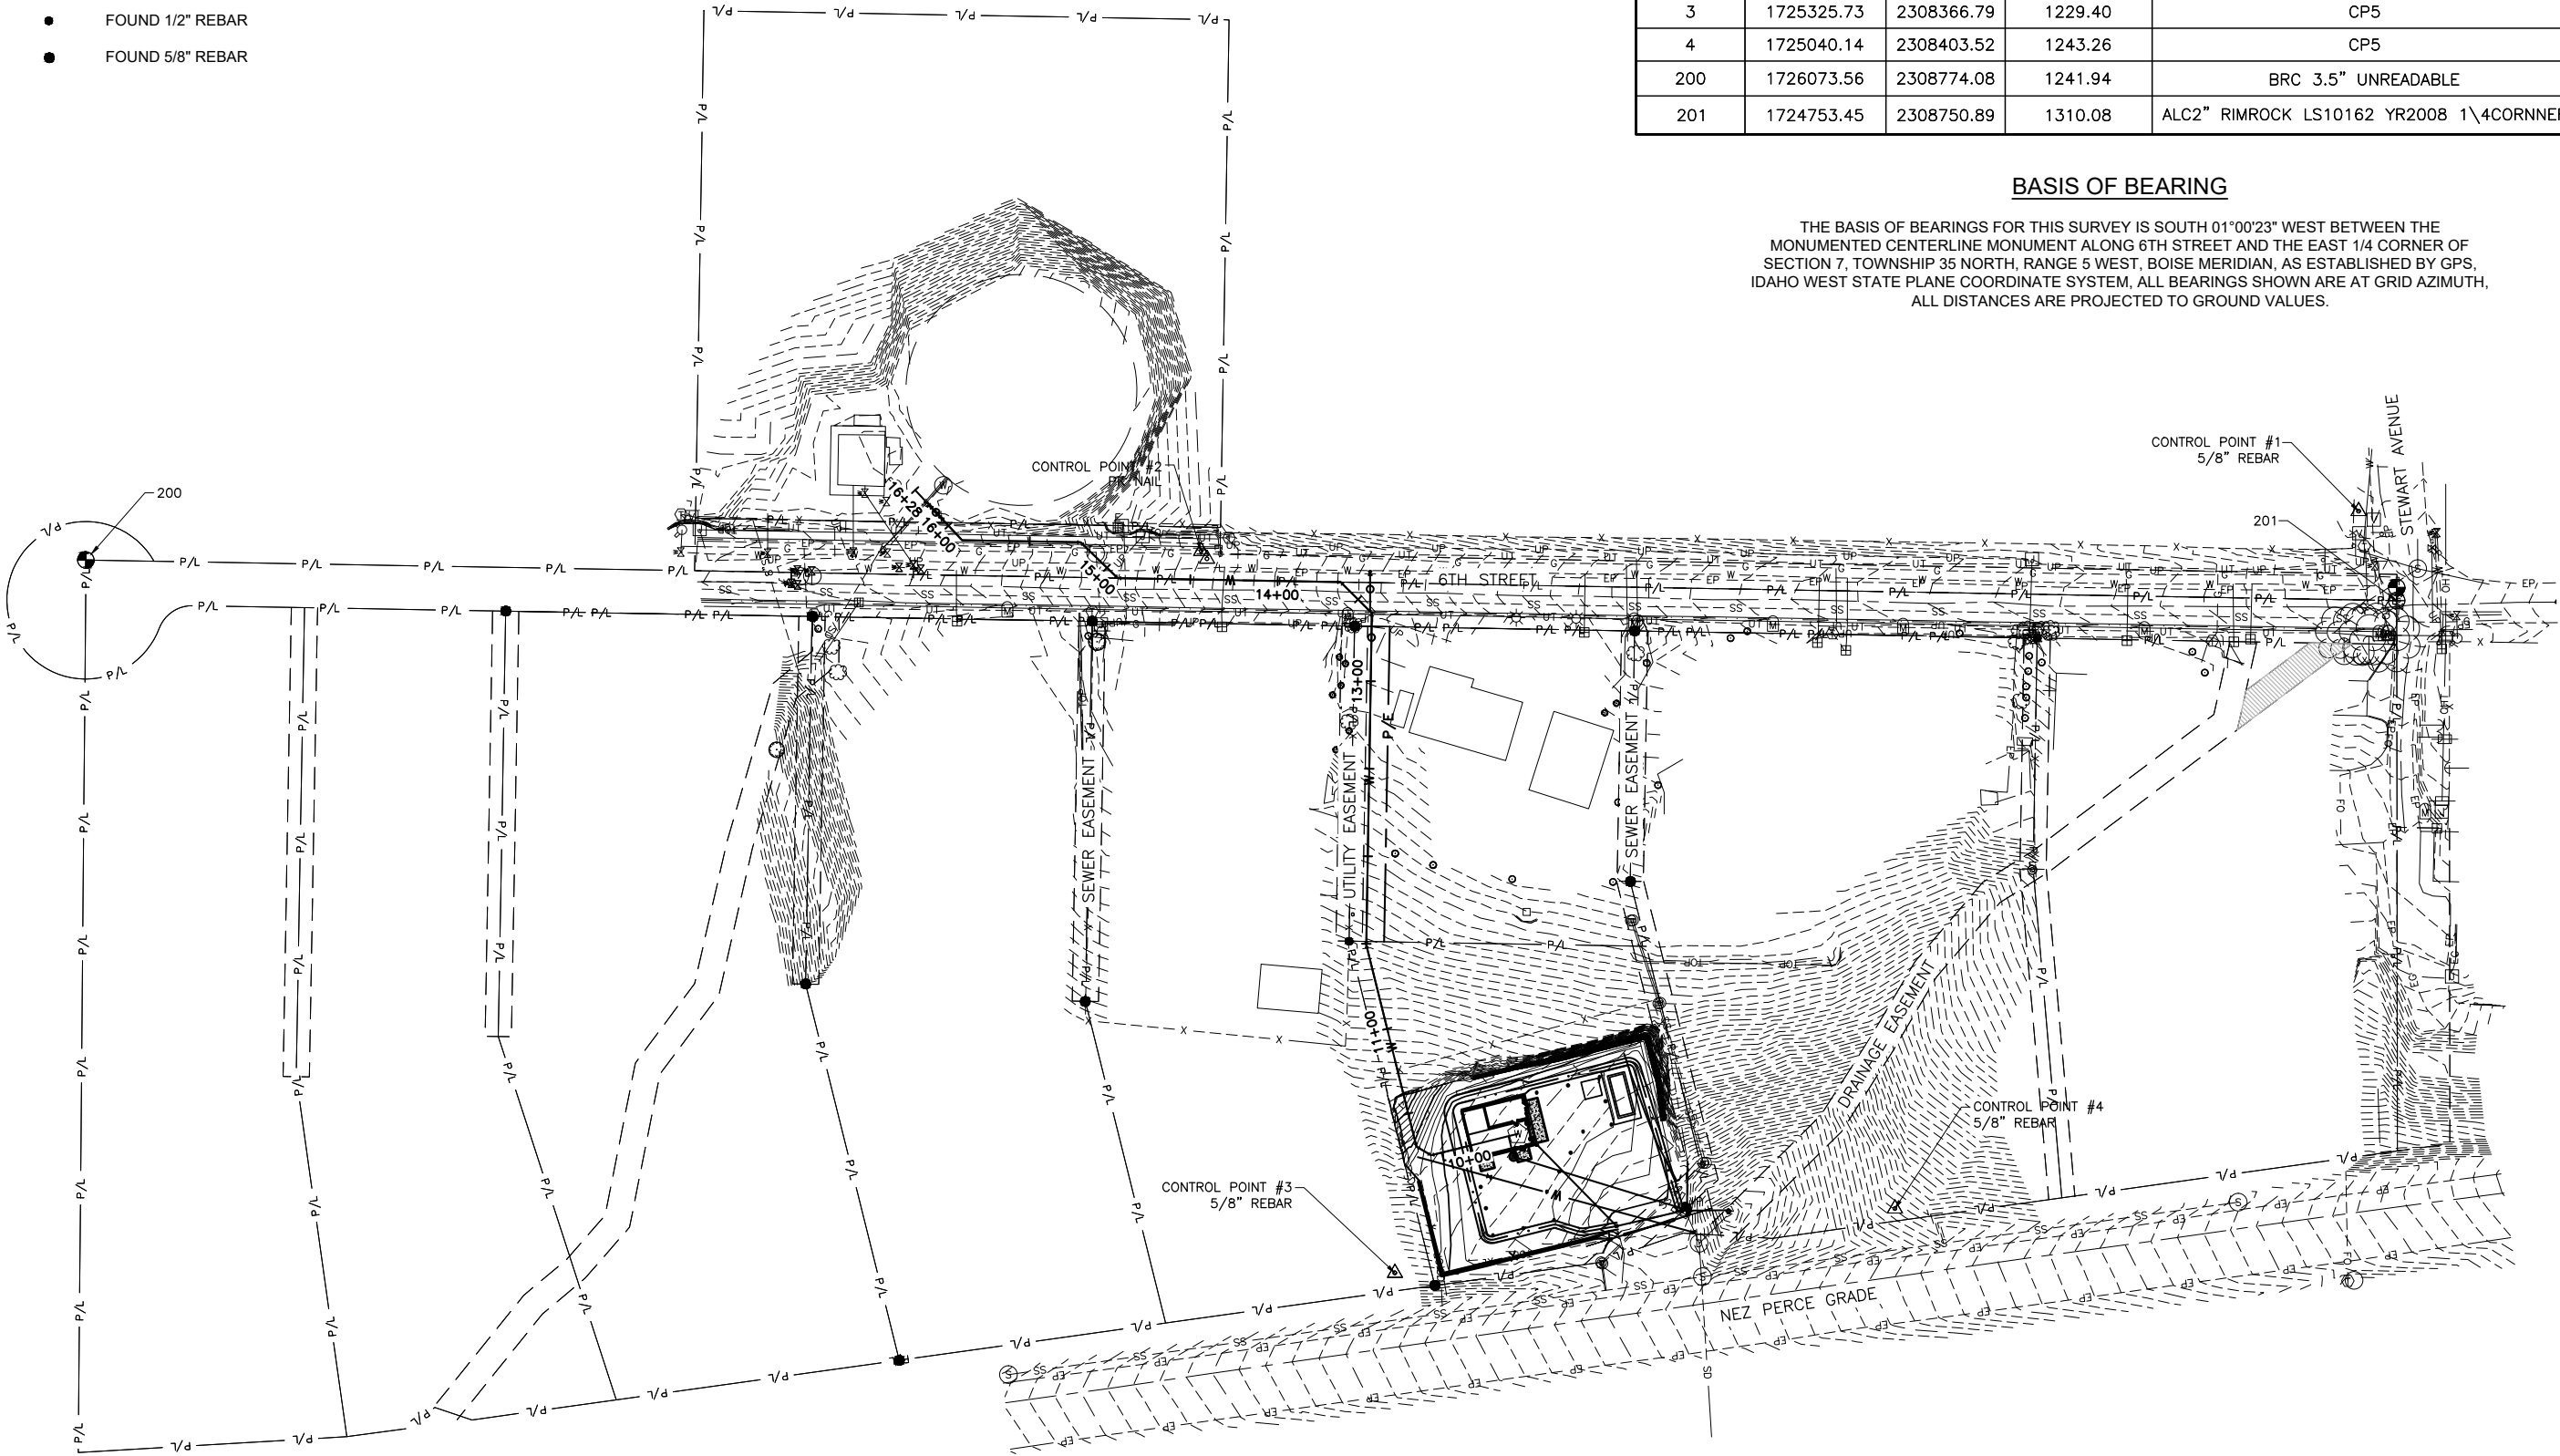

SURVEYOR'S NOTE:

THIS MAP CORRECTLY REPRESENTS A SURVEY MADE BY ME OR UNDER MY DIRECTION IN CONFORMANCE WITH THE REQUIREMENTS OF THE SURVEY RECORDING ACT AT THE REQUEST OF THE CITY OF LEWISTON, APRIL 2020.



J-U-B ENGINEERS, INC.

J-U-B ENGINEERS, INC.
201 South Jackson Street
Moscow, ID 83843

Phone: 208.746.9010
www.jub.com

REUSE OF DRAWINGS
JUB SHALL RETAIN ALL COMMON LAW, STATUTORY, COPYRIGHT AND OTHER RIGHTS IN THIS DRAWING. NO PART OF THIS DRAWING SHALL BE REPRODUCED OR TRANSMITTED IN ANY FORM OR BY ANY MEANS, ELECTRONIC OR MECHANICAL, INCLUDING PHOTOCOPYING, RECORDING, OR BY ANY INFORMATION STORAGE AND RETRIEVAL SYSTEM, WITHOUT THE WRITTEN CONSENT OF JUB. ANY REUSE WITHOUT WRITTEN CONSENT BY JUB WILL BE AT CLIENT'S SOLE RISK AND WITHOUT LIABILITY OR LEGAL EXPOSURE TO JUB.

REVISION		BY		DATE
NO.	DESCRIPTION			


WELL NO. 7
WELL COMPLETION

SURVEY CONTROL

FILE: 21-20-007_V-101
JUB PROJ. #: 21-20-007
DRAWN BY: ARB
DESIGN BY: BK
CHECKED BY: DLW
AT FULL SIZE, IF NOT ONE INCH, SCALE ACCORDINGLY
LAST UPDATED: 5/25/2021


SHEET NUMBER:

V-101

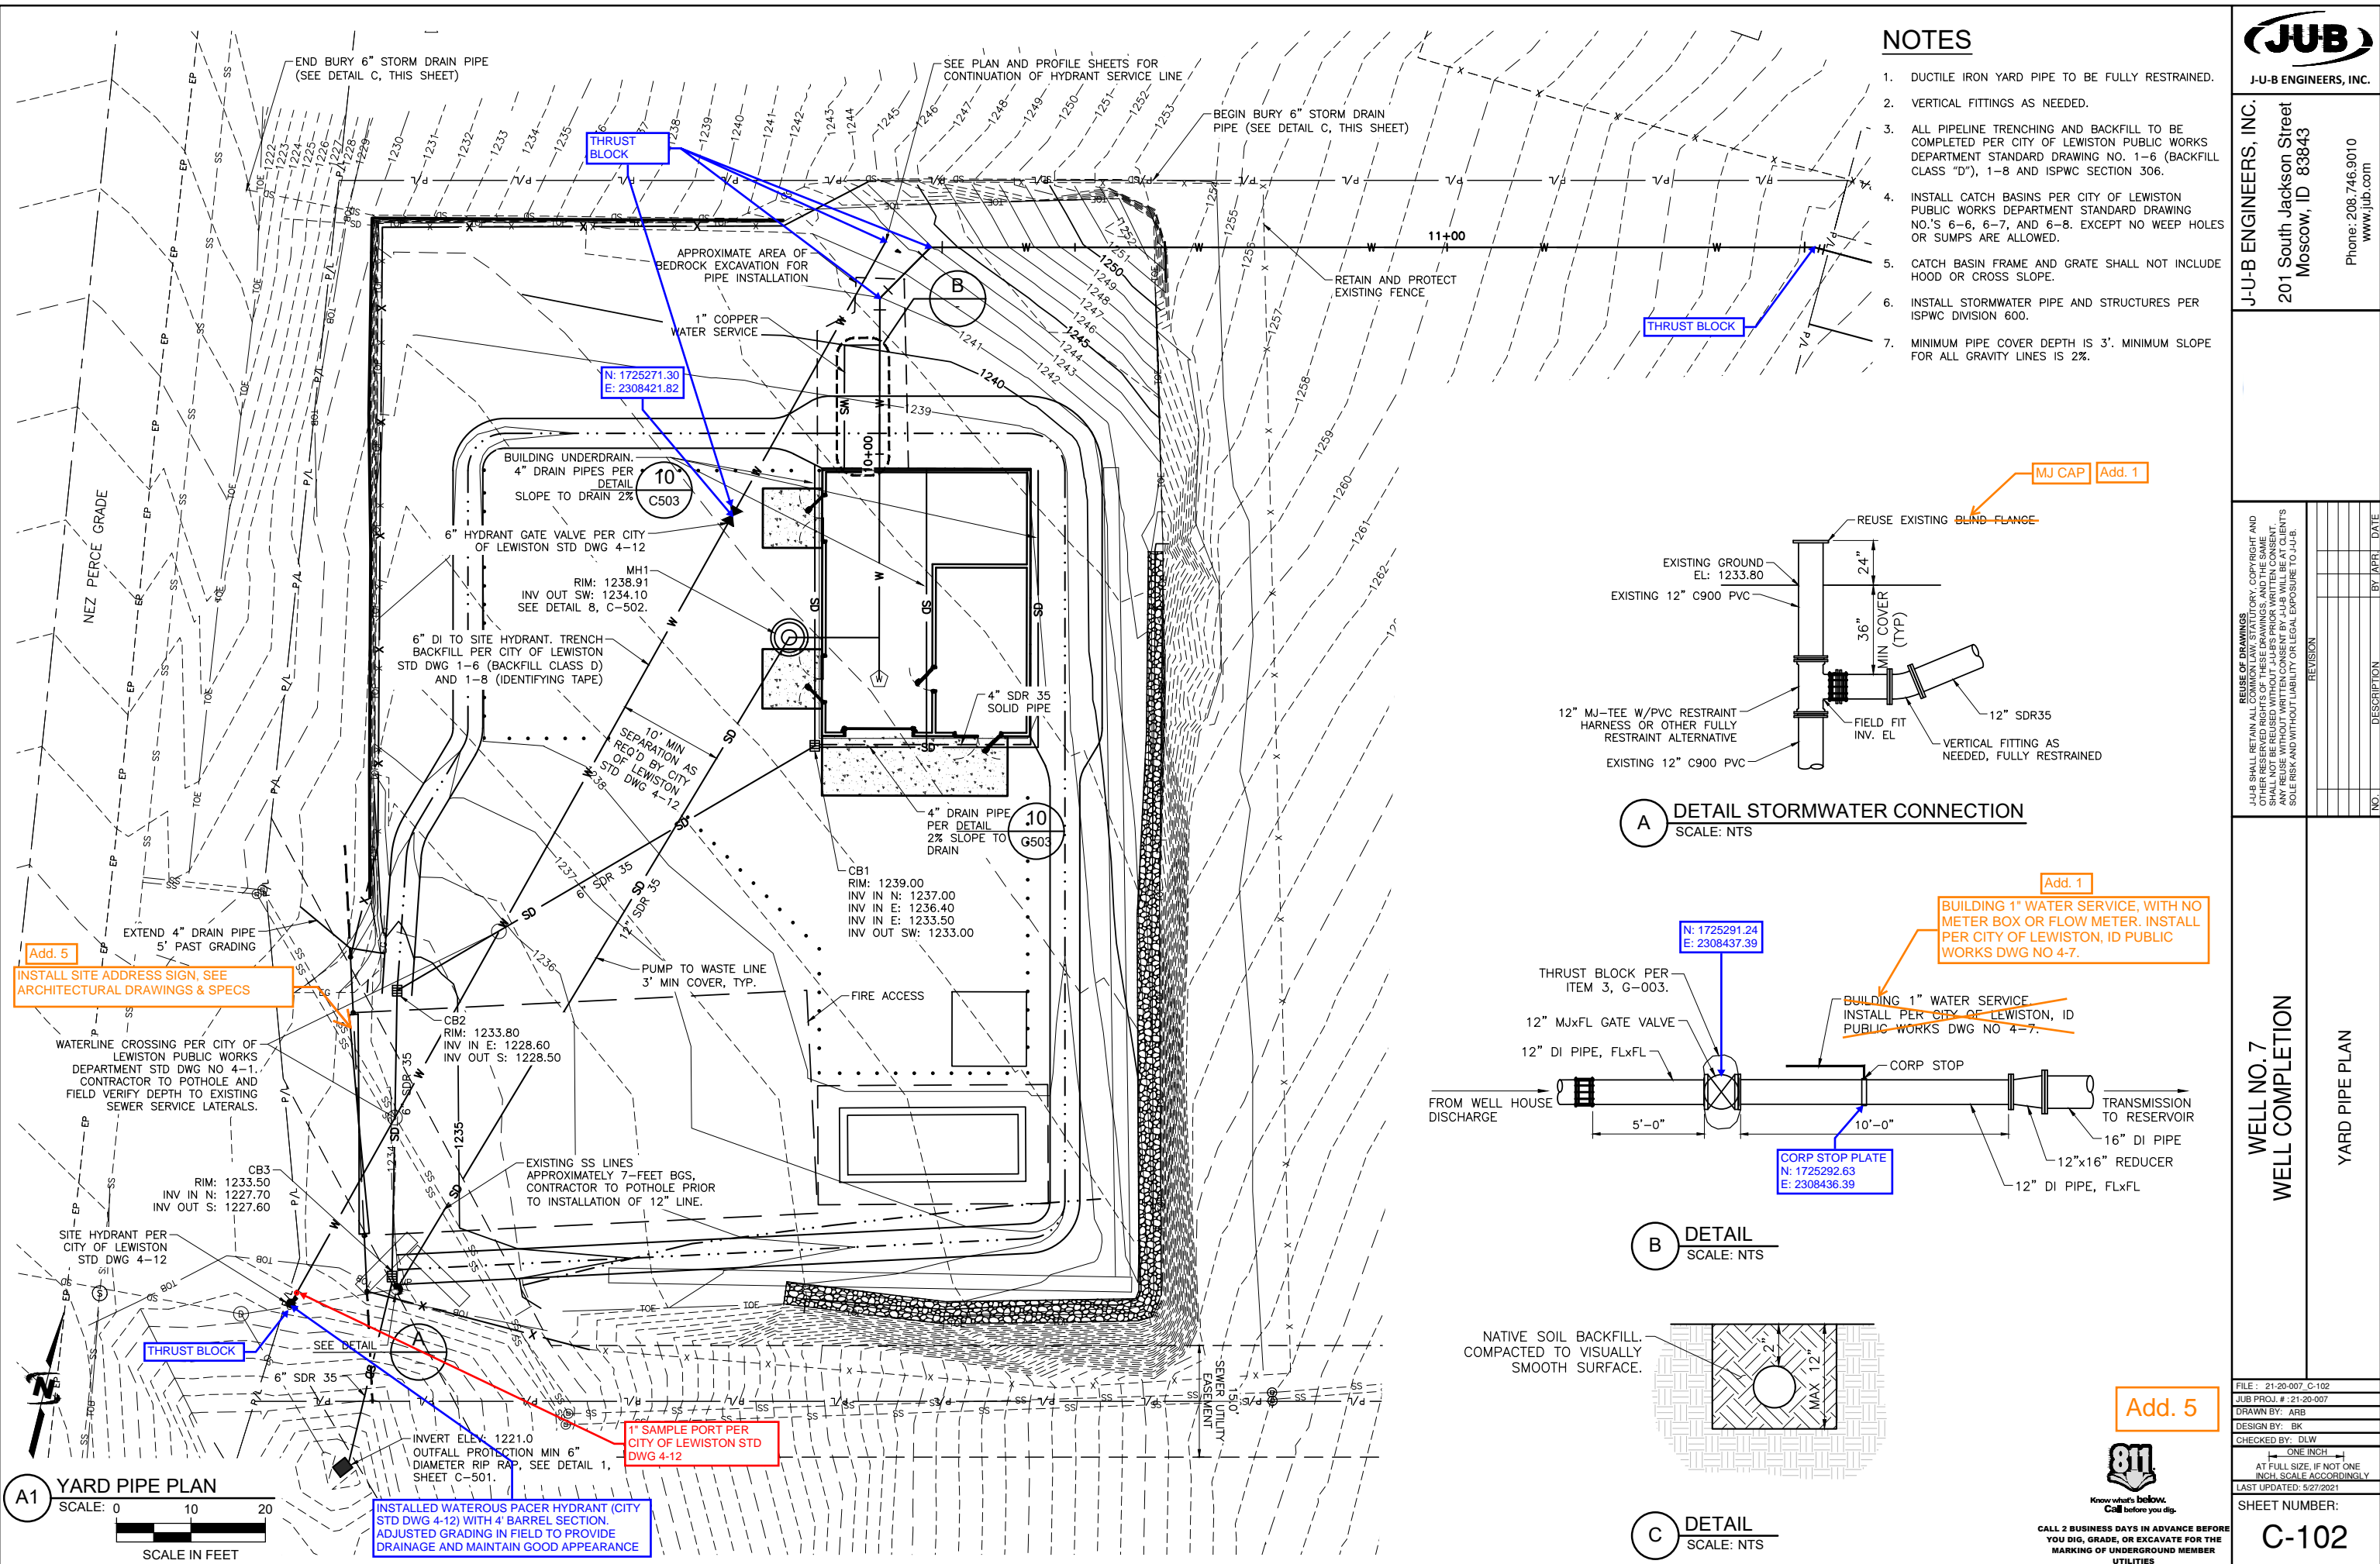



Plot Date: 5/27/2021 9:40 AM Plotted By: Allen Beahm
Date Created: 5/25/2021 \\JUB.COM\CENTRAL CLIENTS\IDLEWIS\CONTRACTS\21-20-007 WELL NOT DESIGN\130- WELL COMPLETION\CAD SHEET\21-20-007 C-103.DWG

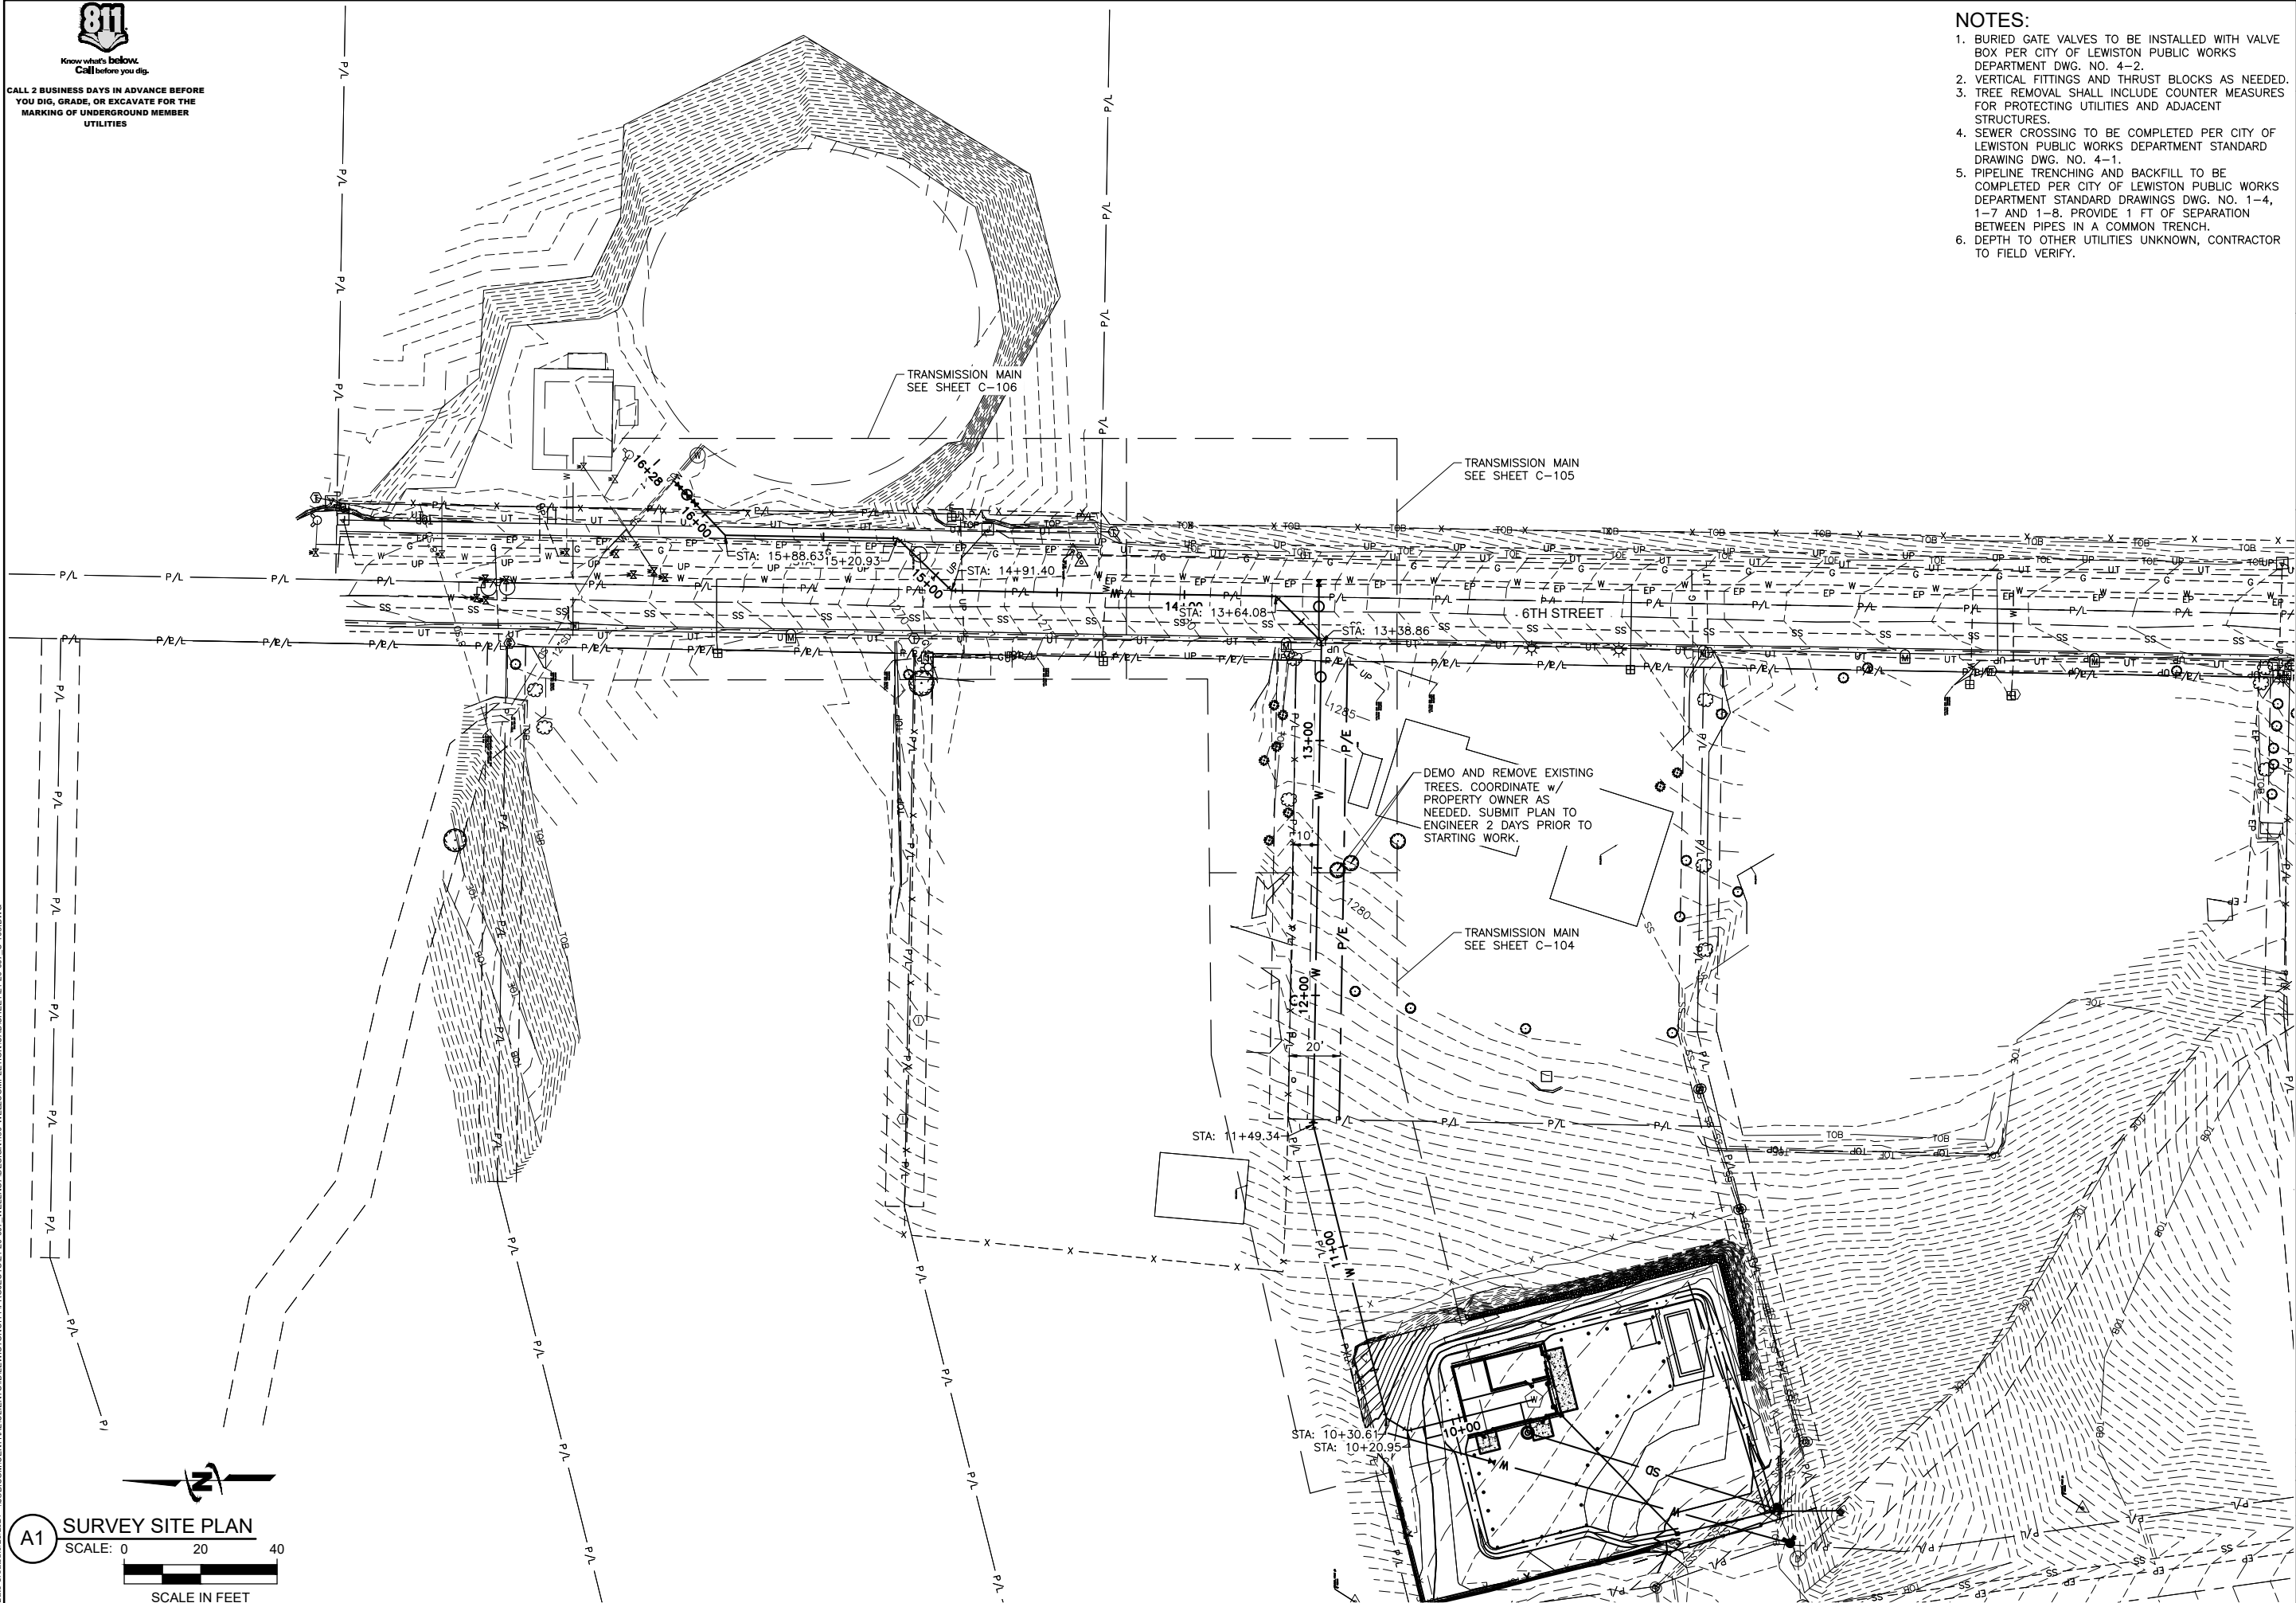


NOTES:

1. BURIED GATE VALVES TO BE INSTALLED WITH VALVE BOX PER CITY OF LEWISTON PUBLIC WORKS DEPARTMENT DWG. NO. 4-2.
2. VERTICAL FITTINGS AND THRUST BLOCKS AS NEEDED.
3. TREE REMOVAL SHALL INCLUDE COUNTER MEASURES FOR PROTECTING UTILITIES AND ADJACENT STRUCTURES.
4. SEWER CROSSING TO BE COMPLETED PER CITY OF LEWISTON PUBLIC WORKS DEPARTMENT STANDARD DRAWING DWG. NO. 4-1.
5. PIPELINE TRENCHING AND BACKFILL TO BE COMPLETED PER CITY OF LEWISTON PUBLIC WORKS DEPARTMENT STANDARD DRAWINGS DWG. NO. 1-4, 1-7 AND 1-8. PROVIDE 1 FT OF SEPARATION BETWEEN PIPES IN A COMMON TRENCH.
6. DEPTH TO OTHER UTILITIES UNKNOWN, CONTRACTOR TO FIELD VERIFY.



REUSE OF DRAWINGS
J-U-B SHALL RETAIN ALL COMMON LAW, STATUTORY, COPYRIGHT AND OTHER RESERVED RIGHTS OF THESE DRAWINGS, AND THE SAME SHALL NOT BE REUSED WITHOUT J-U-B'S PRIOR WRITTEN CONSENT. ANY REUSE WITHOUT WRITTEN CONSENT BY J-U-B WILL BE AT CLIENT'S SOLE RISK AND WITHOUT LIABILITY OR LEGAL EXPOSURE TO J-U-B.

<h1 style="margin: 0;">WELL NO. 7 WELL COMPLETION</h1>	<h1 style="margin: 0;">TRANSMISSION MAIN TO RESERVOIR TANK</h1>
FILE : 21-20-007_C-103	
JUB PROJ. # : 21-20-007	
DRAWN BY: ARB	
DESIGN BY: BK	
CHECKED BY: DLW	
<div style="display: flex; align-items: center; justify-content: center;"> <div style="text-align: center; margin-right: 10px;">  <p>ONE INCH</p> </div> <div style="text-align: center;"> <p>AT FULL SIZE. IF NOT ONE INCH, SCALE ACCORDINGLY.</p> </div> </div>	
LAST UPDATED: 5/25/2021	
SHEET NUMBER:	
<h1 style="margin: 0;">C-103</h1>	

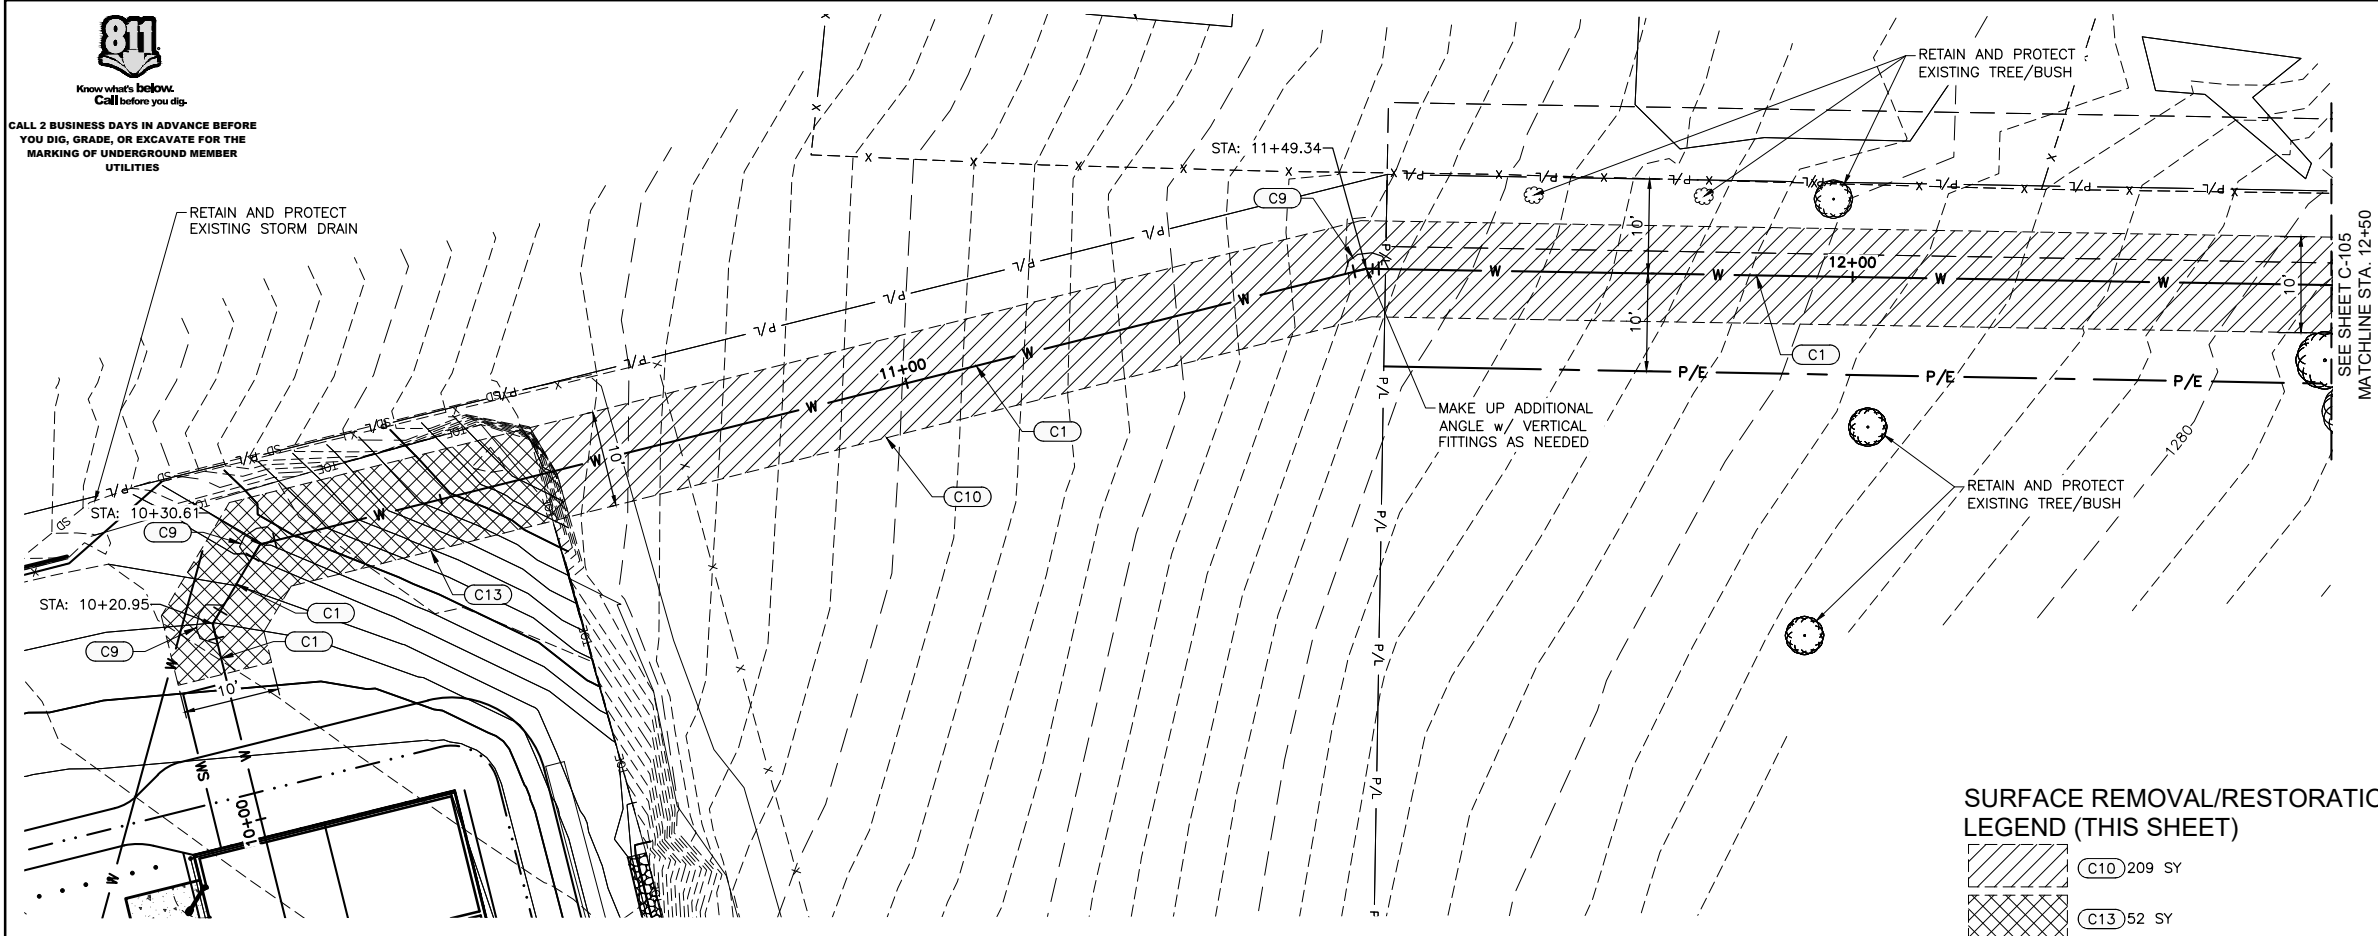

NOTES:

1. BURIED GATE VALVES TO BE INSTALLED WITH VALVE BOX PER CITY OF LEWISTON PUBLIC WORKS DEPARTMENT DWG. NO. 4-2.
2. VERTICAL FITTINGS AND THRUST BLOCKS AS NEEDED.
3. TREE REMOVAL SHALL INCLUDE COUNTER MEASURES FOR PROTECTING UTILITIES AND ADJACENT STRUCTURES.
4. SEWER CROSSING TO BE COMPLETED PER CITY OF LEWISTON PUBLIC WORKS DEPARTMENT STANDARD DRAWING DWG. NO. 4-1.
5. PIPELINE TRENCHING AND BACKFILL TO BE COMPLETED PER CITY OF LEWISTON PUBLIC WORKS DEPARTMENT STANDARD DRAWINGS DWG. NO. 1-4, 1-7 AND 1-8. PROVIDE 1 FT OF SEPARATION BETWEEN PIPES IN A COMMON TRENCH.
6. DEPTH TO OTHER UTILITIES UNKNOWN, CONTRACTOR TO FIELD VERIFY.

KEYED NOTES:	
C1	16" DI WATER TRANSMISSION MAIN AND 6" DI HYDRANT SERVICE LINE W/ CLASS A BACKFILL (DWG. 1-4)
C2	16" DI WATER TRANSMISSION MAIN W/ CLASS F BACKFILL (DWG. 1-7)
C3	12" DI WATER TRANSMISSION MAIN W/ CLASS F BACKFILL (DWG. 1-7)
C4	6" DI HYDRANT SERVICE LINE W/ CLASS F BACKFILL (DWG. 1-7)
C5	TIE IN TO HIGH PRESSURE LINE
C6	TRANSMISSION TIE IN
C7	TRANSMISSION MAIN COMBINATION AIR/VAC VALVE
C8	ABANDON SEWER FORCEMAIN IN PLACE, PLUG CUT ENDS WITH 2 FT OF GROUT
C9	THRUST BLOCK PER ITEM 3, G-003.
C10	NATURAL SURFACE RESTORATION PER DETAIL 3, SHEET C-501.
C11	SIDEWALK, CURB AND GUTTER SURFACE RESTORATION PER CITY OF LEWISTON PUBLIC WORKS DEPARTMENT DWG. NO. 2-8.
C12	ASPHALT SURFACE RESTORATION PER CITY OF LEWISTON PUBLIC WORKS DEPARTMENT DWG. NO. 3-4 FOR ASPHALT PAVEMENT ONLY.
C13	SEE SHEET C-101 FOR SURFACE REPAIR
C14	CONCRETE GUTTER PER CITY OF LEWISTON PUBLIC WORKS DEPARTMENT DWG. NO. 2-8.



201 South Jackson Street
Moscow, ID 83843

www.jub.com

www.jub.com

OTHER RESERVED RIGHTS OF THESE DRAWINGS, AND THE SAME SHALL NOT BE REUSED WITHOUT J-U-B'S PRIOR WRITTEN CONSENT. ANY REUSE WITHOUT WRITTEN CONSENT BY J-U-B WILL BE AT CLIENT'S SOLE RISK AND WITHOUT LIABILITY OR LEGAL EXPOSURE TO J-U-B.

REVISION					
NO.	DESCRIPTION	BY	APR.	DATE	

WELL NO. 7
WELL COMPLETION

PLAN AND PROFILE


21-20-007_C-103
PROJ. # : 21-20-007
OWN BY: ARB
GN BY: BK
CHECKED BY: DLW

ONE INCH
AT FULL SIZE, IF NOT ONE
INCH, SCALE ACCORDINGLY
UPDATED: 5/25/2021

PAGE NUMBER:

0.104

C-104

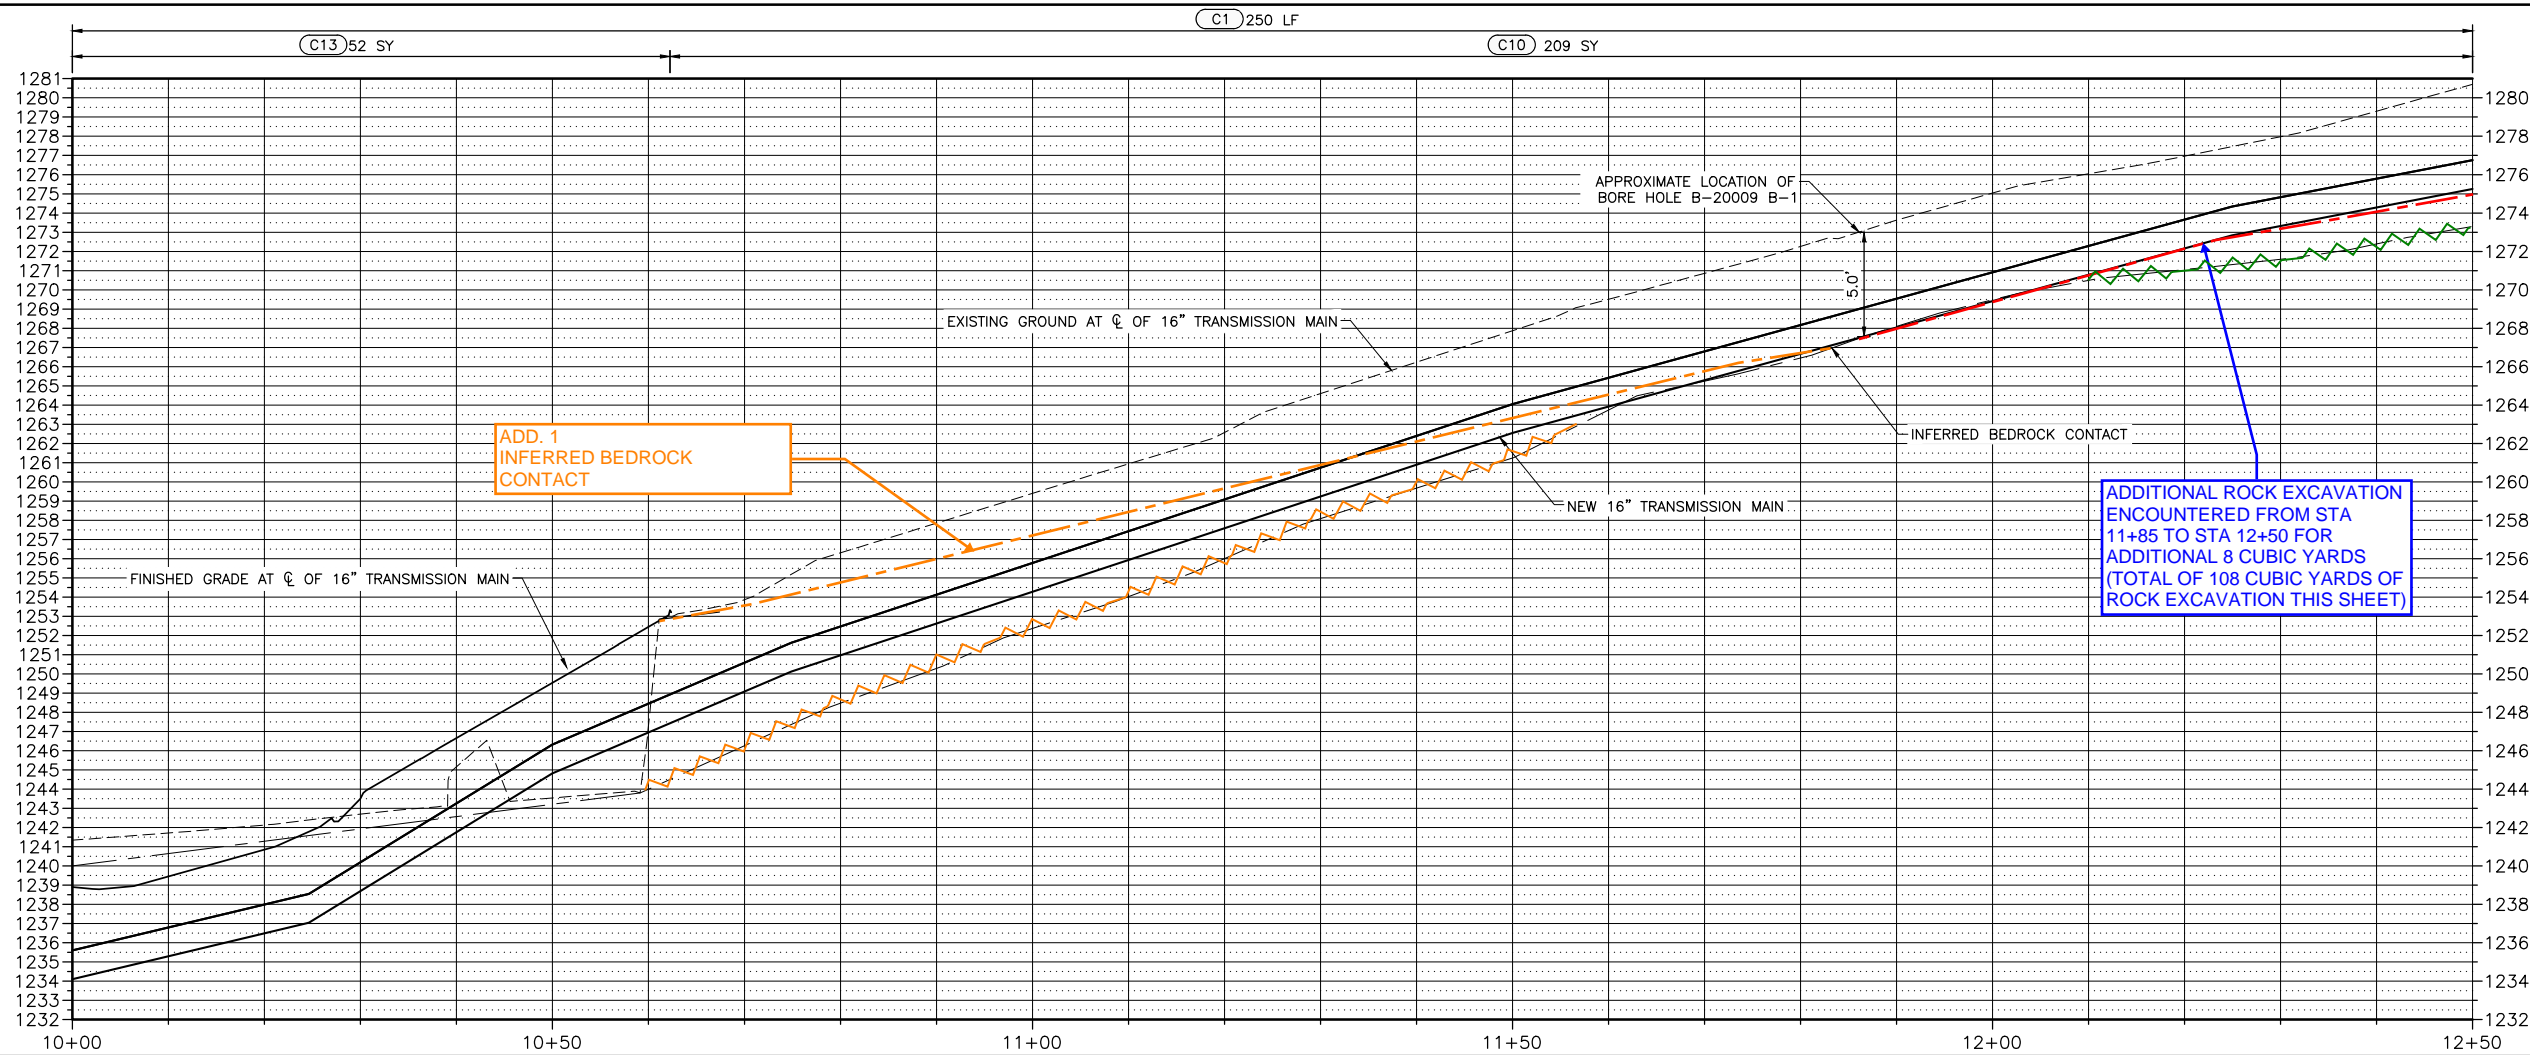


Add. 1

C-104



Know what's below.
Call before you dig.

CALL 2 BUSINESS DAYS IN ADVANCE BEFORE
YOU DIG, GRADE, OR EXCAVATE FOR THE
MARKING OF UNDERGROUND MEMBER
UTILITIES

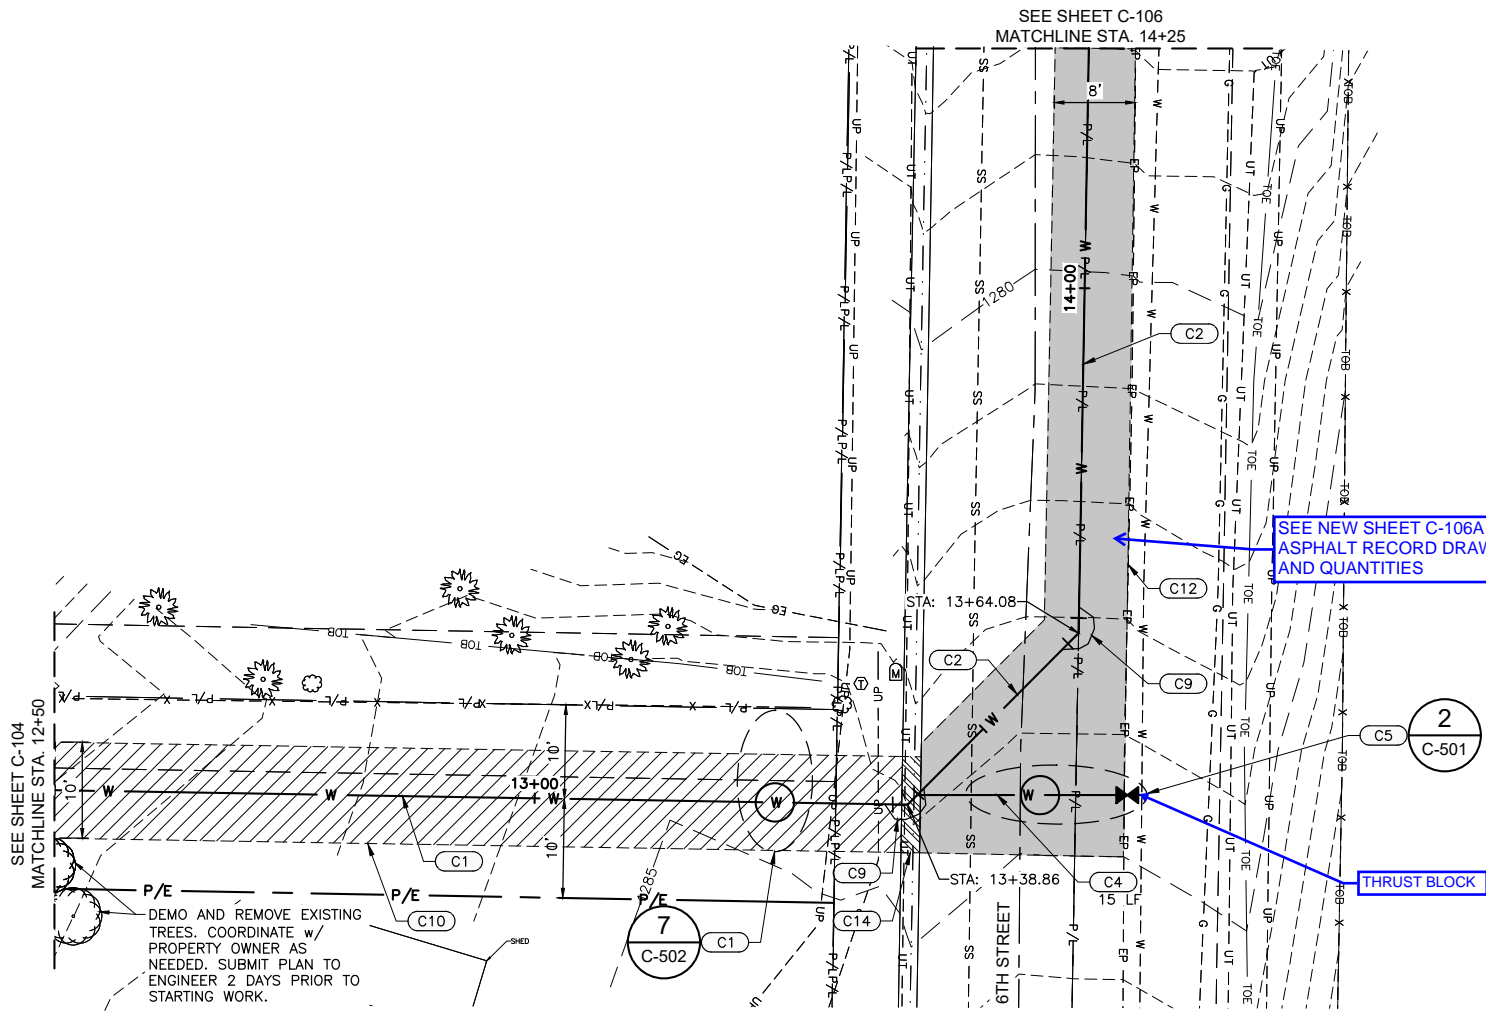

SEE NEW SHEET C-106A FOR
ASPHALT RECORD DRAWINGS
AND QUANTITIES

THRUST BLOCK

SURFACE REMOVAL/RESTORATION LEGEND (THIS SHEET)

	C10 98 SY
	C12 105 SY
	C14 10 LF

SEE NEW SHEET C-106A FOR
ASPHALT RECORD DRAWINGS
AND QUANTITIES

NOTES:

- BURIED GATE VALVES TO BE INSTALLED WITH VALVE BOX PER CITY OF LEWISTON PUBLIC WORKS DEPARTMENT DWG. NO. 4-2.
- VERTICAL FITTINGS AND THRUST BLOCKS AS NEEDED.
- TREE REMOVAL SHALL INCLUDE COUNTER MEASURES FOR PROTECTING UTILITIES AND ADJACENT STRUCTURES.
- SEWER CROSSING TO BE COMPLETED PER CITY OF LEWISTON PUBLIC WORKS DEPARTMENT STANDARD DRAWING DWG. NO. 4-1.
- PIPELINE TRENCHING AND BACKFILL TO BE COMPLETED PER CITY OF LEWISTON PUBLIC WORKS DEPARTMENT STANDARD DRAWINGS DWG. NO. 1-4, 1-7 AND 1-8. PROVIDE 1 FT OF SEPARATION BETWEEN PIPES IN A COMMON TRENCH.
- DEPTH TO OTHER UTILITIES UNKNOWN, CONTRACTOR TO FIELD VERIFY.

KEYED NOTES:

C1	16" DI WATER TRANSMISSION MAIN AND 6" DI HYDRANT SERVICE LINE W/ CLASS A BACKFILL (DWG. 1-4)
C2	16" DI WATER TRANSMISSION MAIN w/ CLASS F BACKFILL (DWG. 1-7)
C3	12" DI WATER TRANSMISSION MAIN W/ CLASS F BACKFILL (DWG. 1-7)
C4	6" DI HYDRANT SERVICE LINE W/ CLASS F BACKFILL (DWG. 1-7)
C5	TIE IN TO HIGH PRESSURE LINE
C6	TRANSMISSION TIE IN
C7	TRANSMISSION MAIN COMBINATION AIR/VAC VALVE
C8	ABANDON SEWER FORCEMAIN IN PLACE, PLUG CUT ENDS WITH 2 FT OF GROUT
C9	THRUST BLOCK PER ITEM 3, G-003.
C10	NATURAL SURFACE RESTORATION PER DETAIL 3, SHEET C-501.
C11	SIDEWALK, CURB AND GUTTER SURFACE RESTORATION PER CITY OF LEWISTON PUBLIC WORKS DEPARTMENT DWG. NO. 2-8.
C12	ASPHALT SURFACE RESTORATION PER CITY OF LEWISTON PUBLIC WORKS DEPARTMENT DWG. NO. 3-4 FOR ASPHALT PAVEMENT ONLY.
C13	SEE SHEET C-101 FOR SURFACE REPAIR
C14	CONCRETE GUTTER PER CITY OF LEWISTON PUBLIC WORKS DEPARTMENT DWG. NO. 2-8.



J-U-B ENGINEERS, INC.

201 South Jackson Street
Moscow, ID 83843

Phone: 208.746.9010
www.jub.com

REUSE OF DRAWINGS
JUB SHALL RETAIN ALL COMMON LAW, STATUTORY, COPYRIGHT AND OTHER RIGHTS IN THIS DRAWING. NO PART OF THIS DRAWING SHALL BE REPRODUCED OR TRANSMITTED IN ANY FORM OR BY ANY MEANS, ELECTRONIC OR MECHANICAL, INCLUDING PHOTOCOPYING, RECORDING, OR BY ANY INFORMATION STORAGE AND RETRIEVAL SYSTEM, WITHOUT WRITTEN CONSENT BY JUB. ANY REUSE WITHOUT WRITTEN CONSENT BY JUB WILL BE AT CLIENT'S SOLE RISK AND WITHOUT LIABILITY OR LEGAL EXPOSURE TO JUB.

NO.	REVISION	DESCRIPTION	BY	DATE



WELL NO. 7 WELL COMPLETION

TRANSMISSION MAIN TO RESERVOIR TANK
PLAN AND PROFILE



FILE: 21-20-007_C-103
JUB PROJ. #: 21-20-007
DRAWN BY: ARB
DESIGN BY: BK
CHECKED BY: DLW
AT FULL SIZE, IF NOT ONE
INCH, SCALE ACCORDINGLY
LAST UPDATED: 5/25/2021

SHEET NUMBER:

C-105

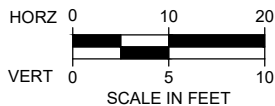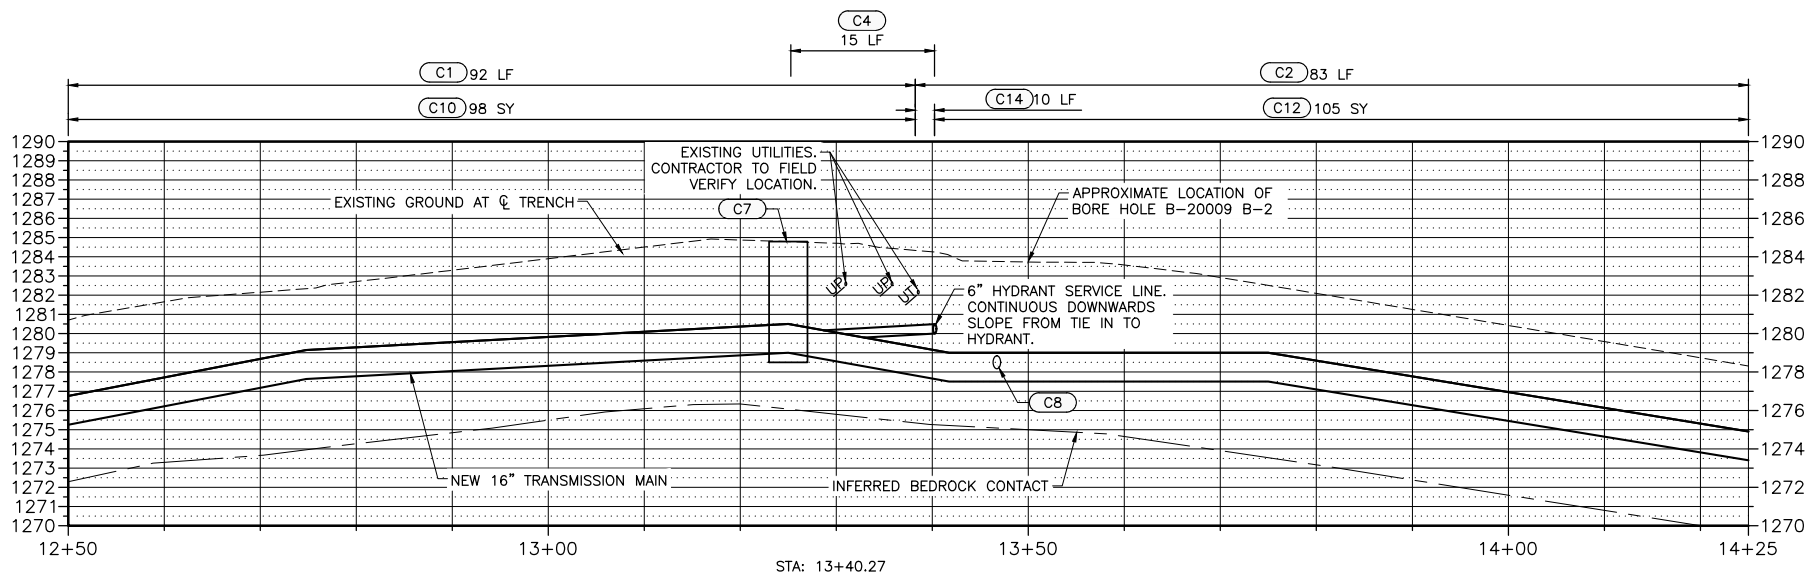

Plot Date: 5/27/2021 9:41 AM Plotted By: Allen Boehm
Date Created: 5/25/2021 JUB.COM\CENTRAL\CLIENTS\LEWISTON\GITY\PROJECTS\21-20-007 WELL\NOT DESIGN\03-WELL\COMPLETION\CA\Sheet\21-20-007 C-103.DWG

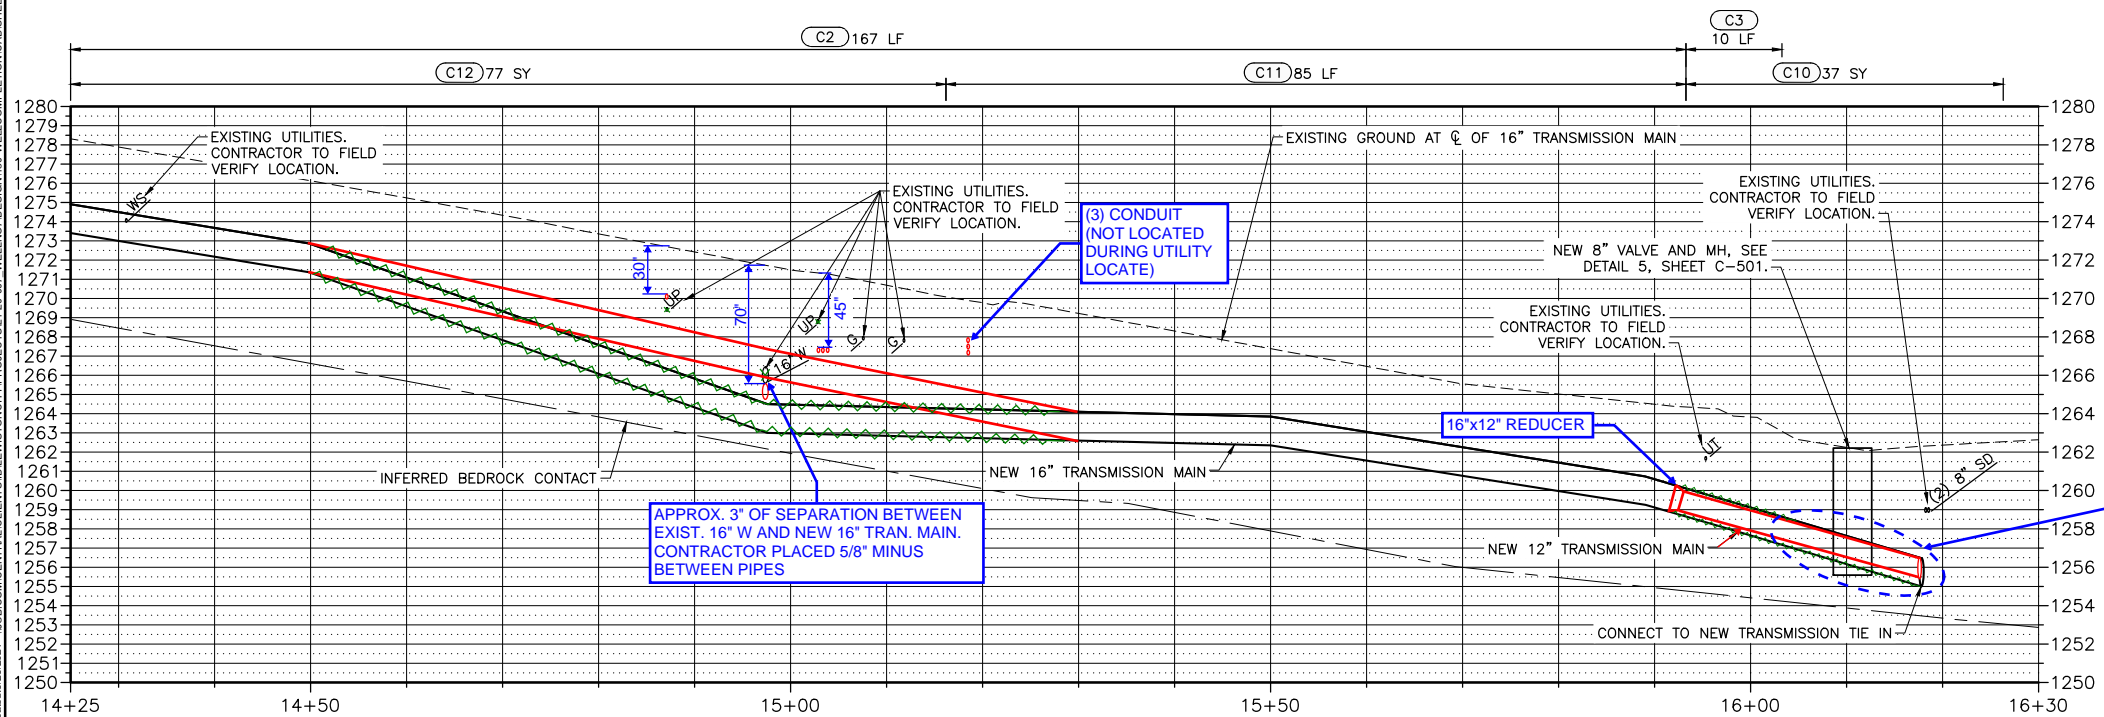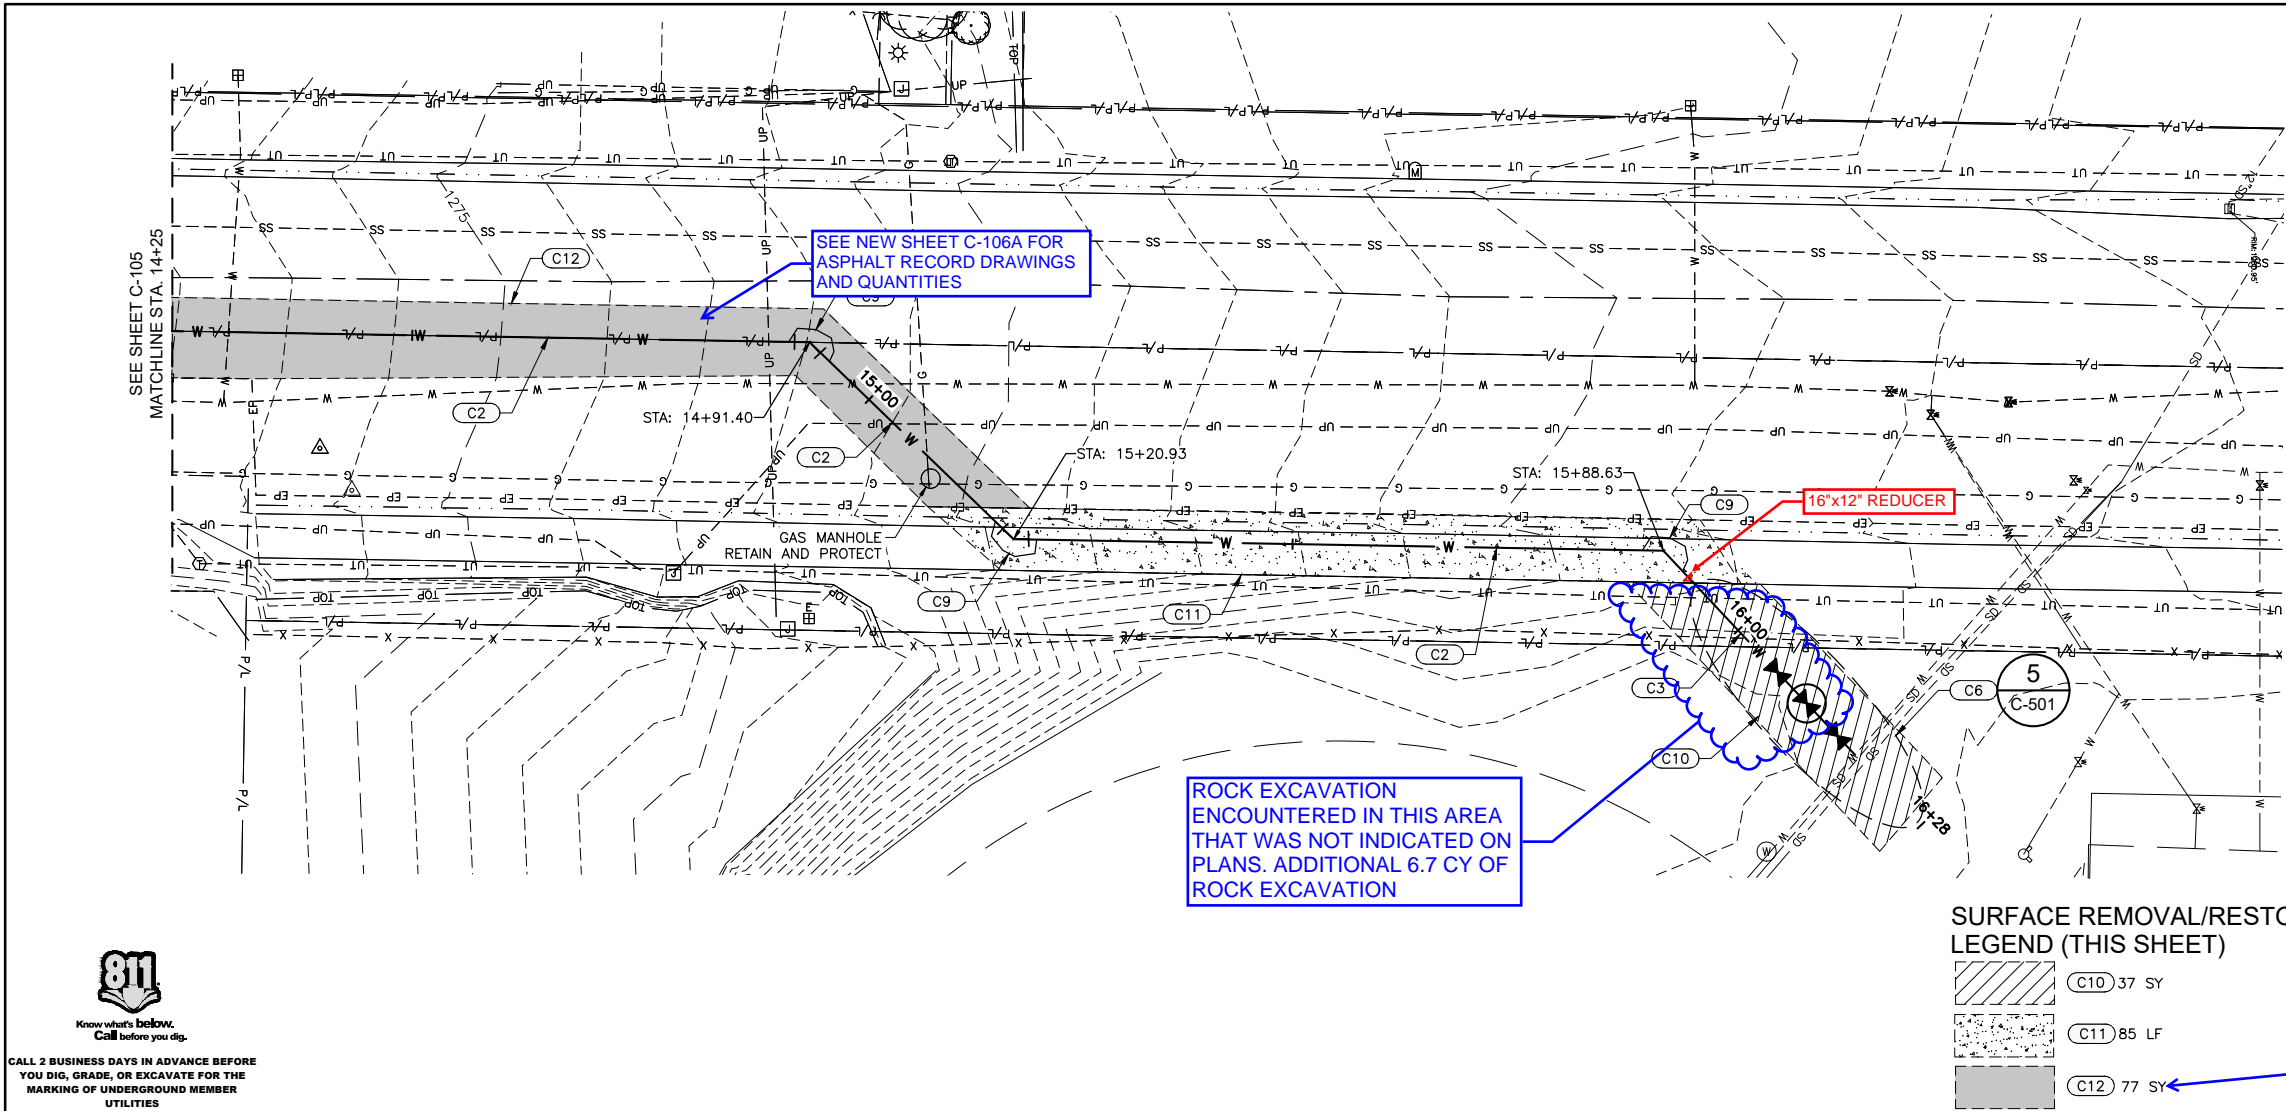

NOTES:

- BURIED GATE VALVES TO BE INSTALLED WITH VALVE BOX PER CITY OF LEWISTON PUBLIC WORKS DEPARTMENT DWG. NO. 4-2.
- VERTICAL FITTINGS AND THRUST BLOCKS AS NEEDED.
- TREE REMOVAL SHALL INCLUDE COUNTER MEASURES FOR PROTECTING UTILITIES AND ADJACENT STRUCTURES.
- SEWER CROSSING TO BE COMPLETED PER CITY OF LEWISTON PUBLIC WORKS DEPARTMENT STANDARD DRAWING DWG. NO. 4-1.
- PIPELINE TRENCHING AND BACKFILL TO BE COMPLETED PER CITY OF LEWISTON PUBLIC WORKS DEPARTMENT STANDARD DRAWINGS DWG. NO. 1-4, 1-7 AND 1-8. PROVIDE 1 FT OF SEPARATION BETWEEN PIPES IN A COMMON TRENCH.
- DEPTH TO OTHER UTILITIES UNKNOWN, CONTRACTOR TO FIELD VERIFY.


KEYED NOTES:


C1	16" DI WATER TRANSMISSION MAIN AND 6" DI HYDRANT SERVICE LINE W/ CLASS A BACKFILL (DWG. 1-4)
C2	16" DI WATER TRANSMISSION MAIN w/ CLASS F BACKFILL (DWG. 1-7)
C3	12" DI WATER TRANSMISSION MAIN W/ CLASS F BACKFILL (DWG. 1-7)
C4	6" DI HYDRANT SERVICE LINE W/ CLASS F BACKFILL (DWG. 1-7)
C5	TIE IN TO HIGH PRESSURE LINE
C6	TRANSMISSION TIE IN
C7	TRANSMISSION MAIN COMBINATION AIR/VAC VALVE
C8	ABANDON SEWER FORCEMAIN IN PLACE, PLUG CUT ENDS WITH 2 FT OF GROUT
C9	THRUST BLOCK PER ITEM 3, G-003.
C10	NATURAL SURFACE RESTORATION PER DETAIL 3, SHEET C-501.
C11	SIDEWALK, CURB AND GUTTER SURFACE RESTORATION PER CITY OF LEWISTON PUBLIC WORKS DEPARTMENT DWG. NO. 2-8.
C12	ASPHALT SURFACE RESTORATION PER CITY OF LEWISTON PUBLIC WORKS DEPARTMENT DWG. NO. 3-4 FOR ASPHALT PAVEMENT ONLY.
C13	SEE SHEET C-101 FOR SURFACE REPAIR
C14	CONCRETE GUTTER PER CITY OF LEWISTON PUBLIC WORKS DEPARTMENT DWG. NO. 2-8.

J-U-B ENGINEERS, INC.	
201 South Jackson Street Moscow, ID 83843	
Phone: 208.746.9010 www.jub.com	
J-U-B ENGINEERS, INC.	REVISION
	NO. DESCRIPTION BY DATE
J-U-B SHALL RETAIN ALL COMMON LAW, STATUTORY, COPYRIGHT AND OTHER RIGHTS IN THIS DRAWING. NO PART OF THIS DRAWING SHALL BE REPRODUCED OR TRANSMITTED IN ANY FORM OR BY ANY MEANS, ELECTRONIC OR MECHANICAL, INCLUDING PHOTOCOPYING, RECORDING, OR BY ANY INFORMATION STORAGE AND RETRIEVAL SYSTEM, WITHOUT WRITTEN PERMISSION FROM JUB. ANY REUSE WITHOUT WRITTEN PERMISSION BY JUB WILL BE AT CLIENT'S SOLE RISK AND WITHOUT LIABILITY OR LEGAL EXPOSURE TO JUB.	

WELL NO. 7	
WELL COMPLETION	
TRANSMISSION MAIN TO RESERVOIR TANK PLAN AND PROFILE	
FILE: 21-20-007 C-103	
JUB PROJ. #: 21-20-007	
DRAWN BY: ARB	
DESIGN BY: BK	
CHECKED BY: DLW	
AT FULL SIZE, IF NOT ONE INCH SCALE ACCORDINGLY	
LAST UPDATED: 5/25/2021	
SHEET NUMBER:	
C-106	

Plot Date: 5/27/2021 9:40 AM Plotted By: Allen Beal
Date Created: 5/25/2021 J:\JUB\COM\CENTRAL\CLIENTS\JULIE\WISCONSIN\CITY\PROJECTS\21-20-007 WELL\NOT\DESIGN\138-WELL\COMPLETION\CA\DWG\21-20-007 C-106.DWG

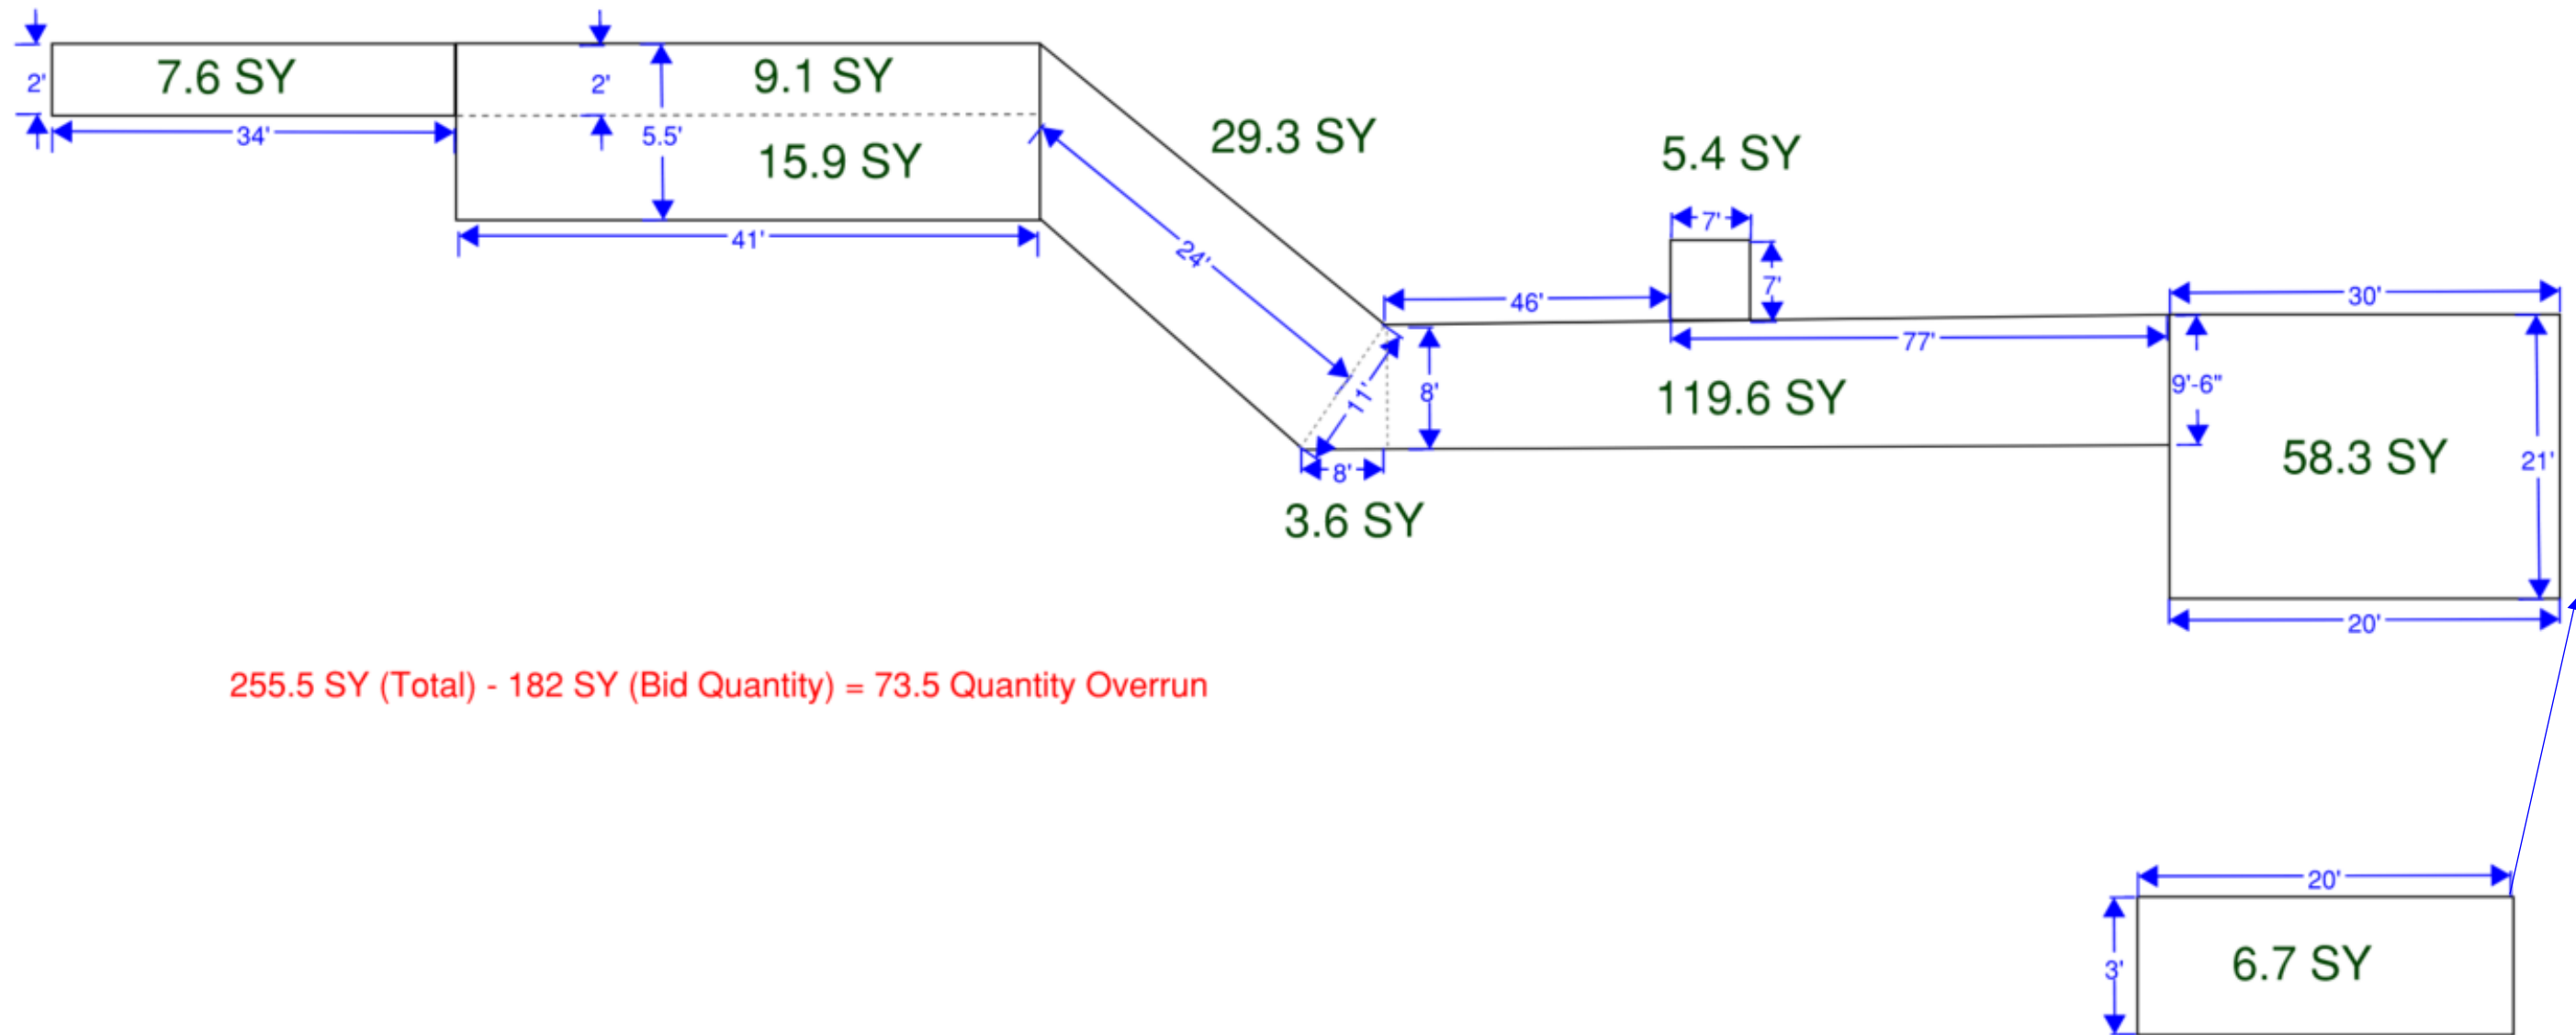



J-U-B ENGINEERS, INC.

J-U-B ENGINEERS, INC.
201 South Jackson Street
Moscow, ID 83843
Phone: 208.746.9010
www.jub.com

REUSE OF DRAWINGS
JUB SHALL RETAIN ALL COMMON LAW, STATUTORY, COPYRIGHT AND OTHER RIGHTS IN THIS DRAWING. NO PART OF THIS DRAWING SHALL BE REPRODUCED OR TRANSMITTED IN ANY FORM OR BY ANY MEANS, ELECTRONIC OR MECHANICAL, INCLUDING PHOTOCOPYING, RECORDING, OR BY ANY INFORMATION STORAGE AND RETRIEVAL SYSTEM, WITHOUT THE WRITTEN CONSENT OF JUB. ANY REUSE WITHOUT WRITTEN CONSENT BY JUB WILL BE AT CLIENT'S SOLE RISK AND WITHOUT LIABILITY OR LEGAL EXPOSURE TO JUB.


REVISION			
NO.	DESCRIPTION	BY	DATE

WELL NO. 7
WELL COMPLETION


ASPHALT QUANTITIES

FILE: 21-20-007_C-103
JUB PROJ. #: 21-20-007
DRAWN BY: ARB
DESIGN BY: BK
CHECKED BY: DLW
AT FULL SIZE, IF NOT ONE INCH SCALE ACCORDINGLY
LAST UPDATED: 5/25/2021


SHEET NUMBER:
C-106A

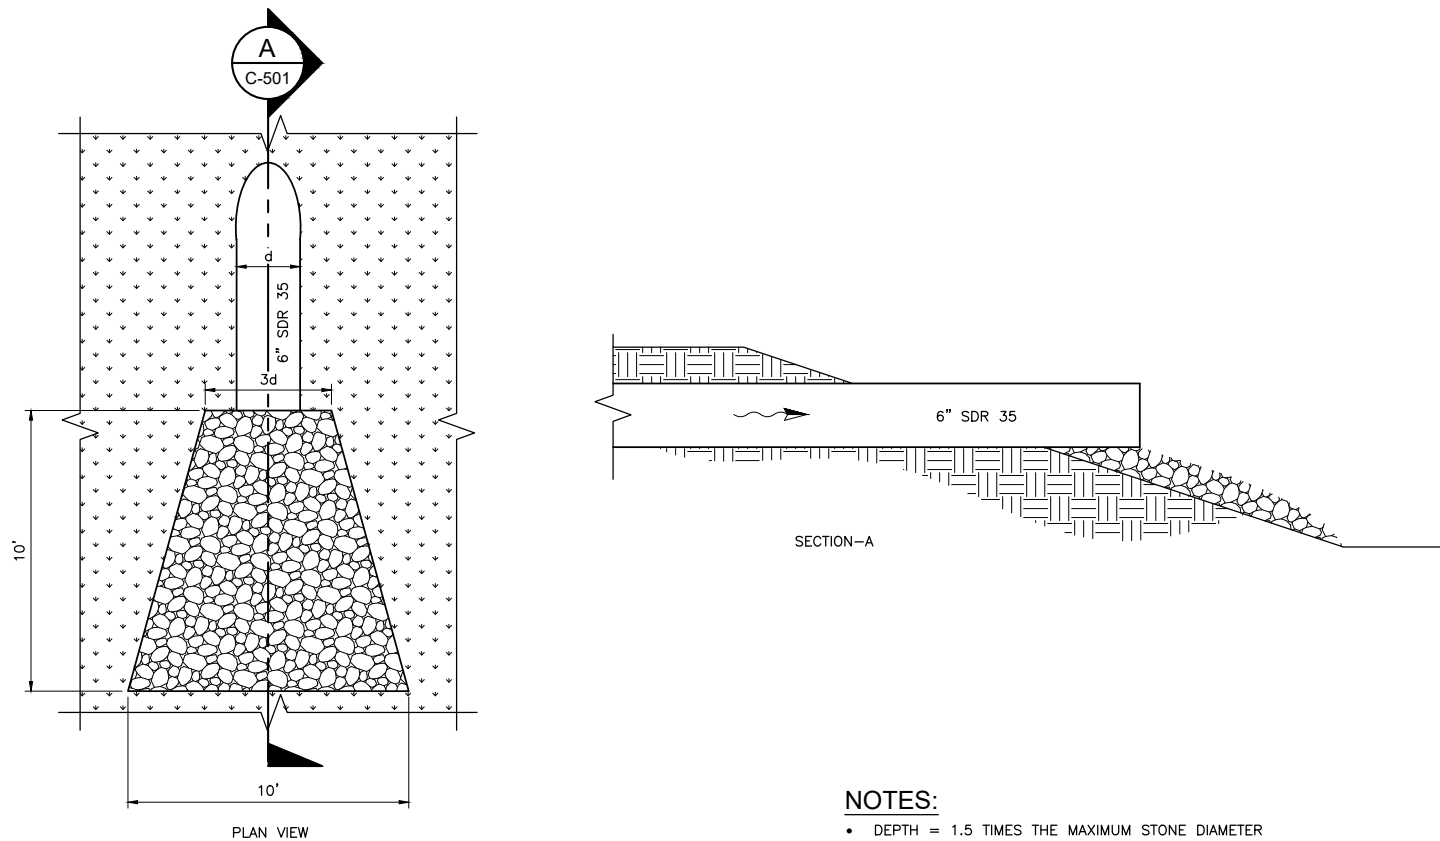


1 CULVERT OUTLET PROTECTION
NOT TO SCALE

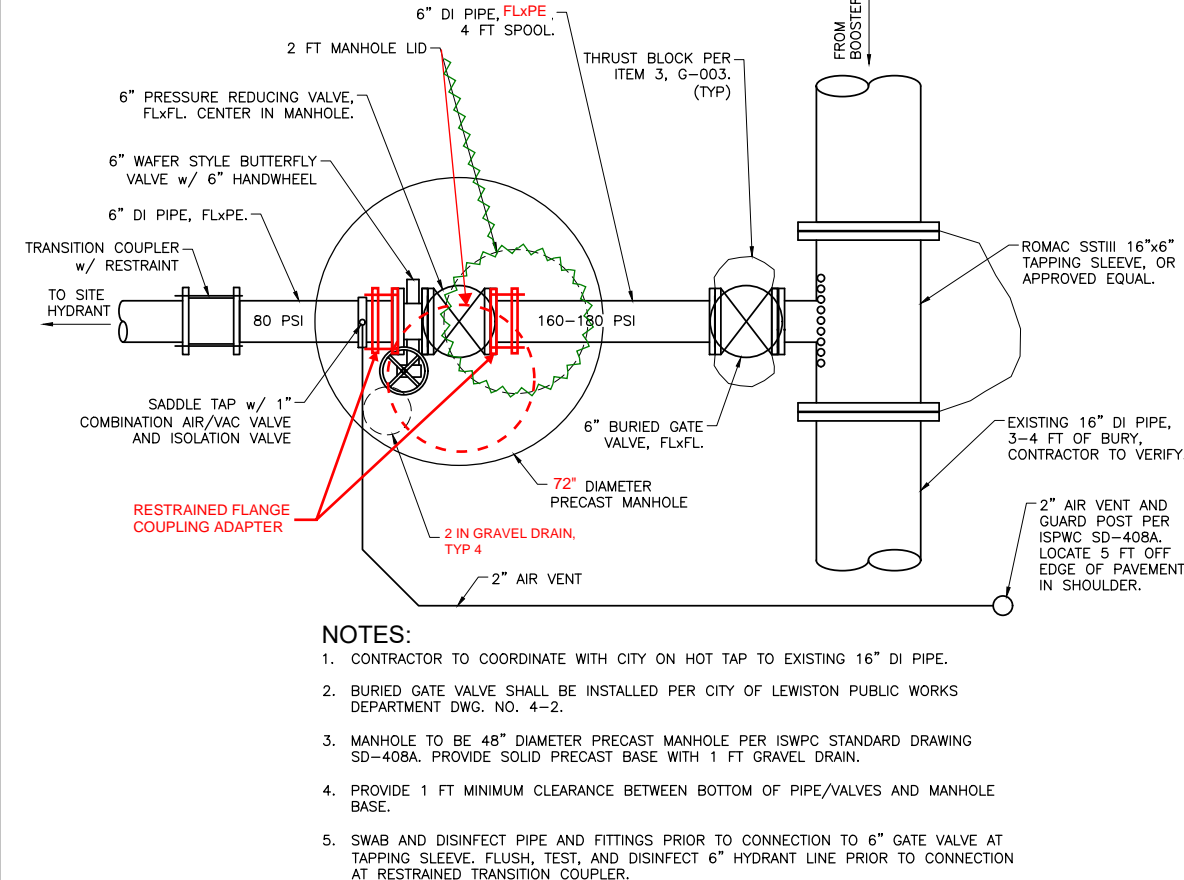

2 TIE IN TO HIGH PRESSURE LINE
NOT TO SCALE

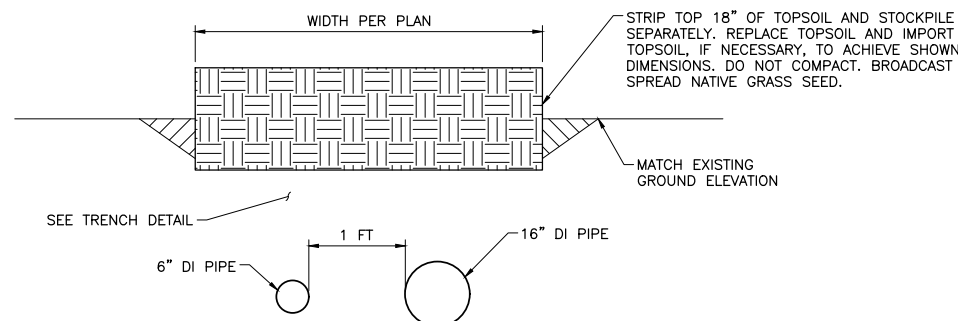

3 NATURAL SURFACE REPAIR
NOT TO SCALE

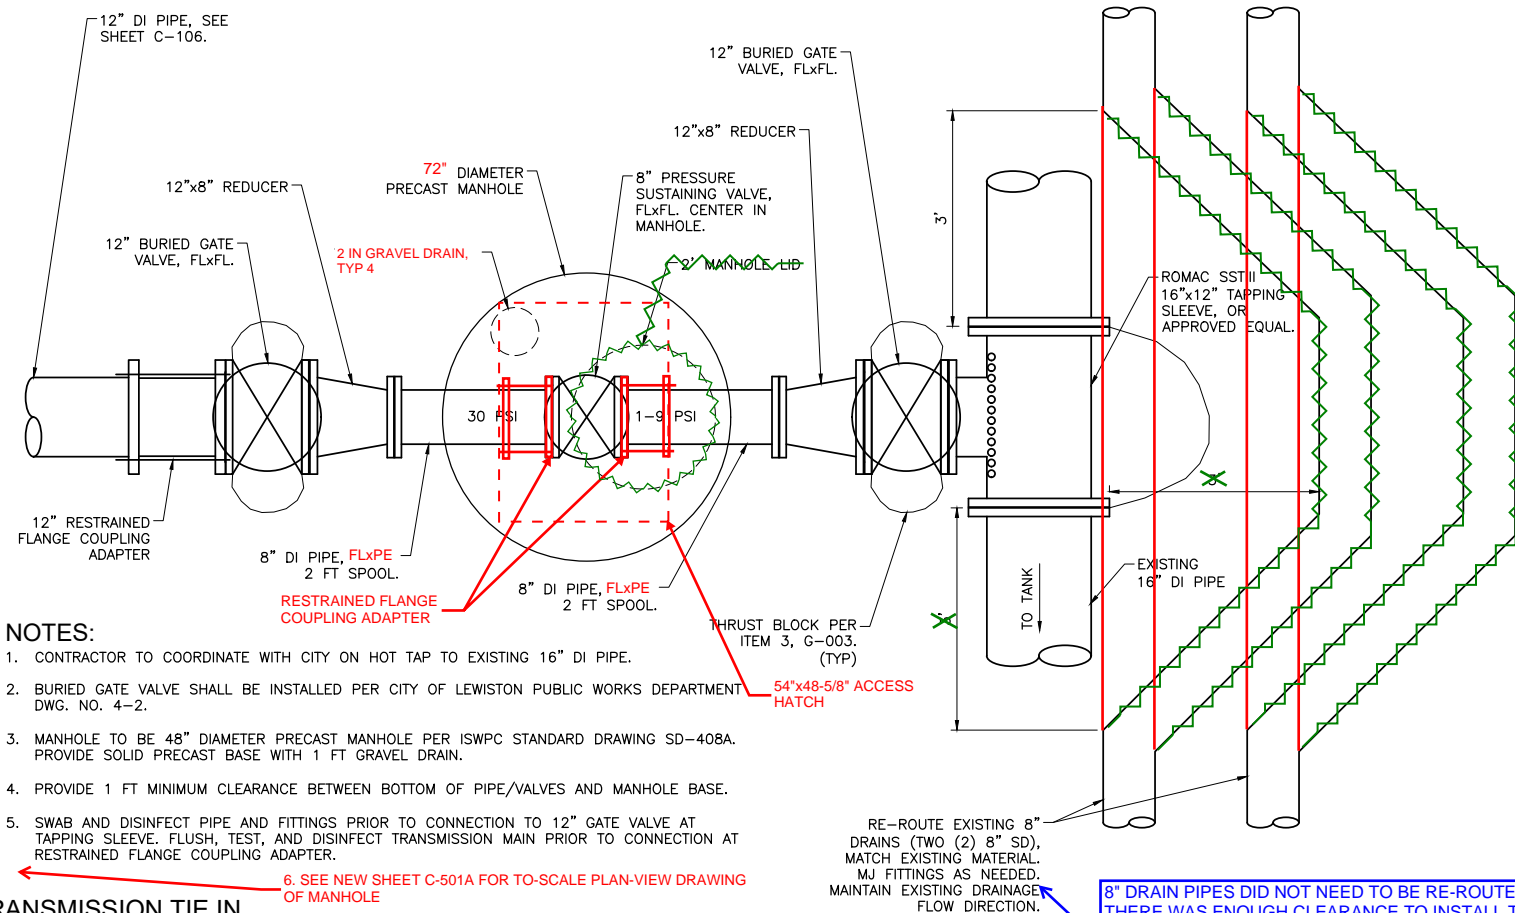

5 TRANSMISSION TIE IN
NOT TO SCALE

4 RESERVED
NOT TO SCALE

2" GRAVEL DRAIN (TYP. 4)

9.00"

1'-8.00"

9.00"

2'-1.38"

RESTRAINED FLANGED COUPLING ADAPTER

8" DUCTILE IRON

54"x48-5/8" ACCESS HATCH



6'

Diagram illustrating the plan view of a 6' diameter manhole assembly, showing internal components and dimensions:

- Overall Diameter:** 6'
- Internal Components:**
 - SADDLE TAP WITH 1" PORT
 - BUTTERFLY VALVE
 - RESTRAINED FLANGED COUPLING ADAPTER
 - 6" DUCTILE IRON
 - 2" GRAVEL DRAIN (TYP. 4)
 - 2" MANHOLE LID
- Dimensions:**
 - 5.00"
 - 6.38"
 - 9.00"
 - 1'-3.75"
 - 1'-8.00"
 - 9.00"

Plot Date: 5/27/2021 9:41 AM Plotted By: Allen Beal
Date Created: 5/25/2021 JUB-COM-CENTRAL-CLIENTS\JUB-ENGINEERING\PROJECTS\21-20-007 WELL NO. 7 DESIGN\38-WELL COMPLETION CAD SHEET\21-20-007 C-501X.DWG


6 AIR GAP BASIN
NOT TO SCALE

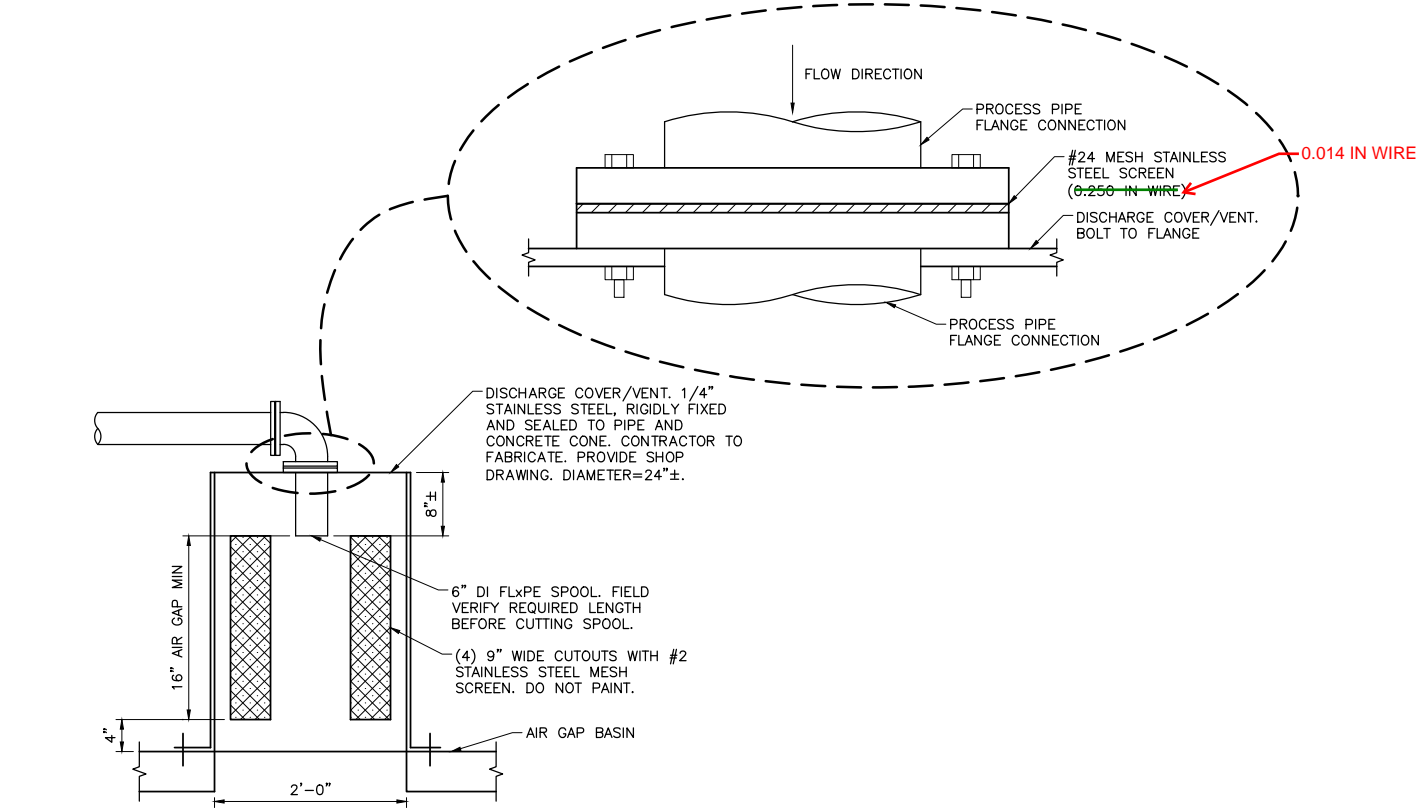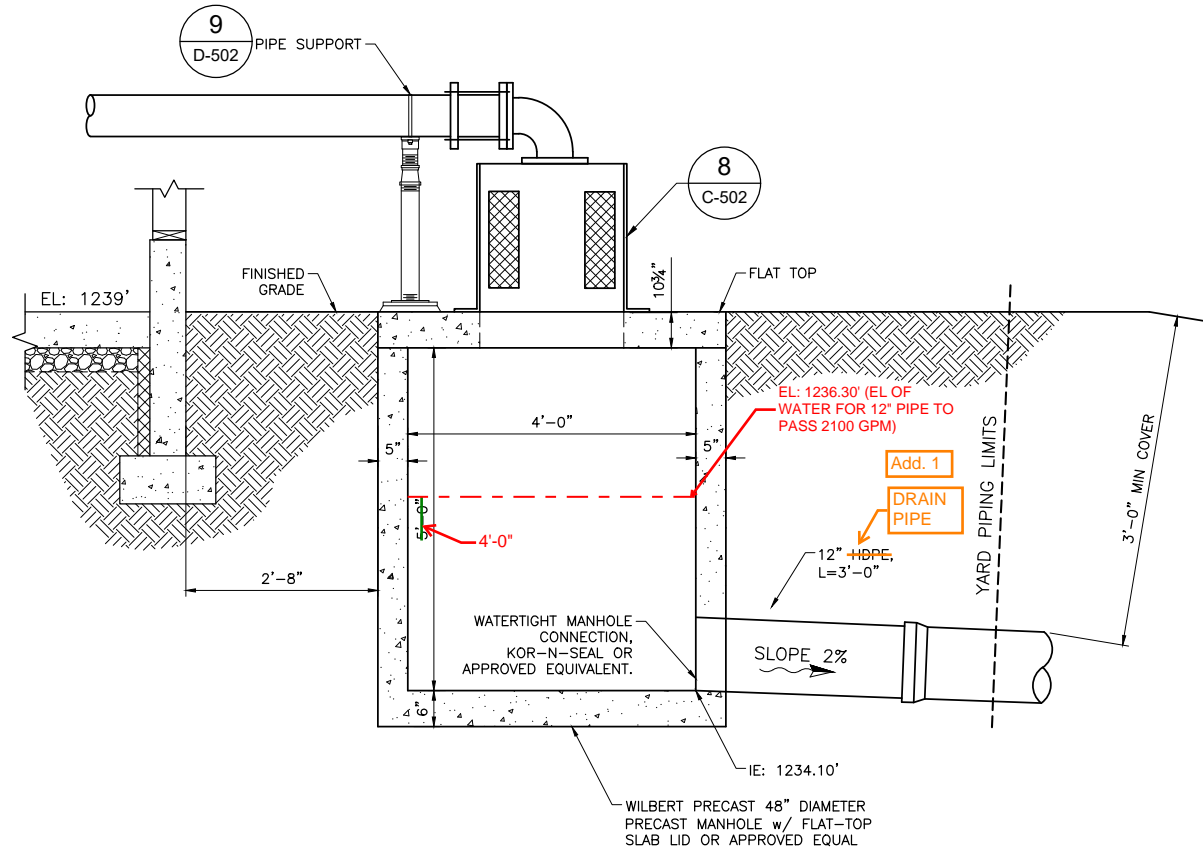

8 DISCHARGE COVER AND VENT
NOT TO SCALE

7 TRANSMISSION MAIN COMBINATION AIR/VAC VALVE
NOT TO SCALE

- NOTES:
1. MANHOLE TO BE 48" DIAMETER PRECAST MANHOLE PER ISWPC STANDARD DRAWING SD-408A. PROVIDE SOLID PRECAST BASE WITH 1 FT GRAVEL DRAIN.
 2. PROVIDE 1 FT. MINIMUM CLEARANCE BETWEEN BOTTOM OF PIPE/VALVES AND MANHOLE BASE.
 3. INSTALL 2" COMBINATION AIR/VAC VALVE AND APPURTENANCES PER ISWPC SD-408A.
 4. AIR/VAC VAULT SHALL BE LOCATED AT HIGH POINT OF TRANSMISSION MAIN.
 5. ROUTE NEW 6" HYDRANT MAIN AROUND MANHOLE.

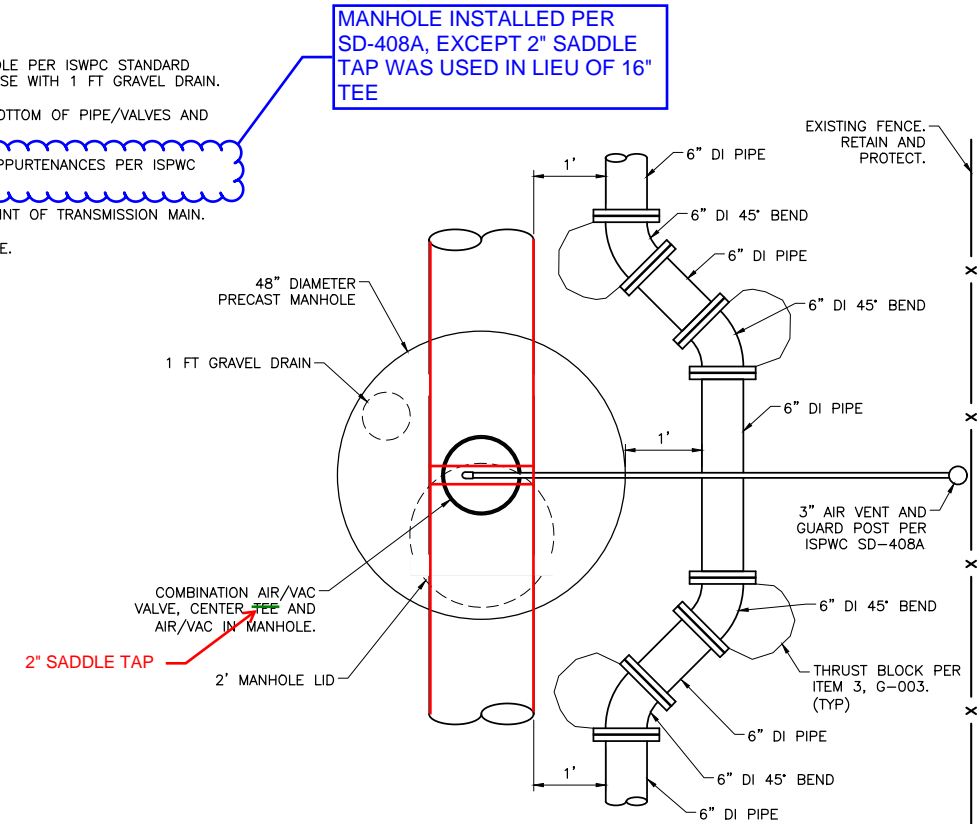



J-U-B ENGINEERS, INC.

J-U-B ENGINEERS, INC.

201 South Jackson Street
Moscow, ID 83843

Phone: 208.746.9010
www.jub.com

REUSE OF DRAWINGS

JUB SHALL RETAIN ALL COMMON LAW, STATUTORY, COPYRIGHT AND OTHER RIGHTS IN ANY DESIGN OR DRAWING. NO PART OF ANY DESIGN OR DRAWING SHALL BE REPRODUCED OR TRANSMITTED IN ANY FORM OR BY ANY MEANS, ELECTRONIC OR MECHANICAL, INCLUDING PHOTOCOPYING, RECORDING, OR BY ANY INFORMATION STORAGE AND RETRIEVAL SYSTEM, WITHOUT THE WRITTEN CONSENT OF JUB. ANY REUSE WITHOUT WRITTEN CONSENT BY JUB WILL BE AT CLIENT'S SOLE RISK AND WITHOUT LIABILITY OR LEGAL EXPOSURE TO JUB.

NO.	REVISION	DESCRIPTION	BY	DATE


WELL NO. 7
WELL COMPLETION

CIVIL (C)
YARD PIPING DETAILS


FILE: 21-20-007_C-501X
JUB PROJ. #: 21-20-007
DRAWN BY: ARB
DESIGN BY: BK
CHECKED BY: DLW
AT FULL SIZE, IF NOT ONE
INCH, SCALE ACCORDINGLY
LAST UPDATED: 5/26/2021
SHEET NUMBER:
C-502

Plot Date: 5/27/2021 12:51 PM Plotted By: Allen Bearin
Date Created: 7/26/2021 JUB.COM\CENTRAL\CLIENTS\JULIUSWISCONSIN\CITY\PROJECTS\21-20-007 WELL\NOT DESIGN\38-WELL\COMPLETION\CAD\SHEET\21-20-007 C-503X.DWG


10 TYPICAL SITE FOUNDATION PREPARATION AND INTERBED REMEDIATION DETAIL
NOT TO SCALE

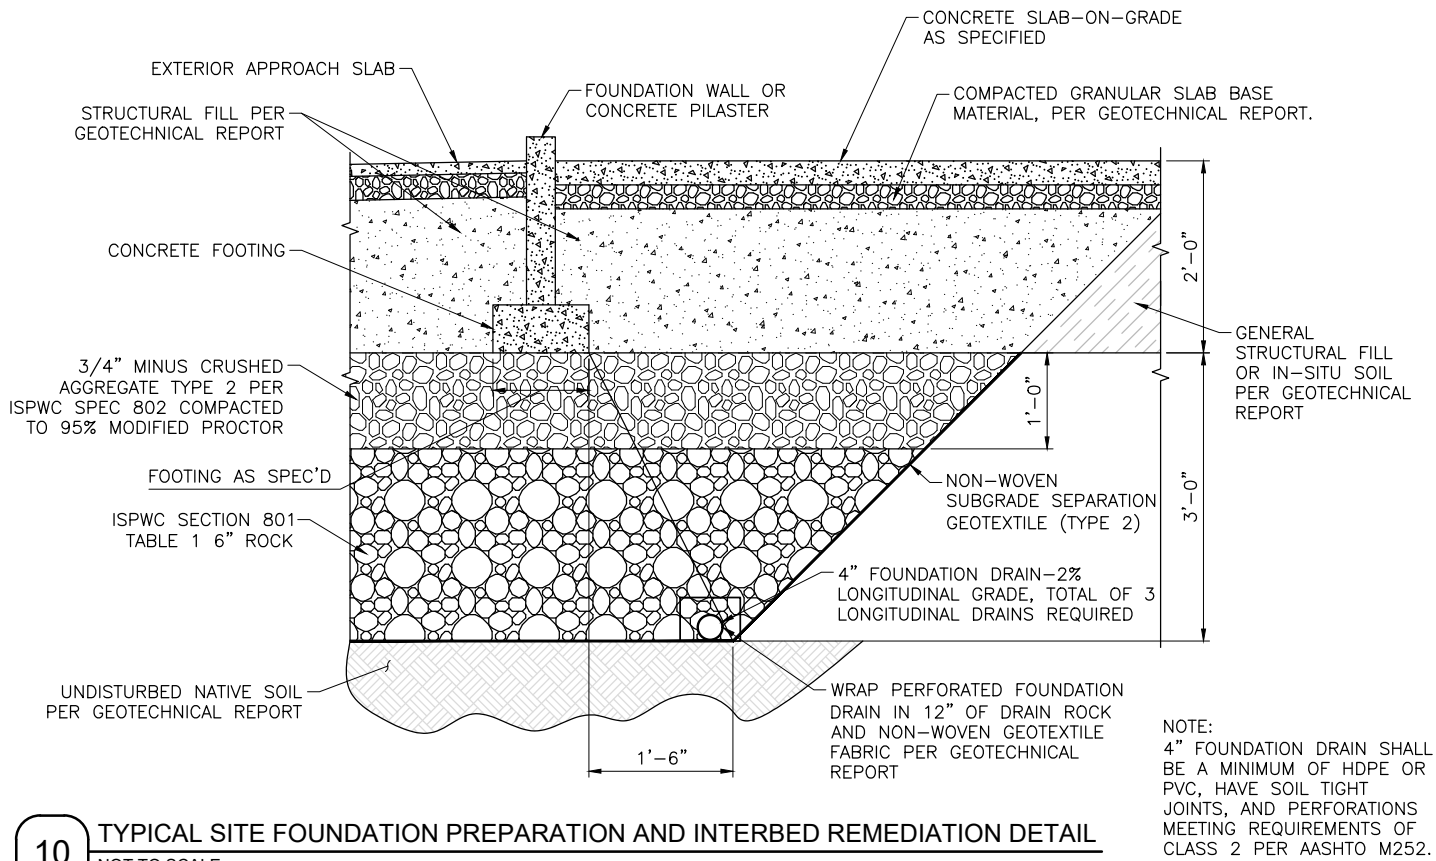

16 BOLLARD DETAILS
NOT TO SCALE

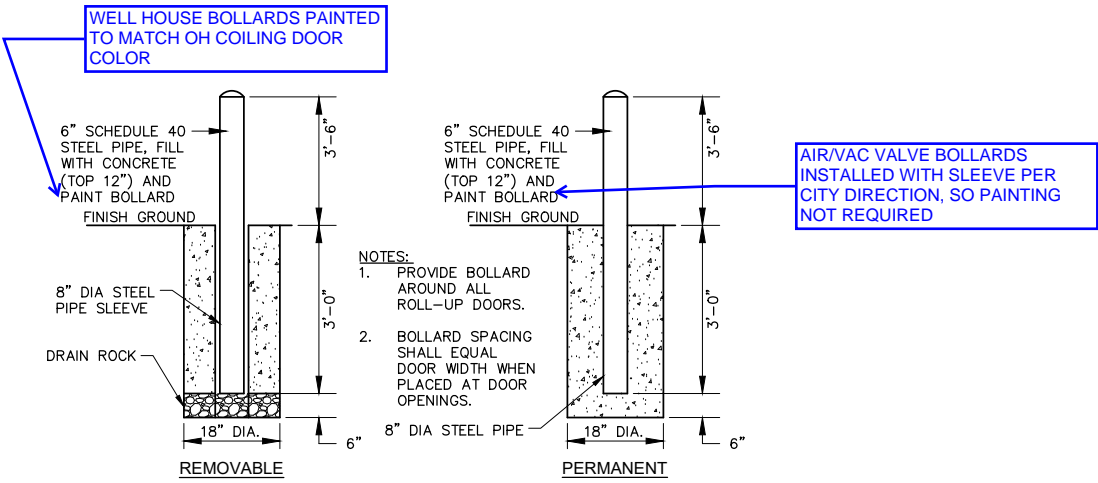

11 SITE PAD - TYPICAL SECTION
NOT TO SCALE

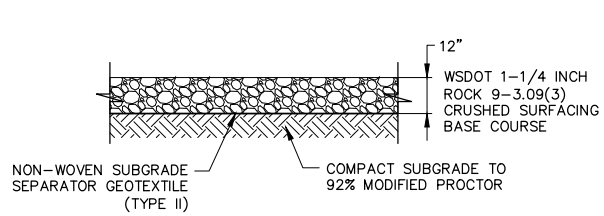


- NOTES:
1. COMPACTION OF WSDOT 1-1/4 INCH ROCK 9-3.09(3) CRUSHED SURFACING BASE COURSE SHALL BE METHOD SPECIFIC, PER ISPWC SECTION 202.3.8.C.3.
 2. SUBGRADES FOUND IN BEDROCK NEED NOT BE COMPACTED.
 3. IF BEDROCK EXCAVATION EXTENDS 2.0 FEET OR LESS BELOW DESIGN SUBGRADE AS DETERMINED BY ENGINEER, COMPACT WITH AT LEAST 5 COMPLETE PASSES OF 10-TON COMPRESSION ROLLER OR VIBRATORY ROLLER. IF EXCAVATION EXTENDS >2.0 FEET BELOW DESIGN SUBGRADE AS DETERMINED BY ENGINEER, REMOVE OVER-EXCAVATED MATERIAL AND REPLACE WITH STRUCTURAL FILL MATERIAL.

REVISION		NO.	DESCRIPTION	BY	DATE


Plot Date: 5/27/2021 12:51 PM Plotted By: Allen Bearlin Date Created: 7/28/2021 J:\BID\CENTRAL CLIENTS\IDLEWIST\CONGTY\PROJECTS\21-20-007 WELL\NOT DESIGN\38-WELL\COMPLETE\CONGAD\SHEET\21-20-007 C-503X.DWG

MINIMUM MEMBER SIZE AND WEIGHT FOR CHAIN LINK FENCE																			
MATERIAL	BRACE & TOP RAILS				LINE POSTS				END, CORNER, INTER. END				GATE POSTS						
GALVANIZED OR ALUMINUM COATED	TUBULAR		ROLL FORMED		TUBULAR		H-SECTION		ROLL FORMED		TUBULAR		ROLL FORMED		FOR GATE LEAF WIDTH	TUBULAR		ROLL FORMED	
	O.D.	#/FT.	SIZE	#/FT.	O.D.	#/FT.	SIZE	#/FT.	SIZE	#/FT.	O.D.	#/FT.	SIZE	#/FT.		O.D.	#/FT.	SIZE	#/FT.
	1½"	2.27	1½" x 1¼"	1.35	2"	2.72	1⅞" x 1½"	2.70	1⅞" x 1½"	2.28	2½"	5.79	3½" x 3½"	5.14	0' - 6' 6' - 13' 6"	2 ⅞" 4" 6"	5.79 9.10 18.97	3½" x 3½"	5.14
ALUMINUM ALLOY	1½"	0.786	-----	-----	2"	1.264	1⅞" x 1½"	0.913	-----	-----	2½"	2.004	3" x 3"	2.00	0' - 6' 6' - 13' 13' - 18'	2 ⅞" 4" 6"	2.00 3.15 6.56	3" x 3"	2.00

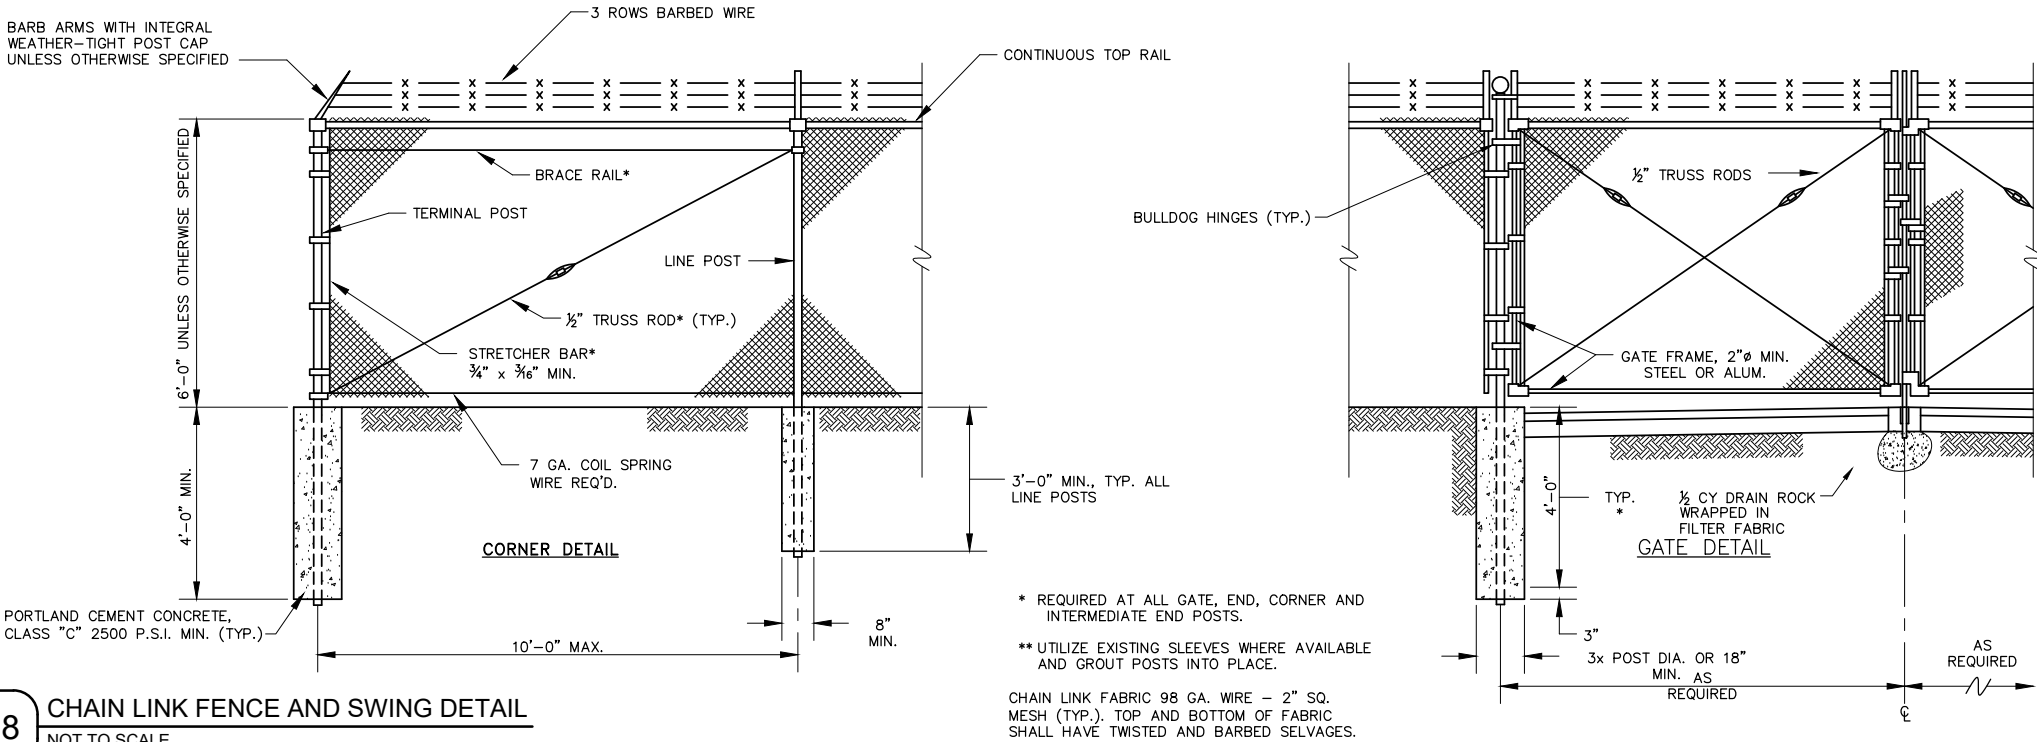

18 CHAIN LINK FENCE AND SWING DETAIL

NOT TO SCALE

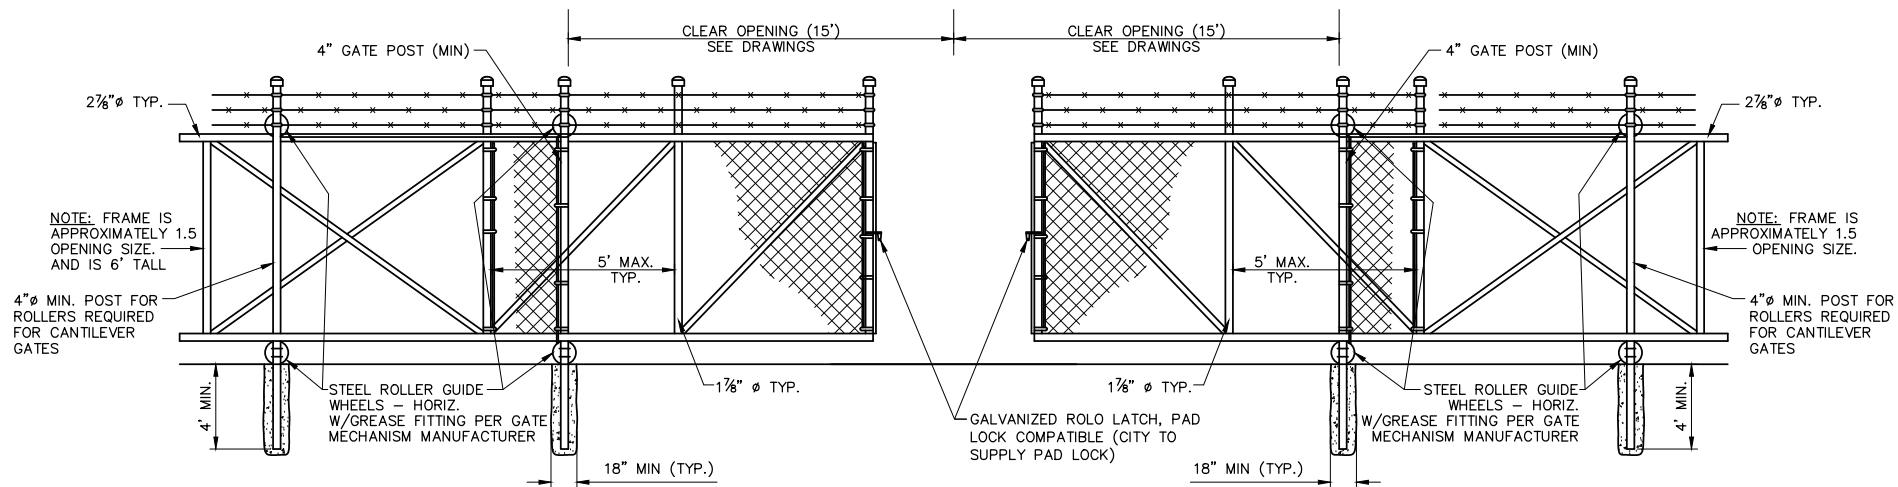

NOTES:

- FENCE DESIGNER/MANUFACTURER TO PROVIDE ENGINEERING CALCULATIONS SEALED BY IDAHO PROFESSIONAL ENGINEER FOR CANTILEVER GATES.
- GATES TO BE NON-MOTORIZED.
- FENCE DESIGNER/MANUFACTURE TO PROVIDE FINAL GATE DIMENSIONS AND LAYOUT. DIAMETERS AND CONCRETE FOOTINGS, INCLUDING EMBEDMENT DEPTH, GIVEN IN DETAIL 19 SHALL BE TAKEN AS MINIMUMS REQUIRED.
- ALL MATERIALS AND HARDWARE SHALL BE GALVANIZED AND ABLE TO RESIST CORROSION DURING USE WITHOUT ADDITIONAL COATINGS.
- CONTRACTOR TO SUPPLY ALL HARDWARE, SUPPLIES, AND MATERIALS AS REQUIRED FOR A FULLY FUNCTIONAL GATE INSTALLATION AND TO MAKE THE CONNECTION BETWEEN THE GATES AND THE SITE FENCE.
- PROVIDE A DIMENSIONED SHOP DRAWING SHOWING THE GATE DESIGN.

19 ROLLING CHAIN LINK GATE

NOT TO SCALE



J-U-B ENGINEERS, INC.

J-U-B ENGINEERS, INC.
201 South Jackson Street
Moscow, ID 83843

Phone: 208.746.9010
www.jub.com

REUSE OF DRAWINGS
JUB SHALL RETAIN ALL COMMON LAW, STATUTORY, COPYRIGHT AND OTHER RESERVED RIGHTS OF THESE DRAWINGS AND THE SAME SHALL BE THE PROPERTY OF JUB. ANY REUSE WITHOUT WRITTEN CONSENT BY JUB WILL BE AT CLIENTS SOLE RISK AND WITHOUT LIABILITY OR LEGAL EXPOSURE TO JUB.

REVISION			
NO.	DESCRIPTION	BY	DATE

WELL NO. 7
WELL COMPLETION
CIVIL (C)
STANDARD DETAILS

FILE : 21-20-007 C-503X
JUB PROJ. # : 21-20-007
DRAWN BY: ARB
DESIGN BY: BK
CHECKED BY: DLW
AT FULL SIZE, IF NOT ONE INCH, SCALE ACCORDINGLY
LAST UPDATED: 5/27/2021
SHEET NUMBER:

C-504

Plot Date: 5/27/2021 9:42 AM Plotted By: Allen Boehm
Date Created: 4/6/2021 JUB-001-CENTRAL CLIENT SIDE LAYOUT (CONC) PROJECT 19-29-007 WELL NO.7 DESIGN 103- WELLS COMPLETION CAD SHEET 19-29-007 S-01 DWG

GENERAL STRUCTURAL NOTES & SPECIFICATIONS

1. GENERAL.
- A. THESE GENERAL STRUCTURAL NOTES AND SPECIFICATIONS SUPPLEMENT THE PROJECT WRITTEN TECHNICAL SPECIFICATIONS AND THE PROJECT STRUCTURAL DRAWINGS.
- B. THE CONTRACTOR IS RESPONSIBLE FOR ALL CONSTRUCTION BRACING, TEMPORARY SHORING, AND OTHER SITE SAFETY CONTROLS REQUIRED DURING CONSTRUCTION IN ACCORDANCE WITH ALL APPLICABLE LOCAL, STATE AND FEDERAL REGULATIONS, TO INSURE THE STABILITY AND SAFETY OF ALL CONSTRUCTION UNTIL IT IS COMPLETED AND SELF-SUPPORTING.
- C. THE CONTRACTOR IS RESPONSIBLE FOR ALL WATER, BOTH ABOVE AND BELOW GROUND, RUNOFF AND OTHER ENVIRONMENTAL CONTROLS REQUIRED DURING CONSTRUCTION TO INSURE THE SITE IS MAINTAINED IN COMPLIANCE WITH ALL APPLICABLE LOCAL, STATE AND FEDERAL REGULATIONS.
- D. DETAILS ON THESE PLANS ARE INTENDED TO DEPICT THE GENERAL CONSTRUCTION DETAILS AND METHODS FOR THIS STRUCTURE. CONNECTION DETAILS AND CONDITIONS NOT SPECIFICALLY SHOWN THAT ARE SIMILAR IN NATURE TO THOSE THAT ARE SPECIFIED SHALL BE ASSUMED ONE AND THE SAME. IF QUESTIONS REGARDING THE APPLICATION OF DETAILS ARE ENCOUNTERED, NOTIFY THE ENGINEER FOR CLARIFICATION OR INSTRUCTION.
- E. PRIOR TO IMPLEMENTING ANY CHANGES TO THESE PLANS, THE ENGINEER SHALL BE NOTIFIED IN WRITING FOR THEIR WRITTEN APPROVAL. CHANGES IMPLEMENTED WITHOUT THE ARCHITECT/ENGINEERS WRITTEN APPROVAL SHALL RELIEVE THE ARCHITECT/ENGINEER OF ANY CLAIM OR LIABILITY RESULTING FROM THAT PORTION OF THE STRUCTURE CHANGED OR AFFECTED BY THE CHANGE.
2. CONTRACTOR RESPONSIBILITY FOR COORDINATION.
- A. IT IS THE CONTRACTORS PRIME RESPONSIBILITY TO COORDINATE THE WORK SHOWN ON ALL OF THE PROJECT DRAWINGS, GENERAL, SPECIAL AND TECHNICAL SPECIFICATIONS.
- B. THE CONTRACTOR IS RESPONSIBLE TO VERIFY ALL EXISTING CONSTRUCTION MATERIAL TYPES, DIMENSIONS, ELEVATIONS AND CONDITIONS.
- C. THE CONTRACTOR SHALL VERIFY AND COORDINATE THE DIMENSIONS AMONG ALL DRAWINGS AND IN THE FIELD PRIOR TO PROCEEDING WITH ANY WORK OR FABRICATION, ANY DISCREPANCY SHALL BE IMMEDIATELY REPORTED TO THE ARCHITECT/ENGINEER.
- D. IT IS THE CONTRACTOR'S RESPONSIBILITY TO CAREFULLY STUDY AND COORDINATE THE CONSTRUCTION REQUIREMENTS SHOWN ON BOTH THE ARCHITECTURAL AND THE STRUCTURAL DRAWINGS. WHEN CONFLICTS OR DISCREPANCIES ARE FOUND BETWEEN THESE PLAN SETS AND/OR WITHIN THESE DRAWINGS, THE CONTRACTOR SHALL REPORT THEM IMMEDIATELY TO THE PROJECT ARCHITECT/ENGINEER FOR DIRECTION AND/OR CLARIFICATION.
- E. ANY CONSTRUCTION WORK DONE BY THE CONTRACTOR BEFORE OBTAINING SUCH CLARIFICATION FROM THE PROJECT ARCHITECT/ENGINEER SHALL BE AT THE CONTRACTORS OWN RISK AND COST. FURTHERMORE, ANY WORK REQUIRED TO CORRECT, REPLACE AND/OR RESTORE THE WORK AS DIRECTED BY THE ARCHITECT/ENGINEER SHALL BE AT THE CONTRACTORS OWN RISK AND COST.
3. CODES.
- A. INTERNATIONAL BUILDING CODE, IBC 2018 EDITION.
- B. MINIMUM DESIGN LOADS FOR BUILDINGS AND OTHER STRUCTURES, ASCE 7-16.
- C. AMERICAN CONCRETE INSTITUTE, ACI 318, BUILDING CODE REQUIREMENTS FOR STRUCTURAL CONCRETE; REFERENCED EDITION.
- D. AMERICAN CONCRETE INSTITUTE, ACI 301, SPECIFICATIONS FOR STRUCTURAL CONCRETE.
- E. NATIONAL DESIGN SPECIFICATIONS, NDS 2018 FOR WOOD CONSTRUCTION.
4. SPECIAL INSPECTIONS. SPECIAL INSPECTIONS PER IBC CHAPTER 17 ARE REQUIRED FOR THE FOLLOWING ITEMS: C INDICATES CONTINUOUS, P INDICATES PERIODIC.
- | A. SOILS. BY GEOTECHNICAL ENGINEER. | FREQUENCY |
|-------------------------------------|-----------|
| i SITE PREPARATION: | P |
| ii FILL MATERIAL VERIFICATION: | P |
| iii FILL PLACEMENT AND COMPACTION: | C |
| iv LIFT THICKNESS: | C |
- B. CONCRETE.
- | | |
|------------------------------------------|---|
| i REINFORCEMENT PLACEMENT: | P |
| ii PLACEMENT OF CAST-IN-PLACE ANCHORS: | P |
| iii VERIFICATION OF USE OF REQUIRED MIX: | P |
| iv CONCRETE PLACEMENT: | C |
- C. ALL SPECIAL INSPECTION SHALL BE PERFORMED BY ICC CERTIFIED INSPECTORS.
5. SUBMITTALS.
- A. SUBMIT REQUIRED COPIES, FOUR (4) MINIMUM, OF PRODUCT OR MATERIAL DESIGN INFORMATION TO THE ARCHITECT/ENGINEER FOR REVIEW FOR THE FOLLOWING ITEMS:
- i CONCRETE MIX DESIGNS AND ADMIXTURES.
 - ii NON-SHRINK GROUT.
6. DEFERRED SUBMITTALS. THE FOLLOWING ITEMS TO BE DESIGNED BY OTHERS ARE CONSIDERED "DEFERRED SUBMITTALS". DEFERRED SUBMITTALS SHALL BE ACCOMPANIED BY DESIGN DRAWINGS, SHOP DRAWINGS AND STRUCTURAL CALCULATIONS, STAMPED AND SIGNED BY A PROFESSIONAL STRUCTURAL ENGINEER CURRENTLY REGISTERED IN THE STATE OF IDAHO.
- A. PRE-ENGINEERED AND SHOP FABRICATED WOOD TRUSSES.
- B. PRE-ENGINEERED AND SHOP FABRICATED PRE-CAST CONCRETE COMPONENTS
7. SHOP DRAWINGS:
- A. SUBMIT REQUIRED COPIES OF SHOP DRAWINGS, FOUR (4) MINIMUM, TO THE ENGINEER FOR REVIEW PRIOR TO FABRICATION OF THE FOLLOWING ITEMS:
- i REINFORCING STEEL FOR ALL CONCRETE.
8. DESIGN CRITERIA.
- A. OCCUPANCY OR USE; IBC TABLE 1607.1: WELL HOUSE
- B. RISK CATEGORY; ASCE TABLE 1.5-2: IV
- C. LIVE LOADS:
- i MINIMUM ROOF LIVE LOAD: 25 PSF (SNOW)
 - ii GROUND SNOW LOAD, PG: 22 PSF
 - iii UNBALANCED SNOW PER ASCE-7, CHAPTER 7
- D. DEAD LOADS:
- i ROOF DEAD LOAD: 18 PSF
 - (a) TRUSS TOP CHORD: 8 PSF
 - (b) TRUSS BOTTOM CHORD: 10 PSF
 - (c) TRUSS NET UPLIFT: 15 PSF AT INTERIOR (ASD), 62 PSF AT OVERHANG (ASD)
- E. WIND:
- i BASIC WIND SPEED: 114 MPH
 - ii SITE EXPOSURE: C
 - iii IMPORTANCE FACTOR: 1.00
- F. SEISMIC:
- i EARTHQUAKE SPECTRAL RESPONSE ACCELERATION:
 - (a) SHORT PERIOD, SS: 29.7%
 - (b) 1-SECOND, S1: 10.7% - ii IMPORTANCE FACTOR, IE: 1.5
 - iii SOIL CLASS: C
 - iv SEISMIC RISK CATEGORY: IV
- F. MECHANICAL LOADS: REFER TO FRAMING PLANS AND MECHANICAL PLANS FOR SPECIAL MECHANICAL EQUIPMENT LOADS.
9. FOUNDATIONS.
- A. ALL FOOTINGS TO BE PLACED ON 12" MIN THICK OF COMPACTED GRANULAR STRUCTURAL FILL (CA-1) ATOP PREPARED BASALT BEDROCK. EXPOSED BEDROCK SUBGRADES MUST COMPRISE A NEAT AND LEVEL ROCK SURFACE, FREE OF LOOSE SOIL AND DEBRIS. WHERE VARIATIONS IN THE ROCK SURFACE REQUIRE PLACEMENT OF FILL TO CREATE A LEVEL SURFACE, PLACE COMPACTED GRANULAR STRUCTURAL FILL (CA-1).
- B. ALL PIERS AND FOOTINGS OUTSIDE OR AT THE PERIMETER OF THE STRUCTURE, OR IN OTHER UNHEATED AREAS SHALL BE SET TO A DEPTH OF AT LEAST 24-IN. BELOW FINISH GRADE, UNLESS OTHER WISE NOTED ON THE PLANS.
- C. ALLOWABLE BEARING PRESSURE FOR ALL FOOTINGS QA = 3,000 PSF
- D. LOCAL AREAS OF SOFT AND/OR UNACCEPTABLE MATERIAL, SUCH AS INTERBED SOIL, ENCOUNTERED AT BOTTOM OF FOOTING ELEVATIONS INDICATED ON THE PLANS MUST BE OVER-EXCAVATED AT LEAST 3-FEET AND BROUGHT UP TO DESIGN GRADE WITH COMPACTED STRUCTURAL FILL OR LEAN CONCRETE FILL.

- E. ALL STRUCTURAL FILL AND/OR BACKFILL SHALL BE GRANULAR, FREE DRAINING, MATERIAL AND MUST MEET REQUIREMENTS IN ISPWC SECTION 802 - CRUSHED AGGREGATES. MATERIAL SHALL BE PLACED IN LIFTS NO GREATER THAN 6-IN. IN DEPTH AND COMPACTED TO 95% OF MAXIMUM DENSITY AS DETERMINED PER ASTM D1557.
- F. THE ENGINEER SHALL BE NOTIFIED IN WRITING IF ANY GROUND WATER, INTERBED SOIL, CLAY TYPE SOILS, DEBRIS OR UNCONSOLIDATED MATERIALS ARE ENCOUNTERED DURING EXCAVATIONS FOR FOUNDATIONS.
- G. REFER TO THE FINAL PROJECT GEOTECHNICAL REPORT BY GPI, FILE NO. MO20009A, DATED JUNE 12, 2020.
10. STRUCTURAL MATERIALS.
- A. ANCHOR RODS: ANCHOR RODS (BOLTS SET INTO CONCRETE) SHALL BE ASTM F1554, FY=36 KSI. NUTS FOR ANCHOR RODS SHALL CONFORM TO ASTM A563, GRADE A, HEAVY HEX.
- B. THREADED STEEL RODS: THREADED STEEL RODS SHALL CONFORM TO ASTM A36, FY=36 KSI. NUTS FOR THREADED RODS SHALL CONFORM TO ASTM A563, GRADE A, HEAVY HEX.
- C. WASHERS: ALL WASHERS SHALL CONFORM TO ASTM F436.
- D. BOLT PLACEMENT: ALL BOLTS SHALL BE ON MEMBER STANDARD GAGE LINES EXCEPT AS NOTED OTHERWISE.
- E. PROJECT CONCRETE MIX TYPES: CONCRETE SHALL BE PROPORTIONED AND FURNISHED FOR THE VARIOUS PROJECT USES AS INDICATED ON THE PLANS AND AS FOLLOWS:
- i M2500-SEC: SECONDARY CONCRETE MIX FOR FILL AND BACKFILL AROUND BURIED PIPES UNDERNEATH STRUCTURAL FOOTINGS AND FOUNDATION SLABS: FC = 2,500 PSI, ABSOLUTE WATER-CEMENT RATIO BY WEIGHT = 0.55, AIR CONTENT = 6% (+/- 1.5%), MAXIMUM AGGREGATE SIZE 3/8-INCH; SLUMP 8-INCH
 - ii M4000-INT: CONCRETE MIX FOR CLASS 1, 2 OR 3 INTERIOR SLABS ON GRADE: FC = 4,000 PSI, ABSOLUTE WATER-CEMENT RATIO BY WEIGHT = 0.45, AIR CONTENT = 0 TO 2% (NON-AIR ENTRAINED MIX)
 - iii M4000-FND: STANDARD EXTERIOR CONCRETE MIX FOR NON-LIQUID RETAINING BUILDING FOOTINGS/FOUNDATION WALLS: FC = 4,000 PSI, ABSOLUTE WATER-CEMENT RATIO BY WEIGHT = 0.45, AIR CONTENT = 6% (+/- 1.5%)
- F. CONCRETE MIX COMPONENTS.
- i A WATER-REDUCING ADMIXTURE CONFORMING TO ASTM C494, USED IN STRICT CONFORMANCE WITH THE MANUFACTURERS INSTRUCTIONS, SHALL BE INCORPORATED IN ALL CONCRETE MIX DESIGNS.
 - ii FOR ALL WATER-RETAINING CONCRETE STRUCTURAL WALLS AND SLABS, A HIGH-RANGE WATER-REDUCING (HRWR) ADMIXTURE CONFORMING TO ASTM C494, TYPE F OR G, SHALL BE USED. THE TOTAL SLUMP SHALL BE LESS THAN 10-IN.
 - iii HIGHER WATER-CEMENT RATIOS THAN SHOWN ABOVE MAY BE USED IF SUBSTANTIATED IN ACCORDANCE WITH ACI 318-89, CHAPTER 5.
 - iv FLY-ASH CONFORMING TO ASTM C618 TYPE F OR C, MAY REPLACE UP TO 20% OF THE CEMENT CONTENT, PROVIDED THAT THE MIX STRENGTH IS SUBSTANTIATED BY TEST DATA.
 - v CEMENT: ASTM C150 TYPE I OR II.
 - vi WATER: CLEAN & POTABLE.
 - vii AIR ENTRAINING AGENT: ASTM C260. EXCEPT WHERE NOTED NON-AIR ENTRAINED.
 - viii AGGREGATE: 0.75-INCH MAXIMUM AGGREGATE PER ASTM C33. UNLESS NOTED OTHERWISE.
 - ix MIX PROPORTIONING: ACI 211.1 AND 350R.
- G. CONCRETE ACCESSORIES:
- i REINFORCING STEEL: REINFORCING STEEL SHALL CONFORM TO ASTM A615 GRADE 60; #3 BARS MAY BE GRADE 40.
 - ii WIRE: PLAIN WIRE SHALL CONFORM TO ASTM A 82. DEFORMED WIRE SHALL CONFORM TO ASTM A 496.
- H. LUMBER: GRADING SHALL BE TO THE STANDARD GRADING RULES OF THE WWPA. TYPICAL STRUCTURAL LUMBER SHALL BE NUMBER 2 DOUGLAS-FIR/LARCH OR BETTER. MEMBERS NOTED AS WOOD BEAMS, POSTS OR COLUMNS SHALL BE NUMBER 1 DOUGLAS-FIR/LARCH OR BETTER. STUDS FOR INTERIOR NON-BEARING WALLS MAY BE STUD GRADE LUMBER. LUMBER TO BE LEFT EXPOSED, WITHOUT OTHER FINISH AND LUMBER IN CONTACT WITH CONCRETE SHALL BE PRESSURE TREATED.
- I. TREATED LUMBER: LUMBER, INCLUDING WOOD SHEATHING, TO BE LEFT EXPOSED WITHOUT OTHER FINISH, LOCATED WITHIN 8" OF FINISH GRADE, OR IN CONTACT WITH CONCRETE OR MASONRY SHALL BE PRESSURE TREATED MATERIAL. CONTRACTOR SHALL COORDINATE AND VERIFY THAT ALL STEEL ITEMS IN CONTACT WITH THE TREATED MATERIAL, INCLUDING STEEL HANGARS, CONNECTORS AND FASTENERS HAVE A GALVANIZED FINISH OF SUFFICIENT THICKNESS, OR OTHER TYPE OF PROTECTION, THAT IS COMPATIBLE WITH THE SPECIFIC TREATMENT TYPE SELECTED.
- J. NAILING: WHERE NOT OTHERWISE SPECIFIED ON THE PLANS, NAILING SHALL CONFORM TO IBC TABLE 2304.9.1, FASTENING SCHEDULE. ALL NAILS SHALL BE COMMON WIRE NAILS OR PNEUMATICALLY DRIVEN NAILS WITH AN EQUIVALENT CROSS-SECTION AND PENETRATION, UNLESS NOTED OTHERWISE.
- K. BOLTS & LAG SCREWS FOR WOOD CONSTRUCTION: CONFORM TO ANSI/ASME STANDARDS B18.2.1-1981 AND THE NATIONAL DESIGN SPECIFICATION FOR WOOD CONSTRUCTION (NDS) 2018 EDITION PART VIII FOR BOLTS AND PART IX FOR SCREWS.
- L. WOOD SCREWS: CONFORM TO ANSI/ASME STANDARDS B18.6.1-1981 AND THE NATIONAL DESIGN SPECIFICATION FOR WOOD CONSTRUCTION (NDS) 2018 EDITION PART XI.
- M. NAILS & SPIKES: CONFORM TO FEDERAL SPECIFICATION FF-N-105B AND THE NATIONAL DESIGN SPECIFICATION (NDS) 2018 EDITION PART XII.
- N. LUMBER HARDWARE: WOOD CONSTRUCTION CONNECTORS SHALL BE AS MANUFACTURED BY SIMPSON STRONG-TIE COMPANY; CURRENT CATALOG, OR AN APPROVED EQUAL. HARDWARE EXPOSED TO WEATHER OR VIEW, IN UNHEATED PORTIONS OF THE STRUCTURE, OR AS INDICATED ON THE DRAWINGS OR IN THE SPECIFICATIONS SHALL BE HOT-DIPPED GALVANIZED WITH GALVANIZED FASTENERS.
- O. ROOF SHEATHING: ALL ROOF SHEATHING SHALL BE 5/8" NOMINAL, EXTERIOR APA RATED SHEATHING (32/16) INSTALLED WITH PLY-CLIPS.
- P. EXTERIOR WALL SHEATHING: ALL EXTERIOR WALL SHEATHING SHALL BE 1/2" NOMINAL APA RATED EXTERIOR SHEATHING (24/16). NOTE, 7/16" OSB WITH APA SPAN RATING OF (24/16) IS ACCEPTABLE.
11. CONCRETE QUALITY AND DETAILS.
- A. GENERAL. CONCRETE SHALL BE PROPORTIONED TO PROVIDE AN AVERAGE COMPRESSIVE STRENGTH, FC, AS PRESCRIBED IN ACI 318/350 SECTION 5.3.2 AND SHALL SATISFY THE DURABILITY CRITERIA OF ACI 318/350 CHAPTER 4.
- B. CONCRETE PROPORTIONS.
- i CONCRETE MIX PROPORTIONING SHALL BE IN ACCORDANCE WITH ACI 211.1; STANDARD PRACTICE FOR SELECTING PROPORTIONS FOR NORMAL, HEAVYWEIGHT, AND MASS CONCRETE.
 - ii CONCRETE MIX PROPORTIONING FOR LIGHTWEIGHT CONCRETE SHALL BE IN ACCORDANCE WITH ACI 211.2; STANDARD PRACTICE FOR SELECTING PROPORTIONS FOR LIGHTWEIGHT CONCRETE.
- C. CONCRETE MIX VERIFICATION: CONCRETE MIX DESIGNS SHALL BE VERIFIED BY STANDARD 28-DAY CYLINDER TESTS PER ASTM C39.
- D. EVALUATION AND ACCEPTANCE OF CONCRETE. CONCRETE SHALL BE TESTED IN ACCORDANCE WITH THE REQUIREMENTS OF ACI 318/350 SECTION 5.6.
- E. MIXING & PLACING CONCRETE. CONCRETE SHALL BE PREPARED, MIXED, PLACED AND CONSOLIDATED IN ACCORDANCE WITH ACI 318/350 SECTIONS 5.7 THROUGH 5.10 AND AS FOLLOWS:
- i ACI 304; GUIDE FOR MEASURING, MIXING, TRANSPORTING, AND PLACING CONCRETE.
 - ii ACI 309; GUIDE FOR CONSOLIDATION OF CONCRETE.
- F. CONCRETE CURING. CONCRETE SHALL BE MAINTAINED ABOVE 50-DEGREES F AND IN A MOIST CONDITION FOR AT LEAST 7 DAYS AFTER PLACEMENT, EXCEPT WHEN CURED IN ACCORDANCE WITH ACI 318 SECTION 5.11.3.
- i CURING OF CONCRETE SHALL BE PER THE RECOMMENDATIONS GIVEN IN ACI 308; GUIDE TO CURING CONCRETE.
- G. COLD WEATHER REQUIREMENTS. ADEQUATE EQUIPMENT SHALL BE PROVIDED FOR HEATING CONCRETE MATERIALS AND PROTECTING CONCRETE DURING FREEZING OR NEAR-FREEZING WEATHER. THE RECOMMENDED PROCEDURES LISTED IN ACI 306; COLD WEATHER CONCRETING SHALL BE FOLLOWED.
- i COLD WEATHER IS DEFINED AS A PERIOD WHEN, FOR MORE THAN 3 CONSECUTIVE DAYS, THE FOLLOWING CONDITIONS EXIST:
 - (a) THE AVERAGE DAILY AIR TEMPERATURE IS LESS THAN 40-DEGREES F AND
 - (b) THE AIR TEMPERATURE IS NOT GREATER THAN 50-DEGREES F FOR MORE THAN ONE-HALF OF ANY 24-HOUR PERIOD.
- H. HOT WEATHER REQUIREMENTS. DURING HOT WEATHER, PROPER ATTENTION SHALL BE GIVEN TO INGREDIENTS, PRODUCTION METHODS, HANDLING, PLACING, PROTECTION, AND CURING TO PREVENT EXCESSIVE CONCRETE TEMPERATURES OR WATER EVAPORATION THAT COULD IMPAIR REQUIRED STRENGTH OR SERVICEABILITY OF THE MEMBER OR STRUCTURE. THE RECOMMENDED PROCEDURES LISTED IN ACI 305; HOT WEATHER CONCRETING SHALL BE FOLLOWED.
- i HOT WEATHER IS ANY COMBINATION OF THE FOLLOWING CONDITIONS THAT TENDS TO IMPAIR THE QUALITY OF FRESHLY MIXED OR HARDENED CONCRETE BY ACCELERATING THE RATE OF MOISTURE LOSS AND RATE OF CEMENT HYDRATION, OR OTHERWISE CAUSING DETRIMENTAL RESULTS:
 - (a) HIGH AMBIENT TEMPERATURE.
 - (b) HIGH CONCRETE TEMPERATURE.
 - (c) LOW RELATIVE HUMIDITY.
 - (d) WIND SPEED.
 - (e) SOLAR RADIATION.
12. FORMWORK.
- A. FORMS SHALL RESULT IN A FINAL STRUCTURE THAT CONFORMS TO SHAPES, LINES, AND DIMENSIONS OF THE MEMBERS AS REQUIRED BY THE DESIGN DRAWINGS AND SPECIFICATIONS.
- i DESIGN OF FORMWORK SHALL BE IN ACCORDANCE WITH ACI 318/350 SECTION 6.1.
 - ii FORMWORK SHALL BE IN ACCORDANCE WITH ACI 347; GUIDE TO FORMWORK FOR CONCRETE.
- B. EMBEDMENTS IN CONCRETE.
- i CONDUITS, PIPES, AND SLEEVES OF ANY MATERIAL NOT HARMFUL TO CONCRETE AND WITHIN LIMITATIONS OF ACI 318/350 SECTION 6.3 SHALL BE PERMITTED TO BE EMBEDDED IN CONCRETE WITH APPROVAL OF THE PROJECT ENGINEER, PROVIDED THEY ARE NOT CONSIDERED TO REPLACE STRUCTURALLY THE DISPLACED CONCRETE, EXCEPT AS PROVIDED IN SECTION 6.3.6.
 - ii CONDUITS AND PIPES OF ALUMINUM SHALL NOT BE EMBEDDED IN STRUCTURAL CONCRETE UNLESS EFFECTIVELY COATED OR COVERED TO PREVENT ALUMINUM-CONCRETE REACTION OR ELECTROLYTIC ACTION BETWEEN ALUMINUM AND STEEL.
- C. CONSTRUCTION JOINTS.
- i CONSTRUCTION JOINTS SHALL ONLY BE PLACED WHERE INDICATED ON THE PROJECT DRAWINGS OR AS APPROVED BY THE PROJECT ENGINEER.
 - ii CONSTRUCTION JOINTS SHALL BE CONSTRUCTED IN ACCORDANCE WITH ACI 318/350 SECTION 6.4

13. DETAILS OF REINFORCEMENT.

- A. PLACEMENT OF ALL REINFORCING STEEL WITHIN CONCRETE STRUCTURES SHALL BE IN CONFORMANCE WITH ACI 318/350 CHAPTER 7.
- B. REINFORCING STEEL HOOKS, BENDS, TIES, SPLICES AND OTHER REINFORCEMENT DETAILS SHALL BE IN ACCORDANCE WITH ACI 315; DETAILS AND DETAILING OF CONCRETE REINFORCEMENT.
- C. SPACING LIMITS FOR REINFORCEMENT SHALL BE IN CONFORMANCE WITH ACI 318/350 SECTION 7.6.
- D. CONCRETE PROTECTION FOR REINFORCEMENT. UNLESS NOTED ELSEWHERE ON THE DRAWINGS, ALL REINFORCING STEEL SHALL HAVE THE FOLLOWING CONCRETE COVER:
- (a) CONCRETE CAST AGAINST EARTH: 3.00 INCH
 - (b) CONCRETE EXPOSED TO EARTH OR WEATHER:
 - NO. 5 OR SMALLER BARS: 1.50-INCH
 - NO. 6 OR LARGER BARS: 2.00-INCH - (a) CONCRETE NOT EXPOSED TO EARTH OR WEATHER;
 - NO. 11 OR SMALLER BARS: 0.75-INCH
- E. CONCRETE BLOCKS OR PLASTIC-COATED BAR CHAIRS SHALL BE PROVIDED FOR SUPPORT OF ALL SLAB REINFORCING STEEL, SUFFICIENT IN NUMBER TO PREVENT SETTLEMENT OR SAGGING, BUT IN NO CASE SHALL SUCH SUPPORT BE CONTINUOUS. METAL CLIPS OR SUPPORTS SHALL NOT BE PLACED IN CONTACT WITH THE FORMS OR THE SUB-GRADE.
- F. DOWELS AND ANCHOR BOLTS SHALL BE WIRED OR OTHERWISE HELD IN CORRECT POSITION PRIOR TO PLACING CONCRETE. CARE SHALL BE TAKEN TO INSURE THAT DOWELS AND ANCHOR BOLTS REMAIN PLUM AFTER CONCRETE IS POURED AND VIBRATED. IN NO CASE SHALL DOWELS OR ANCHOR BOLTS BE STABBED INTO FRESHLY POURED CONCRETE!
- G. PROVIDE DOWELS IN FOOTINGS AND AT CONSTRUCTION JOINTS TO MATCH VERTICAL REINFORCING BAR SIZE AND SPACING, UNLESS OTHERWISE NOTED ON THE DRAWINGS.
- H. COORDINATE PLACEMENT OF DOWELS INTO MASONRY WALLS WITH THE MASONRY SHOP DRAWINGS.
- I. WHERE DRILLED IN ANCHORS ARE TO BE POST-INSTALLED INTO CONCRETE SURFACES TAKE CARE TO LOCATE REINFORCING STEEL SO THAT IT WILL NOT INTERFERE WITH THE DRILLING OPERATIONS. MOVE BARS PLUS OR MINUS 1 TO 2 INCHES IN ORDER TO AVOID DRILLING CONFLICTS.
- J. ALL BAR BENDS, HOOKS, SPLICES AND OTHER REINFORCING STEEL DETAILS SHALL CONFORM TO THE REQUIREMENTS OF ACI 315.
- K. UNLESS OTHERWISE NOTED ON THE PLANS ALL BARS SHALL BE SPLICED WITH A MINIMUM CLASS B LAP SPLICE; LAP SPLICES OF DEFORMED BARS AND DEFORMED WIRE IN COMPRESSION ZONES MAY BE CLASS A SPLICES.
- L. AT ALL CORNERS AND WALL INTERSECTIONS PROVIDE BENT BARS TO MATCH THE HORIZONTAL REINFORCING STEEL AND IN ACCORDANCE WITH THE TYPICAL CORNER REINFORCING DETAILS.
- M. CHAMFER ALL EXPOSED CORNERS AND FILLET ENTRANT ANGLES 3/4" UNLESS OTHERWISE NOTED ON THE DRAWINGS.

14. CONCRETE FLOORS AND SLABS.

- A. CONCRETE FLOORS AND SLABS SHALL BE CONSTRUCTED IN ACCORDANCE WITH ACI 302; CONCRETE FLOOR AND SLAB CONSTRUCTION. PROVIDE THE FOLLOWING CLASS CONCRETE FLOOR SLABS IN ACCORDANCE WITH TABLE 2.1 UNLESS OTHERWISE NOTED ON THE DRAWINGS:
- i INTERIOR GARAGE, INDUSTRIAL OR WORK AREAS SUBJECT TO EQUIPMENT OR TRAFFIC LOADS: CLASS 6 FLOOR WITH A SPECIAL METALLIC OF MINERAL AGGREGATE SURFACE HARDENER.
 - ii EXTERIOR STRUCTURAL FLOOR SLABS SUBJECT TO FOOT AND MAINTENANCE TRAFFIC LOADS: CLASS 4 OR 5 FLOOR. PROVIDE A NONSLIP FINISH TO ALL WALKING SURFACES.
- B. PLACING, CONSOLIDATING, AND FINISHING. FOLLOW THE RECOMMENDATIONS GIVEN IN CHAPTER 8.

15. TIMBER FRAMING:

- A. ALL WOOD FRAMING, BLOCKING AND NAILING SHALL CONFORM TO THE CURRENT LOCAL BUILDING CODE.
- B. ALL STUD WALLS ARE TO HAVE DOUBLE TOP PLATES OF THE SAME DIMENSIONS AND GRADE AS THE STUD. PLATES ARE TO BE LAPPED A MINIMUM OF 4'-0" AND NAILED TOGETHER WITH AT LEAST (8) 16D NAILS THROUGH BOTH PLATES ON EACH SIDE OF ALL SPLICE POINTS OR AS NOTED ON THE PLANS AND DETAILS.
- C. ALL TRIMMERS SHALL HAVE SOLID BEARING TO THE FOUNDATION.
- D. ALL RAFTERS, TRUSSES AND JOISTS SHALL HAVE FULL DEPTH BLOCKING, UNLESS NOTED OTHERWISE ON THE PLANS AND DETAILS, AT BEARING SUPPORTS, SHEAR TRANSFER SUPPORTS, INTERMEDIATE AND CANTILEVER SUPPORTS AND AT MID-SPAN, AND AS REQUIRED BY THE BUILDING CODE OR PRODUCT SUPPLIER.
- E. ALL POSTS AND COLUMNS SHALL BE INSTALLED WITH APPROVED POST OR COLUMN CAPS AND BASES, UNLESS OTHERWISE NOTED ON THE PLANS.
- F. ALL FRAMING HARDWARE INCLUDING COLUMN CAPS AND BASES, JOIST HANGERS, TRUSS ANCHORS, STRAPS, ETC. SHALL BE APPROVED (I.E. SIMPSON CO. OR EQUIVALENT) OR CUSTOM FABRICATED SPECIFICALLY AS DETAILED ON THE PLANS. THEY SHALL BE INSTALLED WITH NAILS, SCREWS OR BOLTS EXACTLY AS CALLED FOR BY THE MANUFACTURER OR AS NOTED ON THE PLANS.

16. PRE-ENGINEERED/FABRICATED WOOD TRUSSES.

- A. ALL PRE-ENGINEERED/FABRICATED WOOD (P.E.W.) TRUSSES INDICATED ON THE DRAWINGS SHALL BE METAL PRESS-PLATE CONNECTED WOOD TRUSSES DESIGNED BY A PROFESSIONAL ENGINEER REGISTERED IN THE STATE OF IDAHO PER THESE NOTES AND THE SPECIFICATIONS.
- i DESIGN P.E.W. TRUSSES TO THE FOLLOWING DEFLECTION LIMITS:
 - ii ROOF DEAD + LIVE LOAD: SPAN/240 OR 3/4 IN MAXIMUM
 - iii ROOF LIVE LOAD ONLY: SPAN/360 OR 1/2-IN MAXIMUM
- B. SHOP DRAWINGS AND DESIGN CALCULATIONS SIGNED AND STAMPED BY THE DESIGN ENGINEER SHALL BE SUBMITTED TO THE ARCHITECT/ENGINEER FOR REVIEW PRIOR TO FABRICATION.
- C. ALL NECESSARY BRIDGING, BLOCKING, PRE-NOTCHED OR BEVELED PLATES, HANGERS, ETC. SHALL BE DETAILED OR SPECIFIED ON THE SHOP DRAWINGS AND FURNISHED BY THE TRUSS MANUFACTURER.
- D. TRUSS MANUFACTURER SHALL VERIFY ALL SETBACKS, DIMENSIONS, OVERHANGS, VERTICAL CONTROLS AND DIMENSIONS PRIOR TO FABRICATION.
- E. ALTERATION OF THE TRUSS LAYOUT SHOWN ON THE PLANS MAY REQUIRE SUPPORTING STRUCTURAL AND FOUNDATION CHANGES, THEREFORE, PRIOR APPROVAL BY THE ARCHITECT/ENGINEER IS REQUIRED FOR ANY PROPOSED LAYOUT CHANGE.
- F. TRUSSES SHALL NOT BE FIELD MODIFIED WITHOUT WRITTEN AUTHORIZATION FROM THE TRUSS MANUFACTURER'S ENGINEER OF RECORD.
- G. TRUSSES SHALL BE HANDLED, ERECTED AND BRACED AS DIRECTED BY THE TRUSS MANUFACTURER AND PER THE REQUIREMENTS OF THE TRUSS PLATE INSTITUTE MANUAL HIB-91 OR CURRENT EDITION.

17. WOOD SHEATHED DIAPHRAGM CONSTRUCTION REQUIREMENTS.

- A. WOOD SHEATHED ROOF DIAPHRAGMS:
- i UNLESS OTHERWISE NOTED ON THE DRAWINGS, ORIENT ROOF SHEATHING WITH FACE-GRAIN PERPENDICULAR TO SUPPORTING MEMBERS, WITH JOINTS IN ADJACENT ROWS STAGGERED 1/2 PANEL LENGTH.
 - ii NAIL ROOF SHEATHING TO ALL SUPPORTING MEMBERS AND BLOCKING AS FOLLOWS:
 - (a) 8D NAILS @ 6-IN. O.C. AT ALL DIAPHRAGM BOUNDARIES.
 - (b) 8D NAILS @ 6-IN. O.C. AT ALL PANEL EDGES.
 - (c) 8D NAILS @ 12-IN. O.C. TO INTERMEDIATE FRAMING MEMBERS.
- B. WOOD SHEATHED WALLS:
- i WALL SHEATHING TO BE ORIENTED VERTICALLY.
 - ii ALL UNSUPPORTED EDGES TO BE BACKED WITH 2X SOLID BLOCKING.
 - iii MINIMUM NAILING WHERE NOT NOTED OTHERWISE SHALL BE 8D NAILS @ 6-IN. O.C. TO ALL PANEL EDGES AND 12-IN. O.C. AT INTERMEDIATE SUPPORTING MEMBERS.

19. MECHANICAL OPENINGS.

- A. MECHANICAL OPENINGS ARE NOT SHOWN ON THE STRUCTURAL DRAWINGS; REFER TO MECHANICAL PLANS FOR SIZE AND LOCATIONS.
- B. OPENINGS THROUGH CONCRETE OR MASONRY WALLS GREATER THAN 6-INCH SQUARE OR 8-INCH ROUND SHALL BE REINFORCED WITH A MINIMUM OF 1-#5 BAR, EACH OF FOUR SIDES, EXTENDING 24" PAST THE OPENING EDGE. IN MASONRY WALLS THE BARS SHALL BE PLACED IN SOLID GROUTED CORES.



J-U-B ENGINEERS, INC.

J-U-B ENGINEERS, INC.
201 South Jackson Street
Moscow, ID 83843

Phone: 208.746.9010
www.jub.com

REUSE OF DRAWINGS
J-U-B SHALL RETAIN ALL COMMON LAW, STATUTORY, COPYRIGHT AND OTHER RIGHTS IN THIS DESIGN AND DRAWING. NO PART OF THIS DESIGN OR DRAWING SHALL BE REPRODUCED, COPIED, OR TRANSMITTED IN ANY FORM OR BY ANY MEANS, WITHOUT THE WRITTEN CONSENT OF J-U-B ENGINEERS, INC. ANY UNAUTHORIZED REUSE OF THIS DESIGN OR DRAWING SHALL BE AT THE USER'S SOLE RISK AND WITHOUT LIABILITY OR LEGAL EXPOSURE TO J-U-B.

REVISION		BY		DATE
NO.	DESCRIPTION			

WELL NO. 7
WELL COMPLETION

STRUCTURAL (S)
GENERAL NOTES

FILE: 21-20-007_S-001

JUB PROJ. # :21-20-007

DRAWN BY: ARB

DESIGN BY: JLS

CHECKED BY: RSM

AT FULL SIZE, IF NOT ONE
INCH SCALE ACCORDINGLY

LAST UPDATED: 5/20/2021

SHEET NUMBER:


S-001

Plot Date: 5/27/2021 9:43 AM Plotted By: Allen Beahm
Date Created: 5/26/2021 JUB.COM\CENTRAL\CLIENTS\JULIEWESTONCITY\PROJECTS\21-20-007 WELL NOT DESIGN\30-WELL COMPLETION\CAD SHEET\21-20-007 S-102.DWG

A1

PUMP STATION ROOF FRAMING PLAN

SCALE: 0 2'-0" 4'-0" 8'-0"
1/4" = 1'-0" @ Full Scale

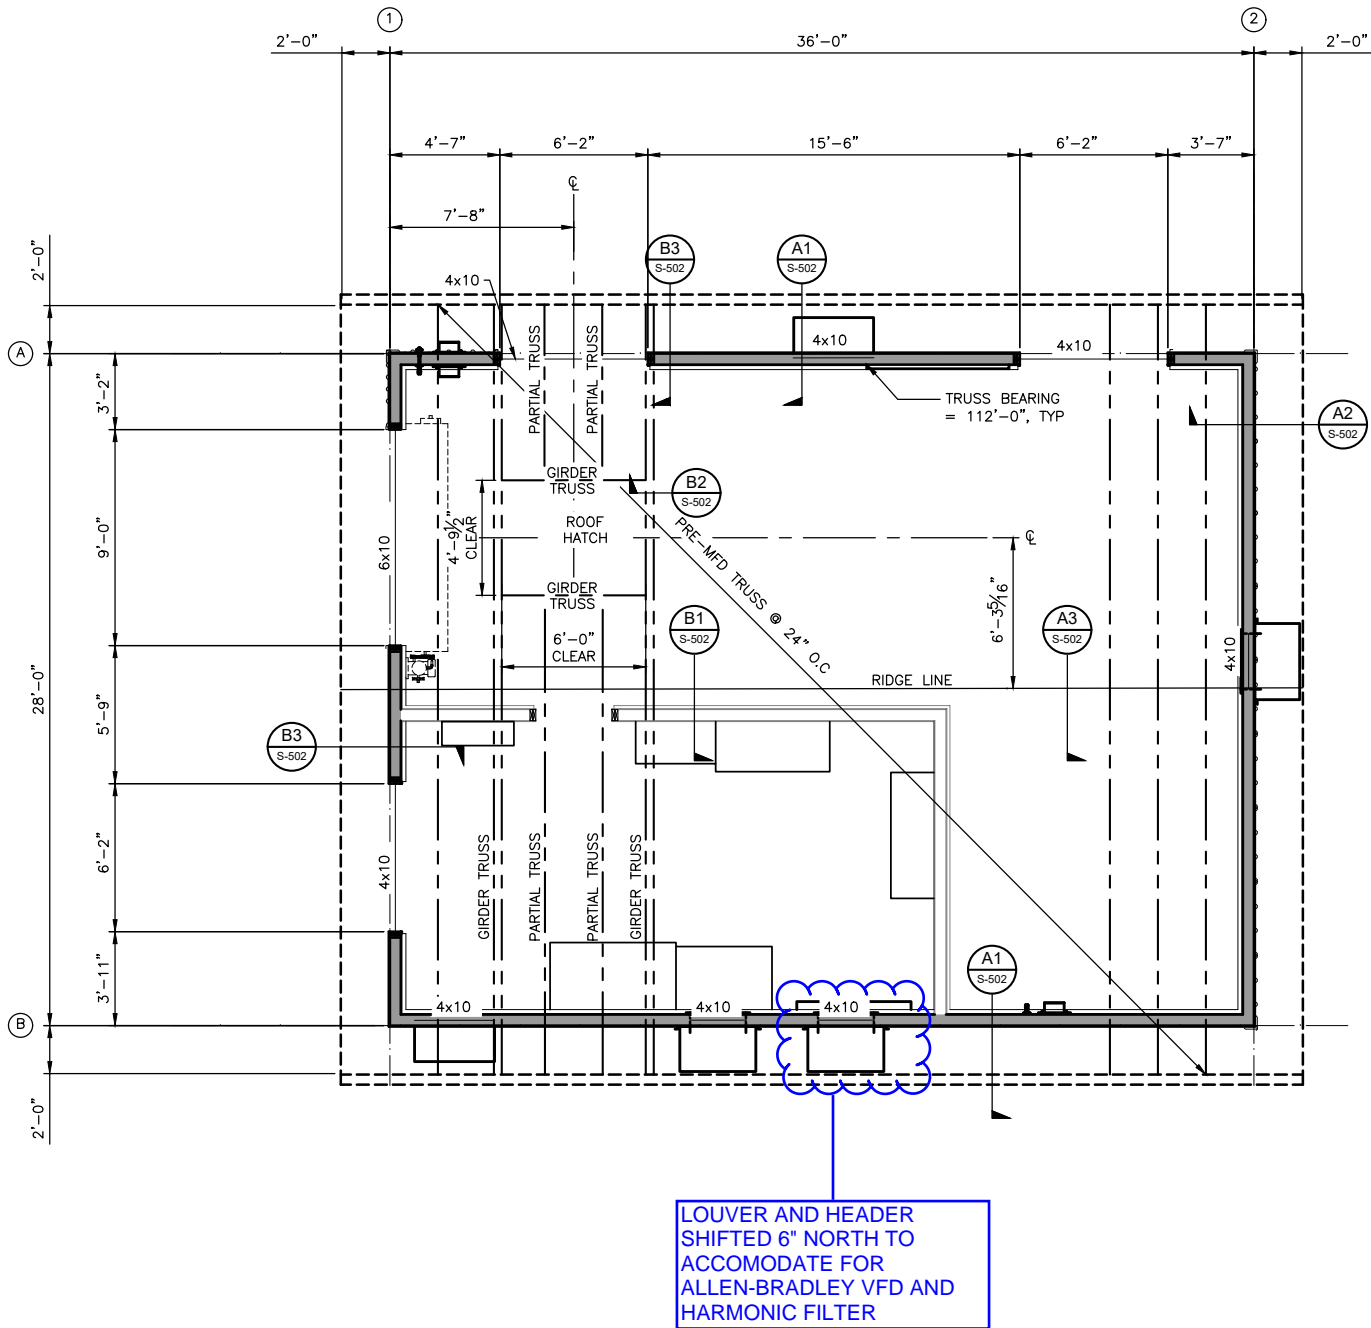

WELL BUILDING PLAN NOTES

1. VERIFY ALL DIMENSIONS WITH THE ARCHITECTURAL DRAWINGS.
2. DETAILS ON THESE PLANS ARE INTENDED TO DEPICT THE GENERAL CONSTRUCTION METHODS FOR THIS STRUCTURE. CONNECTIONS, DETAILS AND CONDITIONS NOT SPECIFICALLY SHOWN THAT ARE SIMILAR TO THOSE THAT ARE SPECIFIED SHALL BE ASSUMED ONE AND THE SAME. IF QUESTIONS REGARDING THE APPLICATION OF DETAILS ARE ENCOUNTERED, NOTIFY THE ARCHITECT/ENGINEER FOR CLARIFICATION IN A TIMELY MANNER PRIOR TO CONSTRUCTION.
3. SEE SITE/ARCH. DRAWINGS FOR WALKWAYS, DRIVEWAYS...ETC.
4. FINISHED FLOOR ELEVATION=100'-0"=1239.0' IS THE REFERENCE DATUM FOR THESE STRUCTURAL DRAWINGS. SEE SITE DRAWINGS FOR FINAL FINISH FLOOR ELEV. AND SITE GRADING INFORMATION
6. ■■■■■ INDICATES 2x WOOD STUD SHEAR WALL. SEE STRUCTURAL DETAILS FOR NAILING REQUIREMENTS.
7. SEE SHEETS S-001 FOR GENERAL STRUCTURAL NOTES AND ADD'L INFO.
8. CJ=SLAB ON GRADE CONTROL JOINT OR SAW JOINT PER S-901.
9. PROVIDE 1/2" CONCRETE EXPANSION BOARD BETWEEN CONCRETE SLABS AND ALL FOUNDATIONS (STEM WALLS).
10. ALL EXTERIOR WALL STUDS ARE 2x6 DF #2 STUDS AT 16" O.C.
11. TYPICAL HEADER SUPPORTS SHALL BE AS FOLLOWS:
(1) 2x6 DF#2 TRIMMER STUDS AND (2) 2x6 DF#2 KING STUDS, TYP. UNO.
12. CONTRACTOR IS TO COORDINATE WEIGHTS & LOCATIONS OF MECH UNITS, DUCTS,...ETC (IF ANY) w/ TRUSS MANUFACTURER.
13. SEE SHEET S-902 FOR TYPICAL WOOD FRAMING DETAILS.
14. EXTERIOR WALL SHEATHING TO BE 7/16" SHEATHING, APA INDEX 24/16. NAIL w/ 8d NAILS @ 6" OC ALONG SUPPORTED PANEL EDGES AND 12" OC ALONG INTERMEDIATE FRAMING, TYP. ALL EXTERIOR WALLS SHALL BE BLOCKED.
15. ROOF SHEATHING TO BE 5/8" NOMINAL SHEATHING, APA INDEX 40/20. NAIL w/ 8d NAILS @ 6" OC ALONG SUPPORTED PANEL EDGES AND 12" OC ALONG INTERMEDIATE FRAMING. INSTALL PANELS w/ FACE GRAIN PERPENDICULAR TO JOIST FRAMING AND STAGGER PANEL END JOINTS. USE PLY CLIPS BETWEEN TRUSSES. TYP.
16. TYP.=TYPICAL, G.T.=GIRDER TRUSS, FD=FLOOR DRAIN, TOC=TOP OF CONCRETE, FCJ=FLOOR CONTROL JOINT.
17. HD INDICATES FOUNDATION HOLD DOWN. USE SIMPSON STHD10 W/ (20) 16d SINKERS. ATTACH TO (2) 2x6 DF#2 FULL HEIGHT KING STUDS. TYP.
18. ALL HEADERS NOT LABELED ON PLAN SHALL BE 4x10 DF #2 FOR EXTERIOR BEARING WALLS AND (2) 2x10 DF #2 FOR INTERIOR NON-BEARING WALLS. SEE NOTE 11 FOR TYPICAL HEADER SUPPORTS.



J-U-B ENGINEERS, INC.

J-U-B ENGINEERS, INC.
201 South Jackson Street
Moscow, ID 83843

Phone: 208.746.9010
www.jub.com

REUSE OF DRAWINGS
JUB SHALL RETAIN ALL COMMON LAW, STATUTORY, COPYRIGHT AND PATENT RIGHTS IN THIS DRAWING. NO PART OF THIS DRAWING SHALL BE REPRODUCED OR TRANSMITTED IN ANY FORM OR BY ANY MEANS, ELECTRONIC OR MECHANICAL, INCLUDING PHOTOCOPYING, RECORDING, OR BY ANY INFORMATION STORAGE AND RETRIEVAL SYSTEM, WITHOUT THE WRITTEN CONSENT OF JUB. ANY REUSE WITHOUT WRITTEN CONSENT BY JUB WILL BE AT CLIENT'S SOLE RISK AND WITHOUT LIABILITY OR LEGAL EXPOSURE TO JUB.

REVISION		DATE	
NO.	DESCRIPTION	BY	DATE

WELL NO. 7
WELL COMPLETION


STRUCTURAL (S)
ROOF PLAN

FILE : 21-20-007 S-102
JUB PROJ. # : 21-20-007
DRAWN BY: ARB
DESIGN BY: JLS
CHECKED BY: RSM
AT FULL SIZE, IF NOT ONE INCH, SCALE ACCORDINGLY
LAST UPDATED: 5/26/2021


SHEET NUMBER:

S-102


Plot Date: 5/27/2021 9:43 AM Plotted By: Allen Boehm
Date Created: 5/17/2021 JUB.COM\CENTRAL\CLIENTS\JUB\WISCONSIN\CITY PROJECTS\21-20-007 WELL NOT DESIGN\138-WELL COMPLETION\CAD SHEET\21-20-007 S-501X.DWG

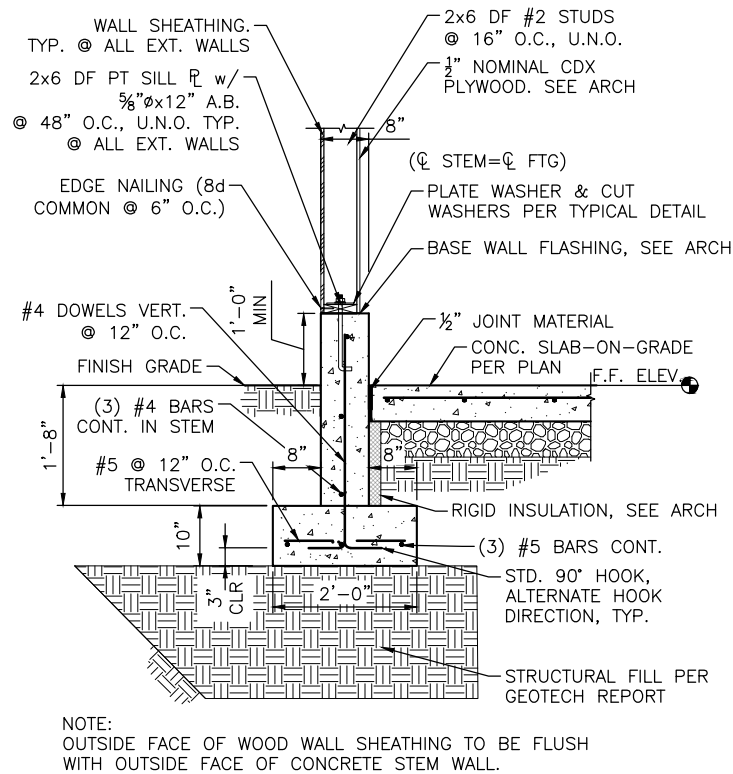

A1 EXT WALL FOOTING
SCALE: NTS

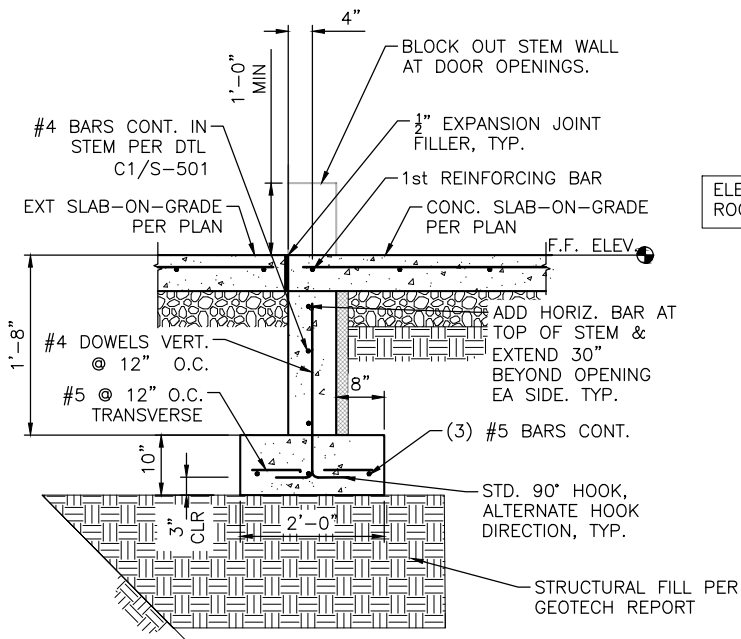


A2 OPENING @ EXT WALL FOOTING
SCALE: NTS

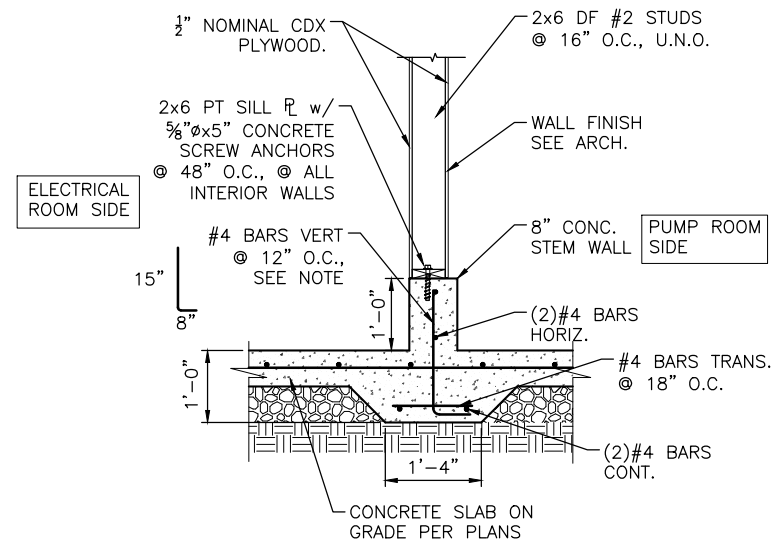


NOTE:
CONTRACTOR MAY DRILL AND EPOXY #4 VERTICAL BARS WITH 9" EMBED @ 12" O.C.

A3 INT NON-BEARING WALL FOOTING
SCALE: NTS

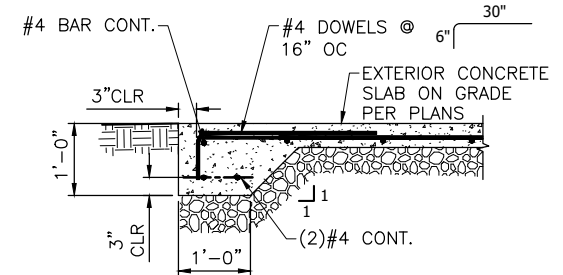

A4 TURN DOWN SLAB
SCALE: NTS

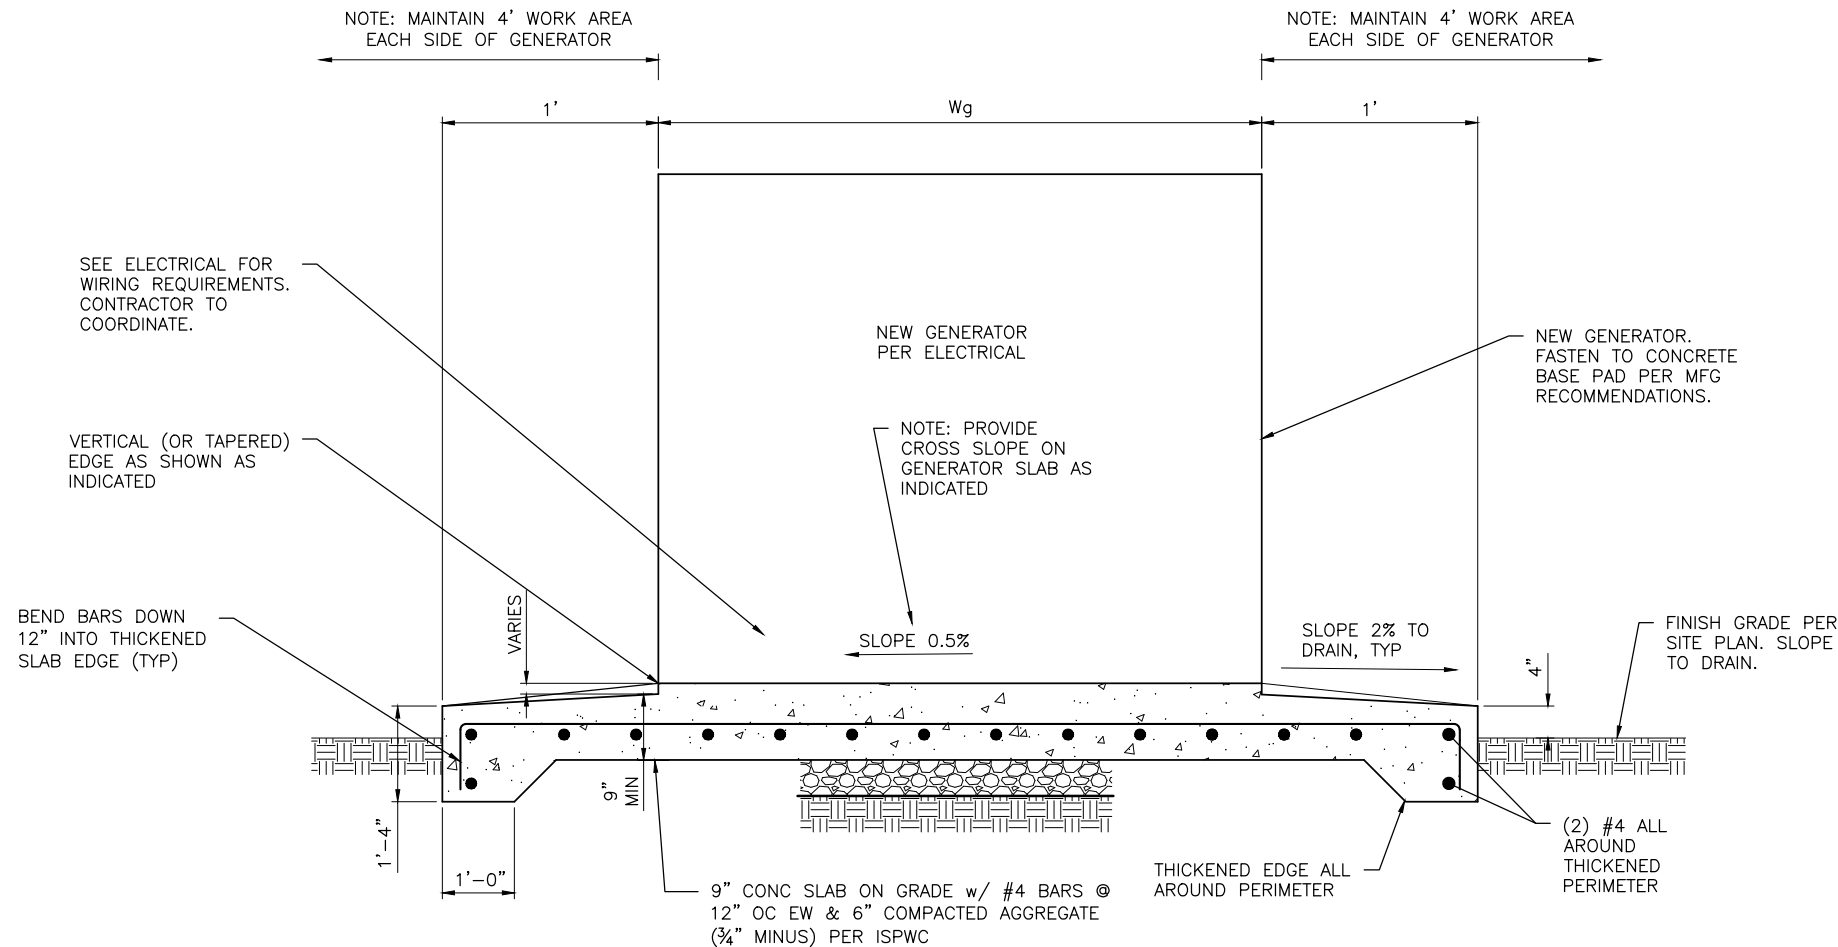

B1 TYPICAL GENERATOR SLAB-ON-GRADE DETAIL
SCALE: NTS

REUSE OF DRAWINGS
JUB SHALL RETAIN ALL COMMON LAW, STATUTORY, COPYRIGHT AND OTHER RIGHTS IN THIS DRAWING. NO PART OF THIS DRAWING SHALL BE REPRODUCED OR TRANSMITTED IN ANY FORM OR BY ANY MEANS, ELECTRONIC OR MECHANICAL, INCLUDING PHOTOCOPYING, RECORDING, OR BY ANY INFORMATION STORAGE AND RETRIEVAL SYSTEM, WITHOUT THE WRITTEN CONSENT OF JUB. ANY REUSE WITHOUT WRITTEN CONSENT BY JUB WILL BE AT CLIENT'S SOLE RISK AND WITHOUT LIABILITY OR LEGAL EXPOSURE TO JUB.



REVISION		NO.	DESCRIPTION	BY	DATE

WELL NO. 7
WELL COMPLETION

STRUCTURAL FOUNDATION DETAILS

FILE #: 21-20-007 S-501X
JUB PROJ. #: 21-20-007
DRAWN BY: ARB
DESIGN BY: JLS
CHECKED BY: RSM
AT FULL SIZE, IF NOT ONE INCH SCALE ACCORDINGLY
LAST UPDATED: 5/26/2021
SHEET NUMBER:


S-501

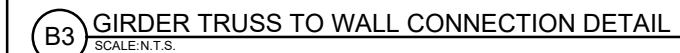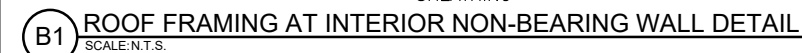


Plot Date: 10/13/2021 5:16 PM Plotted By: Jessie Shookles
Date Created: 10/13/2021 JUB.COM\CENTRAL\CLIENTS\LEWISTON\CITY PROJECTS\21-20-007 WELL NO.7\DESIGN\308-WELL COMPLETION\CAD SHEET\21-20-007 S-501X.DWG

A1

PUMP SUPPORT - PEDESTAL PLAN & FOUNDATION SECTION
SCALE: NTS

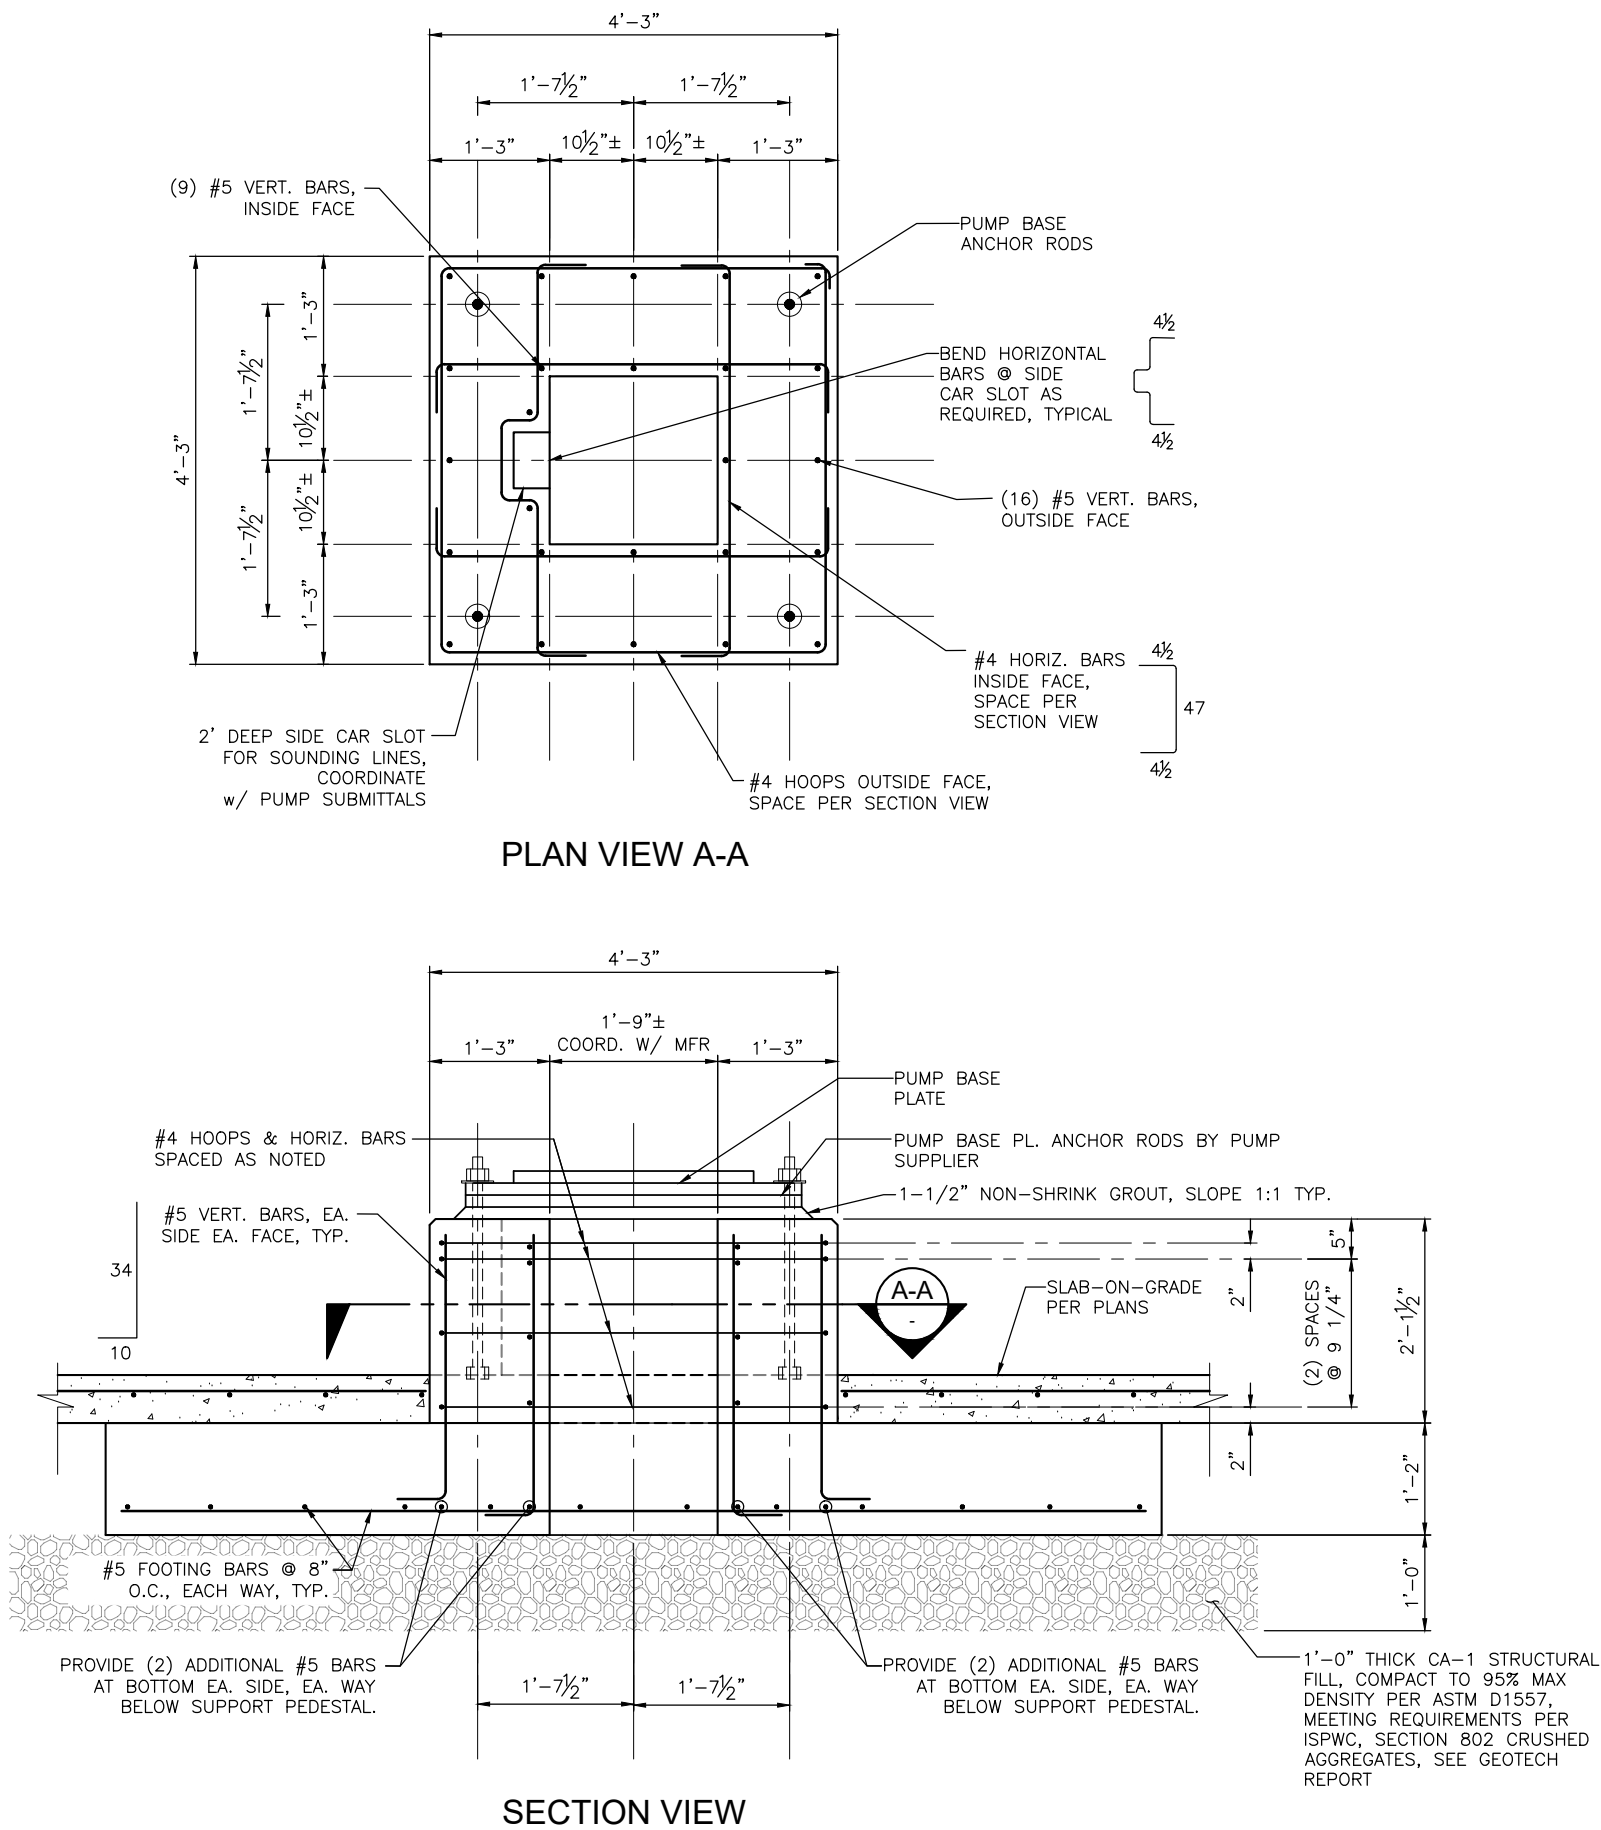

ORIGINAL S-503 WAS
RE-ISSUED IN WORK
CHANGE DIRECTIVE 01
TO INCORPORATE THE
SIDE CAR SLOT AS
SHOWN IN CURRENT
S-503



J-U-B ENGINEERS, INC.

J-U-B ENGINEERS, INC.

201 South Jackson Street
Moscow, ID 83843

Phone: 208.746.9010
www.jub.com

REUSE OF DRAWINGS

J-U-B SHALL RETAIN ALL COMMON LAW, STATUTORY, COPYRIGHT AND OTHER RIGHTS IN ALL DRAWINGS, SPECIFICATIONS AND THE SAME SHALL BE REUSED IN ANY PROJECT WITHOUT THE WRITTEN CONSENT OF J-U-B. ANY REUSE WITHOUT WRITTEN CONSENT BY J-U-B WILL BE AT CLIENT'S SOLE RISK AND WITHOUT LIABILITY OR LEGAL EXPOSURE TO J-U-B.

REVISION		NO.	DESCRIPTION	BY	DATE

WELL NO. 7
WELL COMPLETION

STRUCTURAL PUMP SUPPORT DETAILS

FILE: 21-20-007_S-501X
JUB PROJ. #: 21-20-007
DRAWN BY: ARB
DESIGN BY: JLS
CHECKED BY: RSM

ONE INCH
AT FULL SIZE, IF NOT ONE
INCH, SCALE ACCORDINGLY

LAST UPDATED: 10/13/2021

SHEET NUMBER:


S-503

Plot Date: 5/27/2021 9:43 AM Plotted By: Allen Boehm
Date Created: 5/12/2021 JUB.COM\CENTRAL\CLIENTS\JULWISTON\GITY\PROJECTS\21-20-007 WELL\NOT DESIGN\138-WELL\COMPLETION\CAD\SHEET\21-20-007 S-901X.DWG

TYPICAL LAP SPLICE LENGTHS IN INCHES, PER ACI 318									
BAR SIZE	LAP CLASS	f'c=3,000 psi		f'c=4,000 psi		f'c=5,000 psi		f'c=6,000 psi	
		CAT.1	CAT.2	CAT.1	CAT.2	CAT.1	CAT.2	CAT.1	CAT.2
#4	A	22	33	19	28	17	25	15	23
	B	28	43	25	37	22	33	20	30
#5	A	27	41	24	36	21	32	19	29
	B	36	53	31	46	28	41	25	38
#6	A	33	49	28	43	25	38	23	35
	B	43	64	37	55	33	50	30	45
#7	A	48	72	42	62	37	56	34	51
	B	62	93	54	81	48	72	44	66
#8	A	55	82	47	71	42	64	39	58
	B	71	106	61	92	55	83	50	76
#9	A	62	92	53	80	48	72	44	65
	B	80	120	69	104	62	93	57	85

- NOTES:
- FOR GRADE 60 REINFORCING STEEL BARS.
 - ALL LAP SPLICES SHALL BE CLASS B, UNLESS NOTED OTHERWISE.
 - CATEGORY 1: CLEAR COVER \geq db & CLR. SPACING \geq db, AND STIRRUPS OR TIES THROUGHOUT L_d ARE PROVIDED.
 - CATEGORY 1: CLEAR COVER \geq db & CLR. SPACING \geq 2db.
 - CATEGORY 2: CLEAR COVER $<$ db OR CLR. SPACING $<$ 2db.
 - FOR TOP BARS MULTIPLY LAP LENGTH LISTED BY 1.30
 - TOP BARS ARE HORIZONTAL BARS WITH MORE THAN 12" OF CONCRETE CAST BELOW THE BARS.

A1 TYPICAL REBAR LAP SPLICE SCHEDULE
SCALE: N.T.S.

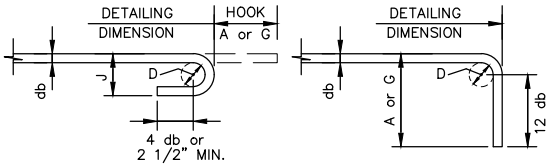


180° HOOKS 90° HOOKS

BAR SIZE	D	180° HOOKS		90° HOOKS
		A or G	J	A or G
#3	2 1/4"	5"	3"	6"
#4	3"	6"	4"	8"
#5	3 3/4"	7"	5"	10"
#6	4 1/2"	8"	6"	1'-0"
#7	5 1/4"	10"	7"	1'-2"
#8	6"	11"	8"	1'-4"

- NOTES:
- db = NOMINAL BAR DIAMETER.
 - D = FINISHED INSIDE BEND DIAMETER.
 - MINIMUM D = 6 db FOR #3 TO #8 BARS
 - MINIMUM D = 8 db FOR #9 TO #11 BARS
 - MINIMUM D = 10 db FOR #14 AND #18 BARS
 - TYPICAL MINIMUM END HOOKS, ALL GRADES OF STEEL.

A2 TYP. REBAR HOOK DETAILS
SCALE: N.T.S.

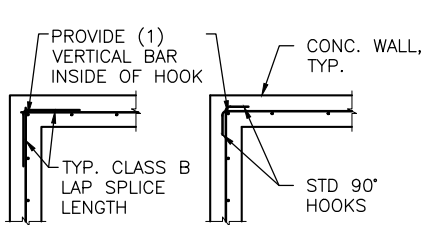


OPTION "A" OPTION "B"

- NOTES:
- CORNER AND INTERSECTION BARS TO MATCH SIZE & SPACING OF HORIZ. BARS.
 - CENTER VERTICAL BARS IN WALL U.N.O.
 - REFER TO OTHER DETAILS FOR REQUIRED BAR SIZE AND SPACING.
 - THIS IS A TYPICAL DETAIL FOR WALLS WITH (1) MATT OF REINFORCING.
 - THIS IS A TYPICAL DETAIL FOR NON-WATER RETAINING WALLS.


A3 TYP. WALL INTERSECTION REBAR DETAILS
SCALE: N.T.S.

A4 DETAIL NOT USED
SCALE: 3/4"=1'-0"

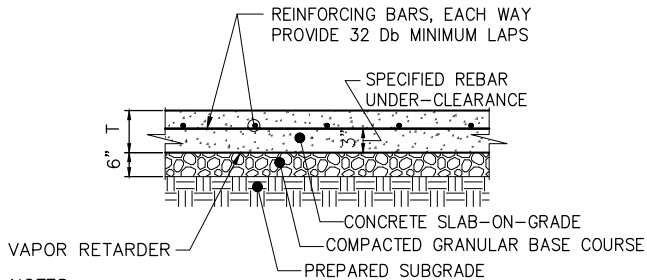


- NOTES:
- PREPARE & COMPACT SUBGRADE PER GEOTECHNICAL REPORT RECOMENDATIONS.
 - CAREFULLY INSTALL VAPOR BARRIER/RETARDER & PROTECT FROM DAMAGE.
 - REFER TO FOUNDATION PLANS FOR SLAB THICKNESS T & BASE COURSE G.

B1 TYPICAL SLAB-ON-GRADE DETAIL
SCALE: 1"=1'-0"

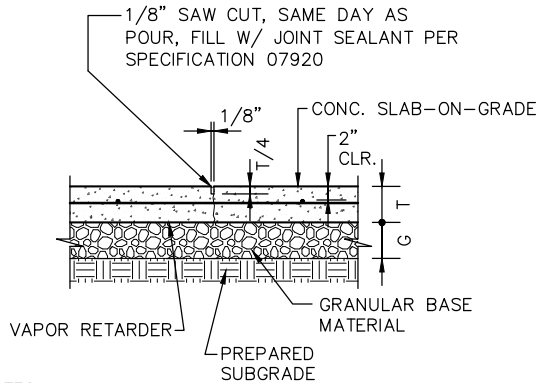

- NOTES:
- REFER TO FOUNDATION PLAN FOR SLAB AND GRANULAR MATERIAL THICKNESS T AND G, AND SLAB REINFORCING REQUIREMENTS.
 - CONTROL JOINTS TO BE 15'-0" ON CENTER, MAXIMUM, UNLESS NOTED OTHERWISE.
 - CUT EVERY OTHER BAR CROSSING CONTROL JOINTS.
 - USE FOR NON WATER-RETAINING INTERIOR FLOOR SLABS.

B2 TYPICAL CONCRETE SLAB-ON-GRADE FCJ DETAIL
SCALE: 1"=1'-0"

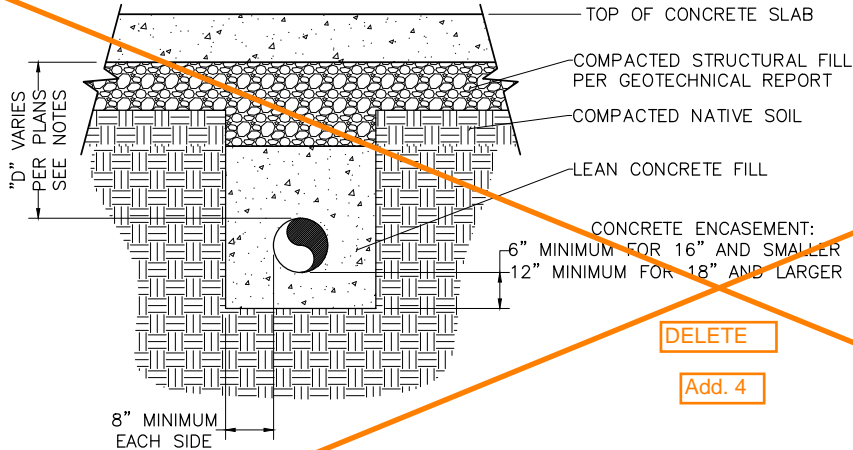

B3 PIPE ENCASEMENT IN CONCRETE BENEATH SLAB
SCALE: N.T.S.

- NOTES:
- UNLESS NOTED OTHERWISE:
 - IF "D" IS LESS THAN 1'-6" PROVIDE CONCRETE ENCASEMENT CONTINUOUS TO SLAB.
 - IF "D" IS GREATER THAN 1'-6" PROVIDE CONCRETE ENCASEMENT TO TOP OF NATIVE SOIL; 12" MINIMUM CONCRETE ENCASEMENT.
 - EXTEND CONCRETE PIPE ENCASEMENT 12" BEYOND EDGE OF SLAB, TYPICAL.

DELETE

Add. 4

C1 DETAIL NOT USED
SCALE: 3/4"=1'-0"

C2 DETAIL NOT USED
SCALE: 3/4"=1'-0"

C3 DETAIL NOT USED
SCALE: 3/4"=1'-0"

C4 DETAIL NOT USED
SCALE: 3/4"=1'-0"



J-U-B ENGINEERS, INC.

J-U-B ENGINEERS, INC.

201 South Jackson Street
Moscow, ID 83843

Phone: 208.746.9010
www.jub.com

REUSE OF DRAWINGS
JUB SHALL RETAIN ALL COMMON LAW, STATUTORY, COPYRIGHT AND OTHER RIGHTS IN ANY DESIGN OR DRAWING. NO PART OF ANY DESIGN OR DRAWING SHALL BE REPRODUCED OR TRANSMITTED IN ANY FORM OR BY ANY MEANS, ELECTRONIC OR MECHANICAL, INCLUDING PHOTOCOPYING, RECORDING, OR BY ANY INFORMATION STORAGE AND RETRIEVAL SYSTEM, WITHOUT THE WRITTEN CONSENT OF JUB. ANY REUSE WITHOUT WRITTEN CONSENT BY JUB WILL BE AT CLIENT'S SOLE RISK AND WITHOUT LIABILITY OR LEGAL EXPOSURE TO JUB.

REVISION		NO.	DESCRIPTION	BY	DATE

WELL NO. 7

WELL COMPLETION

CONCRETE TYPICAL DETAILS



FILE: 21-20-007_S-901X
JUB PROJ. #: 21-20-007
DRAWN BY: ARB
DESIGN BY: JLS
CHECKED BY: RSM

ONE INCH
AT FULL SIZE, IF NOT ONE
INCH, SCALE ACCORDINGLY

LAST UPDATED: 5/25/2021

SHEET NUMBER:

S-901

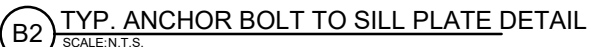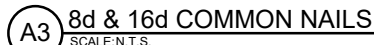

GENERAL NOTES:

1. ALL DIMENSION ARE TO FACE OF STUDS UNLESS NOTED OTHERWISE.
2. SEE EXTERIOR ELEVATIONS FOR ADDITIONAL OPENING LOCATIONS AND SIZES.
3. SEE STRUCTURAL, PROCESS, ELECTRICAL AND MECHANICAL FOR ADDITIONAL INFORMATION AND CONSTRUCTION REQUIREMENTS.
4. SEE SITE CIVIL FOR FINISH ELEVATIONS AROUND EXTERIOR PERIMETER OF BUILDING AND STRUCTURAL FOR INTERIOR ELEVATIONS.
5. SEE EXTERIOR ELEVATIONS FOR EXTERIOR ROOM AND BUILDING SIGNAGE LOCATIONS.

LEGEND:

DS = GUTTER DOWNSPOUT
FE = FIRE EXTINGUISHER. SEE 19/A-903

AREA SUMMARY (excludes exterior walls):

ELECTRICAL ROOM: 281 SF
PUMP ROOM: 669 SF
TOTAL AREA: 950 SF

RECORD DRAWINGS:

These record drawings have been prepared based on information gathered during field observations as well as information provided by others. The accuracy or completeness of information provided by others has not been verified by J-U-B ENGINEERS, Inc. and/or B2 Architecture, Inc. The Architect shall not be held responsible for the accuracy or completeness of the information provided by the Contractor.

If these record drawings are a public record, J-U-B ENGINEERS, Inc. grants the public entity with jurisdiction the right to copy and disseminate the hard copy or digital image to those who legitimately request the information in writing. Any release, use, or reuse by the public entity, any individual, or organization, shall be at the public entity's, individual's, and/or organization's sole risk and without liability or legal exposure to J-U-B ENGINEERS, Inc. and/or B2 Architecture, Inc.

Any seals of the registrants included hereon represent that the drafting of the record drawing information was completed by staff under the registrants' responsible charge.



J-U-B ENGINEERS, INC.
201 South Jackson Street
Moscow, ID 83843
Phone: 208.746.9010
www.jub.com

RECORD
LICENSED ARCHITECT
AR-985283
ORIGINAL SIGNED BY:
JAMES E. LEMON
DATE ORIGINAL
SIGNED: 5/24/21
James E. Lemon
STATE OF IDAHO


DRAWINGS

REUSE OF DRAWINGS		REVISION	
THIS DOCUMENT AND THE IDEAS AND DESIGNS INCORPORATED HEREIN ARE THE PROPERTY OF JUB ENGINEERS, INC. AND SHALL NOT BE REPRODUCED, COPIED, OR TRANSMITTED IN ANY FORM OR BY ANY MEANS, ELECTRONIC OR MECHANICAL, WITHOUT THE EXPRESS WRITTEN AUTHORIZATION OF JUB ENGINEERS, INC.		NO.	DATE
1	RECORD DRAWINGS	DESCRIPTION	DATE
1	RECORD DRAWINGS	DESCRIPTION	DATE

WELL NO. 7
CITY OF LEWISTON
ARCHITECTURAL (A)
WELL NO. 7
FLOOR PLAN

FILE:
JUB PROJ. #: 21-20-007
DRAWN BY: JL
DESIGN BY: JL
CHECKED BY: JL
AT FULL SIZE, IF NOT ONE
INCH, SCALE ACCORDINGLY
LAST UPDATED:
SHEET NUMBER:

A-101R

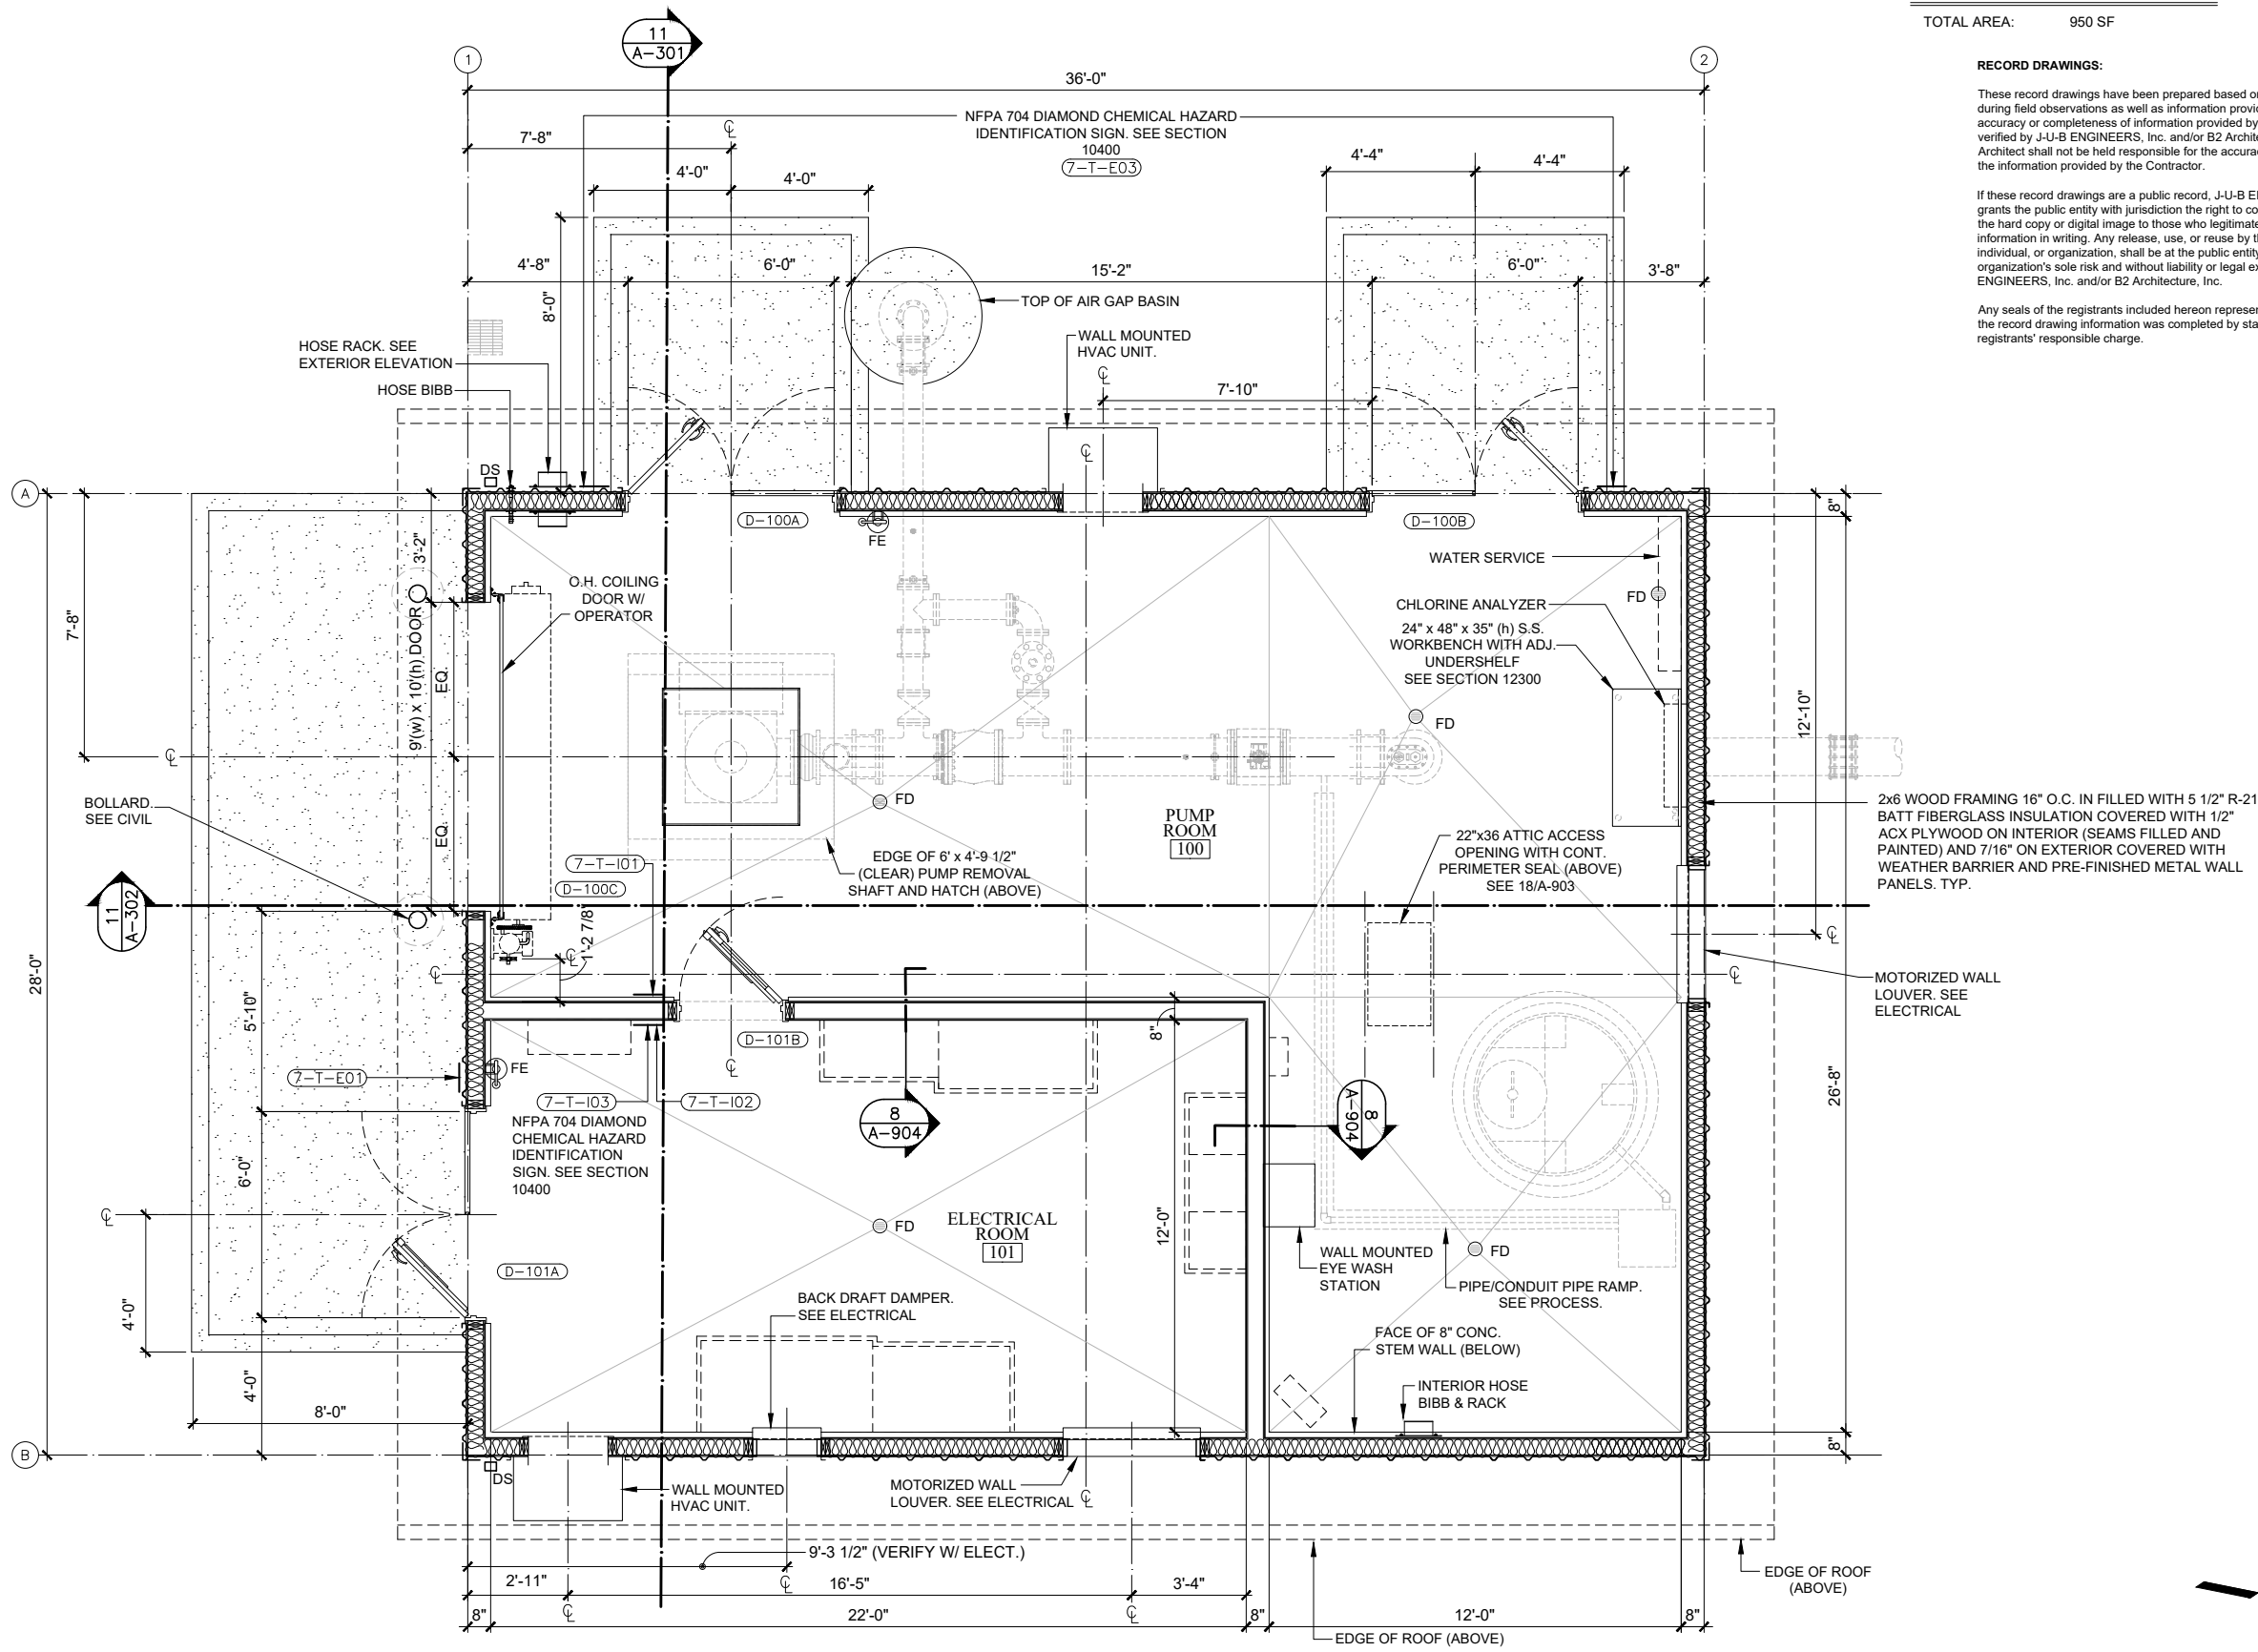

16 | PRELIMINARY - FLOOR PLAN

SCALE: 3/8" = 1'-0" (3/16" on 11" x 17")

Plot Date: 11/14/2022 5:15 PM Plotted By: James Lemon
Date Created: 11/17/2022 C:\CRODPOXP\DRIVE2001\CITY OF LEWISTON - WELL 7\2 DRAWINGS\2D DESIGN\WELL 7 BASE RECORD SET.DWG

Plot Date: 11/14/2022 5:16 PM Plotted By: James Lemon
Date Created: 11/17/2022 C:\DROPC\XP_DRIVE\2001 CITY OF LEWISTON - WELL 702 DRAWINGS\2D DESIGN\WELL 7 BASE-RECORD SET.DWG

GENERAL ELEVATION NOTES:


1. SEE MANUFACTURER'S PRODUCT AND COLOR SCHEDULE ALONG WITH ROOM AND MISCELLANEOUS ITEM FINISH SCHEDULE ON SHEET A-901 FOR MATERIAL AND COLORS.
2. SEE STRUCTURAL, PROCESS, ELECTRICAL AND MECHANICAL FOR ADDITIONAL INFORMATION AND CONSTRUCTION REQUIREMENTS.

RECORD DRAWINGS:

These record drawings have been prepared based on information gathered during field observations as well as information provided by others. The accuracy or completeness of information provided by others has not been verified by J-U-B ENGINEERS, Inc. and/or B2 Architecture, Inc. The Architect shall not be held responsible for the accuracy or completeness of the information provided by the Contractor.



If these record drawings are a public record, J-U-B ENGINEERS, Inc. grants the public entity with jurisdiction the right to copy and disseminate the hard copy or digital image to those who legitimately request the information in writing. Any release, use, or reuse by the public entity, any individual, or organization, shall be at the public entity's, individual's, and/or organization's sole risk and without liability or legal exposure to J-U-B ENGINEERS, Inc. and/or B2 Architecture, Inc.

Any seals of the registrants included hereon represent that the drafting of the record drawing information was completed by staff under the registrants' responsible charge.

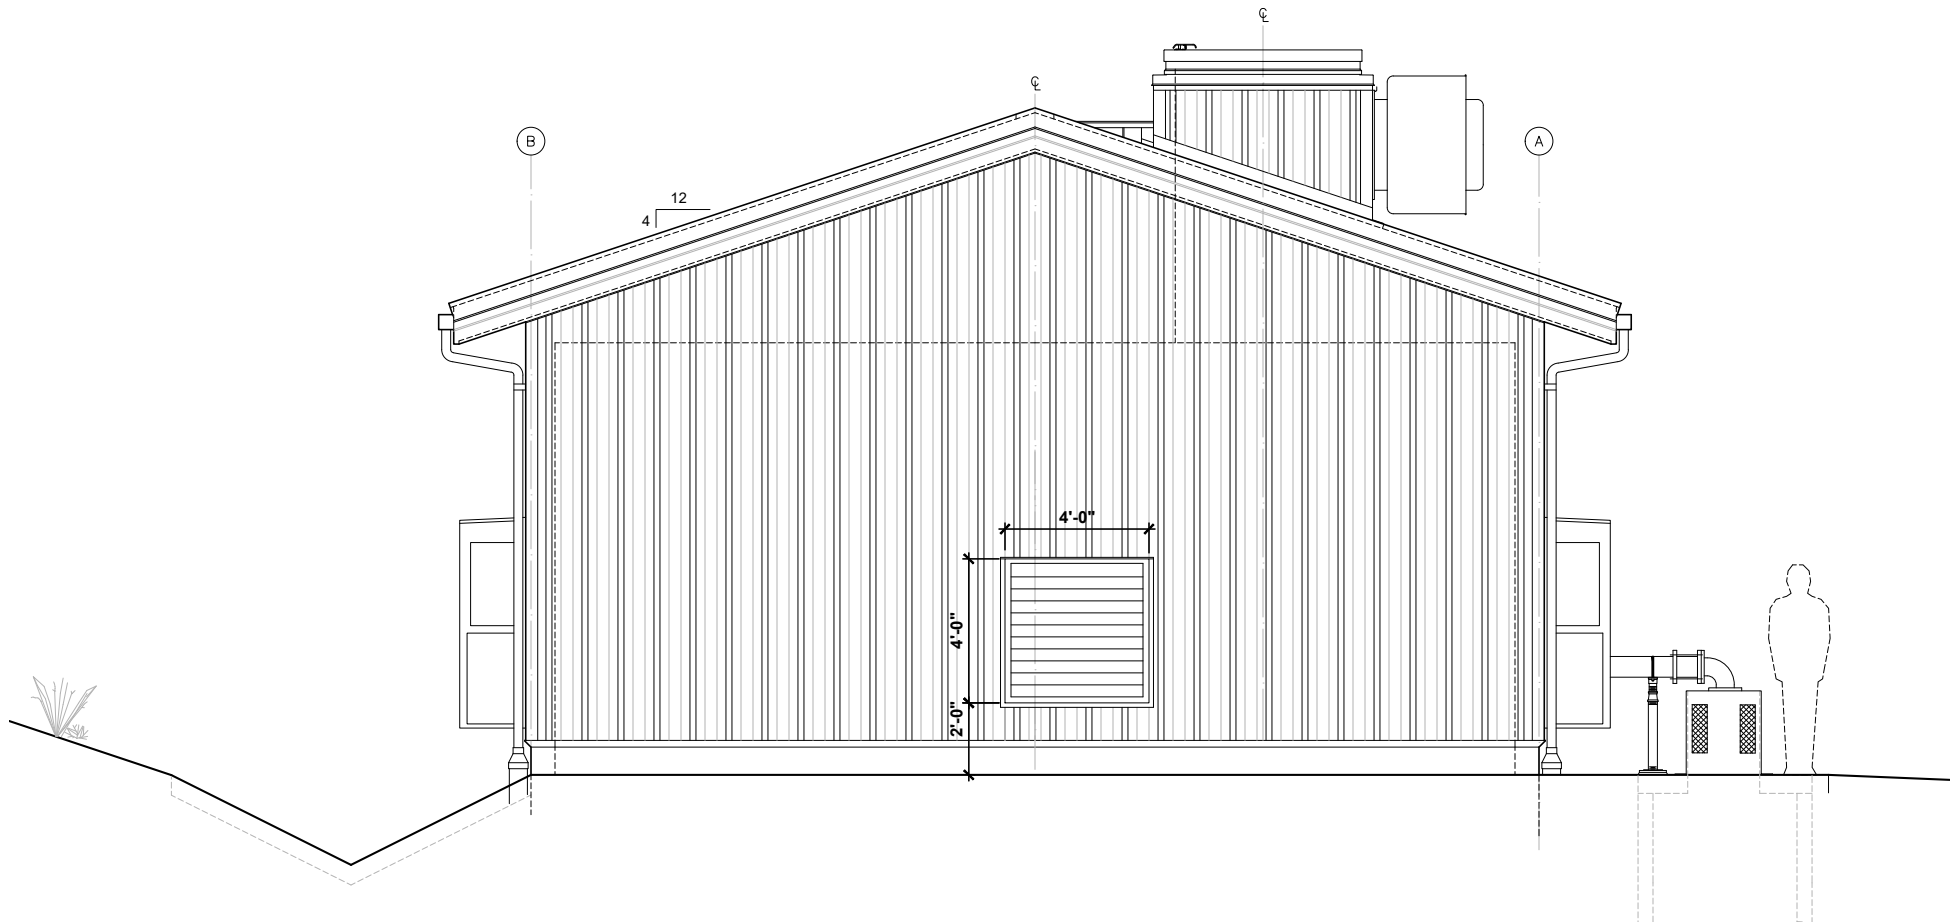

6 | EXTERIOR ELEVATION - NORTH

SCALE: 3/8" = 1'-0" (3/16" on 11" x 17")

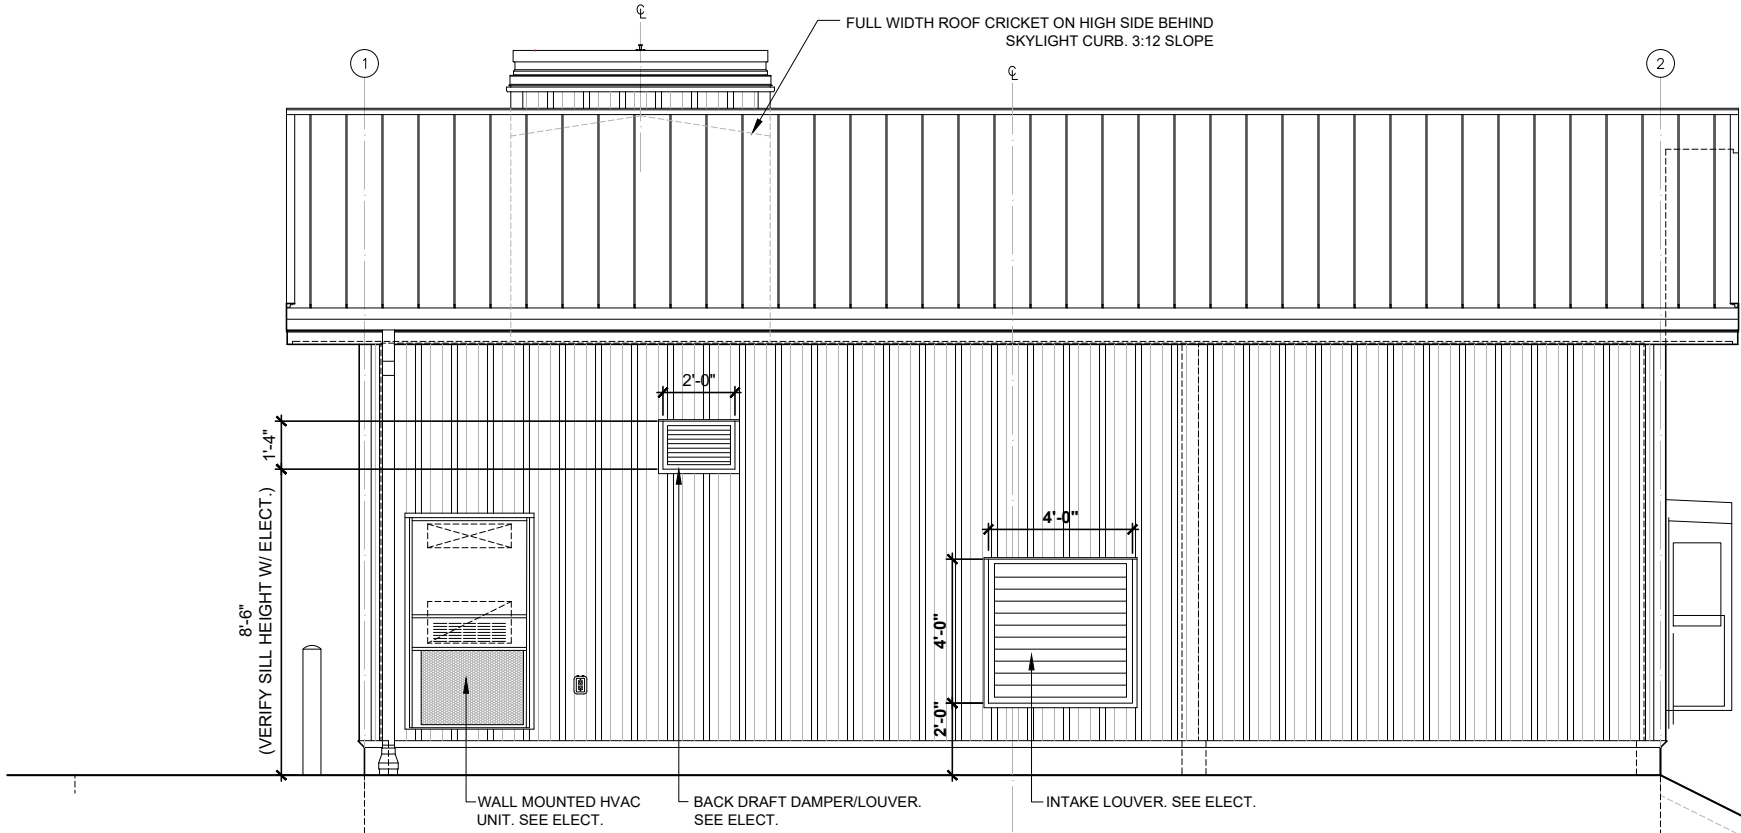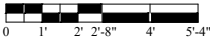

16 | EXTERIOR ELEVATION - EAST

SCALE: 3/8" = 1'-0" (3/16" on 11" x 17")



J-U-B ENGINEERS, INC.

201 South Jackson Street
Moscow, ID 83843

Phone: 208.746.9010
www.jub.com

RECORD

LICENSED
ARCHITECT
AR-985283

ORIGINAL SIGNED BY:
JAMES E. LEMON
DATE ORIGINAL
SIGNED: 5/24/21

James E. Lemon
STATE OF IDAHO

DRAWINGS

REUSE OF DRAWINGS
THIS DOCUMENT AND THE IDEAS AND DESIGNS INCORPORATED HEREIN ARE THE PROPERTY OF J-U-B ENGINEERS, INC. AND NOT BE REUSED IN WHOLE OR PART FOR ANY OTHER PROJECT WITHOUT THE EXPRESS WRITTEN AUTHORIZATION OF J-U-B ENGINEERS, INC.

REVISION		NO.	DESCRIPTION	BY	DATE
1	RECORD DRAWINGS	JEL	JEL	11-14-22	

WELL NO. 7
CITY OF LEWISTON

ARCHITECTURAL (A)
WELL NO. 7

SOUTH & WEST EXTERIOR ELEVATIONS

FILE:
JUB PROJ. #: 21-20-007
DRAWN BY: JL
DESIGN BY: JL
CHECKED BY: JL
AT FULL SIZE, IF NOT ONE
INCH, SCALE ACCORDINGLY
LAST UPDATED:
SHEET NUMBER:

A-201R

Plot Date: 11/14/2022 5:16 PM Plotted By: James Lemon
Date Created: 11/17/2022 C:\DROBOX\DRIVE201 CITY OF LEWISTON - WELL 702 DRAWINGS\2D DESIGN\WELL 7 BASE-RECORD SET.DWG

GENERAL ELEVATION NOTES:


1. SEE MANUFACTURER'S PRODUCT AND COLOR SCHEDULE ALONG WITH ROOM AND MISCELLANEOUS ITEM FINISH SCHEDULE ON SHEET A-901 FOR MATERIAL AND COLORS.
2. SEE STRUCTURAL, PROCESS, ELECTRICAL AND MECHANICAL FOR ADDITIONAL INFORMATION AND CONSTRUCTION REQUIREMENTS.

RECORD DRAWINGS:


These record drawings have been prepared based on information gathered during field observations as well as information provided by others. The accuracy or completeness of information provided by others has not been verified by J-U-B ENGINEERS, Inc. and/or B2 Architecture, Inc. The Architect shall not be held responsible for the accuracy or completeness of the information provided by the Contractor.

If these record drawings are a public record, J-U-B ENGINEERS, Inc. grants the public entity with jurisdiction the right to copy and disseminate the hard copy or digital image to those who legitimately request the information in writing. Any release, use, or reuse by the public entity, any individual, or organization, shall be at the public entity's, individual's, and/or organization's sole risk and without liability or legal exposure to J-U-B ENGINEERS, Inc. and/or B2 Architecture, Inc.

Any seals of the registrants included hereon represent that the drafting of the record drawing information was completed by staff under the registrants' responsible charge.

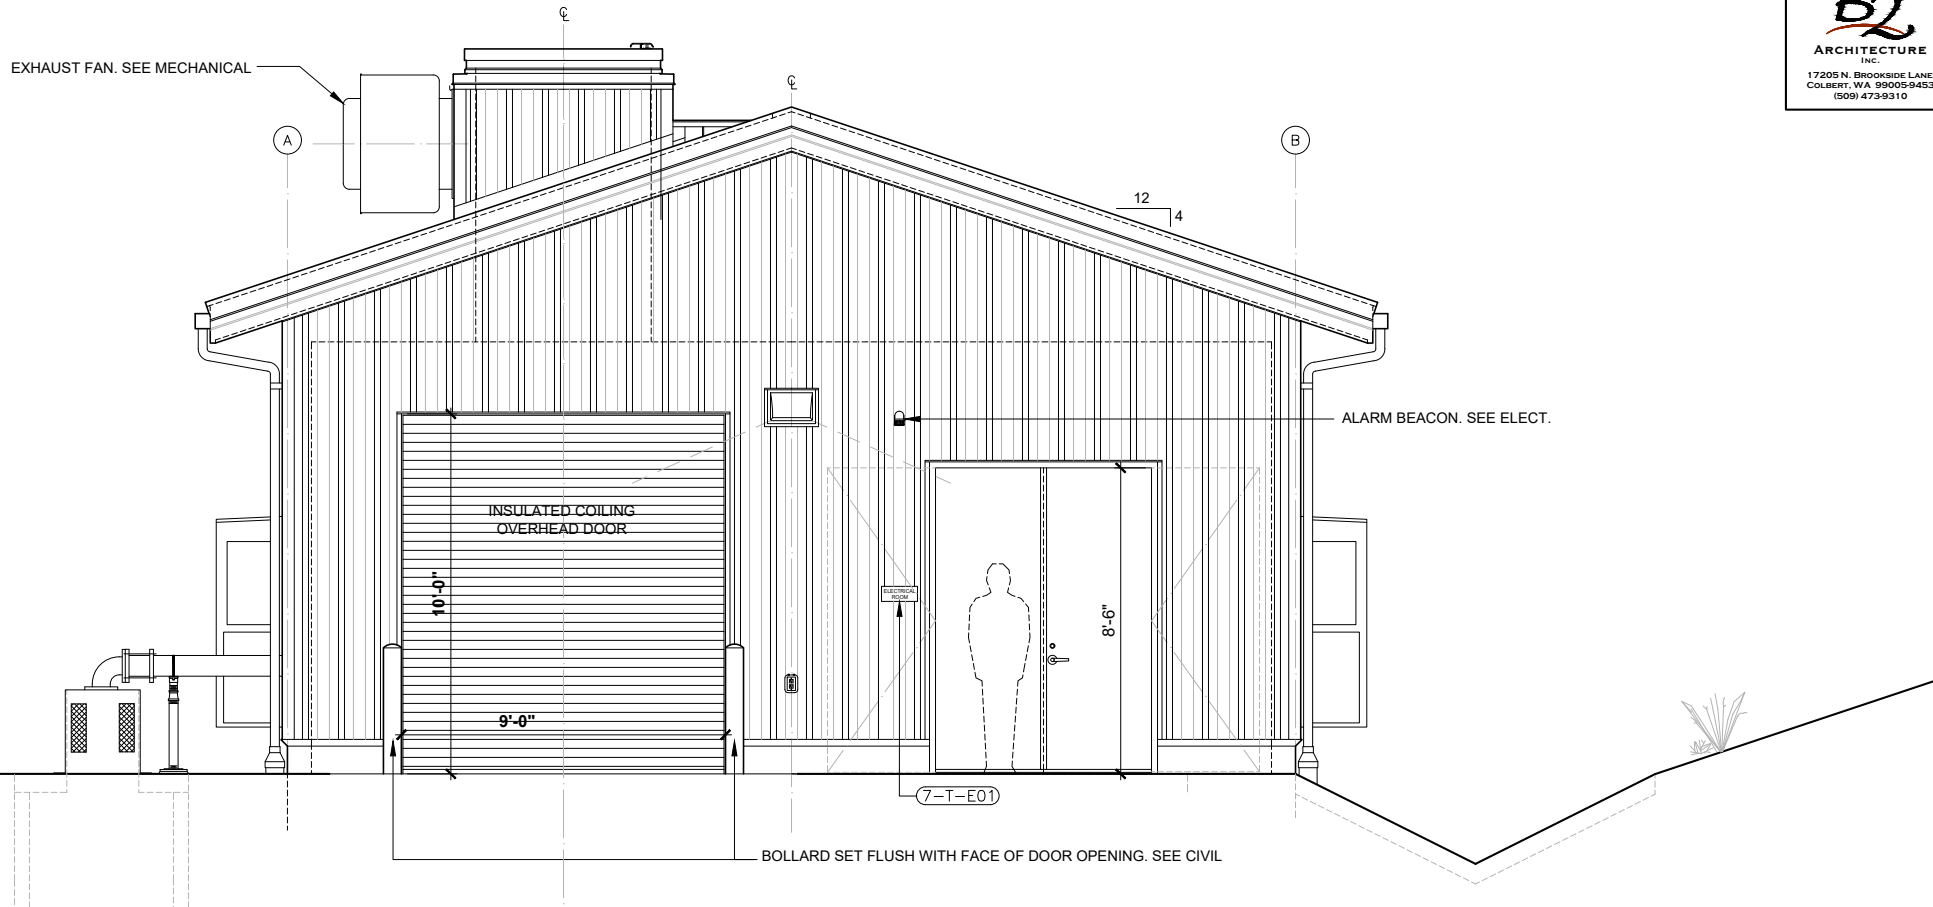

6 | EXTERIOR ELEVATION - SOUTH
SCALE: 3/8" = 1'-0" (3/16" on 11" x 17")

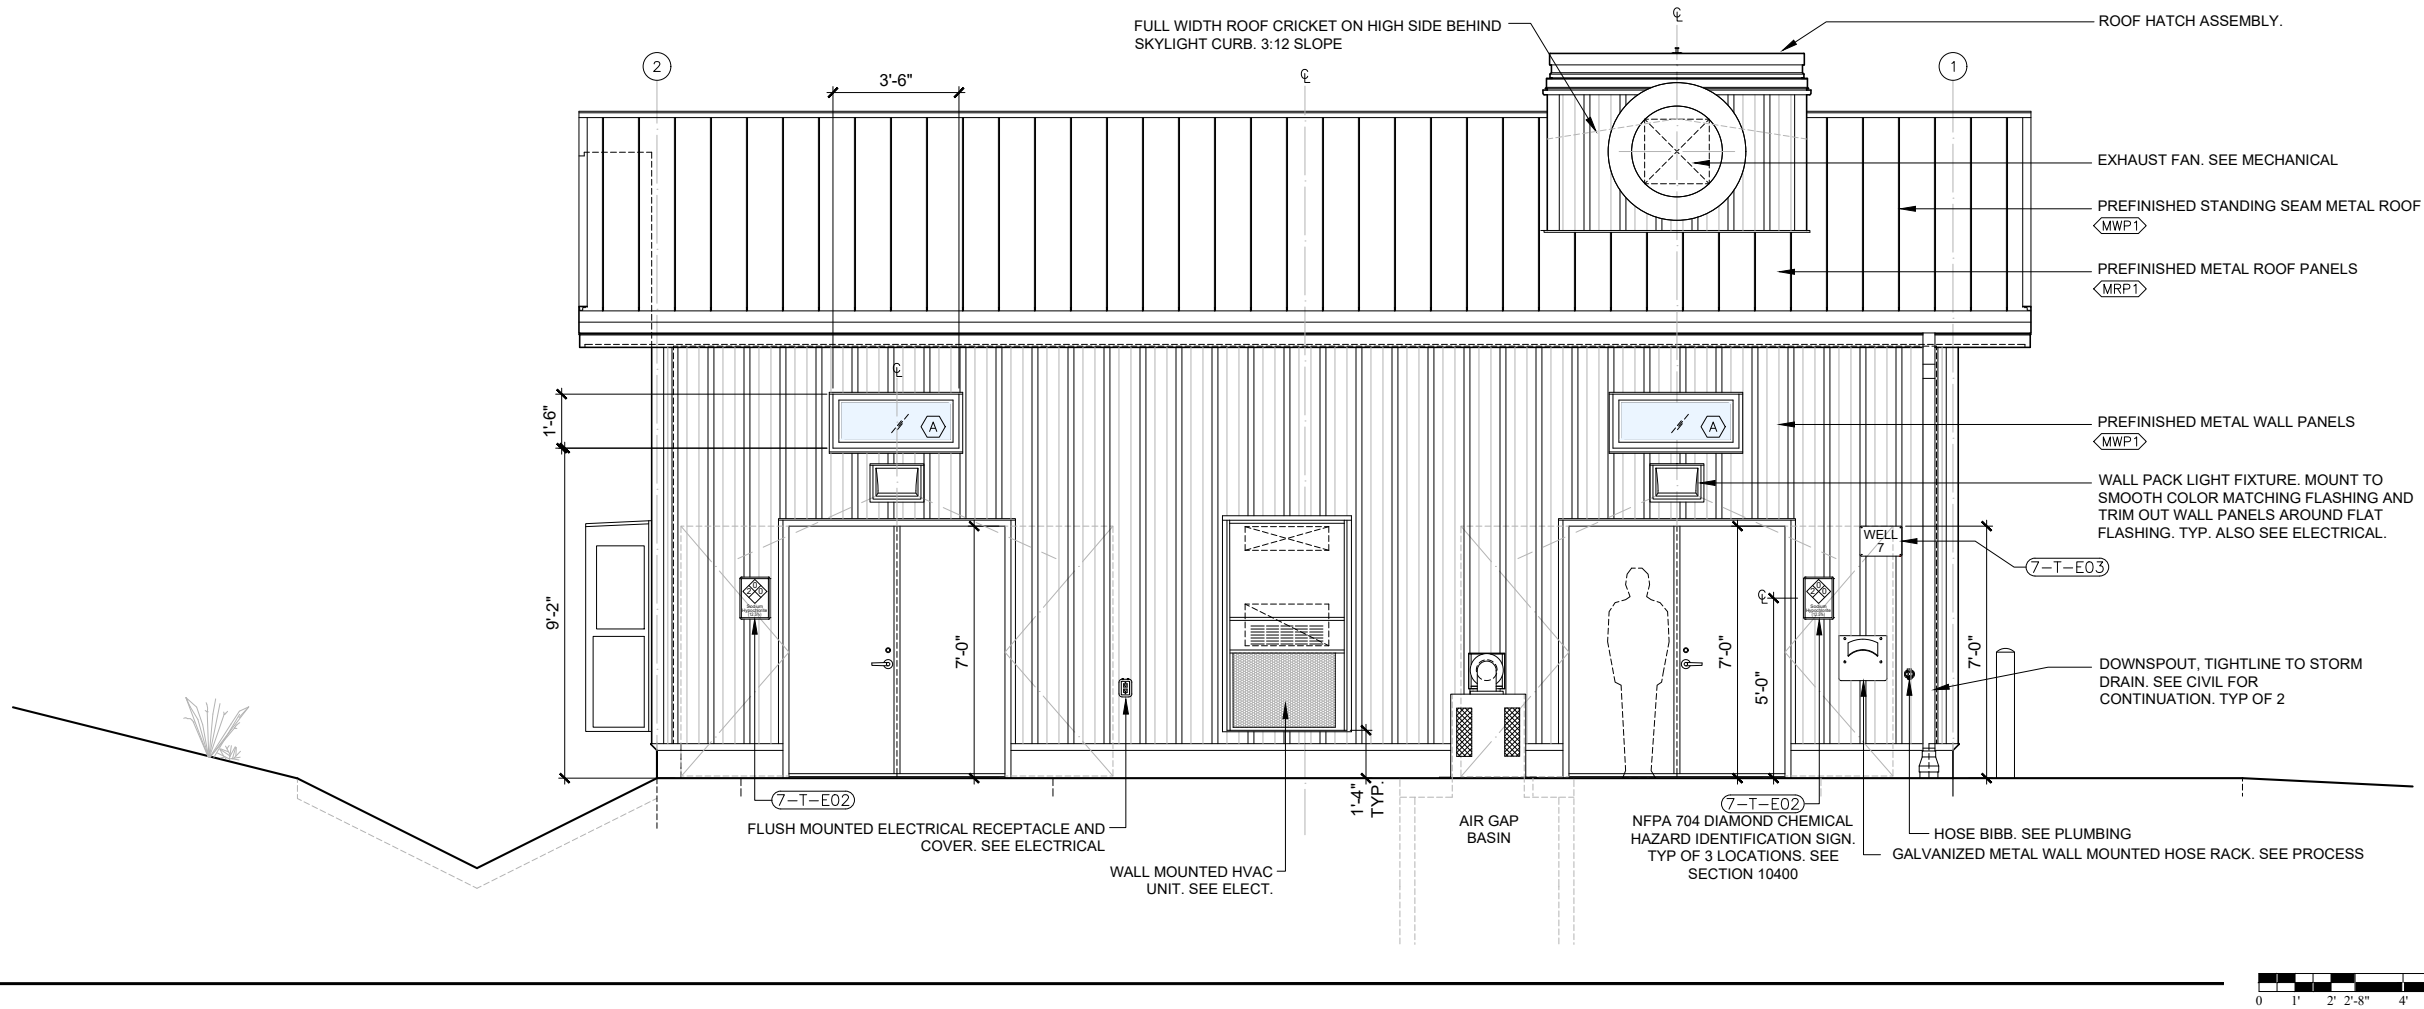

16 | EXTERIOR ELEVATION - WEST
SCALE: 3/8" = 1'-0" (3/16" on 11" x 17")

RECORD

ORIGINAL SIGNED BY:
JAMES E. LEMON
DATE ORIGINAL
SIGNED: 5/24/21
James E. Lemon
STATE OF IDAHO


DRAWINGS

REUSE OF DRAWINGS		REVISION	
THIS DOCUMENT AND THE IDEAS AND DESIGNS INCORPORATED HEREIN ARE THE PROPERTY OF J-U-B ENGINEERS, INC. AND ARE NOT TO BE REPRODUCED OR USED IN WHOLE OR PART FOR ANY OTHER PROJECT WITHOUT THE EXPRESS WRITTEN AUTHORIZATION OF J-U-B ENGINEERS, INC.		NO.	DATE
1	RECORD DRAWINGS	JEL	11-14-22
	DESCRIPTION	BY	DATE

WELL NO. 7
CITY OF LEWISTON
ARCHITECTURAL (A)
WELL NO. 7
SOUTH & WEST EXTERIOR ELEVATIONS

FILE:
JUB PROJ. #: 21-20-007
DRAWN BY: JL
DESIGN BY: JL
CHECKED BY: JL
AT FULL SIZE, IF NOT ONE
INCH, SCALE ACCORDINGLY
LAST UPDATED:
SHEET NUMBER:

A-202R

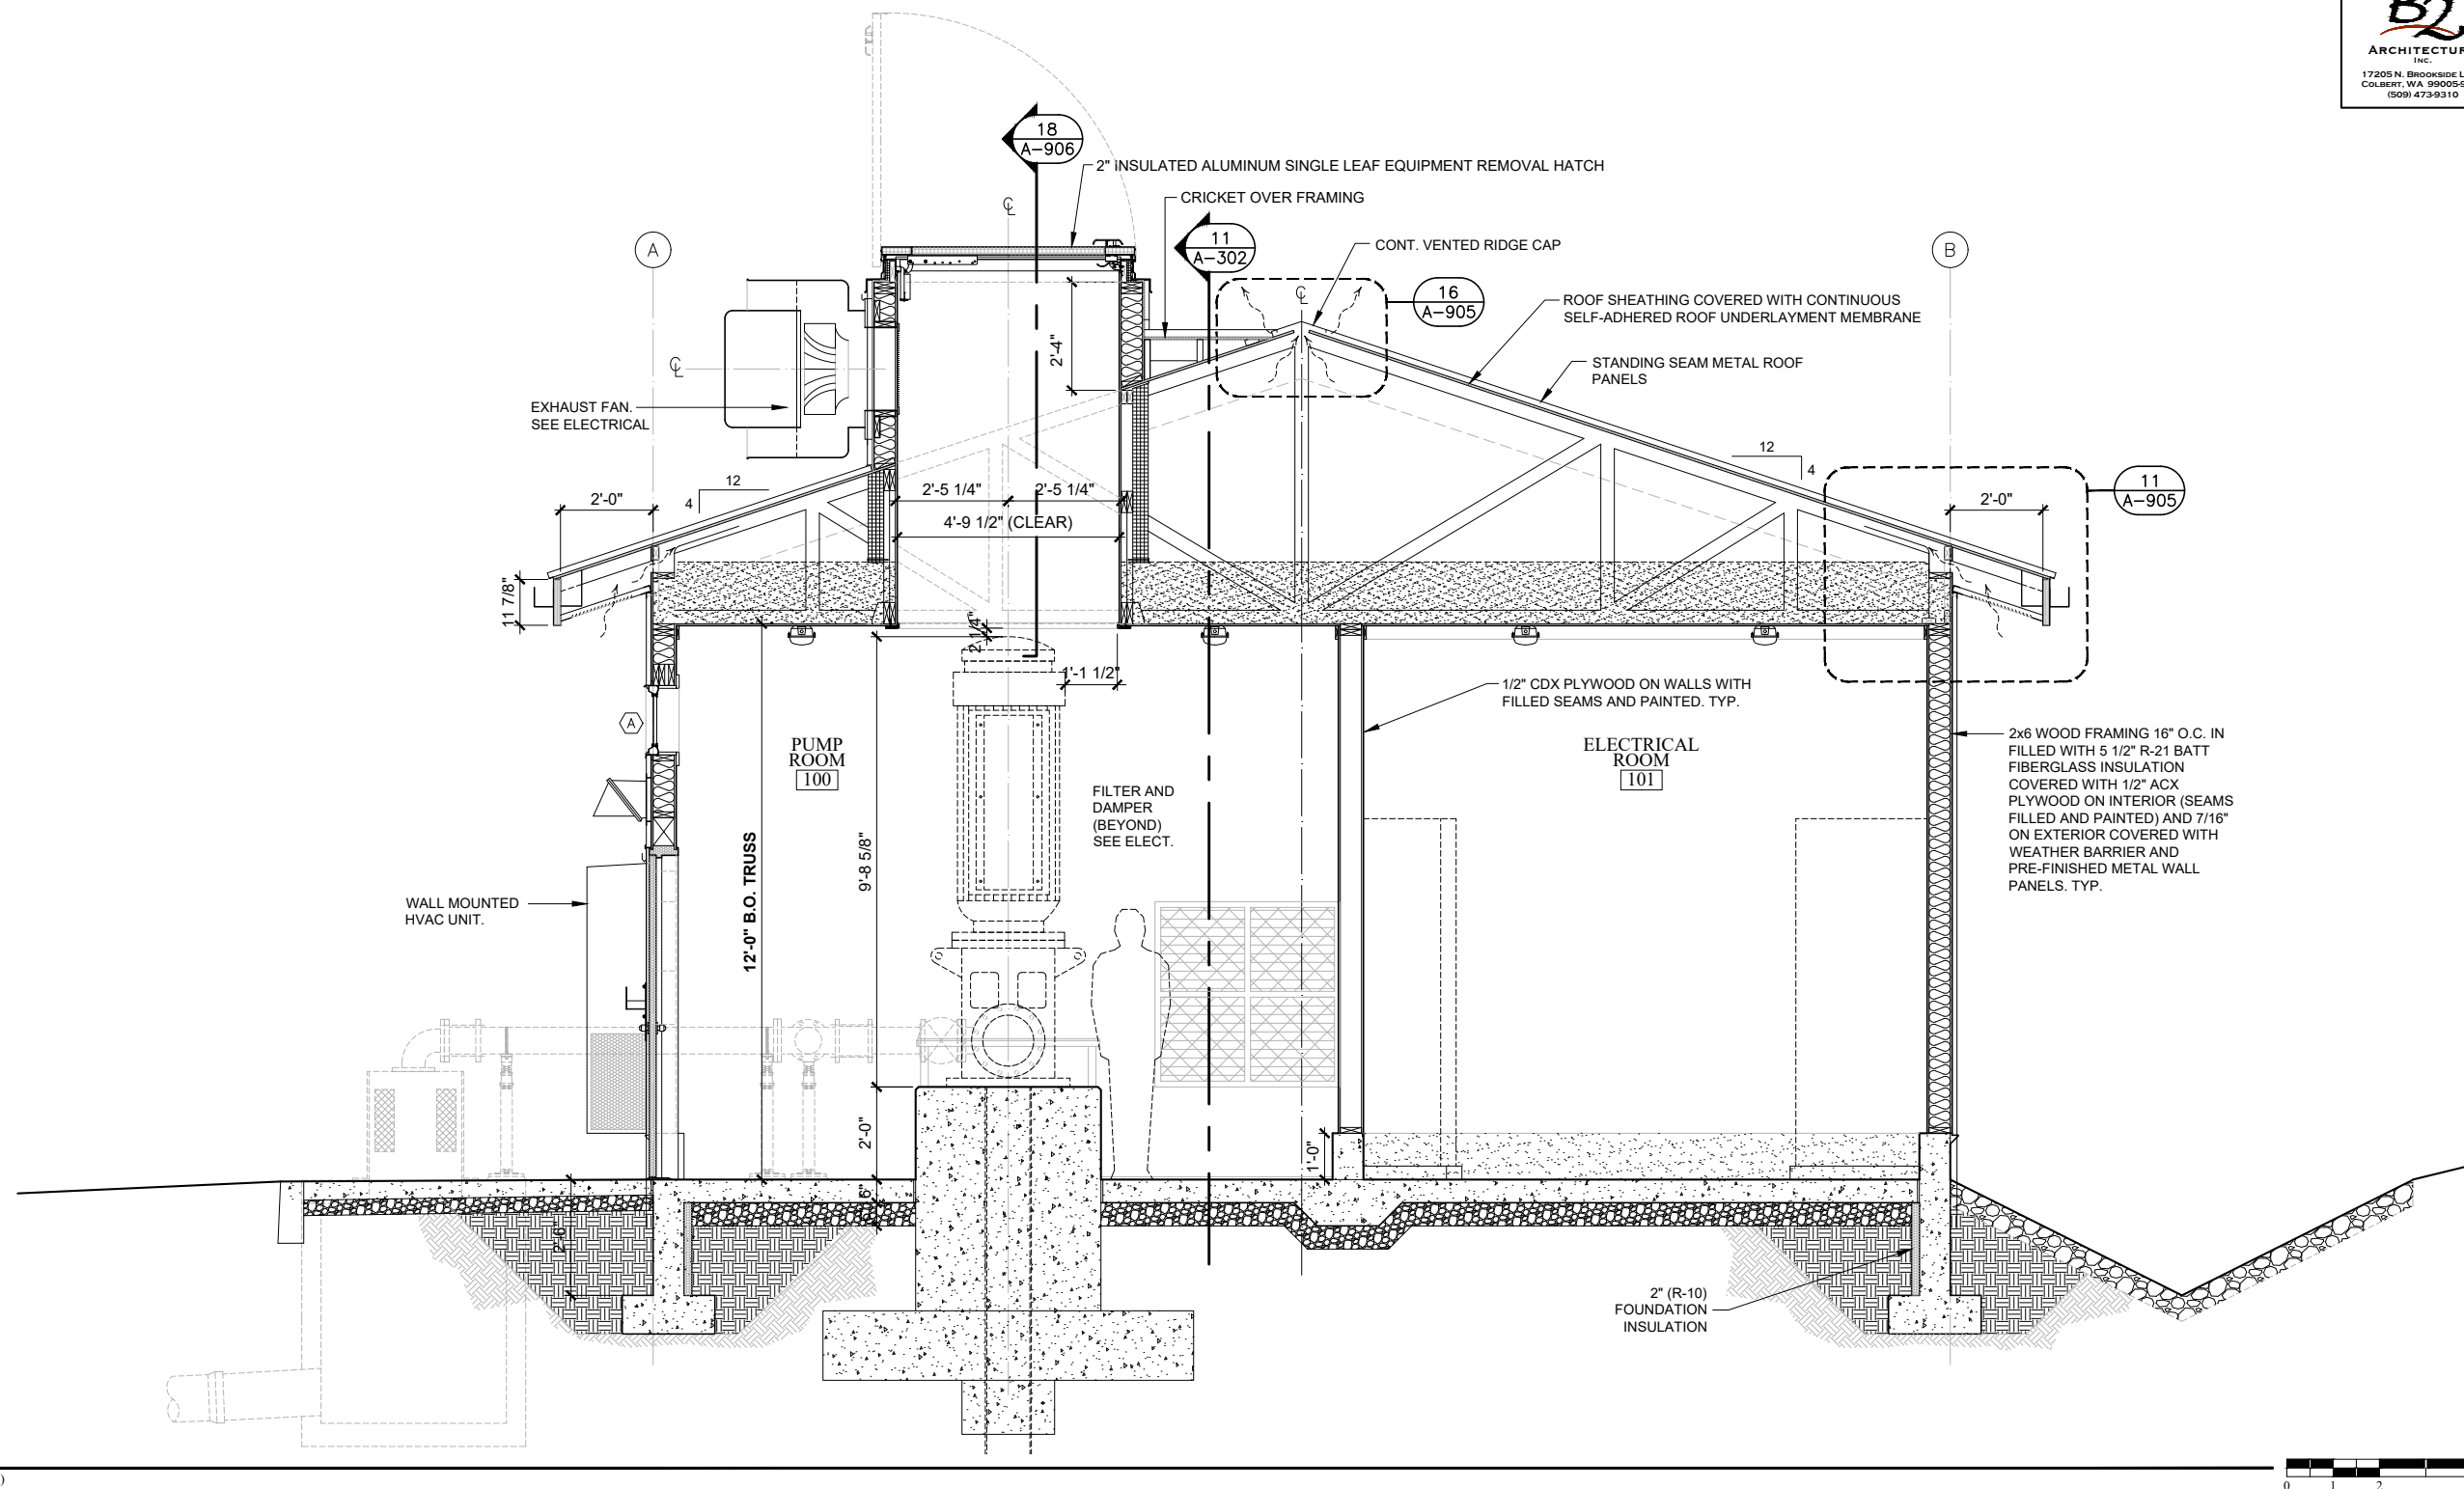

GENERAL NOTES:

1. SEE STRUCTURAL, PROCESS, ELECTRICAL AND MECHANICAL FOR ADDITIONAL INFORMATION AND CONSTRUCTION REQUIREMENTS.
2. SEE SITE CIVIL FOR FINISH ELEVATIONS AROUND EXTERIOR PERIMETER OF BUILDING AND STRUCTURAL FOR INTERIOR ELEVATIONS.
3. DO NOT NOT INSTALL EQUIPMENT, CONDUITS OR PIPING ON WALLS OR CEILING UNTIL ALL COATINGS ARE COMPLETE AND DRY.
4. SEE MANUFACTURER'S PRODUCT AND COLOR SCHEDULE ALONG WITH ROOM AND MISCELLANEOUS ITEM FINISH SCHEDULE ON SHEET A-901 FOR MATERIAL AND COLOR.


RECORD DRAWINGS:

These record drawings have been prepared based on information gathered during field observations as well as information provided by others. The accuracy or completeness of information provided by others has not been verified by J-U-B ENGINEERS, Inc. and/or B2 Architecture, Inc. The Architect shall not be held responsible for the accuracy or completeness of the information provided by the Contractor.

If these record drawings are a public record, J-U-B ENGINEERS, Inc. grants the public entity with jurisdiction the right to copy and disseminate the hard copy or digital image to those who legitimately request the information in writing. Any release, use, or reuse by the public entity, any individual, or organization, shall be at the public entity's, individual's, and/or organization's sole risk and without liability or legal exposure to J-U-B ENGINEERS, Inc. and/or B2 Architecture, Inc.

Any seals of the registrants included hereon represent that the drafting of the record drawing information was completed by staff under the registrants' responsible charge.

Plot Date: 11/14/2022 5:17 PM Plotted By: James Lemon
Date Created: 11/17/2022 C:\DRP\DRP\DRIVE201 CITY OF LEWISTON - WELL 722 DRAWINGS\2D DESIGN\WELL 7 BASE-RECORD SET.DWG

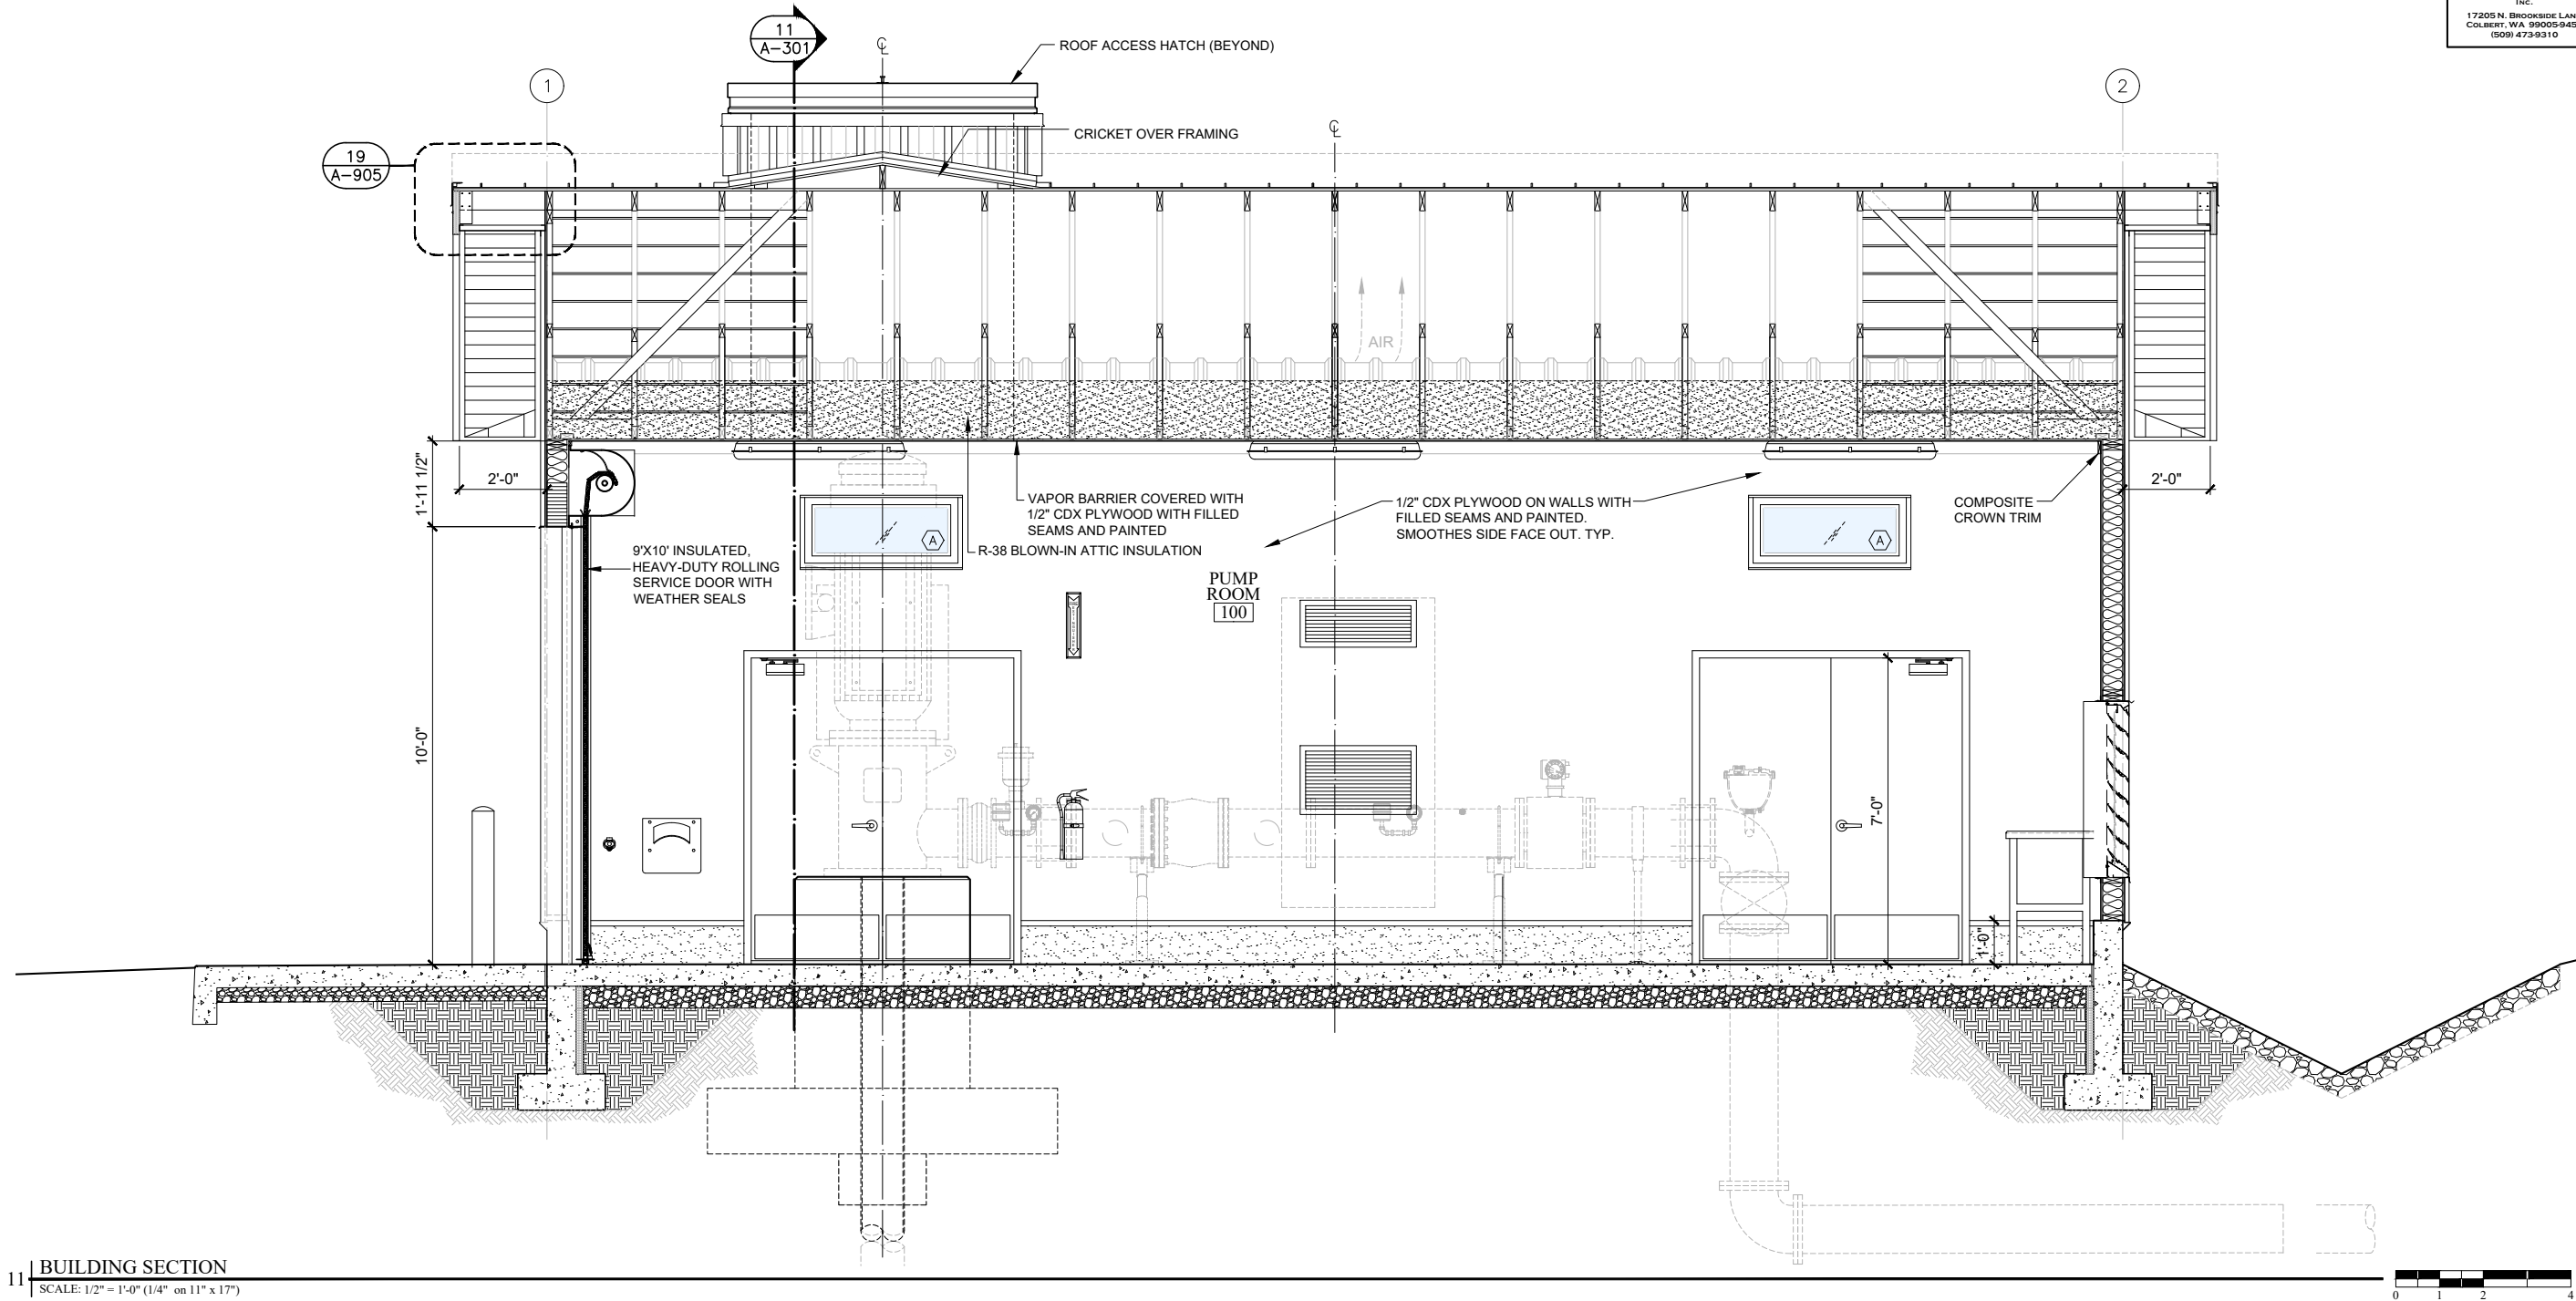

- GENERAL NOTES:**
1. SEE STRUCTURAL, PROCESS, ELECTRICAL AND MECHANICAL FOR ADDITIONAL INFORMATION AND CONSTRUCTION REQUIREMENTS.
 2. SEE SITE CIVIL FOR FINISH ELEVATIONS AROUND EXTERIOR PERIMETER OF BUILDING AND STRUCTURAL FOR INTERIOR ELEVATIONS.
 3. DO NOT NOT INSTALL EQUIPMENT, CONDUITS OR PIPING ON WALLS OR CEILING UNTIL ALL COATINGS ARE COMPLETE AND DRY.
 4. SEE MANUFACTURER'S PRODUCT AND COLOR SCHEDULE ALONG WITH ROOM AND MISCELLANEOUS ITEM FINISH SCHEDULE ON SHEET A-901 FOR MATERIAL AND COLOR.

RECORD DRAWINGS:

These record drawings have been prepared based on information gathered during field observations as well as information provided by others. The accuracy or completeness of information provided by others has not been verified by J-U-B ENGINEERS, Inc. and/or B2 Architecture, Inc. The Architect shall not be held responsible for the accuracy or completeness of the information provided by the Contractor.

If these record drawings are a public record, J-U-B ENGINEERS, Inc. grants the public entity with jurisdiction the right to copy and disseminate the hard copy or digital image to those who legitimately request the information in writing. Any release, use, or reuse by the public entity, any individual, or organization, shall be at the public entity's, individual's, and/or organization's sole risk and without liability or legal exposure to J-U-B ENGINEERS, Inc. and/or B2 Architecture, Inc.

Any seals of the registrants included hereon represent that the drafting of the record drawing information was completed by staff under the registrants' responsible charge.

RECORD
LICENSED ARCHITECT
AR-985283
ORIGINAL SIGNED BY:
JAMES E. LEMON
DATE ORIGINAL
SIGNED: 5/24/21
James E. Lemon
STATE OF IDAHO

DRAWINGS			
REUSE OF DRAWINGS			
THIS DOCUMENT AND THE IDEAS AND DESIGNS INCORPORATED HEREIN ARE THE PROPERTY OF J-U-B ENGINEERS, INC. AND IS NOT TO BE REPRODUCED, COPIED, OR TRANSMITTED IN ANY FORM OR BY ANY MEANS, WITHOUT THE EXPRESS WRITTEN AUTHORIZATION OF J-U-B ENGINEERS, INC.			
REVISION			
NO.	RECORD DRAWINGS	DESCRIPTION	DATE
1	JEL	11-14-22	BY APR

WELL NO. 7
CITY OF LEWISTON
ARCHITECTURAL (A)
WELL NO. 7
BUILDING SECTION

FILE:
JUB PROJ. #: 21-20-007
DRAWN BY: JL
DESIGN BY: JL
CHECKED BY: JL
AT FULL SIZE, IF NOT ONE
INCH, SCALE ACCORDINGLY
LAST UPDATED:
SHEET NUMBER:

A-302R

Plot Date: 11/14/2022 5:16 PM Plotted By: Jamie Lemon
Date Created: 11/1/2022 C:\DRG\PROJ\DRIVE200\ CITY OF LEWISTON - WELL 720 DRAWINGS 2D DESIGN\SCHEMULE-DTL5-RECORD SET.DWG

1. ALL WORK, INCLUDING MATERIALS & WORKMANSHIP SHALL CONFORM TO THE REQUIREMENTS OF LOCAL, STATE, & FEDERAL APPLICABLE CODES, LAWS, AND ORDINANCES INCLUDING THE 2018 I-CODES.
2. THE CONTRACTOR SHALL VERIFY ALL CONDITIONS AND DIMENSIONS AND NOTIFY THE ARCHITECT OF ANY CONDITIONS WHERE THE INTENT OF THE DRAWINGS IS IN DOUBT, OR THERE IS A DISCREPANCY BETWEEN FIELD CONDITIONS AND THE DOCUMENTS.
3. SAFETY OF ALL PARTIES PRESENT ON THE JOB SITE IS THE RESPONSIBILITY OF THE CONTRACTOR.
4. THE USE OF DRAWINGS AND SPECIFICATIONS IS FOR THE PROPOSED SITE ONLY AND THEY ARE THE PROPERTY OF THE ARCHITECT. COPYRIGHT PRIVILEGES ARE MAINTAINED AND NO REPRODUCTION OR REUSE IS ALLOWED WITHOUT PERMISSION.
5. IN THE EVENT OF INCONSISTENCY WITHIN THE DRAWINGS THE MORE COSTLY OR RESTRICTIVE SHALL APPLY.
6. ALL MATERIALS TO BE NEW UNLESS NOTED OTHERWISE.
7. ALL DETAILS, SECTION, NOTES OR REFERENCE TO OTHER DRAWINGS ARE FOR CONVENIENCE AND ARE INTENDED TO BE TYPICAL. THESE REFERENCES SHALL APPLY TO SIMILAR CONDITIONS ELSEWHERE, UNLESS NOTED OTHERWISE.
8. LARGEST SCALE DRAWINGS SHALL GOVERN OVER SMALLER SCALE DRAWINGS.
9. CONTRACTOR SHALL BE RESPONSIBLE FOR ALL ASPECTS OF SAFETY TO ALL PARTIES PRESENT DURING BUILDING CONSTRUCTION AND SHALL PROVIDE ADEQUATE SHORING AND BRACING TO INSURE SUCH SAFETY.
10. DURING CONSTRUCTION, AND PRIOR TO THE INCORPORATION OF ANY CHANGES, REVISIONS, MODIFICATIONS, AND/OR DEVIATIONS FROM THE CONSTRUCTION DOCUMENTS, CONTRACTOR SHALL BRING TO THE ATTENTION OF, AND OBTAIN APPROVAL FROM THE ARCHITECT AND THE GOVERNING BUILDING OFFICIAL BEFORE PROCEEDING WITH THE WORK.
11. ALL MATERIALS LISTED SHALL BE INSTALLED PER MANUFACTURER'S INSTRUCTIONS/SPECIFICATIONS AND APPLICABLE CODE REQUIREMENTS.
12. CONTRACTOR SHALL VERIFY ALL PROJECT MATERIALS/FINISHES/COLORS AND LOCATIONS WITH OWNER/ARCHITECT PRIOR TO PURCHASE/INSTALLATION.
13. PROVIDE OPERATION AND MAINTENANCE DATA MANUALS FOR EQUIPMENT AND MATERIAL SPECIFIED BY THE ARCHITECT.
14. ALL SCHEDULES CONTAINED IN THIS CONSTRUCTION SET OF DRAWINGS ARE PROVIDED FOR THE CONVENIENCE OF THE CONTRACTOR. IT IS THE CONTRACTOR'S RESPONSIBILITY TO VERIFY ALL SUPPLIED INFORMATION AND ACTUAL CONDITIONS PRIOR TO ORDERS, FABRICATION OR INSTALLATION AS REQUIRED TO COMPLETE THE PROJECT.
15. VERIFY ALL WALL OPENING DIMENSIONS WITH APPROVED PIPING, MECHANICAL AND PLUMBING SUBMITTALS.
16. SEE ENERGY CONSERVATION CODE NOTES FOR ADDITIONAL REQUIRED CONSTRUCTION MEANS AND METHODS.

6

GENERAL ARCHITECTURAL NOTES

SCALE: NTS

MATL. WELL #3	PRODUCT DESCRIPTION	MANUFACTURE'S NAME	STYLE									
			NAME	NUMBER								
CS1	CONCRETE SEALER (FLOORS)	SEE SPECS	SEE SPECS	-	CLEAR	-		N/A				CS1
CT1	COMPOSITE TRIM	SEE SPECS	SEE SPECS	-	PT2	-		N/A				CT1
FRP1	FIBERGLASS REINFORCED WALL PANELS	SEE SPECS	SEE SPECS	-	WHITE	-		N/A	FULLY ADHERED, NOT EXPOSED FASTENERS, EDGE AND JOINT MOLDING TO MATCH FRP PANEL COLOR, @ SINK AREA			FRP1
MF1	PREFINISHED METAL FLASHING	SEE SPECS	SEE SPECS & DWGS	-	EXTERIOR COLOR MATCH MRP1	-		N/A	FASCIA"J" METAL, MISC FLASHING, INTERIOR FLASHING TO MATCH INTERIOR WALL COLOR			MF1
MRP1	METAL ROOF PANELS	MATAL SALES	VERTICAL SEAM	24 GAUGE	MEDIUM BRONZE	H4	1 3/4" RIB x 16" WIDE	SEE ROOF DETAILS FOR ADDITIONAL REQUIREMENTS. FIELD VERIFY COLOR SPECIFIED MATCHED WELL #5 ROOF/TRIM COLOR				MRP1
MSP1	PREFINISHED METAL SOFFIT PANELS	METAL SALES	SOFFIT PANEL LANCED	24 GA, V-GROOVE	MEDIUM BRONZE	H4	1" DEEP x 12" WIDE	24-GA, V-GROOVE, HALF VENT PERFORATED PANELS FOR VENTILATION				MSP1
MWP1	PREFINISHED METAL WALL PANELS	METAL SALES	PBR	24 GAUGE	PARCHMENT	W74	1 1/4" x 36" WIDE					MWP1
PT1	PAINT	SHERWIN-WILLIAMS	SEE SPECS	-	COLOR MATCH VINYL WIN. FRAME	CUSTOM MATCH	N/A	METAL DOORS, METAL DOOR FRAMES. SEE 09910 FOR COATING SYSTEM TO USE BASED ON BASE MATERIAL, COLOR MATCH VINYL WINDOW FRAME COLOR				PT1
PT2	PAINT	SHERWIN-WILLIAMS	SEE SPECS	-	WHITE	-	N/A	INTERIOR WALLS, CEILING, CROWN TRIM				PT2

- GENERAL NOTES:
1. FOR MATERIALS THAT DO NOT HAVE A COATING SYSTEM IDENTIFIED IN THE ROOM FINISH SCHEDULE OR ELSEWHERE, REFER TO APPLICABLE COATING SYSTEM IDENTIFIED IN SECTION 09910 - ARCHITECTURAL PAINT AND COATINGS.
2. COLOR AND FINISH SAMPLES SUBMITTED ELECTRONICALLY, SUCH AS PHOTOS, SCANS, ETC. WILL NOT BE ACCEPTED. SAMPLES MUST BE SUBMITTED IN HARD COPY FORMAT TO ARCHITECT AND 2ND SAMPLE TO OWNER FOR REVIEW AND APPROVAL.
3. SECTION 09910: COATING SYSTEM (PREP, PRIMER AND FINAL) DEPENDENT ON BASE MATERIAL. LOOK UP BASE MATERIAL IN SECTION 09910.2.04 AND 2.05 FOR COATING (NOT COLOR) SYSTEMS TO USE. COLOR PER ROOM AND ABOVE COLOR SCHEDULE.
4. ALL EXTERIOR COLOR LOCATIONS TO MATCH LOID WELL #5. SEE EXISTING WELL #5 PHOTO SHOWN ON SHEET A-201.

11

MANUFACTURER'S PRODUCT AND COLOR SCHEDULE

SCALE: NTS

ROOM FINISH SCHEDULE

ROOM NO.		FLOOR	BASE	WALL SUBSTRATE				WALL FINISH				WALL COATING SYSTEM (SEE 09910)	CEILING			CEILING COATING SYSTEM	REMARKS
				NORTH	EAST	SOUTH	WEST	NORTH	EAST	SOUTH	WEST		MATERIAL	FINISH	HEIGHT		
100	ELECTRICAL ROOM	SEALED CONC.	CONC.	PLYWOOD	PLYWOOD	PLYWOOD	PLYWOOD	PT2	PT2	PT2	PT2	INT-PLY-1	PLYWOOD	PT2	14'-0"	PRODUCT SPECS	PAINT PLYWOOD WALLS DOWN TO T.O. CONC. STEM WALL. DO NOT PAINT WALL BASE FLASHING
101	PUMP ROOM	SEALED CONC.	CONC.	PLYWOOD	PLYWOOD	PLYWOOD	PLYWOOD	PT2	PT2	PT2	PT2	INT-PLY-1	PLYWOOD	PT2	14'-0"	PRODUCT SPECS	PAINT PLYWOOD WALLS DOWN TO T.O. CONC. STEM WALL. DO NOT PAINT WALL BASE FLASHING

- GENERAL NOTES:
1. SCHEDULES ARE PROVIDED FOR THE CONVENIENCE OF THE CONTRACTOR. IT IS THE CONTRACTOR'S RESPONSIBILITY TO DETERMINE FROM PLANS, SECTIONS, ISOMETRICS, DETAILS AND SPECIFICATIONS, THE REQUIRED QUANTITY AND QUALITY OF EQUIPMENT AND MATERIALS TO COMPLETE THE PROJECT.
2. DO NOT SURFACE MOUNT ANY EQUIPMENT, CONDUITS OR PIPING ON WALLS OR CEILING UNTIL ALL COATINGS ARE COMPLETE AND DRY.
3. DO NOT INSTALL DOOR HARDWARE, UNTIL ALL DOOR FRAME AND DOOR LEAFS ARE COMPLETE AND DRY (NO MASKING ALLOWED).
4. INSTALL 1/2" CDX INTERIOR PLYWOOD SHEATHING WITH BEST SIDE FACING TOWARD INTERIOR (EXPOSED) ROOM SIDE. SEAL ALL SEAMS & FASTENER HOLES PRIOR TO PRIMING AND PAINTING. SEE SECTION 07920, TYPE 4 FOR JOINT AND HOLE FILLER/SEALANT.


MISCELLANEOUS ITEMS FINISH SCHEDULE

	FINISH	COATING SYSTEM (09910)	MANUFACTURER'S NAME	REMARKS
METAL DOORS - INTERIOR FACE	PT1	INT-S-1	SEE SPECIFICATIONS	
METAL DOORS - EXTERIOR FACE	PT1	EXT-S-1	SEE SPECIFICATIONS	
COILING OVERHEAD DOOR (EXTERIOR)	MFR (MATCH VINYL WINDOW FRAME)	MFR	SEE SPECIFICATIONS	EXTERIOR FINISH TO COLOR MATCH VINYL WINDOW COLOR
VINYL WINDOWS (MILGARD - VINYL)	MFR (SAND)	MFR	SEE SPECIFICATIONS	
EXTERIOR FACE OF ALL LOUVERS	MFR (COLOR TO MATCH MRP1)	MFR		
COMPOSITE INTERIOR CROWN TRIM	PT2	INT-T-1	SEE SPECIFICATIONS	
PREFINISHED GUTTERS	MFR (COLOR TO MATCH ROOF PANELS)	MFR	SEE SPECIFICATIONS	
PREFINISHED DOWNSPOUTS	MFR (COLOR TO MATCH WALL PANELS)	MFR	SEE SPECIFICATIONS	

16

ROOM AND MISCELLANEOUS ITEM FINISH SCHEDULE


SCALE: NTS

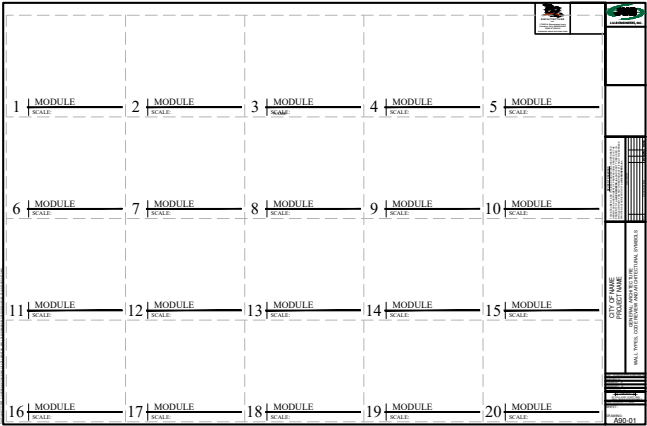

3

ARCHITECTURAL DRAWING LAYOUT SYSTEM

SCALE: NTS

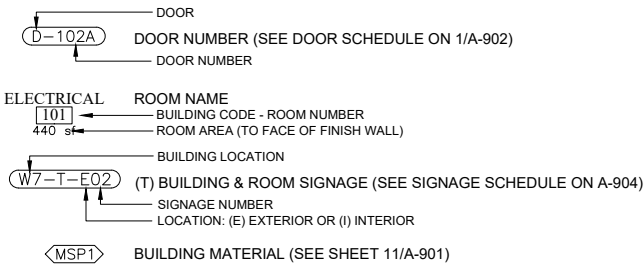

SEE OTHER DISCIPLINES SHEETS FOR
ADDITIONAL LEGENDS & ABBREVIATIONS

4

ARCHITECTURAL SYMBOLS & ABBREVIATIONS LEGEND

SCALE: NTS

RECORD DRAWINGS:

These record drawings have been prepared based on information gathered during field observations as well as information provided by others. The accuracy or completeness of information provided by others has not been verified by J-U-B ENGINEERS, Inc. and/or B2 Architecture, Inc. The Architect shall not be held responsible for the accuracy or completeness of the information provided by the Contractor.

If these record drawings are a public record, J-U-B ENGINEERS, Inc. grants the public entity with jurisdiction the right to copy and disseminate the hard copy or digital image to those who legitimately request the information in writing. Any release, use, or reuse by the public entity, any individual, or organization, shall be at the public entity's, individual's, and/or organization's sole risk and without liability or legal exposure to J-U-B ENGINEERS, Inc. and/or B2 Architecture, Inc.

Any seals of the registrants included hereon represent that the drafting of the record drawing information was completed by staff under the registrants' responsible charge.

RECORD

ORIGINAL SIGNED BY:
JAMES E. LEMON
DATE ORIGINAL
SIGNED: 5/24/21
James E. Lemon
STATE OF IDAHO

DRAWINGS

NO.	RECORD DRAWINGS	DESCRIPTION	BY	DATE
1	RECORD DRAWINGS	DESCRIPTION	JEL	11-14-22

WELL NO. 7
CITY OF LEWISTON
ARCHITECTURAL (A)
GENERAL NOTES, MANF. PRODUCT
& COLOR SCHEDULE, ROOM & MISC. SCHEDULE

FILE:
JUB PROJ. #: 21-20-007
DRAWN BY: JL
DESIGN BY: JL
CHECKED BY: JL
ONE INCH
AT FULL SIZE, IF NOT ONE
INCH, SCALE ACCORDINGLY
LAST UPDATED:
SHEET NUMBER:

A-901R


LOC'N CODE	DOOR NO.	DOOR							FRAME					FIRE RATING	DETAILS			HARDWARE GROUP	NOTES
		WIDTH	HEIGHT	THICKNESS	MATL.	GLAZING	FINISH	TYPE	DEPTH	MATL.	FINISH	SEAL	TYPE		HEAD	JAMB	THRESHOLD		
W7	100A	PR 3'-0"	7'-0"	1-3/4"	Metal	No	PT1	A	7 1/2"	Metal	PT1	Weather	2	N/A	14/A-902	11 & 12/A-902	6/A-903	HW-03	INSULATED COILING METAL DOOR, ELECTRIC OPERATOR WITH BACKUP MANUAL CHAIN OPERATION
W7	100B	PR 3'-0"	7'-0"	1-3/4"	Metal	No	PT1	A	7 1/2"	Metal	PT1	Weather	2	N/A	14/A-902	11 & 12/A-902	6/A-903	HW-03	
W7	100C	9'-0" CLR	10'-0" CLR	3/4"	Metal	N/A	MFR	C	MFR	Metal	MFR	Weather	N/A	N/A	14/A-902	11 & 12/A-902	6/A-903	HW-04	
W7	101A	PR 3'-0"	8'-6"	1-3/4"	Metal	No	PT1	A	7 1/2"	Metal	PT1	Weather	2	N/A	14/A-902	11 & 12/A-902	6/A-903	HW-01	
W7	101B	3'-0"	7'-0"	1-3/4"	Metal	GL-1	PT1	B	7 1/2"	Metal	PT1	Sound	1	N/A	14/A-902 Sim	11 & 12/A-902	No Threshold	HW-02	



17205 N. BROOKSIDE LANE
COLBERT, WA 99005-0455
(509) 473-9310

1 DOOR AND FRAME SCHEDULE

- NOTES:
- DOOR ELEVATIONS ARE SCHEMATIC IN NATURE. THE CONTRACTOR TO PROVIDE EQUIPMENT AND MATERIALS TO MEET ALL SPECIFICATION REQUIREMENTS.
 - PREPARE, PRIME AND PAINT ALL WOOD BLOCKING PRIOR TO OVERHEAD DOOR INSTALLATION.


LEGEND:

 TEMPERED SAFETY GLAZING AS REQUIRED PER 2018 IBC, CHAPTER 24 AND/OR REQUESTED BY OWNER.

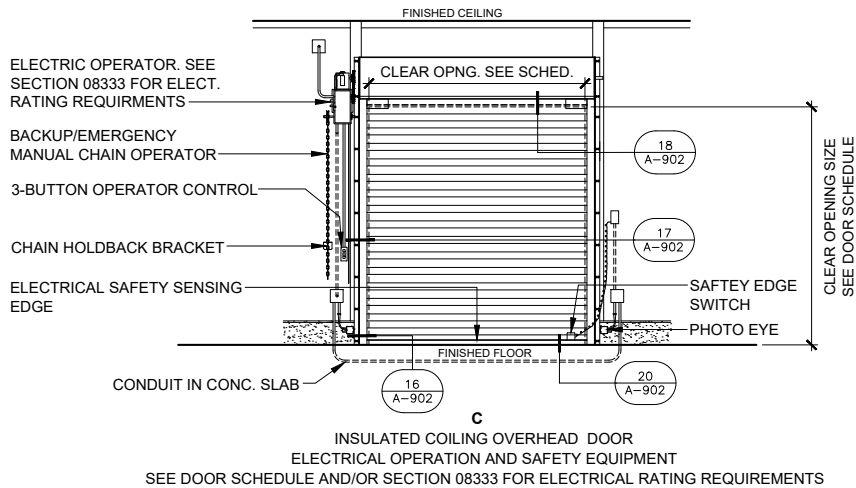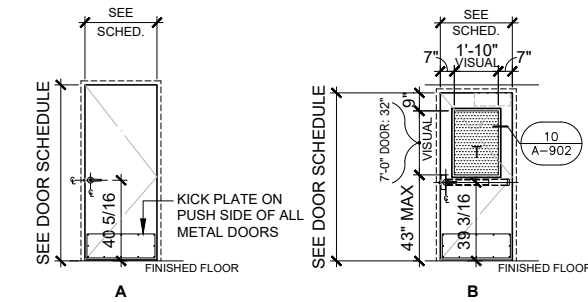


6 DOOR TYPES

SCALE: 1/4" = 1'-0" (1/8" on 11" x 17")

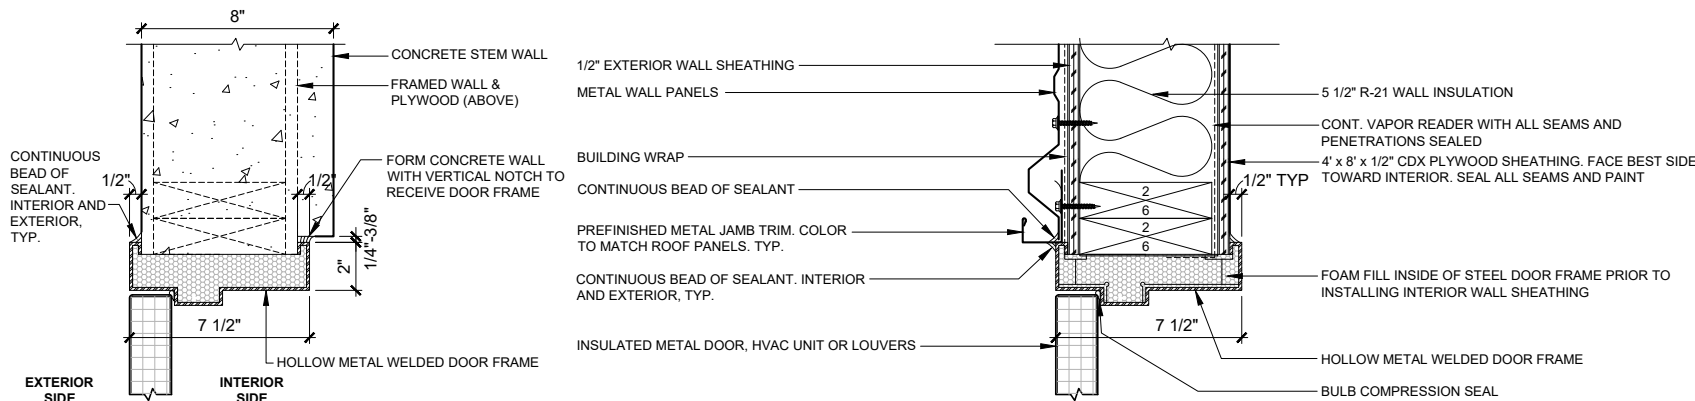

11 DOOR JAMB @ CONCRETE STEM WALL

SCALE: 3" = 1'-0" (1 1/2" = 1'-0" on 11" x 17")

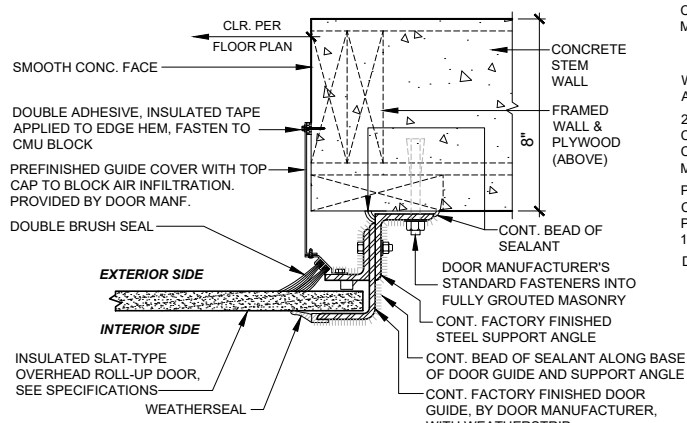


16 OVERHEAD DOOR - JAMB

SCALE: 3" = 1'-0" (1 1/2" = 1'-0" on 11" x 17")

12 DOOR JAMB @ FRAMED WALL

SCALE: 3" = 1'-0" (1 1/2" = 1'-0" on 11" x 17")

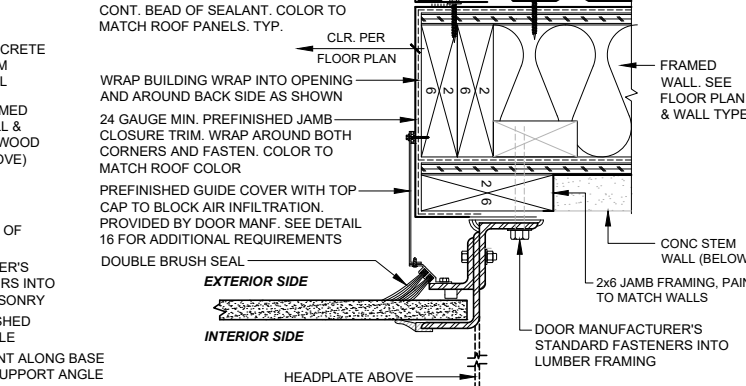


17 OVERHEAD DOOR - JAMB

SCALE: 3" = 1'-0" (1 1/2" = 1'-0" on 11" x 17")


9 FRAME TYPES

SCALE: 1/4" = 1'-0" (1/8" on 11" x 17")

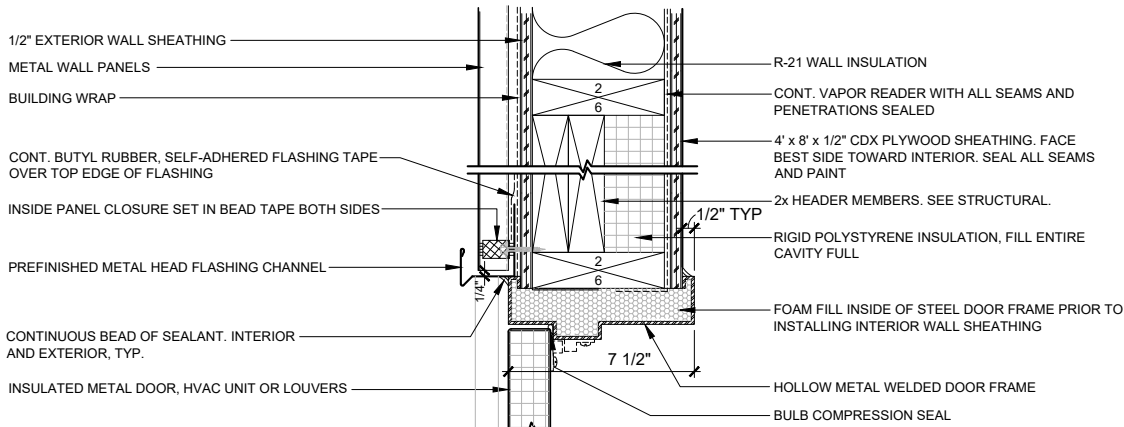

14 DOOR HEAD

SCALE: 3" = 1'-0" (1 1/2" = 1'-0" on 11" x 17")

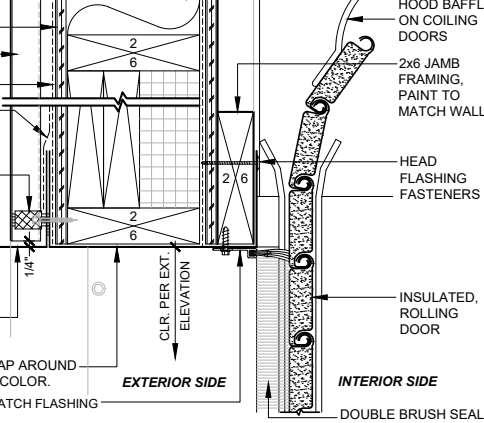

18 OVERHEAD DOOR - HEAD


SCALE: 3" = 1'-0" (1 1/2" = 1'-0" on 11" x 17")

RECORD DRAWINGS:

These record drawings have been prepared based on information gathered during field observations as well as information provided by others. The accuracy or completeness of information provided by others has not been verified by J-U-B ENGINEERS, Inc. and/or B2 Architecture, Inc. The Architect shall not be held responsible for the accuracy or completeness of the information provided by the Contractor.

If these record drawings are a public record, J-U-B ENGINEERS, Inc. grants the public entity with jurisdiction the right to copy and disseminate the hard copy or digital image to those who legitimately request the information in writing. Any release, use, or reuse by the public entity, any individual, or organization, shall be at the public entity's, individual's, and/or organization's sole risk and without liability or legal exposure to J-U-B ENGINEERS, Inc. and/or B2 Architecture, Inc.

Any seals of the registrants included hereon represent that the drafting of the record drawing information was completed by staff under the registrants' responsible charge.

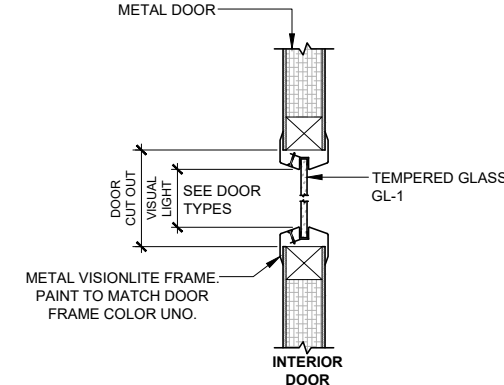

10 METAL VISION LITE FRAME

SCALE: 3" = 1'-0" (1 1/2" = 1'-0" on 11" x 17")

16 OVERHEAD DOOR - JAMB

SCALE: 3" = 1'-0" (1 1/2" = 1'-0" on 11" x 17")

17 OVERHEAD DOOR - JAMB

SCALE: 3" = 1'-0" (1 1/2" = 1'-0" on 11" x 17")

18 OVERHEAD DOOR - HEAD

SCALE: 3" = 1'-0" (1 1/2" = 1'-0" on 11" x 17")

20 SECTIONAL DOOR THRESHOLD

SCALE: 3" = 1'-0" (1 1/2" = 1'-0" on 11" x 17")

RECORD

ORIGINAL SIGNED BY:
JAMES E. LEMON
DATE ORIGINAL
SIGNED: 5/24/21

James E. Lemon
STATE OF IDAHO

DRAWINGS


NO.	REVISION	DESCRIPTION	DATE
1		RECORD DRAWINGS	JUL/JUL 11/14/22

WELL NO. 7
CITY OF LEWISTON
ARCHITECTURAL (A)
DOOR SCHEDULE & DETAILS

FILE: SCHEDULE-DTLS-RECORD SET
JUB PROJ. #: 21-20-07
DRAWN BY: JL
DESIGN BY: JL
CHECKED BY: JL
AT FULL SIZE, IF NOT ONE
INCH, SCALE ACCORDINGLY
LAST UPDATED: 4/24/2018
SHEET NUMBER:


A-902R

Plot Date: 11/14/2022 5:19 PM Plotted By: James Lemon
Date Created: 11/17/2022 C:\00\PROJECTS\DRIVE201 CITY OF LEWISTON - WELL 722 DRAWINGS\2D DESIGN\SCHEDULE-DTL-S-RECORD SET.DWG

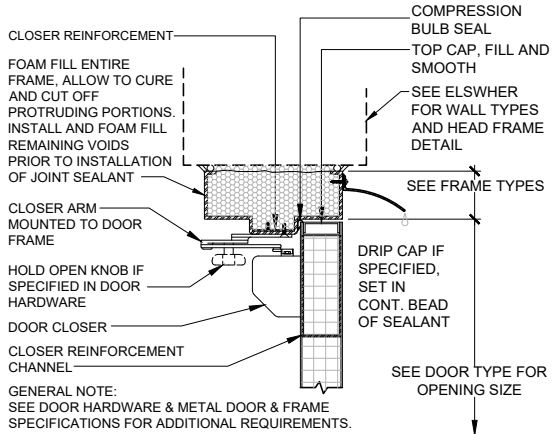

a DOOR HARDWARE - HEAD


SCALE: 3" = 1'-0" (1 1/2" = 1'-0" on 11" x 17")

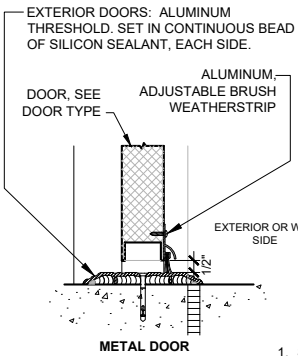

1. SEE DOOR HARDWARE SCHEDULE FOR ADDITIONAL REQUIREMENTS

6 DOOR BOTTOM SWEEP & THRESHOLD


SCALE: 3" = 1'-0" (1 1/2" = 1'-0" on 11" x 17")

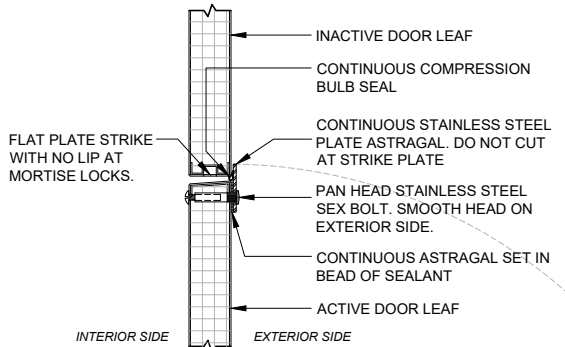

GENERAL NOTE: SEE DOOR HARDWARE & METAL DOOR & FRAME SPECIFICATIONS FOR ADDITIONAL REQUIREMENTS.


11 DOOR ASTRAGAL

SCALE: 3" = 1'-0" (1 1/2" = 1'-0" on 11" x 17")

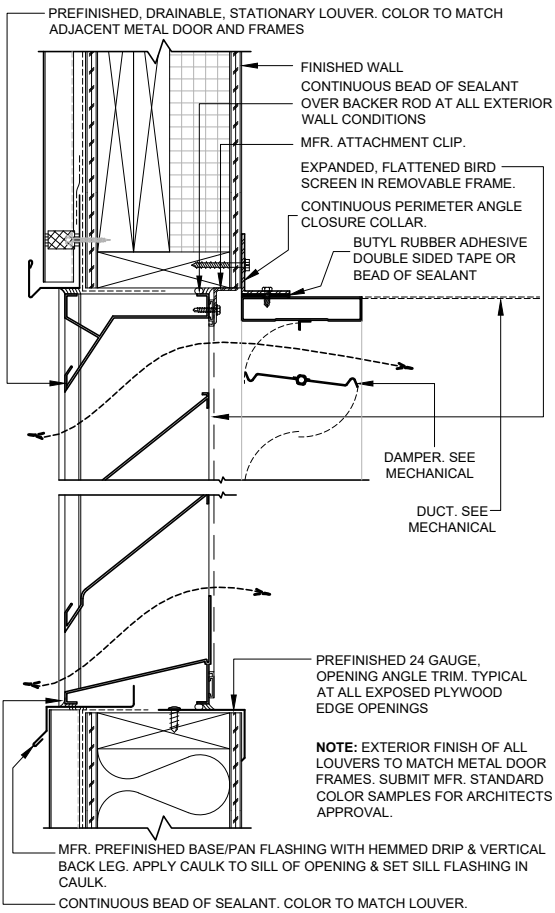


17 LOUVER DETAIL

SCALE: 3" = 1'-0" (1 1/2" = 1'-0" on 11" x 17")

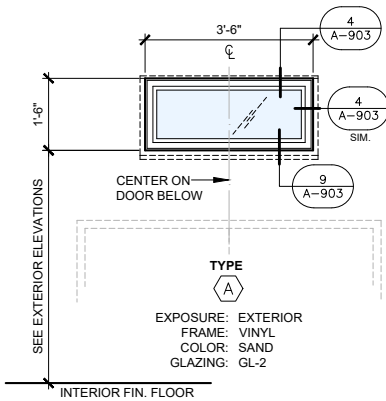


11 WINDOW TYPES (EXTERIOR VIEW)

SCALE: 1/2" = 1'-0" (1/4" = 1'-0" on 11" x 17")

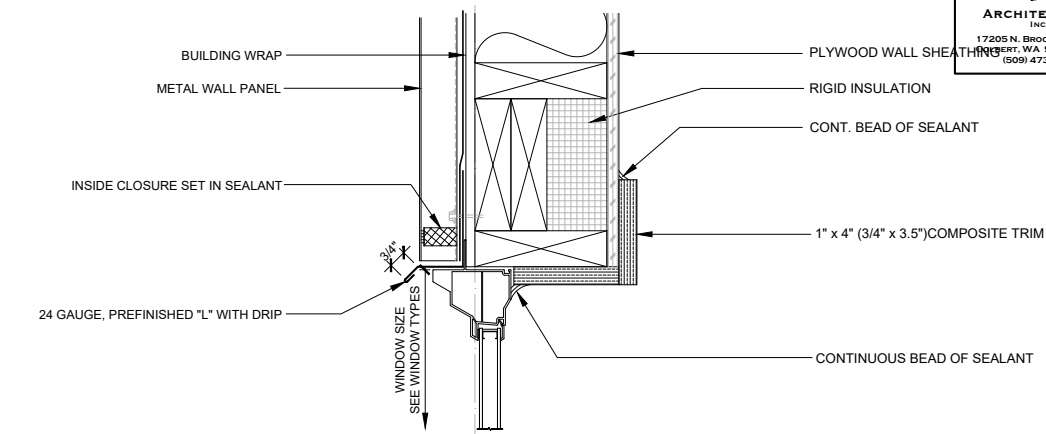

4 VINYL WINDOW - HEAD IN WOOD WALL (JAMB SIM.)


SCALE: 3" = 1'-0" (1 1/2" = 1'-0" on 11" x 17")

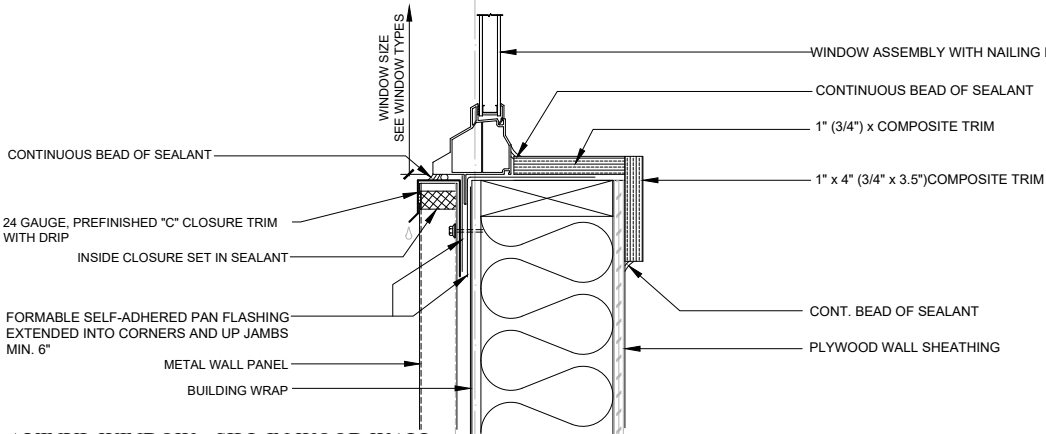

9 VINYL WINDOW - SILL IN WOOD WALL

SCALE: 3" = 1'-0" (1 1/2" = 1'-0" on 11" x 17")

- GENERAL NOTES:
- ATTIC ACCESS OPENING SHALL BE PROVIDED TO ANY ATTIC AREA HAVING A CLEAR HEIGHT OF OVER 30 INCHES.
 - HEADROOM CLEARANCE SHALL NOT BE LESS THAN 30 INCHES OVER TOP EDGE OF INSULATION DAM.
 - PROVIDE ACCESS OPENING ON EACH SIDE OF ATTIC DRAFT WALL.

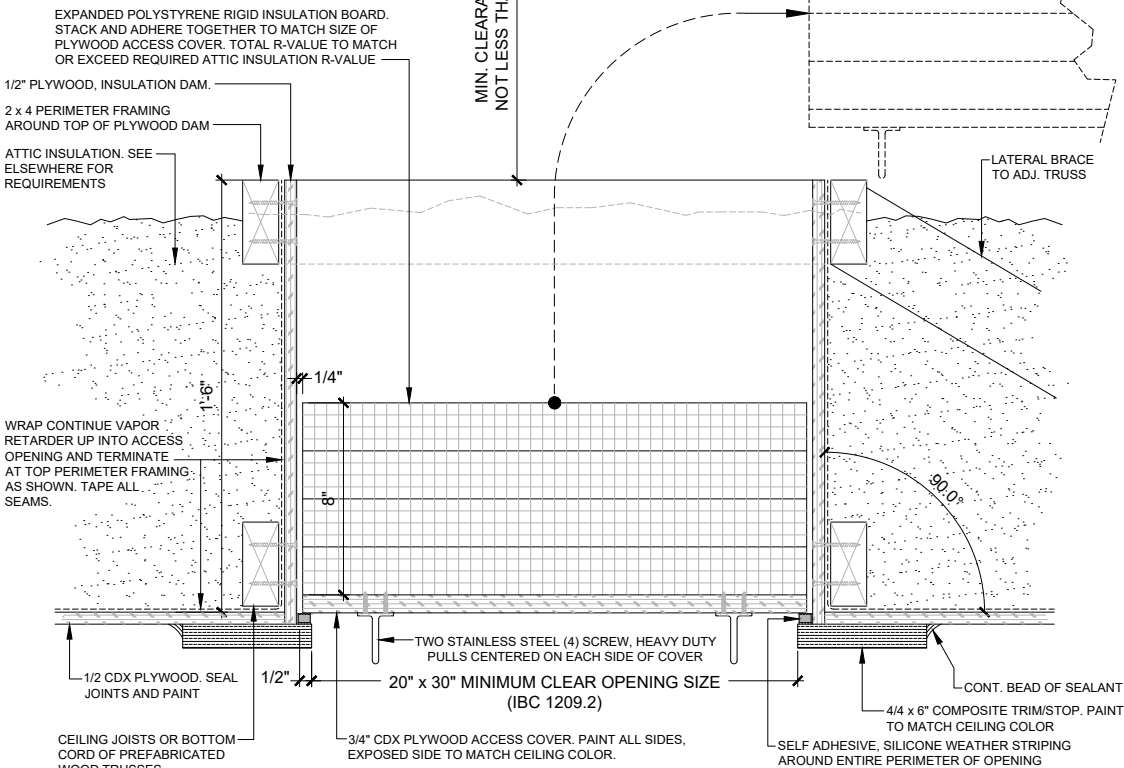

18 ATTIC ACCESS

SCALE: 3" = 1'-0" (1 1/2" = 1'-0" on 11" x 17")

RECORD DRAWINGS:

These record drawings have been prepared based on information gathered during field observations as well as information provided by others. The accuracy or completeness of information provided by others has not been verified by J-U-B ENGINEERS, Inc. and/or B2 Architecture, Inc. The Architect shall not be held responsible for the accuracy or completeness of the information provided by the Contractor.

If these record drawings are a public record, J-U-B ENGINEERS, Inc. grants the public entity with jurisdiction the right to copy and disseminate the hard copy or digital image to those who legitimately request the information in writing. Any release, use, or reuse by the public entity, any individual, or organization, shall be at the public entity's, individual's, and/or organization's sole risk and without liability or legal exposure to J-U-B ENGINEERS, Inc. and/or B2 Architecture, Inc.

Any seals of the registrants included hereon represent that the drafting of the record drawing information was completed by staff under the registrants' responsible charge.

RECORD

LICENSED ARCHITECT
AR-985283

ORIGINAL SIGNED BY:
JAMES E. LEMON
DATE ORIGINAL
SIGNED: 5/24/21
James E. Lemon
STATE OF IDAHO

DRAWINGS

REUSE OF DRAWINGS		REVISION	
THIS DOCUMENT AND THE IDEAS AND DESIGNS INCORPORATED HEREIN ARE THE PROPERTY OF J-U-B ENGINEERS, INC. AND NOT BE REPRODUCED, COPIED, OR PART OF ANY OTHER PROJECT WITHOUT THE EXPRESS WRITTEN AUTHORIZATION OF J-U-B ENGINEERS, INC.		NO.	
1		1	
RECORD DRAWINGS		JUL 11-14-22	
		BY APR	
		DATE	

WELL NO. 7
CITY OF LEWISTON

ARCHITECTURAL (A)
DOOR DETAILS,
WINDOW TYPES & DETAILS

FILE : SCHEDULE-DTL-S-RECORD SET

JUB PROJ. #: 21-20-007

DRAWN BY: JL

DESIGN BY: JL

CHECKED BY: JL

ONE INCH


AT FULL SIZE, IF NOT ONE INCH, SCALE ACCORDINGLY

LAST UPDATED: 4/24/2018

SHEET NUMBER:

A-903R


NOTE: SEE SPECIFICATION SECTION 10520 FOR ADDITIONAL REQUIREMENTS

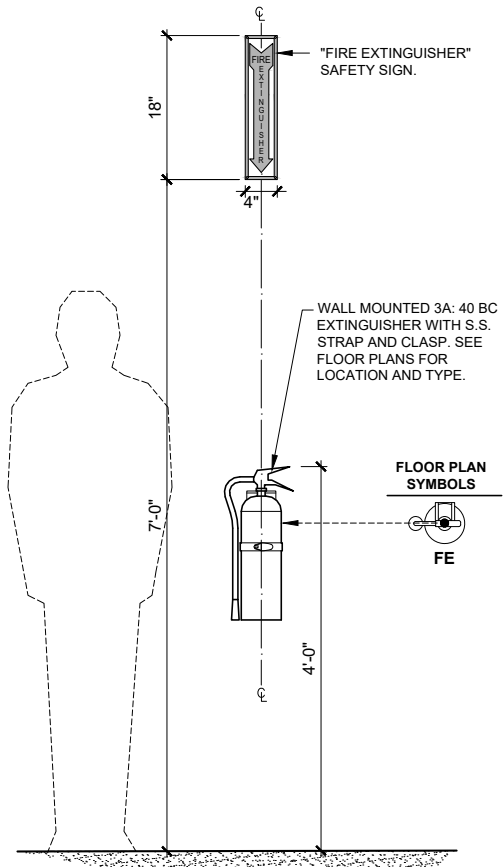

20 FIRE EXTINGUISHER AND SIGN


SCALE: 1" = 1'-0" (1/2" = 1'-0" on 11" x 17")

SEAL ALL SEAMS & FASTENERS HOLES AND THEN PRIME AND PAINT PRIOR TO EQUIPMENT INSTALLATION! TYPICAL AT ALL ELECTRICAL ROOM WALLS

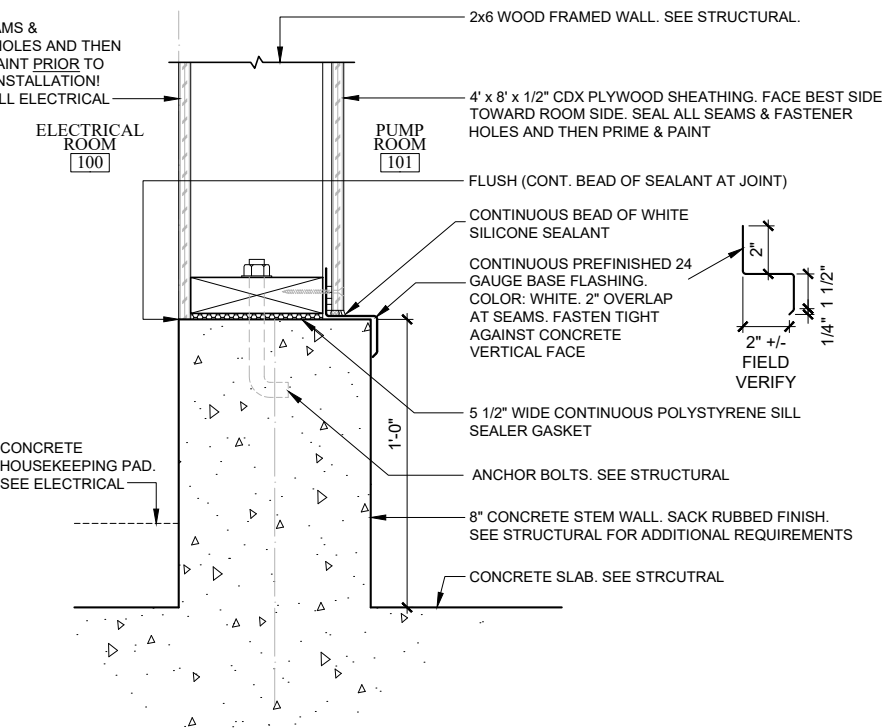

8 INTERIOR WALLS (TYPICAL OF 2)

SCALE: 3" = 1'-0" (1 1/2" = 1'-0" on 11" x 17")

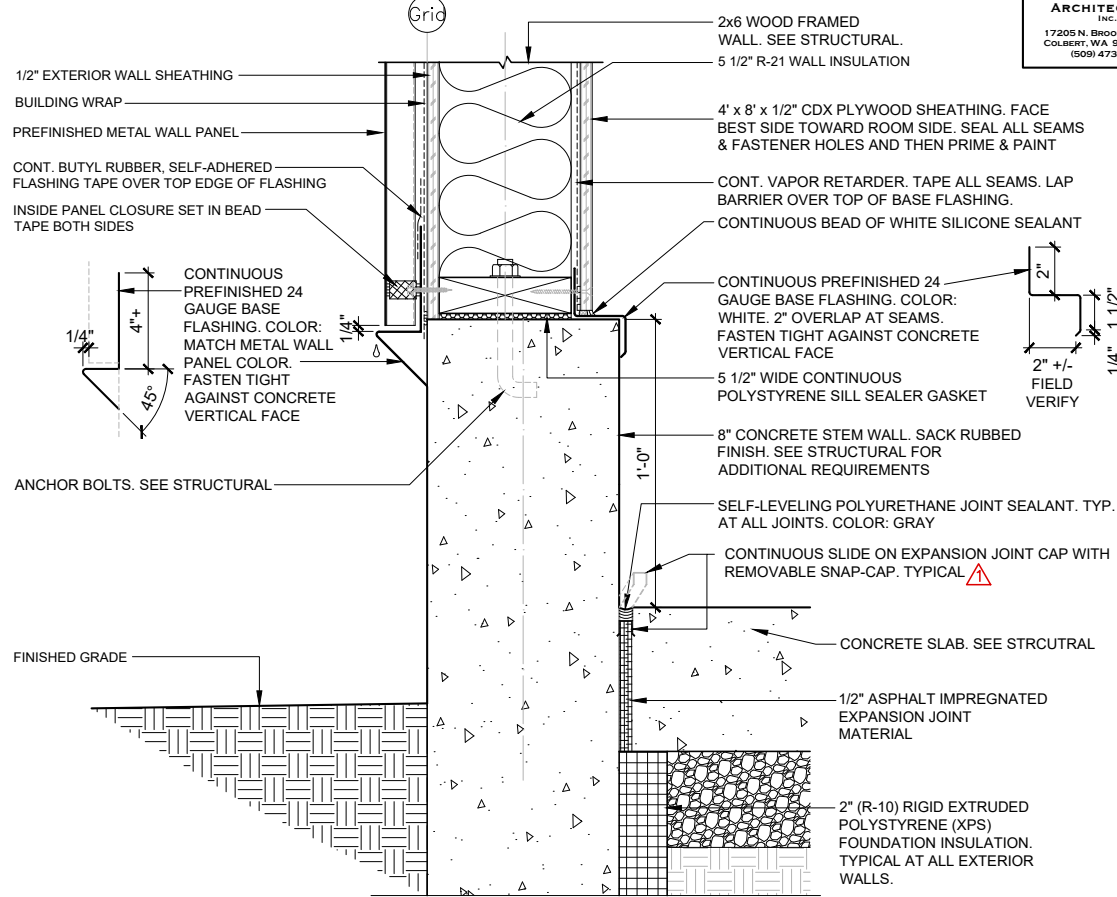

9 EXTERIOR WALLS

SCALE: 3" = 1'-0" (1 1/2" = 1'-0" on 11" x 17")

((## -T- ##))							SEE 6/AD-901
CODE	SIGN NUMBER	QTY	TYPE	SIZE (H x W)	MOUNTING HEIGHT	COPY	REMARKS
INTERIOR IDENTIFICATION SIGNAGE							
7	I01	1	A	5" x 10"	5'-0" (CL)	ELECTRICAL ROOM	A, ROOM SIGN
7	I02	1	A	5" x 10"	5'-0" (CL)	PUMP ROOM	B, ROOM SIGN
7	I03	1	B	14" x 10"	5'-0" (CL)	SODIUM HYPOCHLORITE (12.5%)	NFPA 704 DIAMOND SIGN
EXTERIOR BUILDING/STRUCTURE IDENTIFICATION SIGNAGE							
7	E01	1	A	5" x 10"	5'-0" (CL)	ELECTRICAL ROOM	A, ROOM SIGN
7	E02	2	B	14" x 10"	5'-0" (CL)	SODIUM HYPOCHLORITE (12.5%)	NFPA 704 DIAMOND SIGN
7	E03	1	C	14" x 10"	7'-0" (TOP)	WELL 7	C, BUILDING SIGN

- NOTES:
- SEE FLOOR PLANS & ELEVATIONS FOR LOCATIONS.
 - SEE SPECIFICATION SECTION 10400 FOR ADDITIONAL IDENTIFICATION AND SIGNAGE REQUIREMENTS.

- REMARK NOTES:
- RED SIGN WITH WHITE LETTERS.
 - DARK BRONZE (BROWN) WITH WHITE LETTERS.
 - REFLECTIVE WHITE WITH DARK BRONZE (BROWN) LETTERS.


CODES:
7 = WELL #7
T = SIGN
I# = INTERIOR
E# = EXTERIOR
-T-

RECORD DRAWINGS:

These record drawings have been prepared based on information gathered during field observations as well as information provided by others. The accuracy or completeness of information provided by others has not been verified by J-U-B ENGINEERS, Inc. and/or B2 Architecture, Inc. The Architect shall not be held responsible for the accuracy or completeness of the information provided by the Contractor.

If these record drawings are a public record, J-U-B ENGINEERS, Inc. grants the public entity with jurisdiction the right to copy and disseminate the hard copy or digital image to those who legitimately request the information in writing. Any release, use, or reuse by the public entity, any individual, or organization, shall be at the public entity's, individual's, and/or organization's sole risk and without liability or legal exposure to J-U-B ENGINEERS, Inc. and/or B2 Architecture, Inc.

Any seals of the registrants included hereon represent that the drafting of the record drawing information was completed by staff under the registrants' responsible charge.

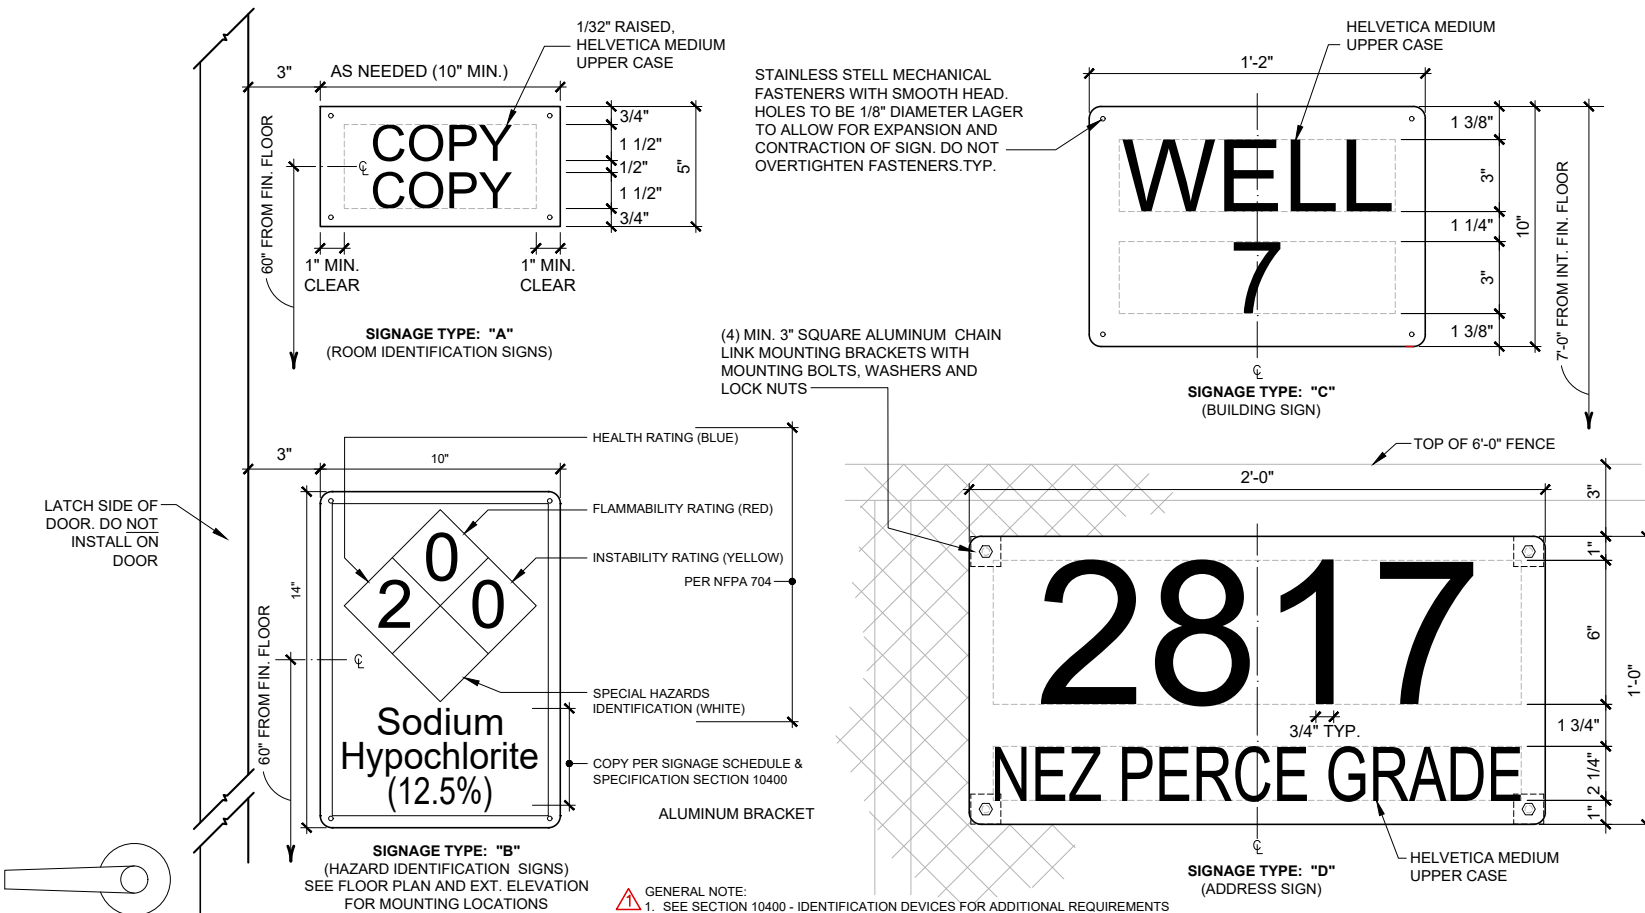

18 SIGN DETAILS

SCALE: 3" = 1'-0" (1 1/2" = 1'-0" on 11" x 17")

RECORD

LICENSED
ARCHITECT
AR-985293

ORIGINAL SIGNED BY:
JAMES E. LEMON
DATE ORIGINAL
SIGNED: 5/24/21
James E. Lemon
STATE OF IDAHO

DRAWINGS


REUSE OF DRAWINGS			
THIS DOCUMENT AND THE IDEAS AND DESIGNS INCORPORATED HEREIN ARE THE PROPERTY OF J-U-B ENGINEERS, INC. AND ARE NOT TO BE REPRODUCED, COPIED, OR PART OF ANY OTHER PROJECT WITHOUT THE EXPRESS WRITTEN AUTHORIZATION OF J-U-B ENGINEERS, Inc.			
NO.	REVISION	DATE	BY
1	RECORD DRAWINGS	11-14-22	JEL

WELL NO. 7
CITY OF LEWISTON
ARCHITECTURAL (A)
MISC. DETAILS

FILE : SCHEDULE-DTLS-RECORD SET
JUB PROJ. # : 21-20-007
DRAWN BY: JL
DESIGN BY: JL
CHECKED BY: JL
ONE INCH
AT FULL SIZE, IF NOT ONE
INCH, SCALE ACCORDINGLY
LAST UPDATED: 4/24/2018
SHEET NUMBER:

A-904R

Plot Date: 11/14/2022 5:19 PM Plotted By: James Lemon
Date Created: 11/11/2022 C:\DRP\DRP_DRIVE\201 CITY OF LEWISTON - WELL 720 DRAWINGS\2D DESIGN\SCHEDULE-DTL-S-RECORD SET.DWG

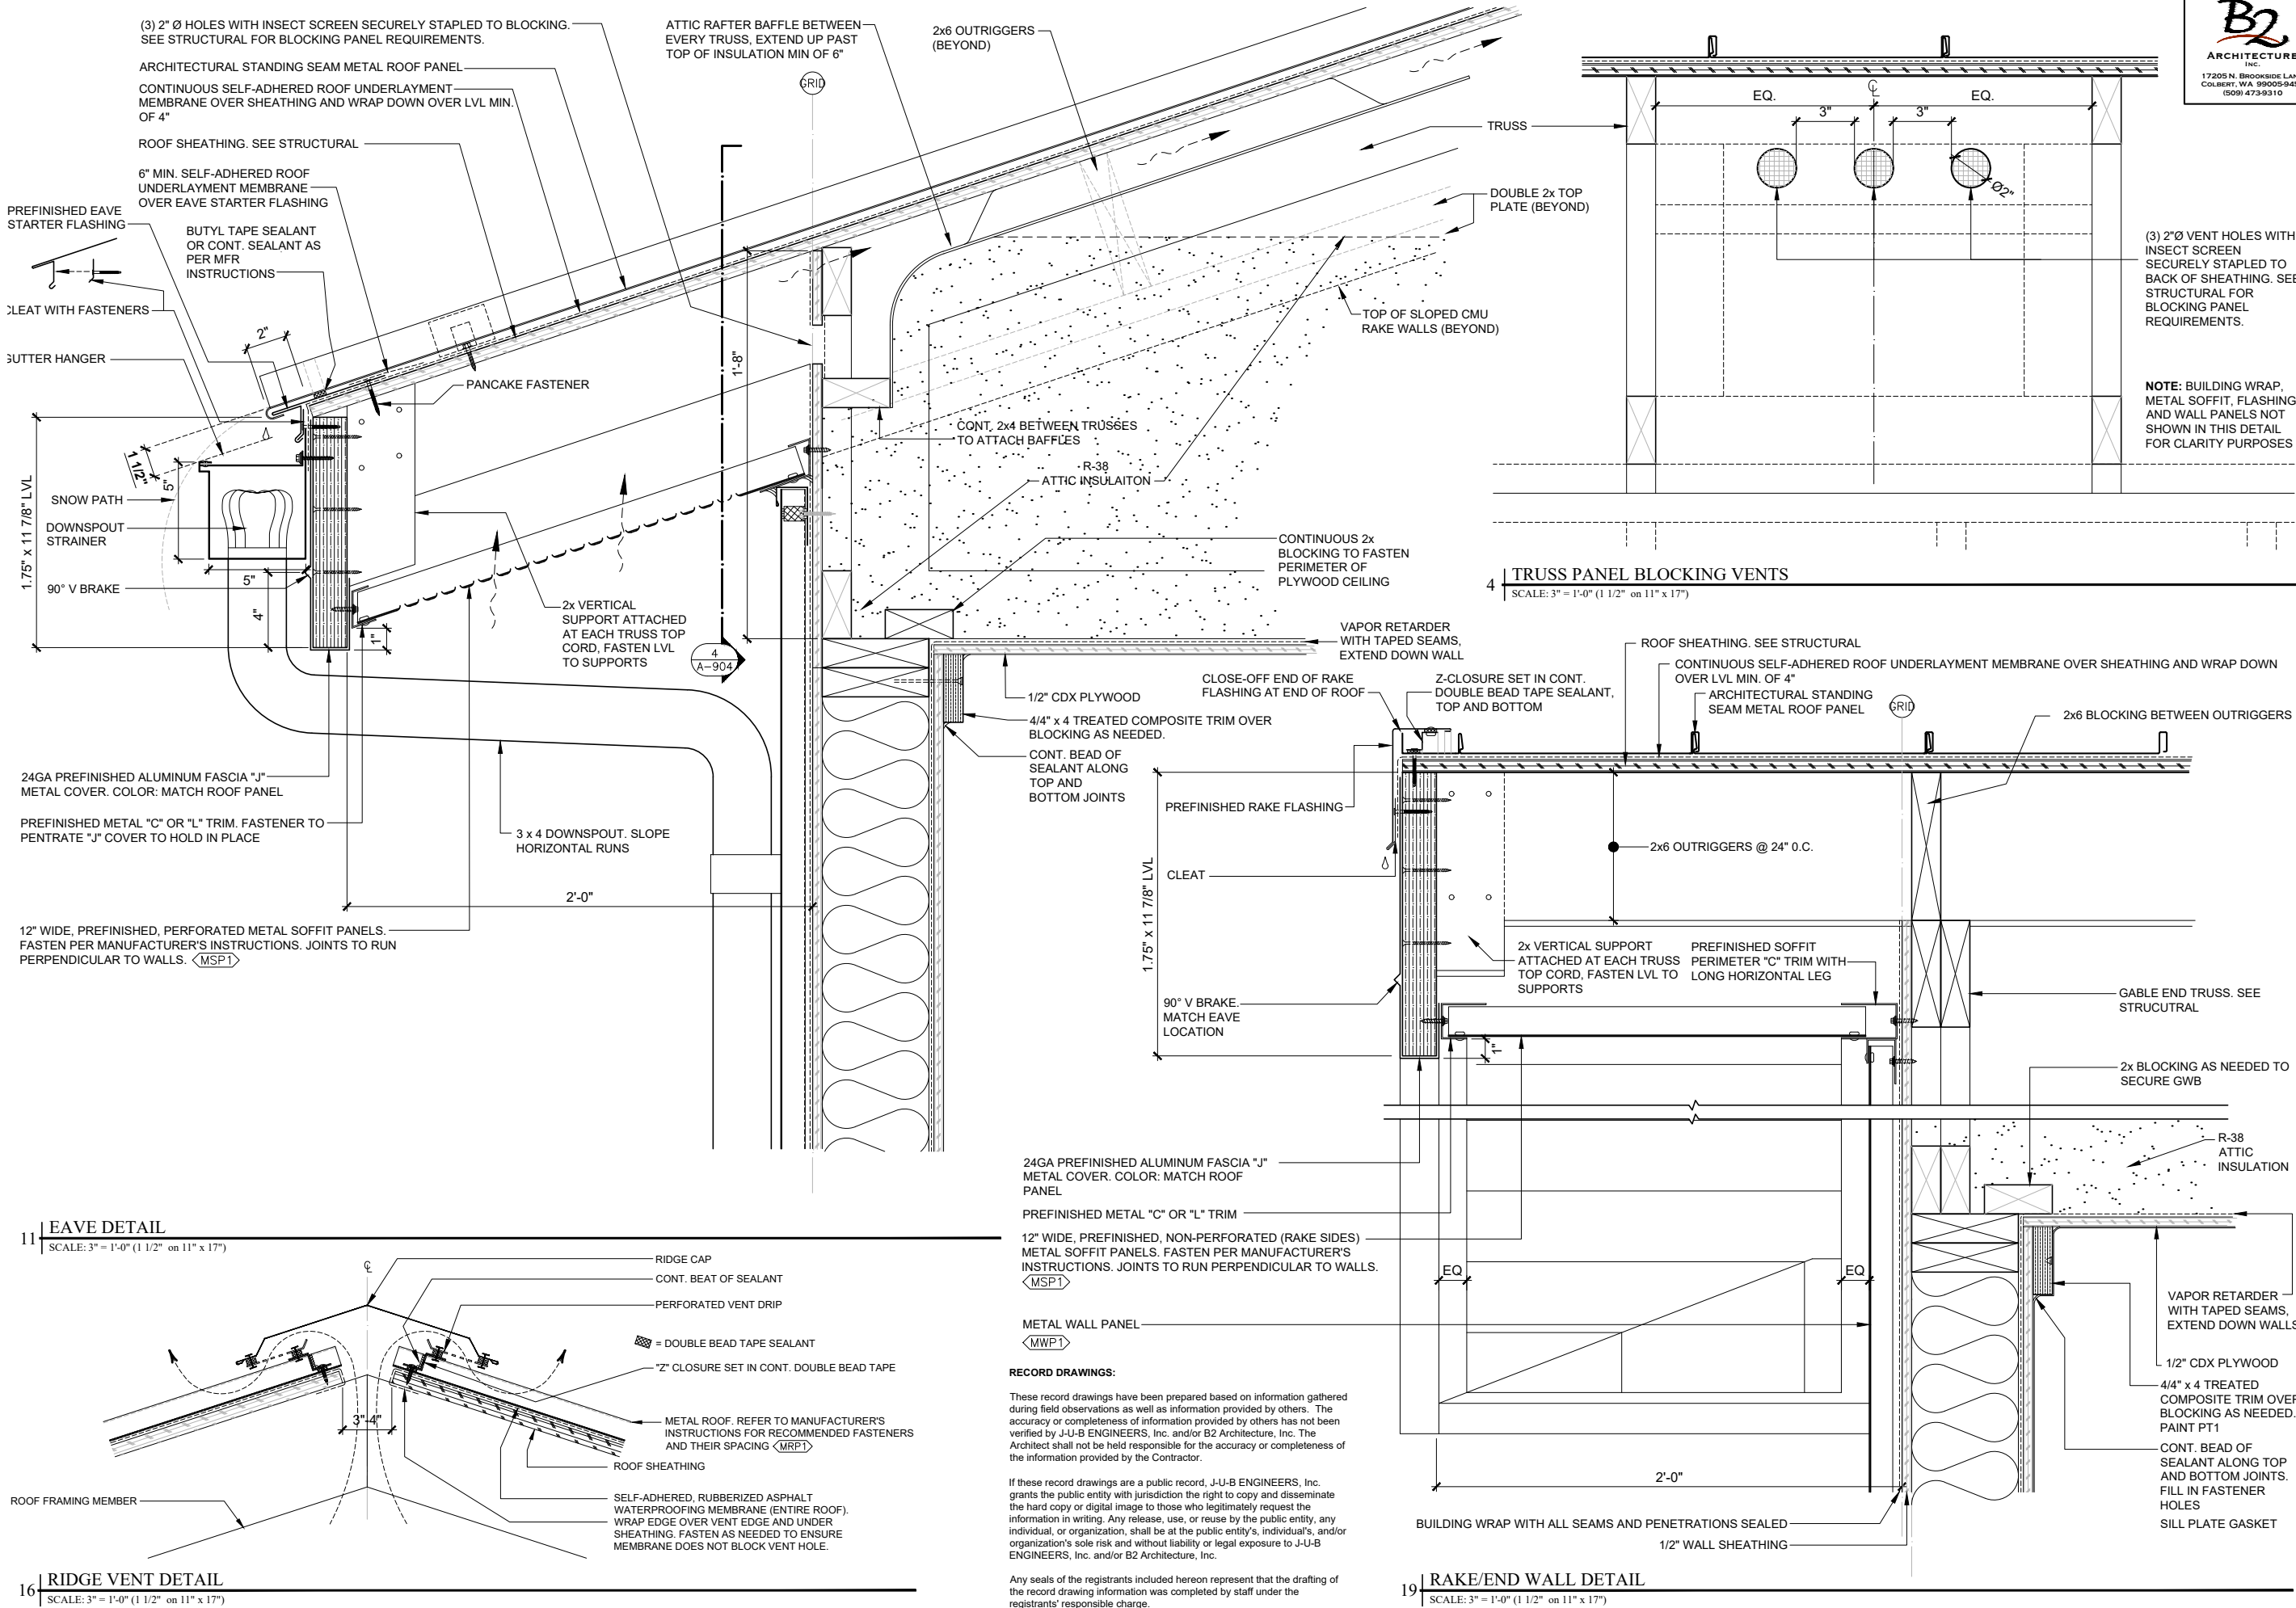

REUSE OF DRAWINGS		REVISION	
THIS DOCUMENT AND THE IDEAS AND DESIGNS INCORPORATED THEREIN ARE THE PROPERTY OF J-U-B ENGINEERS, INC. AND NOT BE REPRODUCED, COPIED, OR PART FOR ANY OTHER PROJECT WITHOUT THE EXPRESS WRITTEN AUTHORIZATION OF J-U-B ENGINEERS, INC.		NO.	DESCRIPTION
1	RECORD DRAWINGS	JEL	11-14-22
		BY	DATE



J-U-B ENGINEERS, INC.
201 South Jackson Street
Moscow, ID 83843
Phone: 208.746.9010
www.jub.com

RECORD

LICENSED
ARCHITECT
AR-985283

ORIGINAL SIGNED BY
JAMES E. LEMON
DATE ORIGINAL
SIGNED: 5/24/21


James E. Lemon
STATE OF IDAHO

DRAWINGS


[illegible]

WELL NO. 7
CITY OF LEWISTON

ARCHITECTURAL (A)
ROOF HATCH DETAILS

FILE : SCHEDULE-DTLS-RECORD
JUB PROJ. # : 21-20-007
DRAWN BY: JL
DESIGN BY: JL
CHECKED BY: JL

ONE INCH
AT FULL SIZE, IF NOT ONE
INCH, SCALE ACCORDINGLY
LAST UPDATED: 4/24/2018
SHEET NUMBER:

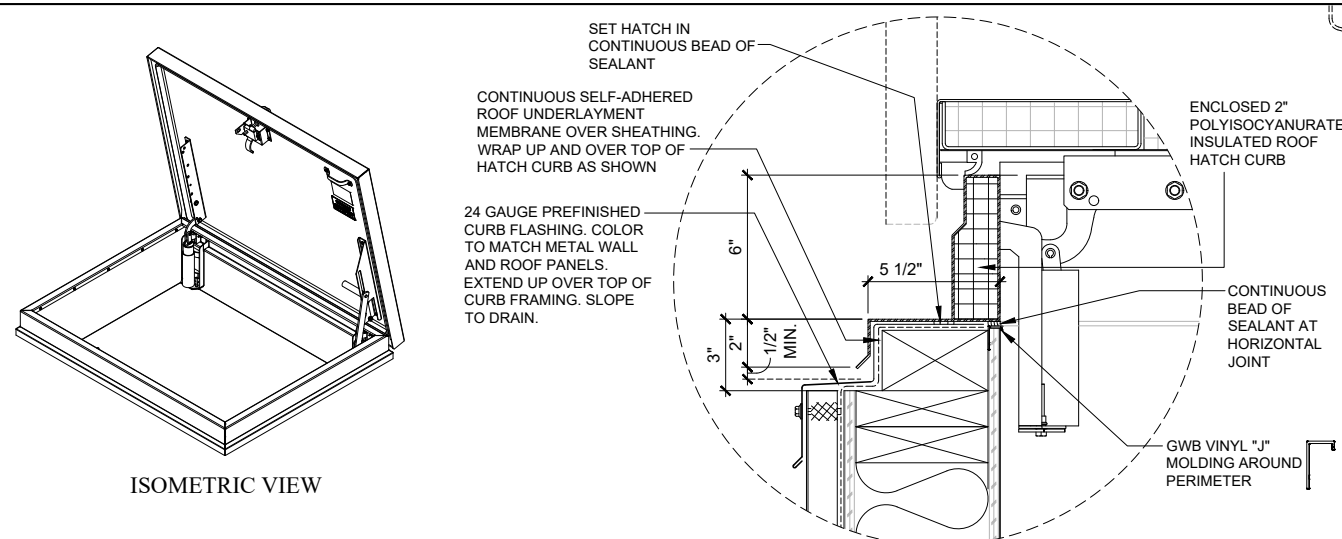A-906R



GENERAL NOTES:
1. ALL FLASHING TO BE REFINISHED. COLOR AND GAUGE TO MATCH
ADJACENT METAL ROOF PANELS.

RECORD DRAWINGS:

These record drawings have been prepared based on information gathered during field observations as well as information provided by others. The accuracy or completeness of information provided by others has not been verified by J-U-B ENGINEERS, Inc. and/or B2 Architecture, Inc. The Architect shall not be held responsible for the accuracy or completeness of the information provided by the Contractor.

If these record drawings are a public record, J-U-B ENGINEERS, Inc. grants the public entity with jurisdiction the right to copy and disseminate the hard copy or digital image to those who legitimately request the information in writing. Any release, use, or reuse by the public entity, any individual, or organization, shall be at the public entity's, individual's, and/or organization's sole risk and without liability or legal exposure to J-U-B ENGINEERS, Inc. and/or B2 Architecture, Inc.

Any seals of the registrants included hereon represent that the drafting of the record drawing information was completed by staff under the registrants' responsible charge.

2 | ROOF HATCH FRAME & TOP OF CURB DETAIL
SCALE: NTS

2 | **ROOF HATCH FRAME & TOP OF CURB DETAIL**
SCALE: NTS

2" INSULATED ALUMINUM, SINGLE LEAF, EQUIPMENT HATCH WITH 6" INSULATED CURB. FASTEN PER MANUFACTURERS WRITTEN RECOMMENDATIONS

EXHAUST FAN. SEE ELECTRICAL

BUILDING WRAP WITH TAPED SEAMS. TYP.

5 1/2" R-21 WALL INSULATION

1/2" WALL SHEATHING. SEE STRUCTURAL

EXHAUST FAN. SEE ELECTRICAL

EXHAUST FAN INTAKE GRILL/LOUVER. COLOR: WHITE OR ALUMINUM

CONTINUOUS VAPOR BARRIER WITH ALL SEAMS AND PENETRATIONS SEALED

2 x 6 WALL FRAMING AT 16" O.C. WITH (1) BASE PLATE AND (2) TOP PLATES

1/2" CDX PLYWOOD OVER CONT. VAPOR BARRIER, C FACE OUT, SEAL ALL JOINTS AND SCREW HOLES, PRIME AND PAINT

CONTINUOUS VAPOR BARRIER WITH ALL SEAMS AND PENETRATIONS SEALED

6'-0" CLEAR

R-38 LOOSE-FILL, ATTIC INSULATION

PREMANUFACTURED WOOD TRUSS. SEE STRUCTURAL

NOTCHED OUT 2x4 WOOD TRIM AROUND OPENING TO PROTECT CORNER OF PLYWOOD AT FUTURE TIME OF LIFTING ACCESS. FILL HOLES, PRIME AND PAINT

16 | **ROOF EQUIPMENT REMOVAL HATCH SECTION**
SCALE: 1-1/2" = 1'-0" (3/4" on 11" x 17")

17 | **ROOF HATCH FRAME & TOP OF CURB DETAIL**
SCALE: NTS

18 | **ROOF EQUIPMENT REMOVAL HATCH SECTION**
SCALE: 1-1/2" = 1'-0" (3/4" on 11" x 17")

16 A-906

11 A-302

RAKE FLASHING

CRICKET OVER FRAMING. SLOPE: 1-1/2:12 MIN

2x6 OVER-FRAMING @ 12" O.C.

ROOF SHEATHING PER STRUCTURAL

VENTED RIDGE CAP

PREMANUFACTURED WOOD TRUSSES (BEYOND)

(2) LAYERS OF 2" (R-10) RIGID XPS SKYLIGHT SHAFT INSULATION. EXTEND DOWN 4" BELOW TOP OF BLOWN-IN INSULATION. FASTEN WITH WAFFER HEAD (PBH) FASTENERS. TYPICAL ALL FOUR SIDES. FOAM FILL ALL REMAINING VOIDS

PREMANUFACTURED WOOD GIRDER TRUSS. SEE STRUCTURAL


R-38 LOOSE-FILL, ATTIC INSULATION

PUMP BELOW

16 | ROOF EQUIPMENT REMOVAL HATCH SECTION
SCALE: 1-1/2" = 1'-0" (3/4" on 11" x 17")


18 | ROOF EQUIPMENT REMOVAL HATCH SECTION
SCALE: 1-1/2" = 1'-0" (3/4" on 11" x 17")

Plot Date: 11/14/2022 5:20 PM Plotted By: Jamie Lemon
File Created: 7/11/2022 C:\DROBBOW\DRIVE\2004 CITY OF ELMISTON - WELL 702 DRAWINGS\2022 DESIGN\SCHEDULE.DTI & RECORD SET.DWG

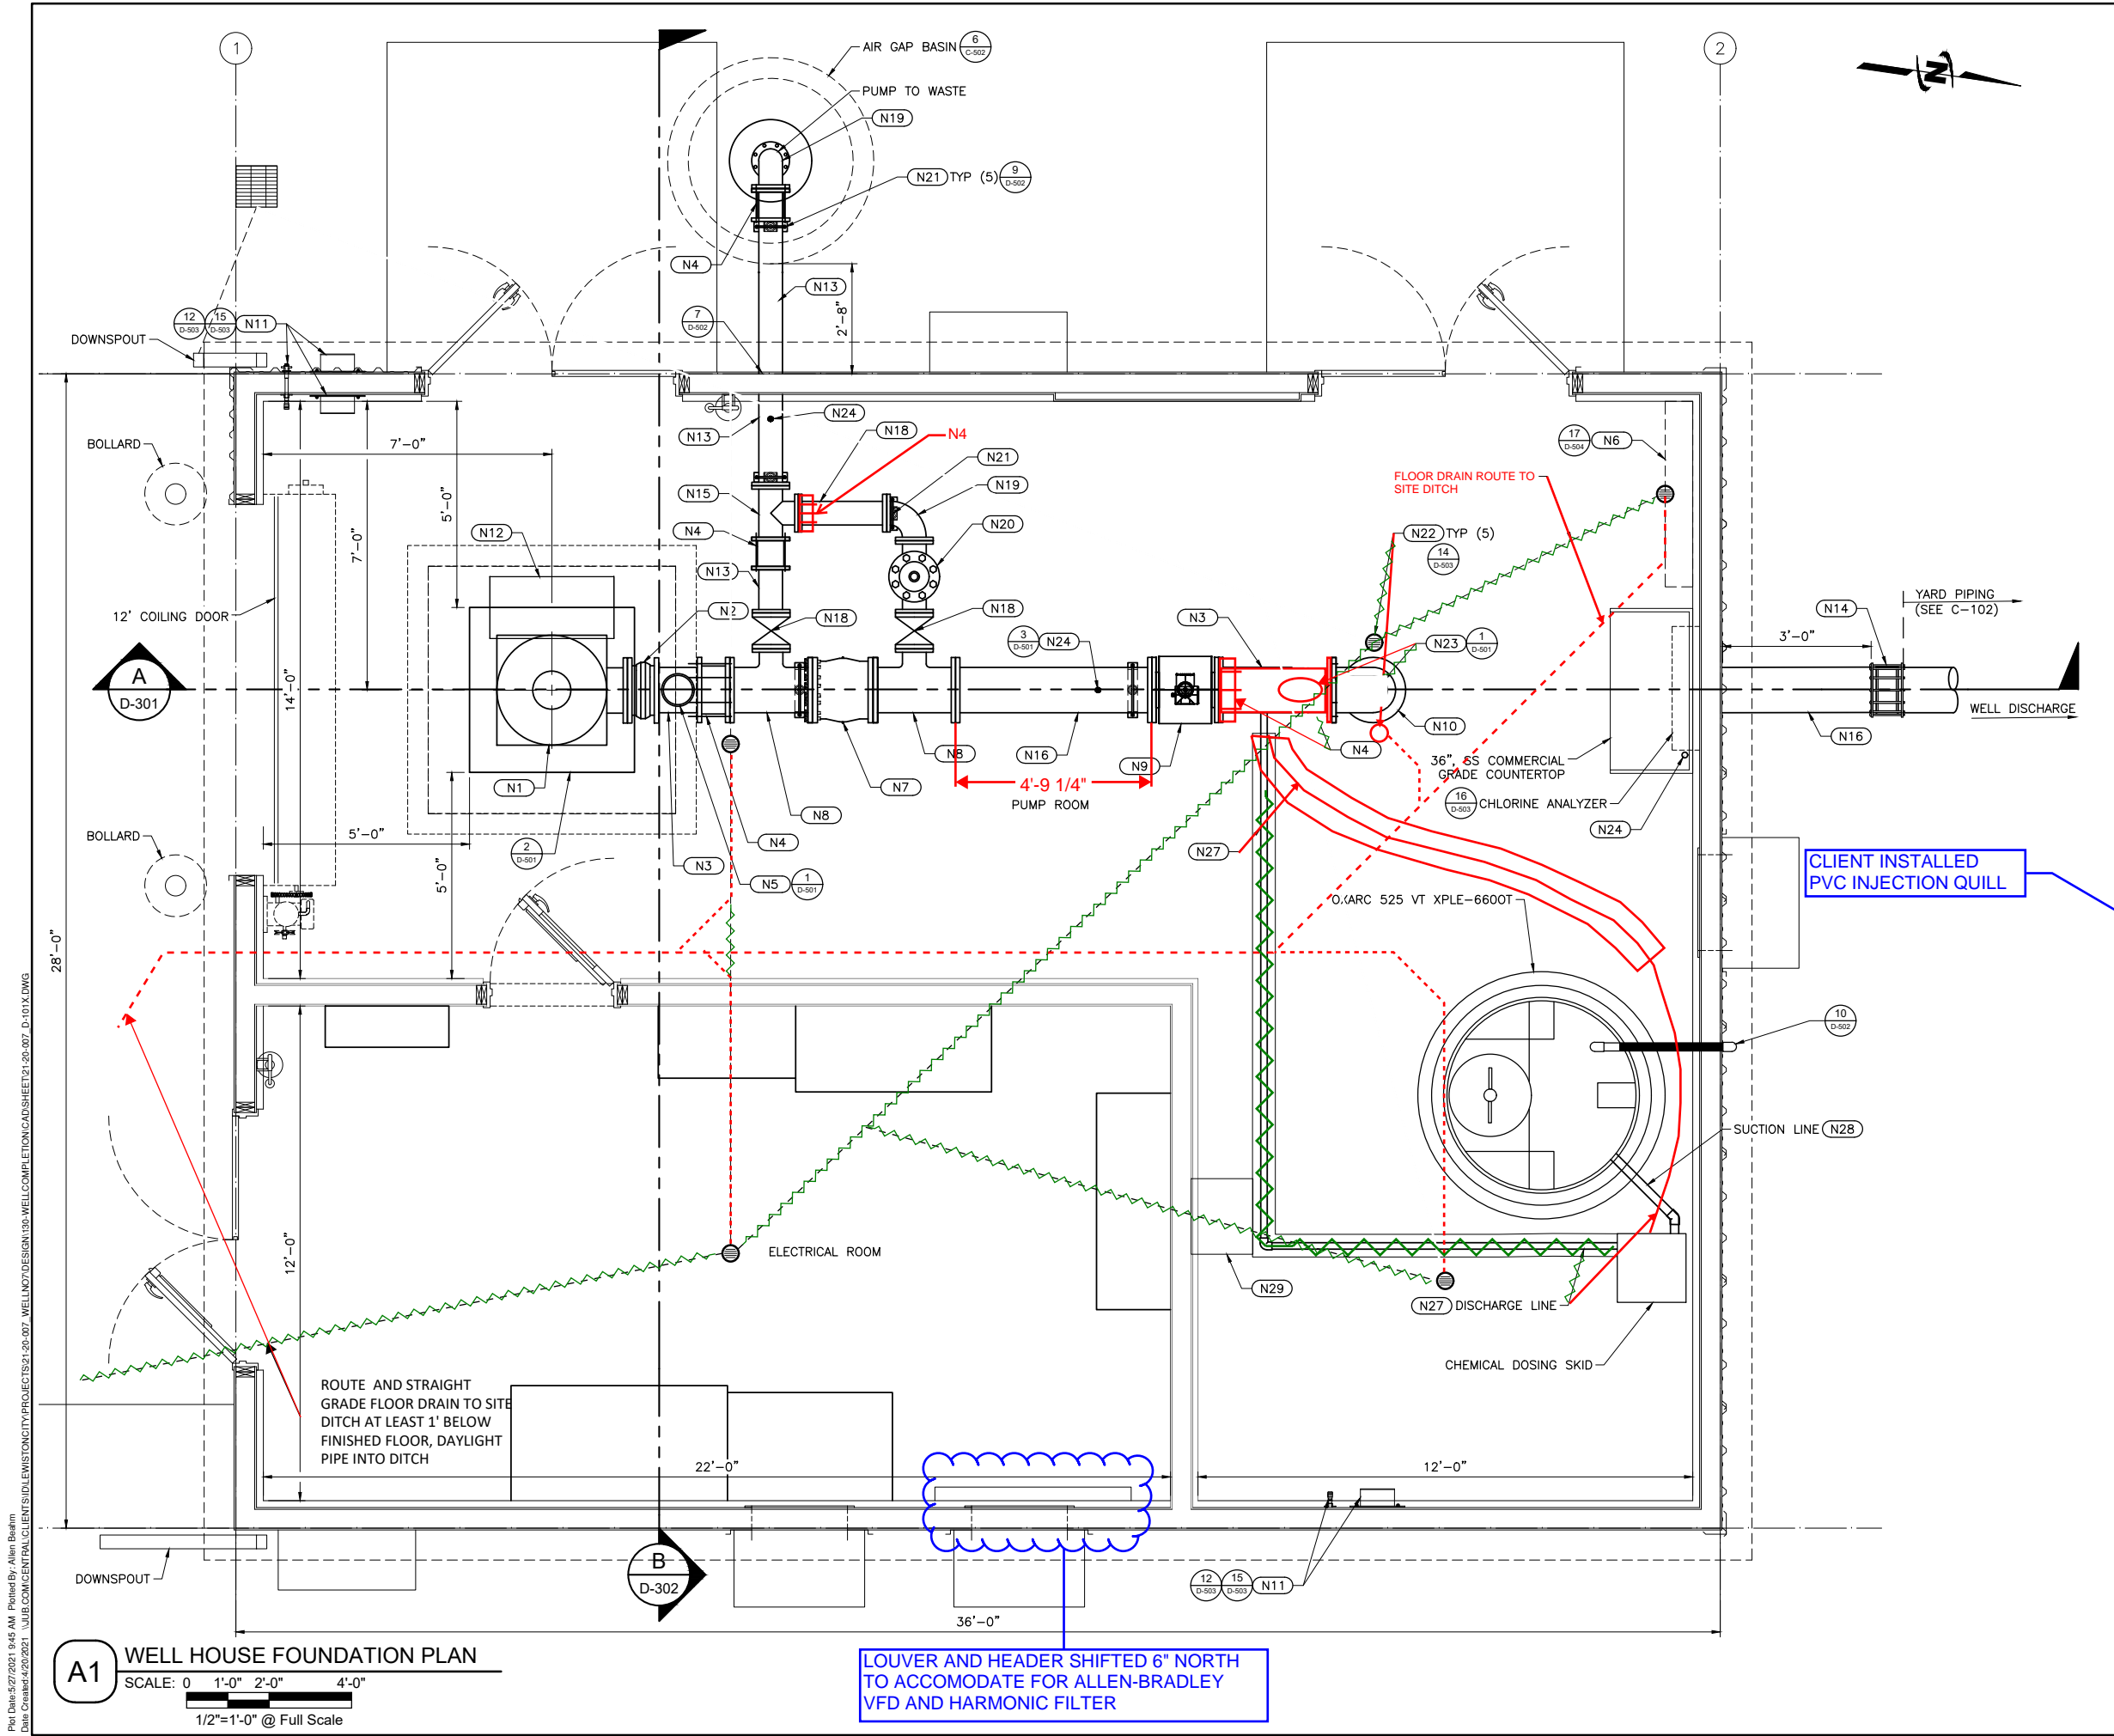

- NOTES:**
1. ALL MATERIALS IN CONTACT WITH POTABLE WATER SHALL BE NSF61 COMPLIANT.
 2. CONTRACTOR SHALL DESIGN FLOOR DRAIN SYSTEM AND SUBMIT TO ENGINEER FOR REVIEW. ROUTE FLOOR DRAINS TO DITCH. SYSTEM SHALL INCLUDE DRAINS, PIPE, CLEAN OUTS, AND VENTS TO MEET PLUMBING CODE.
 3. ABOVE GRADE PIPE SHALL BE PAINTED PER SPEC SECTION 09900 HIGH PERFORMANCE COATINGS.

KEYED NOTES:	
(N1)	WELL PUMP AND MOTOR
(N2)	12" EXPANSION JOINT
(N3)	12" DI PIPE, FLxPE.
(N4)	RESTRAINED FLANGED COUPLING ADAPTER
(N5)	2" DEEP WELL AIR/VAC VALVE
(N6)	WATER SERVICE ASSEMBLY
(N7)	12" GLOBE CHECK VALVE
(N8)	12"x12"x6" DI TEE
(N9)	12" MAGNETIC FLOW METER
(N10)	12" DI 90° BEND
(N11)	HOSE BIBB AND RACK
(N12)	PUMP MOTOR TERMINAL BOX
(N13)	6" DI PIPE, FLxPE.
(N14)	FLEXIBLE TYPE COUPLING w/ RESTRAINED JOINTS
(N15)	6"x6"x6" DI TEE
(N16)	12" DI PIPE, FLxFL.
(N17)	6" DI PIPE, FLxFL.
(N18)	6" GATE VALVE
(N19)	6" DI 90° BEND
(N20)	6" PRESSURE RELIEF VALVE
(N21)	PIPE SUPPRT
(N22)	FLOOR DRAIN
(N23)	1" AIR/VAC VALVE
(N24)	1/2" SMOOTH NOSED SAMPLE PORT
(N25)	12" BUTTERFLY VALVE
(N26)	SAFTFLOW CHEMICAL INJECTION QUILL MODEL DB-146-S-S-6-B-E. ADDITIONAL FITTINGS TO CONNECT TO 1/2" TUBING AS NEEDED.
(N27)	1/2" POLYETHYLENE TUBE CHEMICAL INJECTION LINE WITH COMPRESSION FITTINGS AND/OR CONE TO TIE-IN TO PVC DISCHARGE LINE, AND INJECTION QUILL. RUN IN INDUSTRIAL GRADE RIGID FLOOR RAMP.
(N28)	1/2" PVC CHEMICAL PIPE
(N29)	HONEYWELL FENDALL PURE FLOW 1000 GRAVITY EMERGENCY EYEWASH STATION, OR APPROVED EQUAL. PROVIDE ONE COMPLETE REPLACEMENT SET OF SALINE CARTRIDGES.



J-U-B ENGINEERS, INC.

J-U-B ENGINEERS, INC.


201 South Jackson Street
Moscow, ID 83843

Phone: 208.746.9010
www.jub.com

REUSE OF DRAWINGS JUB SHALL RETAIN ALL COMMON LAW, STATUTORY, COPYRIGHT AND OTHER RIGHTS IN THIS DRAWING. NO PART OF THIS DRAWING SHALL BE REPRODUCED OR TRANSMITTED IN ANY FORM OR BY ANY MEANS, ELECTRONIC OR MECHANICAL, INCLUDING PHOTOCOPYING, RECORDING, OR BY ANY INFORMATION STORAGE AND RETRIEVAL SYSTEM, WITHOUT THE WRITTEN CONSENT OF JUB. ANY REUSE WITHOUT WRITTEN CONSENT BY JUB WILL BE AT CLIENT'S SOLE RISK AND WITHOUT LIABILITY OR LEGAL EXPOSURE TO JUB.	REVISION NO. DESCRIPTION BY DATE	WELL NO. 7 WELL COMPLETION	PROCESS MECHANICAL (D) WELL HOUSE PLAN VIEW

FILE: 21-20-007_D-101X
JUB PROJ. #: 21-20-007
DRAWN BY: ARB
DESIGN BY: BK
CHECKED BY: DLW
AT FULL SIZE, IF NOT ONE INCH SCALE ACCORDINGLY
LAST UPDATED: 5/25/2021
SHEET NUMBER:
D-101

Plot Date: 5/27/2021 9:47 AM Plotted By: Allen Beam
Date Created: 4/9/2021 JUB.COM/CENTRAL/CLIENTS/IDLEWISTON/CITY/PROJECTS/21-20-007 WELL/NOT DESIGN/138-WELL/COMPLETION/CA/SHEET/21-20-007 D-301X.DWG

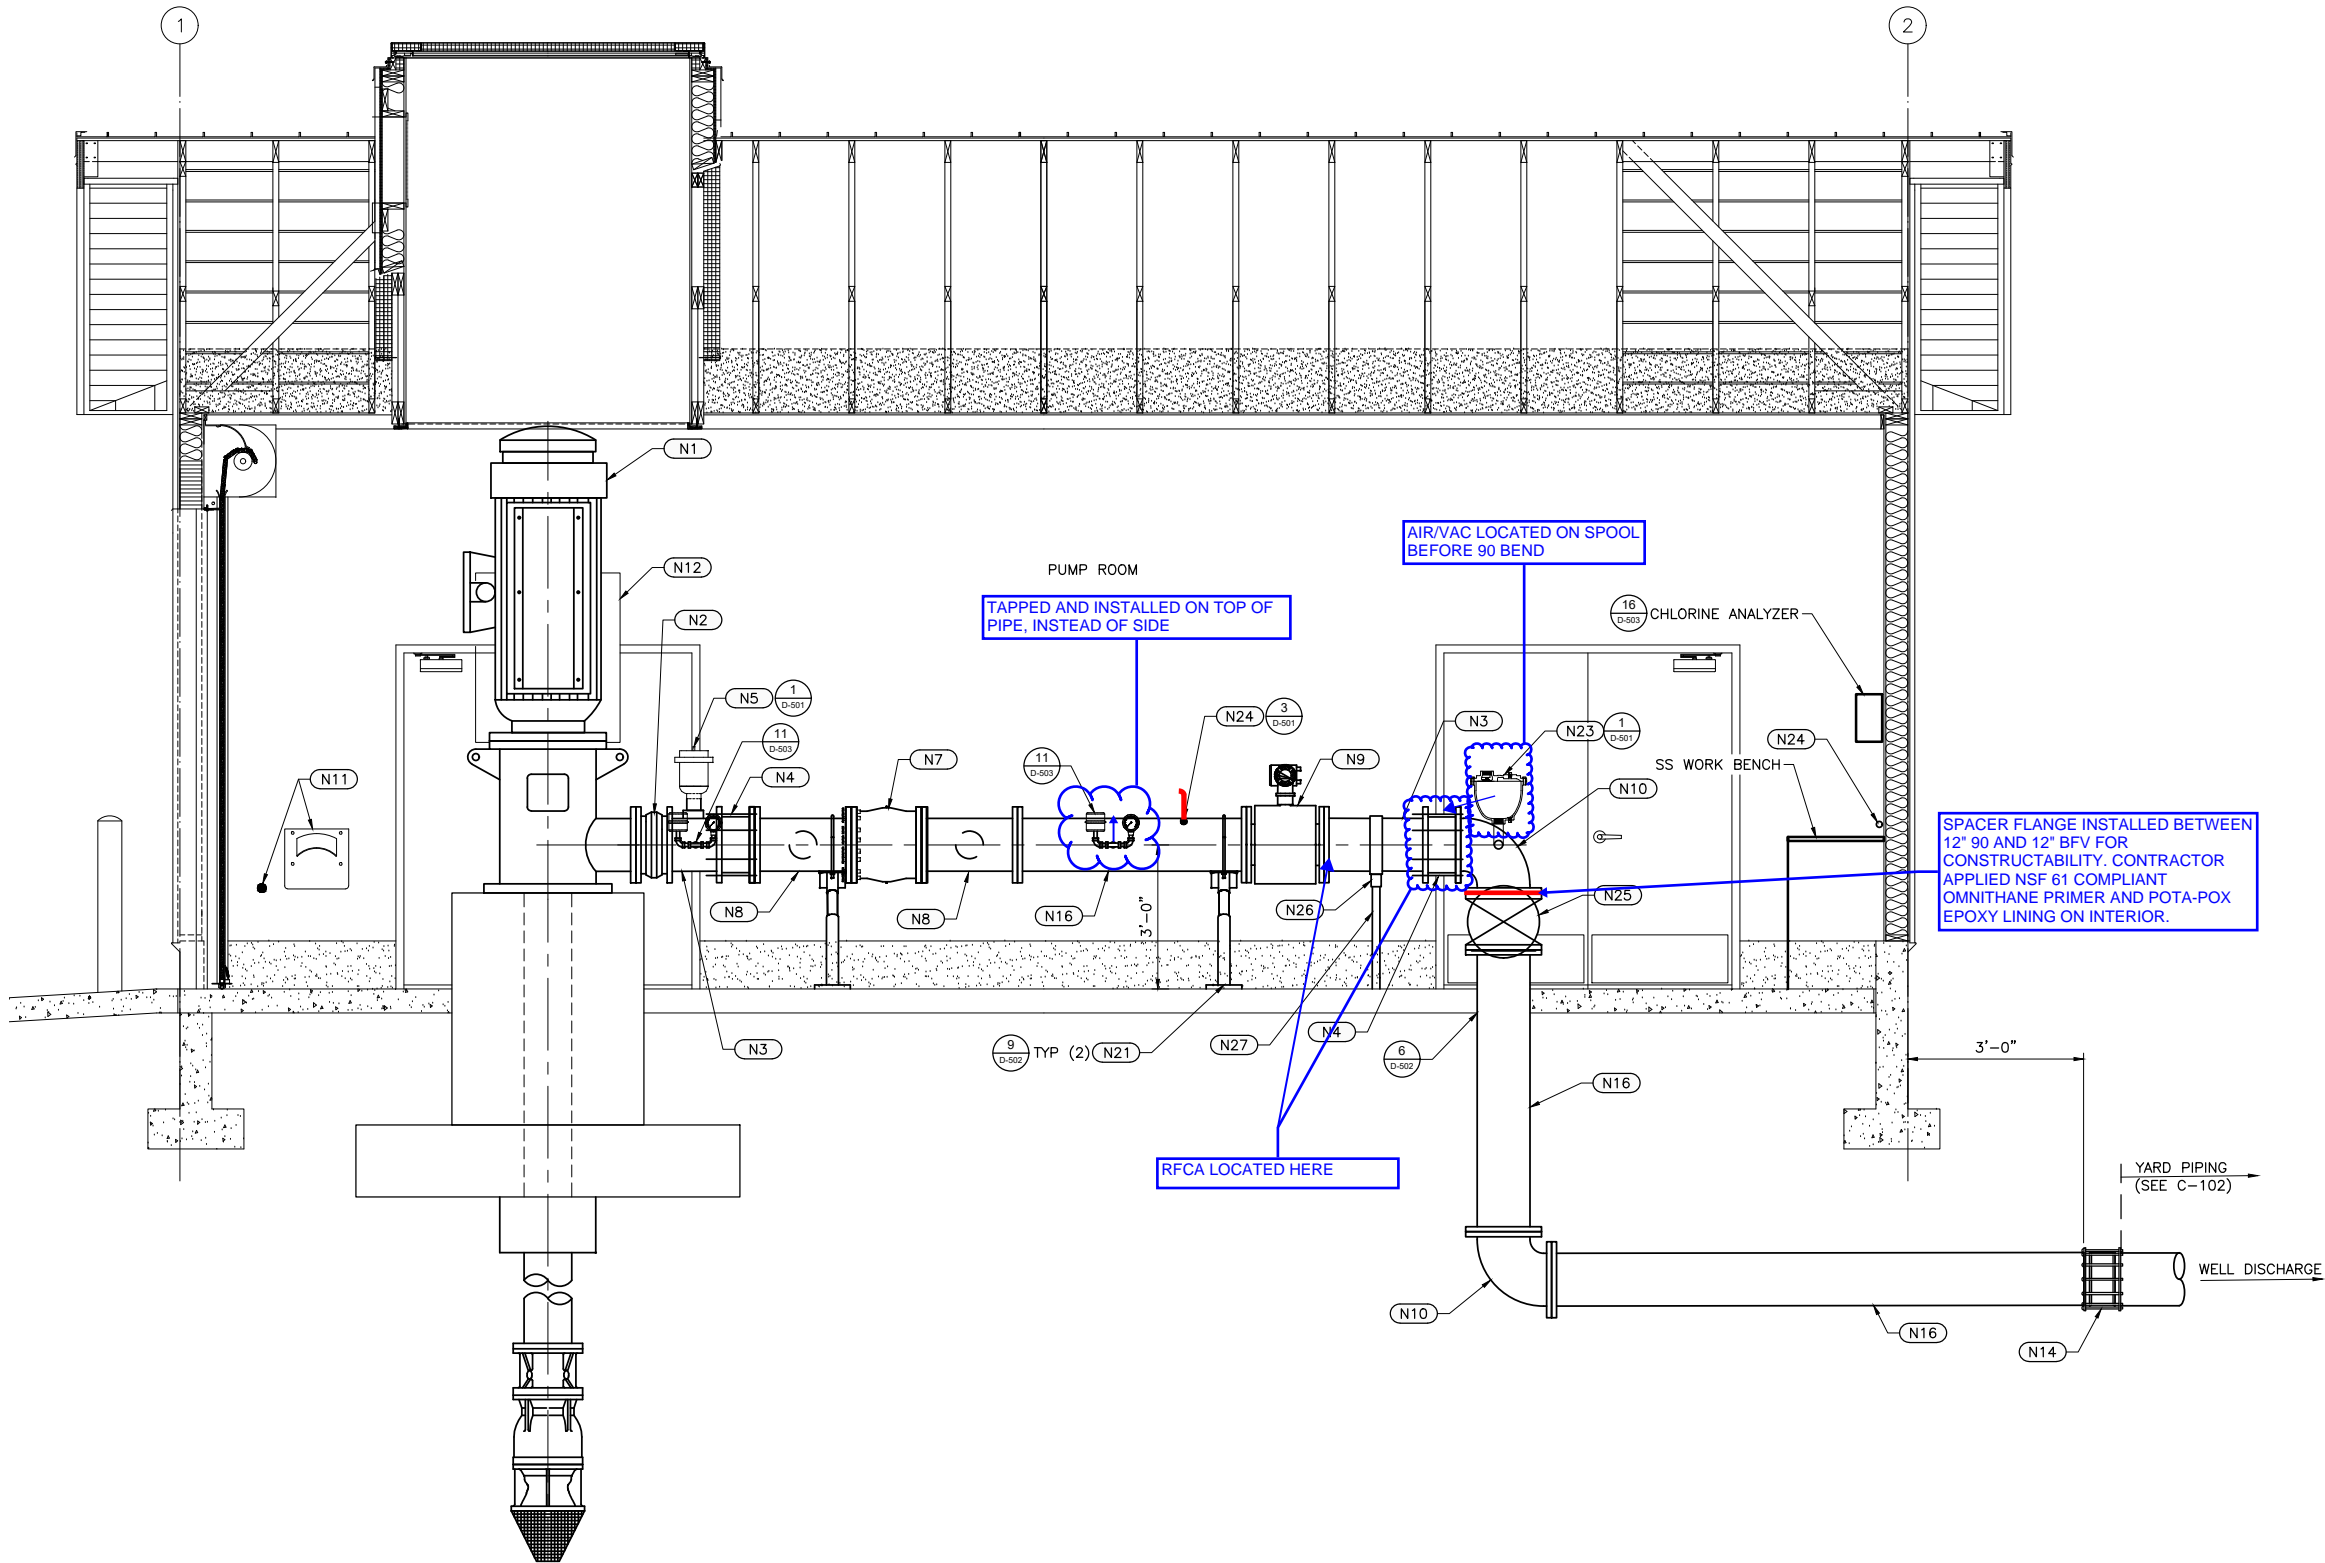

A WELL HOUSE SECTION VIEW
SCALE: 0 1'-0" 2'-0" 4'-0"
1/2"=1'-0" @ Full Scale

NOTES:

1. ALL MATERIALS IN CONTACT WITH POTABLE WATER SHALL BE NSF61 COMPLIANT.
2. CONTRACTOR SHALL DESIGN FLOOR DRAIN SYSTEM AND SUBMIT TO ENGINEER FOR REVIEW. ROUTE FLOOR DRAINS TO CATCH BASIN. SYSTEM SHALL INCLUDE DRAINS, PIPE, CLEAN OUTS, AND VENTS TO MEET PLUMBING CODE.
3. ABOVE GRADE PIPE SHALL BE PAINTED PER SPEC SECTION 09900 HIGH PERFORMANCE COATINGS.

KEYED NOTES:

(N1)	WELL PUMP AND MOTOR
(N2)	12" EXPANSION JOINT
(N3)	12" DI PIPE, FLxPE.
(N4)	RESTRAINED FLANGED COUPLING ADAPTER
(N5)	2" DEEP WELL AIR/VAC VALVE
(N6)	WATER SERVICE ASSEMBLY
(N7)	12" GLOBE CHECK VALVE
(N8)	12"x12"x6" DI TEE
(N9)	12" MAGNETIC FLOW METER
(N10)	12" DI 90° BEND
(N11)	HOSE BIBB AND RACK
(N12)	PUMP MOTOR TERMINAL BOX
(N13)	6" DI PIPE, FLxPE.
(N14)	FLEXIBLE TYPE COUPLING w/ RESTRAINED JOINTS
(N15)	6"x6"x6" DI TEE
(N16)	12" DI PIPE, FLxFL.
(N17)	6" DI PIPE, FLxFL.
(N18)	6" GATE VALVE
(N19)	6" DI 90° BEND
(N20)	6" PRESSURE RELIEF VALVE
(N21)	PIPE SUPPRT
(N22)	FLOOR DRAIN
(N23)	1" AIR/VAC VALVE
(N24)	½" SMOOTH NOSED SAMPLE PORT
(N25)	12" BUTTERFLY VALVE
(N26)	SAFTFLOW CHEMICAL INJECTION QUILL MODEL DB-146-S-S-6-B-E. ADDITIONAL FITTINGS TO CONNECT TO 1/2" TUBING AS NEEDED.
(N27)	½" POLYETHYLENE TUBE CHEMICAL INJECTION LINE WITH COMPRESSION FITTINGS AND/OR CONE TO TIE-IN TO PVC DISCHARGE LINE, AND INJECTION QUILL. RUN IN INDUSTRIAL GRADE RIGID FLOOR RAMP.
(N28)	½" PVC CHEMICAL PIPE
(N29)	HONEYWELL FENDALL PURE FLOW 1000 GRAVITY EMERGENCY EYEWASH STATION, OR APPROVED EQUAL. PROVIDE ONE COMPLETE REPLACEMENT SET OF SALINE CARTRIDGES.



J-U-B ENGINEERS, INC.

J-U-B ENGINEERS, INC.

201 South Jackson Street
Moscow, ID 83843

Phone: 208.746.9010
www.jub.com

REUSE OF DRAWINGS
JUB SHALL RETAIN ALL COMMON LAW, STATUTORY, COPYRIGHT AND OTHER RIGHTS IN THIS DRAWING. NO PART OF THIS DRAWING SHALL BE REPRODUCED OR TRANSMITTED IN ANY FORM OR BY ANY MEANS, ELECTRONIC OR MECHANICAL, INCLUDING PHOTOCOPYING, RECORDING, OR BY ANY INFORMATION STORAGE AND RETRIEVAL SYSTEM, WITHOUT THE WRITTEN CONSENT OF JUB. ANY REUSE WITHOUT WRITTEN CONSENT BY JUB WILL BE AT CLIENT'S SOLE RISK AND WITHOUT LIABILITY OR LEGAL EXPOSURE TO JUB.

NO.	REVISION	DESCRIPTION	BY	DATE

WELL NO. 7

WELL COMPLETION

PROCESS MECHANICAL (D)
WELL HOUSE SECTION VIEW


FILE: 21-20-007_D-301X
JUB PROJ. #: 21-20-007
DRAWN BY: ARB
DESIGN BY: BK
CHECKED BY: DLW
AT FULL SIZE, IF NOT ONE
INCH, SCALE ACCORDINGLY
LAST UPDATED: 5/24/2021

SHEET NUMBER:

D-301


Plot Date: 5/27/2021 9:45 AM Plotted By: Allen Boehm
Date Created: 4/9/2021 JUB.COM/CENTRAL/CLIENTS/IDLEWISTON/CITY/PROJECTS/21-20-007 WELL/NOT DESIGN/138-WELL/COMPLETION/CA/SHEET/21-20-007 D-301X.DWG

B WELL HOUSE SECTION VIEW
SCALE: 0 1'-0" 2'-0" 4'-0"
1/2"=1'-0" @ Full Scale

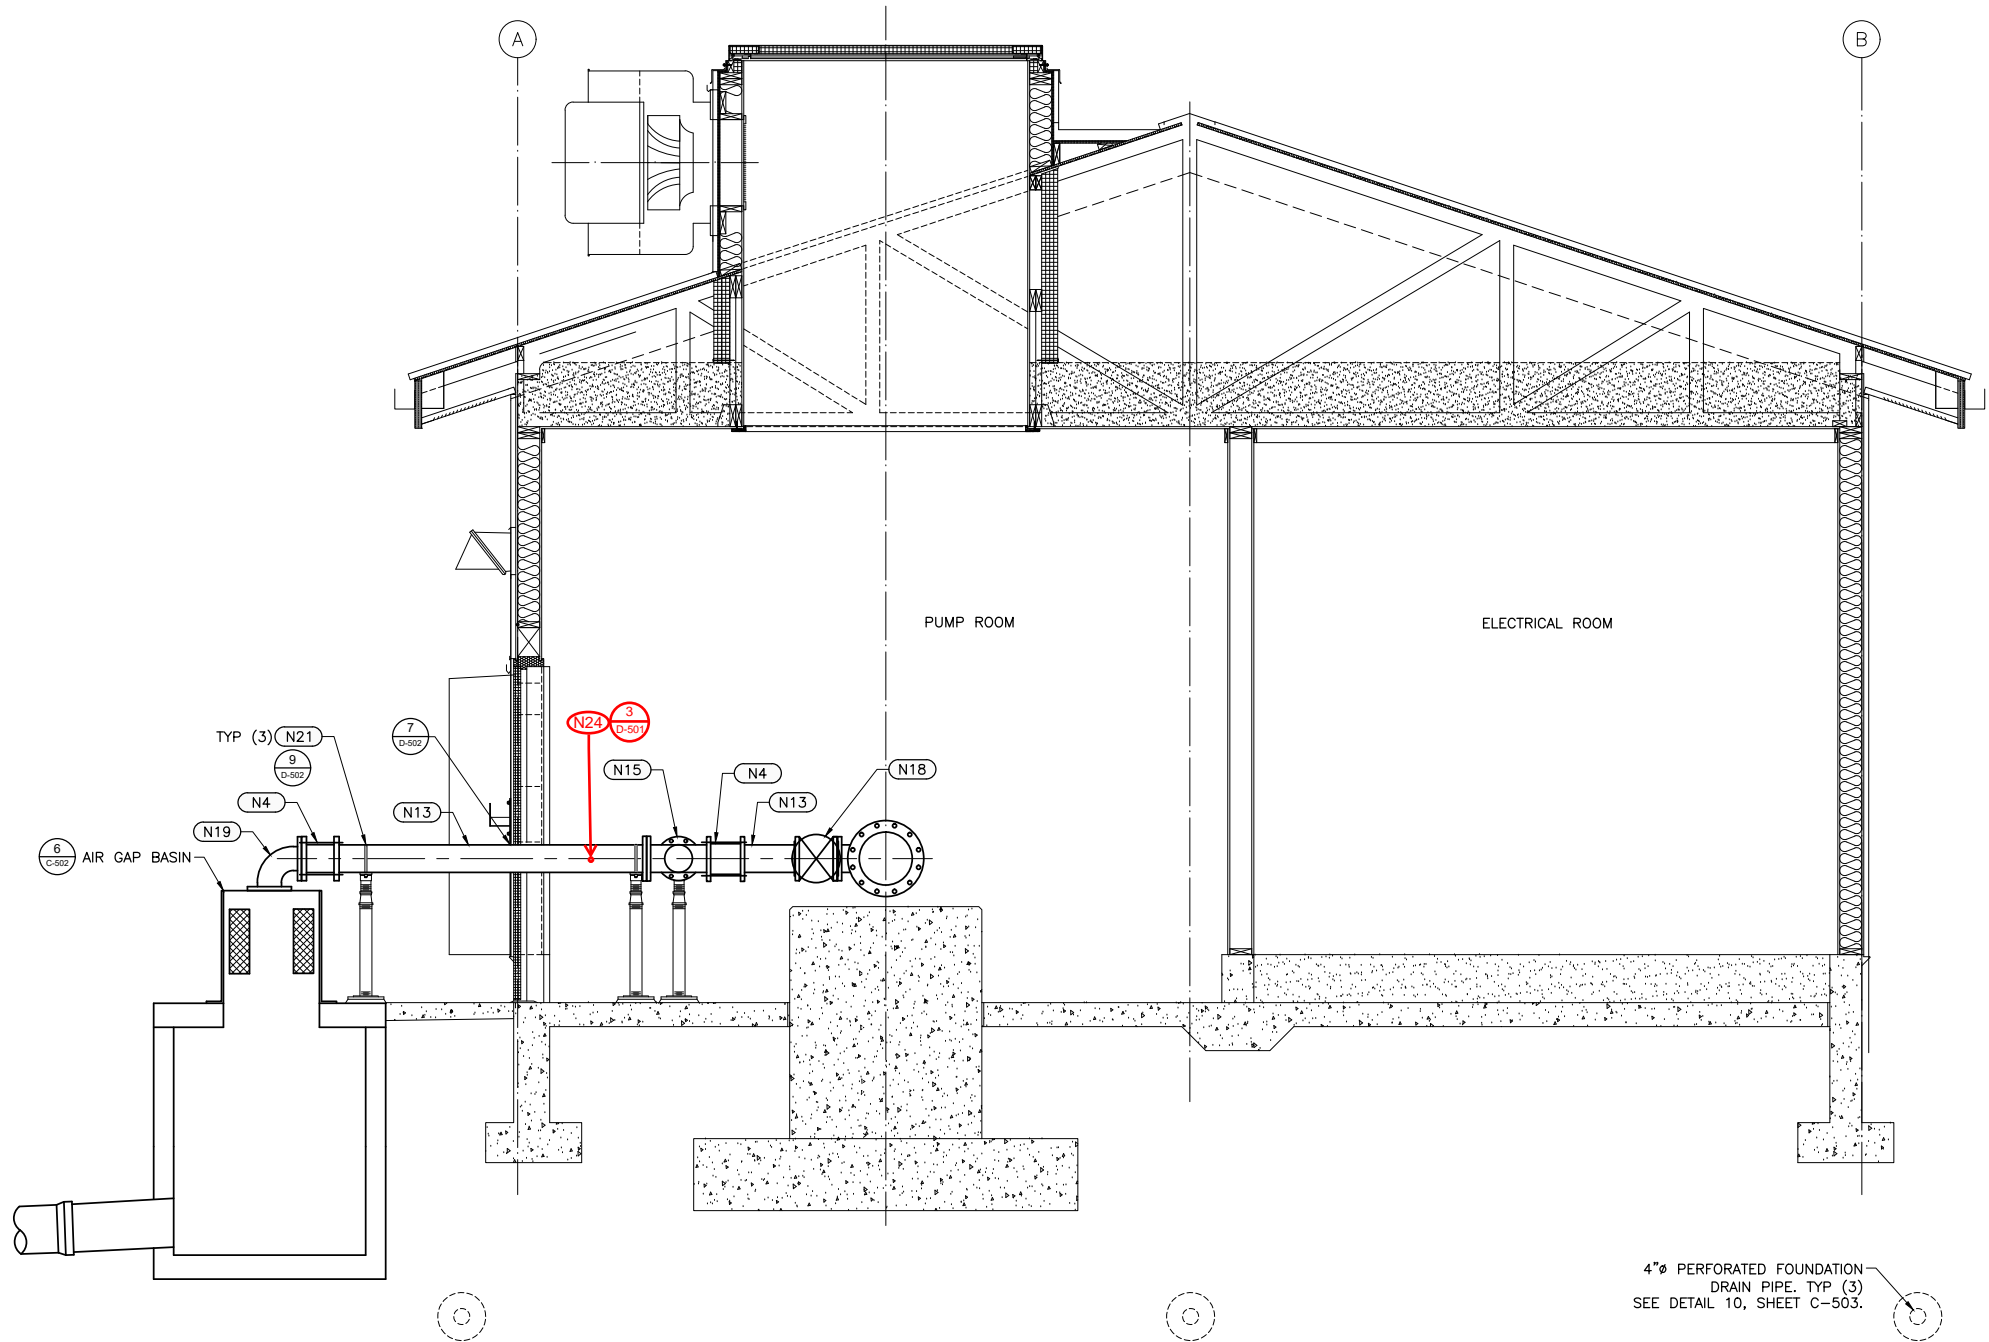

- NOTES:**
1. ALL MATERIALS IN CONTACT WITH POTABLE WATER SHALL BE NSF61 COMPLIANT.
 2. CONTRACTOR SHALL DESIGN FLOOR DRAIN SYSTEM AND SUBMIT TO ENGINEER FOR REVIEW. ROUTE FLOOR DRAINS TO CATCH BASIN. SYSTEM SHALL INCLUDE DRAINS, PIPE, CLEAN OUTS, AND VENTS TO MEET PLUMBING CODE.
 3. ABOVE GRADE PIPE SHALL BE PAINTED PER SPEC SECTION 09900 HIGH PERFORMANCE COATINGS.

KEYED NOTES:	
N1	WELL PUMP AND MOTOR
N2	12" EXPANSION JOINT
N3	12" DI PIPE, FLxPE.
N4	RESTRAINED FLANGED COUPLING ADAPTER
N5	2" DEEP WELL AIR/VAC VALVE
N6	WATER SERVICE ASSEMBLY
N7	12" GLOBE CHECK VALVE
N8	12"x12"x6" DI TEE
N9	12" MAGNETIC FLOW METER
N10	12" DI 90° BEND
N11	HOSE BIBB AND RACK
N12	PUMP MOTOR TERMINAL BOX
N13	6" DI PIPE, FLxPE.
N14	FLEXIBLE TYPE COUPLING w/ RESTRAINED JOINTS
N15	6"x6"x6" DI TEE
N16	12" DI PIPE, FLxFL.
N17	6" DI PIPE, FLxFL.
N18	6" GATE VALVE
N19	6" DI 90° BEND
N20	6" PRESSURE RELIEF VALVE
N21	PIPE SUPPRT
N22	FLOOR DRAIN
N23	1" AIR/VAC VALVE
N24	1/2" SMOOTH NOSED SAMPLE PORT
N25	12" BUTTERFLY VALVE
N26	SAFTFLOW CHEMICAL INJECTION QUILL MODEL DB-146-S-S-6-B-E. ADDITIONAL FITTINGS TO CONNECT TO 1/2" TUBING AS NEEDED.
N27	1/2" POLYETHYLENE TUBE CHEMICAL INJECTION LINE WITH COMPRESSION FITTINGS AND/OR CONE TO TIE-IN TO PVC DISCHARGE LINE, AND INJECTION QUILL. RUN IN INDUSTRIAL GRADE RIGID FLOOR RAMP.
N28	1/2" PVC CHEMICAL PIPE
N29	HONEYWELL FENDALL PURE FLOW 1000 GRAVITY EMERGENCY EYEWASH STATION, OR APPROVED EQUAL. PROVIDE ONE COMPLETE REPLACEMENT SET OF SALINE CARTRIDGES.



J-U-B ENGINEERS, INC.

J-U-B ENGINEERS, INC.

201 South Jackson Street
Moscow, ID 83843

Phone: 208.746.9010
www.jub.com

REUSE OF DRAWINGS J-U-B SHALL RETAIN ALL COMMON LAW, STATUTORY, COPYRIGHT AND OTHER RIGHTS IN ALL DRAWINGS, SPECIFICATIONS AND OTHER DOCUMENTS. NO PART OF ANY DRAWING OR SPECIFICATION SHALL BE REPRODUCED OR TRANSMITTED IN ANY FORM OR BY ANY MEANS, ELECTRONIC OR MECHANICAL, INCLUDING PHOTOCOPYING, RECORDING, OR BY ANY INFORMATION STORAGE AND RETRIEVAL SYSTEM, WITHOUT THE WRITTEN CONSENT OF J-U-B ENGINEERS, INC. ANY REUSE WITHOUT WRITTEN CONSENT BY J-U-B WILL BE AT CLIENT'S SOLE RISK AND WITHOUT LIABILITY OR LEGAL EXPOSURE TO J-U-B.		REVISION	
		NO.	DESCRIPTION
WELL NO. 7 WELL COMPLETION		BY	DATE
		APR	



PROCESS MECHANICAL (D)
WELL HOUSE SECTION VIEW

FILE: 21-20-007_D-301X
JUB PROJ. #: 21-20-007
DRAWN BY: ARB
DESIGN BY: BK
CHECKED BY: DLW
AT FULL SIZE, IF NOT ONE INCH, SCALE ACCORDINGLY
LAST UPDATED: 5/24/2021

SHEET NUMBER:
D-302


KEYED NOTES:

- N1 COMBINATION AIR/VACUUM OR AIR RELEASE VALVE.
- N2 BALL VALVE, SIZE TO MATCH PIPING.
- N3 PROCESS PIPE.
- N4 AIR GAP, MIN. (2) DIAMETERS OR 2".
- N5 SCH. 40 GALV STEEL PIPE, ROUTE TO NEAREST DRAIN AND SUPPORT, AS REQUIRED.
- N6 DUCTILE IRON SERVICE SADDLE WITH SS HARDWARE SIZE TO MATCH PROCESS PIPE AND VALVE SIZE.
- N7 #2 STAINLESS STEEL MESH SCREEN ON OUTLET.
- N8 SCH. 40 GALV STAIN STEEL NIPPLE, TYP.
- N9 THREAD NIPPLE INTO FACTORY TAP.

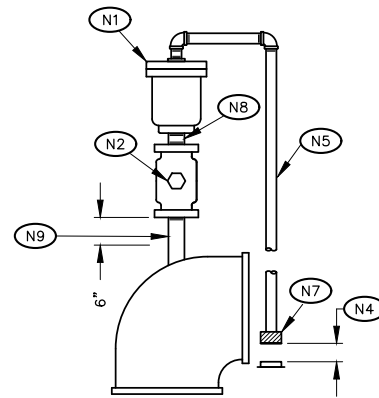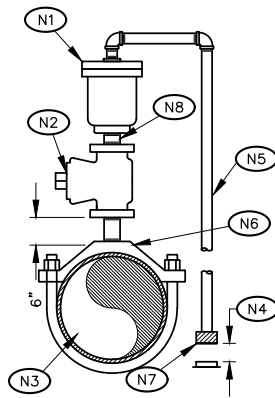


AIR & VAC VALVE ON FITTING

1 AIR & VAC VALVE
NOT TO SCALE

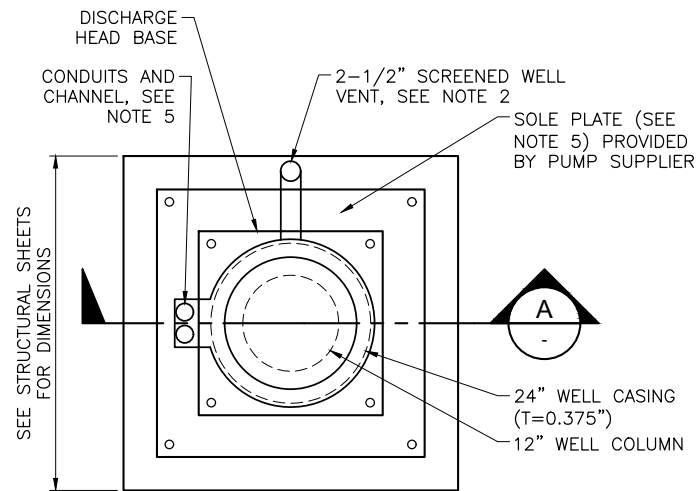

PLAN VIEW

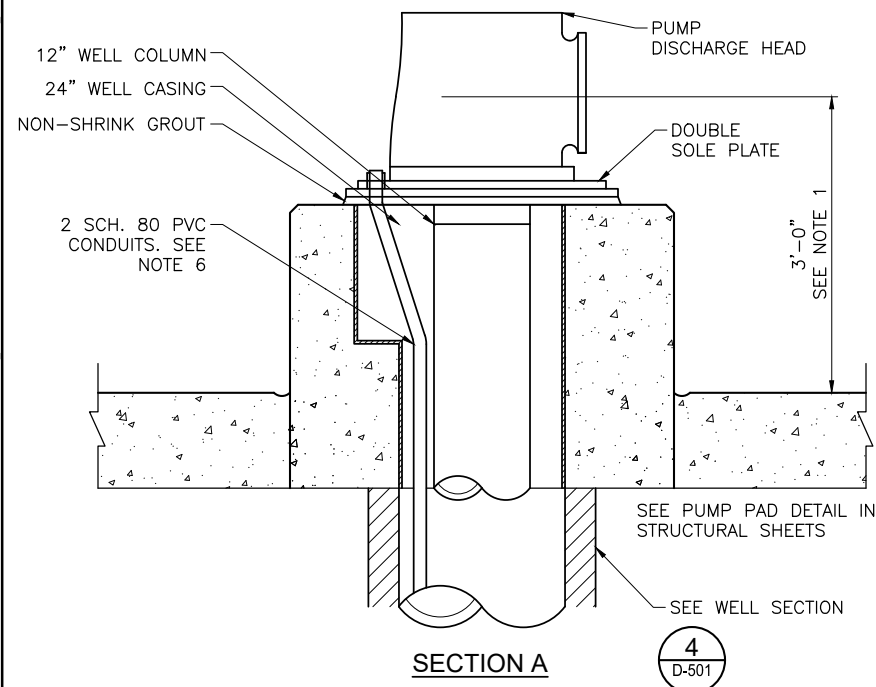

SECTION A


4
D-501

NOTES:


1. PROVIDE CONCRETE PUMP PAD AT ELEVATION REQUIRED TO MATCH 12" DISCHARGE PIPE CENTERLINE ELEVATION OF 3'-0" ABOVE WELL HOUSE FLOOR.
2. ROUTE AND WELD 2 1/2" STEEL PIPE TO PROVIDE CLEAR OPENING BETWEEN WELL CASING AND VENT. PROVIDE 2 1/2" VENT WITH 24 MESH STAINLESS STEEL SCREEN LOCATED AT LEAST 18" MINIMUM ABOVE FLOOR. ADJUST VENT LOCATION AS NECESSARY TO PROVIDE CONCRETE REINFORCEMENT AS REQUIRED.
3. CASING SHALL EXTEND A MINIMUM OF 12" ABOVE FLOOR.
4. A WATERTIGHT SEAL SHALL BE PROVIDED AT TOP OF WELL CASING. A WATERTIGHT SEAL SHALL ALSO BE PROVIDED BETWEEN SOLE PLATE AND DISCHARGE HEAD PER MANUFACTURERS RECOMMENDATION.
5. CONTRACTOR TO COORDINATE WITH PUMP AND SOLE PLATE SUPPLIER TO PROVIDE CONDUITS AND STEEL CONDUIT CHANNEL AS SHOWN. PROVIDE THREADED CAPS FOR CONDUITS.
6. PROVIDE (2) 1-1/2" SCHEDULE 80 PVC FLUSH THREAD PIPE CONDUITS, ATTACHED TO PUMP COLUMN WITH 2 STAINLESS STEEL STRAPS EVERY 10 FEET OF COLUMN FOR ENTIRE LENGTH OR AS DIRECTED BY ENGINEER.

NOTE:

COORDINATE WITH OWNER FOR FINAL LOCATION AND ORIENTATION

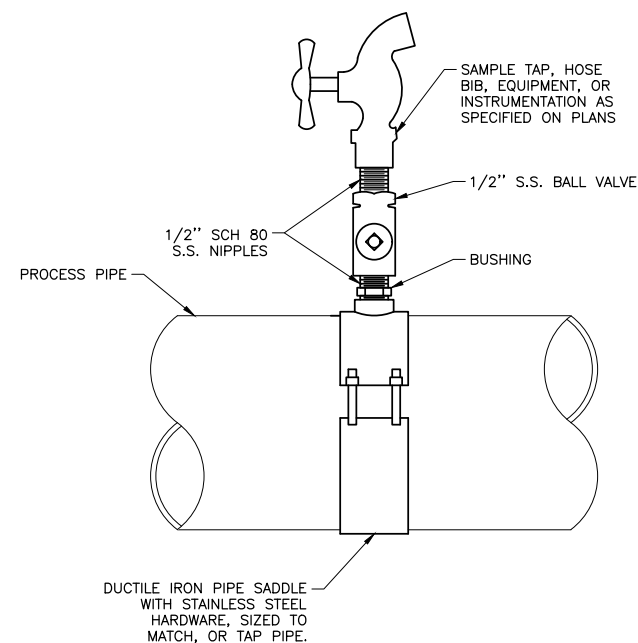


3 HALF INCH SMOOTH NOSED SAMPLE PORT
NOT TO SCALE

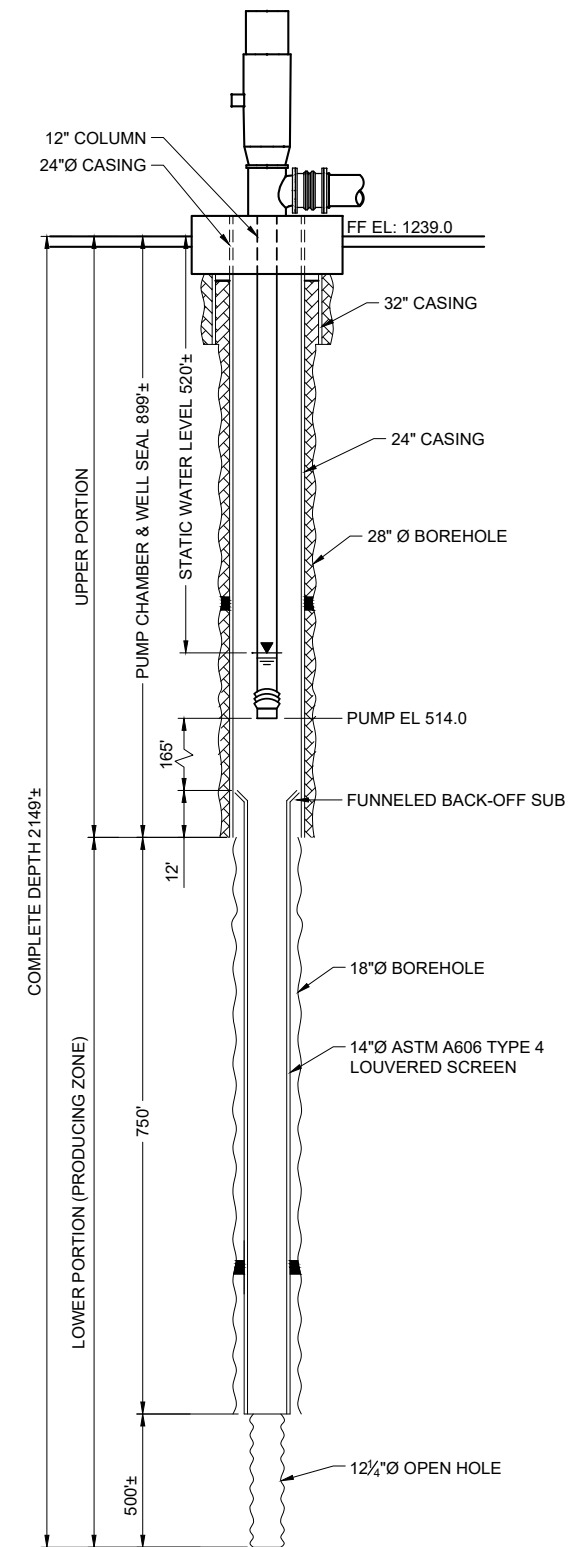


4 WELL SECTION
NOT TO SCALE

NOTE:


1. POTABLE WATER PIPE PENETRATIONS SHALL BE PER APPLICABLE PLUMBING CODE REQUIREMENTS.
2. NO FITTINGS BENEATH SLAB. 2" CLR. MIN. 4" CLR. MAX.

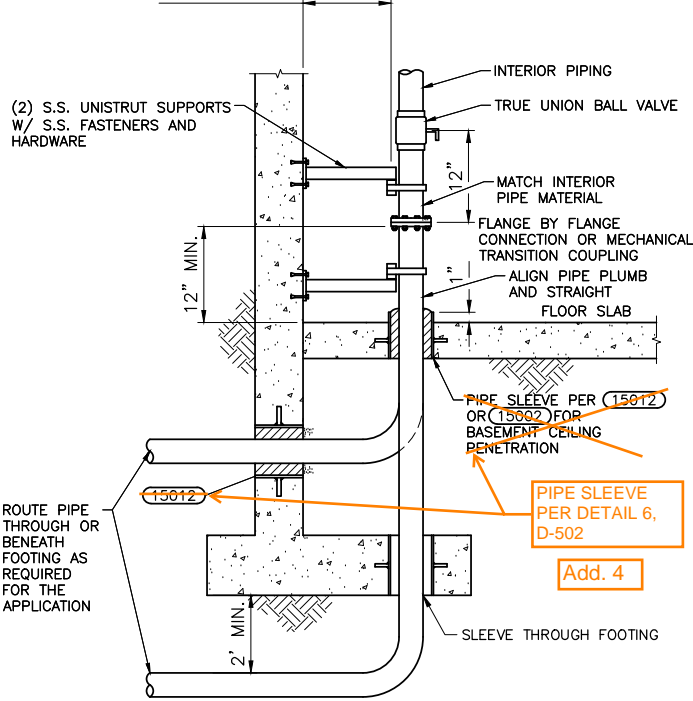


5 TRANSITION THROUGH FLOOR SLAB SMALL DIAMETER PIPE
NOT TO SCALE

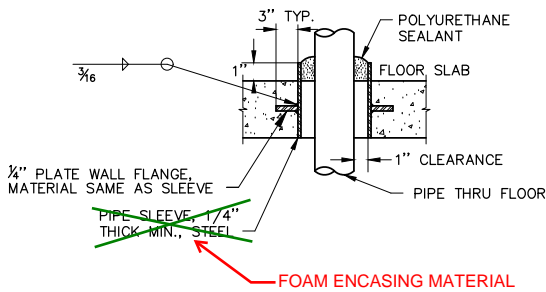

6 FLOOR PIPE SLEEVE
NOT TO SCALE

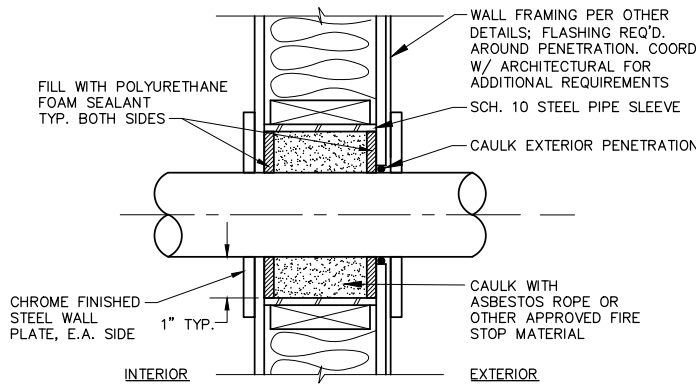

7 PIPE PENETRATION THROUGH FRAMED WALL
NOT TO SCALE

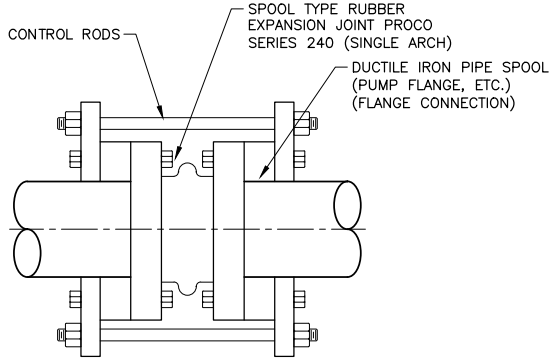


- NOTES:
1. EXPANSION JOINT FITTING SHALL BE NSF 61 COMPLIANT AND BE RATED FOR 250psi SYSTEM PRESSURE.

8 PIPE EXPANSION JOINTS
NOT TO SCALE


ADJUSTABLE PIPE SUPPORT APPROXIMATE DIMENSIONS IN INCHES					
PIPE SIZE	A	B	C	D MINIMUM	D MAXIMUM
2½	2½	1½	9	8	11½
3	2½	1½	9	8½	11¾
3½	2½	1½	9	8½	12
4	3	*2½	9	10¼	14
6	3	*2½	9	11¾	15¼
8	3	*2½	9	13¾	16½
10	3	*2½	9	14¾	18¼
12	3	*2½	9	15¾	19¾
14	4	3	11	18¾	20¾
16	4	3	11	19¾	22¼
18	6	3½	13½	21¼	24
20	6	3½	13½	23¼	25½
24	6	4	13½	26½	28½
30	6	4	13½	29¾	31½
32	6	4	13½	30¾	32¾
36	6	4	13½	32¾	34¾

* SEE MFR.


SIZES 4" THRU 12"

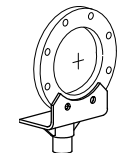

SIZES 14" THRU 36"

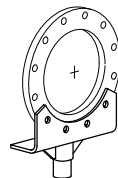


FLANGE SUPPORT

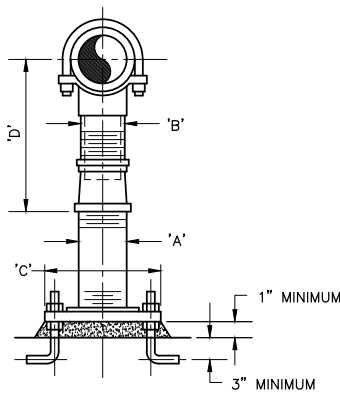

9 PIPE SUPPORT - ADJUSTABLE AND MAXIMUM PIPE SUPPORT SPACING
NOT TO SCALE


		PIPE SIZE (INCHES)																					
MAXIMUM SPAN (FEET)	TYPE OF PIPE	½	¾	1	1½	2	2½	3	3½	4	6	8	10	12	14	16	18	20	24	30			
	STEEL OR DUCTILE IRON	5	6	7	9	10	11	12	13	14	17	19	22	23	25	27	28	30	30	30			
	PVC SCHEDULE 40	4½	4½	5	5½	5½	6½	7	7	7	8	8½	9	10½									
	PVC SCHEDULE 80	4½	5	5½	6	6½	7½	7½	8	8½	9½	10½											
	COPPER & BRASS TUBING	5	6	6	8	9	10	10	11	12													
	HANGER DIAMETER FOR GIVEN PIPE SIZE (INCHES)																						
HANGER ROD	¾	¾	¾	¾	¾	½	½	½	¾	¾	¾	1	1¼	1¼	1¼	1¼	1½	1½	2				

- NOTES:
1. IT IS RECOMMENDED THAT CONTINUOUS SUPPORT BE USED WHEN INDIVIDUAL SUPPORT SPACING BECOMES ECONOMICALLY PROHIBITIVE.
2. PIPE SUPPORT DATA FOR PIPES NOT LISTED SHALL BE SUBMITTED TO THE ENGINEER FOR APPROVAL.
3. PROVIDE ADDITIONAL SUPPORTS AT ALL PIPE BENDS, TEES, PLUGS AND ON EACH SIDE OF ALL FLEXIBLE PIPE JOINTS (2/JOINT).
4. THE CHART DOES NOT INCLUDE CONCENTRATED LOAD SUPPORTS. PROVIDE ADDITIONAL SUPPORTS AT ALL VALVES, CHECKS, CONTROL VALVES AND OTHER CONCENTRATED LOAD AREAS.

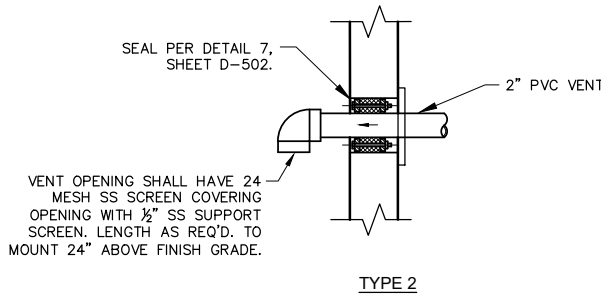


10 VENT
NOT TO SCALE

REVISION		DATE	
NO.	DESCRIPTION	BY	DATE

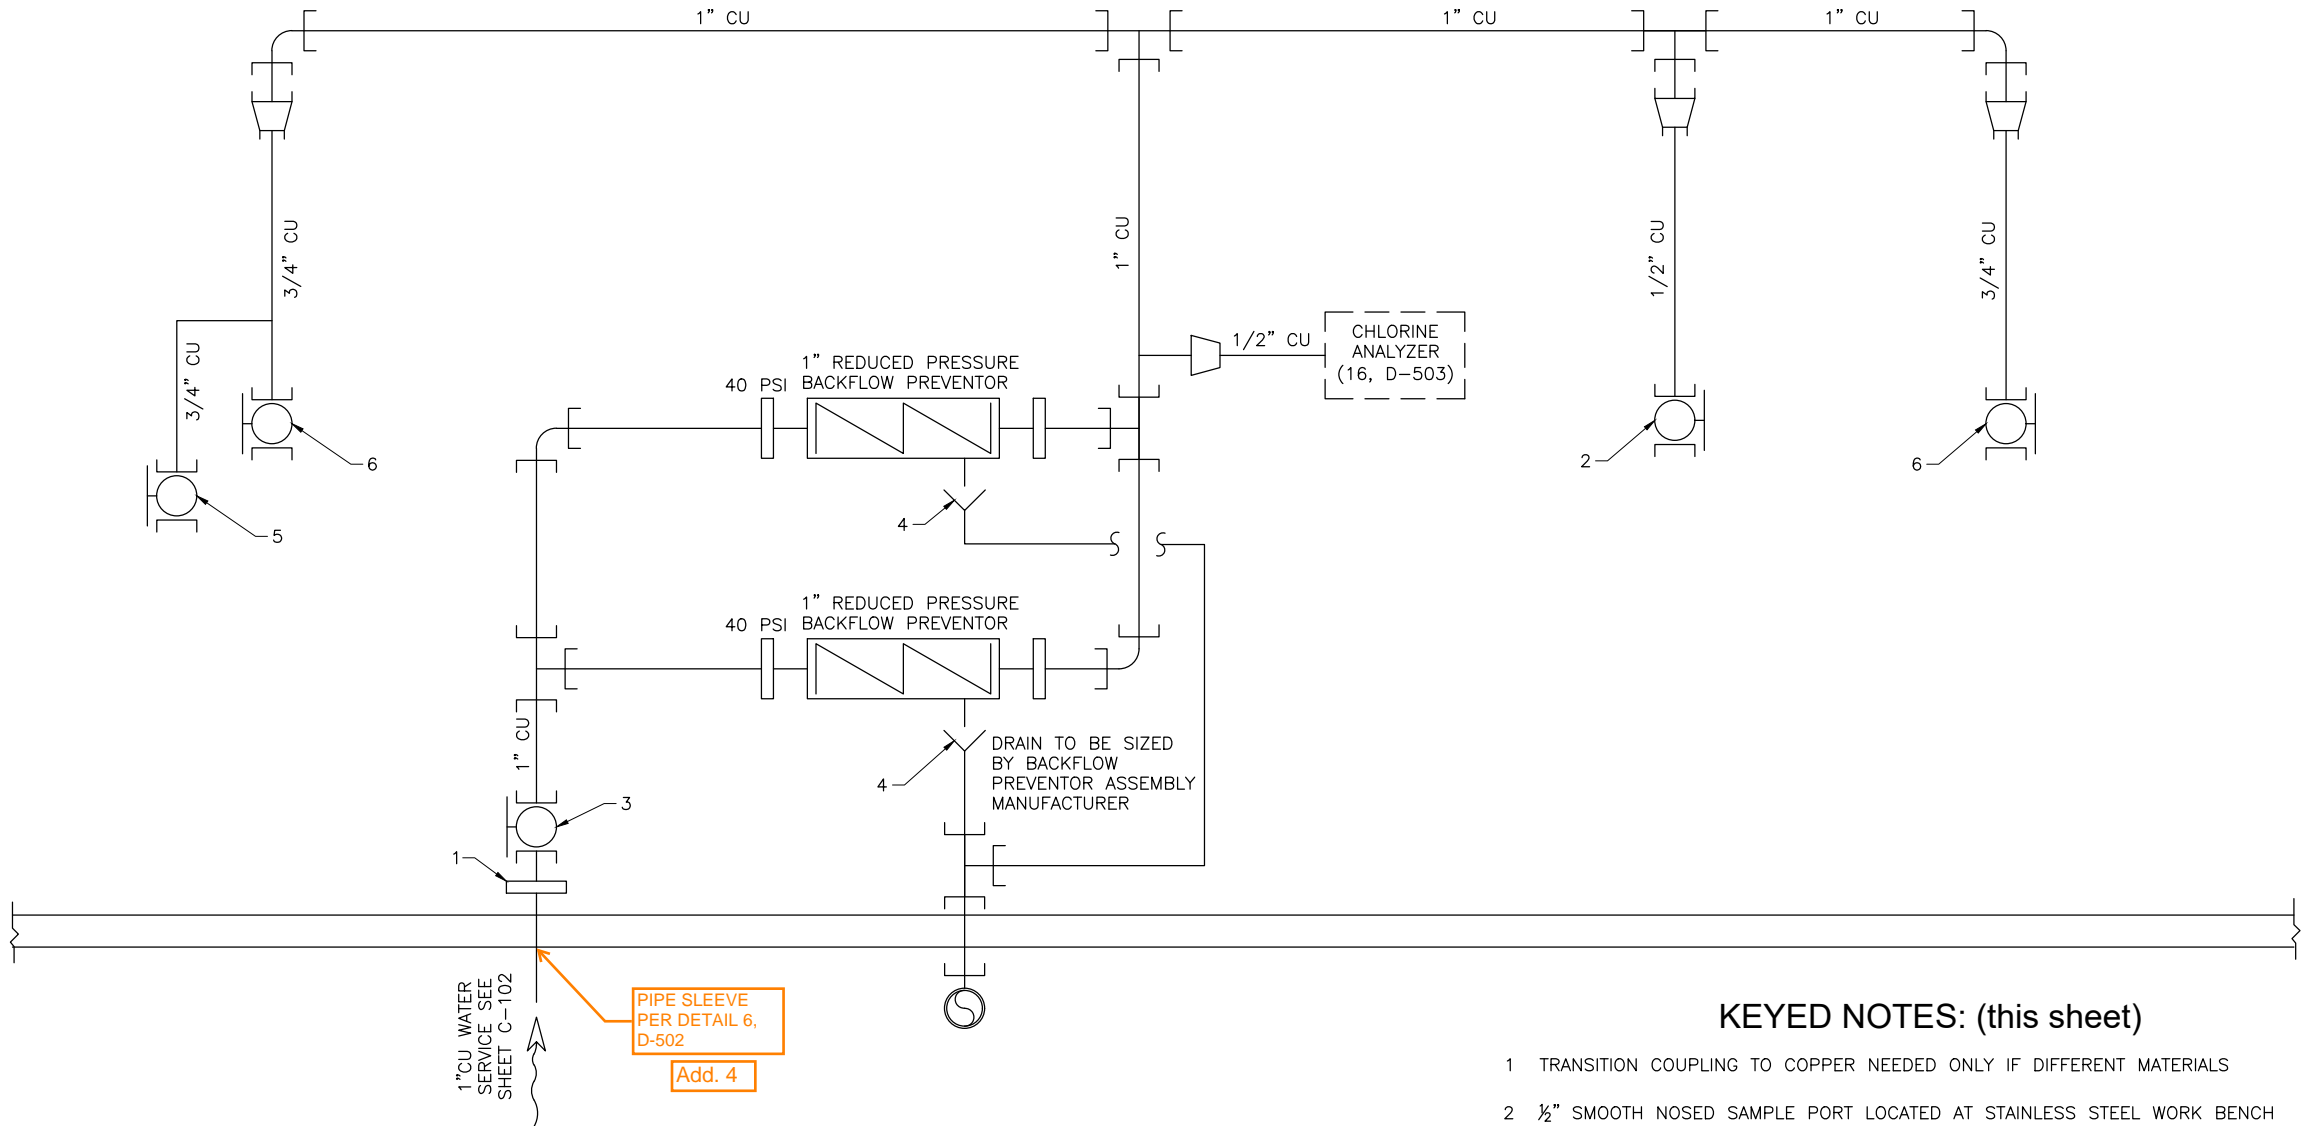

KEYED NOTES: (this sheet)

- 1 TRANSITION COUPLING TO COPPER NEEDED ONLY IF DIFFERENT MATERIALS
- 2 1/2" SMOOTH NOSED SAMPLE PORT LOCATED AT STAINLESS STEEL WORK BENCH
- 3 ISOLATION BALL VALVE
- 4 AIR GAP
- 5 TYPE 4 HOSE BIBB; EXTERIOR. SEE LOCATION ON PLANS.
- 6 TYPE 5 HOSE BIBB; INTERIOR. SEE LOCATION ON PLANS.



J-U-B ENGINEERS, INC.

J-U-B ENGINEERS, INC.
201 South Jackson Street
Moscow, ID 83843

Phone: 208.746.9010
www.jub.com

REUSE OF DRAWINGS

J-U-B SHALL RETAIN ALL COMMON LAW, STATUTORY, COPYRIGHT AND OTHER RIGHTS IN ALL DRAWINGS, SPECIFICATIONS AND OTHER DOCUMENTS PREPARED BY J-U-B. NO PART OF ANY DRAWING OR SPECIFICATION SHALL BE REPRODUCED OR TRANSMITTED IN ANY FORM OR BY ANY MEANS, ELECTRONIC OR MECHANICAL, INCLUDING PHOTOCOPYING, RECORDING, OR BY ANY INFORMATION STORAGE AND RETRIEVAL SYSTEM, WITHOUT THE WRITTEN CONSENT OF J-U-B. ANY REUSE WITHOUT WRITTEN CONSENT BY J-U-B WILL BE AT CLIENT'S SOLE RISK AND WITHOUT LIABILITY OR LEGAL EXPOSURE TO J-U-B.

REVISION		NO.	DESCRIPTION	BY	DATE

WELL NO. 7
WELL COMPLETION

PROCESS MECHANICAL (D)
WATER SERVICE SCHEMATIC

FILE : 21-20-007_D-504
JUB PROJ. # : 21-20-007
DRAWN BY: ARB
DESIGN BY: BK
CHECKED BY: DLW

ONE INCH
AT FULL SIZE, IF NOT ONE
INCH, SCALE ACCORDINGLY

LAST UPDATED: 5/24/2021

SHEET NUMBER:
D-504

INSTRUMENT LINE SYMBOLS

	PROCESS OR DEVICE CONNECTION
	ELECTRICAL SIGNAL
	ANALOG MILLIAMPER SIGNAL
	SOFTWARE OR DATA LINK
	RADIO, SONIC, ELECTROMAGNETIC, OR OPTICAL SIGNAL
	PNEUMATIC SIGNAL
	HYDRAULIC SIGNAL
	CAPILLARY TUBE
	MULTI-CONDUCTORS OR MANUFACTURES' CABLE
	FIBER OPTIC
	ETHERNET

INSTRUMENT FUNCTION SYMBOLS

DISCRETE DEVICES		NON-ADJUSTABLE OR NOT ACCESSIBLE
		ADJUSTABLE BUT NOT ACCESSIBLE TO OPERATOR
		ADJUSTABLE OR ACCESSIBLE TO OPERATOR
PRIMARY SHARED DISPLAY OR SHARED CONTROL FUNCTION TYPICALLY LOCATED AT MCC OR EQUIPMENT CONTROL PANEL		NON-ADJUSTABLE OR NOT ACCESSIBLE
		ADJUSTABLE BUT NOT ACCESSIBLE TO OPERATOR
		ADJUSTABLE OR ACCESSIBLE TO OPERATOR
ALTERNATE SHARED DISPLAY OR SHARED CONTROL FUNCTION TYPICALLY LOCATED AT LOCAL CONTROL PANEL PLC I/O AND FUNCTIONS		NON-ADJUSTABLE PLC FUNCTION
		PROGRAMMER ADJUSTABLE PARAMETERS NOT ACCESSIBLE TO OPERATOR
		OPERATOR ADJUSTABLE SETPOINTS THROUGH PLC INPUT PANEL
COMPUTER SYSTEMS, TYPICALLY THE PLANT SCADA SUPERVISORY AND CONTROL FUNCTIONS		NON-ADJUSTABLE SCADA FUNCTION
		PROGRAMMER ADJUSTABLE PARAMETERS NOT ACCESSIBLE TO OPERATOR
		OPERATOR ADJUSTABLE SETPOINTS THROUGH SCADA INPUT PANEL
		INTERLOCK LOGIC OR SEQUENTIAL CONTROL
		PILOT LIGHT
		MOTOR OR DEVICE
AAA - FUNCTION BBB - SYSTEM CCC - LOOP NUMBER DDD - DESCRIPTION		

FIRST LETTER	SUCCEEDING LETTER	A						C	E	G	I	L	Q	R	S						T		Y	V, Z			SPECIAL IDENTIFICATION							
		ALARM	HIGH-HIGH ALARM	HIGH ALARM	LOW ALARM	LOW-LOW ALARM	SENSOR FAULT ALARM								BLIND CONTROLLER	INDICATING CONTROLLER	SENSOR (PRIMARY ELEMENT)	GLASS	INDICATOR	PILOT LIGHT	TOTALIZER	RECORD		SWITCH	HIGH-HIGH SWITCH	HIGH SWITCH			LOW SWITCH	LOW-LOW SWITCH	BLIND TRANSMITTER	INDICATING TRANSMITTER	SOLENOID VALVE (PILOT), RELAY, COMPUTATION, CONVERTER	CONTROL VALVE
																											SYMBOL	DESCRIPTION						
A	ANALYSIS	AA	AAHH	AAH	AAL	AALL	AAT	AC	AIC	AE		AI	AL		AR	AS	ASHH	ASH	ASL	ASLL	AT	AIT	AY	ACV	AV	AZ								
B	BURNER, COMBUSTION																																	
C	USER'S CHOICE																																	
D	USER'S CHOICE																																	
E	VOLTAGE	EA	EAHH	EAH	EAL	EALL	EAT	EC	EIC	EE		EI	EL		ER	ES	ESHH	ESH	ESL	ESLL	ET	EIT	EY			EZ								
F	FLOW	FA	FAHH	FAH	FAL	FALL	FAT	FC	FIC	FE	FG	FI	FL	FQI	FR	FS	FSHH	FSH	FSL	FSLL	FT	FIT	FY	FCV	FV		FO	ORIFICE PLATE						
FF	FLOW RATIO	FFAF	FAHH	FFAH	FFAL	FFALL		FFC	FFIC			FFI			FFR	FFS	FFSHH	FFSH	FFSL	FFSLL			FFY	FFCV										
G	USER'S CHOICE																																	
H	HAND	HA						HC	HIC				HL		HS									HCV	HV		HMS	PUSH BUTTON SWITCH						
I	CURRENT (ELECTRICAL)	IA	IAHH	IAH	IAL	IALL	IAT	IC	IIC	IE		II	IL		IR	IS	ISHH	ISH	ISL	ISLL	IT	IIT	IY			IZ								
J	POWER	JA	JSHH	JAH	JAL	JALL	JAT	JC	JIC	JE		JI	JL	JQI	JR	JS	JSHH	JSH	JSL	JSLL	JT	LIT	JY			JZ								
K	TIME SCHEDULE	KA										KI	KL			KS							KY											
KQ	TIME TOTAL	KQAK	QAHH	KQAH	KQAL	KQALL						KQI	KQL	KQR	KQS	KQSHH	KQSH	KQSL	KQSLL															
L	LEVEL	LA	LAHH	LAH	LAL	LALL	LAT	LC	LIC	LE	LG	LI	LL		LR	LS	LSHH	LSH	LSL	LSLL	LT	LIT	LY	LCV	LV									
M	MOISTURE			MAH												MS																		
N	SAFETY															NS																		
O	USER'S CHOICE																																	
P	PRESSURE OR VACUUM	PA	PAHH	PAH	PAL	PALL	PAT	PC	PIC			PI	PL		PR	PS	PSHH	PSH	PSL	PSLL	PT	PIT	PIT	PY	PV	PSV		PRESSURE SAFETY VALVE						
PD	PRESSURE DIFFERENTIAL	PDAP	PDAHH	PDAH	PDAL	PDALL	PDAT	PDC	PDIC			PDI	PDL		PDR	PDS	PDSHH	PDSH	PDSL	PDSLL	PDT	PDT	PDY	PDCV										
Q	QUANTITY													QQI																				
R	RADIATION																																	
S	SPEED OR FREQUENCY	SA	SAHH	SAH	SAL	SALL	SAT	SC	SIC	SE		SI	SL		SR	SS	SSHH	SSH	SSL	SSLL	ST	SIT	SY	SCV	SZ	SK		SPEED CONTROL STATION						
T	TEMPERATURE	TA	TAHH	TAH	TAL	TALL	TAT	TC	TIC	TE		TI	TL		TR	TS	TSHH	TSH	TSL	TSLL	TT	TIT	TY	TCV	TV	TZ	TW	THERMOWELL						
U	MULTI-VARIABLE																																	
V	VIBRATION OR MECH. ANALYSIS	VA	VAHH	VAH			VAT			VE		VI	VL		VR	VS	VSHH	VSH			VT	VIT	VY											
W	WEIGHT OR FORCE	WA	WAHH	WAH	WAL	WALL	WAT	WC	WIC	WE		WI	WL	WQI	WR	WS	WSHH	WSH	WSL	WSLL	WT	WIT	WY	WCV	WV	WZ								
X	UNCLASSIFIED																																	
Y	EVENT, STATE OR PRESENCE	YA										YI	YL		YR	YS																		
Z	POSITION OR DIMENSION	ZA	ZAO=OPEN	ZAC=CLOSE	ZAT	ZC	ZC	ZE	ZG	ZI	ZL		ZR	ZS	ZSO=OPEN	ZSC=CLOSE	ZT	ZT	ZY	ZCV	ZV	ZZ												


 

 
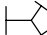

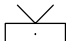






MECHANICAL EQUIPMENT SYMBOLS

	DIAPHRAGM PRESSURE SEAL		REDUCER
	CENTRIFUGAL PUMP		SUBMERSIBLE PUMP
	METERING PUMP		VERTICAL PUMP
	ROTARY LOBE PUMP		MIXER
	ROTARY LOBE BLOWER		SILENCER
	PROGRESSIVE CAVITY PUMP		STRAINER
	GEAR PUMP		COMPRESSOR
	POSITIVE DISPLACEMENT PUMP		GENERATOR
	ORIFICE PLATE		MOTOR
	STATIC MIXER		PULSATION DAMPNER

VALVE KEY

N.O.	N.C.	N.O.	N.C.
GATE VALVE		BUTTERFLY VALVE	
HAND OPERATED SLIDE GATE		DIAPHRAGM VALVE	
STOP GATE		COMBINATION AIR/VACUUM RELIEF VALVE	
CHECK VALVE		AIR RELIEF VALVE	
N.O.	N.C.		
PLUG VALVE		MUD VALVE	
N.O.	N.C.		
BALL VALVE		INJECTION QUILL	
REDUCED PRESSURE BACK FLOW PREVENTER		PRESSURE RELIEF VALVE	
SOLENOID ACTUATOR		PRESSURE REDUCING REGULATOR	
WEIR GATE		BACK PRESSURE REGULATOR	
MOTOR OPERATED ACTUATOR			

 MISCELLANEOUS

EQUIPMENT TAG		XX-XX-XXX-X		N-NEW F-FUTURE E-EXISTING R-RELOCATED		EQUIPMENT STATUS
		LINE NUMBER		CONTINUATION SHEET		
X		XX		LINE CONTINUATION		
MISC.				METERS		
		FLOAT				MAGNETIC FLOWMETER
		UNION				ULTRASONIC FLOWMETER
		FIRE DEPARTMENT CONNECTION				TURBINE FLOWMETER
		DRAIN				PADDLE WHEEL METER
		FLEXIBLE LINK				VARIABLE AREA FLOWMETER
		ANEROID BELLOWS				OPEN CHANNEL FLUME
		CALIBRATION COLUMN				


RECORD DRAWING

Plot Date: 12/5/2022 9:37 AM Plotted By: Ted Schawender
Date Created: 12/1/2022 3:03 PM JUB-LEWISTON WELL 7 DRAWINGS RECORD DRAWINGS M19102-I002.DWG

4.1

PIPING AND INSTRUMENTATION DIAGRAM

NOT TO SCALE

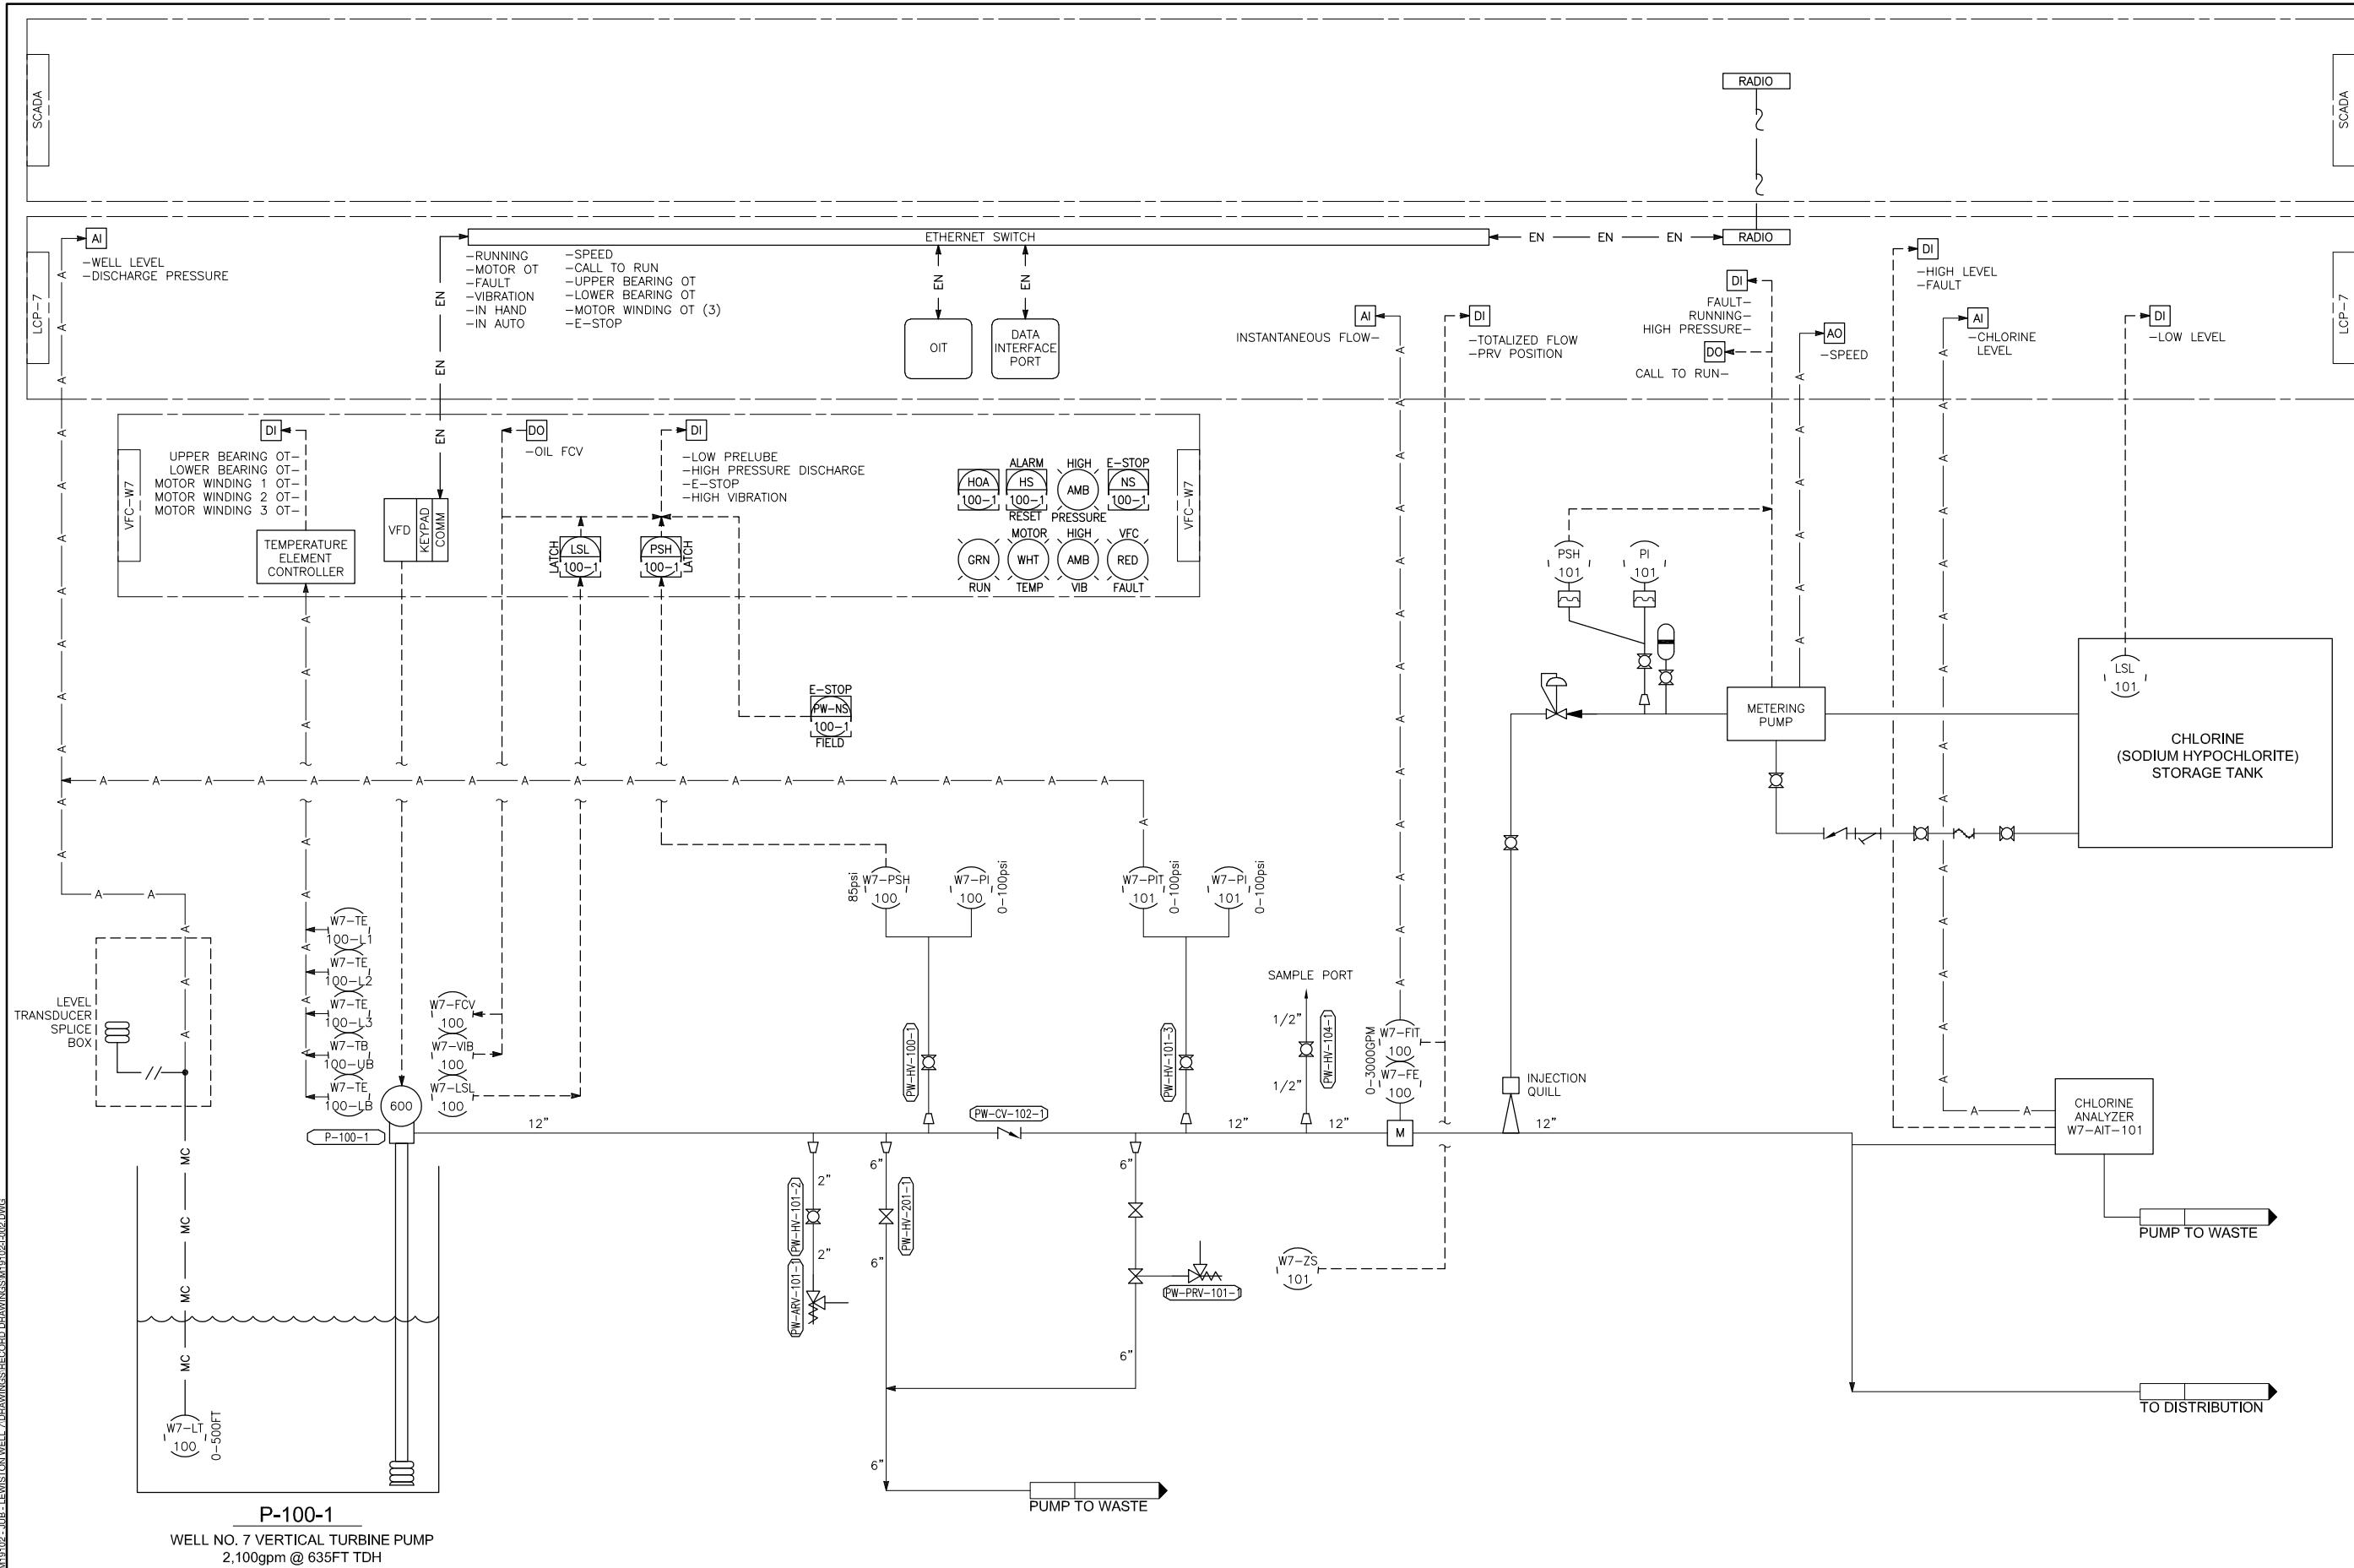

RECORD DRAWING

1038 W. Davidson Avenue
Coeur d'Alene, ID 83814
(208) 666-4021 office
(208) 666-4021 fax

JUB
J-U-B ENGINEERS, INC.

AEI
Engineering
Incorporated

J-U-B ENGINEERS, INC.
1630 23rd Ave.
Suite 1101-A
Lewiston, ID 83501
Phone: 208.746.9010
Fax: 208.746.9926
www.jub.com

PROFESSIONAL ENGINEER
18028
STATE OF IDAHO
SCOTT R. JACOBSON

12/01/22

REUSE OF DRAWINGS
THIS DOCUMENT AND THE IDEAS AND DESIGNS INCORPORATED HEREIN AS AN INSTRUMENT OF PROFESSIONAL SERVICE ARE THE PROPERTY OF JUB ENGINEERS, INC. AND ARE NOT TO BE REPRODUCED, COPIED, OR USED IN WHOLE OR PART, FOR ANY OTHER PROJECT WITHOUT THE EXPRESS WRITTEN AUTHORIZATION OF JUB ENGINEERS, INC.

REVISION	DATE
1	12/01/22
2	06/02/21
3	05/28/21
4	04/28/21
5	04/28/21
FILE: M19102-I002

JUB PROJ. #:

DRAWN BY: TLS

DESIGN BY: SRJ

CHECKED BY: RJW

AT FULL SIZE, IF NOT ONE INCH, SCALE ACCORDINGLY

LAST UPDATED: 12/01/22

SHEET NUMBER:

I-002

CITY OF LEWISTON
WELL NO. 7


PIPING AND INSTRUMENTATION DIAGRAM

ELECTRICAL LEGEND													
SYMBOL		DESCRIPTION		SYMBOL		DESCRIPTION		ABBREVIATIONS		REFERENCE SYMBOLS			
	LED LUMINAIRE, SURFACE MOUNTED ON CEILING WITH EMERGENCY BATTERY PACK		CONDUIT CONCEALED IN WALLS OR CEILINGS WHERE POSSIBLE		GROUND ROD IN GROUND ROD BOX		TRANSFORMER, PLAN VIEW SHOWN TO SCALE	AAMP – AMPERE AL – ALARM AC – AIR COMPRESSOR AF – AMPERE FRAME AFF – ABOVE FINISHED FLOOR AFG – ABOVE FINISHED GRADE AFS – AMPERE FUSE AI – ANALOG INPUT POINT (PLC) AIC – AMPS INTERRUPTING CAPACITY AIL – AMBER INDICATING LIGHT ALT – ALTERNATOR AO – ANALOG OUTPUT POINT (PLC) AS – AMPERE SWITCH AT – AMPERE TRIP ATS – AUTOMATIC TRANSFER SWITCH BC – BATTERY CHARGER BH – BLOCK HEATER BIL – BLUE INDICATING LIGHT BP – BYPASS CONTACTOR C – CONDUIT (GRS) CB – CIRCUIT BREAKER CGD – COMBUSTIBLE GAS DETECTOR CP – CONTROL PANEL CPT – CONTROL POWER XFMR CT – CURRENT TRANSFORMER CTL – CONTROL CV – CHECK VALVE DB – DIRECT BURIED DE – DOUBLE END D.E. – DEAD END DEM – DEMAND DF – DEMAND FACTOR DI – AC DIGITAL INPUT POINT (PLC) DO – AC DIGITAL OUTPUT POINT (PLC) EF – EXHAUST FAN ESD – EMERGENCY SHUTDOWN ESS – EMERGENCY STOP SWITCH EXIST – EXISTING GFI – GROUND FAULT INTERRUPT GND – GROUND GIL – GREEN INDICATING LIGHT GRS – GALVANIZED RIGID STEEL H – HOT, HIGH HH – HAND HOLE HMI – HUMAN MACHINE INTERFACE HOA – HAND–OFF–AUTO HS – HAND SWITCH HTR – HEATER IC – INTRUSION SWITCH ISOL – ISOLATION CONTACTOR ISR – INTRINSICALLY SAFE RELAY KS – KEY SWITCH KVARH – KILOWATT HOUR KWH – KILOWATT HOUR L – LOW LCP – LOCAL CONTROL PANEL LS – LIMIT SWITCH N – NEUTRAL MCC – MOTOR CONTROL CENTER MCP – MAIN CONTROL PANEL MESR – MASTER EMERGENCY STOP RELAY MFGOR – MANUFACTURER MOV – MOTOR OPERATED VALVE MTR – MOTOR OFE – OWNER FURNISHED EQUIPMENT OIT – OPERATOR INTERFACE TERMINAL ORD – OXIDATION REDUCTION POTENTIAL P – PILOT LIGHT PBL – PUSH BUTTON – LIGHTED PB – PUSH BUTTON PFR – PHASE FAILURE RELAY PS – PRESSURE SWITCH PT – POTENTIAL TRANSFORMER PTZ – PAN, TILT, ZOOM PVC – POLY VINYL CHLORIDE (CONDUIT) PWR – POWER RHP – RADIANT HEAT PANEL RIL – RED INDICATING LIGHT RR – REMOTE RACK RTM – RUN TIME METER SA – SURGE ARRESTOR SIG – SIGNAL SPC – SHIELDED POWER CABLE SSOL – SOLID STATE OVERLOAD RELAY SS – SOLID STATE OR STAINLESS STEEL SV – SOLENOID VALVE STP – SHIELDED TWISTED PAIR STT – SHIELDED TWISTED THREE CONDUCTOR (TRIAD) T – THERMOSTAT TC – THERMOCOUPLE TDOE – TIME DELAY ON ENERGIZATION TDOO – TIME DELAY ON DE–ENERGIZATION TR – TRIP RELAY TNI – TELEPHONE NETWORK INTERFACE TVSS – TRANSIENT VOLTAGE SURGE SUPPRESSOR UH – UNIT HEATER UTP – UNSHIELDED TWISTED PAIR VFD – VARIABLE FREQUENCY DRIVE WIL – WHITE INDICATING LIGHT WP – WEATHER PROOF WR – WEATHER RESISTANT WS – TORQUE SWITCH PROOF XFMR – TRANSFORMER XP – EXPLOSION PROOF	PLAN	DESCRIPTION	ABBREVIATIONS	REFERENCE SYMBOLS	
	LED LUMINAIRE, SURFACE MOUNTED ON CEILING		CONDUIT UNDER FLOOR OR UNDERGROUND		TRANSFORMER, PLAN VIEW SHOWN TO SCALE		CURRENT TRANSFORMER, NUMBER INDICATES NUMBER OF C.T.'S. PLAN VIEW SHOWN TO SCALE		CONDUIT IDENTIFICATION				
	LED LUMINAIRE, RECESSED MOUNTED IN CEILING WITH EMERGENCY BATTERY PACK		EXISTING CONDUIT ROUTED UNDERGROUND		MOTOR, NUMBER INDICATES HORSEPOWER		OVERTEMPERATURE CUTOUT		DETAIL NUMBER OR SECTION LETTER				
	LED LUMINAIRE, RECESSED MOUNTED IN CEILING		UNDERGROUND UTILITY PRIMARY				LOCAL EQUIPMENT CONTROL PANEL – MCP, LCP, FACP		SHEET WHERE DETAIL IS TAKEN FROM				
	LED LUMINAIRE, WALL MOUNTED		UNDERGROUND PRIMARY POWER				SOLENOID VALVE		SECTION LETTER				
	LED EXIT SIGN, SHADED AREA INDICATES FACE. ARROW INDICATES DIRECTIONAL ARROW.		MC–HL CABLE WITH XP SEAL FITTINGS				MAGNETIC MOTOR STARTER (SS–SOLID STATE)		SHEET ON WHICH SECTION APPEARS				
	SPECIAL PURPOSE RECEPTACLE – AS NOTED		CONDUIT FLEXIBLE				MAGNETIC MOTOR STARTER W/ DISCONNECT		FIGURE OR PHOTO DETAIL NUMBER				
	DUPLEX RECEPTACLE Y=NOTATIONS FOR ALL RECEPTACLE TYPES: GFI = GROUND FAULT CIRCUIT INTERRUPTER (GFCI) HT = RECEPTACLE USED FOR HEAT TRACE WP = WEATHER PROOF COVER I = SOLATED GROUND C = CEILING MOUNTED RECEPTACLE +X"= INDICATES CENTERLINE MOUNTING HEIGHT ABOVE FINISHED FLOOR OR GRADE		HEAT TAPE ON PIPING				FULL VOLTAGE STARTER/NEMA SIZE MS = MOTOR STARTER CONTACT BP = BYPASS CONTACTOR IC = ISOLATION CONTACTOR		SHEET WHERE DETAIL IS TAKEN FROM				
	DATA OUTLET		MANUFACTURERS CORD/CABLE				DISCONNECT SWITCH, NON FUSED (60A) INDICATES AMPERAGE RATING X = NOTATIONS FOR ALL EQUIPMENT DISCONNECT TYPES: M = MOTOR RATED DISCONNECT SWITCH, EATON – ARROWHART #AHD530, OR APPROVED EQUAL		DETAIL AREA				
	THERMOSTAT		CONDUIT TURNED UP OR TOWARD				DISCONNECT SWITCH, FUSED 200 = SWITCH RATING, 100 = FUSE RATING		RECORD DRAWING				
	HUMIDISTAT		CONDUIT TURNED DOWN OR AWAY				TIME DELAYED CONTACTS (TIME DELAY TO OPEN) (TIME DELAY TO CLOSE)		ELECTRICAL LEGEND				
	PANELBOARD		CONDUIT CAPPED				INDICATING LIGHT: A = AMBER G = GREEN W = WHITE B = BLUE R = RED		SYMBOL DESCRIPTION				
	TERMINAL		CONDUIT SEALS. CLASS 1. DIV.1 EXPLOSION PROOF				PUSH TO TEST INDICATING LIGHT TRANSFORMER TYPE		GENERAL NOTES				
	TERMINAL IN MCP		CONDUIT HOME RUN 3/4"C, 2#12 & 1#12 GND. TO PANEL L, CKT. 7 UNLESS SHOWN OTHERWISE. IF NO HASH MARKS SHOWN, DEFAULT TO CONDUCTORS AS REQUIRED BY NEC				LIGHTED PUSHBUTTON		1. THIS IS A STANDARD LEGEND SHEET. THEREFORE SOME ABBREVIATIONS OR SYMBOLS THAT APPEAR ON THIS SHEET MAY NOT BE USED ON THIS PROJECT.				
	TERMINAL REMOTE DEVICE OR PANEL		JUNCTION BOX				SELECTOR SWITCH: HOR = HAND/OFF/REMOTE AS = AMP SWITCH HOA = HAND/OFF/AUTO VS = VOLT SWITCH ROL = RMOTE/OFF/LOCAL RO = RUN/OFF		2. THE ELECTRICAL PLAN DRAWINGS ARE GENERALLY DIAGRAMMATIC. THE LOCATION OF EQUIPMENT IS APPROXIMATE UNLESS DIMENSIONED. EXACT LOCATIONS AND ROUTING OF CONDUITS AND WIREWAYS SHALL BE GOVERNED BY STRUCTURAL CONDITIONS AND PHYSICAL INTERFERENCES AND BY LOCATIONS OF ELECTRICAL TERMINATIONS ON EQUIPMENT.				
	SOLID STATE OVERLOAD		CONDUIT HOME RUN – SEE SCHEDULE				EV=ELECTRICAL VAULT, PV=POWER VAULT SV=SIGNAL VAULT		3. NOT ALL CONDUIT MAY BE SHOWN OR CALLED OUT FOR CLARITY. SEE CONDUIT AND WIRE SCHEDULE FOR ADDITIONAL CONDUIT.				
	GRAVITY DAMPER		CONDUIT HOME RUN – SEE SCHEDULE				HAND SWITCH		SYMBOL SECURITY SYMBOL FIRE PROTECTION				
	EXHAUST FAN, INLINE		CONDUIT HOME RUN – SEE SCHEDULE				PUSHBUTTON SWITCH. MOMENTARY ON		SYMBOL DESCRIPTION				
			CONDUIT HOME RUN – SEE SCHEDULE				EMERGENCY STOP SWITCH (PUSH/PULL)		SYMBOL DESCRIPTION				
			CONDUIT HOME RUN – SEE SCHEDULE				PRESSURE SWITCH. NORMALLY CLOSED		SYMBOL DESCRIPTION				
			CONDUIT HOME RUN – SEE SCHEDULE				FLOW SWITCH. NORMALLY CLOSED		SYMBOL DESCRIPTION				
			CONDUIT HOME RUN – SEE SCHEDULE				LIMIT SWITCH, NORMALLY OPEN		SYMBOL DESCRIPTION				
			CONDUIT HOME RUN – SEE SCHEDULE				LEVEL SWITCH, CLOSES ON RISING LEVEL		SYMBOL DESCRIPTION				
			CONDUIT HOME RUN – SEE SCHEDULE				TS–TEMP. SWITCH, (SEE DWG. FOR OPERATION) TC–THERMOCOUPLE, T–THERMOSTAT		SYMBOL DESCRIPTION				
			CONDUIT HOME RUN – SEE SCHEDULE				POTENTIOMETER		SYMBOL DESCRIPTION				
			CONDUIT HOME RUN – SEE SCHEDULE				LEVEL (T=TRANSMITTER, E=ELEMENT, S=SWITCH)		SYMBOL DESCRIPTION				
			CONDUIT HOME RUN – SEE SCHEDULE				PRESSURE TRANSMITTER		SYMBOL DESCRIPTION				
			CONDUIT HOME RUN – SEE SCHEDULE				SPEED INDICATOR		SYMBOL DESCRIPTION				
			CONDUIT HOME RUN – SEE SCHEDULE				FLOW TRANSMITTER		SYMBOL DESCRIPTION				
			CONDUIT HOME RUN – SEE SCHEDULE				DOOR SECURITY SWITCH		SYMBOL DESCRIPTION				
			CONDUIT HOME RUN – SEE SCHEDULE				TORQUE SWITCH		SYMBOL DESCRIPTION				
			CONDUIT HOME RUN – SEE SCHEDULE				CONTROL STATION, SINGLE OR MULTIPLE SWITCHES		SYMBOL DESCRIPTION				
			CONDUIT HOME RUN – SEE SCHEDULE				MOISTURE SENSOR		SYMBOL DESCRIPTION				
			CONDUIT HOME RUN – SEE SCHEDULE				HEATER		SYMBOL DESCRIPTION				
			CONDUIT HOME RUN – SEE SCHEDULE				HEATER		SYMBOL DESCRIPTION				
			CONDUIT HOME RUN – SEE SCHEDULE										

4.1

OVERALL ELECTRICAL SITE PLAN

SCALE: 1"=10'

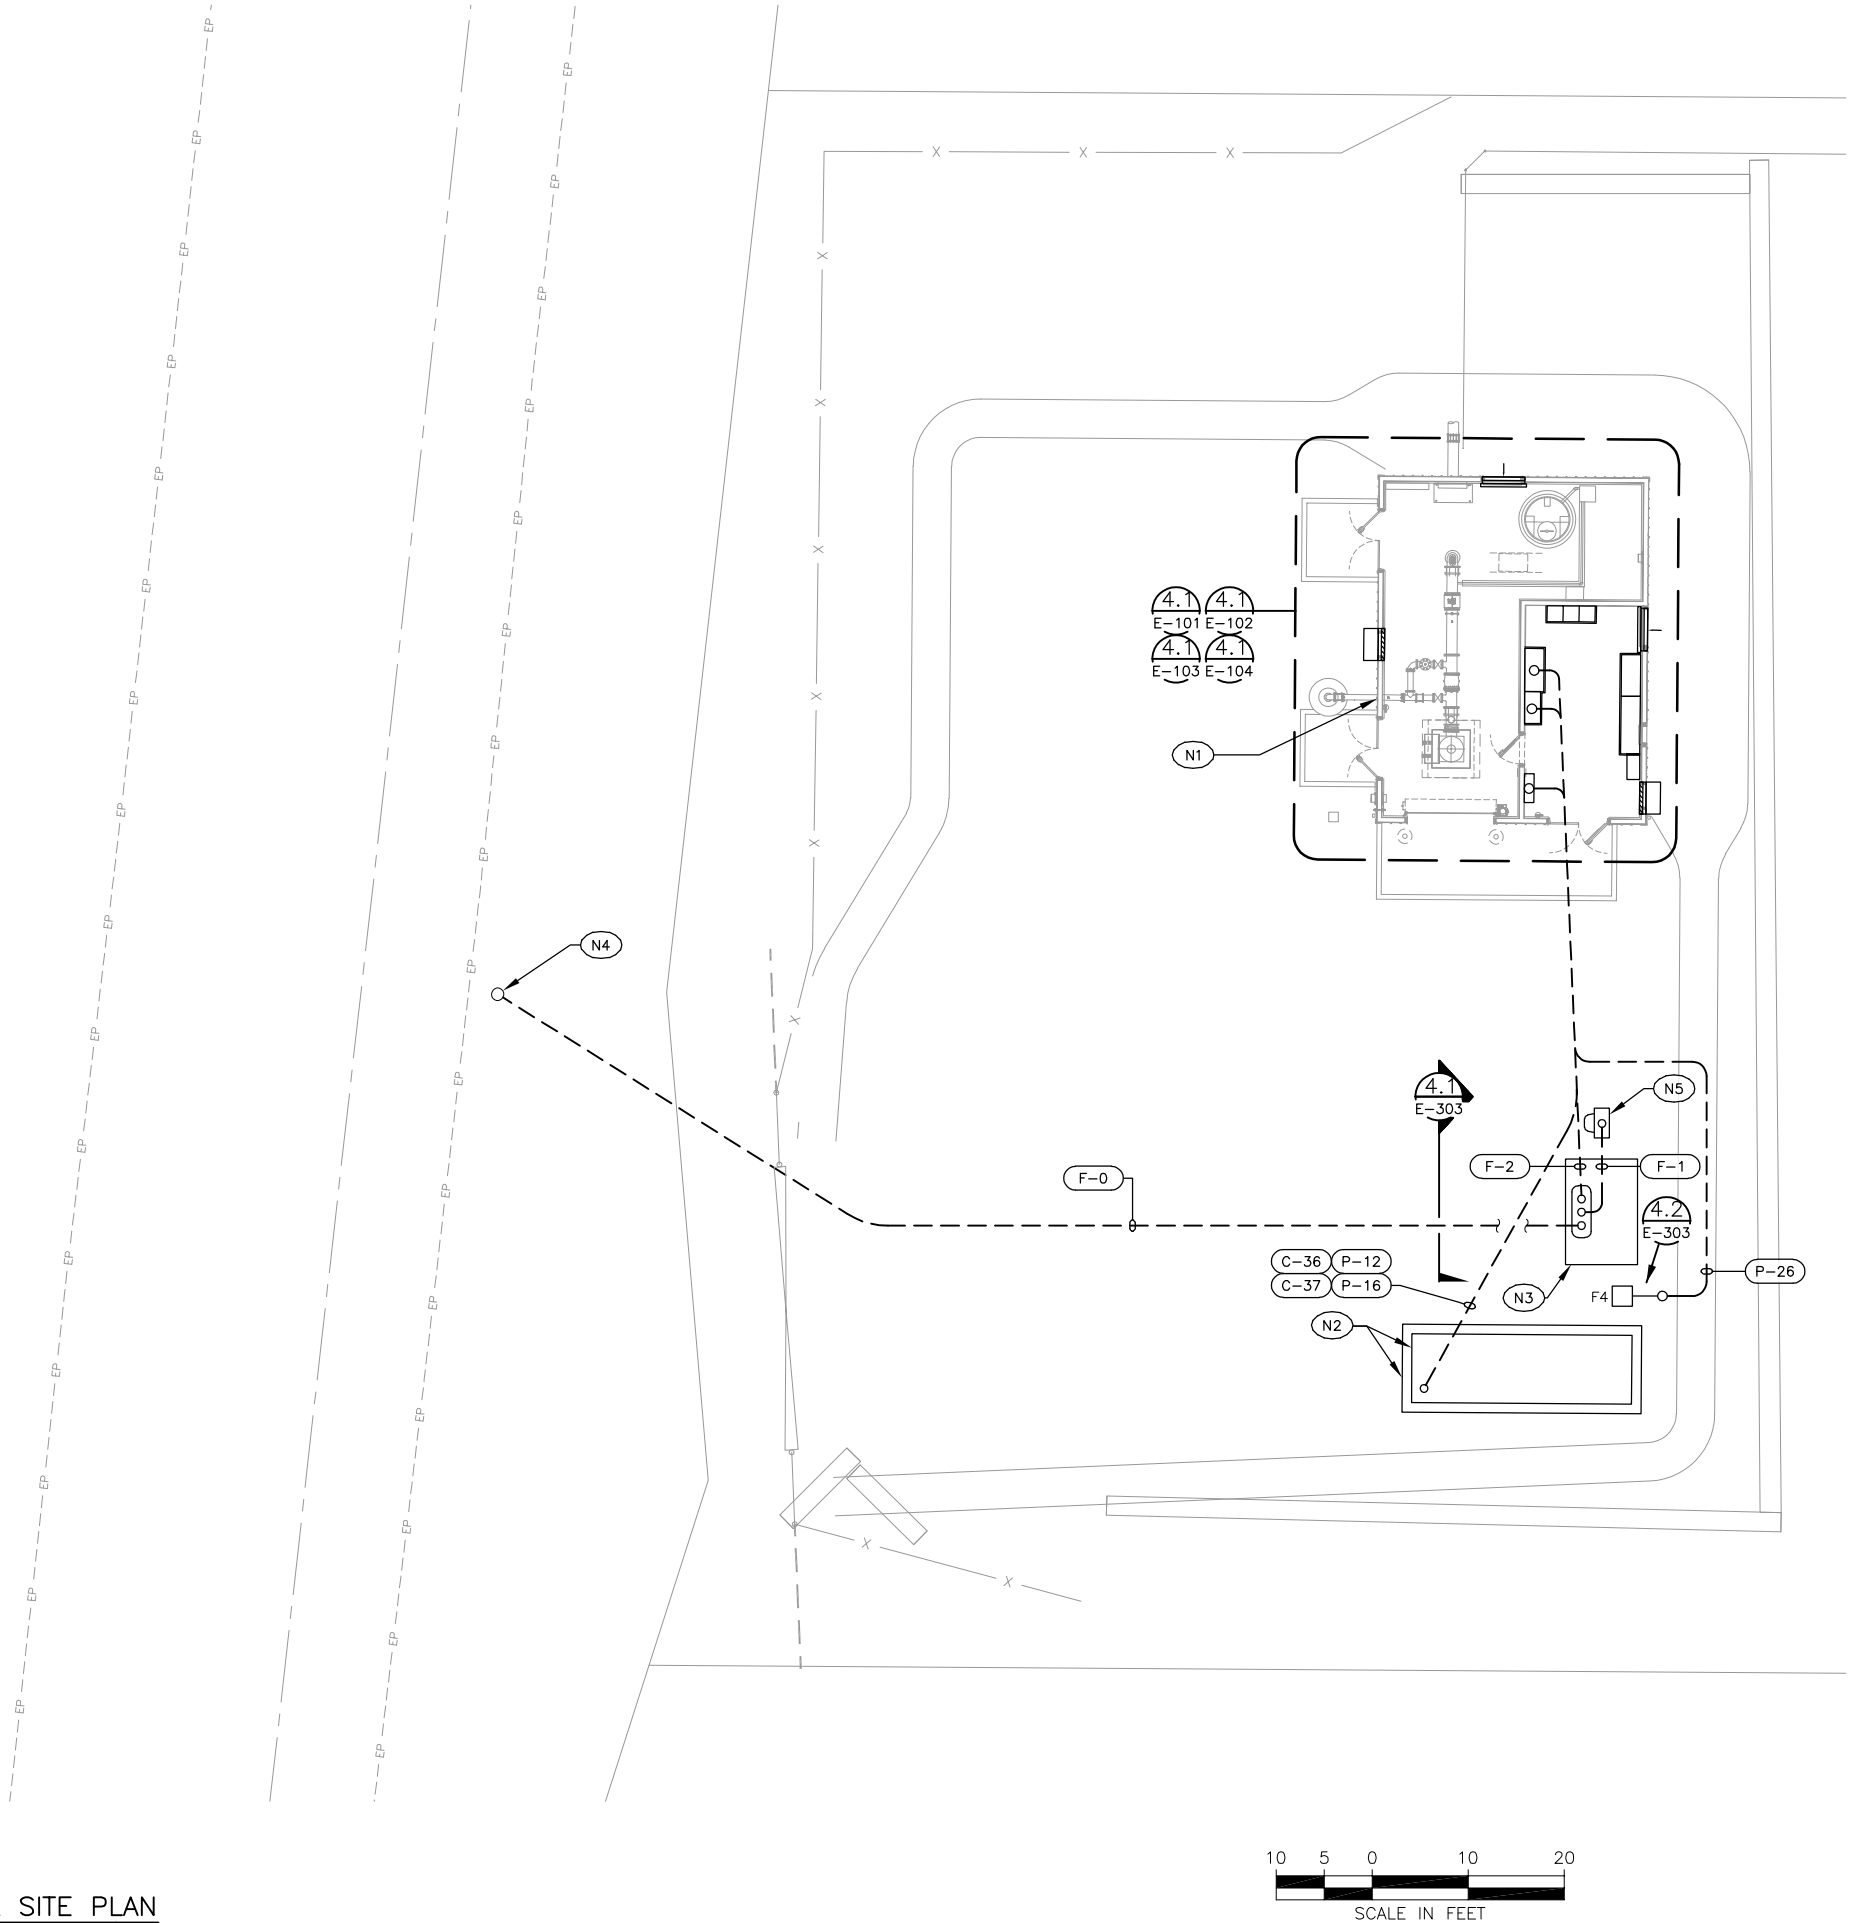

NOTES: (for this sheet)

- (N1) WELL HOUSE BUILDING.
- (N2) GENERATOR AND GENERATOR CONCRETE PAD. CONTRACTOR SHALL COORDINATE INSTALLATION LOCATION TO PROVIDE A MINIMUM CLEARANCE OF 48" ON ALL SIDES OF GENERATOR.
- (N3) UTILITY PAD MOUNT TRANSFORMER.
- (N4) NEW AVISTA POWER POLE.
- (N5) UTILITY METER. INSTALL PER UTILITY REQUIREMENTS.

RECORD DRAWING



1038 W. Davidson Avenue
Coeur d'Alene, ID 83814
JUB PROJECT OFFICE
(208) 666-4021 Fax

J-U-B ENGINEERS, INC.

1630 23rd Ave.

Suite 1101-A

Lewiston, ID 83501

Phone: 208.746.9010

Fax: 208.746.9926

www.jub.com



12/01/22

THIS DOCUMENT AND THE IDEAS AND DESIGNS INCORPORATED HEREIN ARE THE PROPERTY OF JUB ENGINEERS, INC. THESE DESIGNS ARE NOT TO BE REPRODUCED OR USED IN WHOLE OR PART FOR ANY OTHER PROJECT WITHOUT THE EXPRESS WRITTEN AUTHORIZATION OF JUB ENGINEERS, INC.

REVISION			
NO.	DESCRIPTION	BY	DATE
1	RECORD DRAWINGS	TLS	12/01/22
0	FOR BID	TLS	05/28/21
0	90% REVIEW	TLS	04/28/21
0	30% REVIEW	TLS	04/28/21
0	DESIGN	TLS	04/28/21

CITY OF LEWISTON
WELL NO. 7

OVERALL ELECTRICAL SITE PLAN

FILE: M19102-E-002
JUB PROJ. #:
DRAWN BY: TLS
DESIGN BY: SRJ
CHECKED BY: RJW
AT FULL SIZE, IF NOT ONE INCH, SCALE ACCORDINGLY
LAST UPDATED: 12/01/22


SHEET NUMBER:

E-002

4.1 ONE LINE DIAGRAM
NOT TO SCALE

NOTES: (for this sheet)

- (N1) CONFIRM BREAKER SIZE PER MANUFACTURERS NAME PLATE INFORMATION.
(N2) PROVIDE REQUIRED LUGS.
(N3) INSTALL PER UTILITY REQUIREMENTS.
(N4) PROVIDE PLACARD SHOWING AVAILABLE FAULT CURRENT. COORDINATE WITH UTILITY.

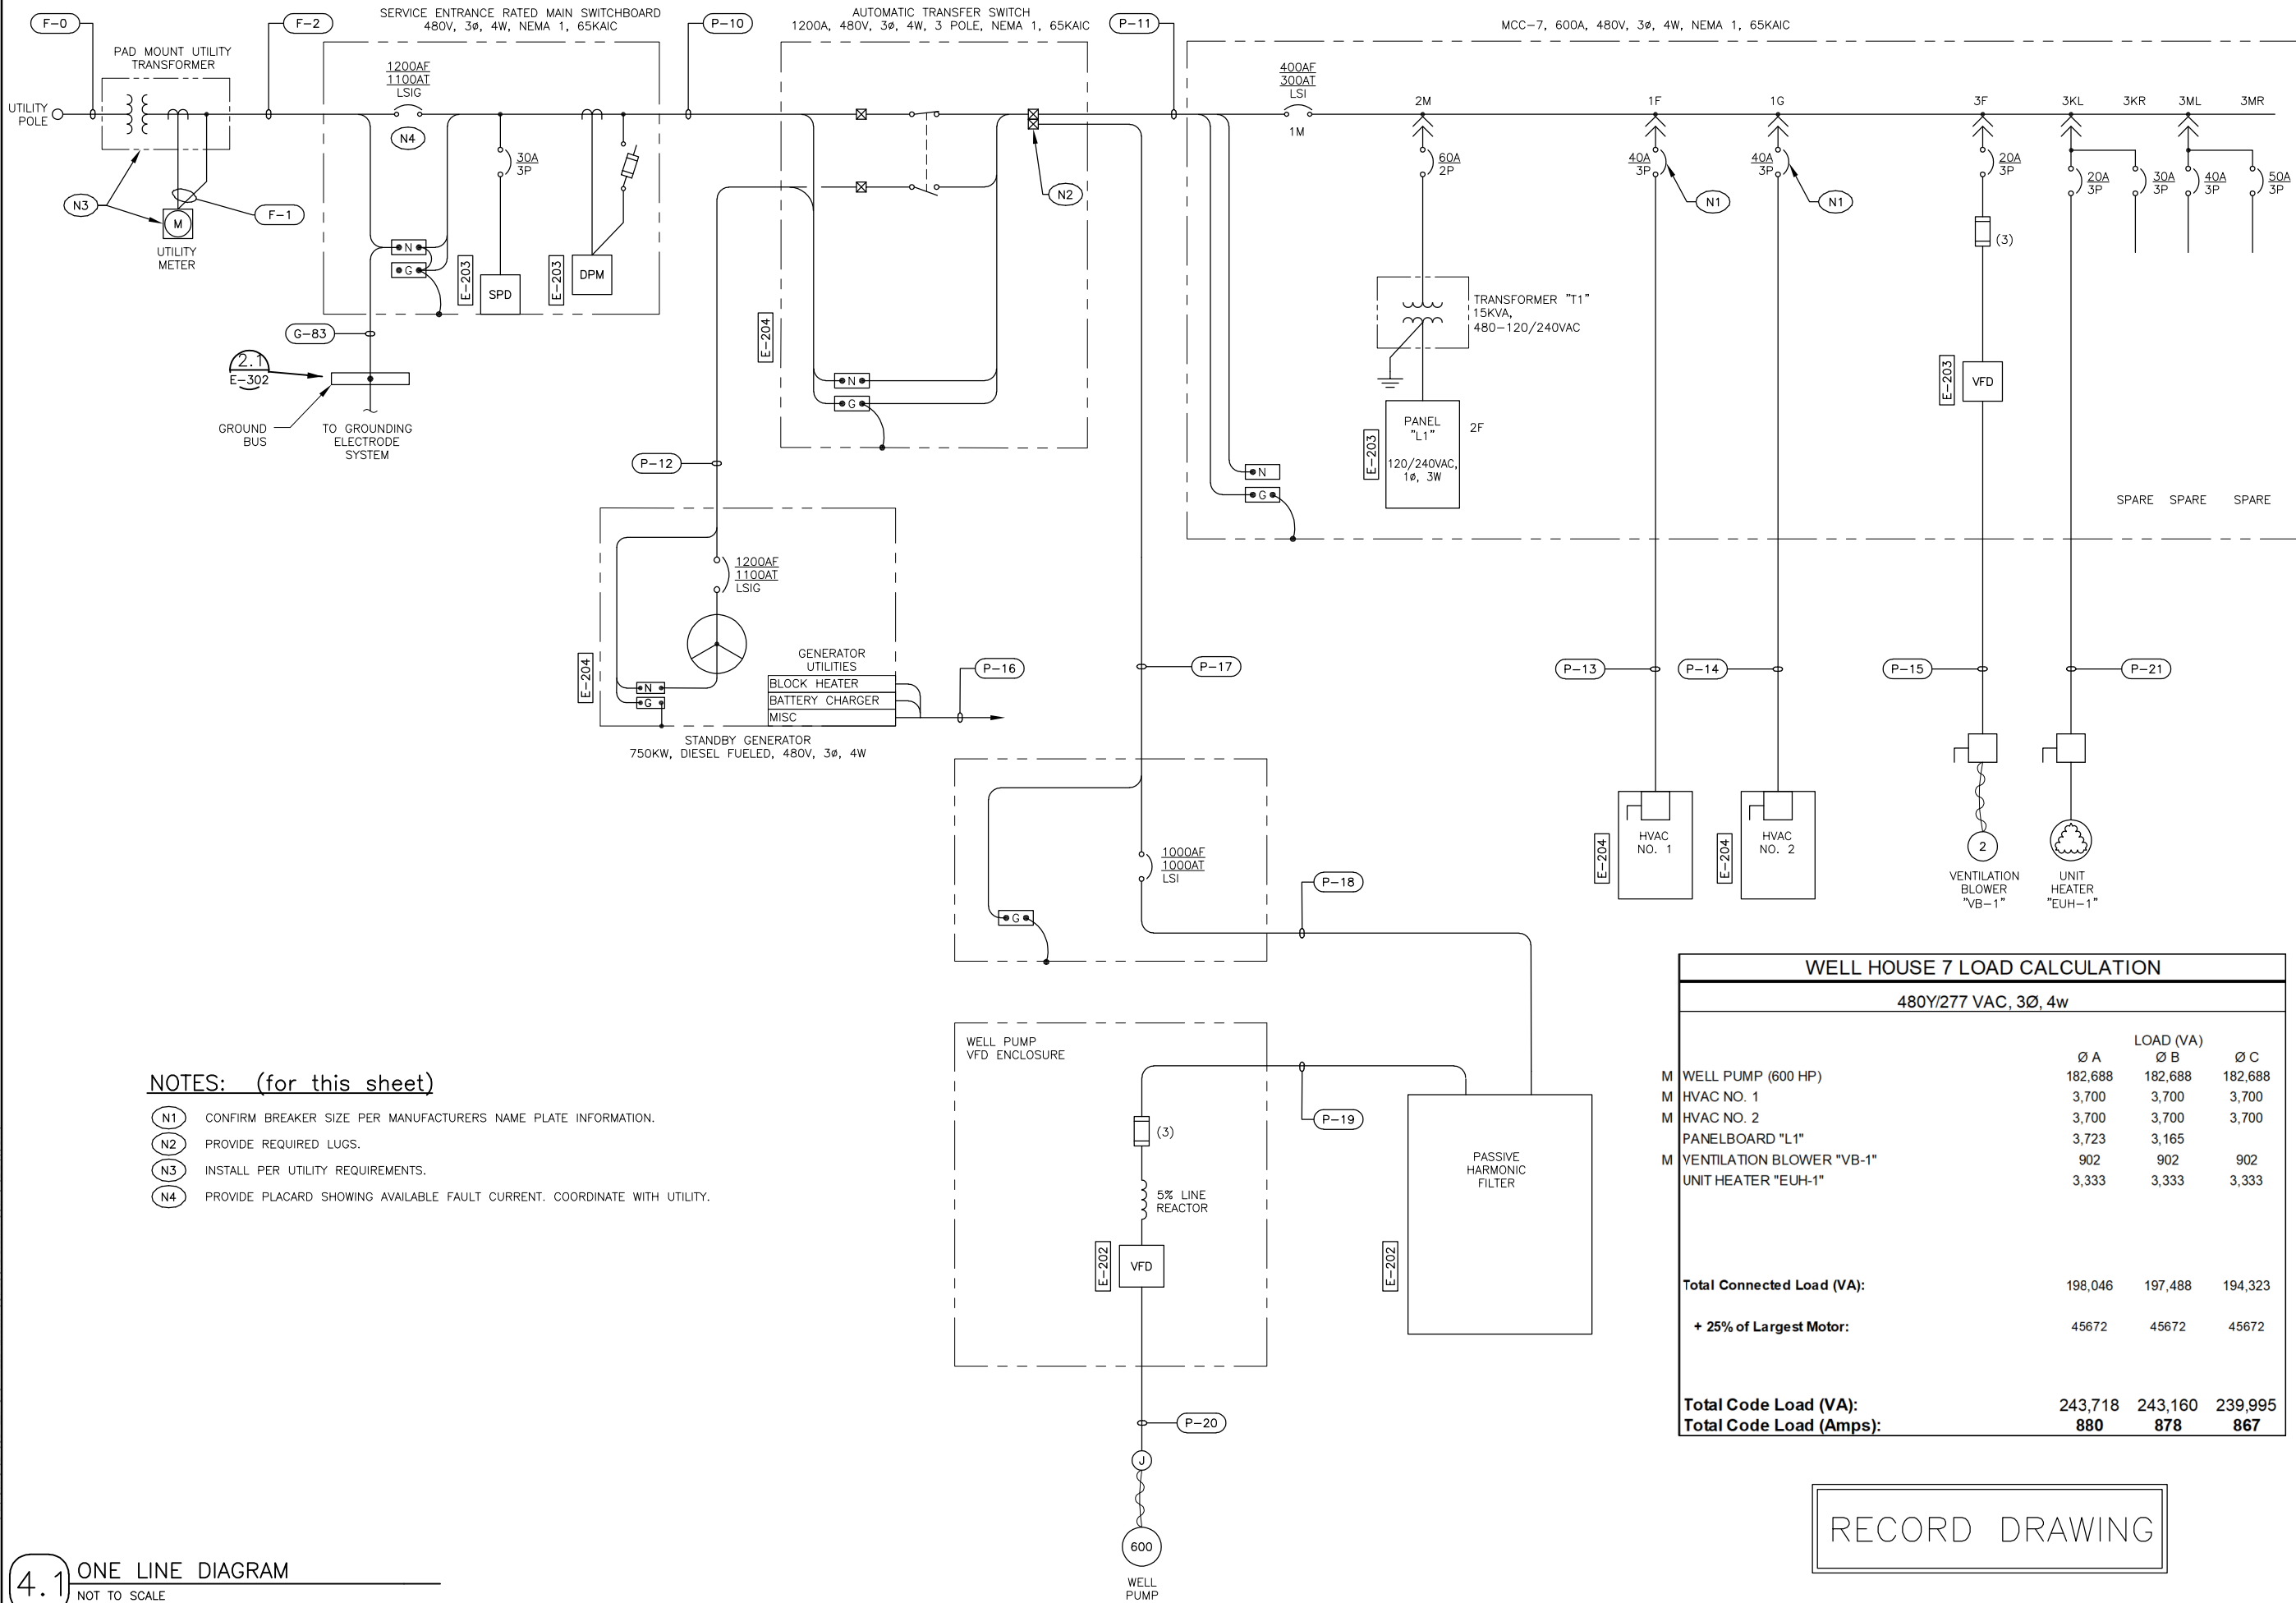

WELL HOUSE 7 LOAD CALCULATION				
480Y/277 VAC, 3Ø, 4w				
		LOAD (VA)		
		Ø A	Ø B	Ø C
M	WELL PUMP (600 HP)	182,688	182,688	182,688
M	HVAC NO. 1	3,700	3,700	3,700
M	HVAC NO. 2	3,700	3,700	3,700
	PANELBOARD "L1"	3,723	3,165	
M	VENTILATION BLOWER "VB-1"	902	902	902
	UNIT HEATER "EUH-1"	3,333	3,333	3,333
Total Connected Load (VA):		198,046	197,488	194,323
+ 25% of Largest Motor:		45672	45672	45672
Total Code Load (VA):		243,718	243,160	239,995
Total Code Load (Amps):		880	878	867

RECORD DRAWING

Plot Date: 2/5/2022 9:51 AM Plotted By: Ted Schawwender
Date Created: 2/1/2022 3:03:19 PM JUB - LEWISTON WELL 2 DRAWINGS RECORD DRAWINGS M19102-E-004.DWG

4.1 CONDUIT AND WIRE SCHEDULE
NOT TO SCALE

C&W SCHEDULE									
ABBREVIATIONS: CAB-CABLE CTL-CONTROL DISC-DISCONNECT JB-JUNCTION BOX LEV-LEVEL MFG-MANUFACTURER MTR-MOTOR PRESS-PRESSURE PR-PAIR PWR-POWER RCPT-RECEPTACLE									
SIG-SIGNAL SPC-SHIELDED POWER CABLE STP- SHIELDED TWISTED PAIR CABLE SW-SWITCH XMITTER-TRANSMITTER (2-7C)- INDICATES TWO-SEVEN CONDUCTOR CABLES									
CONDUIT TAG	SERVICE	ROUTING		CONDUIT		CONDUCTORS		REMARKS OR REFERENCE DRAWING	
		FROM	TO	QTY	SIZE	(QTY) & SIZE	GROUND SIZE		
F-0	UTILITY SERVICE	UTILITY POWER POLE	UTILITY PAD MOUNTED TRANSFORMER	3	2"	BY UTILITY	-	PER UTILITY REQUIREMENTS	
F-1	UTILITY SERVICE	UTILITY PAD MOUNTED TRANSFORMER	UTILITY METER	1	1"	(10) 10 AWG	10 AWG		
F-2	UTILITY SERVICE	UTILITY PAD MOUNTED TRANSFORMER	SERVICE ENTRANCE RATED MAIN SWITCHBOARD	3	4"	(3) 500 KCML (1) 4/0 AWG	-		
P-10	POWER	SERVICE ENTRANCE RATED MAIN SWITCHBOARD	AUTOMATIC TRANSFER SWITCH	3	4"	(3) 500 KCML (1) 4/0 AWG	3/0 AWG		
P-11	MCC FEED	AUTOMATIC TRANSFER SWITCH	MCC-7	1	4"	(3) 500 KCML (1) 4/0 AWG	3 AWG		
P-12	STANDBY GENERATOR POWER	STANDBY GENERATOR	AUTOMATIC TRANSFER SWITCH	3	4"	(3) 500 KCML (1) 4/0 AWG	3/0 AWG		
P-13	HVAC	MCC-7	HVAC-1	1	1"	(3) 8 AWG	10 AWG		
P-14	HVAC	MCC-7	HVAC-2	1	1"	(3) 8 AWG	10 AWG		
P-15	VENTILATION BLOWER "VB-1"	MCC-7	VENTILATION BLOWER "VB-1" STARTER	1	3/4"	(3) 12 AWG	12 AWG		
P-16	GENERATOR UTILITIES	STANDBY GENERATOR	PANEL "L1"	1	1-1/2"	(3) 10 AWG	10 AWG		
P-17	WELL PUMP	AUTOMATIC TRANSFER SWITCH	WELL PUMP VFC ENCLOSURE	3	3-1/2"	(3) 500 KCML	2/0 AWG		
P-18	WELL PUMP	WELL PUMP VFC ENCLOSURE	PASSIVE HARMONIC FILTER	3	3-1/2"	(3) 500 KCML	2/0 AWG		
P-19	WELL PUMP	PASSIVE HARMONIC FILTER	WELL PUMP VFC ENCLOSURE	3	3-1/2"	(3) 500 KCML	2/0 AWG		
P-20	WELL PUMP	WELL PUMP VFC ENCLOSURE	WELL PUMP MOTOR VIA JB	3	3-1/2"	(1-3C) 350 KCML SPC	IN CAB		
P-21	UNIT HEATER	MCC-7	UNIT HEATER "EUH-1"	1	3/4"	(3) 12 AWG	12 AWG		
P-22	OVERHEAD DOOR OPERATOR POWER	PANEL "L1"	OVERHEAD DOOR DISCONNECT	1	3/4"	(2) 12 AWG	12 AWG		
P-23	MOTORIZED LOUVER "ML-1"	MCC-7	MOTORIZED LOUVER "ML-1"	1	3/4"	(2) 12 AWG	12 AWG		
P-24	MOTORIZED LOUVER "ML-2"	LOCAL CONTROL PANEL "LCP-7"	MOTORIZED LOUVER "ML-2"	1	3/4"	(2) 12 AWG	12 AWG		
P-25	METERING PUMP POWER	PANEL "L1"	METERING PUMP	1	3/4"	(2) 12 AWG	12 AWG		
P-26	POLE MOUNTED YARD LIGHT W/ RECEPTACLE	LIGHT SWITCH JUNCTION BOX	POLE MOUNTED YARD LIGHT W/ RECEPTACLE	1	1"	(4) 12 AWG	12 AWG		
C-30A	VFC EXHAUST LOUVERS "LV-1", "LV-2"	EXHAUST LOUVERS "LV-1", "LV-2"	JUNCTION BOX	1	3/4"	(4) 12 AWG	12 AWG		
C-30	VFC EXHAUST LOUVERS "LV-1", "LV-2"	JUNCTION BOX	LOCAL CONTROL PANEL "LCP-7"	1	3/4"	(4) 12 AWG	12 AWG		
C-31	HEAT DETECTOR, PUMP ROOM	LOCAL CONTROL PANEL "LCP-7"	HEAT DETECTOR "HD-P1"	1	3/4"	(2) 14 AWG	14 AWG		
C-32	HEAT DETECTOR, ELECTRICAL ROOM	LOCAL CONTROL PANEL "LCP-7"	HEAT DETECTOR "HD-E1"	1	3/4"	(2) 14 AWG	14 AWG		
C-33	PUMP ROOM INTRUSION SWITCH	JUNCTION BOX "JB-P1"	LOCAL CONTROL PANEL "LCP-7"	1	3/4"	(2) 14 AWG	14 AWG		
C-34	PUMP ROOM INTRUSION SWITCH	JUNCTION BOX "JB-P2"	LOCAL CONTROL PANEL "LCP-7"	1	3/4"	(2) 14 AWG	14 AWG		
C-35	ELECTRICAL ROOM INTRUSION SWITCH	JUNCTION BOX "JB-E1"	LOCAL CONTROL PANEL "LCP-7"	1	3/4"	(2) 14 AWG	14 AWG		
C-36	GENERATOR STATUS/ALARMS	GENERATOR CONTROL PANEL	LOCAL CONTROL PANEL "LCP-7"	1	1-1/2"	(6) 14 AWG	14 AWG		
C-37	GENERATOR CALL TO RUN	GENERATOR CONTROL PANEL	AUTOMATIC TRANSFER SWITCH	1	1-1/2"	(2) 14 AWG	14 AWG		
C-38	AUTOMATIC TRANSFER SWITCH STATUS	AUTOMATIC TRANSFER SWITCH	LOCAL CONTROL PANEL "LCP-7"	1	3/4"	(5) 14 AWG	14 AWG		
C-39	VFC CONTROL/STATUS	LOCAL CONTROL PANEL "LCP-7"	WELL PUMP VFC ENCLOSURE	1	1"	(13) 14 AWG	14 AWG		
C-40	PASSIVE HARMONIC FILTER CONTROL	LOCAL CONTROL PANEL "LCP-7"	PASSIVE HARMONIC FILTER	1	3/4"	(2) 14 AWG	14 AWG		
C-41	VENTILATION BLOWER "VB-1"	LOCAL CONTROL PANEL "LCP-7"	VENTILATION BLOWER "VB-1"	1	3/4"	(2) 14 AWG	14 AWG		
C-42	ALARM BEACON	LOCAL CONTROL PANEL "LCP-7"	ALARM BEACON	1	3/4"	(2) 14 AWG	14 AWG		
C-43A	FLOW INDICATING TRANSMITTER "W7-FIT-100"	FLOW INDICATING TRANSMITTER "W7-FIT-100"	JUNCTION BOX	1	3/4"	(4) 14 AWG	14 AWG		
C-43	FLOW INDICATING TRANSMITTER "W7-FIT-100"	JUNCTION BOX	LOCAL CONTROL PANEL "LCP-7"	1	3/4"	(4) 14 AWG	14 AWG		
C-44	SERVICE ENTRANCE RATED MAIN SWITCHBOARD STATUS	SERVICE ENTRANCE RATED MAIN SWITCHBOARD	LOCAL CONTROL PANEL "LCP-7"	1	3/4"	(4) 14 AWG	14 AWG		
C-45A	DISCHARGE PRESSURE TRANSMITTER "W7-PSH-100"	DISCHARGE PRESSURE TRANSMITTER "W7-PSH-100"	JUNCTION BOX	1	3/4"	(4) 14 AWG	14 AWG		
C45B	PRV POSITION	JUNCTION BOX	PRV-W7-ZS-101	1	3/4"	(2) 14 AWG	14 AWG		
C-45	DISCHARGE PRESSURE TRANSMITTER "W7-PSH-100"	JUNCTION BOX	MCC-7	1	3/4"	(6) 14 AWG	14 AWG		
C-46	HVAC-1 FAULT	HVAC-1	LOCAL CONTROL PANEL "LCP-7"	1	3/4"	(2) 14 AWG	14 AWG		
C-47	HVAC-2 FAULT	HVAC-2	LOCAL CONTROL PANEL "LCP-7"	1	3/4"	(2) 14 AWG	14 AWG		
C-48	METERING PUMP STATUS AND CALL TO RUN	LOCAL CONTROL PANEL "LCP-7"	METERING PUMP	1	3/4"	(4) 14 AWG	14 AWG		
C-49	METERING PUMP "PSH-101"	METERING PUMP "PSH-101"	LOCAL CONTROL PANEL "LCP-7"	1	3/4"	(2) 14 AWG	14 AWG		
C-50	SODIUM HYPOCHLORITE TANK LS	SODIUM HYPOCHLORITE TANK FLOAT	LOCAL CONTROL PANEL "LCP-7"	1	3/4"	(2) 14 AWG	14 AWG		
C-51	VFC VENTILATION	LOCAL CONTROL PANEL "LCP-7"	VFC VENTILATION MOTORIZED DAMPERS	1	3/4"	(6) 14 AWG	14 AWG		
C-52	CHLORINE ANALYZER W7-AIT-101	LOCAL CONTROL PANEL "LCP-7"	CHLORINE ANALYZER W7-AIT-101	1	3/4"	(4) 14 AWG	14 AWG		
C-53A	INSTRUMENTS "LSL-100", "FCV-100"	INSTRUMENTS "LSL-100", "FCV-100"	JUNCTION BOX	1	3/4"	(4) 14 AWG	14 AWG		
C-53	INSTRUMENTS "LSL-100", "FCV-100"	JUNCTION BOX	LOCAL CONTROL PANEL "LCP-7"	1	3/4"	(4) 14 AWG	14 AWG		
C-54	EMERGENCY STOP SWITCH "ESS"	EMERGENCY STOP SWITCH "ESS"	WELL PUMP VFC ENCLOSURE	1	3/4"	(2) 14 AWG	14 AWG		
S-60	WINDING AND BEARING RTD'S	WELL PUMP VFC ENCLOSURE	WELL PUMP MOTOR VIA JB	1	2"	(5) 16 AWG RTD CABLE	14 AWG	RTD'S FOR WINDINGS, UPPER BEARINGS, LOWER BEARINGS	
S-61	CELLULAR ANTENNA	LOCAL CONTROL PANEL "LCP-7"	TELEMETRY ANTENNA	1	2"	CELLULAR CABLE	12 AWG		
S-62	VFC SPEED CONTROL/STATUS	LOCAL CONTROL PANEL "LCP-7"	WELL PUMP VFC ENCLOSURE	1	3/4"	(2) 16 AWG STP	14 AWG		
S-63	LEVEL TRANSDUCER "LT-100-1"	LOCAL CONTROL PANEL "LCP-7"	JB-LT	1	3/4"	(1) 16 AWG STP	14 AWG	LOCATE BELLWS IN JB-LT	
S-64	ETHERNET COMMUNICATIONS	SERVICE ENTRANCE RATED MAIN SWITCHBOARD	LOCAL CONTROL PANEL "LCP-7"	1	1"	(1) CAT 5e	12 AWG		
S-66A	FLOW INDICATING TRANSMITTER "W7-FIT-100"	FLOW INDICATING TRANSMITTER "W7-FIT-100"	JUNCTION BOX	1	3/4"	(1) 16 AWG STP	14 AWG		
S-66	FLOW INDICATING TRANSMITTER "W7-FIT-100"	JUNCTION BOX	LOCAL CONTROL PANEL "LCP-7"	1	3/4"	(1) 16 AWG STP	14 AWG		
S-67A	DISCHARGE PRESSURE TRANSMITTER "W7-PIT-101"	DISCHARGE PRESSURE TRANSMITTER "W7-PIT-101"	JUNCTION BOX	1	3/4"	(1) 16 AWG STP, (2) 14 AWG	14 AWG		
S-67	DISCHARGE PRESSURE TRANSMITTER "W7-PIT-101"	JUNCTION BOX	LOCAL CONTROL PANEL "LCP-7"	1	3/4"	(1) 16 AWG STP, (2) 14 AWG	14 AWG		
S-68	METERING PUMP FLOW PACE	METERING PUMP	LOCAL CONTROL PANEL "LCP-7"	1	3/4"	(1) 16 AWG STP	14 AWG		
S-69	CHLORINE ANALYZER W7-AIT-101	LOCAL CONTROL PANEL "LCP-7"	CHLORINE ANALYZER W7-AIT-101	1	1"	(1) 16 AWG STP	14 AWG		
S-70	TEMPERATURE TRANSMITTER "W7-TT-122"	TEMPERATURE TRANSMITTER "W7-TT-122"	LOCAL CONTROL PANEL "LCP-7"	1	1"	(1) 16 AWG STP	14 AWG		
S-71	TEMPERATURE TRANSMITTER "W7-TT-123"	TEMPERATURE TRANSMITTER "W7-TT-123"	LOCAL CONTROL PANEL "LCP-7"	1	1"	(1) 16 AWG STP	14 AWG		
S-72	TEMPERATURE TRANSMITTER "W7-TT-124"	TEMPERATURE TRANSMITTER "W7-TT-124"	LOCAL CONTROL PANEL "LCP-7"	1	1"	(1) 16 AWG STP	14 AWG		
G-80	GROUNDING ELECTRODE SYSTEM	GROUND BUS	GROUND RING	1	-	-	4/0 AWG		
G-81	ANTENNA SURGE PROTECTION GROUND	TELEMETRY ANTENNA	GROUND ROD	1	1"	-	1 AWG	THWN GREEN CU CONDUCTOR	
G-82	GROUNDING ELECTRODE SYSTEM	GROUND RING	GROUND RING	1	-	-	4/0 AWG	BURY 24" BELOW FINISHED GRADE	
G-83	GROUNDING ELECTRODE SYSTEM	SERVICE ENTRANCE RATED MAIN SWITCHBOARD	GROUND BUS	1	-	-	4/0 AWG		
G-84	GROUNDING ELECTRODE SYSTEM	PROCESS PIPE	GROUND RING	1	1"	-	1 AWG	BARE CU CONDUCTOR, UTILIZE PVC SLEEVE AS REQUIRED	
G-85	GROUNDING ELECTRODE SYSTEM	BUILDING STRUCTURAL STEEL/REBAR	GROUND RING	1	-	-	2/0 AWG	BARE CU CONDUCTOR	
G-86	GROUNDING ELECTRODE SYSTEM	BUILDING STRUCTURAL STEEL/REBAR	GROUND ROD	1	-	-	2/0 AWG	BARE CU CONDUCTOR	
G-87	WELL PUMP MOTOR GROUNDING	WELL PUMP MOTOR CASING	GROUND BUS	1	2"	-	2/0 AWG	HIGH-FREQUENCY GROUND STRAP, REFERENCE SPECIFICATION 16060 FOR ADDITIONAL INFO	

RECORD DRAWING

1038 W. Davidson Avenue
Coeur d'Alene, ID 83814
(208) 666-4021 office
(208) 666-4021 fax

AEI Engineering Incorporated

JUB

J-U-B ENGINEERS, INC.

J-U-B ENGINEERS, INC.
1630 23rd Ave.
Suite 1101-A
Lewiston, ID 83501
Phone: 208.746.9010
Fax: 208.746.9926
www.jub.com

PROFESSIONAL ENGINEER
18028
STATE OF IDAHO
SCOTT R. JACOBSON

12/01/22

REUSE OF DRAWINGS
THIS DOCUMENT AND THE IDEAS AND DESIGNS INCORPORATED HEREIN ARE AN INTELLECTUAL PROPERTY OF JUB ENGINEERS, INC. NO PART OF THIS DOCUMENT SHALL BE REPRODUCED OR TRANSMITTED IN ANY FORM OR BY ANY MEANS, ELECTRONIC OR MECHANICAL, INCLUDING PHOTOCOPYING, RECORDING, OR BY ANY INFORMATION STORAGE AND RETRIEVAL SYSTEM, WITHOUT THE EXPRESS WRITTEN AUTHORIZATION OF JUB ENGINEERS, INC.

REVISIONS

NO.	REVISION	DATE
2	RECORD DRAWINGS	12/01/22
1	ADDENDUM 1	06/10/21
0	FOR BID	05/28/21
0	90% REVIEW	04/28/21
0	30% REVIEW	04/28/21
0	DESIGN	04/28/21
NO.	DESCRIPTION	DATE

CITY OF LEWISTON
WELL NO. 7

CONDUIT AND WIRE SCHEDULE

FILE: M19102-E-004
JUB PROJ. #:
DRAWN BY: TLS
DESIGN BY: SRJ
CHECKED BY: RJW
AT FULL SIZE, IF NOT ONE INCH, SCALE ACCORDINGLY
LAST UPDATED: 12/01/22
SHEET NUMBER:
E-004

4.1

ELECTRICAL SCHEDULES

NOT TO SCALE

LUMINAIRE SCHEDULE							
TYPE	DESCRIPTION	VOLTS	LAMP QTY	WATTS / FIXTURE	MOUNTING	MANUFACTURE NUMBER	NOTES
						BASIS OF DESIGN	
F1/F1E	4' SURFACE MTD, ENCLOSED AND GASKETED, ELECTRONIC BALLAST, 5799 LUMENS, RIBBED FROSTED ACRYLIC LENS, FAST BLOW FUSE	120 VAC	LED	52W	CEILING SURFACE	F1: COLUMBIA #LXEM4-35HL-RFA-EU-GLR, OR APPROVED EQUAL F1E: COLUMBIA #LXEM4-35HL-RFA-EU-GLR-ELL14, OR APPROVED EQUAL	EMERGENCY BATTERY PACK WHERE INDICATED
F2	WALL PACK MOUNTED LUMINAIRE, TYPE III DISTRIBUION, 4000K, 3421 LUMENS, PHOTOCONTROL BUTTON, MOTION SENSOR, IN-LINE FUSING, BRONZE FINISH	120 VAC	LED	38W	WALL SURFACE	PHILIPS GARDCO #121-16L-700-NW-G3-3-EBPC-120-PCB-IMRI2-F1-BZ, OR APPROVED EQUAL	MOUNTING HIEGHT SHALL BE AS INDICATED ON ARCHITECTURAL PLANS
F3	INCANDESCENT ROTATING LIGHT, PARABOLIC REFLECTOR, RED LENS	120 VAC	INC (1)	40	WALL SURFACE	FEDERAL SIGNAL CORP: 225-120R	PROVIDE CORNER OR NORMAL WALL MOUNTING BRACKET AS INDICATED ON PLANS
F4	SINGLE HEAD RECTILINEAR LED LUMINAIRE WITH DIE CAST ALUMINUM HOUSING AND PHOTOCELL ON 20FT. ROUND STEEL POLE WITH INTEGRAL GFCI RECEPTACLE	120 VAC	LED	162	20 'POLE	LUMINAIRE: MCGRAW-EDISON #GLEON-SA5A-740-U-T3-BZ-HSS-PR, OR APPROVED EQUAL POLE: COOPER #RSS6M20SFN1XE, OR APPROVED EQUAL	


ELECTRICAL-MECHANICAL EQUIPMENT SCHEDULE					
TAG	ITEM	SIZE / RATING	DESCRIPTION	MANUFACTURE NUMBER - BASIS OF DESIGN	NOTES
EUH-1	UNIT HEATER	10KW, 480 VAC, 3 PHASE	WALL/CEILING MOUNTED UNIT HEATER, INTEGRAL CONTACTOR, CONTROL TRANSFORMER AND DISCONNECT SWITCH OPTION, REMOTE LOW VOLTAGE THERMOSTAT.	CHROMALOX MODEL-LUH WITH OPTIONS, OR ENGINEER REVIEWED EQUAL	
ALL VENTILATION CONTROL AND TEMPERATURE ALARM THERMOSTATS	THERMOSTAT, TEMP SWITCH HIGH (TSH) OR TEMP SWITCH LOW (TSL)	25 AMPS, 120V, SPDT, NEMA 4X, 40-110 °F	CORROSION RESISTANT WALL MOUNTED INDUSTRIAL THERMOSTAT.	PECO #TF115-001, OR APPROVED EQUAL	SWITCH TO BE CONFIGURED "LOW" OR "HIGH" WHERE INDICATED ON PLANS
HVAC-1, HVAC-2	HVAC UNIT	16 A, 480V, 3-PH	EXTERIOR WALL MOUNTED UNIT, 5-TON AIR CONDITIONING, 15KW ELECTRIC HEATING, RIGHT SIDED COMPRESSOR AND CONTROLS INCLUDING DISCONNECT, DIGITAL THERMOSTAT/CONTROLLER, BAROMETRIC FRESH AIR DAMPER, 1" WASHABLE FILTER, BEIGE FINISH, EXTREME DUTY DOOR, PHENOLIC COATED OUTDOOR COIL	BARD #W60AA-C15, OR APPROVED EQUAL	PROVIDE MINIMUM CLEARANCE OF 20-INCHES OF EACH SIDE OF UNIT PER MANUFACTURES INSTRUCTIONS.
VB-1	VENTILATION BLOWER	6162 CFM @ 5 INWC, 480 VAC, THREE PHASE, 2 HP, 1127 RPM	WALL MOUNTED, 22" ROUND, BELT DRIVEN, INTERNAL DISCONNECT, ALUMINUM BIRD SCREEN.	COOK #ACW-B-210W9B WITH OPTIONS, OR ENGINEER REVIEWED EQUAL	INTERLOCK OPERATION OF VENTILATOR AND INTAKE LOUVER WITH AIR CONDITIONING UNIT OPERATION.
ML-1, ML-2	MOTORIZED LOUVER	48" x48" 1300 CFM @ 0.4" WC, 120 VAC, 1 PHASE, MOTORIZED OPERATOR, POWER OPEN, SPRING CLOSE.	ALUMINUM COMBINATION DAMPER WITH STATIONARY DRAINABLE FRONT BLADES. UNIT TO BE MOTOR OPERATED TO OPEN, SPRING TO CLOSE, OPERATOR LINKAGE. UNIT TO BE PROVIDED WITH ALUMINUM BIRD SCREEN.	RUSKIN MODEL #ELC6375DAX WITH OPTIONS, OR APPROVED EQUAL	MOUNT BOTTOM OF UNIT +24" AFF
LV-1	VFD EXHAUST LOUVER	18" H x24" W, 120 VAC	ALUMINUM COMBINATION LOUVER WITH STATIONARY DRAINABLE FRONT BLADES. UNIT TO BE MOTOR OPERATED TO OPEN, SPRING TO CLOSE.	RUSKIN MODEL #ELC6375DAX WITH: 120VAC, POWER OPEN- SPRING TO CLOSE ACTUATOR, OPERATOR LINKAGE.	
LV-2	VFD EXHAUST LOUVER	18" H x24" W, 120 VAC	ALUMINUM COMBINATION LOUVER WITH STATIONARY DRAINABLE FRONT BLADES. UNIT TO BE MOTOR OPERATED TO OPEN, SPRING TO CLOSE.	RUSKIN MODEL #ELC6375DAX WITH: 120VAC, POWER CLOSE- SPRING TO OPEN ACTUATOR, OPERATOR LINKAGE.	
FH-1, FH-2	FILTER HOLDING FRAME FOR MOTORIZED DAMPER	(4) 24"x24"x2" FILTER HOLDING FRAMES, 48"x48" OVERALL	16 GAUGE GALVANIZED STEEL FILTER FRAME WIT, SPRING CLIPS, AND GASKETED FRAME DESIGNED FOR EASY FILTER REPLACEMENT. UNIT TO BE MOUNTED AND FLANGED TO COVER THE DISCHARGE SIDE OF THE INTAKE MOTORIZED LOUVER.	KOCH #AR-442 WITH TYPE CA-02 CLIPS, OR APPROVED EQUAL	PROVIDE CORRECTLY SIZED FILTER

Panel: L1		Mains: 80 A		Voltage: 120/240 VAC, 1ø, 3w	
Mounting: MCC-7		Poles: 30		Min. A.I.C.: 10,000	
Use and/or Area Served	C/B	Cir. No.	Load		Use and/or Area Served
			Ø A	Ø B	
L LIGHTS	20	1	738		20 RECEPTACLES
R METERING PUMP RECEPTACLE	20	3	900		20 RECEPTACLES
LOCAL CONTROL PANEL "LCP-7"	20	5	500	1000	30 GENERATOR BLOCK HEATER & BATTERY CHARGER
M MOTORIZED LOUVER ML-1	20	7	900		6 GENERATOR BLOCK HEATER & BATTERY CHARGER
SPARE	20	9	180	180	2 OVERHEAD DOOR OPERATOR
SPARE	20	11	500	900	8
SPARE	20	13		162	20 YARD LIGHT RECEPTACLE
SPARE	20	15		250	12
		17			20 SPARE
		19			14
		21			20 SPARE
		23			16
		25			18
SPD	30	27			20
SPD		29			22
Total Connected Load (VA):			3718	3577	NOTES: 1.) PROMDE INTEGRAL SPD PROTECTION.
+ 25% of Continuous Load:			410	225	
+ 25% of Largest Motor:			125	45	
Total Code Load (VA):			4253	3847	
Total Code Load (Amps):			36	33	

RECORD DRAWING




RECORD DRAWING

FILE : M19102-E-101
JUB PROJ. #:
DRAWN BY: TLS
DESIGN BY: SRJ
CHECKED BY: RJW
 <p>ONE INCH</p> <p>AT FULL SIZE, IF NOT ONE INCH, SCALE ACCORDINGLY</p>
LAST UPDATED: 12/01/22
SHEET NUMBER:

E-101

Plot Date: 12/5/2022 10:57 AM Plotted By: Ted Schawwecker
Date Created: 12/1/2022 3:00 PM M19102-E-102.DWG

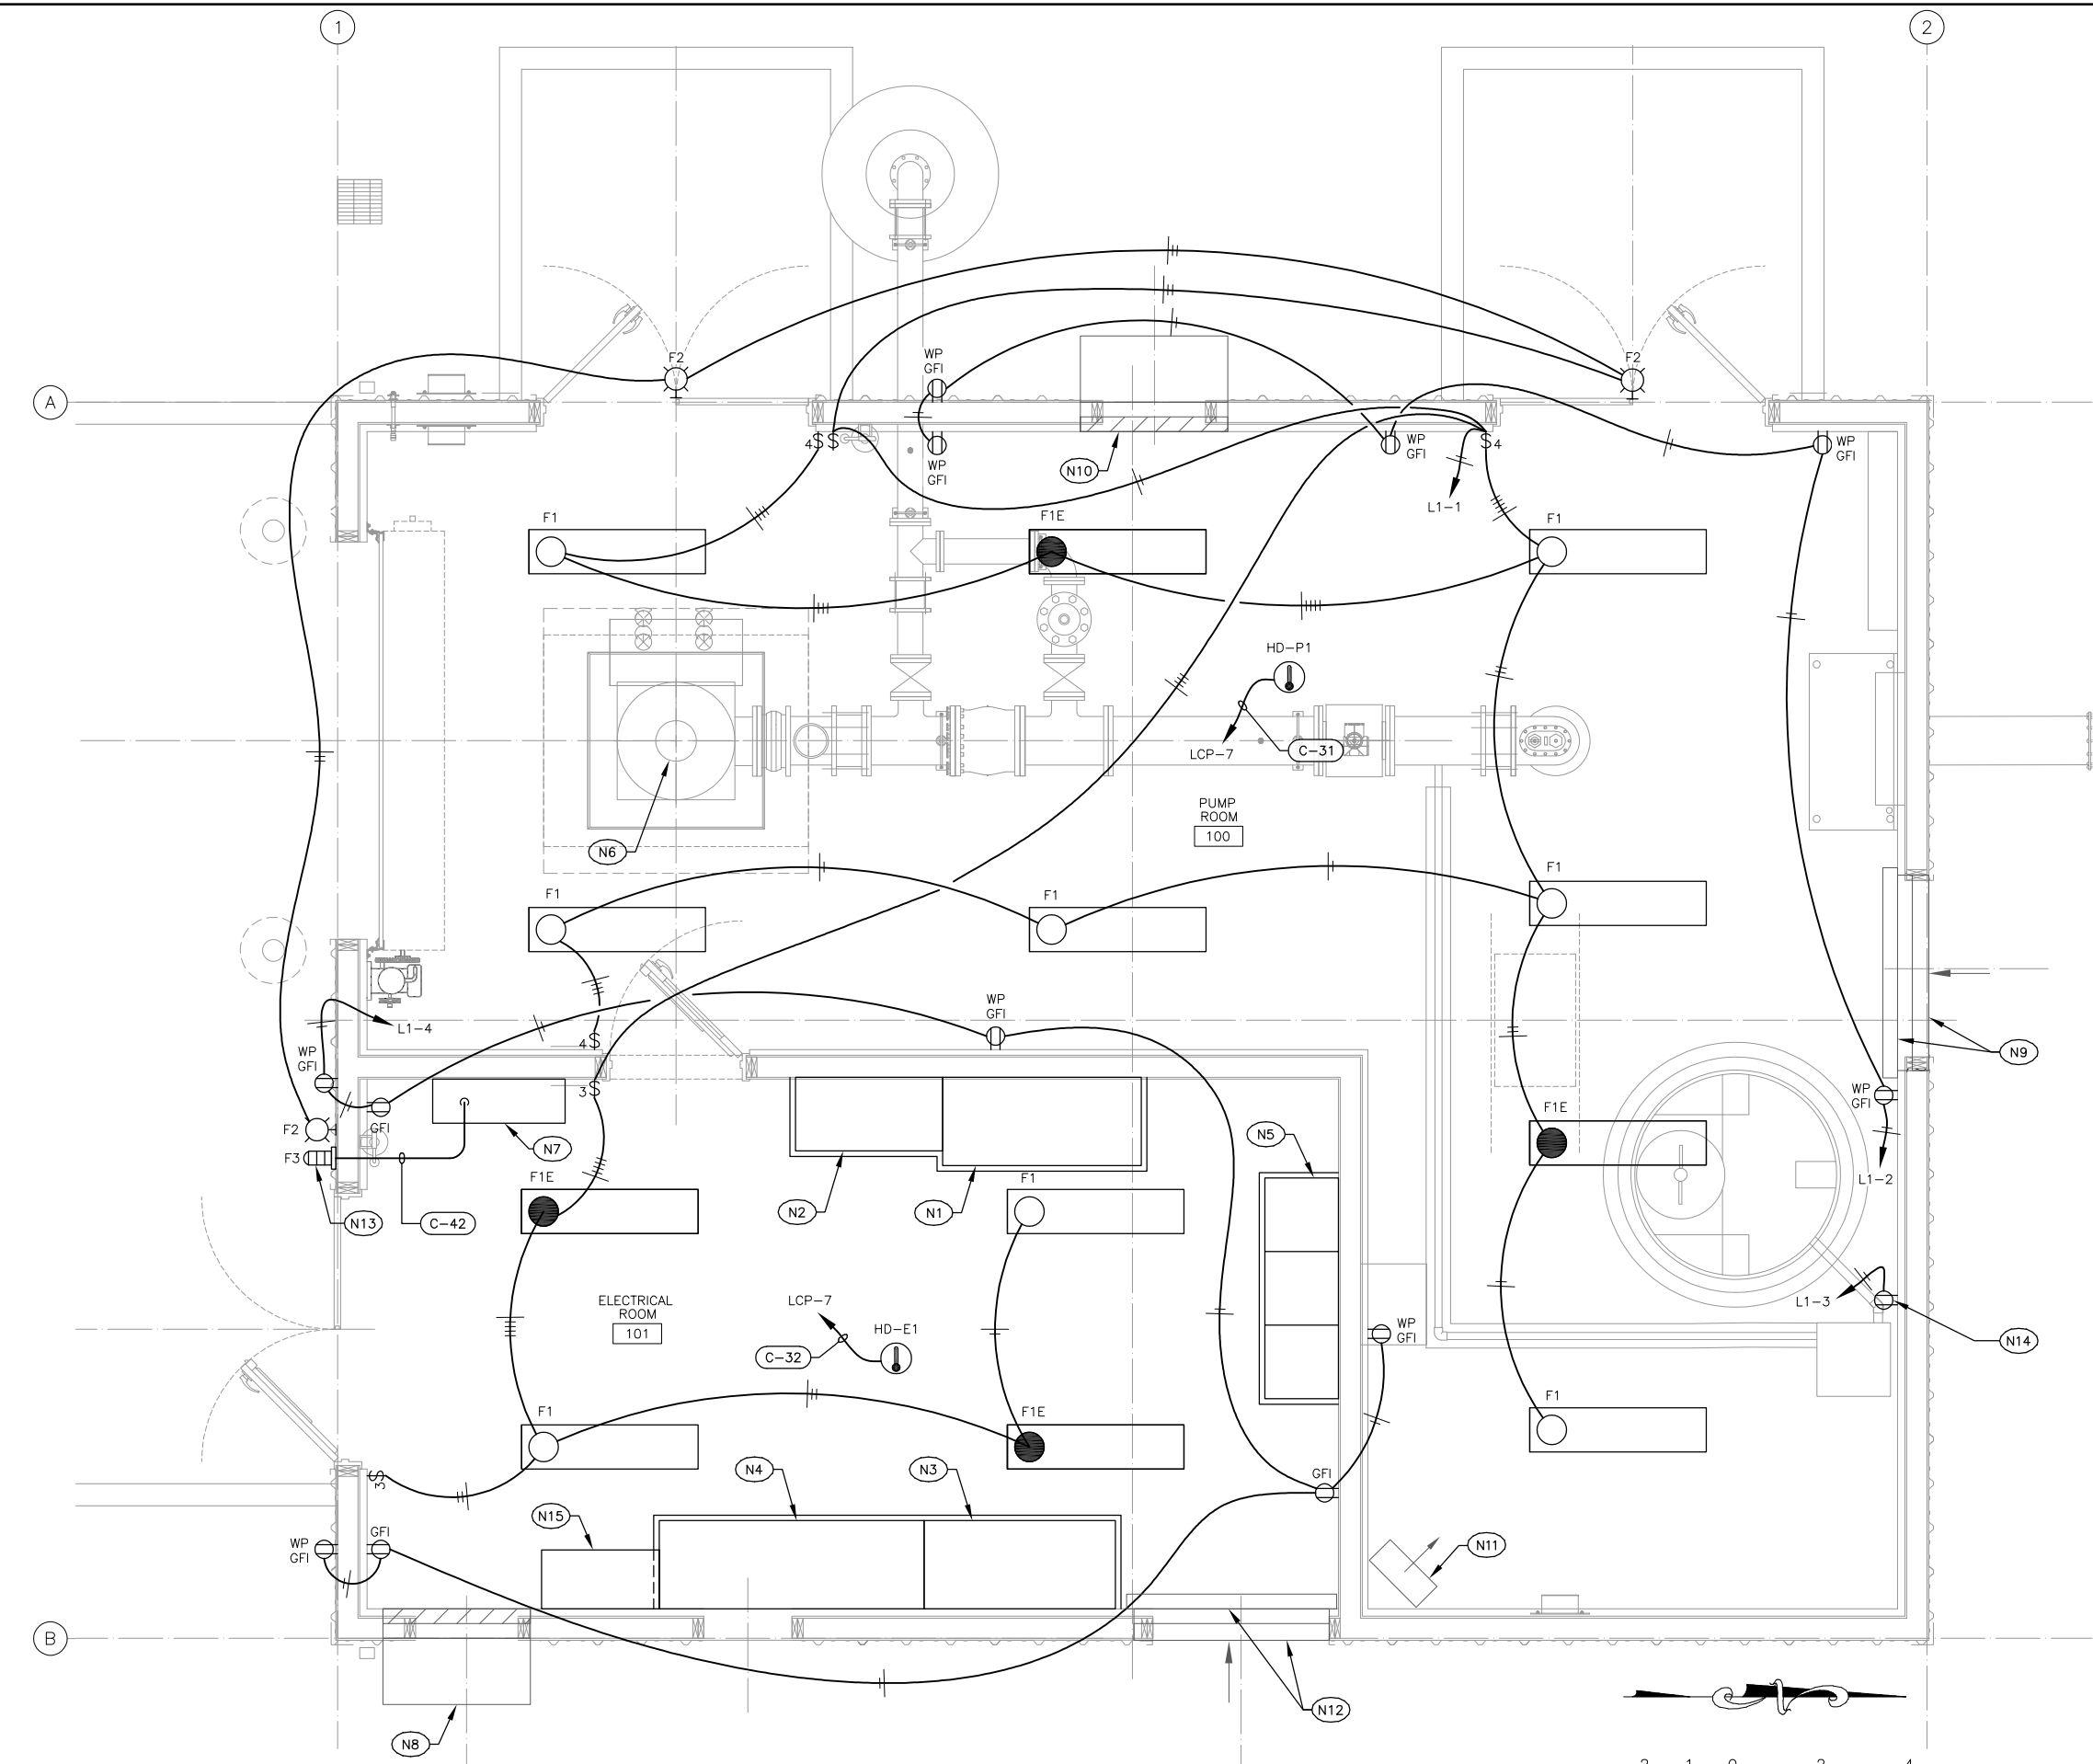

4.1 WELL HOUSE LIGHTING AND RECEPTACLE PLAN
SCALE: 1/2"=1'-0"

NOTES: (for this sheet)

- (N1) MAIN SWITCHBOARD.
- (N2) AUTOMATIC TRANSFER SWITCH.
- (N3) PASSIVE HARMONIC FILTER.
- (N4) WELL PUMP VFD ENCLOSURE.
- (N5) MOTOR CONTROL CENTER "MCC-7".
- (N6) WELL PUMP AND MOTOR.
- (N7) LOCAL CONTROL PANEL "LCP-7".
- (N8) HVAC UNIT "HVAC-1".
- (N9) MOTORIZED LOUVER "ML-1" AND FILTER HOLDER "FH-1".
- (N10) HVAC UNIT "HVAC-2".
- (N11) UNIT HEATER "EUH-1".
- (N12) MOTORIZED LOUVER "ML-2" AND FILTER HOLDER "FH-2".
- (N13) ALARM BEACON.
- (N14) METERING PUMP RECEPTACLE.
- (N15) VFD DISCONNECT.

AEI
Engineering
Incorporated

1038 W. Davidson Avenue
Coeur d'Alene, ID 83814
Phone: 208.746.9010
Fax: 208.746.9026
www.jub.com

JUB
J-U-B ENGINEERS, INC.

J-U-B ENGINEERS, INC.
1630 23rd Ave.
Suite 1101-A
Lewiston, ID 83501
Phone: 208.746.9010
Fax: 208.746.9026
www.jub.com

PROFESSIONAL ENGINEER
18028
STATE OF IDAHO
SCOTT R. JACOBSON

12/01/22

REUSE OF DRAWINGS			
THIS DOCUMENT AND THE IDEAS AND DESIGNS INCORPORATED HEREIN ARE THE PROPERTY OF JUB ENGINEERS, INC. AND ARE NOT TO BE REPRODUCED OR TRANSMITTED IN ANY FORM OR BY ANY MEANS, ELECTRONIC OR MECHANICAL, INCLUDING PHOTOCOPYING, RECORDING, OR BY ANY INFORMATION STORAGE AND RETRIEVAL SYSTEM, WITHOUT THE EXPRESS WRITTEN AUTHORIZATION OF JUB ENGINEERS, INC.			
NO.	REVISION	DATE	BY
1	RECORD DRAWINGS	12/01/22	TLS
0	FOR BID	05/28/21	TLS
B	90% REVIEW	04/28/21	TLS
	DESCRIPTION		


CITY OF LEWISTON
WELL NO. 7
WELL HOUSE LIGHTING AND RECEPTACLE PLAN

FILE: M19102-E-102
JUB PROJ. #:
DRAWN BY: TLS
DESIGN BY: SRJ
CHECKED BY: RJW
AT FULL SIZE, IF NOT ONE
INCH, SCALE ACCORDINGLY
LAST UPDATED: 12/01/22
SHEET NUMBER:


E-102

RECORD DRAWING

Plot Date: 12/5/2022 11:04 AM Plotted By: Ted Schawewski
Date Created: 12/1/2022 3:00 PM M19102-E-103.DWG

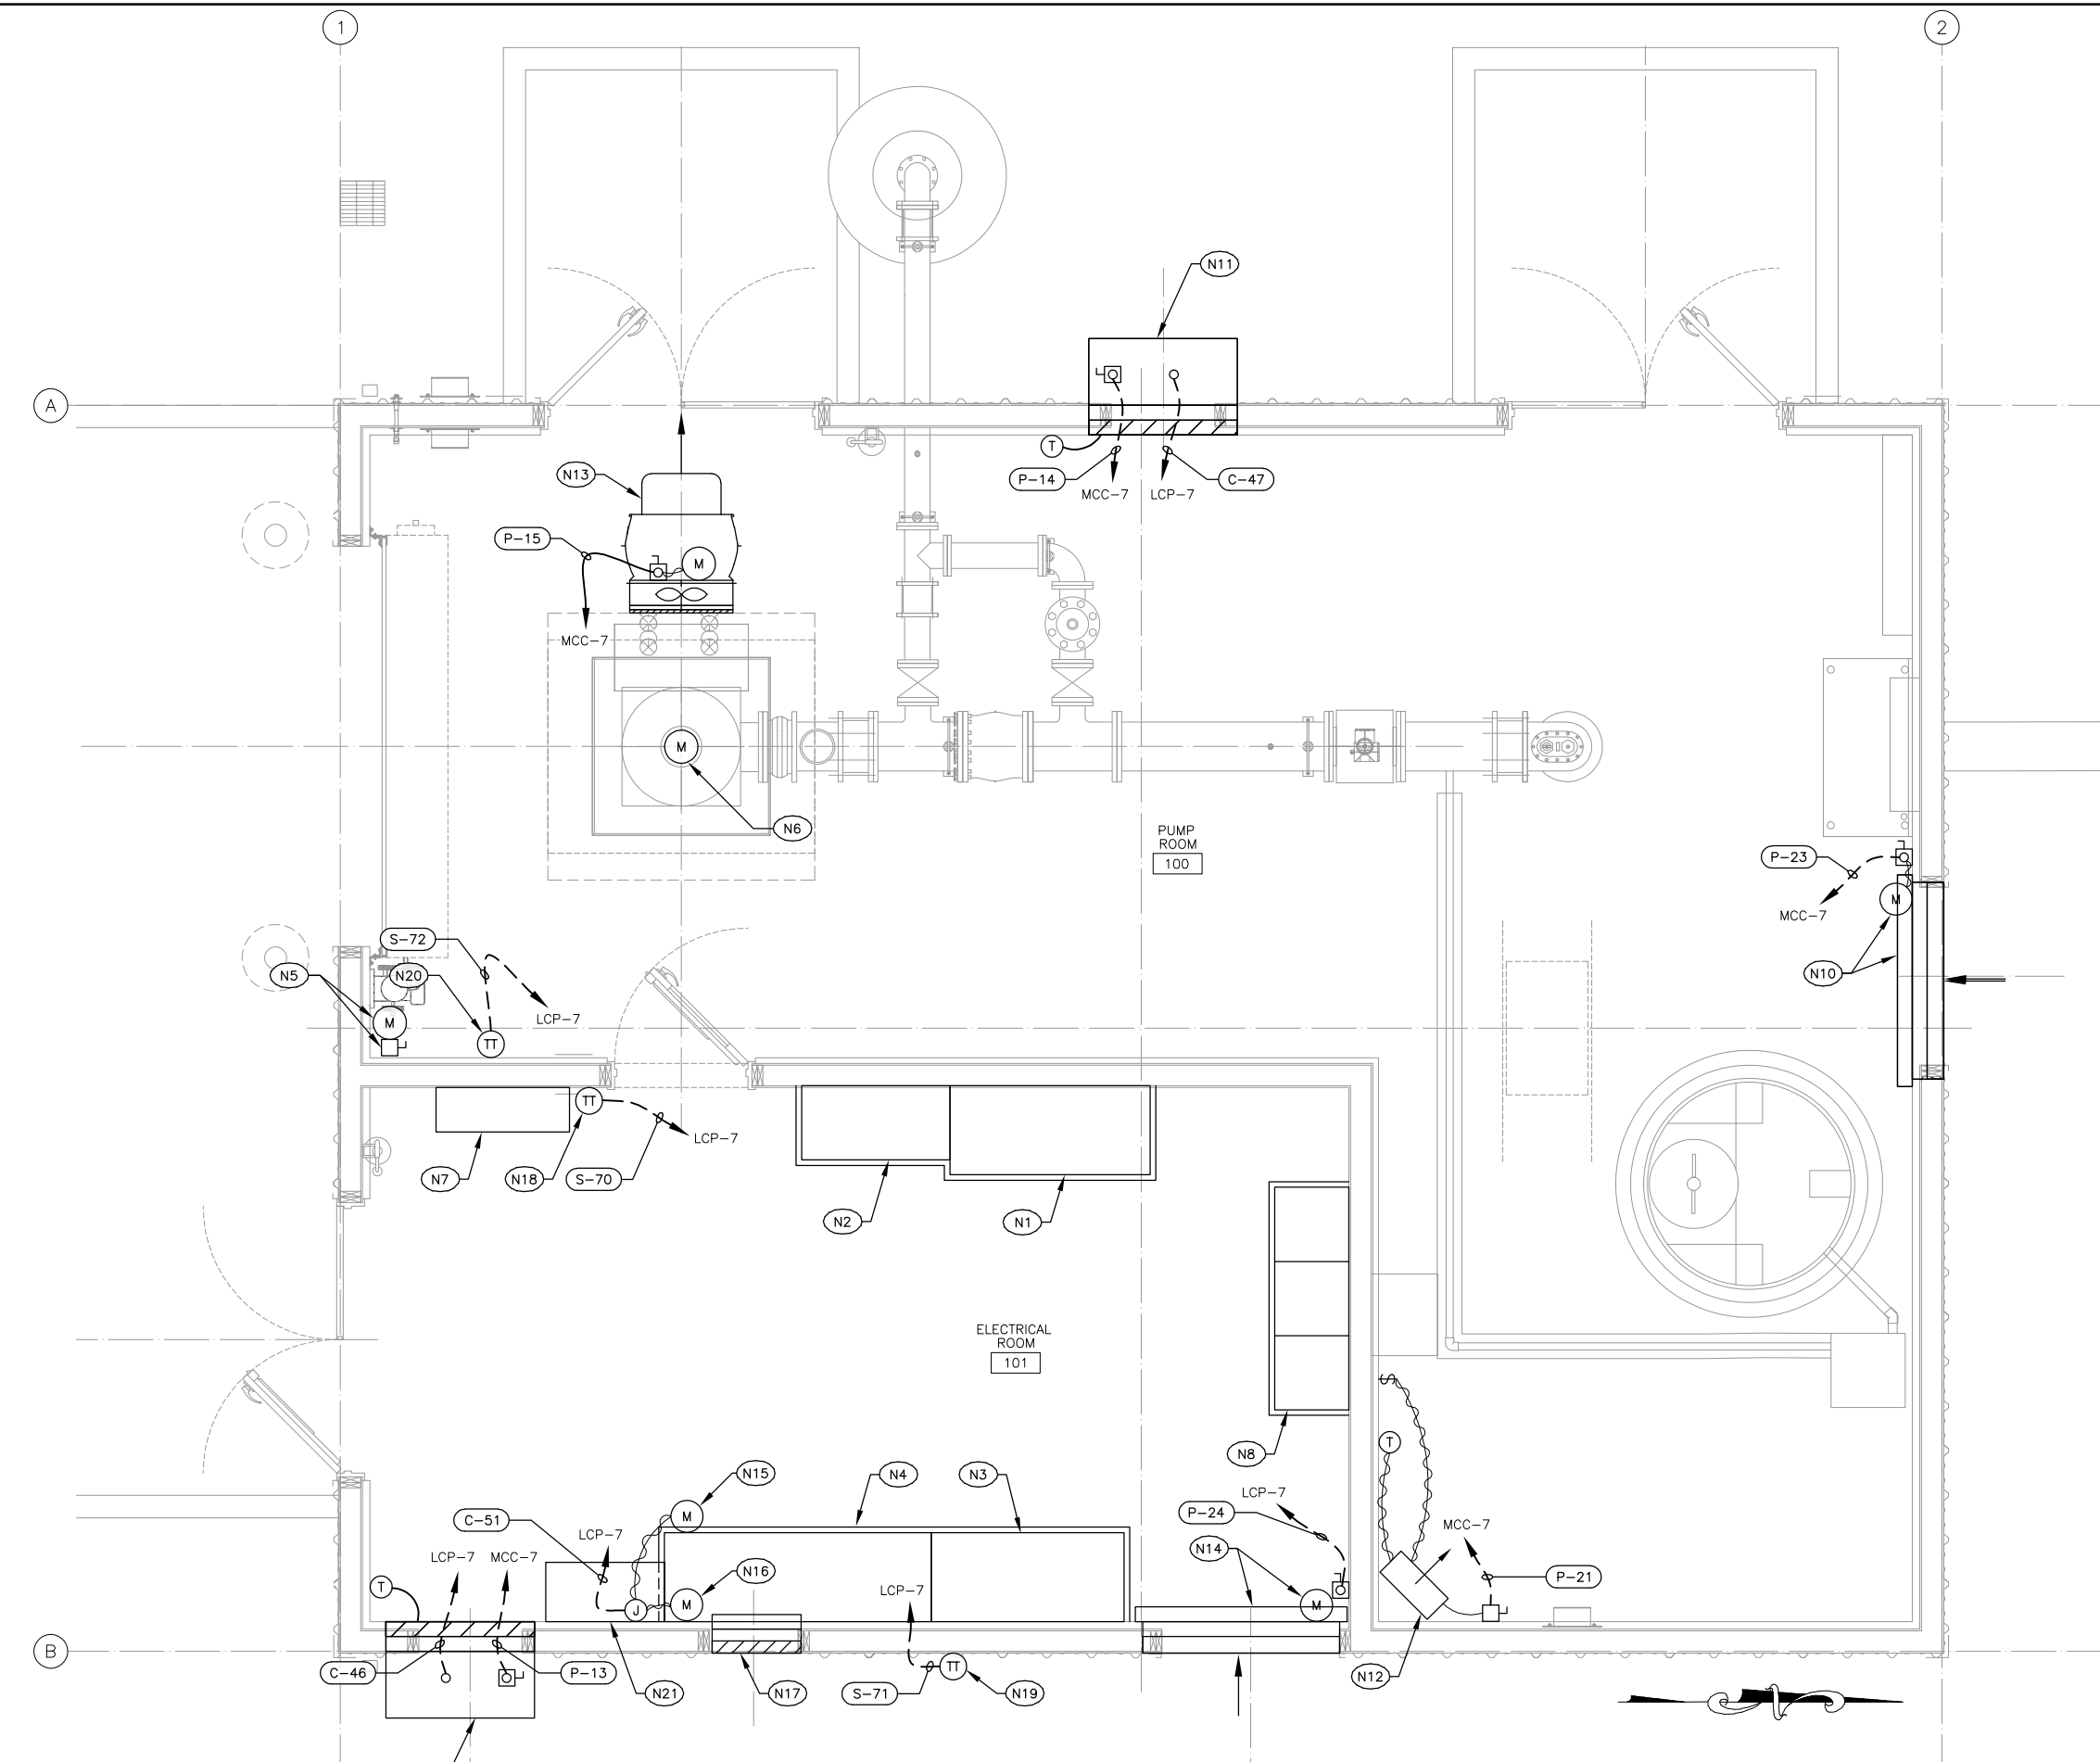

4.1 WELL HOUSE HVAC PLAN
SCALE: 1/2"=1'-0"

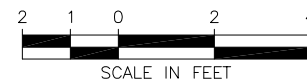

NOTES: (for this sheet)

- (N1) MAIN SWITCHBOARD.
- (N2) AUTOMATIC TRANSFER SWITCH.
- (N3) PASSIVE HARMONIC FILTER.
- (N4) WELL PUMP VFD ENCLOSURE.
- (N5) OVERHEAD DOOR MOTOR AND DISCONNECT.
- (N6) WELL PUMP AND MOTOR.
- (N7) LOCAL CONTROL PANEL "LCP-7".
- (N8) MOTOR CONTROL CENTER "MCC-7".
- (N9) HVAC UNIT "HVAC-1", WITH REMOTE MOUNTED DIGITAL THERMOSTAT. PROVIDE CONDUIT AND WIRE FOR THERMOSTAT AS REQUIRED.
- (N10) MOTORIZED LOUVER "ML-1" AND FILTER HOLDER "FH-1".
- (N11) HVAC UNIT "HVAC-2", WITH REMOTE MOUNTED DIGITAL THERMOSTAT. PROVIDE CONDUIT AND WIRE FOR THERMOSTAT AS REQUIRED.
- (N12) UNIT HEATER "EUH-1" WITH FAN ONLY SWITCH.
- (N13) VENTILATION BLOWER "VB-1".
- (N14) MOTORIZED LOUVER "ML-2" AND FILTER HOLDER "FH-2".
- (N15) VFD VENTILATION EXHAUST DAMPER "LV-1".
- (N16) VFD VENTILATION EXHAUST DAMPER LV-2".
- (N17) 24" X 16" BACK DRAFT DAMPER.
- (N18) TEMPERATURE TRANSMITTER "W7-TT-122".
- (N19) TEMPERATURE TRANSMITTER "W7-TT-123", MOUNTED 8'-0" AFG.
- (N20) TEMPERATURE TRANSMITTER "W7-TT-124".
- (N21) VFD BREAKER.

RECORD DRAWING

1038 W. Davidson Avenue
Coeur d'Alene, ID 83814
(208) 666-4021 office
(208) 666-4021 fax

AEI
Engineering
Incorporated

JUB
J-U-B ENGINEERS, INC.

J-U-B ENGINEERS, INC.
1630 23rd Ave.
Suite 1101-A
Lewiston, ID 83501
Phone: 208.746.9010
Fax: 208.746.9926
www.jub.com

PROFESSIONAL ENGINEER
18028
STATE OF IDAHO
SCOTT R. JACOBSON

12/01/22

THIS DOCUMENT AND THE IDEAS AND DESIGNS INCORPORATED HEREIN ARE THE PROPERTY OF JUB ENGINEERS, INC. THE PROJECT OR PART OF ANY OTHER PROJECT WITHOUT THE EXPRESS WRITTEN AUTHORIZATION OF JUB ENGINEERS, INC.

REVISION	DATE
2	12/01/22
1	06/10/21
0	05/28/21
B	04/28/21
A	04/28/21
NO.	DATE


CITY OF LEWISTON
WELL NO. 7

WELL HOUSE HVAC PLAN

FILE: M19102-E-103
JUB PROJ. #:
DRAWN BY: TLS
DESIGN BY: SRJ
CHECKED BY: RJW
AT FULL SIZE, IF NOT ONE
INCH, SCALE ACCORDINGLY
LAST UPDATED: 12/01/22
SHEET NUMBER:

E-103

Plot Date: 12/25/2022 11:37 AM Plotted By: Ted Schawwecker
Date Created: 12/1/2022 3:03 PM M19102 - JUB - LEWISTON WELL 20 DRAWINGS RECORD DRAWINGS M19102-E-104.DWG

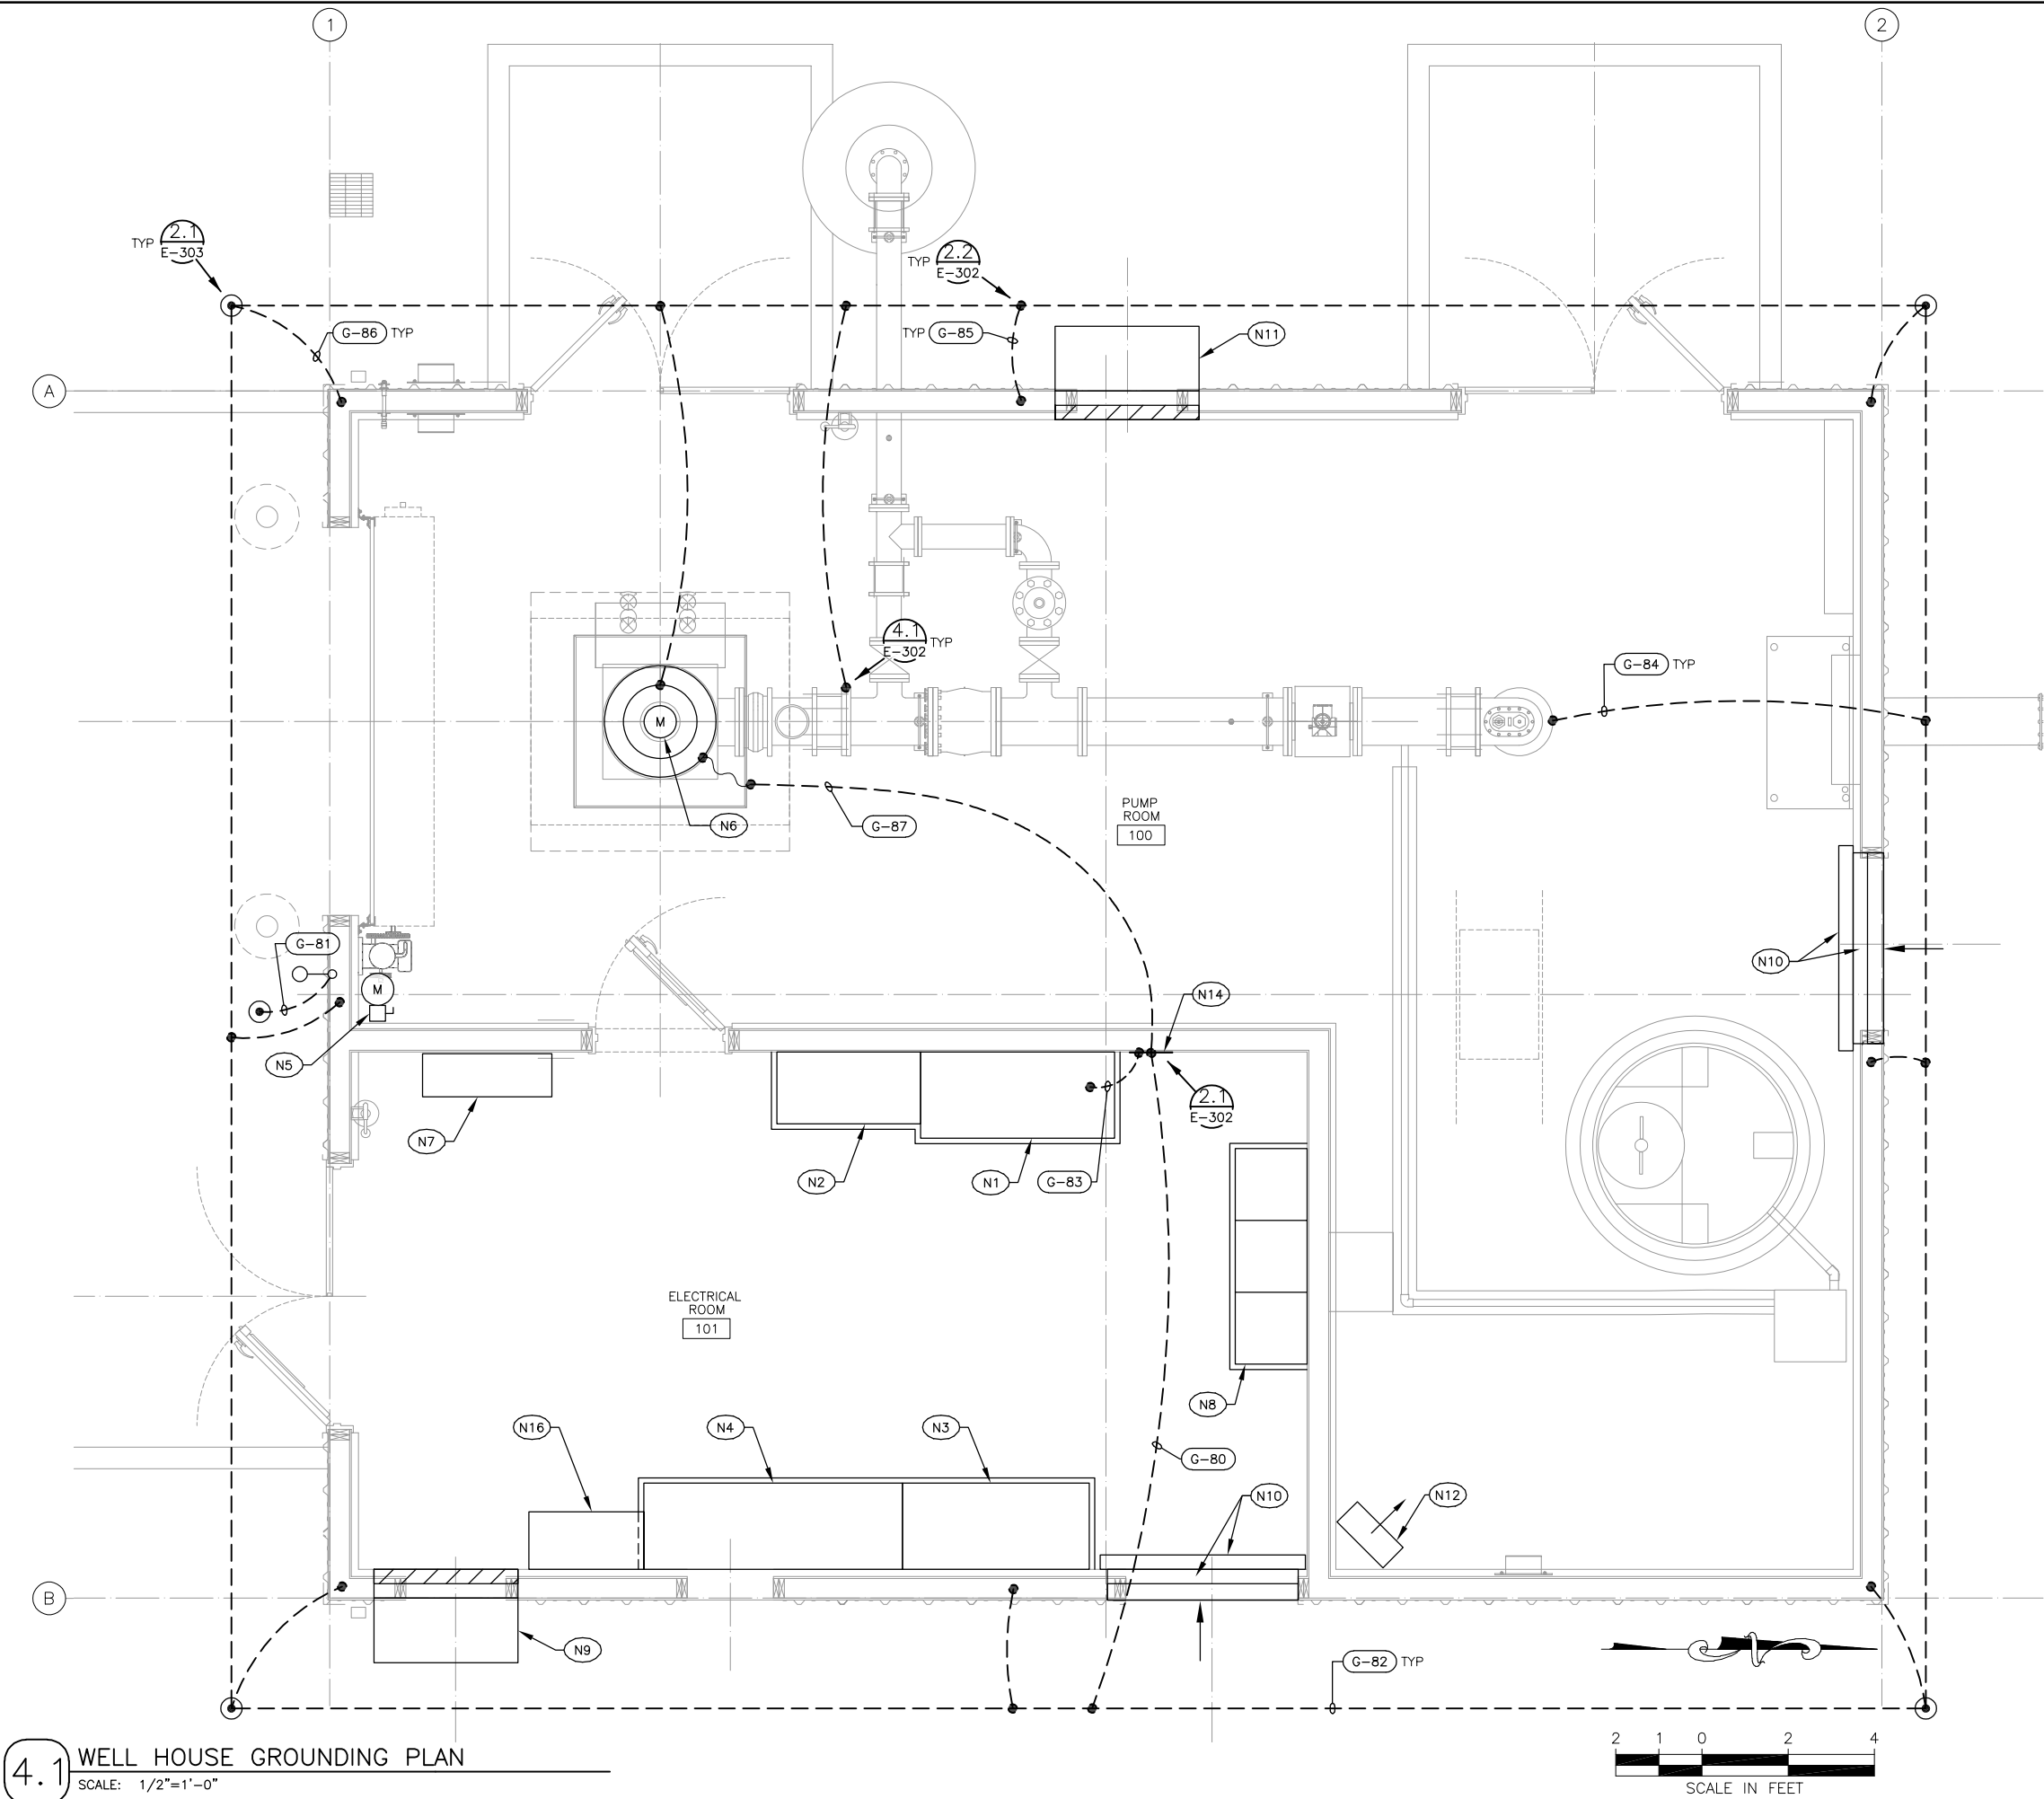

4.1 WELL HOUSE GROUNDING PLAN
SCALE: 1/2"=1'-0"

NOTES: (for this sheet)

- (N1) MAIN SWITCHBOARD.
- (N2) AUTOMATIC TRANSFER SWITCH.
- (N3) PASSIVE HARMONIC FILTER.
- (N4) WELL PUMP VFD ENCLOSURE.
- (N5) OVERHEAD DOOR MOTOR AND DISCONNECT.
- (N6) WELL PUMP MOTOR AND MOTOR CASING.
- (N7) LOCAL CONTROL PANEL "LCP-7".
- (N8) MOTOR CONTROL CENTER "MCC-7".
- (N9) HVAC "HVAC-1".
- (N10) MOTORIZED LOUVER "ML-1" AND FILTER HOLDER "FH-1".
- (N11) HVAC "HVAC-2".
- (N12) UNIT HEATER "EUH-1".
- (N13) TELEMETRY ANTENNA.
- (N14) MAIN GROUND BUS.
- (N15) VFD BREAKER.
- (N16) VFD DISCONNECT.

RECORD DRAWING

1038 W. Davidson Avenue
Coeur d'Alene, ID 83814
(208) 666-4021 office
(208) 666-4021 fax



J-U-B ENGINEERS, INC.
1630 23rd Ave.
Suite 1101-A
Lewiston, ID 83501
Phone: 208.746.9010
Fax: 208.746.9926
www.jub.com




12/01/22

REUSE OF DRAWINGS			
THIS DOCUMENT AND THE IDEAS AND DESIGNS INCORPORATED HEREIN ARE THE PROPERTY OF JUB ENGINEERS, INC. THE REUSE OF THIS DOCUMENT OR ANY PART OF IT FOR ANY OTHER PROJECT WITHOUT THE EXPRESS WRITTEN AUTHORIZATION OF JUB ENGINEERS, INC. IS PROHIBITED.			
NO.	REVISION	DATE	BY
1	RECORD DRAWINGS	12/01/22	TLS
0	FOR BID	05/28/21	TLS
1	90% REVIEW	04/28/21	TLS
2	100% REVIEW	04/28/21	TLS
3	DESCRIPTION	04/28/21	TLS

CITY OF LEWISTON
WELL NO. 7
WELL HOUSE GROUNDING PLAN

FILE: M19102-E-104
JUB PROJ. #:
DRAWN BY: TLS
DESIGN BY: SRJ
CHECKED BY: RJW
AT FULL SIZE, IF NOT ONE INCH, SCALE ACCORDINGLY
LAST UPDATED: 12/01/22
SHEET NUMBER:
E-104

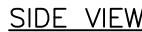

- N1 OPERATOR INTERFACE.
- N2 NEMA 12 STEEL ENCLOSURE.
- N3 MOTION ACTIVATED PANEL LIGHT.
- N4 PANEL TVSS.
- N5 FLANGE MOUNTED UPS.
- N6 CONTROL RELAYS (QUANTITY AS REQUIRED).
- N7 CIRCUIT BREAKERS AND FUSES (QUANTITY AS REQUIRED).
- N8 TERMINAL BLOCKS (QUANTITY AS REQUIRED).
- N9 THREE POINT DOOR PAD LOCKABLE DOOR LATCH.
- N10 PANEL HEATER WITH SELF CONTAINED THERMOSTAT, 400W.
- N11 TAG: LINE 1: "LOCAL CONTROL PANEL"
LINE 2: "LCP-7"
- N12 PLC.
- N13 POWER DISTRIBUTION TERMINAL BLOCK.
- N14 SLOTTED WIREWAY AS REQUIRED.
- N15 CONVENIENCE RECEPTACLE, GFI.
- N16 ETHERNET SWITCH.
- N17 CONTROL PANEL MAIN BREAKER.
- N18 CPU MODULE.
- N19 DI MODULE (QUANTITY AS REQUIRED).
- N20 AI MODULE (QUANTITY AS REQUIRED).
- N21 DO MODULE (QUANTITY AS REQUIRED).
- N22 AO MODULE (QUANTITY AS REQUIRED).
- N23 RADIO.
- N24 12VDC POWER SUPPLY.
- N25 CONDUIT ENTRY SPACE, 6" MIN.
- N26 BULK HEAD LIGHTNING ARRESTOR.
- N27 FOLDOUT SHELF.
- N28 CONTINUE ANTENNA CABLE, OPEN AIR, TO ANTENNA CONDUIT.
- N29 GRACE PORT.

The diagram illustrates a lightning protection system for a radio antenna. A dashed vertical line represents the lightning protection boundary. To the left of this boundary, a 'CELLULAR ANTENNA' is connected to an 'ANTENNA CABLE'. The cable runs vertically and then turns horizontally to the right, crossing the dashed line. At the point of entry, the cable is connected to a 'BULK HEAD LIGHTNING ARRESTOR' (represented by a square box). From the bottom of this arrestor, a ground symbol is shown. The cable continues horizontally into the 'RADIO' enclosure, which is located to the right of the dashed line. Inside the radio enclosure, the cable is connected to an 'ANTENNA' (represented by a square box). The 'RADIO' enclosure also features a 'MODBUS' port (represented by a triangle) and a 'RADIO POWER' section with two terminals: a '+' terminal connected to '12VDC' and a '-' terminal connected to 'COM'.

4.2 LOCAL CONTROL PANEL "LCP-7" WIRING DIAGRAM



RECORD DRAWING

(N1) PASSIVE HARMONIC FILTER CALL TO RUN INPUT TERMINALS.



(N2) CONNECTION TO AND FROM "LCP-7" AND "PHF". "PHF" SHALL ONLY RUN WHEN STANDBY GENERATOR IS NOT SUPPLYING POWER TO THE SYSTEM.



(DOOR MOUNTED)
HIM MOD

VFC ENCLOSURE "VFC"

REFERENCE O&M
MANUAL FOR DETAILED
WIRING DIAGRAMS

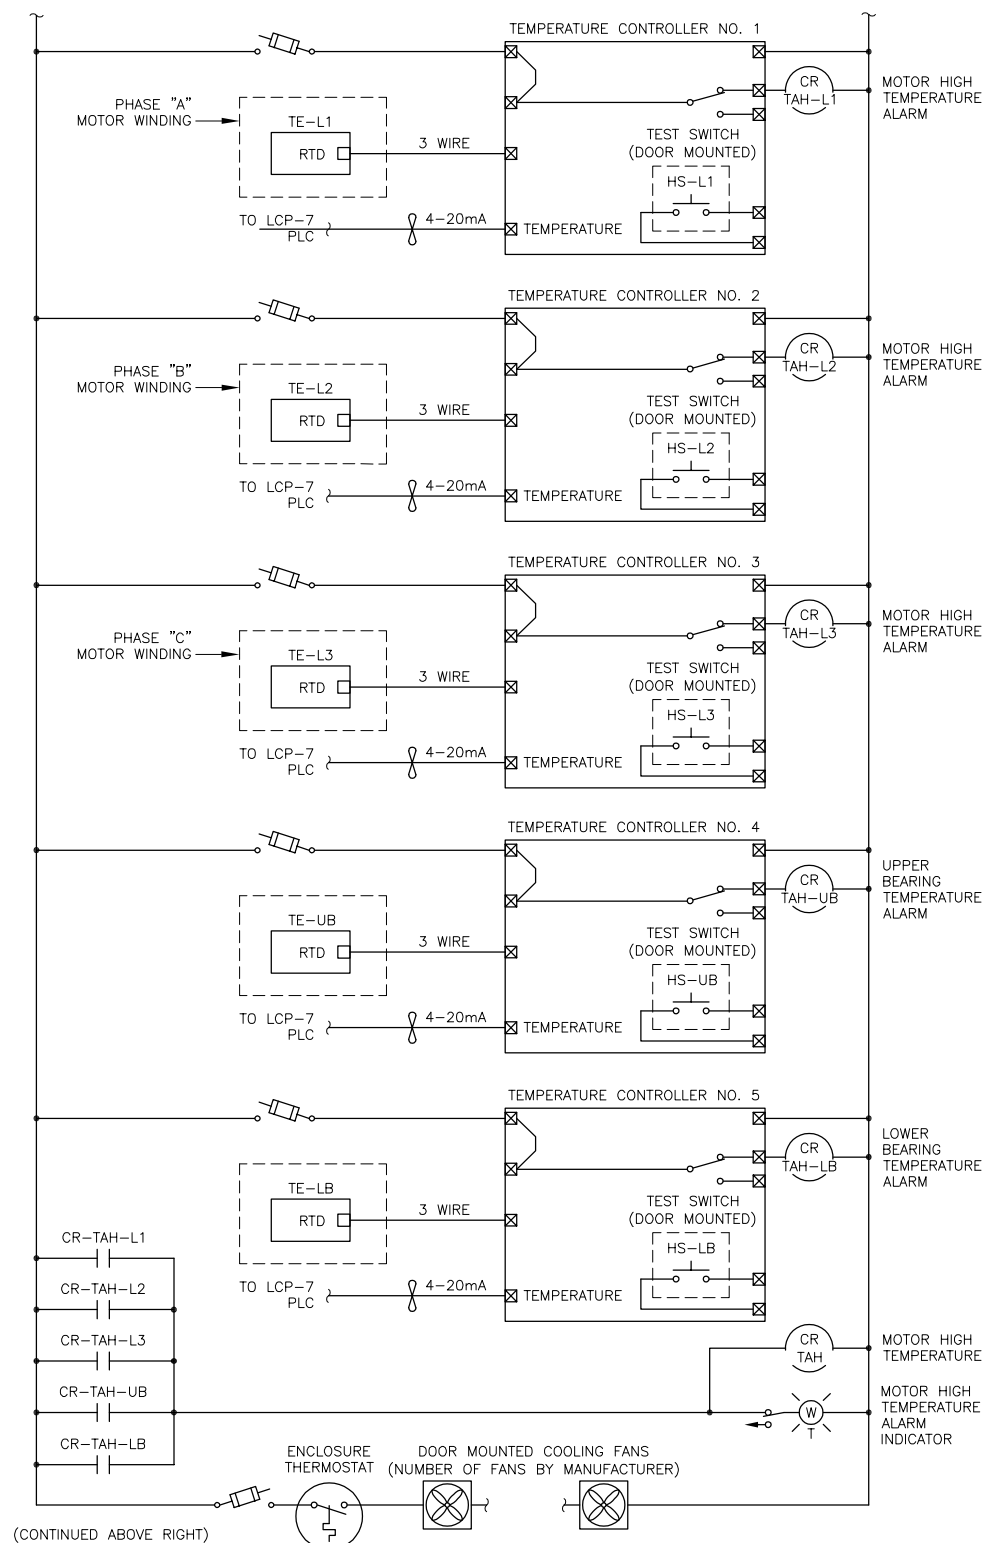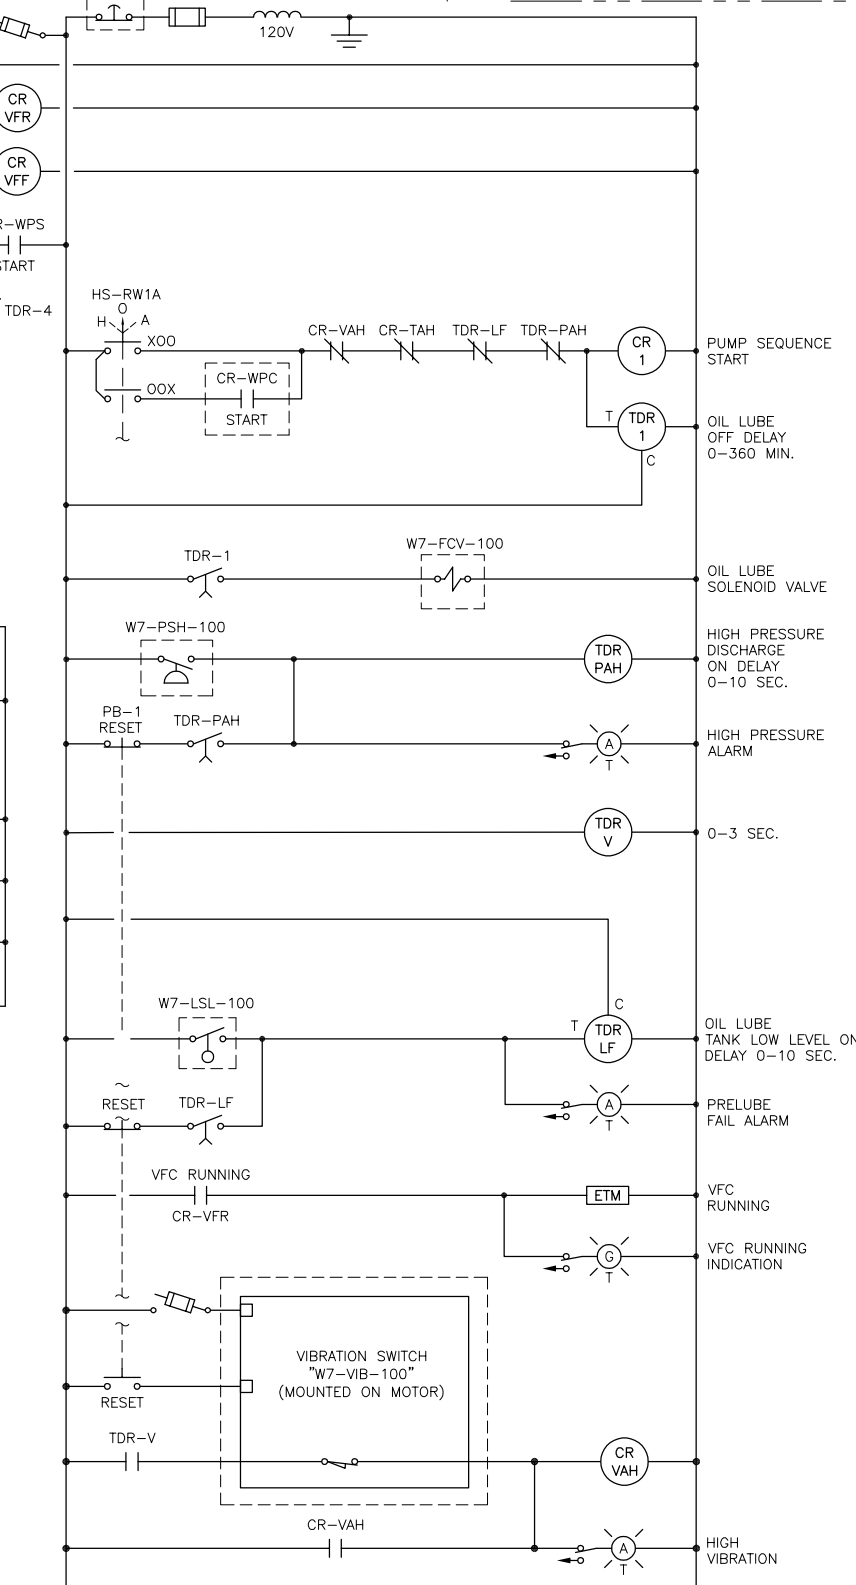


AEI
Engineering
Incorporated

1038 W. Davidson Avenue
Coeur d'Alene, ID 83814
(208) 666-4001 office
(208) 666-4021 fax



J-U-B
J-U-B ENGINEERS, INC.

J-B ENGINEERS, INC.
1630 23rd Ave.
Suite 1101-A
Lewiston, ID 83501
Phone: 208.746.9010
Fax: 208.746.9926
www.jub.com

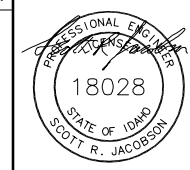


12/01/20

REUSE OF DRAWINGS
THIS DOCUMENT, AND THE IDEAS AND DESIGNS INCORPORATED HEREIN, AS AN INSTRUMENT OF PROFESSIONAL SERVICE, IS THE PROPERTY OF JJB ENGINEERS, Inc. AND IS NOT TO BE USED, IN WHOLE OR PART, FOR ANY OTHER PROJECT WITHOUT THE EXPRESS



REVISION		DATE	BY
2	RECORD DRAWINGS	12/01/22	TLS SRJ
1	ADDENDUM 1	06/10/21	TLS SRJ
0	FOR BID	05/28/21	TLS SRJ
B	90% REVIEW	04/26/21	TLS SRJ
A	30% REVIEW	01/29/21	TLS SRJ

CITY OF LEWISTON
WELL NO. 7

LOCAL CONTROL PANEL "LCP-7" WIRING DIAGRAM

FILE : M19102-E-202
JUB PROJ. # :
DRAWN BY: TLS
DESIGN BY: SRJ
CHECKED BY: RJW

AT FULL SIZE, IF NOT ONE
INCH, SCALE ACCORDINGLY
LAST UPDATED: 12/01/22
SHEET NUMBER:

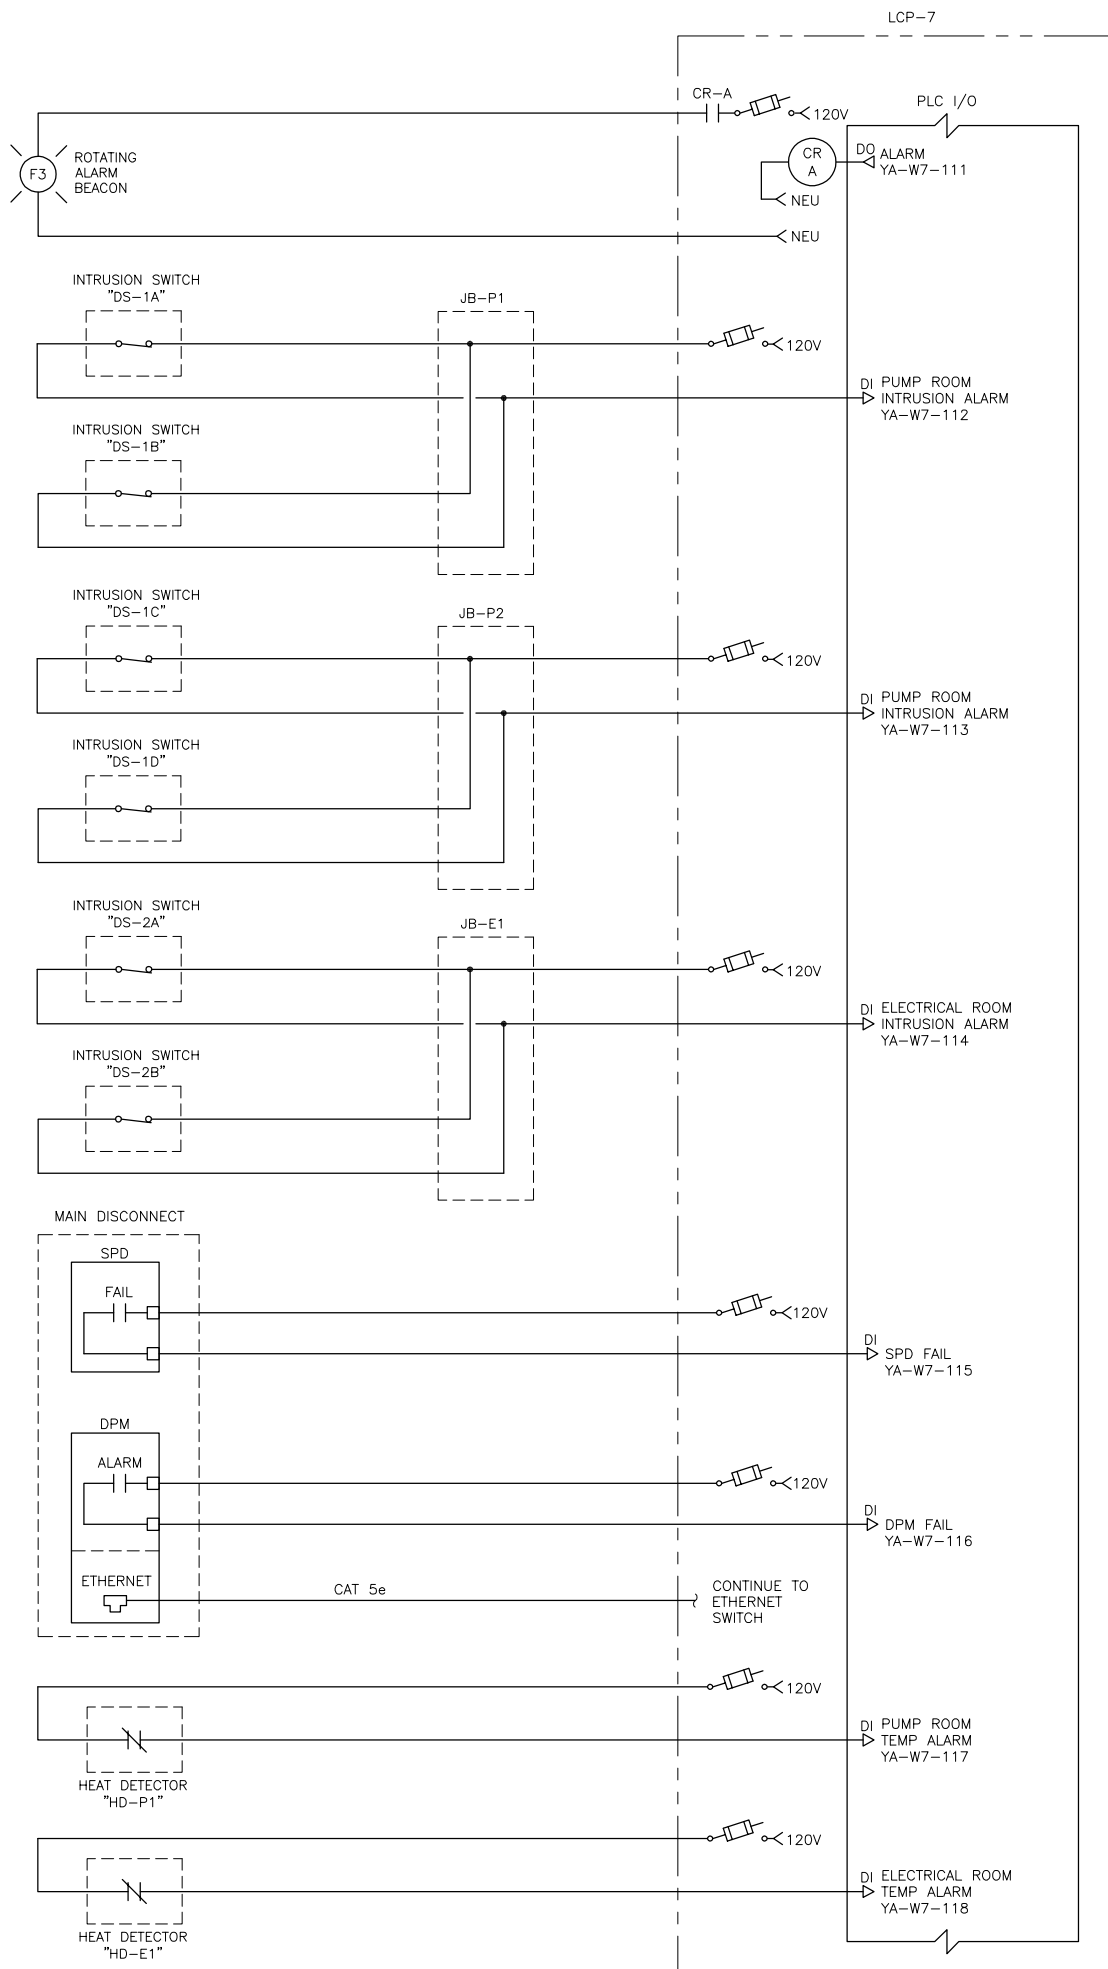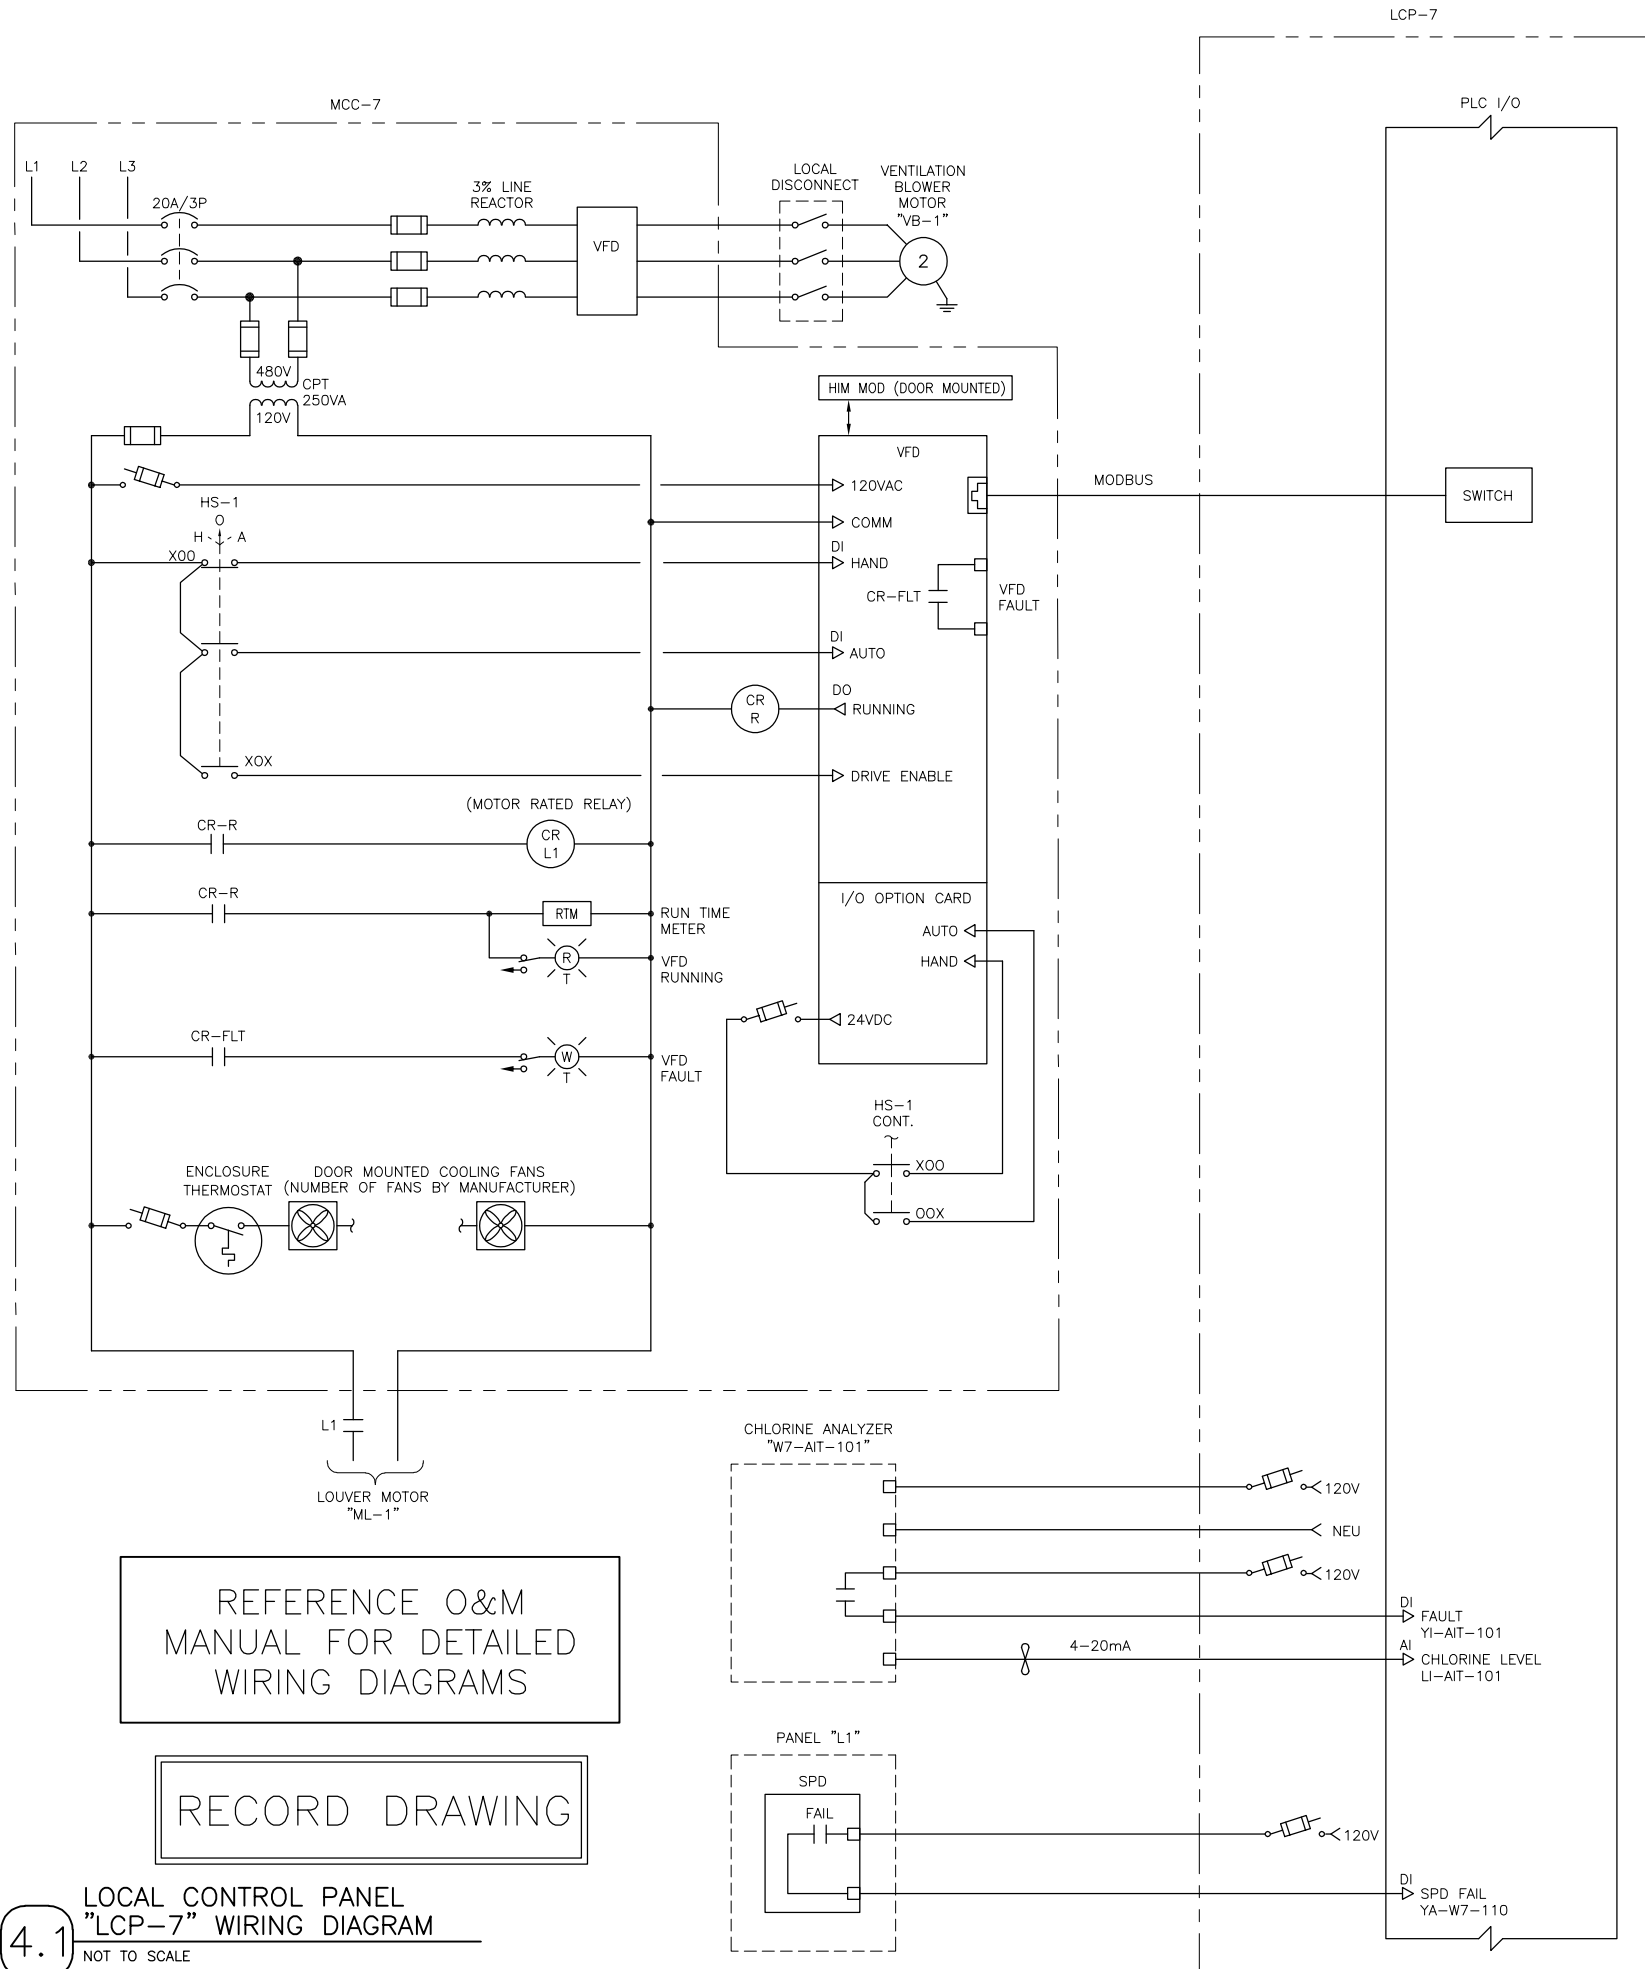E-202



1038 W. Davidson Avenue
Coeur d'Alene, ID 83814
(208) 666-4021 office
(208) 666-4021 fax

AEI
Engineering
Incorporated

JUB
J-U-B ENGINEERS, INC.

J-U-B ENGINEERS, INC.
1630 23rd Ave.
Suite 1101-A
Lewiston, ID 83501
Phone: 208.746.9010
Fax: 208.746.9926
www.jub.com

PROFESSIONAL ENGINEER
18028
STATE OF IDAHO
SCOTT R. JACOBSON

12/01/22

REUSE OF DRAWINGS
THIS DOCUMENT AND THE IDEAS AND DESIGNS INCORPORATED HEREIN ARE THE PROPERTY OF JUB ENGINEERS, INC. THE USER OF THIS DOCUMENT FOR ANY PROJECT WITHOUT THE EXPRESS WRITTEN AUTHORIZATION OF JUB ENGINEERS, INC.

NO.	REVISION	DATE	BY	DATE
1	TLS SRJ	12/01/22		
0	RECORD DRAWINGS FOR BID	05/28/21		
0	90% REVIEW	04/28/21		
B	TLS SRJ	04/28/21		
	DESCRIPTION			

CITY OF LEWISTON
WELL NO. 7


LOCAL CONTROL PANEL "LCP-7"
WIRING DIAGRAM

FILE: M19102-E-203
JUB PROJ. #:
DRAWN BY: TLS
DESIGN BY: SRJ
CHECKED BY: RJW

AT FULL SIZE, IF NOT ONE
INCH, SCALE ACCORDINGLY
LAST UPDATED: 12/01/22

SHEET NUMBER:
E-203

REFERENCE O&M
MANUAL FOR DETAILED
WIRING DIAGRAMS

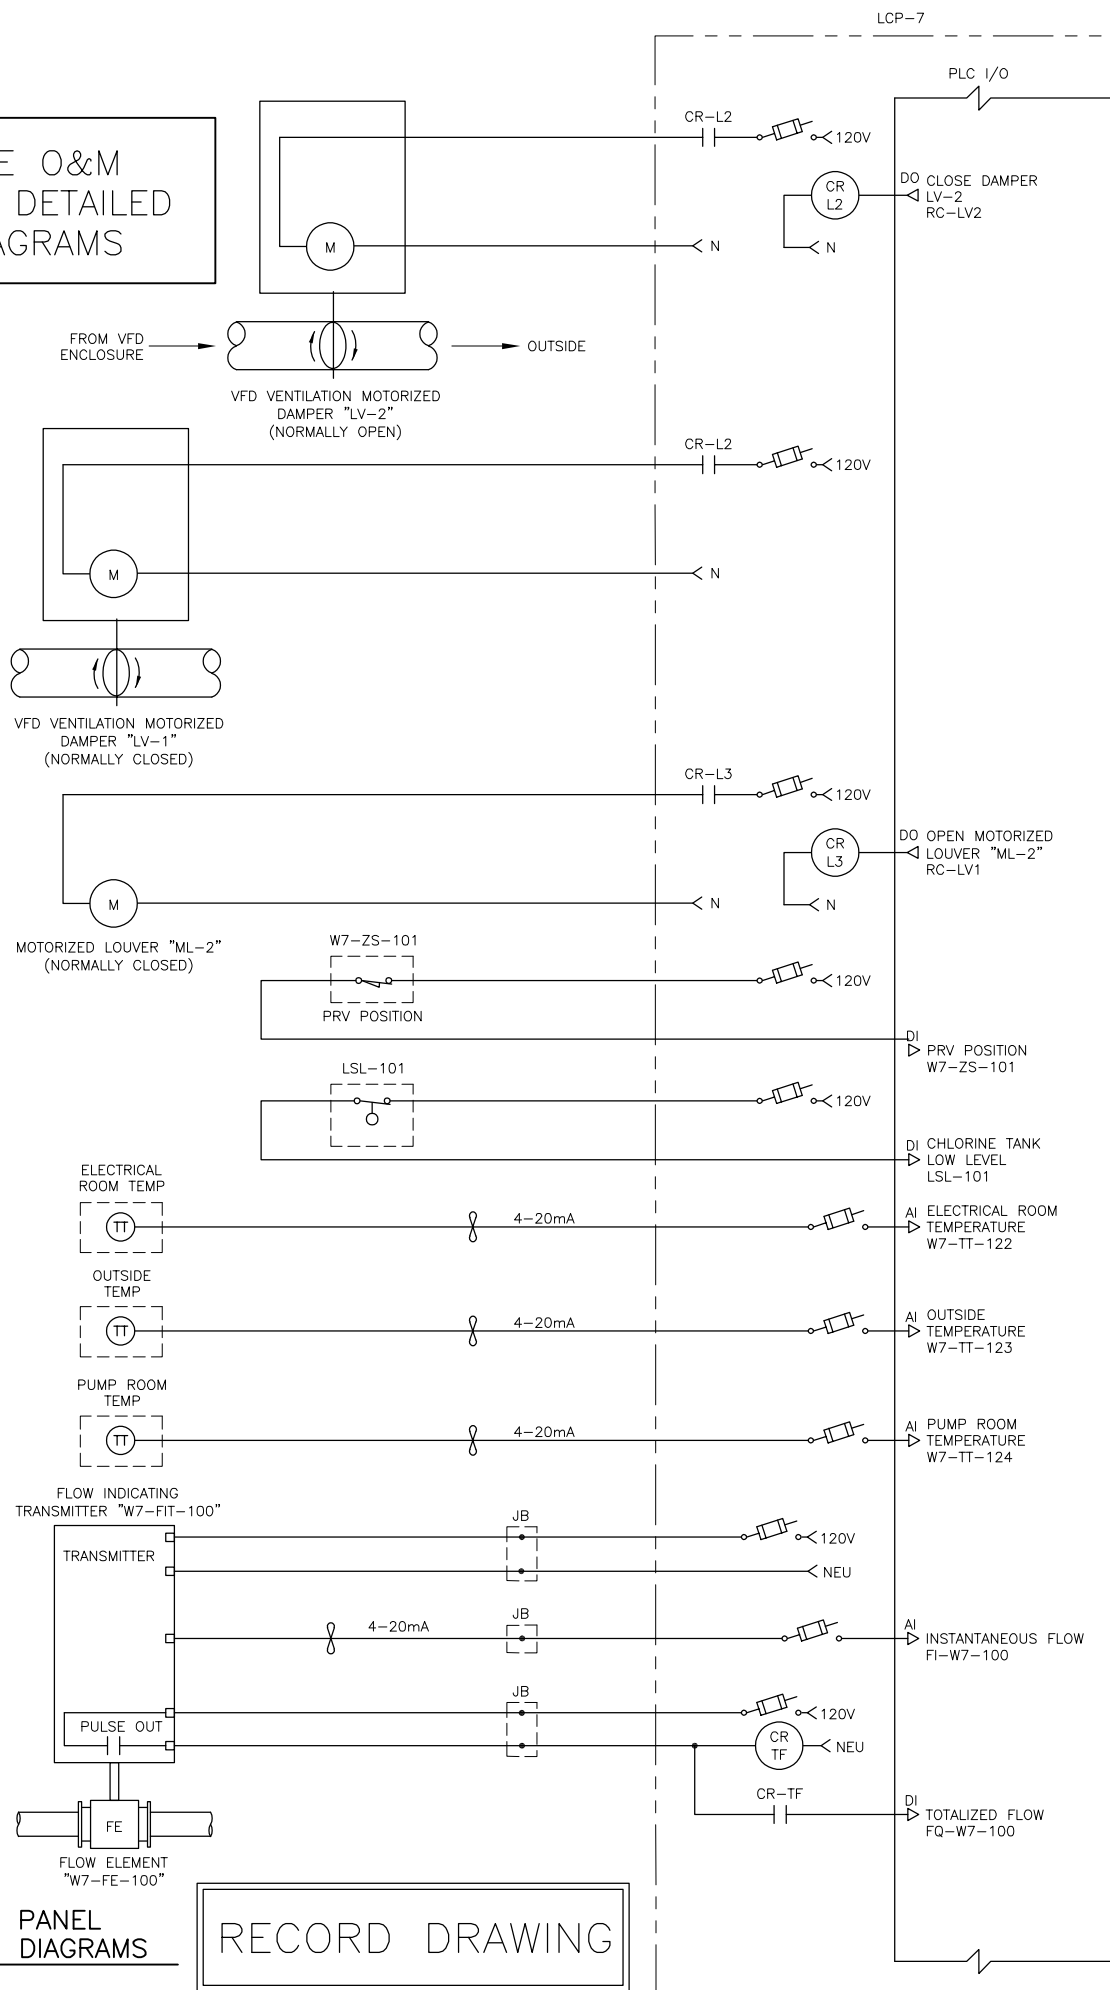


4.1

LOCAL CONTROL PANEL
"LCP-7" WIRING DIAGRAMS

NOT TO SCALE

RECORD DRAWING

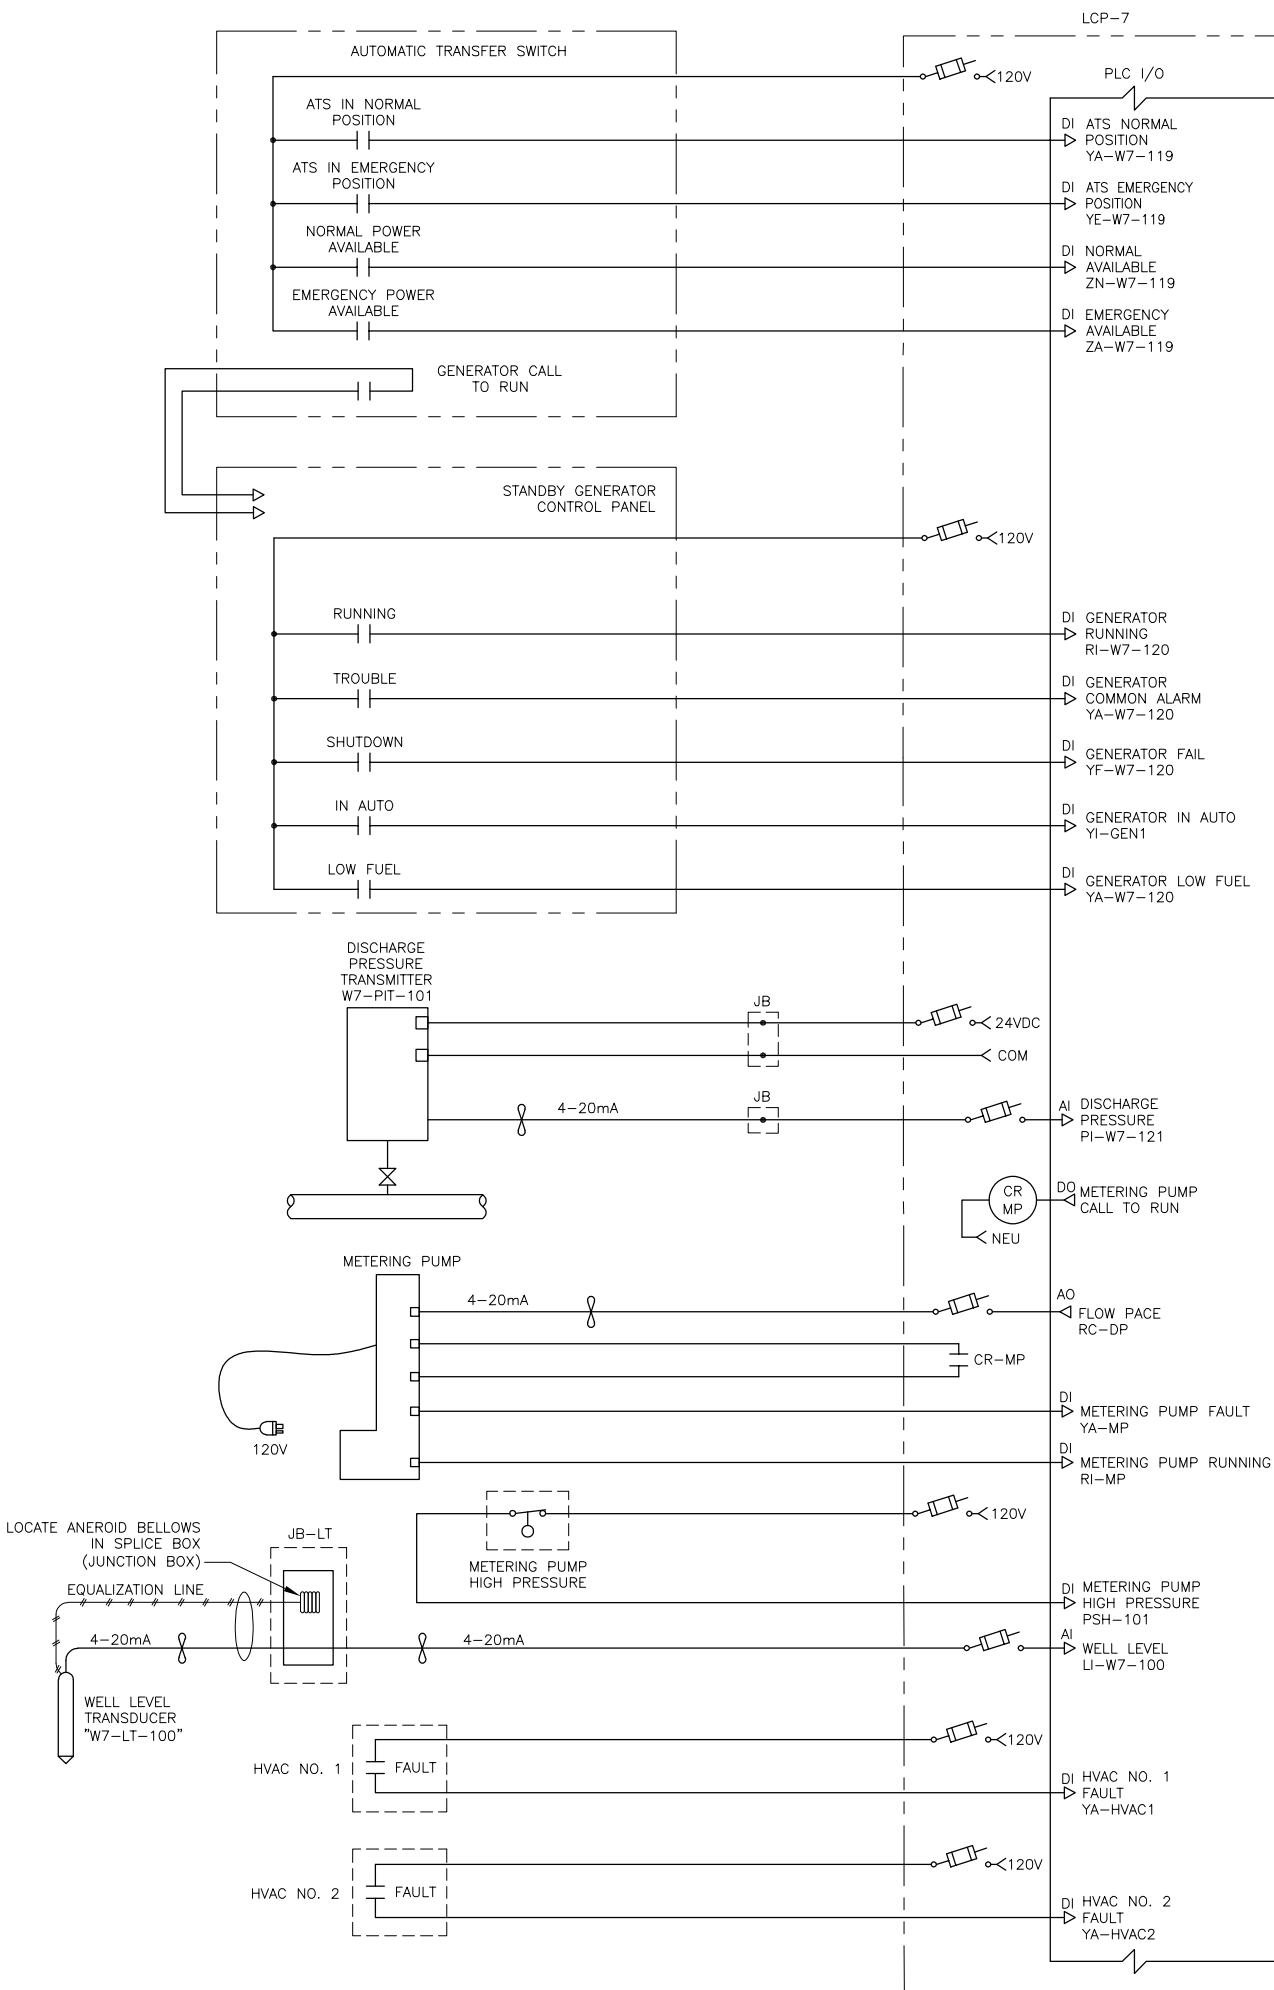

Plot Date: 12/5/2022 11:25 AM Plotted By: Ted Schaeffer
Date Created: 12/1/2022 3:00 PM M19102-E-301-JUB-LEWISTON WELL 2 DRAWINGS RECORD DRAWINGS M19102-E-301.DWG

4.1 "MCC-7" ELEVATION AND SCHEDULE
NOT TO SCALE

MCC-7 NAMEPLATE SCHEDULE		
NP1		NP2
1A	DOOR	
1H	24VDC POWER	SUPPLY
1J	SPARE	
1L	SPARE	
1N	HVAC-1	
1P	HVAC-2	
1R	DOOR	
1S	MAIN BREAKER	
2A	PANELBOARD "L1"	
2J	SPARE	
2L	DOOR	
2M	TRANSFORMER	"T1"
3A	EUH-1	
3C	VFD LINE	REACTOR
3E	"VB-1" VFD	
3J	DOOR	
3V	DOOR	


NOTES: (for this sheet)

- (N1) WELL PUMP VFD ENCLOSURE.
(N2) PASSIVE HARMONIC FILTER.
(N3) AUTOMATIC TRANSFER SWITCH.
(N4) MAIN DISCONNECT.
(N5) DIGITAL PANEL METER.
(N6) REMOVE FACTORY DISCHARGE DIFFUSERS AND PROVIDE NEW DUCTWORK WITH MOTORIZED DAMPERS. DUCTWORK SHALL BE 36"W X 22"H MIN. SIZE DUCTWORK TO ACCOMMODATE SPECIFIC VFC EXHAUST ARRANGEMENT AND SUPPLIED MOTORIZED DAMPERS. SHEET METAL SHALL BE GALVANIZED STEEL, 20 GAUGE MINIMUM.
(N7) VFD VENTILATION EXHAUST LOUVER "LV-1".
(N8) VFD VENTILATION EXHAUST LOUVER "LV-2".
(N9) MOTOR CONTROL CENTER "MCC-7".
(N10) ALL DIMENSIONS ARE APPROXIMATE, EQUIPMENT MUST FIT IN SPACE PROVIDED.
(N11) VFD DISCONNECT.


RECORD DRAWING

4.2 NOTES
NOT TO SCALE

2.2 MAIN DISCONNECT & ATS
ELEVATION DETAIL
NOT TO SCALE

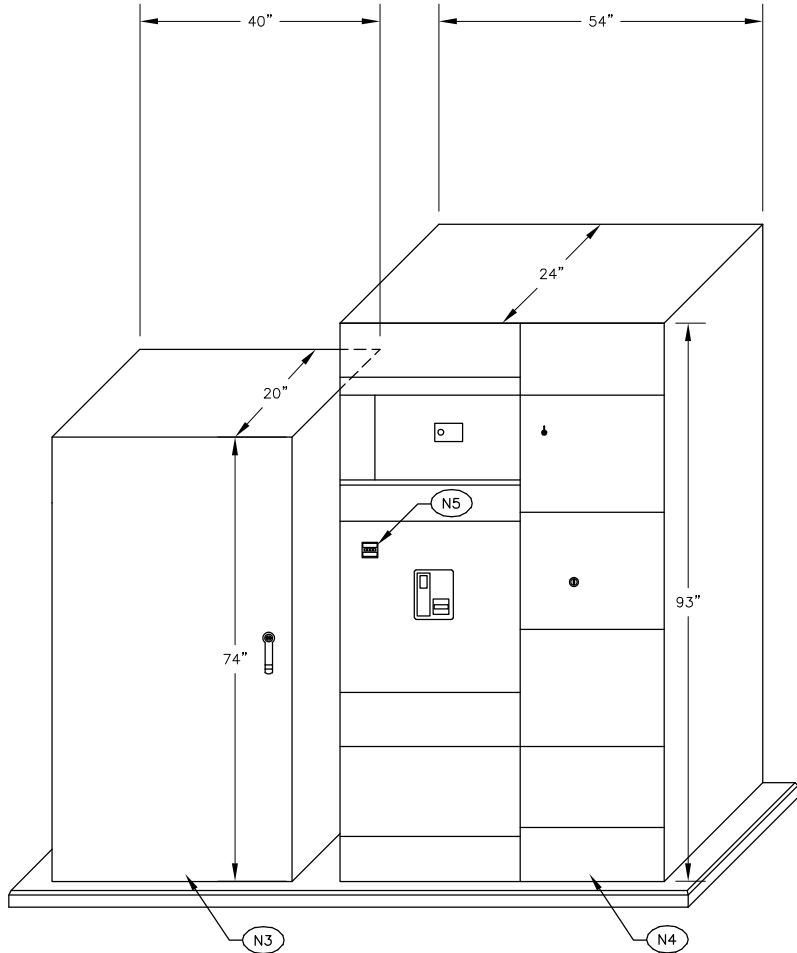

2.3 WELL PUMP VFD &
HARMONIC FILTER ELEVATION DETAIL
NOT TO SCALE

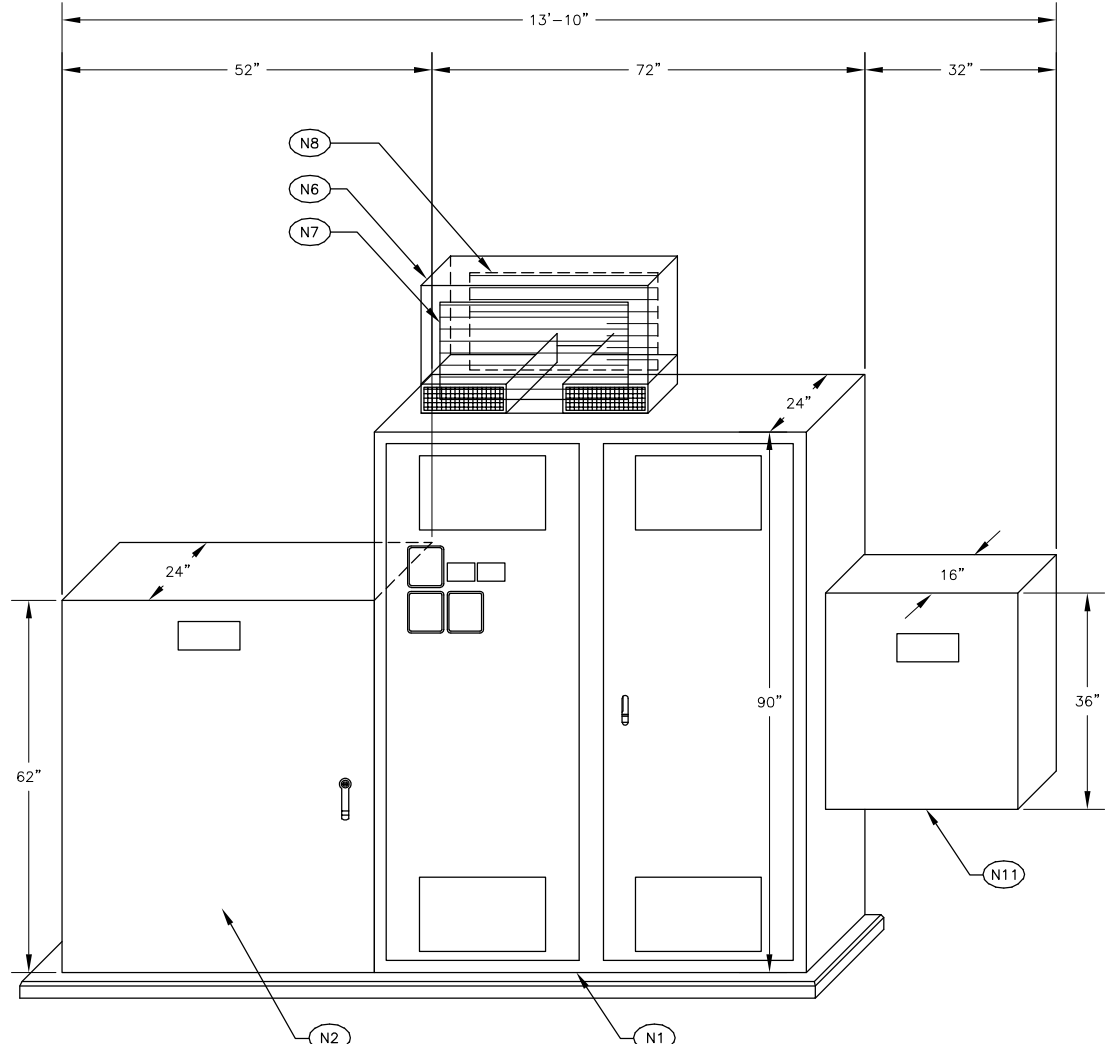

HVAC SYSTEM CONTROL DESCRIPTION		
TAG	DESCRIPTION	NOTES
VFC VENTILATION EXHAUST LOUVER "LV-1"	OPEN WHEN NOT EXHAUSTING AIR IN ELECTRICAL ROOM TO THE OUTSIDE, WHEN "HVAC-1" IS RUNNING. CLOSED WHEN AIR IN ELECTRICAL ROOM IS EXHAUSTING OUTSIDE.	"LV-1" AND "LV-2" ARE BOTH CONTROLLED BY THE SAME RELAY, CR-L2. ONE WILL ALWAYS BE OPEN WHILE THE OTHER IS CLOSED.
VFC VENTILATION EXHAUST LOUVER "LV-2"	CLOSED WHEN NOT EXHAUSTING AIR IN ELECTRICAL ROOM TO THE OUTSIDE, WHEN "HVAC-1" IS RUNNING. OPEN WHEN AIR IN ELECTRICAL ROOM IS EXHAUSTING OUTSIDE.	"LV-1" AND "LV-2" ARE BOTH CONTROLLED BY THE SAME RELAY, CR-L2. ONE WILL ALWAYS BE OPEN WHILE THE OTHER IS CLOSED.
ELECTRICAL ROOM HVAC, "HVAC-1"	OPERATES WHEN AIR TEMPERATURE IN ELECTRICAL ROOM > 80 DEG F, OR USER DEFINED SET POINT.	WHILE OPERATING: "ML-2" CLOSED "LV-1" OPEN "LV-2" CLOSED
PUMP ROOM HVAC, "HVAC-2"	OPERATES WHEN AIR TEMPERATURE IN PUMP ROOM > 80 DEG F, OR USER DEFINED SET POINT.	WHILE OPERATING: "ML-1" CLOSED "VB-1" NOT RUNNING
PUMP ROOM VENTILATION BLOWER "VB-1"	OPERATES WHEN AIR TEMPERATURE IN PUMP ROOM IS BETWEEN 60 DEG F - 80 DEG F, OR USER DEFINED SET POINTS, OR MANUALLY FROM SELECTOR SWITCH ON "MCC-7" BUCKET.	WHILE OPERATING: "ML-1" OPEN "HVAC-2" NOT RUNNING
PUMP ROOM MOTORIZED LOUVER "ML-1"	OPEN WHEN CIRCULATING OUTSIDE AIR IN PUMP ROOM. CONTROLLED BY RELAY CR-L1.	WHILE OPEN: "VB-1" RUNNING "HVAC-2" NOT RUNNING
ELECTRICAL ROOM MOTORIZED LOUVER "ML-2"	OPEN WHEN CIRCULATING OUTSIDE AIR IN ELECTRICAL ROOM. CONTROLLED BY RELAY CR-L3.	WHILE OPEN: "LV-1" CLOSED "LV-2" OPEN "HVAC-1" NOT OPERATING

4.3 HVAC SYSTEM CONTROL DESCRIPTION
NOT TO SCALE

1038 W. Davidson Avenue
Coeur d'Alene, ID 83814
(208) 686-4021 office
(208) 686-4021 fax

AEI
Engineering
Incorporated

JUB
J-U-B ENGINEERS, INC.

J-U-B ENGINEERS, INC.
1630 23rd Ave.
Suite 1101-A
Lewiston, ID 83501
Phone: 208.746.9010
Fax: 208.746.9926
www.jub.com

PROFESSIONAL ENGINEER
18028
STATE OF IDAHO
SCOTT R. JACOBSON

12/01/22

THIS DOCUMENT AND THE IDEAS AND DESIGNS INCORPORATED HEREIN ARE THE PROPERTY OF JUB ENGINEERS, INC. THE PROJECT OR PART OF ANY OTHER PROJECT WITHOUT THE EXPRESS WRITTEN AUTHORIZATION OF JUB ENGINEERS, INC.

REVISION		REVISION	DATE
1	RECORD DRAWINGS	TLS SRJ	12/01/22
0	FOR BID	TLS SRJ	05/28/21
0	90% REVIEW	TLS SRJ	04/28/21
0	100% REVIEW	TLS SRJ	04/28/21
NO.	DESCRIPTION	BY	DATE


CITY OF LEWISTON
WELL NO. 7

ELEVATION DETAILS

FILE: M19102-E-301
JUB PROJ. #:
DRAWN BY: TLS
DESIGN BY: SRJ
CHECKED BY: RJW
AT FULL SIZE, IF NOT ONE
INCH, SCALE ACCORDINGLY
LAST UPDATED: 12/01/22

SHEET NUMBER:


E-301

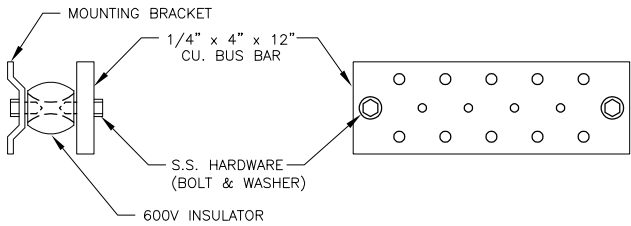

SIDE VIEW

FRONT VIEW


2.1 GROUND BUS BAR DETAIL
NOT TO SCALE

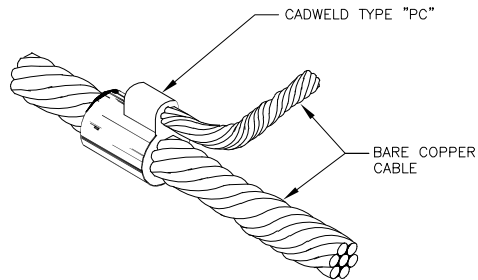


NOTES:

- GROUND MAT CABLES SHALL BE BURIED A MINIMUM OF 2'-6\"
- GROUND CABLE \"TEE\" CONNECTIONS SHALL BE USED AT GROUND MAT CABLE INTERSECTIONS AROUND THE PERIMETER OF GROUND MAT.
- GROUND CABLE \"CROSS\" CONNECTIONS SHALL BE USED AT GROUND MAT CABLE INTERSECTIONS WITHIN THE PERIMETER OF GROUND MAT.
- CADWELD TYPE LISTED FOR REFERENCE ONLY AND DOES NOT PRECLUDE ANY OTHER MANUFACTURERS.

2.2 HORIZONTAL TEE CONNECTION DETAIL
NOT TO SCALE

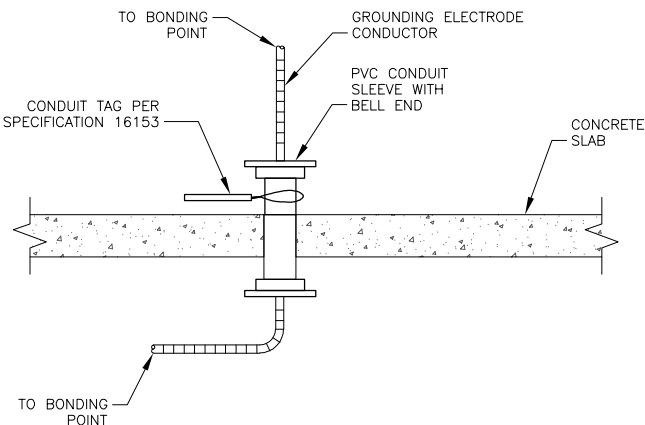


4.1 TYPICAL GROUNDING CONDUCTOR SLEEVE
NOT TO SCALE

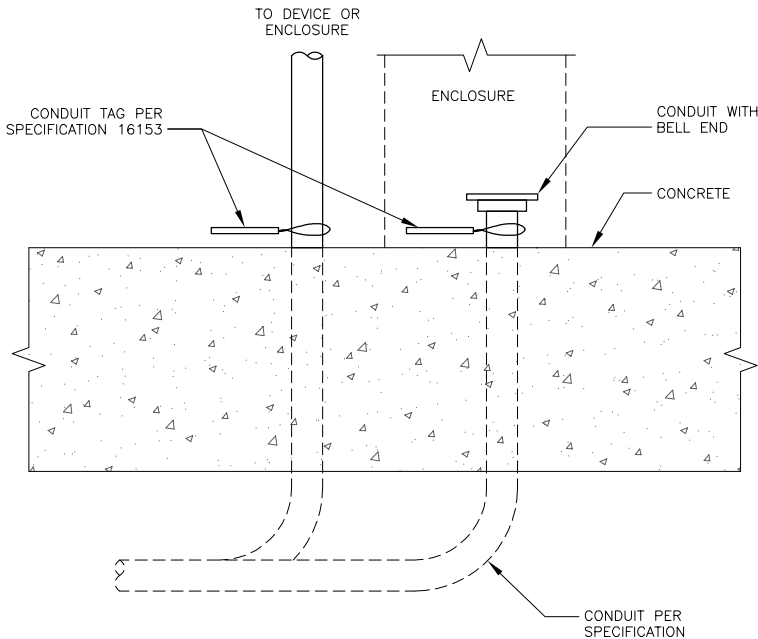

4.2 TYPICAL CONDUIT PENETRATION
NOT TO SCALE

2.3 NOT USED
NOT TO SCALE

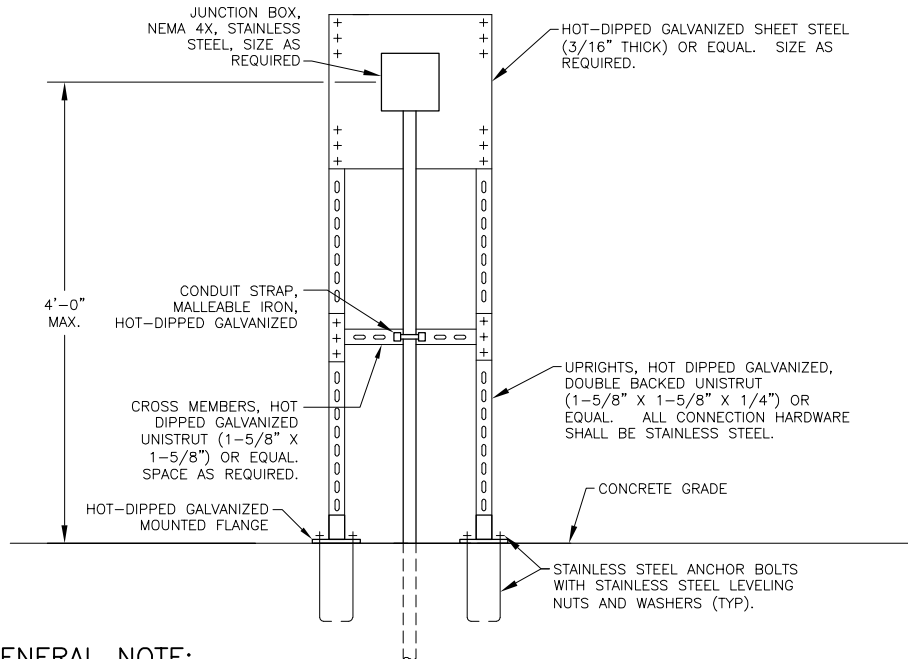

GENERAL NOTE:

- DETAIL IS SHOWN FOR TYPICAL RACK CONSTRUCTION. NOT ALL CONDUITS, JUNCTION BOXES, OR DEVICES ARE SHOWN FOR CLARITY. COORDINATE WITH ENGINEER PRIOR TO FINAL FABRICATION/INSTALLATION.

4.3 TYPICAL WELL HOUSE NO. 7
EQUIPMENT RACK DETAIL
NOT TO SCALE

RECORD DRAWING

THIS DOCUMENT AND THE IDEAS AND DESIGNS INCORPORATED HEREIN ARE THE PROPERTY OF JUB ENGINEERS, INC. THE PROJECT OR PART OF ANY OTHER PROJECT WITHOUT THE EXPRESS WRITTEN AUTHORIZATION OF JUB ENGINEERS, INC.

REVISION	REVISION	DATE
1	RECORD DRAWINGS	12/01/22
0	FOR BID	05/28/21
B	90% REVIEW	04/28/21
C	100% REVIEW	04/28/21
NO.	DESCRIPTION	BY DATE

CITY OF LEWISTON
WELL NO. 7

ELECTRICAL DETAILS

FILE: M19102-E-302
JUB PROJ. #:
DRAWN BY: TLS
DESIGN BY: SRJ
CHECKED BY: RJW
AT FULL SIZE, IF NOT ONE
INCH, SCALE ACCORDINGLY
LAST UPDATED: 12/01/22
SHEET NUMBER:

E-302




4.3 NOT USED
NOT TO SCALE

RECORD DRAWING

JUB
J-U-B ENGINEERS, INC.

J-U-B ENGINEERS, INC.
1630 23rd Ave.
Suite 1101-A
Lewiston, ID 83501
Phone: 208.746.9010
Fax: 208.746.9926
www.jub.com

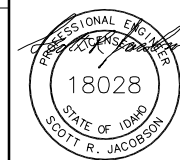


12/01/22

REUSE OF DRAWINGS THIS DOCUMENT, AND THE IDEAS AND DESIGNS INCORPORATED HEREIN, AS AN INSTRUMENT OF PROFESSIONAL SERVICE, IS THE PROPERTY OF JJJ-B ENGINEERS, Inc. AND IS NOT TO BE USED, IN WHOLE OR PART, FOR ANY OTHER PROJECT WITHOUT THE EXPRESS



REVISION			
1	RECORD DRAWINGS	TLS	SRJ 12/01/22
2	FOR BID	TLS	SRJ 05/28/21
3	90% REVIEW	TLS	SRJ 04/26/21
4	30% REVIEW	TLS	SRJ 01/29/21


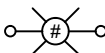
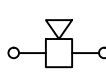
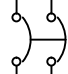
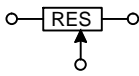
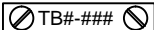
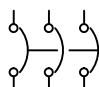




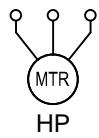
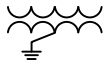
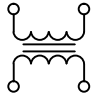
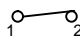
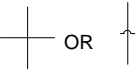
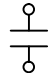
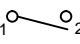
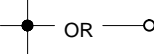

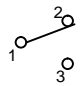

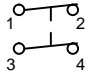
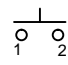
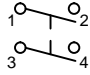
 
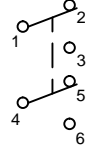
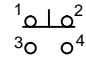

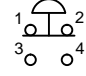

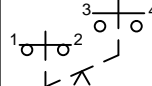
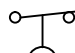
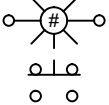
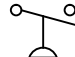
CITY OF LEWISTON
WELL NO. 7


ELECTRICAL DETAILS


FILE : M19102-E-303
JUB PROJ. #:
DRAWN BY: TLS
DESIGN BY: SRJ
CHECKED BY: RJW
 <p>ONE INCH</p> <p>AT FULL SIZE, IF NOT ONE INCH, SCALE ACCORDINGLY</p>
LAST UPDATED: 12/01/22
SHEET NUMBER:

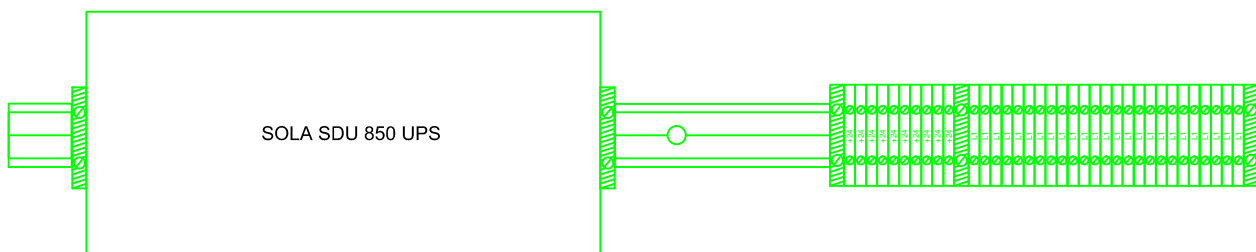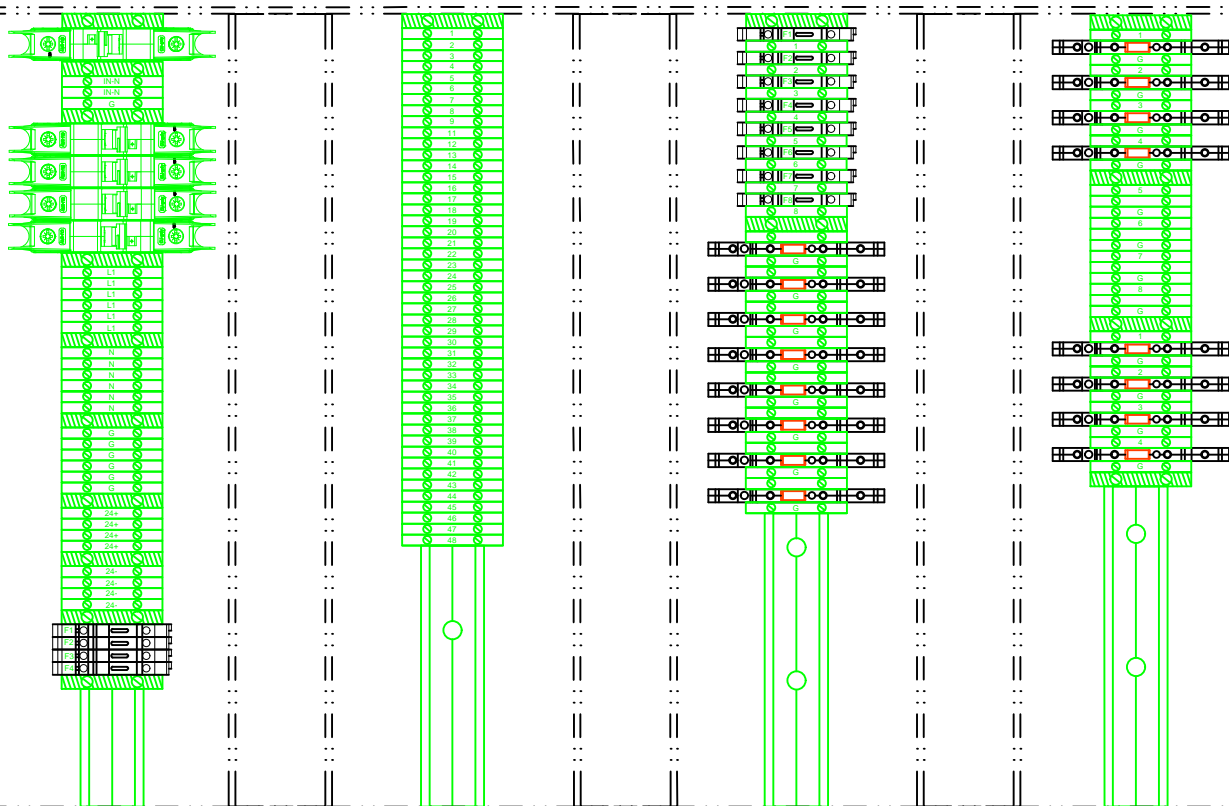
E-303

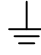


ELECTRICAL SYMBOLS LEGEND											
(NOT ALL SYMBOLS MAY BE USED)											
SYMBOL		DESCRIPTION		SYMBOL		DESCRIPTION		SYMBOL		DESCRIPTION	
		SINGLE POLE CIRCUIT BREAKER (SIZE AS INDICATED)				PILOT LIGHT R = RED G = GREEN A = AMBER B = BLUE				HORN	
		TWO POLE CIRCUIT BREAKER (SIZE AS INDICATED)				RHEOSTAT/POT.				TERMINAL BLOCK CONNECTION	
		THREE POLE CIRCUIT BREAKER (SIZE AS INDICATED)						OR			
		FUSE (SIZE AS INDICATED)				1-PHASE MOTOR (HORSEPOWER AS INDICATED)				GROUND	
		THERMAL OVERLOAD DEVICE				3-PHASE MOTOR (HORSEPOWER AS INDICATED)		-----		FIELD WIRING	
		DELTA TO WYE, 2-WINDING TRANSFORMER (SIZE AND TYPE AS INDICATED)						• OR ○		WIRING CONNECTION OR TERMINATION	
		SINGLE PHASE CONTROL TRANSFORMER (SIZE AND TYPE AS INDICATED)				SINGLE BREAK, N.C. SPST SWITCH				WIRING NOT CONNECTED	
		NORMALLY OPEN CONTACT				SINGLE BREAK, N.O. SPST SWITCH				PHOTO EYE	
		NORMALLY CLOSED CONTACT				SINGLE BREAK, SPDT SWITCH					
		SHUNT COIL				SINGLE BREAK, (2)N.C. DPST SWITCH					
		NORMALLY-OPEN MOMENTARY PUSHBUTTON				SINGLE BREAK, (2)N.O. DPST SWITCH					
		NORMALLY-CLOSED MOMENTARY PUSHBUTTON				SINGLE BREAK, DPDT SWITCH					
		NORMALLY-CLOSED/NORMALLY- OPEN MOMENTARY PUSHBUTTON				LIMIT SWITCH, NORMALLY-CLOSED					
		NORMALLY-CLOSED/NORMALLY-OPEN MUSHROOM HEAD MOMENTARY PUSHBUTTON				LIMIT SWITCH, NORMALLY-OPEN					
		TWO CIRCUIT MAINTAINED PUSHBUTTON				PRESSURE OR VACUUM SWITCH, NORMALLY-CLOSED					
		ILLUMINATED PUSHBUTTON R = RED G = GREEN A = AMBER B = BLUE				PRESSURE OR VACUUM SWITCH, NORMALLY-OPEN					

								<div>UNLESS OTHERWISE SPECIFIED: DIMENSIONS ARE IN INCHES TOLERANCES DECIMALS .XX ± .05 ANGULAR ± 0.5° .XXX ± .010 DO NOT SCALE DRAWING</div>	<div>Control System Technology, Inc.</div>		WADA FARMS			
									TITLE WADA QUINOA PLANT ELECTRICAL SYMBOLS					
REV	REVISION DESCRIPTION	DRAWN	DATE	DWG NUMBER	DESCRIPTION	DWG NUMBER	DESCRIPTION		DESIGN ESJ	DATE 10/1/20				
								DRAWN -ESJ	DATE 10/1/20					
DRAWING REVISIONS				REFERENCE DRAWINGS		REFERENCE DRAWINGS		CHECKED MW	DATE 10/1/20	PLOT DATE 10/1/20	SIZE B	SCALE -	DWG NO. WQ/P1-0.0	REVISIONS

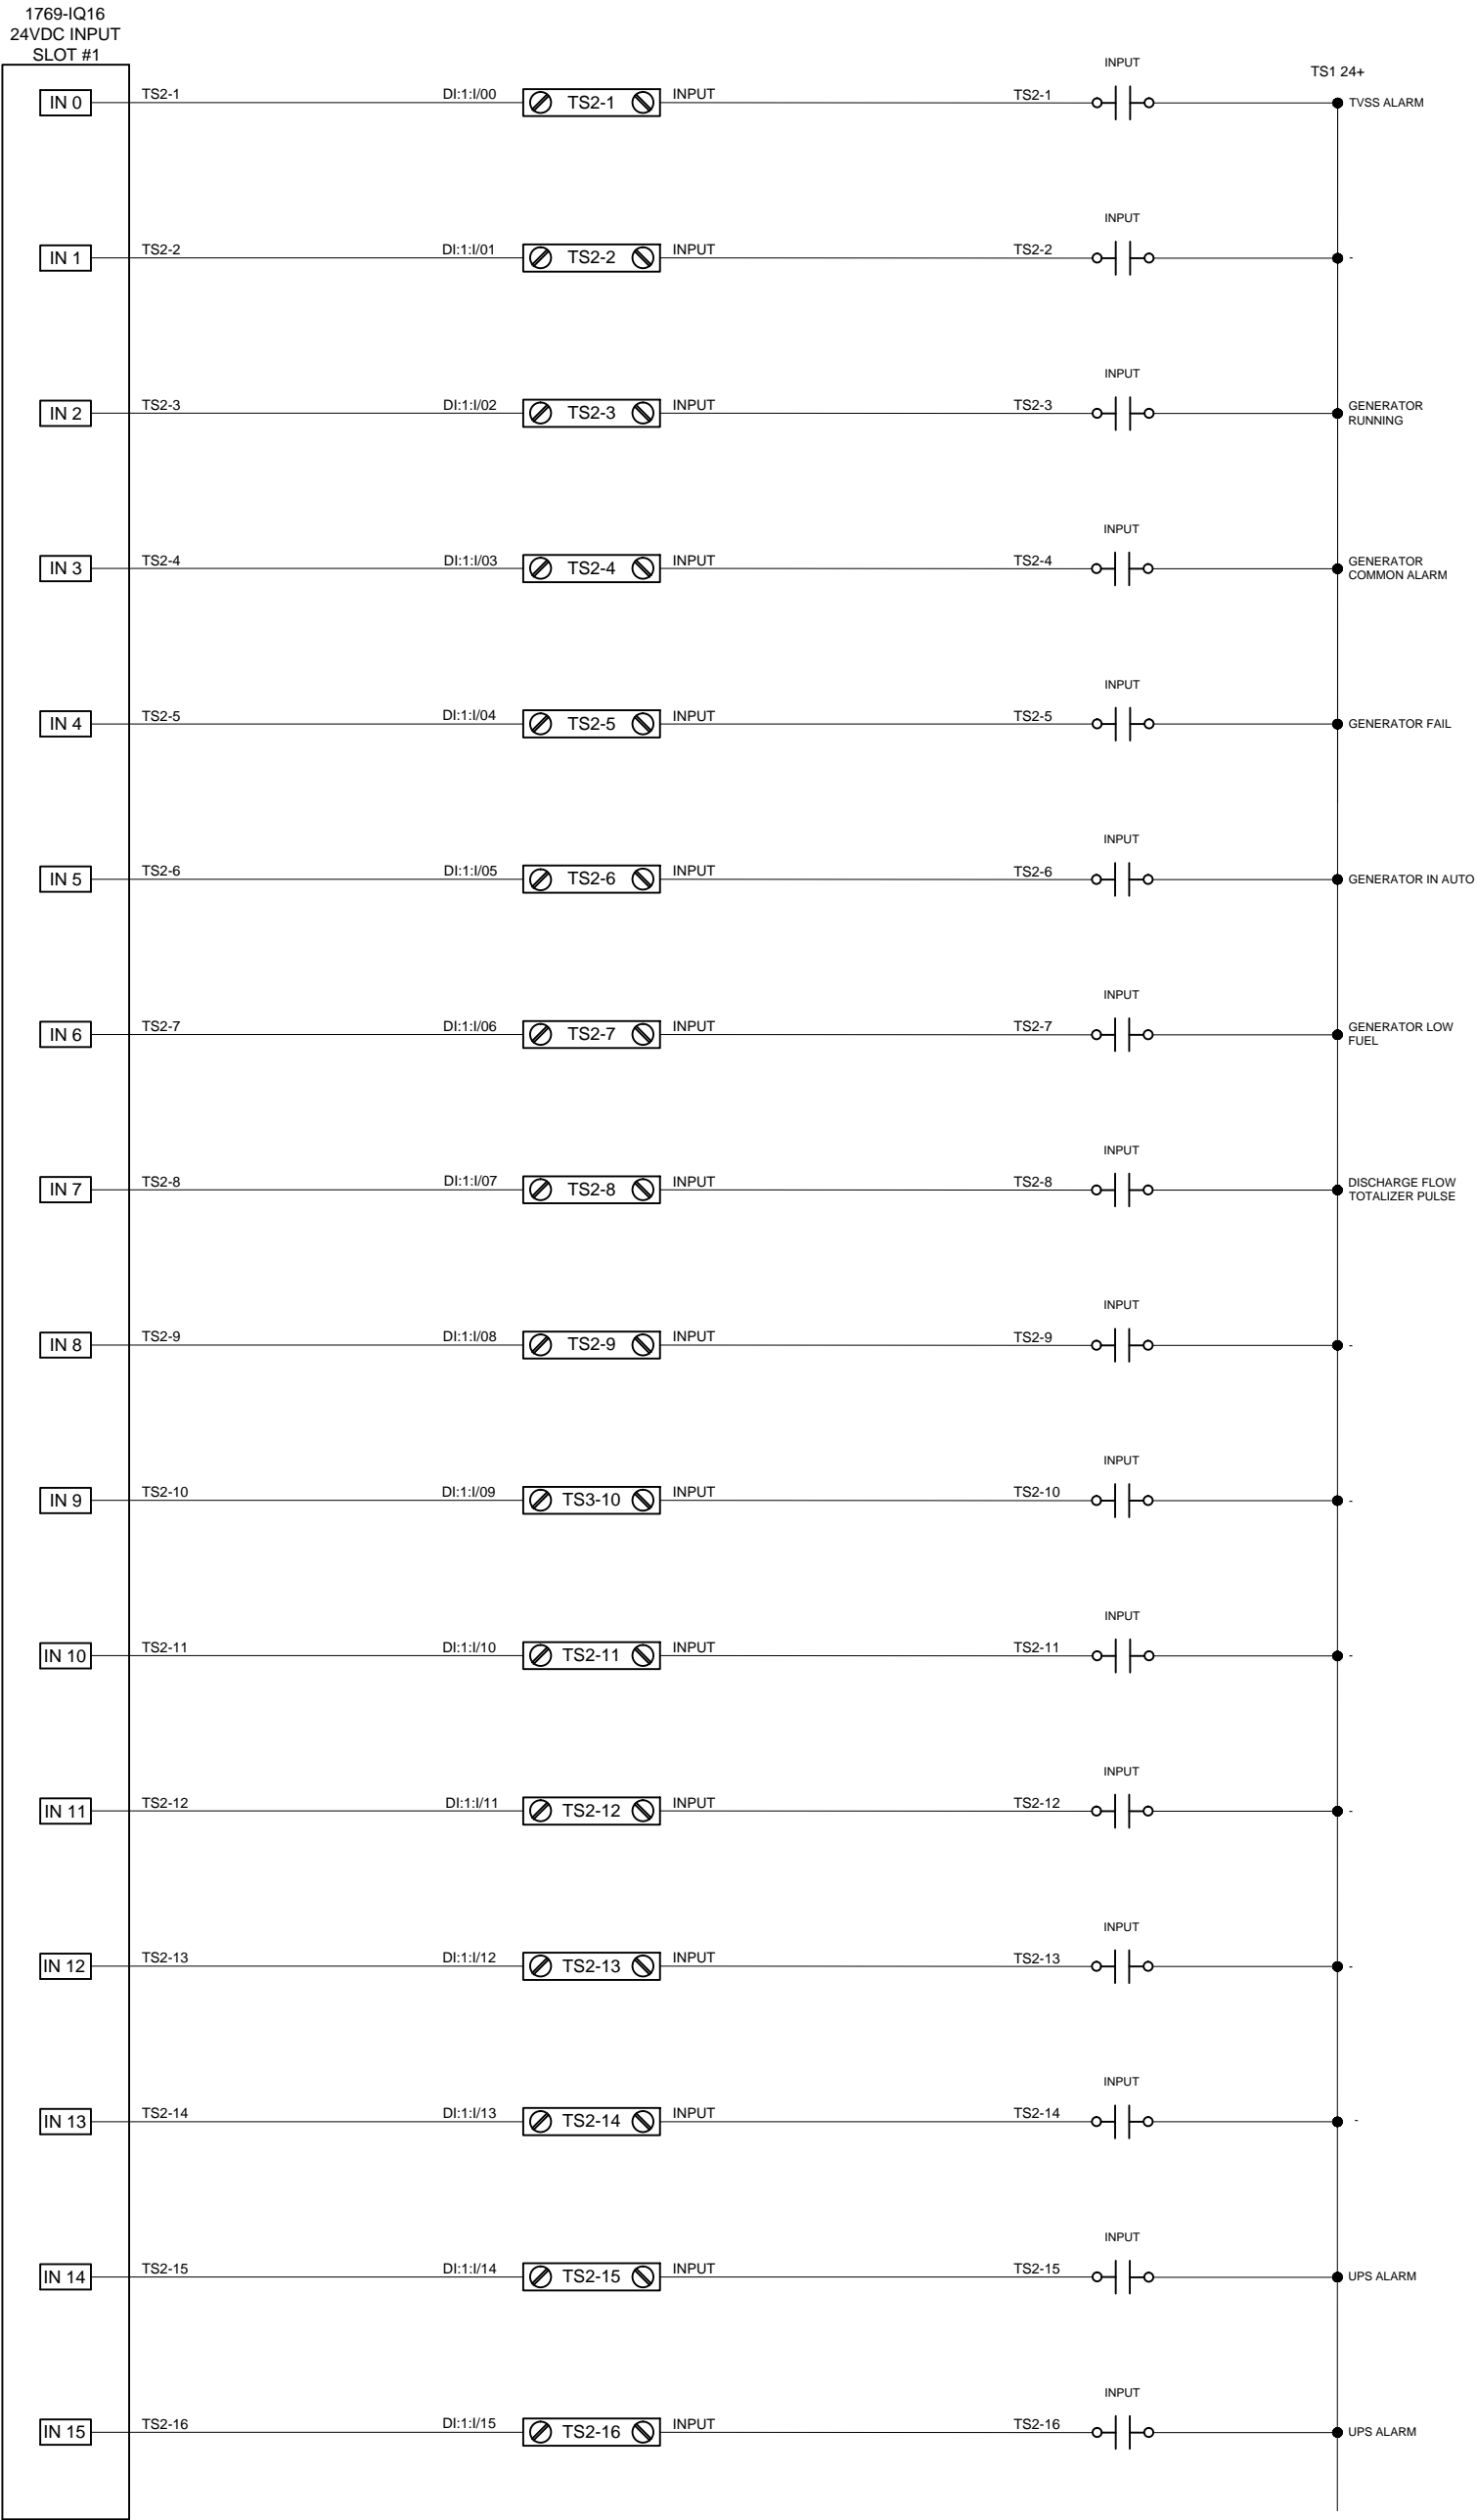


										<div>UNLESS OTHERWISE SPECIFIED: DIMENSIONS ARE IN INCHES TOLERANCES DECIMALS .06 ANGULAR XX ± .010 ± 0.5 DO NOT SCALE DRAWING</div>																			
										TITLE																			
										<div>Control System Technology, Inc.</div>										CONTROL SYSTEM TECHNOLOGY									
										LEWISTON WELL 7 SLOT 1 DC INPUTS																			

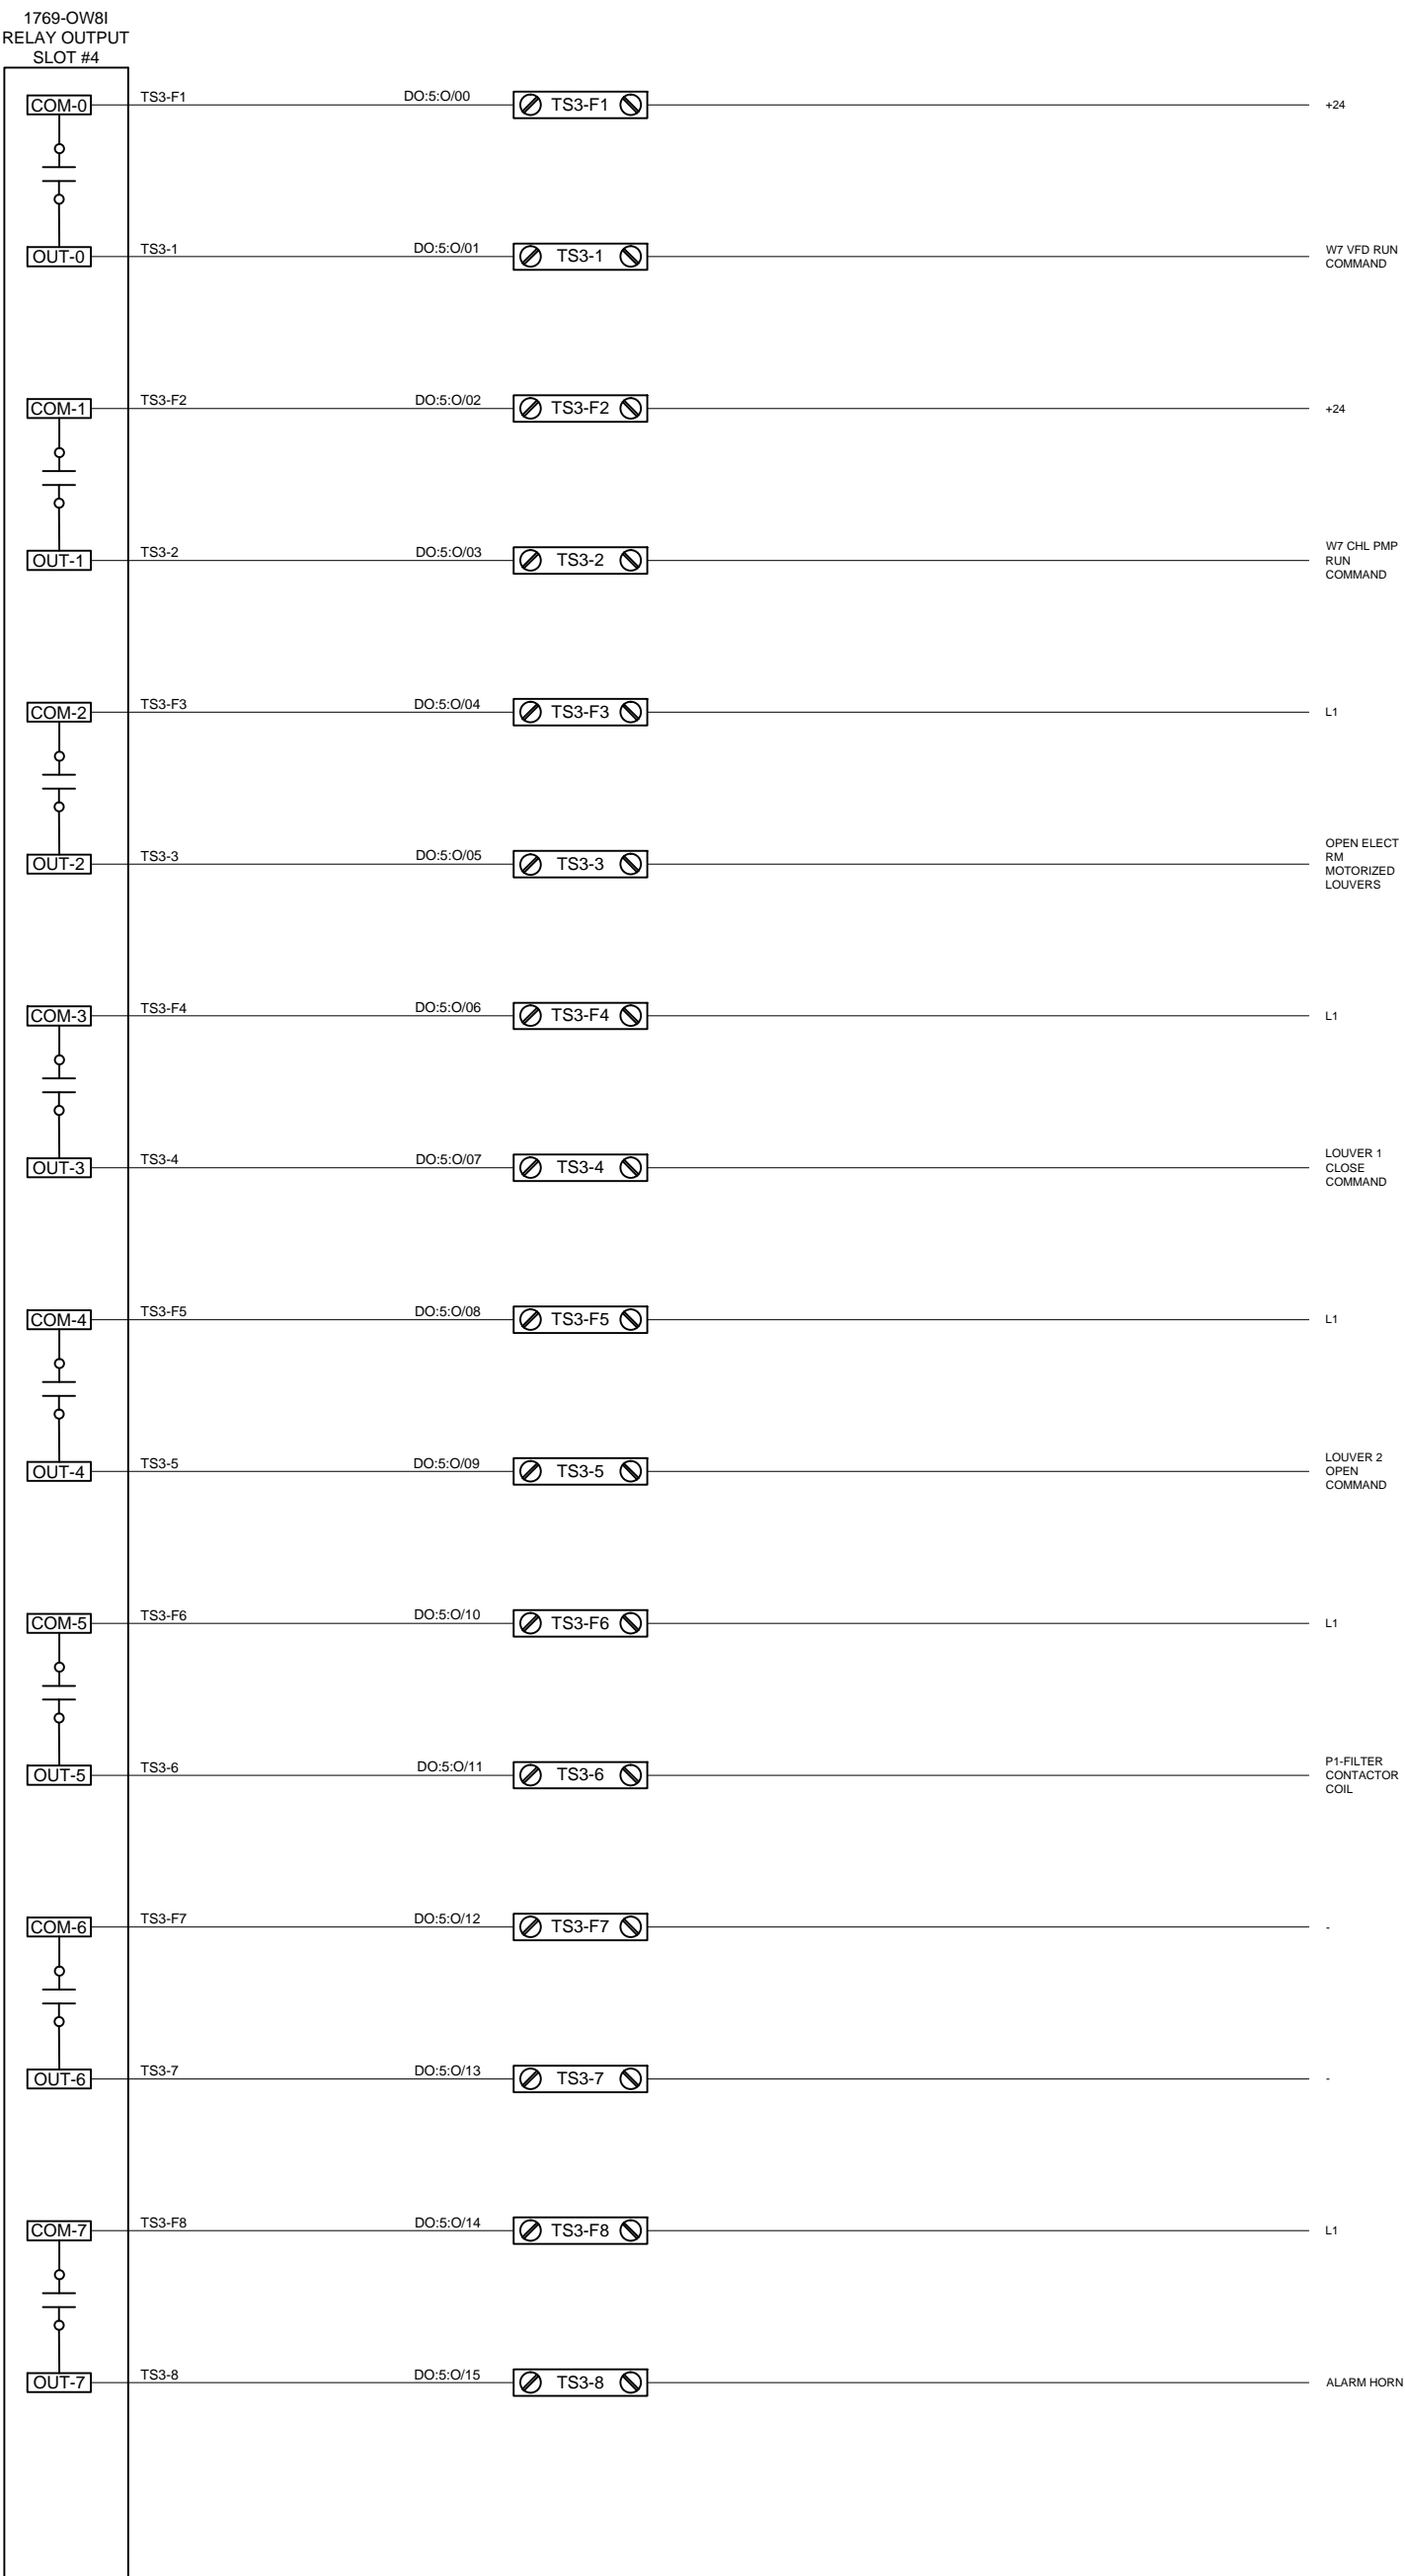


--	--	
1769-IF4I
ANALOG INPUT
SLOT #5

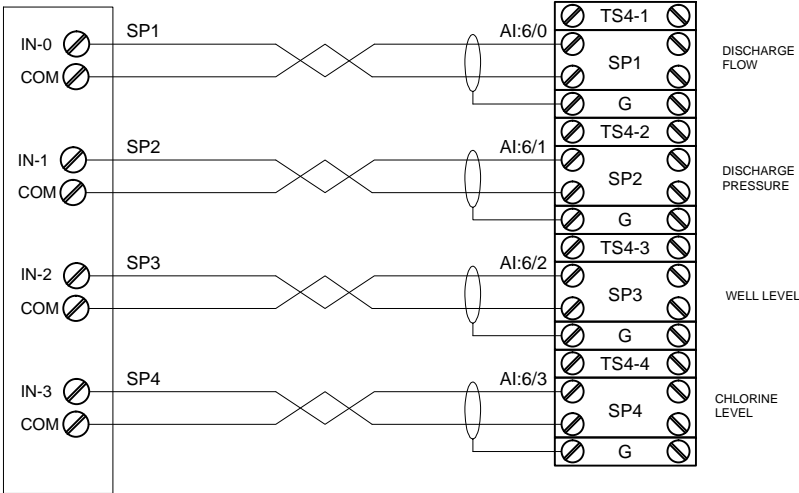


									<div>UNLESS OTHERWISE SPECIFIED: DIMENSIONS ARE IN INCHES TOLERANCES DECIMALS .06 ANGULAR XX ± .010 DO NOT SCALE DRAWING</div>	<div><div><div>CS</div><div>Control System Technology, Inc.</div></div><div>CONTROL SYSTEM TECHNOLOGY</div><div>LEWISTON WELL 7</div><div>SLOT 5 4-20MA ANALOG INPUT</div></div>																																																																																																																																																																																																																																																																																																																																																																																																																																																																																																																																																																																																																																																																																																																																																																																																																																																																																																																																																																																																																																																																																																																																																																																																																																																																																																																																																																																																																																																																																																																																																															
									DESIGN																																																																																																																																																																																																																																																																																																																																																																																																																																																																																																																																																																																																																																																																																																																																																																																																																																																																																																																																																																																																																																																																																																																																																																																																																																																																																																																																																																																																																																																																																																																																																																

1769-OF4CI
ANALOG
OUTPUT
SLOT #6

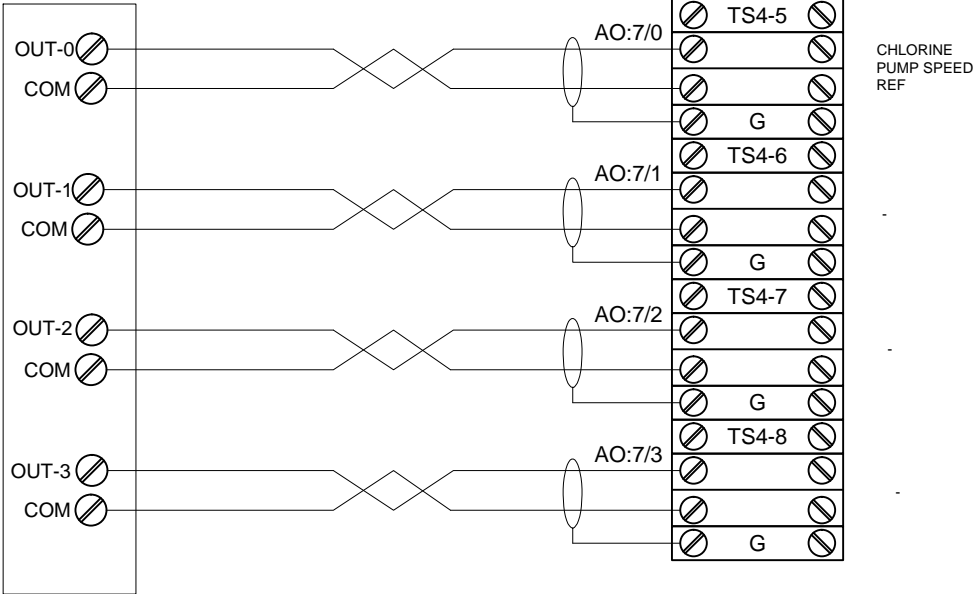

										UNLESS OTHERWISE SPECIFIED: DIMENSIONS ARE IN INCHES TOLERANCES DECIMALS .06 ANGULAR XX ± .010 ± 0.5 DO NOT SCALE DRAWING		TITLE		Control System Technology, Inc.		CONTROL SYSTEM TECHNOLOGY		
																		LEWISTON WELL 7
																		SLOT 6 4-20MA ANALOG OUTPUT

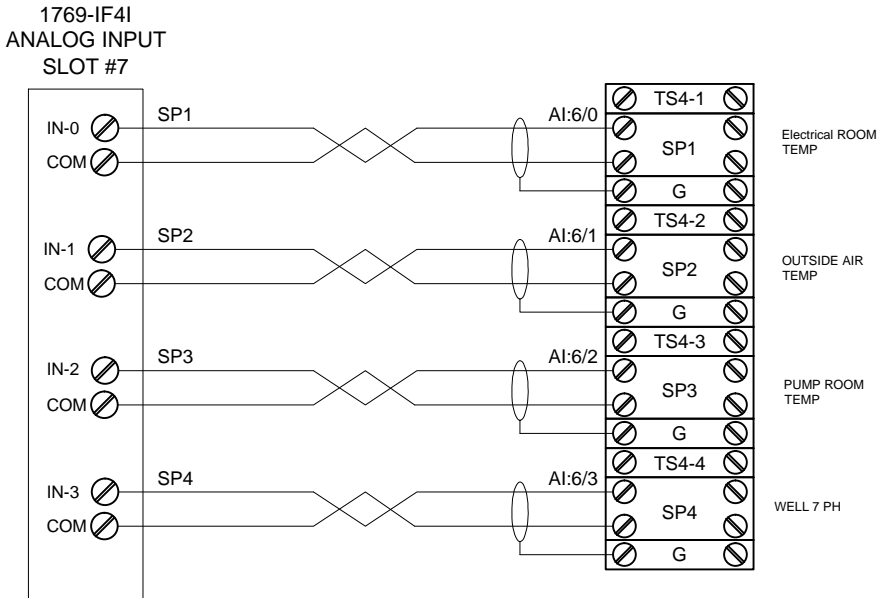

						UNLESS OTHERWISE SPECIFIED: DIMENSIONS ARE IN INCHES DECIMALS FRACTIONS ANGULAR .XX ± .05 .XX ± .010 ± 0.5° DO NOT SCALE DRAWING		TITLE		Control System Technology, Inc.	CONTROL SYSTEM TECHNOLOGY
						DESIGN ESJ DATE		LEWISTON WELL 7			
						DRAWN STA DATE 4/22		SLOT 7 4-20MA ANALOG INPUT			
						CHECKED MW DATE 4/22		PLOT DATE _ SIZE B SCALE _ DWG NO. REV _			
DRAWING REVISIONS											
REVISION DESCRIPTION		DRAWN	DATE	DWG NUMBER	DESCRIPTION	DWG NUMBER		DESCRIPTION			
V											