



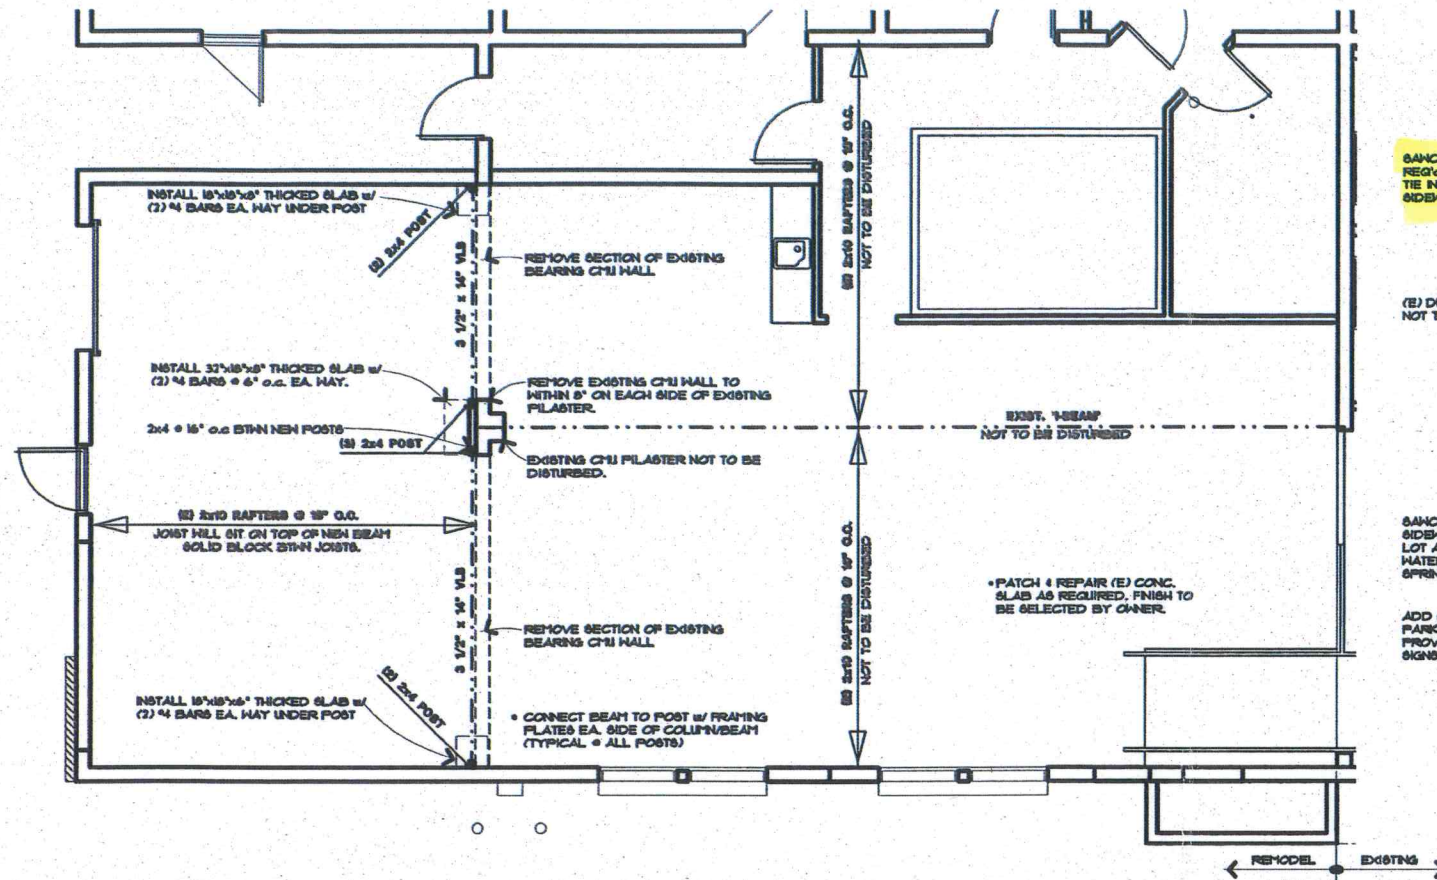

FOUNDATION & ROOF FRAMING PLAN

1/4" = 1' - 0"


1. DOUBLE UP (E) 2x10 ROOF JOISTS • HVAC UNITS. APPROX. LOCATION NOTED ON ROOF PLAN (SEE PARKING LAYOUT DRAWING THIS SHEET).

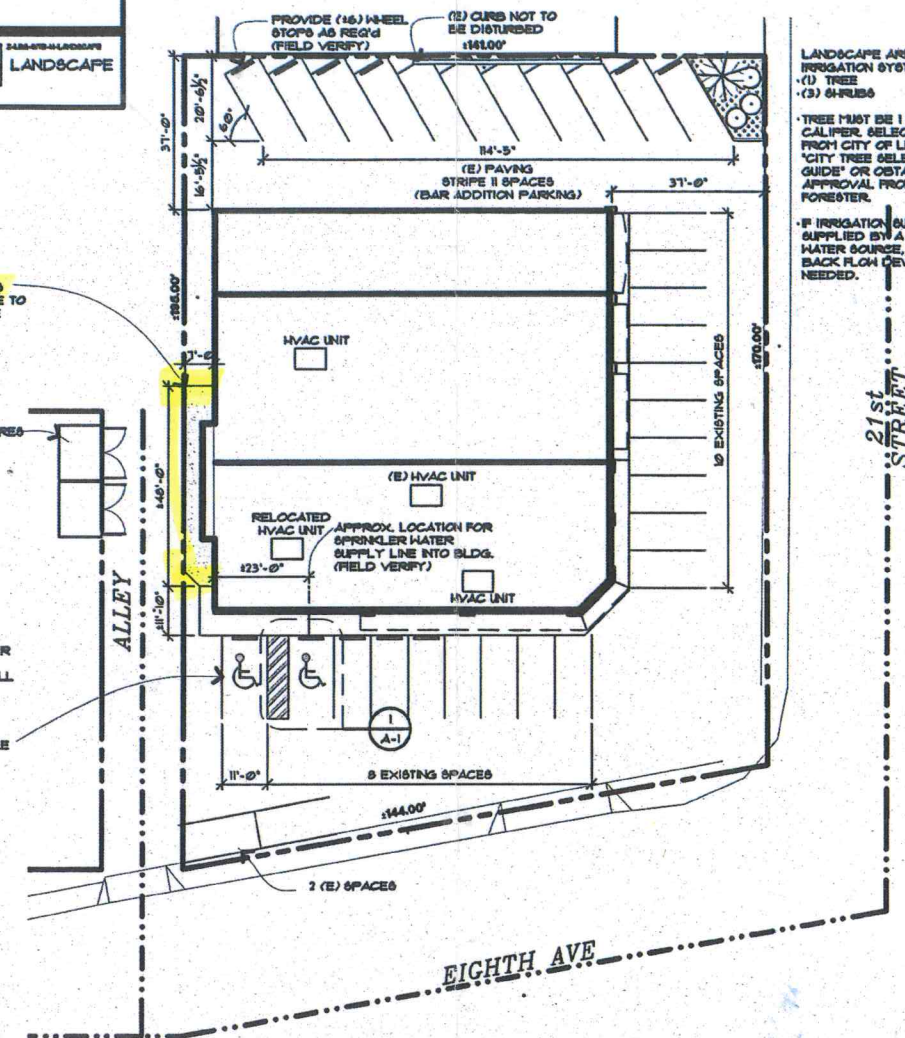

PARKING LAYOUT

1" = 20' - 0"

1. INSTALL NEW PARKING LOT STRIPPING PER CITY OF LEWISTON STANDARD DRAWING D-14 FOR 60° ANGLED PARKING.
2. (E) SIDEWALKS & PARKING ARE FLUSH AT GRADE. SLOPE OF ACCESSIBLE ROUTE FROM PARKING TO MAIN ENTRY DOORS SHALL NOT EXCEED 1:20 IN ANY DIRECTION.

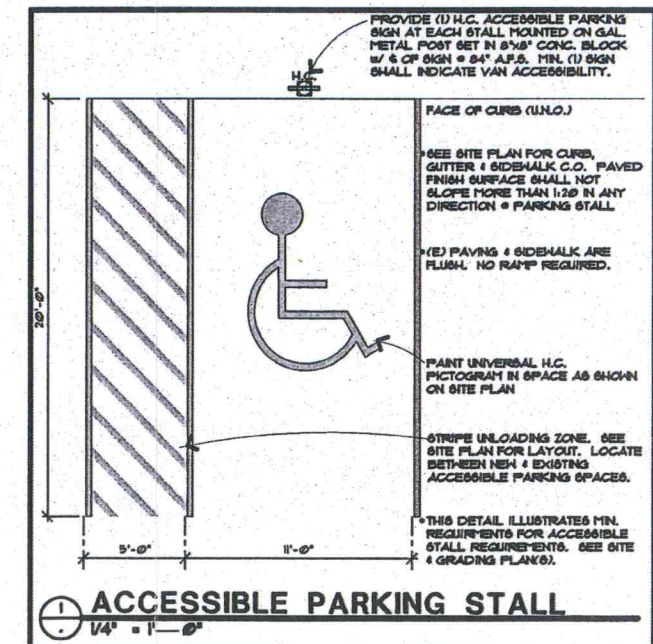

WRANGLER BUILDING
BAR INTERIOR REMODEL

Lewiston Idaho


PARKING LAYOUT/ FOUNDATION & ROOF FRAMING PLAN

Bott & Associates
ARCHITECTS
0909 2nd Street Lewiston, Idaho 83501
Ph: (208) 746-9871 Fax: (208) 746-3523
Email: office@bottarchitecture.com

DRAWN BY: AR
CHECKED BY: DLB
DATE: 7/23/13
JOB NO.: 13-05-24

REVISION DATE:

SHEET:
A1

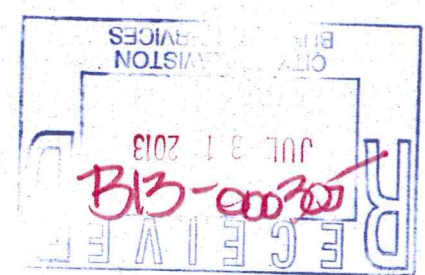

750 21st street