

Form Use:

- Typical Section
- Plan Sheet
- Structure &
- Special Drawings

No.




18TH STREET & MAIN STREET QUANTITIES

FEDERAL ROAD REGION NO.	STATE	FEDERAL AID PROJECT NO.	TOTAL SHEETS	SHEET NO.
10	IDAHO	MG-7254(001)	127	87

1. 1 each 8-PHASE (DUAL RING) TRAFFIC SIGNAL CONTROLLER, SOLID STATE, TRAFFIC ACTUATED, WITH 4 EMERGENCY VEHICLE PRE-EMPTION PHASES IN TYPE P-1 CABINET. TO BE TCT MODEL LMD-8811. CONTROLLER CABINET AND SERVICE CABINET TO BE PLACED ON A COMBINED TYPE P SIGNAL CONTROLLER CABINET AND SERVICE FOUNDATION. SIGNAL CONTROLLER AND CABINET SHALL MEET STATE OF IDAHO STANDARD SPECIFICATIONS. RAILROAD PRE-EMPTION CIRCUITRY SHALL MEET THE STANDARDS AND SPECIFICATIONS FOR THE IDAHO TRANSPORTATION DEPARTMENT.
2. 1 each POLE, STEEL COMBINATION SIGNAL AND LIGHTING, HOT DIPPED GALVANIZED WITH BOLTED LUMINAIRE EXTENSION PER IDAHO TRANSPORTATION DEPARTMENT SPECIFICATION, ID-II-40-Y-3015. POLE B ON PLANS.
3. 1 each POLE, STEEL COMBINATION SIGNAL AND LIGHTING, HOT DIPPED GALVANIZED WITH BOLTED LUMINAIRE EXTENSION PER IDAHO TRANSPORTATION DEPARTMENT SPECIFICATION, ID-I-35-Y-3015. POLE C ON PLANS.
4. 3 each TRAFFIC SIGNAL, 12-INCH, ONE-WAY, THREE COLOR (RED, YELLOW, GREEN), ASTRO BRACKET MODEL NO. AB-116 FOR MAST ARM MOUNTING, 12-INCH TUNNEL VISOR, 5-INCH BACKPLATES, GLASS LENS, TO BE TRAFFIC CONTROL TECHNOLOGIES CATALOG NO. HSF83C300G OR APPROVED EQUAL SIGNAL HEADS 6,7, AND 10.
5. 4 each TRAFFIC SIGNAL, 12-INCH, ONE-WAY, THREE COLOR (RED, YELLOW LEFT ARROW, GREEN LEFT ARROW), ASTRO BRACKET MODEL NO. AB-116 FOR MAST ARM MOUNTING, 12-INCH TUNNEL VISOR, 5-INCH BACKPLATES, GLASS LENS. TO BE TRAFFIC CONTROL TECHNOLOGIES CATALOG NO. HSF83C311G OR APPROVED EQUAL SIGNAL HEADS 1,5,9, AND 12.
6. 2 each TRAFFIC SIGNAL, 12-INCH, ONE-WAY, THREE COLOR (RED, YELLOW, GREEN), STANDARD TERMINAL COMPARTMENT FOR SIDE POLE MOUNTING, AUTOMATIC SIGNAL CATALOG NO. A-802051B OR APPROVED EQUAL, 12-INCH TUNNEL VISOR, 5-INCH BACKPLATES, GLASS LENS. TO BE TRAFFIC CONTROL TECHNOLOGIES CATALOG NO. HSF83C300G OR APPROVED EQUAL SIGNAL HEADS 8 AND 11.
7. 4 each PEDESTRIAN SIGNAL, WALK/DON'T WALK, ONE-WAY, CLAM SHELL MOUNTED INDICATOR CONTROLS COMPANY CATALOG NO. 7092-11C-PHOG-OC3PLM-OSL069. SIGNAL HEADS 16,18,20, AND 22.
8. 4 each PEDESTRIAN SIGNAL, WALK/DON'T WALK, ONE-WAY, CLAM SHELL MOUNTED SINGLE SECTION TO BE INDICATOR CONTROLS COMPANY CATALOG NO. 7092-11C-PHOG-OC3PRM-OSL069. SIGNAL HEADS 17, 19, 21, AND 23. MODIFY MOUNTING BRACKET FOR SIGNAL HEAD 23 TO PROVIDE PROPER VISIBILITY.
9. 4 each EMERGENCY VEHICLE PRE-EMPTION INDICATOR, SIGNAL HEAD TO BE 12-INCH PEDESTRIAN SIGNAL SINGLE SECTION LUNAR WHITE GLASS LENS, TO BE SIMILAR TO A SINGLE VERTICAL SECTION OF AN ECONOLITE CATALOG NO. 54365G1G. TO BE MOUNTED ON AN ASTRO BRACKET MODEL AB-116 FOR MAST ARM MOUNTING. SIGNAL HEADS 24,25,26, AND 27.
10. 2 each TYPE D FOUNDATION, ANCHOR BOLTS INCLUDED. POLES B AND C.
11. 4 each PEDESTRIAN PUSH BUTTONS. TO BE DICK CAMPBELL STYLE 'H' ASSEMBLY WITH REES MODEL 1372-412 BUTTON SWITCH PER IDAHO TRANSPORTATION DEPARTMENT STANDARD DRAWING I-6-B.
12. 8 each DETECTOR, SOLID STATE UNIT, SELF TUNING. FOUR CHANNEL RACK MOUNTED SARASOTA 224 GP5.
13. 3 each LUMINAIRES WITH INDIVIDUAL PHOTO ELECTRIC CELL, GE M-400A2 CUTOFF, POWER/DOOR LUMINAIRE 120-VOLT, 250 WATT LU, INCLUDING LAMP CATALOG NO. M4AC28S1A2GMC32, M-C-III TYPE DISTRIBUTION. TO BE INSTALLED ON LUMINAIRE ARMS ON SIGNAL POLES A, B, AND C.
14. 1 each JUNCTION BOX, PRE-CAST CONCRETE, 32 INCH X 36 INCH X 28 INCH, REINFORCED, TYPE D.
15. 21 each JUNCTION BOX, PRE-CAST CONCRETE, 18 INCH X 13 INCH X 15 INCH, REINFORCED, TYPE C.
16. 1 each CLASS B SERVICE, TO BE MEYERS ELECTRIC PRODUCTS, INC. PEDESTAL SHALL BE A MEYER CATALOG NO. MEUGL-M100 C/S-ITD-MOD, OR EQUAL (SHEET 96).
17. 1 each LOOP DETECTOR INTERFACE CARD, RACK MOUNTED, WITH SERIAL CONNECTOR, SARASOTA CATALOG NO. SC1.
18. 6 each FUSED CONNECTORS, TO BE BUSSMAN MANUFACTURING CATALOG NO. HEB-JW-RLC-J.
19. — MISCELLANEOUS ITEMS TO INCLUDE WIRE, CABLE, CONDUIT, AND MISCELLANEOUS HARDWARE.
20. 1 each SYSTEM TEST AND PROGRAMMING ASSEMBLY, TO MEET SECTION 4.36 OF "FY 93 SPECIFICATION FOR 2 - 8 PHASE DIGITAL TRAFFIC CONTROLLER AND AUXILLARY EQUIPMENT"

ORIGINAL WORK PREPARED DECEMBER 1987 UNDER THE DIRECTION OF STANTON S. NUFFER, P.E. NO. 1881, DECEASED JULY 1991. MODIFICATIONS BY BRUCE F. SCHAFER, P.E. NO. 5334.

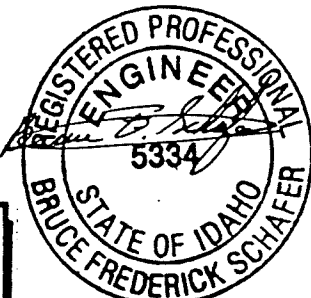

2/11/92

12/2/87


1.01574.01

LEGEND:

S-SAN- SANITARY SEWER
 SS-SS- STORM SEWER
 G-G- GAS
 W-W- WATER
 V-VALVE OR RISER
 C-CATCH BASIN OR INLET
 E-EXISTING CATCH BASIN OR INLET
 M-MANHOLE
 T-T- UNDERGROUND TELEPHONE
 P-P- UNDERGROUND POWER

T-SIGNAL CONDUIT (NEW)
 T-SIGNAL CONDUIT (EXISTING)
 R-RIGID PLASTIC CONDUIT
 S-SIGNAL CONTROLLER COMMUNICATION CABLE, 6PR. STRANDED NO.19 WIRE, REA-SPEC PE-34
 J-JUNCTION BOX (NEW)
 J-JUNCTION BOX (EXISTING)
 P-SIGNAL POLE
 R-RELOCATED SIGNAL CONTROLLER ON NEW FOUNDATION
 C-C-SIGNAL CONTROLLER CABINET AND FOUNDATION (EXISTING)
 S-SIGNAL SERVICE CABINET (PEDESTAL)

5C-FIVE CONDUCTOR, 14 GAUGE STRANDED SIGNAL CABLE
 OPC-OPTICOM PRE-EMPTION DETECTOR CABLE, 3MMODEL 138
 2CS-TWO CONDUCTOR, SHIELDED CABLE
 (PRE. IND.)-PRE-EMPTION INDICATOR, 2-NO.14 THW WIRE SIGNAL CABLE
 (PRE. INT.)-PRE-EMPTION INTERCONNECT CABLE TO BE DETECTOR LOOP LEAD-IN CABLE PER SECTION 656.16

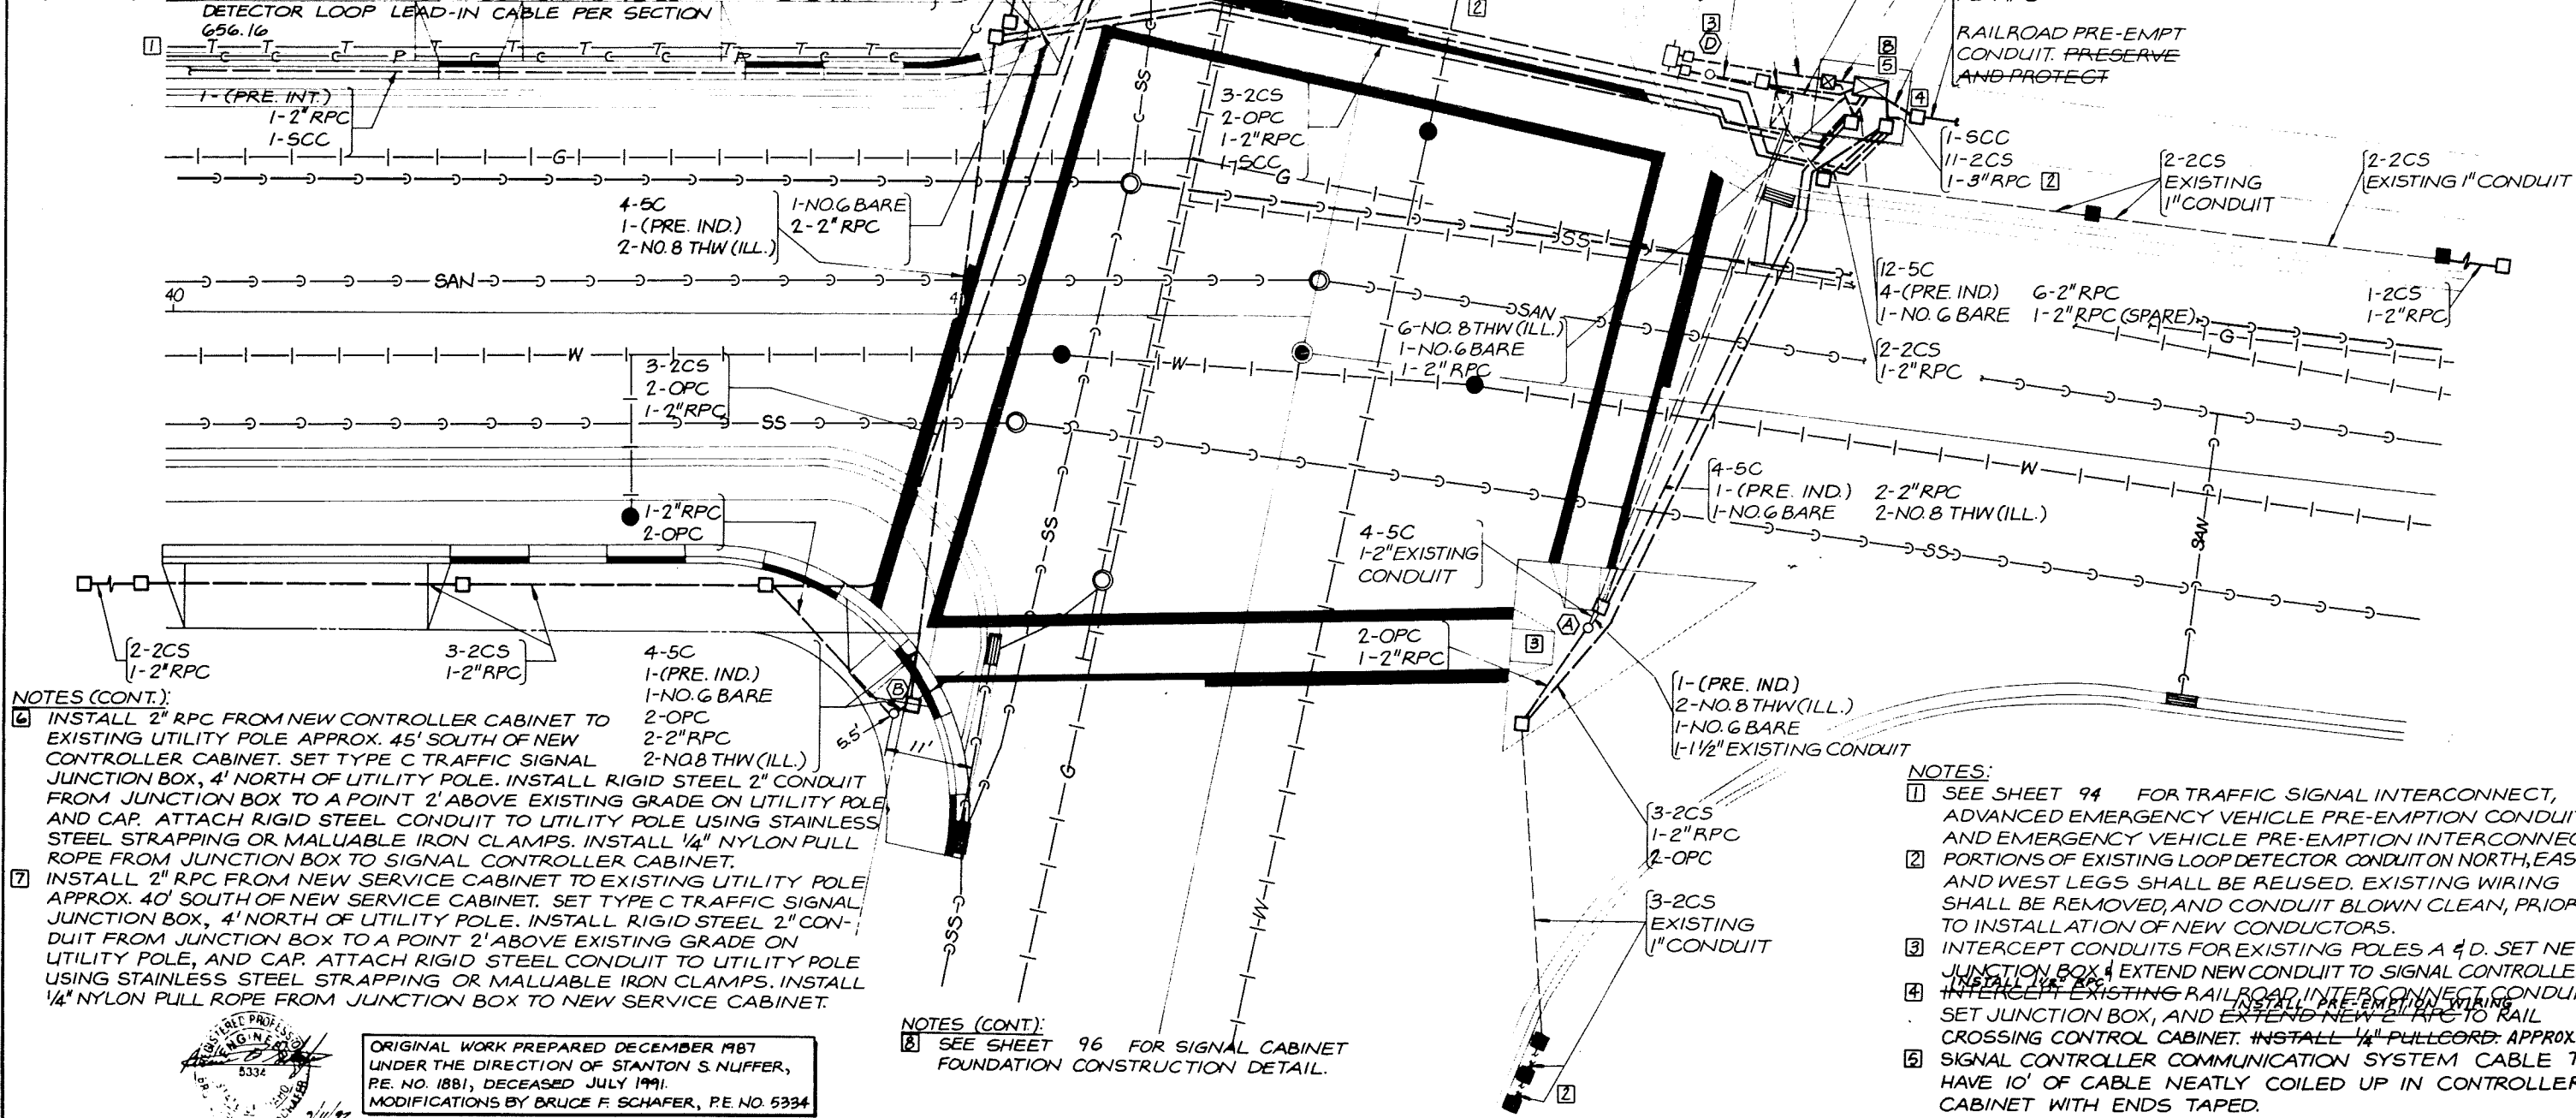

FEDERAL ROAD REGION NO.	STATE	FEDERAL AID PROJECT NO.	TOTAL SHEETS	SHEET NO.
10	IDAHO	MG-7254(001)	127	89

18TH STREET & MAIN STREET
CONDUIT, WIRING, & UTILITIES



NOTES (CONT.):

6. INSTALL 2" RPC FROM NEW CONTROLLER CABINET TO EXISTING UTILITY POLE APPROX. 45' SOUTH OF NEW CONTROLLER CABINET. SET TYPE C TRAFFIC SIGNAL JUNCTION BOX, 4' NORTH OF UTILITY POLE. INSTALL RIGID STEEL 2" CONDUIT FROM JUNCTION BOX TO A POINT 2' ABOVE EXISTING GRADE ON UTILITY POLE, AND CAP. ATTACH RIGID STEEL CONDUIT TO UTILITY POLE USING STAINLESS STEEL STRAPPING OR MALUABLE IRON CLAMPS. INSTALL 1/4" NYLON PULL ROPE FROM JUNCTION BOX TO SIGNAL CONTROLLER CABINET.
7. INSTALL 2" RPC FROM NEW SERVICE CABINET TO EXISTING UTILITY POLE APPROX. 40' SOUTH OF NEW SERVICE CABINET. SET TYPE C TRAFFIC SIGNAL JUNCTION BOX, 4' NORTH OF UTILITY POLE. INSTALL RIGID STEEL 2" CONDUIT FROM JUNCTION BOX TO A POINT 2' ABOVE EXISTING GRADE ON UTILITY POLE, AND CAP. ATTACH RIGID STEEL CONDUIT TO UTILITY POLE USING STAINLESS STEEL STRAPPING OR MALUABLE IRON CLAMPS. INSTALL 1/4" NYLON PULL ROPE FROM JUNCTION BOX TO NEW SERVICE CABINET.

NOTES (CONT.):

8. SEE SHEET 96 FOR SIGNAL CABINET FOUNDATION CONSTRUCTION DETAIL.

NOTES:

1. SEE SHEET 94 FOR TRAFFIC SIGNAL INTERCONNECT, ADVANCED EMERGENCY VEHICLE PRE-EMPTION CONDUIT, AND EMERGENCY VEHICLE PRE-EMPTION INTERCONNECT.
2. PORTIONS OF EXISTING LOOP DETECTOR CONDUIT ON NORTH, EAST, AND WEST LEGS SHALL BE REUSED. EXISTING WIRING SHALL BE REMOVED, AND CONDUIT BLOWN CLEAN, PRIOR TO INSTALLATION OF NEW CONDUCTORS.
3. INTERCEPT CONDUITS FOR EXISTING POLES A & D. SET NEW JUNCTION BOX & EXTEND NEW CONDUIT TO SIGNAL CONTROLLER.
4. INTERCEPT EXISTING RAILROAD INTERCONNECT CONDUIT, SET JUNCTION BOX, AND EXTEND NEW 2" RPC TO RAIL CROSSING CONTROL CABINET. INSTALL 1/4" PULLCORD APPROX. 250'.
5. SIGNAL CONTROLLER COMMUNICATION SYSTEM CABLE TO HAVE 10' OF CABLE NEATLY COILED UP IN CONTROLLER CABINET WITH ENDS TAPED.





ORIGINAL WORK PREPARED DECEMBER 1987
 UNDER THE DIRECTION OF STANTON S. NUFFER,
 P.E. NO. 1881, DECEASED JULY 1991.
 MODIFICATIONS BY BRUCE F. SCHAFER, P.E. NO. 5334




ORIGINAL WORK PREPARED DECEMBER 1987
UNDER THE DIRECTION OF STANTON S. NUFFER,
P.E. NO. 1881, DECEASED JULY 1991.
MODIFICATIONS BY BRUCE F. SCHAFER, P.E. NO. 5334

3/11/92

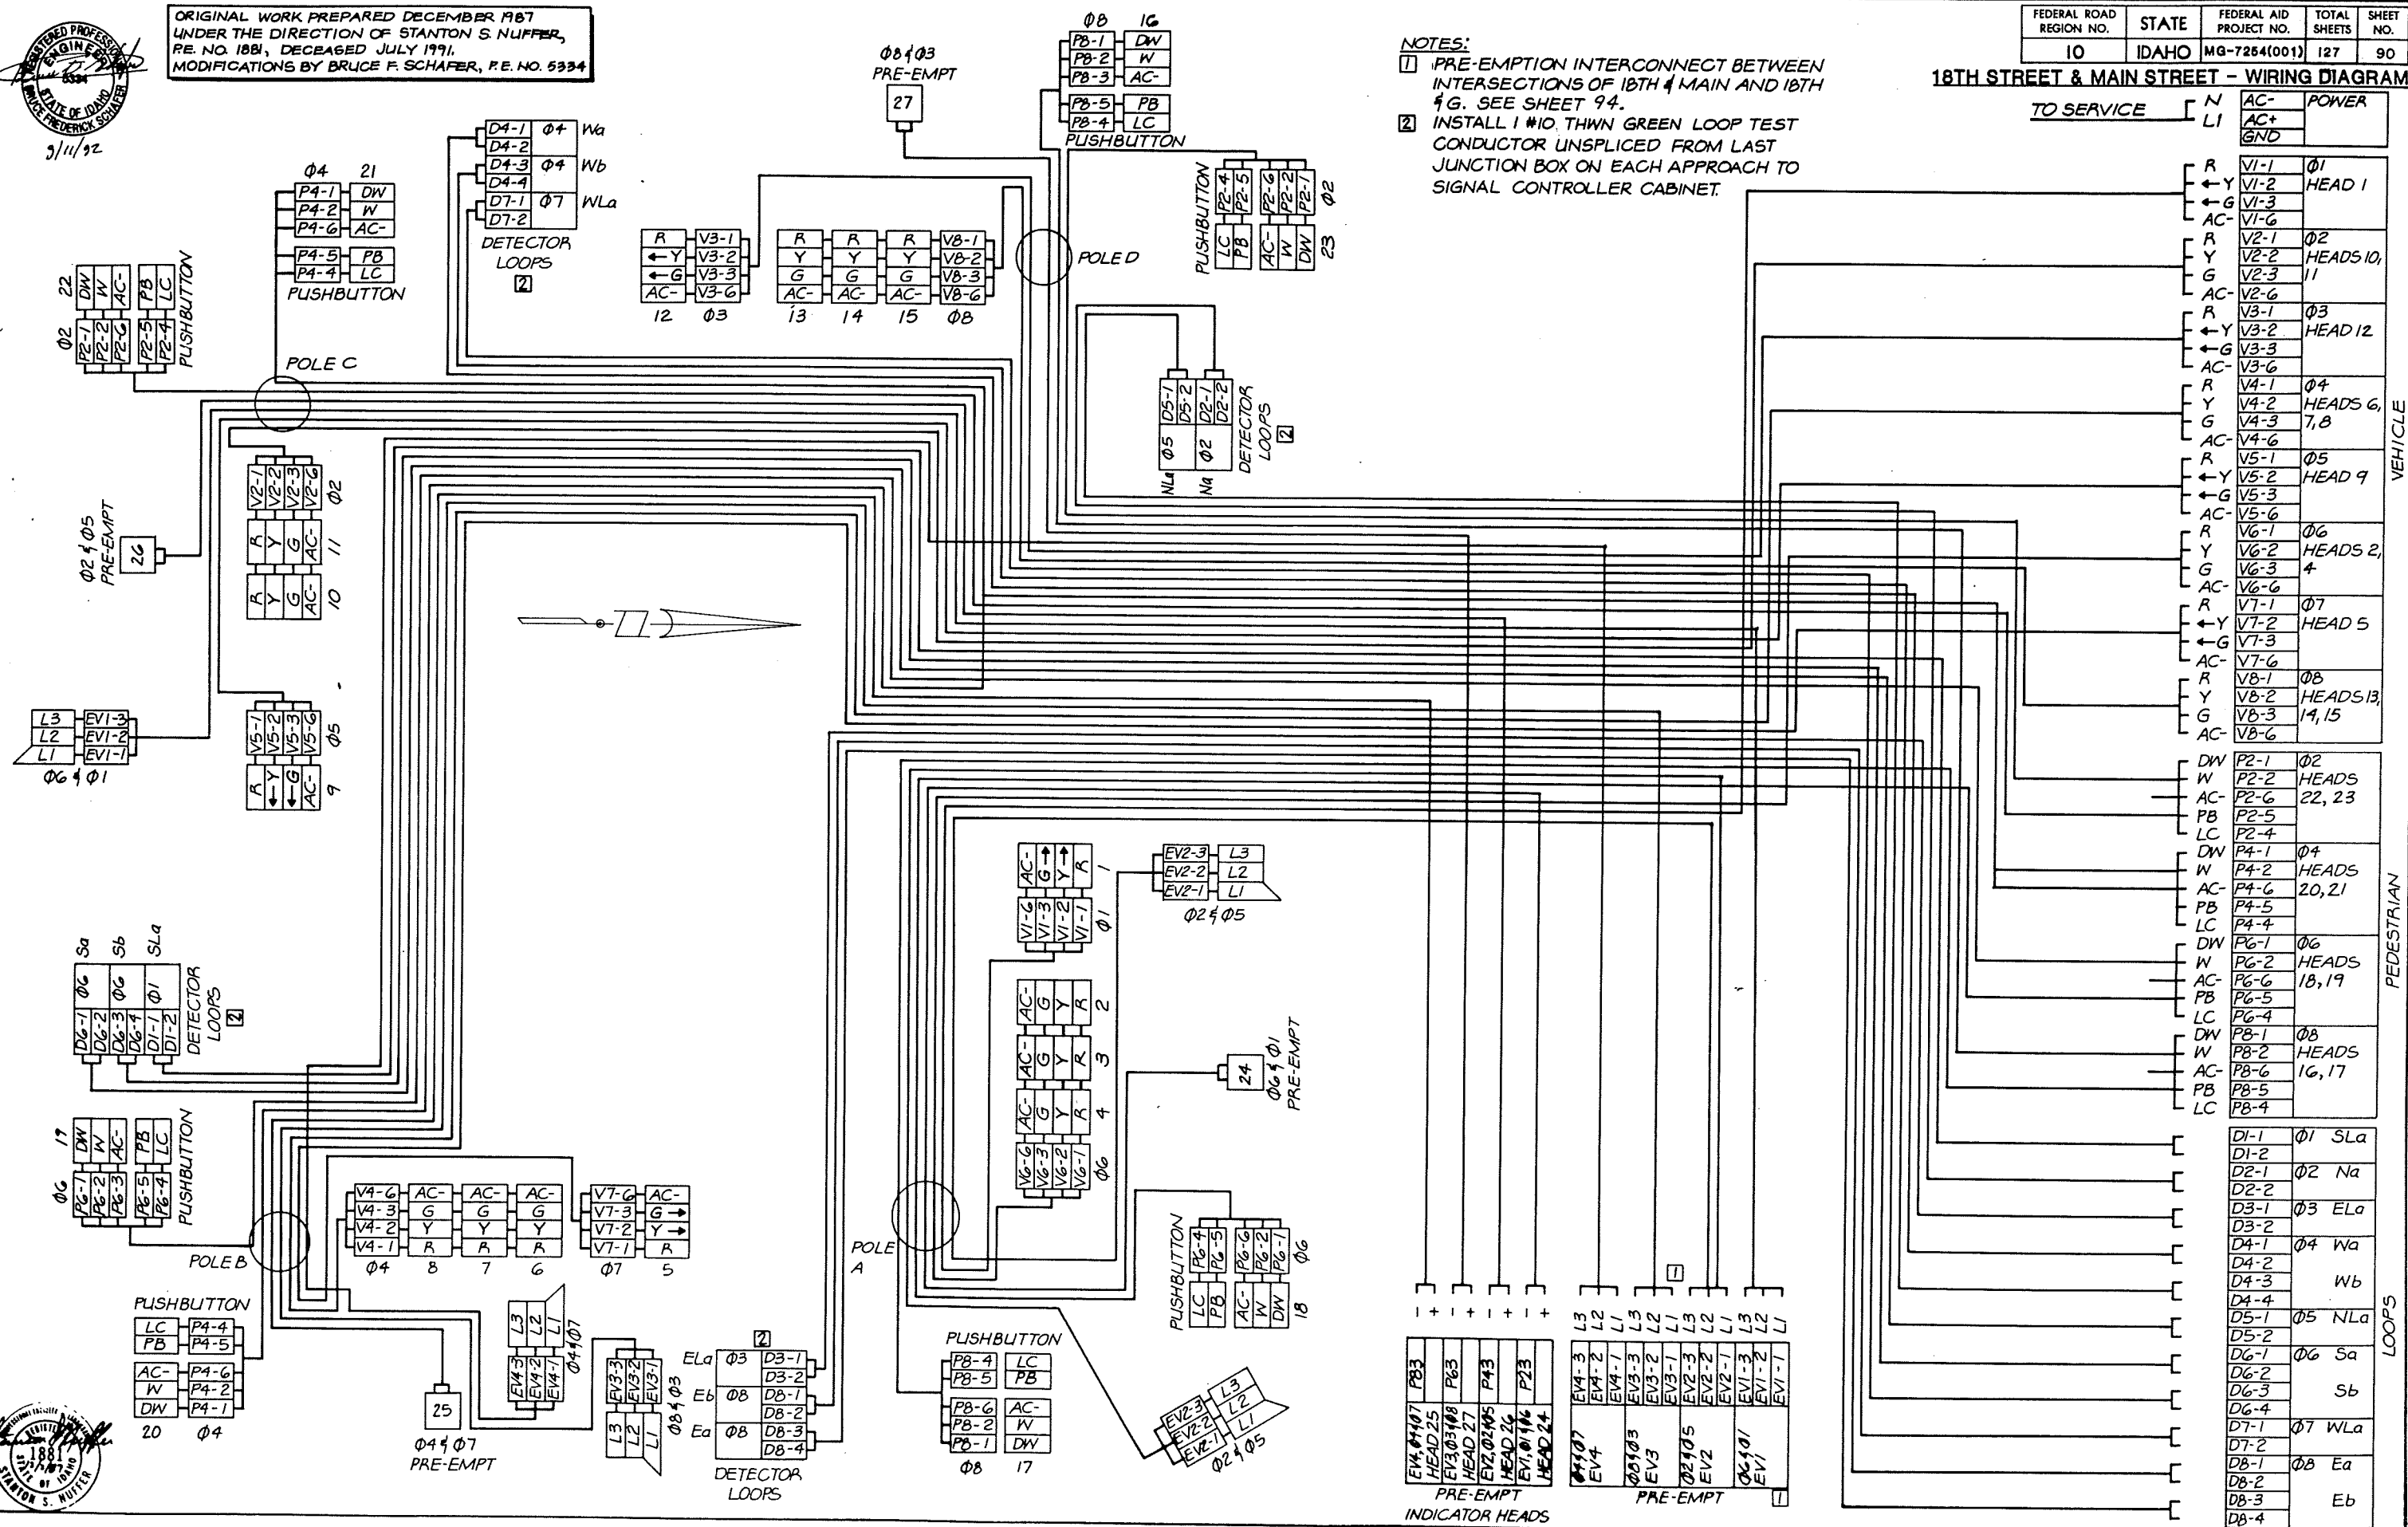

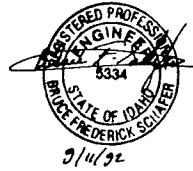

ORIGINAL WORK PREPARED DECEMBER 1987
UNDER THE DIRECTION OF STANTON S. NUFFER,
P.E. NO. 1881, DECEASED JULY 1991.
MODIFICATIONS BY BRUCE F. SCHAFER, P.E. NO. 5334

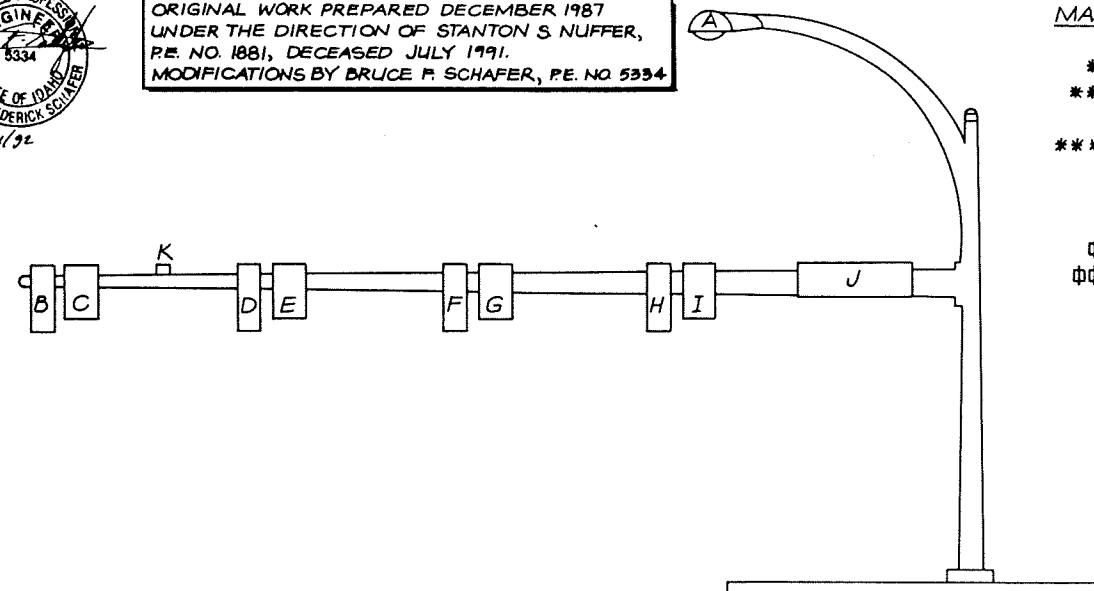


MAST ARM LOADING CHART NOTES:

- * SEE GENERAL NOTE 10, SHEET 71, AND DETAIL 5, SHEET 95.
- ** WITHIN 6" OF MAST ARM END, INSTALL PER DETAIL NO. 1
- *** MOUNTED BELOW TOP OF POLE, ON SIDE OF POLE. SEE DETAIL 1, SHEET 95.
- **** LOCATION OF SIGNS, SIGNAL, PRE-EMPTION INDICATOR, AND DETECTOR MEASURE FROM MAST ARM POLE ATTACHMENT TO CENTER OF UNIT ATTACHED.
- Φ EXISTING POLE
- ΦΦ SIGN S-9
- ΦΦΦ PRE-EMPT DETECTOR FOR EV4 (Φ4 & Φ7) TO BE MOUNTED 23' FROM MAST ARM ATTACHMENT PLATE PER DETAIL NO. 1.
- PRE-EMPT DETECTOR FOR EV3 (Φ3 & Φ8) TO BE MOUNTED PER **

FEDERAL ROAD REGION NO.	STATE	FEDERAL AID PROJECT NO.	TOTAL SHEETS	SHEET NO.
10	IDAHO	MG-7254(001)	127	91

18TH STREET & MAIN STREET PHASING

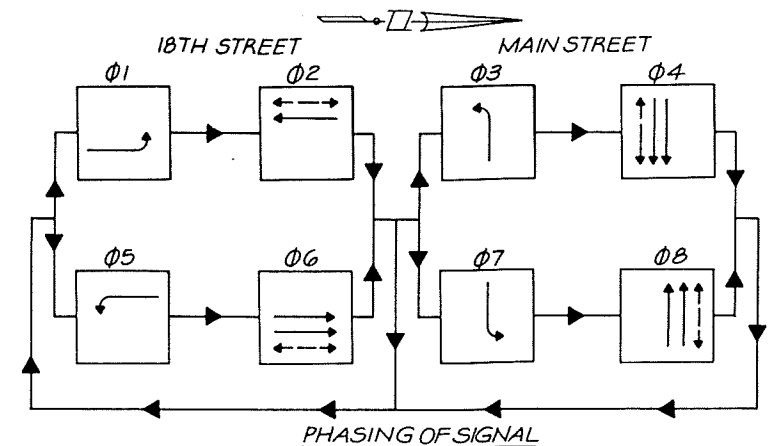


MAST ARM LOADING CHART ****												
POLE	MAST ARM	LUMINAIRE ARM A	SIGNAL HEAD B	30" x 36" SIGN C	SIGNAL HEAD D	30" x 36" SIGN E	SIGNAL HEAD F	30" x 36" SIGN G	SIGNAL HEAD H	PRE-EMPT INDICATOR HEAD*	STREET NAME SIGN J	PRE-EMPT DETECTOR K
A Φ										1'-3"		**
B	40'	15'-0"	40'-0"	37'-0"	30'-0"	—	18'-0"	—	—	1'-3"	6'-0"	ΦΦΦ
C	35'	15'-0"	35'-0"	25'-0"	23'-0"			15'-0" ΦΦ		1'-3"	6'-0"	**
D Φ										1'-3"		


SIGN TABLE Δ				
NUMBER	QUANTITY	DESIGNATION	SIGN SIZE	NOTES
S-1	4	R-10-10L	24" x 30"	"LEFT TURN SIGNAL"
S-2 ΔΔ	2	D3-A	72" x 16"	MAIN STREET
S-3 ΔΔ	1	R3-5R	30" x 36"	"ONLY"
S-4	2	R14-1	24" x 18"	"TRUCK ROUTE" ΔΔ
S-5	1	MG-6R (W)	21" x 15"	↑
S-6	1	EX-1	ΔΔΔ	ΔΔΔ
S-7	2	D3-A	72" x 16"	18TH STREET
S-8	1	GUIDE SIGN	36" x 54"	SEE DETAIL 2, SHEET 95.
S-9	1	EX-2	ΔΔΔ	ΔΔΔ
S-10	1	MG-6L (W)	21" x 15"	↓

SIGN BLANKS TO BE AFFIXED TO MAST ARM THROUGH THE USE OF STAINLESS STEEL BAND-IT MATERIAL AND BRACKETS.
Δ EXISTING SIGNS TO BE REPLACED WITH NEW SIGNS. ALL EXISTING SIGNS TO BE SALVAGED TO DISTRICT 2 IDAHO TRANSPORTATION DEPARTMENT.

ΔΔ S-2 SIGN TO BE RELOCATED IN BETWEEN SIGNAL HEADS 3 & 4. INSTALL S-3 SIGN 5' FROM MAST ARM BOLT CONNECTION TO POLE.
ΔΔΔ EX-1, AND EX-2 SIGNS TO MATCH EXISTING SIGNS, WITH REFLECTORIZED ENGINEER'S GRADE SHEETING ON ALUMINUM SIGN BLANK.
NEW SIGN TO HAVE SAME COLORS AS EXISTING SIGNS. EX-1 AND EX-2 REPLACEMENT SIGNS TO BE FURNISHED BY IDAHO TRANSPORTATION DEPARTMENT.

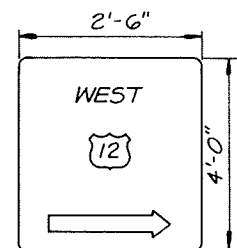

EX-1

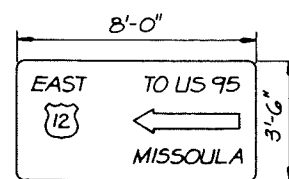

EX-2

SIGNAL SEQUENCE CHART																		
PHASE	HEAD NUMBER																	
	1	2,4	5	6,7,8	9	10,11	12	13,14,15	16,17	18,19	20,21	22,23	24	25	26	27		
Φ1	← G ← Y	R	R	R	R	R	R	R	DW	DW	DW	DW	OFF	OFF	OFF	OFF		
Φ2	R	R	R	R	R	G	R	R	DW	DW	DW	W	OFF	OFF	OFF	OFF		
Φ3	R	R	R	R	R	R	← G ← Y	R	DW	DW	DW	DW	OFF	OFF	OFF	OFF		
Φ4	R	R	R	G	R	R	R	R	DW	DW	W	DW	OFF	OFF	OFF	OFF		
Φ5	R	R	R	R	← G ← Y	R	R	R	DW	DW	DW	DW	OFF	OFF	OFF	OFF		
Φ6	R	G	R	R	R	R	R	R	DW	W	DW	DW	OFF	OFF	OFF	OFF		
Φ7	R	R	← G ← Y	R	R	R	R	R	DW	DW	DW	DW	OFF	OFF	OFF	OFF		
Φ8	R	R	R	R	R	R	R	G	W	DW	DW	DW	OFF	OFF	OFF	OFF		
FLASHING	R	R	R	R	R	R	R	R	OFF	OFF	OFF	OFF	OFF	OFF	OFF	OFF		
EV1 Φ6 & Φ1	← G ← Y	G	R	R	R	R	R	R	DW	DW	DW	DW	ON	OFF	OFF	OFF		
EV2 Φ2 & Φ5	R	R	R	R	← G ← Y	G	R	R	DW	DW	DW	DW	OFF	OFF	ON	OFF		
EV3 Φ8 & Φ3	R	R	R	R	R	R	← G ← Y	G	DW	DW	DW	DW	OFF	OFF	OFF	ON		
EV4 Φ4 & Φ7	R	R	← G ← Y	G	R	R	R	R	DW	DW	DW	DW	OFF	ON	OFF	OFF		

G = GREEN
R = RED
Y = YELLOW

← G = GREEN ARROW (LEFT TURN)
← Y = YELLOW ARROW (LEFT TURN)
W = WALK (WALKING MAN, INT'L SYMBOL)

FDW = FLASHING DON'T WALK (FLASHING HAND, INT'L SYMBOL)
DW = DON'T WALK (SOLID HAND, INT'L SYMBOL)
EV = EMERGENCY VEHICLE PRE-EMPT

18TH STREET & MAIN STREET
RAILROAD PRE-EMPTION PHASING

Handwritten signature

5/11/12

		SIGNAL SEQUENCE CHART																
		PHASE	HEAD NUMBER															
			1	2,4	5	6,7,8	9	10,11	12	13,14,15	16,17	18,19	20,21	22,23	24	25	26	27
RAILROAD PRE-EMPT CIRCULATE	CLEAR- ANCE	Φ2 & Φ5 ←	R R	R R	R R	R R	← G ← Y	G Y	R R	R R	DW DW	DW DW	DW DW	DW DW	OFF OFF	OFF OFF	OFF OFF	OFF OFF
		Φ1 →	← G ← Y	R R	R R	R R	R R	R R	R R	R R	DW DW	DW DW	DW DW	DW DW	OFF OFF	OFF OFF	OFF OFF	OFF OFF
		Φ2 ↔	R R R	R R R	R R R	R R R	R R R	G G Y	R R R	R R R	DW DW DW	DW DW DW	DW DW DW	W FDW DW	OFF OFF OFF	OFF OFF OFF	OFF OFF OFF	OFF OFF OFF
		Φ3 ↙	R R	R R	R R	R R	R R	R R	← G ← Y	R R	DW DW	DW DW	DW DW	DW DW	OFF OFF	OFF OFF	OFF OFF	OFF OFF
		Φ4 ↕	R R R	R R R	R R R	G G Y	R R R	R R R	R R R	R R R	DW DW DW	DW DW DW	W FDW DW	DW DW DW	OFF OFF OFF	OFF OFF OFF	OFF OFF OFF	OFF OFF OFF
		Φ5 ↘	R R R	R R R	R R R	R R R	← G ← Y	R R R	R R R	R R R	DW DW DW	DW DW DW	DW DW DW	DW DW DW	OFF OFF OFF	OFF OFF OFF	OFF OFF OFF	OFF OFF OFF
		Φ8 ↕	R R R	R R R	R R R	R R R	R R R	R R R	R R R	G G Y	W FDW DW	DW DW DW	DW DW DW	DW DW DW	OFF OFF OFF	OFF OFF OFF	OFF OFF OFF	OFF OFF OFF

G = GREEN
R = RED
Y = YELLOW

← G = GREEN ARROW (LEFT TURN)
← Y = YELLOW ARROW (LEFT TURN)
W = WALK (WALKING MAN, INT'L SYMBOL)

FDW = FLASHING DON'T WALK (FLASHING HAND (INT'L SYMBOL)
DW = DON'T WALK (SOLID HAND, INT'L SYMBOL)
EV = EMERGENCY VEHICLE PRE-EMPT