


ITALIANNA GASLITE VILLAGE No. 1

(12 UNIT TOWNHOME DEVELOPMENT)

SOUTHWEST CORNER OF
ELEVENTH AVENUE & 29TH STREET

DEVELOPER: RICHARD AND ANNA ANDERSON

**CITY OF LEWISTON, IDAHO
NEZ PERCE COUNTY**

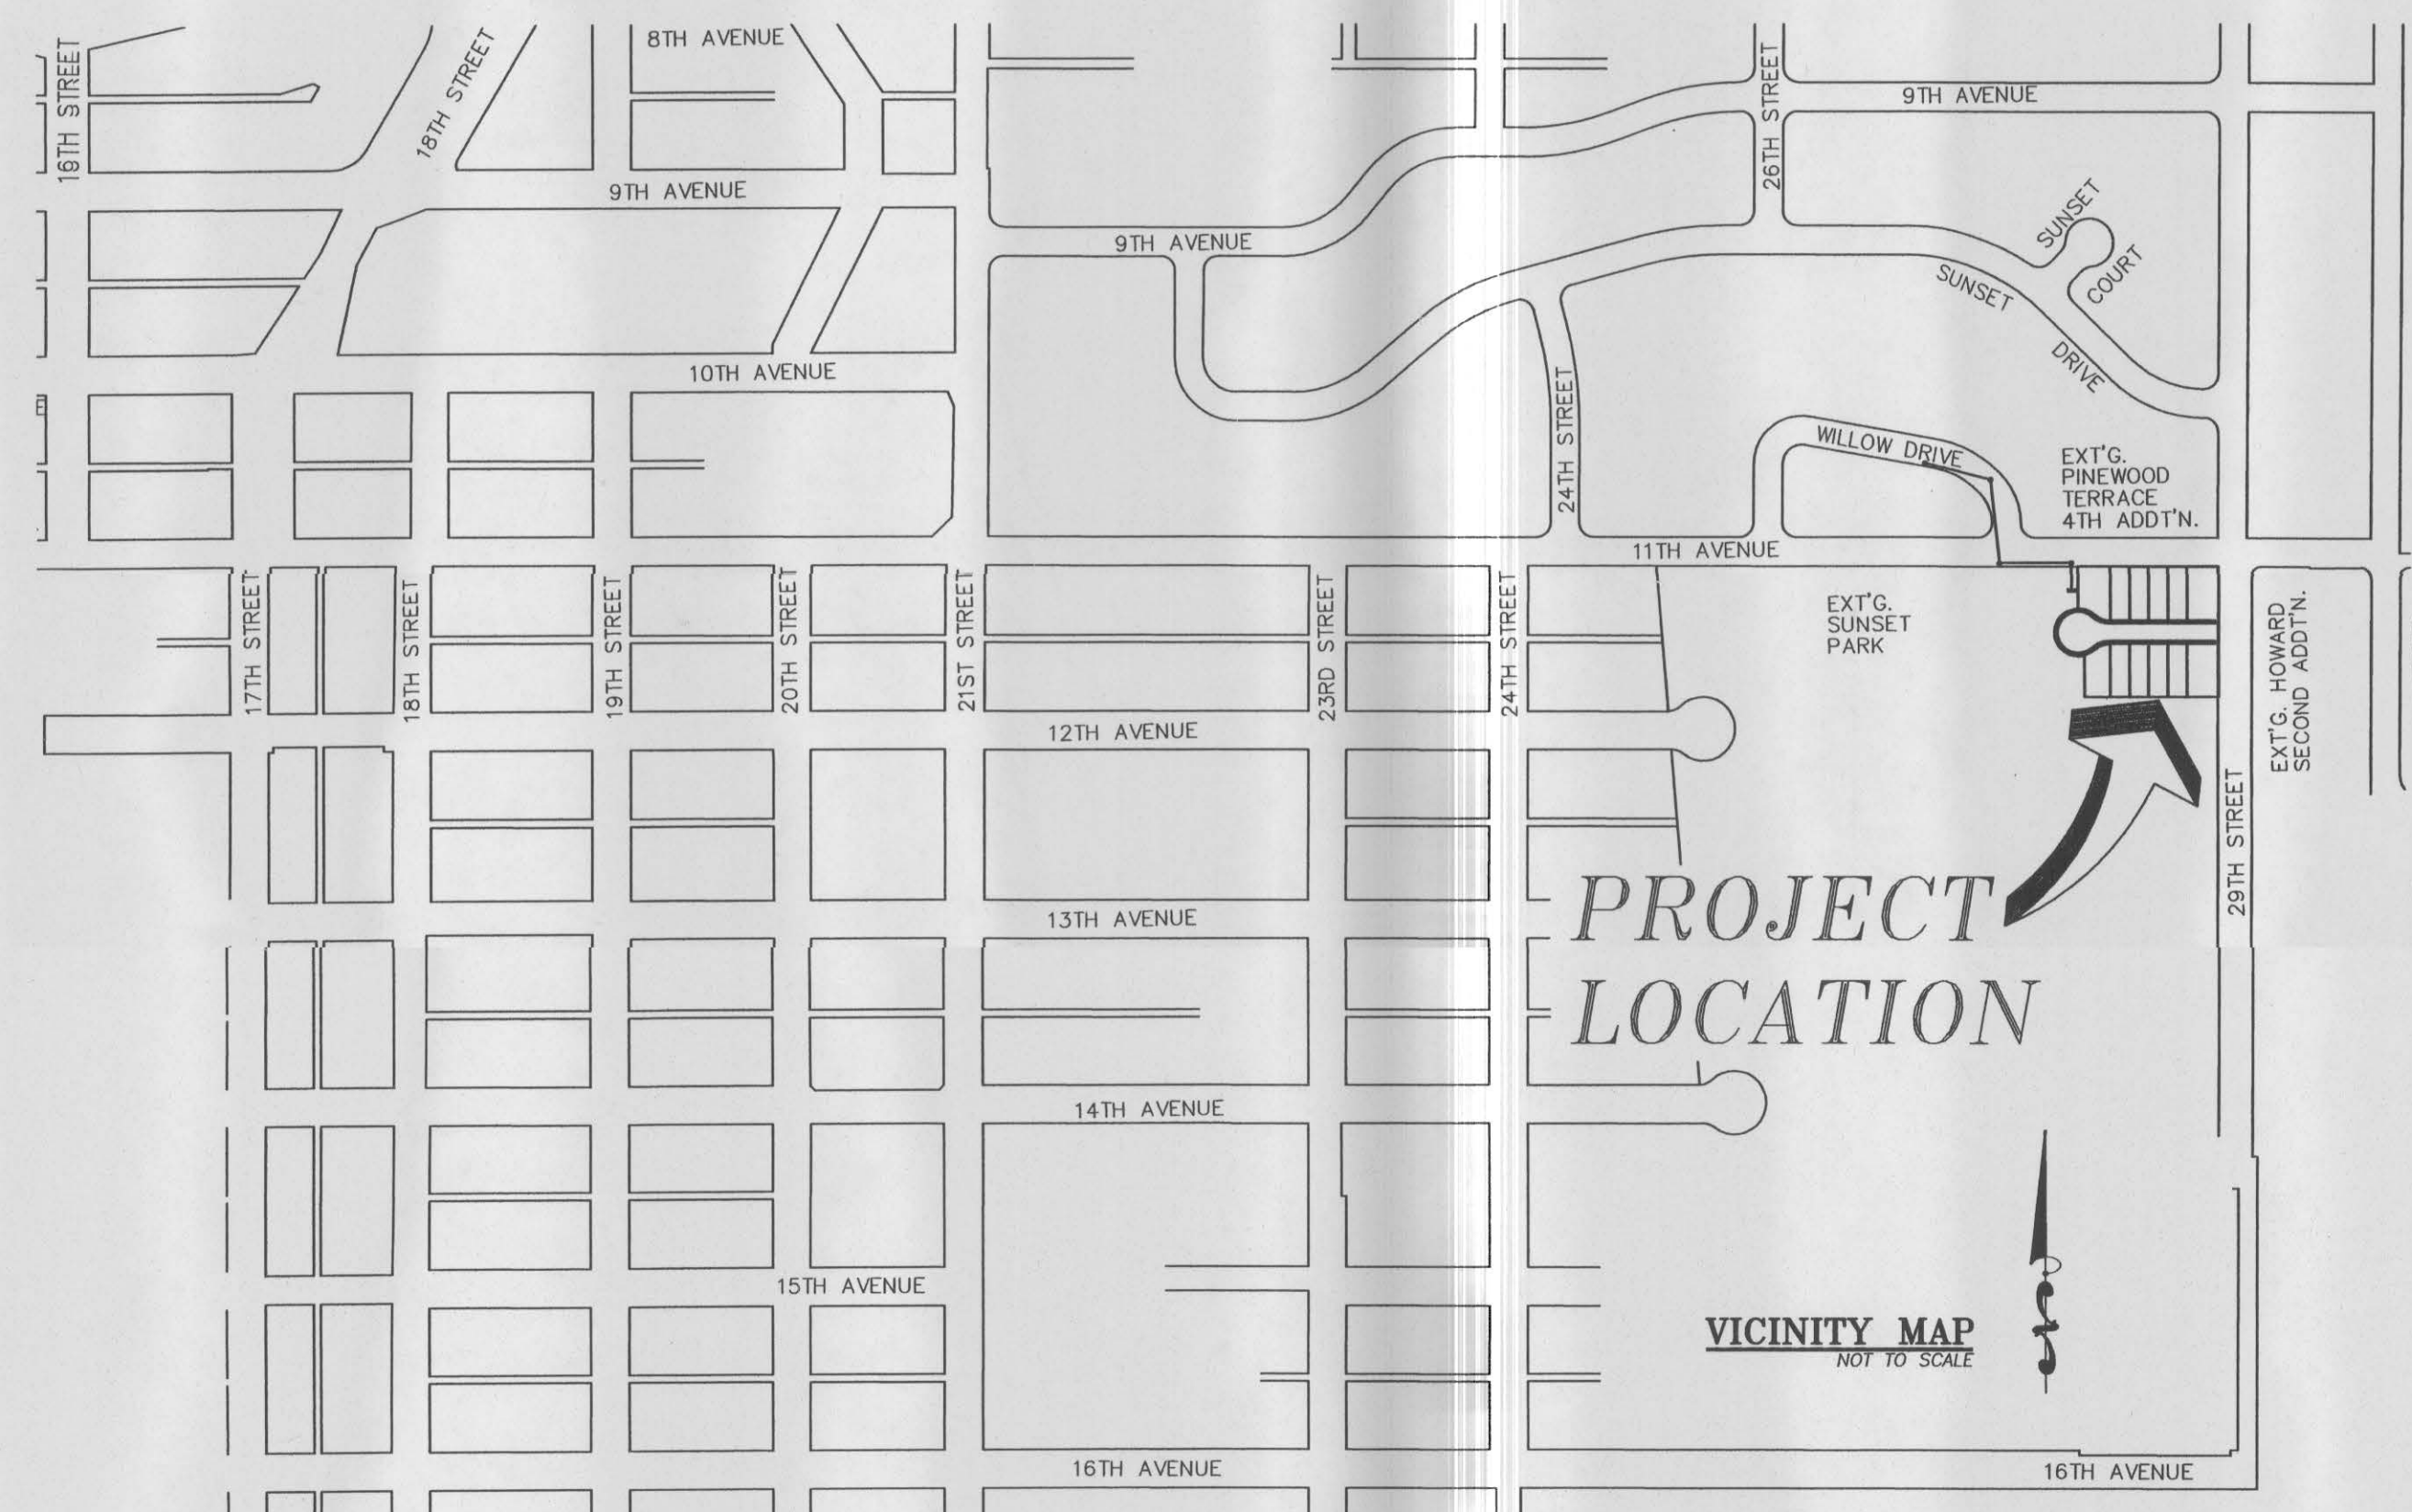

**PROGRESSIVE
ENGINEERING GROUP, INC**

PLANNING DESIGN CONSTRUCTION MANAGEMENT

1208 IDAHO STREET
LEWISTON, IDAHO 83501
PH (208) 746-5406 FAX (208) 746-9732

RECORD DRAWING 10/14/08



SHEET A

As-Builts


2810 Gaslite St.
Italianna Gaslite Village No. 1

U10-000014

RECEIVED
JUN 16 2008
CITY OF LEWISTON
BUILDING SERVICES

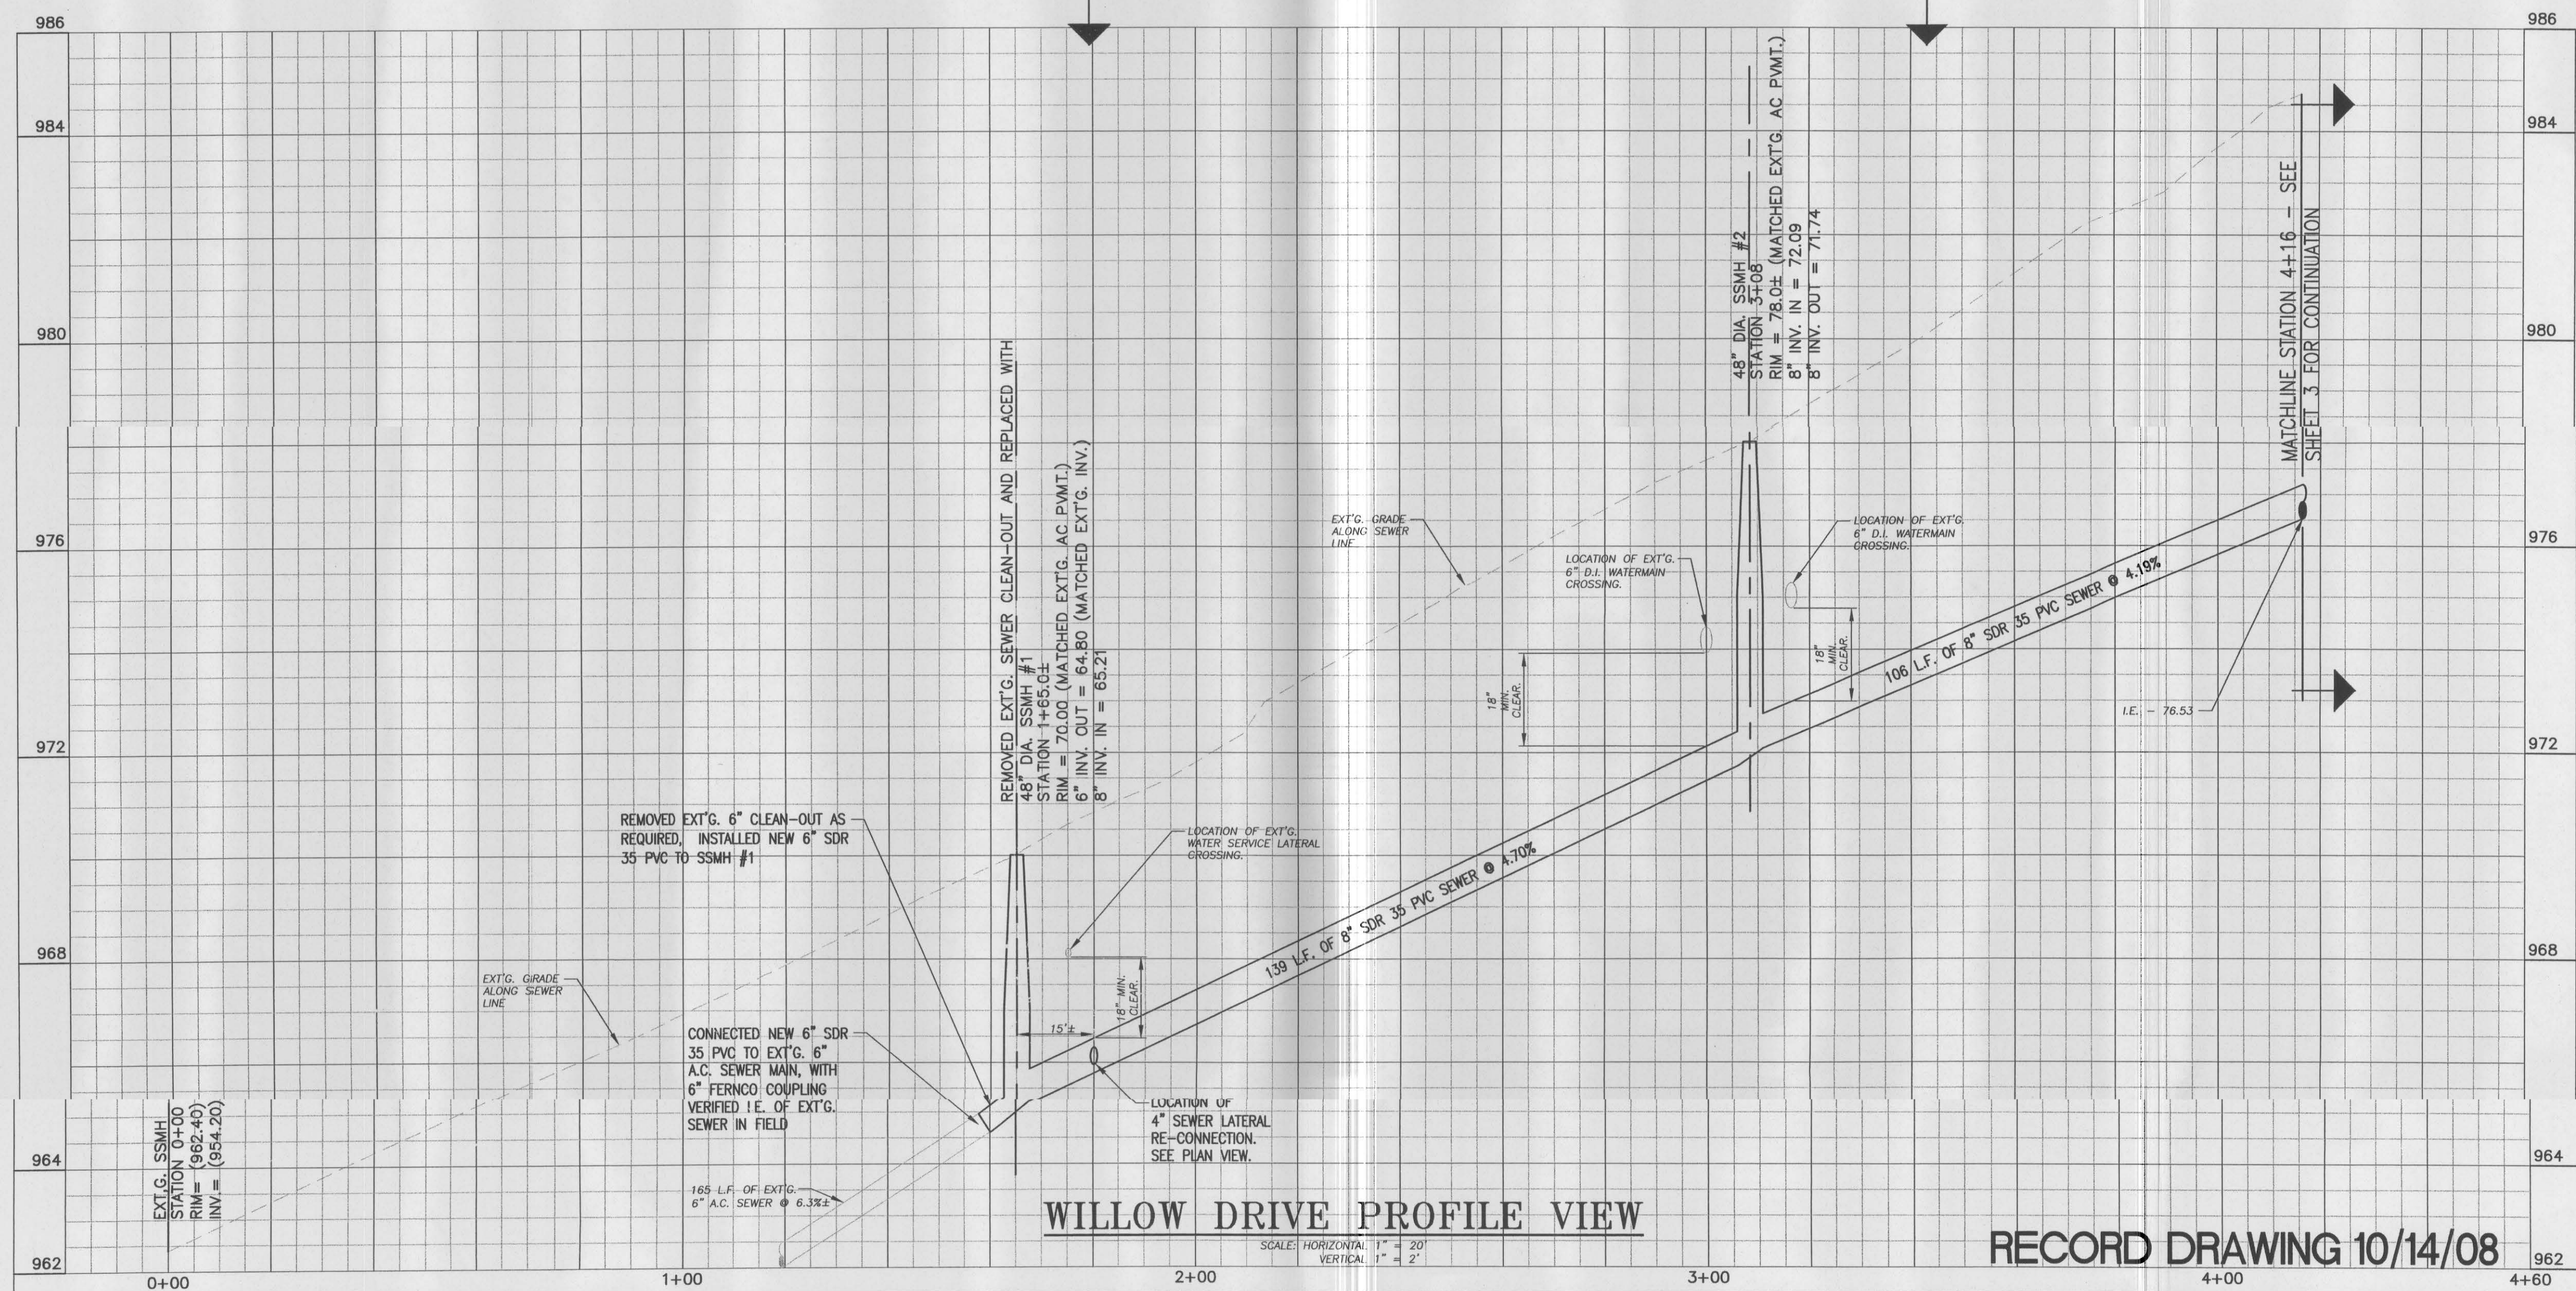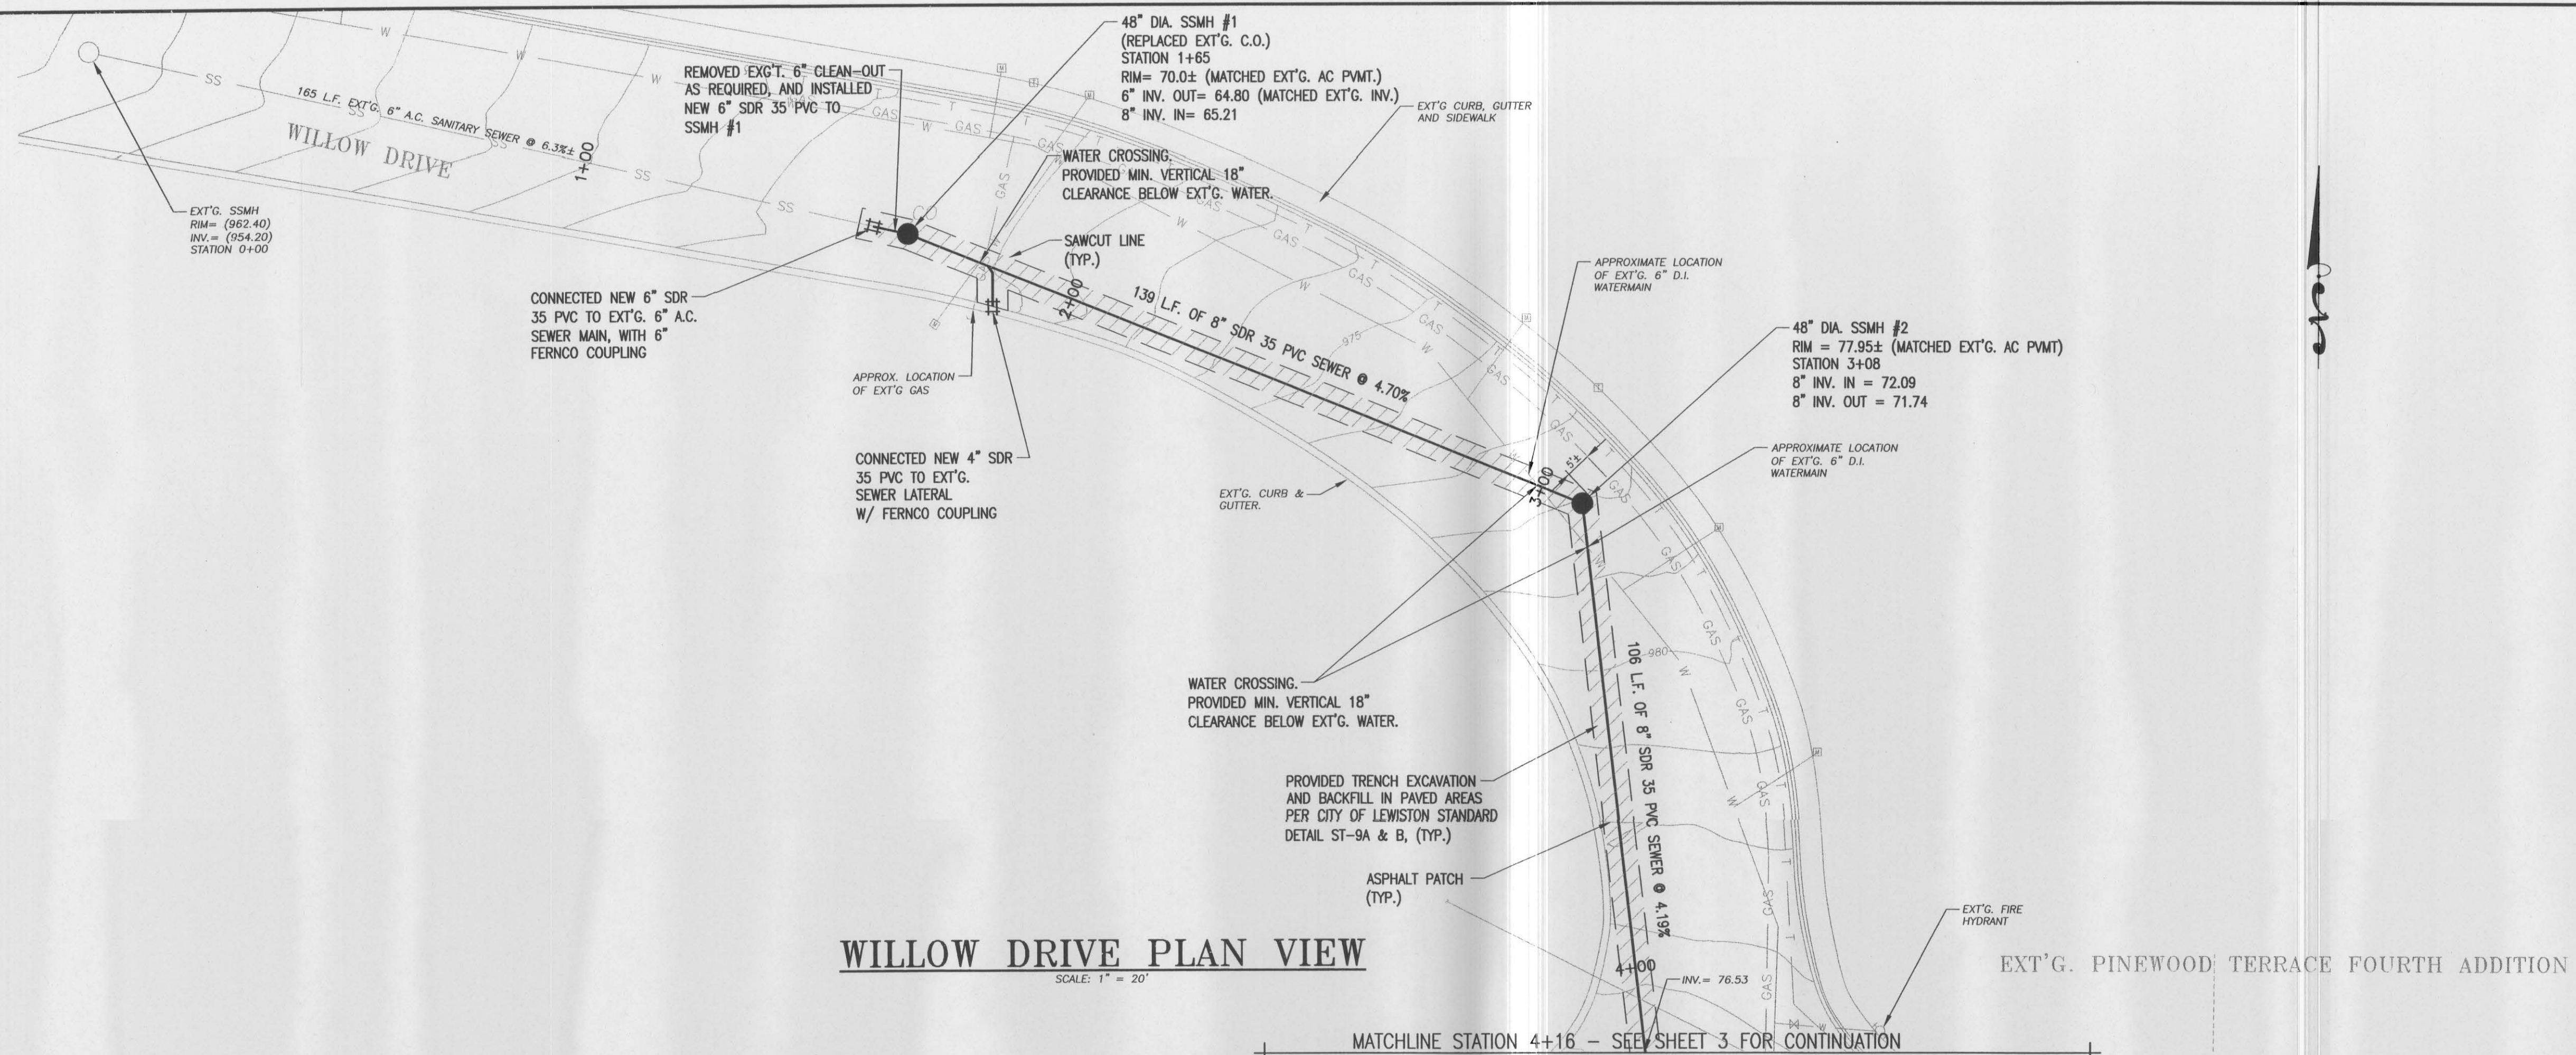

NO.	DATE	BY	REVISIONS

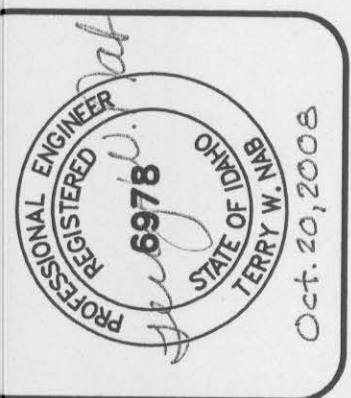



PROGRESSIVE ENGINEERING GROUP, INC
 PLANNING DESIGN & CONSTRUCTION MANAGEMENT
 1208 IDAHO STREET
 LEWISTON, IDAHO 83501
 PH (208) 746-5406 FAX (208) 746-9732

RICHARD AND ANNA ANDERSON
 ITALIANNA GASLITE VILLAGE NO.1
 WILLOW DRIVE
 UTILITY PLAN & PROFILE
 STATION 0+00 TO STATION 4+16.50

DRAWN BY:	CHECKED BY:
DESIGNED BY:	RDS
DATE:	02/04/08
LAST REV:	10/14/08
PROJECT NO.:	07-034
SHEET 1	OF 3

RECORD DRAWING 10/14/08

Z:\Company Shared\AutoCAD\PEO\DRAW\07 JOBS\07-034\ASBUILTS\07-034 SHT 2.dwg, SHT2, 10/15/2008 8:14:13 AM, PROGRESS.pcs3, JAY

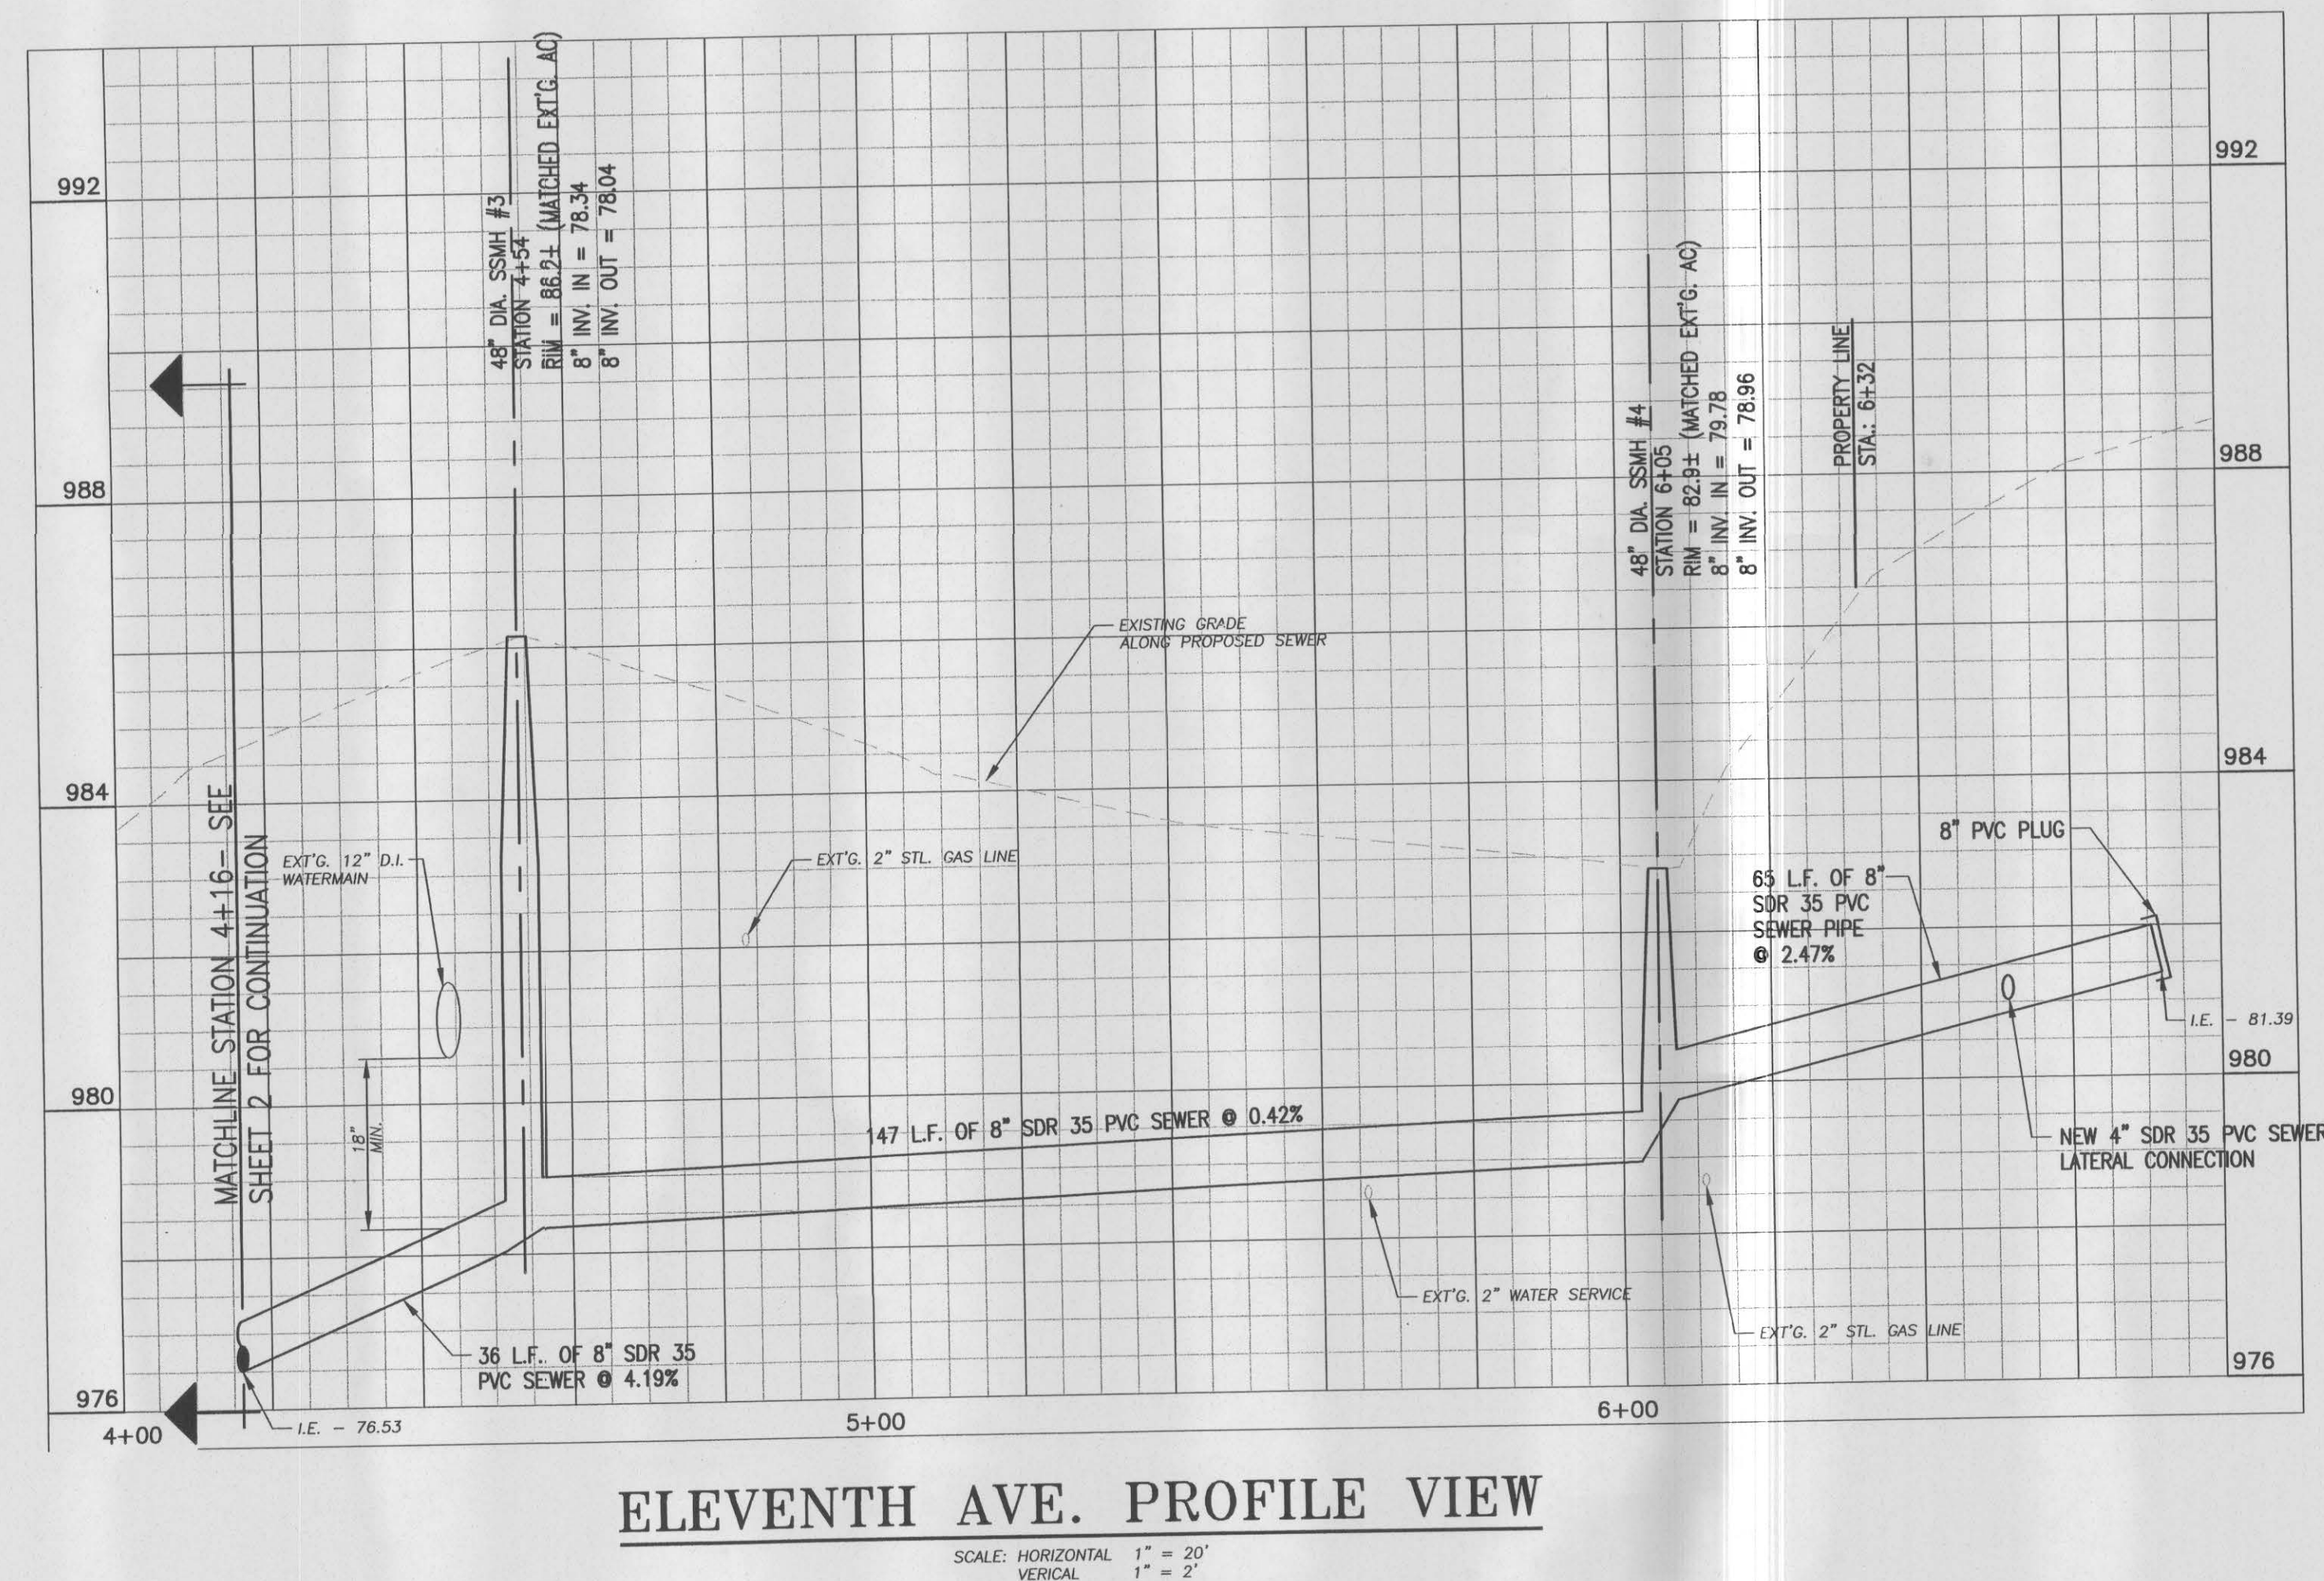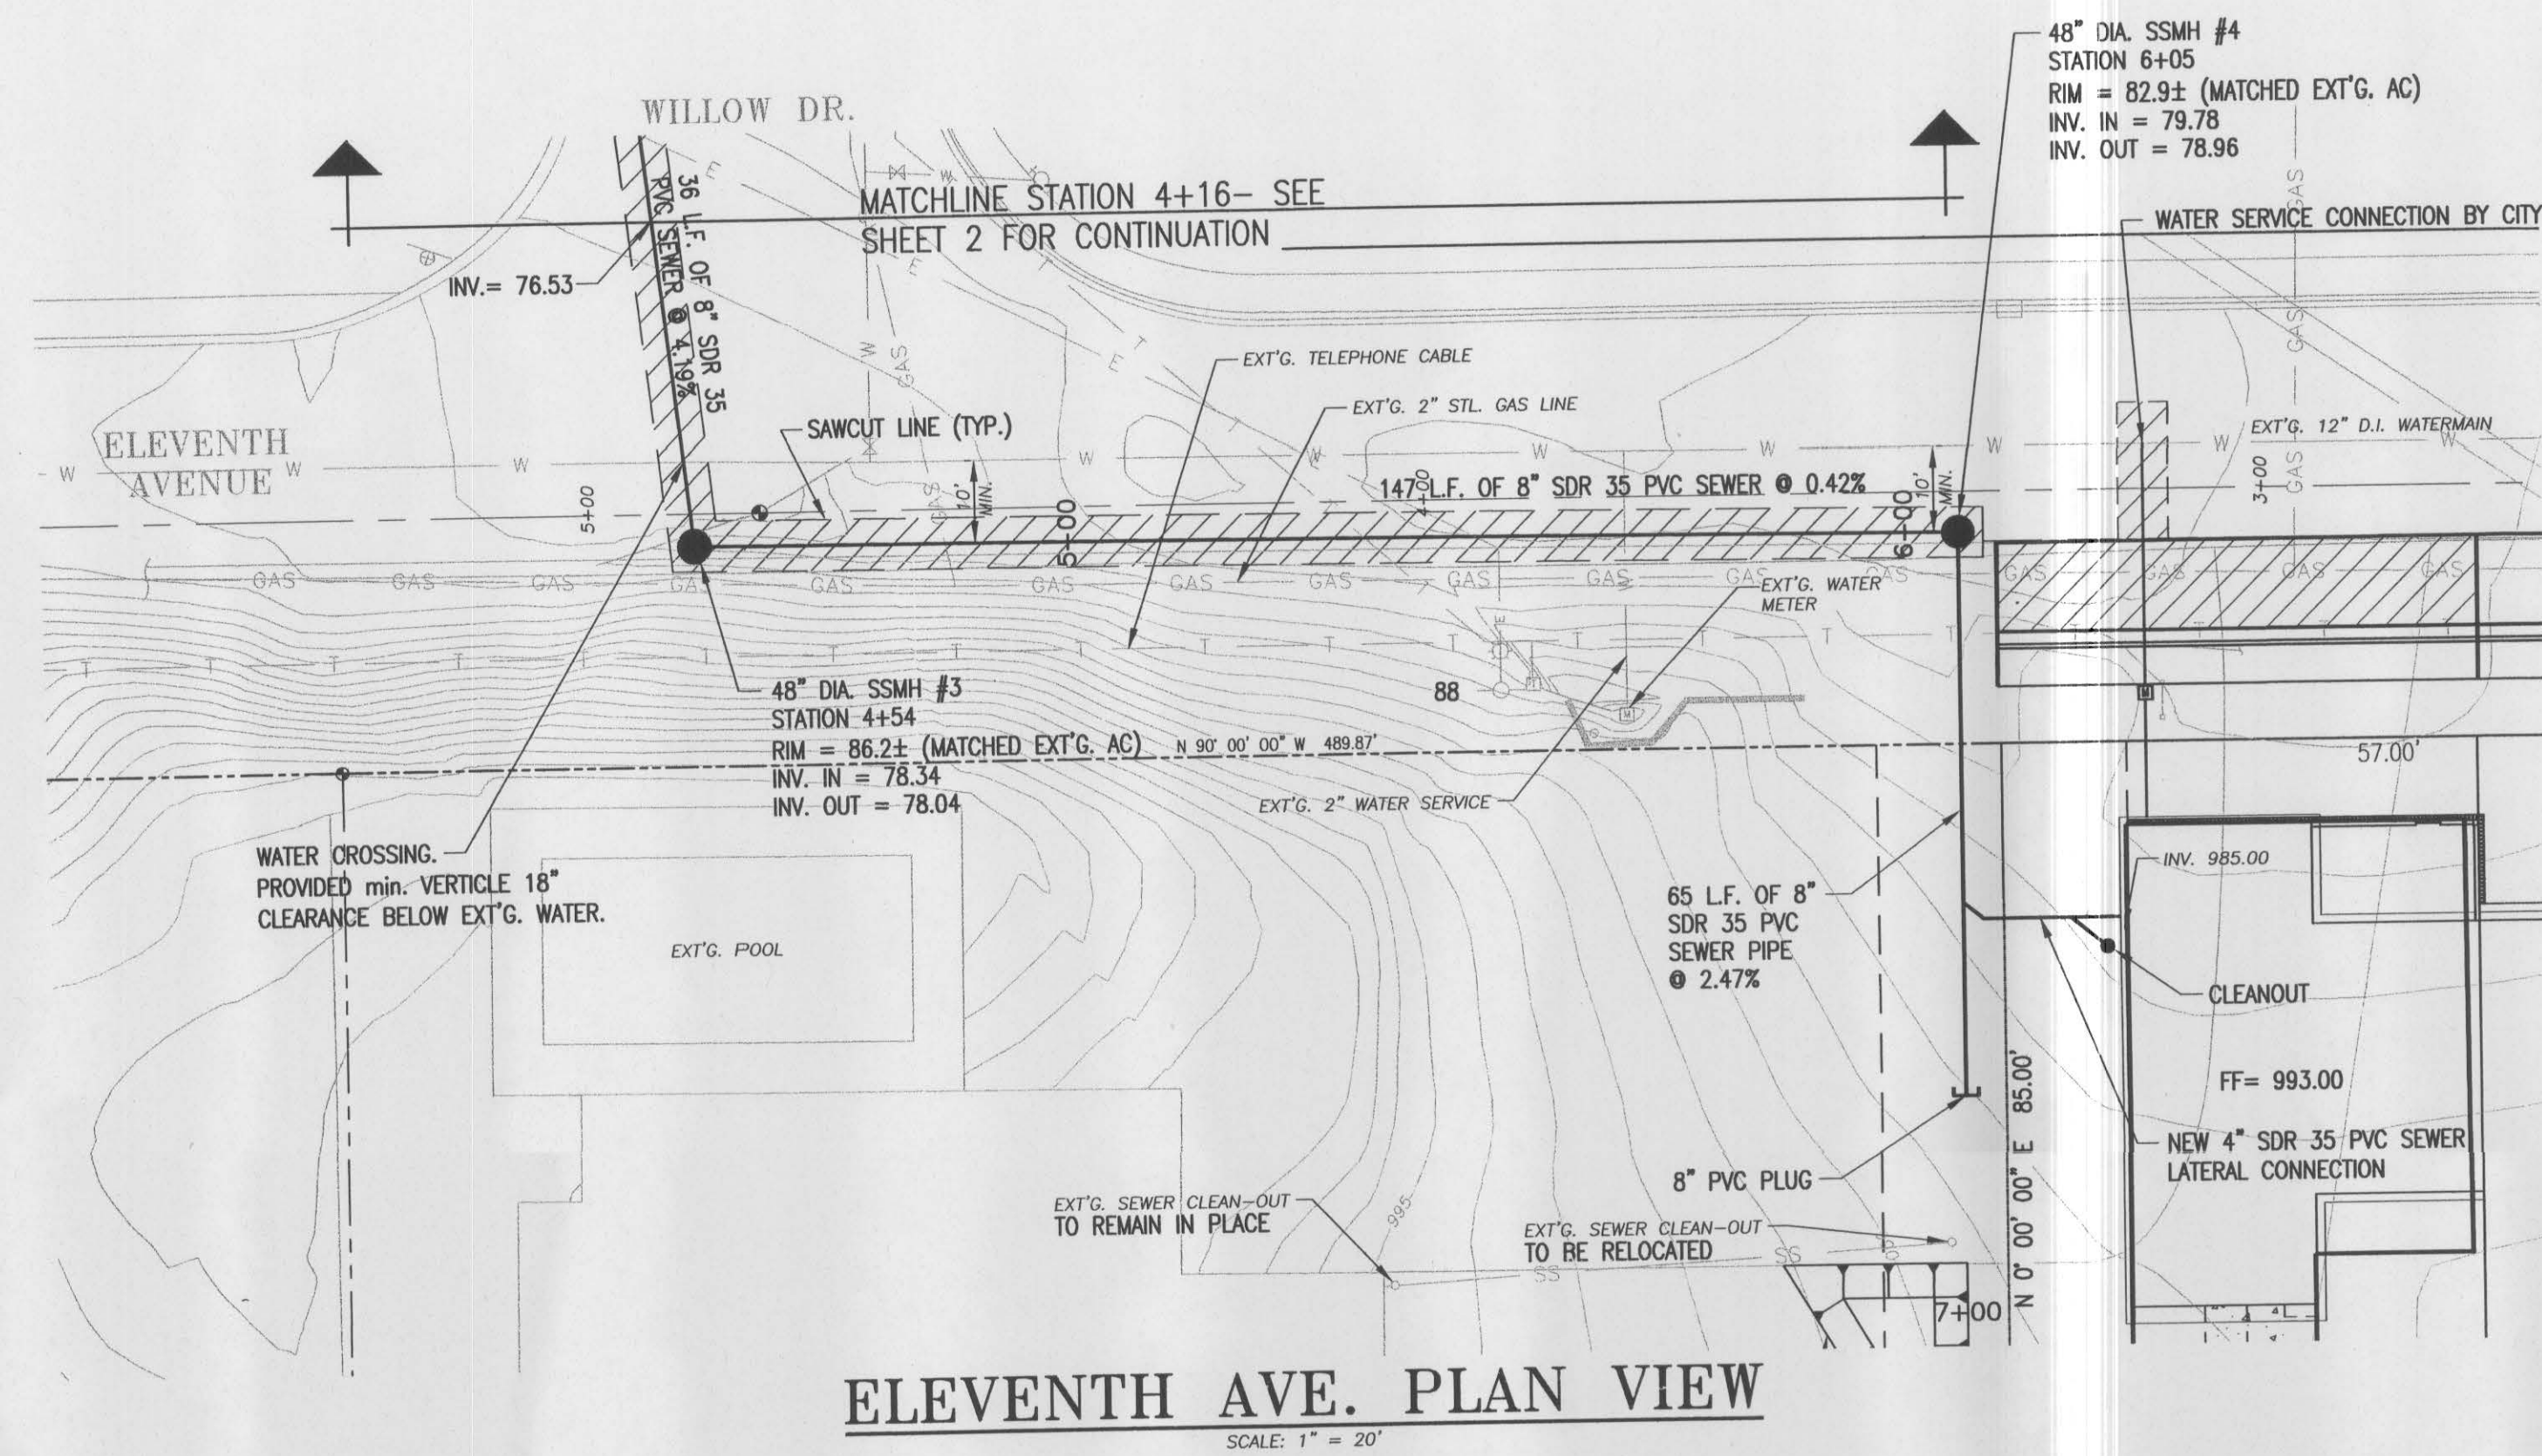


RECORD DRAWING 10/14/08

REVISIONS

BY

DATE


NO.

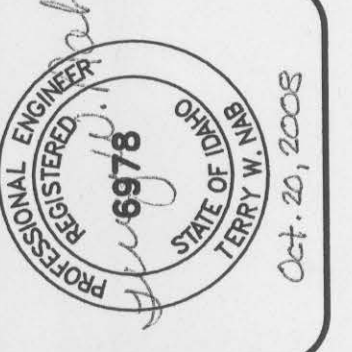

**PROGRESSIVE
ENGINEERING GROUP, INC**
PLANNING DESIGN & CONSTRUCTION MANAGEMENT
1208 IDAHO STREET
LEWISTON, IDAHO 83501
PH (208) 746-5506 FAX (208) 746-9732

RICHARD AND ANNA ANDERSON
ITALIANA GASLITE VILLAGE NO.1
ELEVENTH AVENUE
UTILITY PLAN & PROFILE
STATION 4+16.50 TO STATION 7+71


DRAWN BY:	CHECKED BY:
MSR	TWN
DESIGNED BY:	
RDS	
DATE:	06/05/07
LAST REV:	10/14/08
PROJECT NO:	07-034
SHEET 2	OF 3

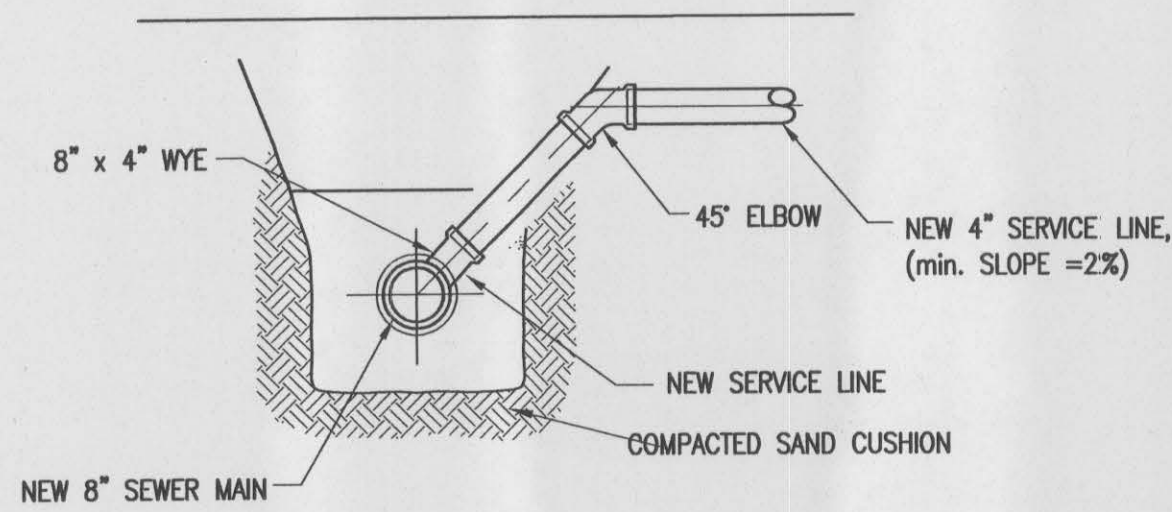

NOTE:
THE POSITION OF WYES SHOWN ON DRAWINGS IS APPROXIMATE AND IS INTENDED ONLY AS AN INDICATION THAT A WYE IS REQUIRED. ACTUAL POSITIONS WILL BE DETERMINED IN THE FIELD TO MOST EFFICIENTLY SERVE THE PROPERTY INTENDED AND MUST BE RECORDED ON A SET OF AS-BUILT DRAWINGS.


TYPICAL SEWER SERVICE CONNECTION

NOT TO SCALE

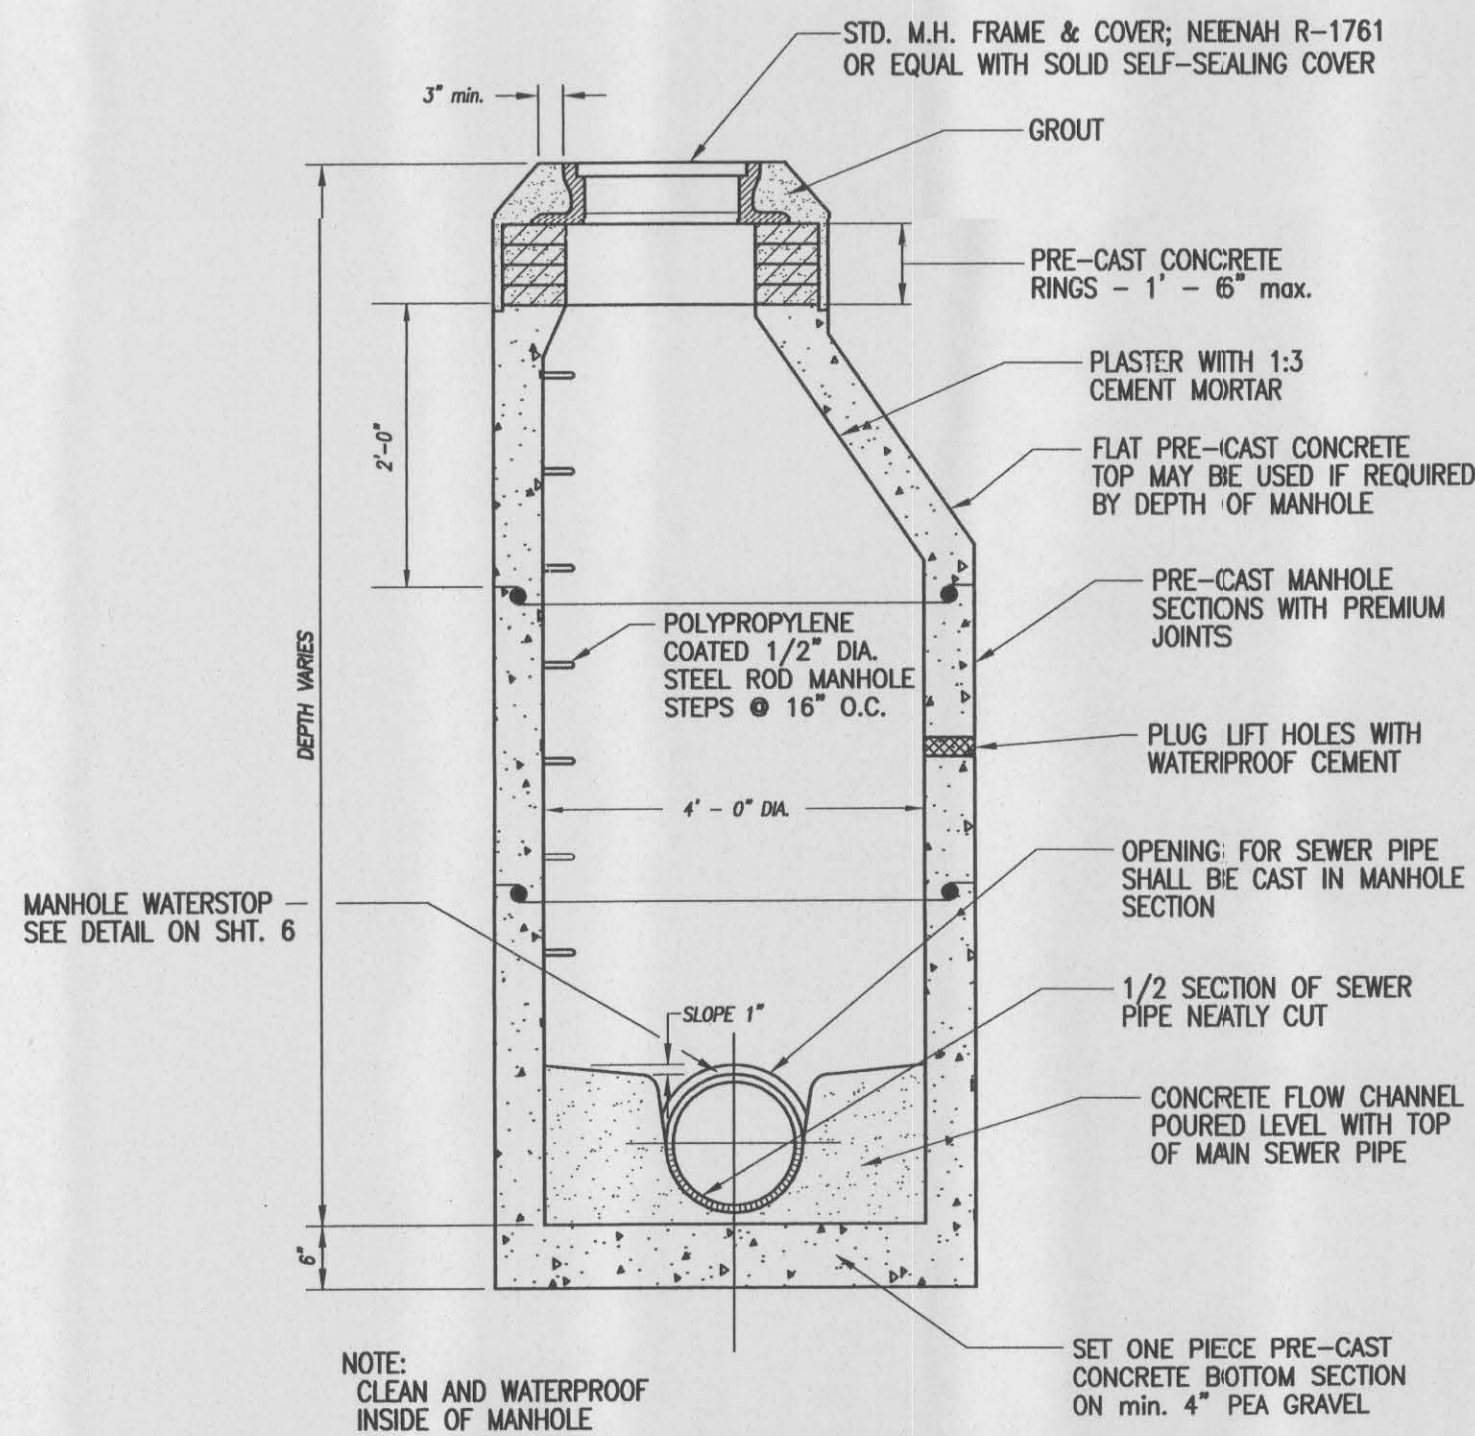


4' MANHOLE DETAIL

NOT TO SCALE

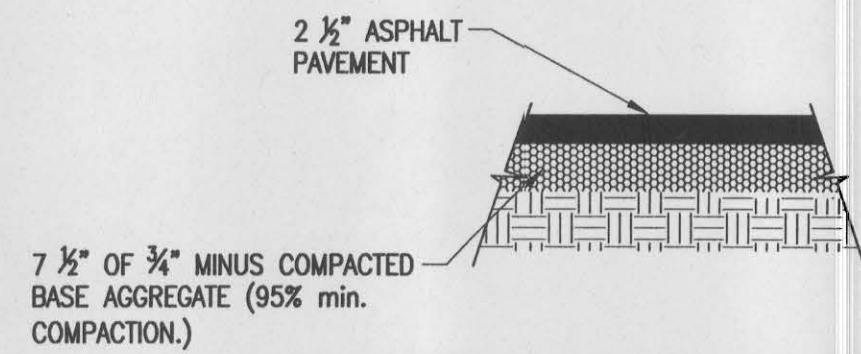

ASPHALT PAVEMENT & PACHTING DETAIL

NOT TO SCALE

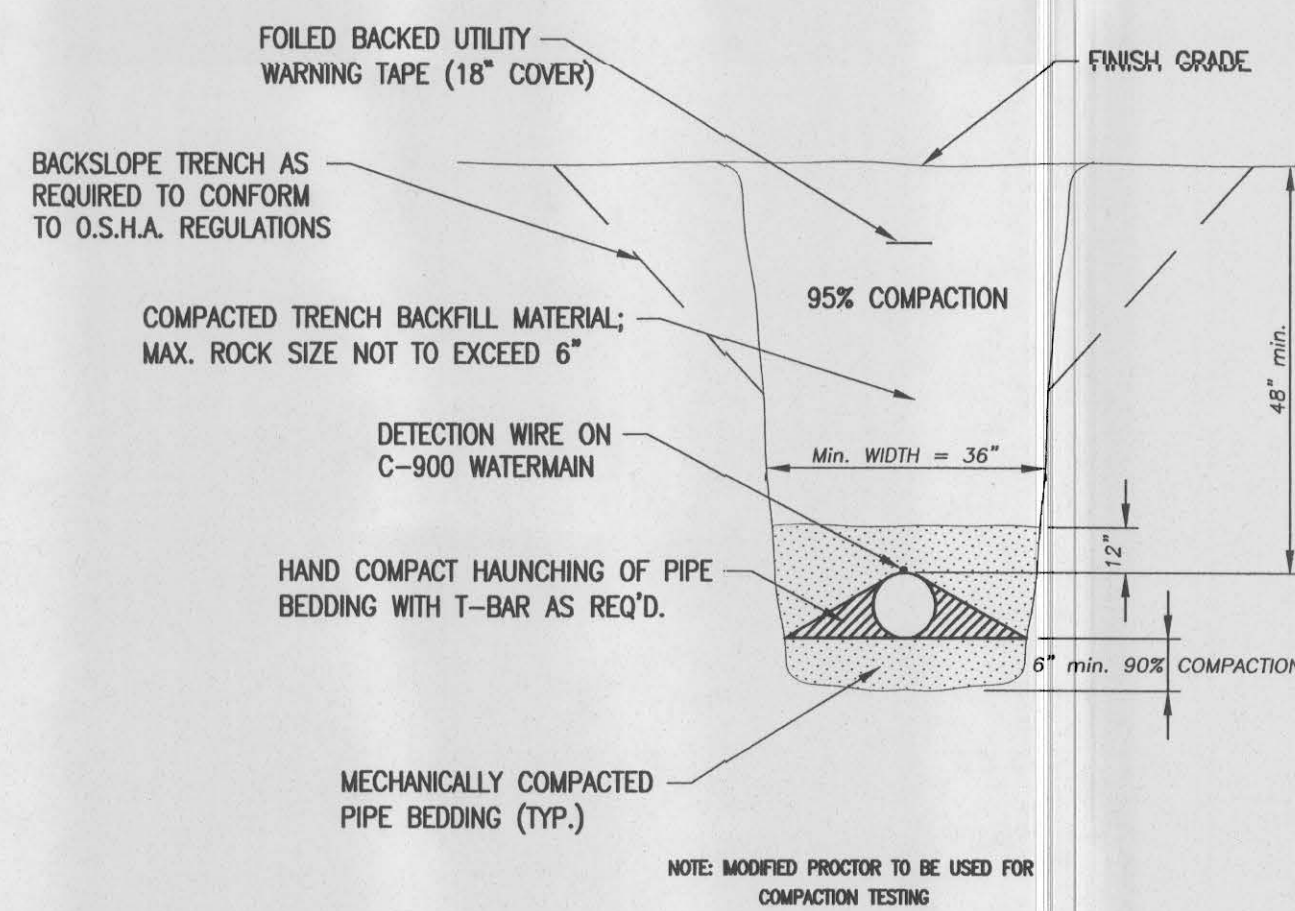


TRENCH EXCAVATION & BACKFILL DETAIL

NOT TO SCALE

REVISIONS

No. DATE BY

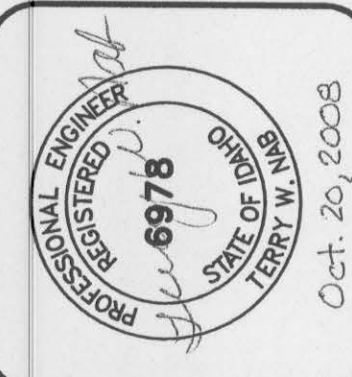

**PROGRESSIVE
ENGINEERING GROUP, INC**
DESIGN & CONSTRUCTION MANAGEMENT
1208 IDAHO STREET
LEWISTON, IDAHO 83501
PH (208) 746-5406 FAX (208) 746-9732

RICHARD AND ANNA ANDERSON
ITALIANNA GASLITE VILLAGE NO.1
DETAIL SHEET
LEWISTON, IDAHO 83501

DRAWN BY: MSR
DESIGNED BY: RDS
DATE: 08/05/07
LAST REV: 10/14/08
PROJECT NO.: 07-034
SHEET 3 OF 3

RECORD DRAWING 10/14/08