


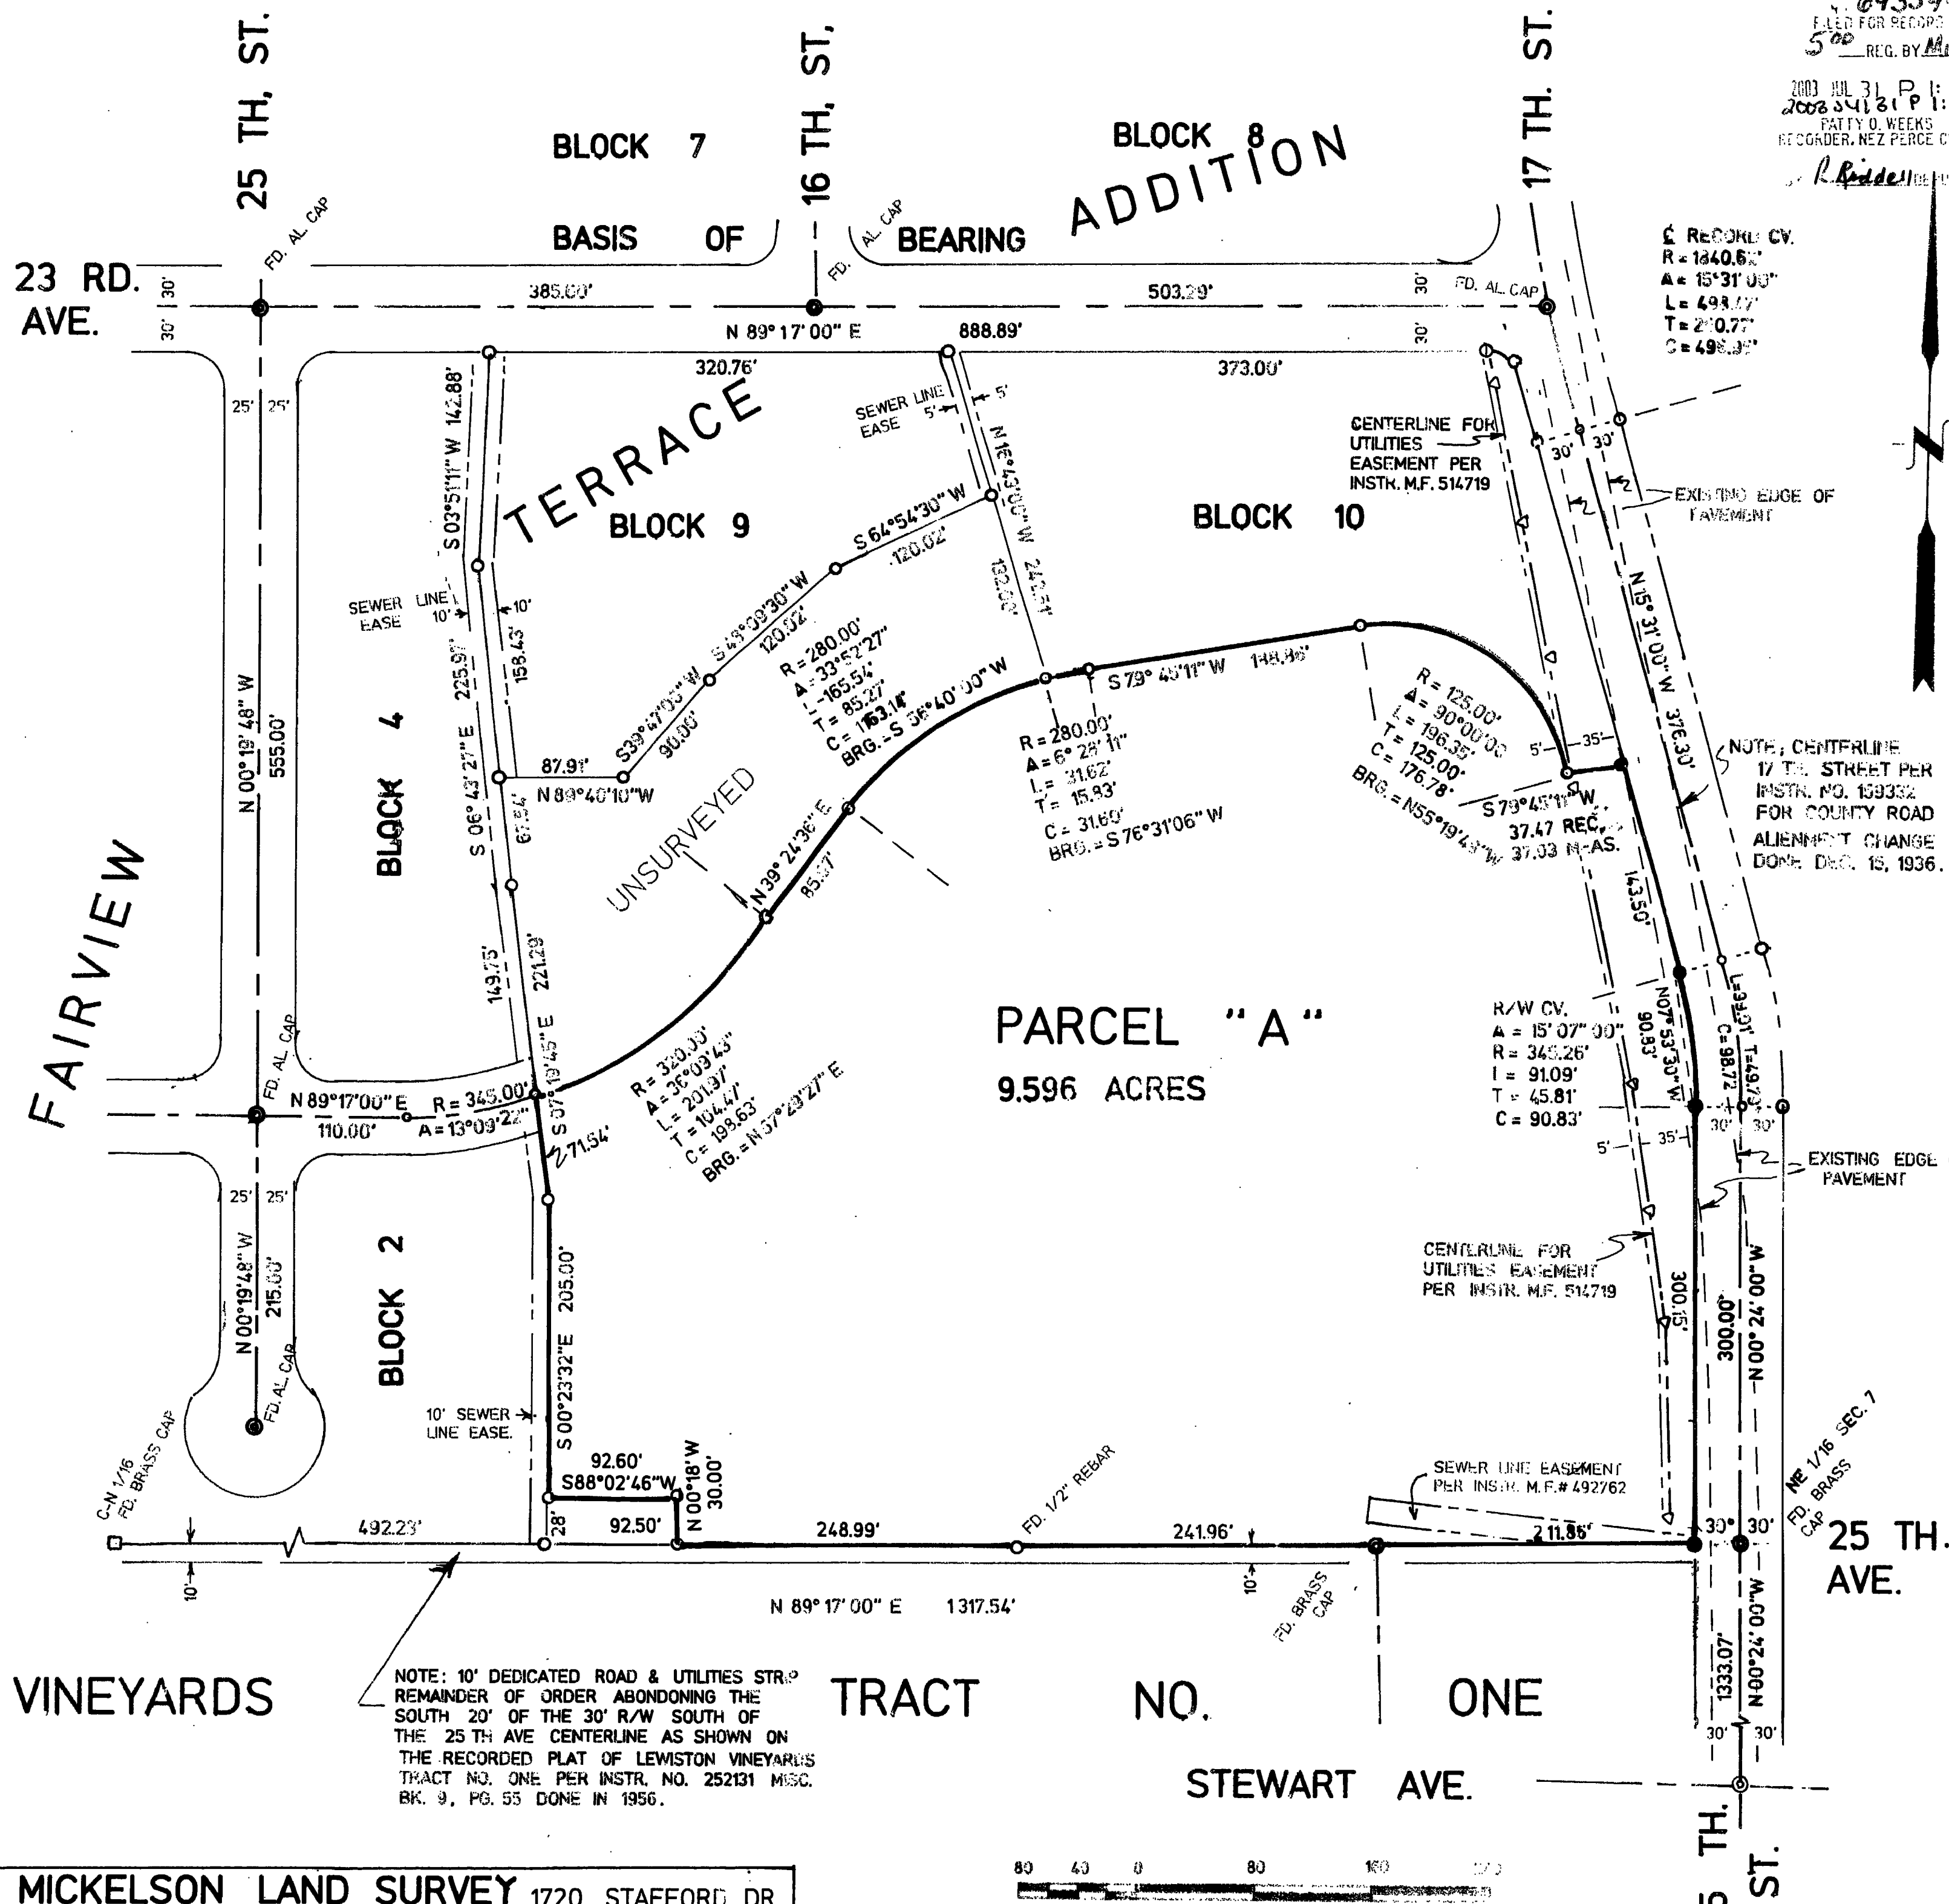

693344
FILED FOR RECORD
500 REG. BY *Richard S. Mickelson*
2003 JUL 31 P 1:15
PATTY O. WEEKS
RECORDER, NEZ PERCE CO ID
R. Riden

CAB III
352 B
COUNTY RECORDER

STATE OF IDAHO, COUNTY OF NEZ PERCE
RECORDED AT THE REQUEST OF _____
AT _____ MINUTES
PAST _____ O'CLOCK THIS _____ DAY OF _____
2003.
FEE _____ RECORDER _____
DEPUTY _____

RECORD OF SURVEY

LOCATED IN THE SE 1/4 NW 1/4-
NE 1/4 OF SECTION 7, TOWNSHIP
35 NORTH, RANGE 5 WEST,
BOISE MERIDIAN, NEZ PERCE
COUNTY, IDAHO.

SURVEY DONE FOR:

RICK KEANE
1519 POWERS AVE.
LEWISTON, IDAHO 83501

SURVEYOR'S CERTIFICATE

THIS MAP CORRECTLY REPRESENTS A SURVEY CONDUCTED
UNDER MY SUPERVISION IN ACCORDANCE WITH THE RE-
QUIREMENTS OF THE SURVEY RECORDS AT THE REQUEST
OF *Rick Keane* DURING *July* 2003.

Richard S. Mickelson DATE *7/16/03*
RICHARD S. MICKELSON, P.L.S. #822
1720 STAFFORD DR.
CLARKSTON, WA. 99403

LEGEND

- PROPERTY CORNER - SET 1/2" BY 30" REBAR W/ SERV. CAP.
- PROPERTY CORNER - FOUND SEE PLAT DESCRIPTION.
- STREET INTERSECTION MONUMENT - FOUND SEE PLAT DESCRIPTION.
- 1/16 SECTION CORNER - FOUND SEE PLAT DESCRIPTION.
- ===== PROPERTY BOUNDARY ESTABLISHED THIS SURVEY.
- LOT LINE
- ROAD CENTERLINE.
- EASEMENT LINE.