



City of Lewiston

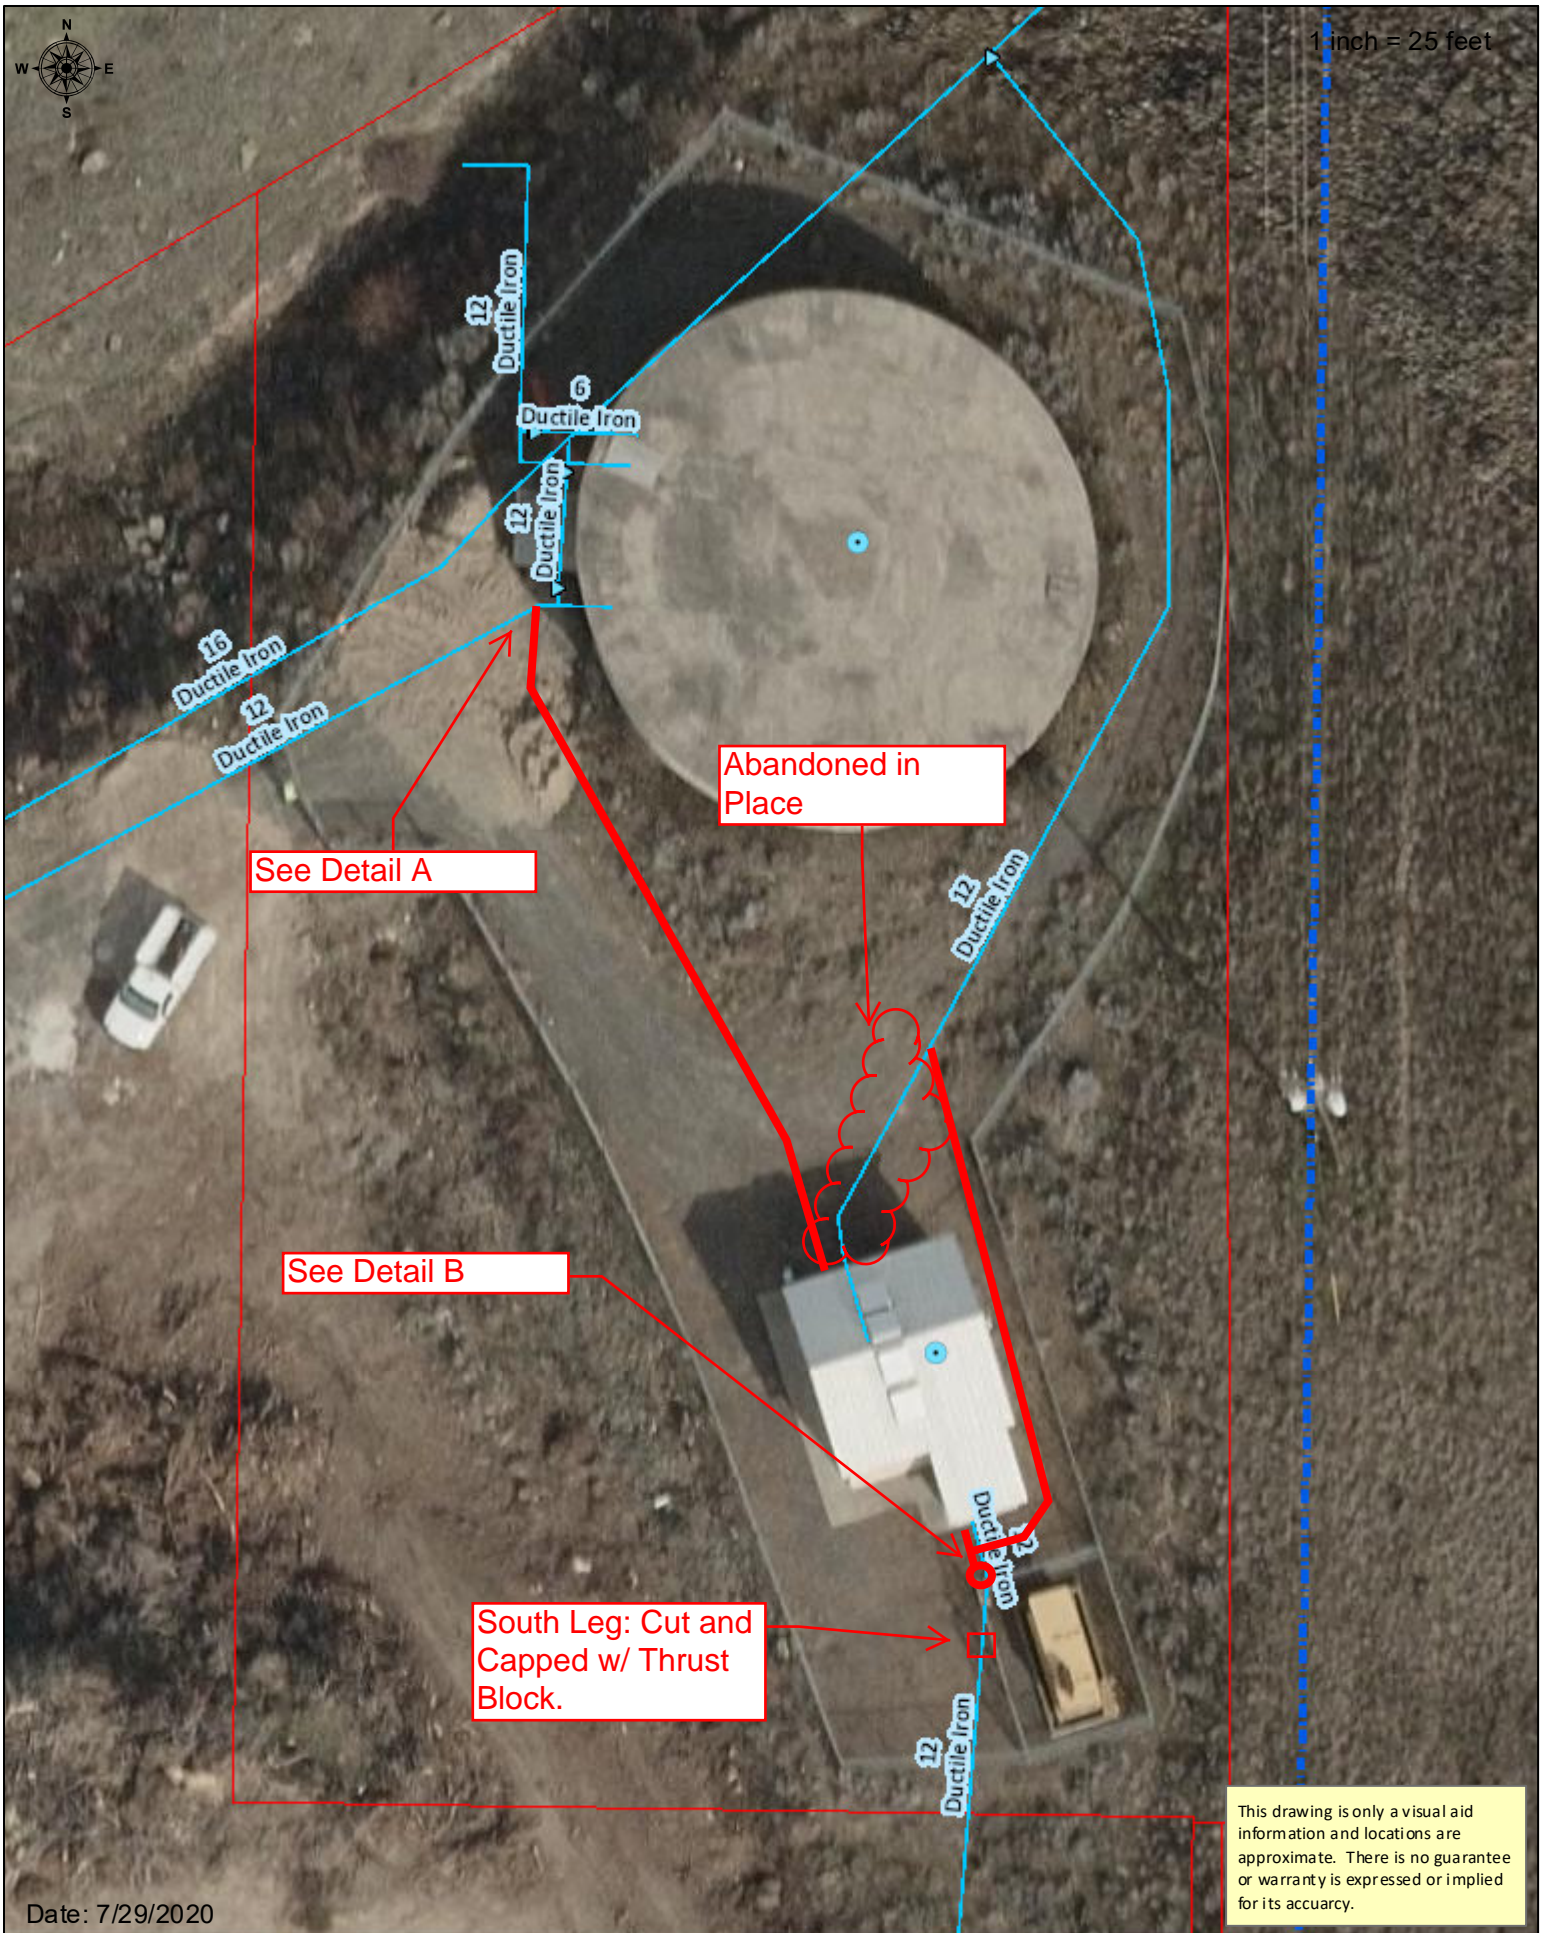

DETAIL A

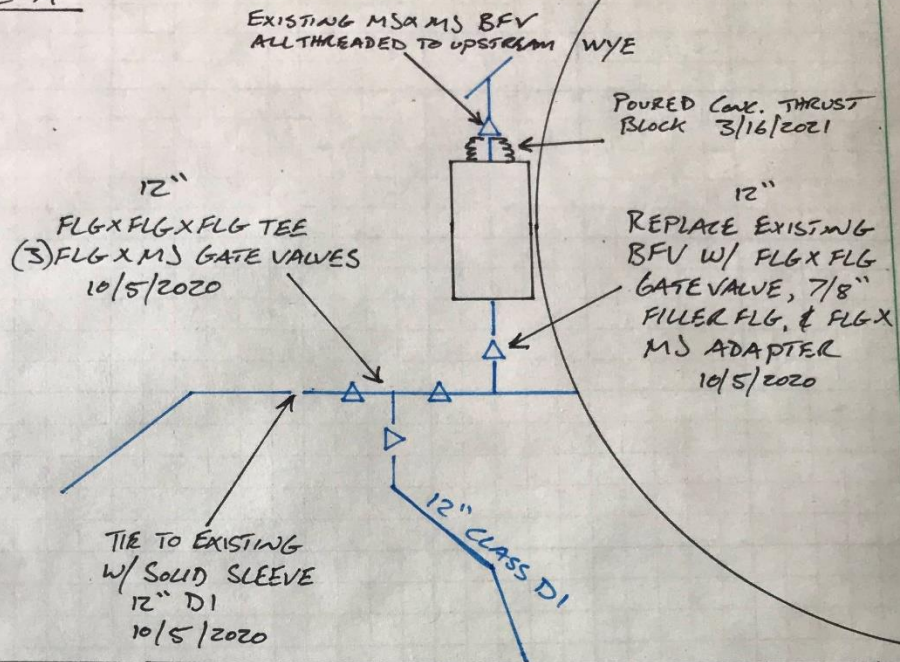

DETAIL B

