

March 23, 2021

Michael Camin, P.E.  
Engineering Manager  
Idaho Department of Environmental Quality  
Lewiston Regional Office  
1118 F Street  
Lewiston, ID 83501

**RE: 2019 Lewiston Water System Improvements: SS-6, BP-1a, BP-3**

Dear Mr. Camin,


The drawing sheets attached to this letter represent Record Drawings for the Lewiston SS-6 and BP-3 projects as submitted on September 30, 2019. Project BP-1a was completed in accordance with the DEQ-approved plans also submitted on September 30, 2019.


Sincerely,



**Mountain Waterworks**

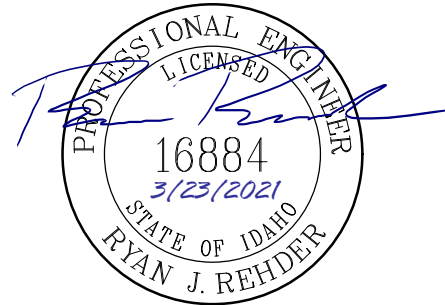

Ryan Rehder, P.E.  
Project Manager


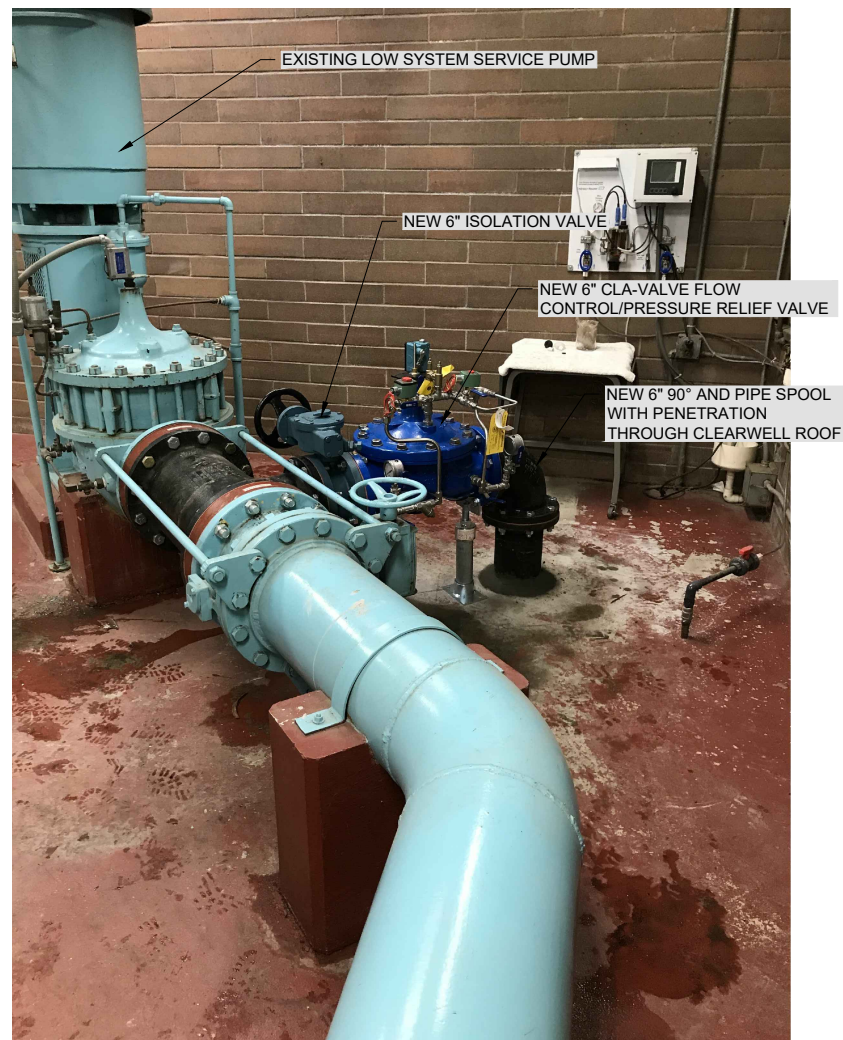




NO.				REVISION		BY	DATE	DESIGN		<b>RECORD DRAWING</b>  THESE RECORD DRAWINGS HAVE BEEN PREPARED BASED IN PART ON INFORMATION PROVIDED BY OTHERS  THIS DRAWING WAS PREPARED ONLY FOR THE PROJECT AND SITE SPECIFICALLY IDENTIFIED HEREON AND IS NOT TO BE USED ELSEWHERE		<b>ENGINEERING AND ENVIRONMENTAL SOLUTIONS</b>  504 MAIN ST. SUITE 310 LEWISTON, IDAHO 83501 208.780.3990  IDAHO OFFICES BOISE · LEWISTON · MCCALL	<b>LEWISTON IDAHO</b>  2019 WATER PROJECT   SS6 : LOW SYSTEM TO HIGH SYSTEM - FWPS INTERTIE	VERIFY SCALE	
2								DRAWN						BAR IS ONE INCH ON FULL SIZE DRAWING 0 1"	
								OTW						PROJECT : 223.0040	
								CHECKED						DATE : 2/26/2021	
								APPROVED						DRAWING NO.	
														2	



Path: C:\NWWS\Drawings\Mountain Waterworks\CAD\DWG\223\0040 2019 Res and Booster 50\CAB\BP3.dwg File Name: BP3.dwg Plot Date: 2/26/2021 1:23 PM cwilliams

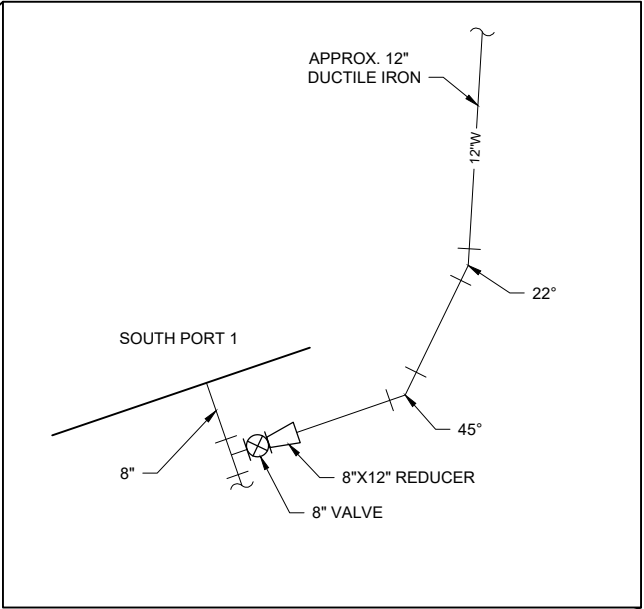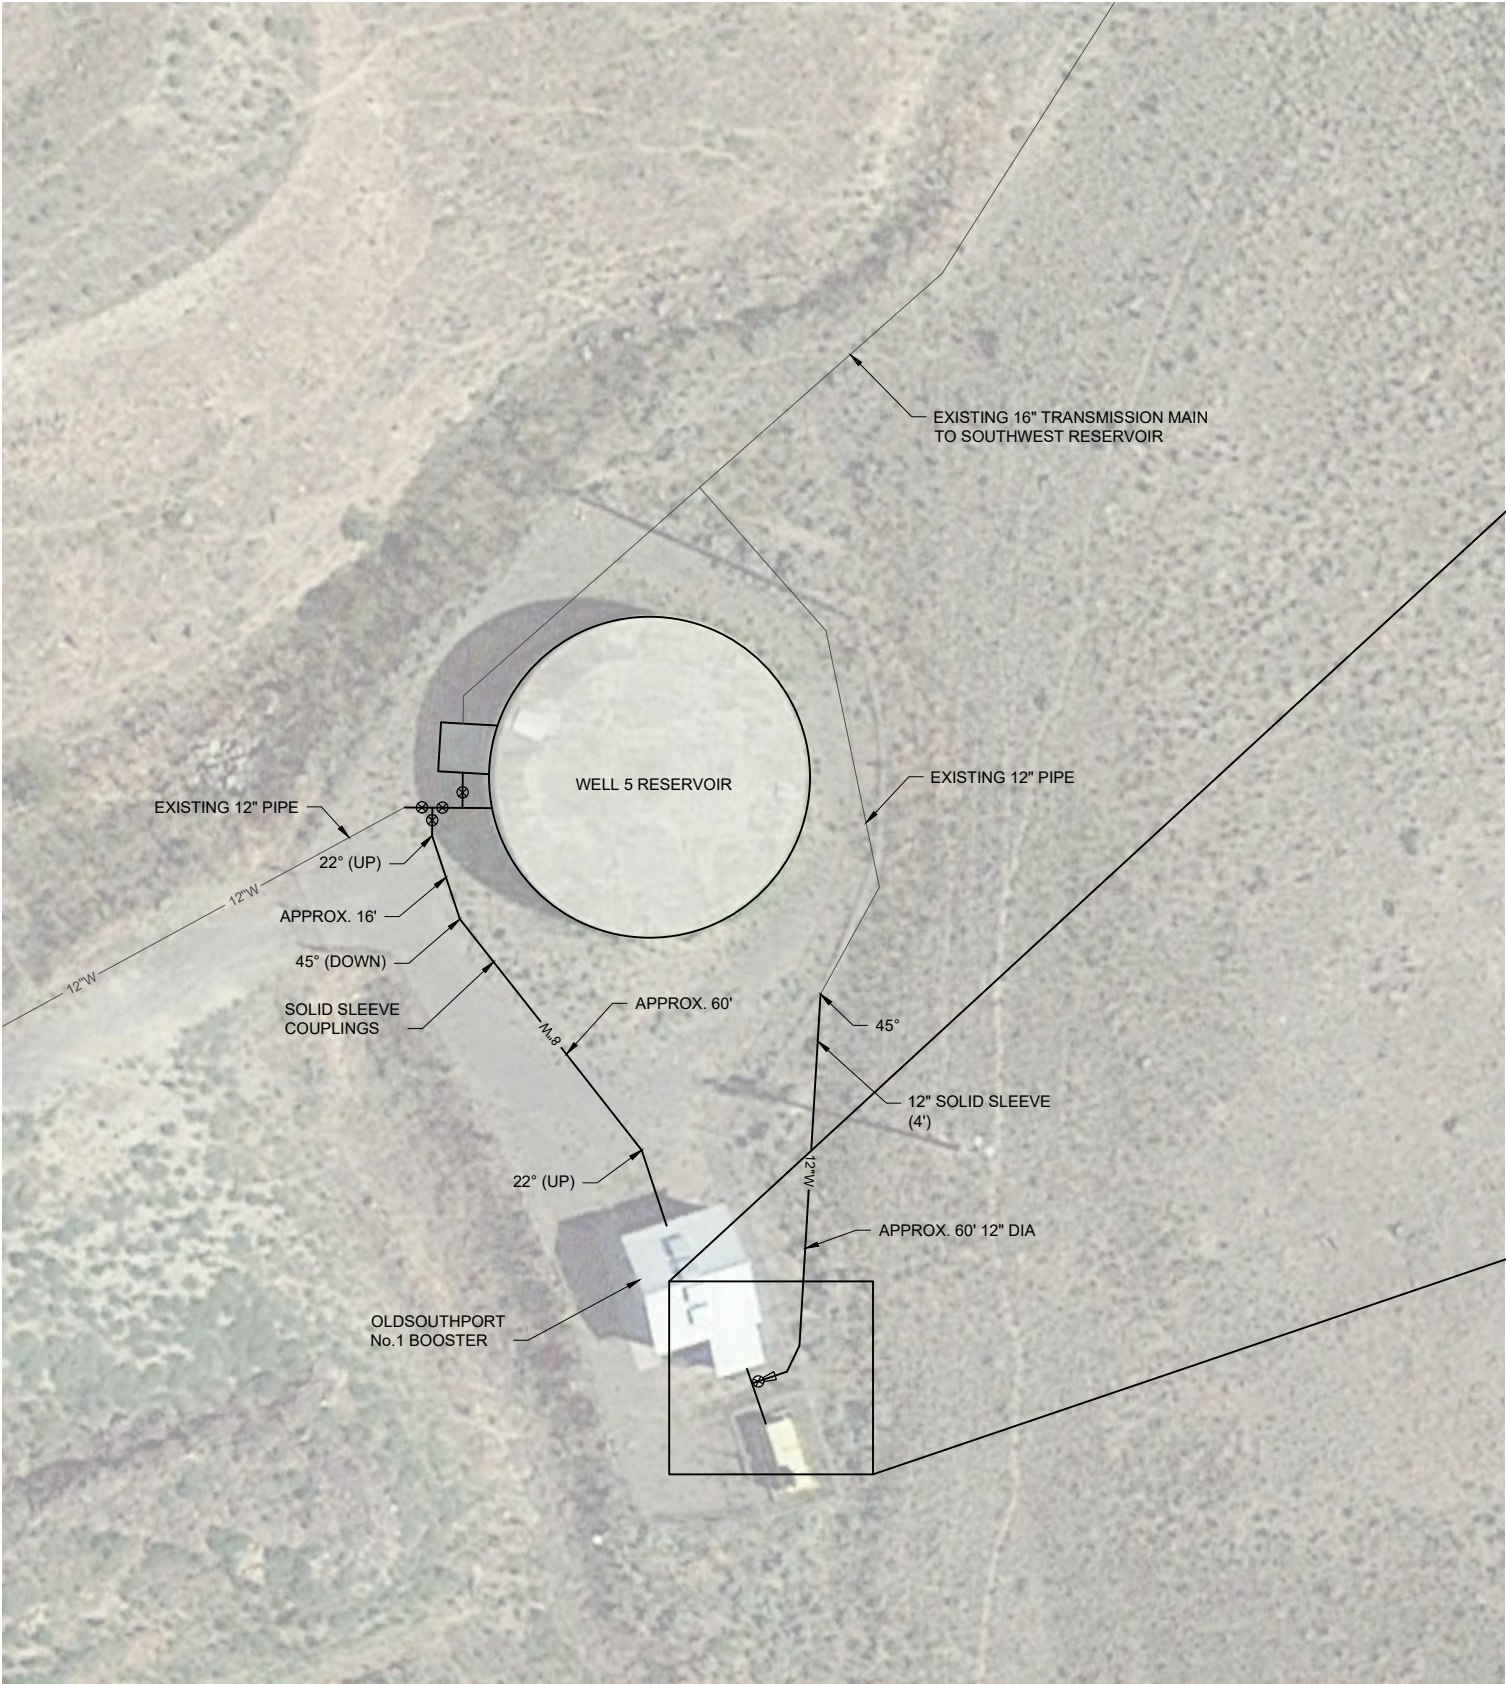

NO.	REVISION	BY	DATE	DESIGN
2				RJR
				OTW
				CHECKED
				APPROVED



RECORD DRAWING

THESE RECORD DRAWINGS HAVE BEEN PREPARED BASED IN PART ON INFORMATION PROVIDED BY OTHERS

THIS DRAWING WAS PREPARED ONLY FOR THE PROJECT AND SITE SPECIFICALLY IDENTIFIED HEREON AND IS NOT TO BE USED ELSEWHERE



ENGINEERING AND ENVIRONMENTAL SOLUTIONS

504 MAIN ST. SUITE 310  
LEWISTON, IDAHO 83501  
208.780.3990

IDAHO OFFICES  
BOISE · LEWISTON · MCCALL

LEWISTON IDAHO

2019 WATER PROJECT

BP3 : SOUTHPORT No.1 BOOSTER INTERTIE

VERIFY SCALE	
BAR IS ONE INCH ON FULL SIZE DRAWING	
PROJECT :	223.0040
DATE :	2/26/2021
DRAWING NO.	
1	