

PROJECT REVIEW COMMENT

PROJECT: **Crestline Circle Dr**
 DATE: 11/09/18
 REVIEW TYPE: Review Comments
PERMIT REVIEWED: U18-000001; BB# 534-126-661
NC= NO COMMENT
NR=NO RESPONSE
A=ACCEPT COMMENT - WILL BE CORRECTED, ADDED, OR CLARIFIED
E=DESIGNER WILL EVALUATE
D=DISAGREE WITH COMMENT, NO ACTION WILL BE TAKEN

ROUTED FOR COMMENTS:
 REQUEST COMMENTS BY:

ROUTED TO:	Review Completed:
PAT SEVERANCE (PS)	
ED GEORGE (EG)	
SHAWN STUBBERS (SS)	
IRIS HEIDORN (IH)	

BB# 138-242-758

ITEM NO.	PAGE, SHEET, GENERAL (G)	COMMENT	RESPONSE	EVALUATION	VERIFIED
1	C2	Missing updated City's Checklist			Yes
2		Address the NPC 2003 GEOLOGIC HAZARDS Report for utility (stormwater, road, etc) and lot development.	GPI to provide report to address geologic hazards		No
3		Missing street lights location & description			Yes
4		Missing franchise utility location and ten (10) feet easement outside of public right-of-way.			Yes
5		Installation of sidewalk on one side and discussion of FILO option for other required frontage improvements.			Yes
6		Missing signage and pavement markings.			Yes
7		Site plan to show construction of gravel turnaround at the end of asphalt.		Fire Dept requested loop connection to be completed with twenty(20) foot wide gravel surface; work with Linda Steputat.	Yes
8	C3	Revise Grading Note #7 to read, "Unless otherwise noted, Street cross sections shall conform to City of Lewiston Standard Drawing #3-1.	Replaced City Standard 3-4 with D-1 on sheet C11	Variance accepted but City Standard D-1 to be place in Plan Set.	Yes
9		City approved video inspection & reporting of all stormwater and wastewater mains prior to paving.			Yes
10	C5	Remove temporary water service at main at 622 Crestline and install permanent service per plans.			Yes
11	C7	Installation of fire hydrants (not flushing hydrants) required.	Corrected note on C5	See C5 - Missed change in Profile note.	Yes

12	C9	Provide access to maintain stormwater pond.	Open ditch and pond will be private system, added notes for slope stability and developer maintenance on sheet C9	New pond location but still lacking easements, access, outlet design, pond construction verification and geo-tech evaluation.	No
13	C9	How will 1/2" diameter orifice opening stay clear from debris?			N/A
14	C11 - C14	Update City Standard Drawings #1-3; #1-8 and #6-1; updated Drawings can be found on City's website under Public Works/Engineering/Construction Standard Drawings			Yes
15	Stormwater System	Lots have to provide individual stormwater mitigation. Overflow can be convey to public system.			Yes
16	Stormwater System	Missing riprap/ channel design calculations			N/A
17		Air/ Vacum Release on high side of water main.	Added after valve at end of existing water main		
18		What is use of the storm line in Lot 5?	Overflow for 3 lots in block 15, 8" pipe is existing, to be maintained by developer		
19		Have Plan Set been submitted to DEQ?	Yes		
20	C5	Waterline Crossing #2 requires waterpipe class pipe. Water service to be locate near main for Lot 5	Changed storm drain crossing pipe from ADS N-12 to PVC C900. Oriented Lot 5 water service perpendicular to waterline		
21		Pre Construction meeting with Engineer, Developer and Contractor required			
22		Variances from standards or approved design require written approval prior to construction by the City Engineer			
23		A right-of-way permit shall be obtained through the Public Works Department prior to any work beginning within Public right-of-way. A certified traffic control supervisor is required to submit a plan for any vehicular or pedestrian traffic modifications.			
24		Site distances for abutting properties driveways and intersections shall be maintained.			

IMPROVEMENT PLANS

CRESTLINE CIRCLE DRIVE LEWISTON, IDAHO 83501

AGENCY TELEPHONE NUMBERS


CITY OF LEWISTON BUILDING INSPECTION CONTACT: KATIE HOLLINGSHEAD OR DAWN ORTIZ	(208) 746-1318 EX 7263 DAWN EX 7203 KATIE
CITY OF LEWISTON WATER & L.O.S.D. CONTACT: BRYAN LACY	(208) 746-1316
CITY OF LEWISTON PUBLIC WORKS DEPT. CONTACT: SHAWN STUBBERS	(208) 746-1316
AVISTA UTILITIES CONTACT: NATE VON LINDERN	(509) 590-8742
CENTURY LINK CONTACT: BRAD McNEW	(208) 736-8760
CABLE ONE CONTACT: DAN SMITH	(208) 746-3336 EX 3 DAN
UNDERGROUND UTILITY LOCATE (CALL 48 HOURS BEFORE YOU DIG)	1-800-342-1585 or call 811
DEVELOPER: JOE & FRANCES MCCANN FAMILY LIMITED PARTNERSHIP 202 26TH AVENUE LEWISTON, ID 83501	
CONTACT: PAT McCANN	(208) 791-6573



LEGEND

—(XXX)—	EXISTING CONTOUR	—XXX—	PROPOSED CONTOUR
—SS—	EXISTING SANITARY SEWER	—SS—	PROPOSED SANITARY SEWER
—W—	EXISTING DOMESTIC WATER	—W—	PROPOSED DOMESTIC WATER
—SD—	EXISTING STORM DRAIN	—SD—	PROPOSED STORM DRAIN
—O/P—	EXISTING OVERHEAD POWER	—P,G,T,C—	PROPOSED UNDERGROUND UTILITIES
—GAS—	EXISTING GAS LINE	—GAS—	PROPOSED GAS LINE
[Hatched Box]	EXISTING A.C.	[Dotted Box]	PROPOSED A.C.
[Stippled Box]	EXISTING CONCRETE	[Cross-hatched Box]	PROPOSED CONCRETE
[Grained Box]	EXISTING GRAVEL	[Cross-hatched Box]	PROPOSED GRAVEL
⊙	EXISTING SEWER MANHOLE	●	PROPOSED SEWER MANHOLE
⊕	EXISTING STORM DRAIN MANHOLE	⊕	PROPOSED STORM DRAIN MANHOLE
■	EXISTING CATCH BASIN	■	PROPOSED CATCH BASIN
⌘	EXISTING GATE VALVE	⌘	PROPOSED GATE VALVE
⊞	EXISTING WATER METER	⊞	PROPOSED WATER METER
⊙	EXISTING FIRE HYDRANT	⊙	PROPOSED FIRE HYDRANT
----	EXISTING EDGE OF ASPHALT	----	PROPOSED EDGE OF ASPHALT/SIDEWALK/CURB/GUTTER
----	EXISTING RIGHT-OF-WAY	----	NEW RIGHT-OF-WAY DEDICATION
----	EXISTING CENTER LINE	----	PROPOSED CENTER LINE OF STREET
—x—	EXISTING FENCE	⊙	PROPOSED MONUMENT
----	EXISTING SECTION LINE		
⊙	EXISTING MONUMENT		
⊕	EXISTING SECTION CORNER		
○	EXISTING PROPERTY CORNER		

VICINITY MAP

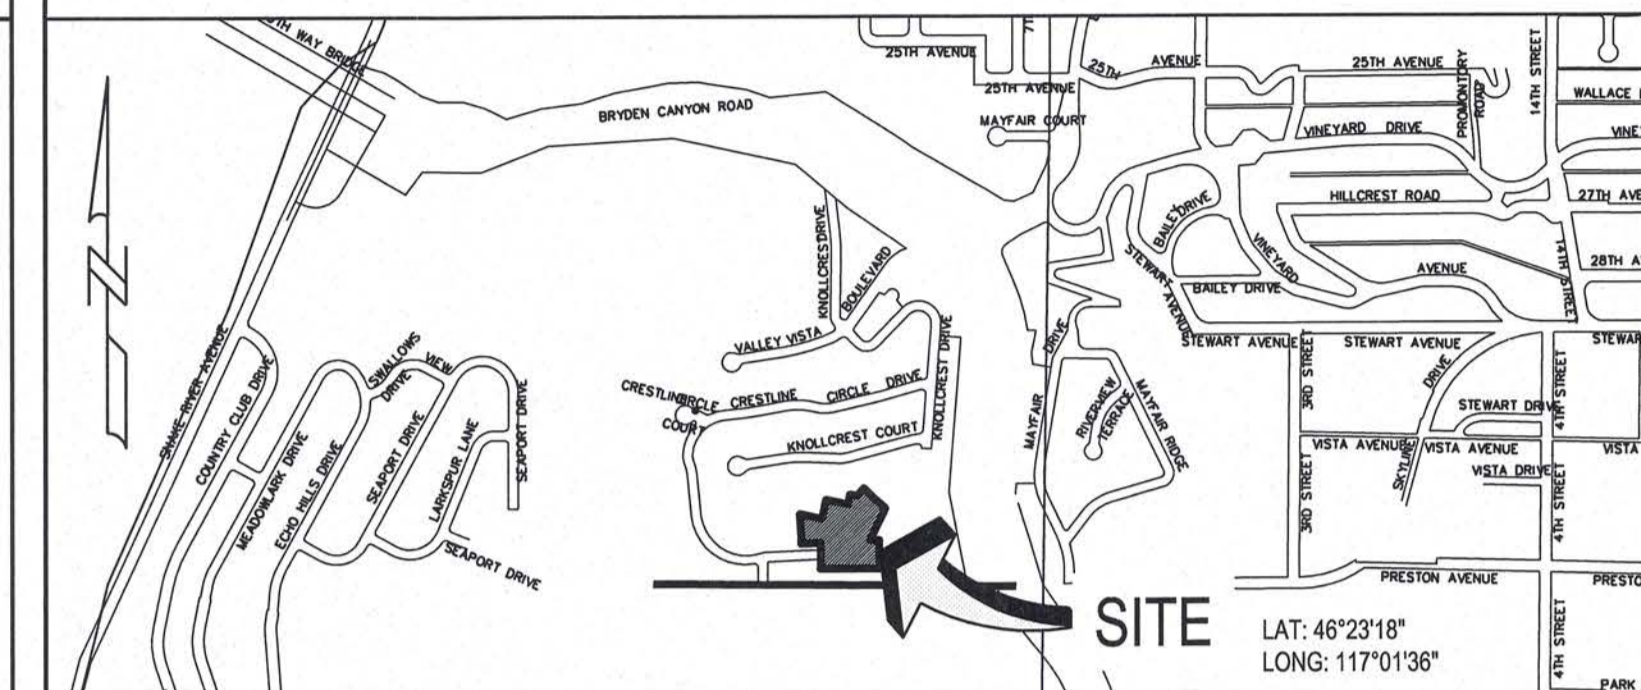

SHEET INDEX

SHEET C1	COVER SHEET
SHEET C2	CONSTRUCTION NOTES #1
SHEET C3	CONSTRUCTION NOTES #2
SHEET C4	TEMPORARY EROSION & SEDIMENT CONTROL
SHEET C5	CRESTLINE CIRCLE DRIVE PLAN & PROFILE
SHEET C6	CRESTLINE CIRCLE DRIVE INTERSECTIONS
SHEET C7	EASTWAY COURT PLAN & PROFILE
SHEET C8	WESTWAY COURT PLAN & PROFILE
SHEET C9	STORMDRAIN PLAN & PROFILE
SHEET C10	OVERALL UTILITIES
SHEET C11	CITY STANDARD DETAILS
SHEET C12	CITY STANDARD DETAILS
SHEET C13	CITY STANDARD DETAILS
SHEET C14	CITY STANDARD DETAILS

RIGHT OF WAY PERMIT QUANTITIES

PAVED AREA IN ROW	± 17,285	S.F.
APPROACH WIDTH @ ROW	± 0	L.F.
TRENCH LENGTH	± 993	L.F.
STREET CUT LENGTH/WIDTH	± 36	L.F.
CURB & GUTTER LENGTH	± 987	L.F.
SIDEWALK LENGTH	± 297	L.F.
MAIN LINE LENGTH	± 993	L.F.

UTILITY PERMIT QUANTITIES


BASE FEE	1	EA
CATCH BASIN	4	EA
MANHOLE	2	EA
DOMESTIC WATER LINE	± 528	L.F.
WASTE WATER LINE	± 88	L.F.
STORM DRAIN LINE	± 377	L.F.

DATE	BY	DESCRIPTION
08/22/18	MSR	CITY COMMENTS 08/16/18

COVER SHEET
CRESTLINE CIRCLE DRIVE
VALLEY VISTA PUD
LEWISTON, ID. 83501

KELTIC ENGINEERING, INC.

315 Adams Lane • Lewiston, Idaho 83501 • (208) 743-2135 • (208) 743-2136 fax
Development • Planning • Design • Construction Management

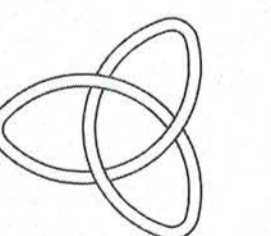

DRAWN BY:	CHECKED BY:
MSR	EFH
DESIGNED BY:	
EFH	
DATE:	07/13/18
LAST REV.:	08/22/18
PROJECT NO.:	17-0089
SHEET NO.:	C1 OF C14

CONSTRUCTION NOTES

SPECIAL INSPECTIONS

NOTE: The City of Lewiston reserves the right for 3rd party verification, inspection, and/or testing prior to infrastructure acceptance. Payment for the services of 3rd party will be the responsibility of the City of Lewiston unless items verified, inspected, and/or tested indicate non-conformance, will be the responsibility of developer/ contractor.

ITEM	MATERIAL	TEST / STANDARD	ACCEPTANCE	TEST FREQUENCY	INSPECTOR/CO.
1. ALL UTILITY TRENCHES & STRUCTURES					
TRENCH SUBGRADE	Native (6" to 8" Lifts Max.)	Moisture Density Relationship of Soils (AASHTO T 180) In-Place Density and Moisture Content (AASHTO 310 Method B)	90% Max. Dry Density	One in-place density test every lift per 100 linear feet. If project is less than 100 linear feet, one in-place density test per day OR per lift [whichever test frequency is more restrictive].	GPI
PIPE BEDDING	3/4" minus Crushed Aggregate (6" to 8" Max. Lift) (Current ITD Spec 703.04) OR 5/8" minus Crushed Aggregate (6" to 8" Max. Lift) (Current WDOTM41-10 Spec 9-03.9)	Moisture Density Relationship of Soils (AASHTO T 180) In-Place Density and Moisture Content (AASHTO 310 Method B)	95% Max. Dry Density	One in-place density test every lift per 100 linear feet. If project is less than 100 linear feet, one in-place density test per day OR per lift [whichever test frequency is more restrictive]. Test top 6" of 12" cover.	GPI
1st FOOT [12"] OF FILL OVER PIPE	3/4" minus Crushed Aggregate (6" to 8" Max. Lift) (Current ITD Spec 703.04) OR 5/8" minus Crushed Aggregate (6" to 8" Max. Lift) (Current WDOTM41-10 Spec 9-03.9)	Moisture Density Relationship of Soils (AASHTO T 180) In-Place Density and Moisture Content (AASHTO 310 Method B)	95% Max. Dry Density	One in-place density test every lift per 100 linear feet. If project is less than 100 linear feet, one in-place density test per day OR per lift [whichever test frequency is more restrictive].	GPI
TRENCH BACKFILL UNDER PROPOSED ROAD & SIDEWALK	3/4" minus Crushed Aggregate (6" to 8" Max. Lift) (Current ITD Spec 703.04) OR 5/8" minus Crushed Aggregate (6" to 8" Max. Lift) (Current WDOTM41-10 Spec 9-03.9)	Moisture Density Relationship of Soils (AASHTO T 180) In-Place Density and Moisture Content (AASHTO 310 Method B)	95% Max. Dry Density	One in-place density test every lift per 100 linear feet. If project is less than 100 linear feet, one in-place density test per day OR per lift [whichever test frequency is more restrictive].	GPI
STRUCTURAL FILLS	As Spec'd by Engineer	As Spec'd by Engineer	As Spec'd by Engineer	As Spec'd by Engineer	GPI
2. STORM DRAIN MAINS					
GASKETED PE Storm Sewer Pipe	Polyethylene, ADS N-12 or Equal		Certified & Visual by City		Certified & Visual by City
ALIGNMENT AND GRADE	N/A	Per Manufacturer's Instructions		Per Plan	KELTIC
JOINTS (Deflection/Proper Pipe Embedment)	N/A	Per Manufacturer's Instructions		Each Joint	KELTIC
PRESSURE TEST	N/A	4 PSI for 15 Minutes, 1/2 PSI Drop	If required by City Engineer	Between Access Holes	KELTIC
MANHOLES	Concrete	City Standard		N/A	Certified & Visual by City
VIDEO INSPECTION	N/A		Public Works Policy No 2012-2		CONTRACTOR
3. WATER MAINS					
DUCTILE IRON or PVC WATER MAIN	AWWA C-151, C-900, C-905 (Class as Req'd)		Certified & Visual by City		Certified & Visual by City
ALIGNMENT AND GRADE	N/A	AWWA C-600, AWWA C-605		Per Plan	KELTIC
JOINTS (Deflection/Proper Pipe Embedment)	N/A	AWWA C-600, AWWA C-605		Each Joint	KELTIC
THRUST BLOCKS	Concrete, 2500 PSI Mix	Per Approved Plans or City Std Dwg # 4-4		Each Joint	Certified & Visual by City
HYDROSTATIC PRESSURE	N/A	2 Hrs, NTE Allowable Leakage Per AWWA C-600, AWWA C-605		150% Working Pressure OR 1 1/2 times the Working Pressure in the Water System	KELTIC
CHLORINATION/BACTERIA	N/A	AWWA C-651		Bacterial Testing: two negative testing samples 24 hours apart	City of Lewiston
4. WASTEWATER MAINS					
PVC WASTEWATER MAIN	PVC, SDR 35	ASTM 3034		N/A	KELTIC
ALIGNMENT AND GRADE	N/A	N/A		Per Plan	KELTIC
JOINTS (Deflection/Proper Pipe Embedment)	N/A	Per Manufacturer's Instructions		Each Joint	KELTIC
MANHOLES	Concrete	Hydrostatic Test		Each Joint	
PRESSURE TEST	N/A	4 PSI for 15 Minutes, 1/2 PSI Drop		Between Access Holes	KELTIC
VIDEO INSPECTION	N/A	No Perforations, Dents or Dimples, No Bellies > 0.02'	Public Works Policy No 2012-2	Between Access Holes	CONTRACTOR
5. CONCRETE CURB, GUTTER & SIDEWALK					
CONCRETE	CLASS 358 - Approved Mix Design Required with Min. Cement Content of 560 LBS/CY, Max. Water/Cement Ratio of .44, a WRA, and an AEA	AASHTO T-22 Compressive Strength of Concrete AASHTO T-23 Making Test Specimens AASHTO T-119 Slump of Hydraulic Cement Concrete AASHTO T-152 Air Content of Freshly Mixed Concrete AASHTO T-309 Temperature of Freshly Mixed Concrete WAGTC TM-2 Sampling Freshly Mixed Concrete	Min. 28 day Compressive Strength = 3000 psi; Water/Cement Ratio shall be 0.5 lbs/lb Max. Slump = 5 inches Air Content Percent = 6.5% ± 1.5 Temperature = 50°F - 60°F	1 of Each Test Minimum per Day, or 1 of Each Test per 50 CY	GPI
CRUSHED AGGREGATE BASE COURSE	3/4" minus Crushed Aggregate (4" Max. LR) (Current ITD Spec 703.04) OR 5/8" minus Crushed Aggregate (4" Max. LR) (Current WDOTM41-10 Spec 9-03.9)	Moisture Density Relationship of Soils (AASHTO T 180) In-Place Density and Moisture Content (AASHTO 310 Method B)	95% Max. Dry Density	1 Tests Per 500 LF-Min 2 Tests	GPI
ALIGNMENT AND GRADE	N/A	Visual	+ 0.02' from Design Grade/Alignment	Per 10' Section	City Approval
JOINTS/FLATNESS/STRAIGHTNESS	N/A	Visual	+ 0.02/10' Segment	Per 10' Section	
FINISH	N/A	Visual	Floated, Uniform, Light Broom Finish	Entire Surface Area	
6. ASPHALTIC CONCRETE PAVING					
SUPERPAVE HOT MIX ASPHALT	ITD 405 Superpave Class SP3 and SP5 (2017 ITD Spec 405 and 703.05) Note: Contractor shall provide a pre-pave meeting to discuss methods and production operations for new roadway construction or projects over 200 tons. The City of Lewiston reserves the right to request a pre-pave meeting for projects with 200 tons or less.	Class SP2: AASHTO T-306, Asphalt Content AASHTO T-27 & T-11, Sieve Analysis WAGTC TM-8, In-Place Density of Bituminous Mixes AASHTO T-209, Theoretical Maximum Density (RICE) Class SP3 and SP5: AASHTO T-308, Asphalt Content AASHTO T-27 & T-11, Sieve Analysis AASHTO T-166 Method A, Air Voids, and Voids in Mineral Aggregates (VMA) WAGTC TM-8, In-Place Density of Bituminous Mixes with Correlated Nuclear Gauge or AASHTO T-166, Density of Bituminous Mixes by Cones AASHTO T-209, Theoretical Maximum Density (RICE) Density Note: When a non-correlated gauge is used to determine in-place density during production, cores will be taken for final density and thickness determination. When a correlated gauge is used for production testing, cores will be taken for thickness determination only. Core quantities and locations to be determined by the City of Lewiston.	ITD Section 405.03 Asphalt Content - C.M.F. Value +/- 0.3% Sieve Analysis - Table 405.03-5 Air Voids - 4.0 +/- 1.0% Voids in Mineral Aggregates, at N design - 7.0 to 9.0% All Projects Regardless of Tonnage Theoretical (When acceptance will be from correlated gauge, contractor must submit documentation showing gauge correlation to proposed bituminous mixture used.)	Project 200 tons or less - Minimum of 1 test (asphalt content, and gradation) per project. A minimum of 2 cores will be taken to determine final thickness and/or density. Projects 200 tons or more - Minimum of 1 test (asphalt content, gradation, voids, and VMA) per 750 tons or, one per day. A minimum of 5 cores will be taken to determine final thickness and/or density. Random sampling locations determined by the City of Lewiston. The City of Lewiston reserves the right for 3rd party verification, inspections, and/or testing prior to infrastructure acceptance.	on
CRUSHED AGGREGATE BASE COURSE	Same test requirement as under 5. Concrete Curb, Gutter & Sidewalk				on
7. EROSION & SEDIMENT CONTROLS					
	Per Approved Plan	Per Plan and Manufacturers' Instructions		1/Wk or After Every Rainfall	contractor
8. TRAFFIC CONTROL					
	Per Approved Plan	Current Adopted MUTCD/ATSSA		Continuous	
9. PRIVATE STORMWATER SYSTEM					
	Per Approved Plan	City Resolution #60-100	Certified & Visual by City		Certified & Visual by City - Underground structures require field approval by City prior to install.
10. RECORD DRAWINGS					
	AutoCAD Elect File, Bond Paper, 22" x 34" Min Size	City Checklist		Before Public Improvements Accepted	
Data Last Revised December 2017					

NOTES: 1) SPECIAL INSPECTIONS TO BE COORDINATED BY CONTRACTOR AND PERFORMED BY THE COMPANIES LISTED ABOVE. 24 HOURS OR MORE NOTICE TO THESE COMPANIES IS REQUIRED PRIOR TO INSPECTION. 2) THE SPECIAL INSPECTIONS DEPICTED HERE ARE INFORMATIONAL. ADDITIONAL SPECIAL OR OTHER INSPECTIONS MAY BE REQUIRED, AND THE FOREGOING LIST IS NOT EXCLUSIVE.

APPLICABLE STANDARD DETAILS

CITY OF LEWISTON STANDARD DRAWINGS


- 1-1 UTILITY LOCATIONS
- 1-2 UTILITY PEDESTAL & TRENCH DETAIL
- 1-3 STREET MONUMENT W/ FRAME & COVER
- 1-6 BACKFILL CLASS D
- 1-8 IDENTIFYING TAPE DETAIL
- 2-5 DETECTABLE WARNING FOR PEDESTRIAN ACCESS
- 2-6 GENERAL NOTES FOR ALL TYPES OF CURB & GUTTER
- 2-7 HIGH BACK CURB AND ROLLED CURB & GUTTER
- 2-8 CONCRETE SIDEWALK
- 2-11 SIDEWALK RAMP TYPE 1
- D-1 LOCAL RESIDENTIAL STREET
- 4-1 POTABLE & NON-POTABLE WATERLINE SEPARATION
- 4-2 GATE VALVE BOX W/ ASSEMBLY
- 4-3 COMBINATION BLOW OFF & SAMPLING TAP
- 4-4 THRUST BLOCKING DETAIL
- 4-5 TYPICAL WATER METER OR UTILITY MARKER LOCATION
- 4-7 STANDARD 1" WATER SERVICE CONNECTION
- 4-12 FIRE HYDRANT W/ SHUT-OFF VALVE
- 5-1 WASTEWATER PRIVATE SERVICE CONNECTION
- 5-2 SERVICE TAP OPTIONS
- 5-3 WASTEWATER TYPE 1 MANHOLE
- 5-6 CONCRETE MANHOLE COLLAR
- 5-7 MANHOLE FRAME & COVER
- 5-8 MANHOLE CHANNEL DETAILS
- 6-1 SYSTEM GENERAL NOTES
- 6-2 STORMWATER TYPE 1 MANHOLE
- 6-4 MANHOLE CONCRETE COLLAR
- 6-5 MANHOLE FRAME AND COVER
- 6-6 GENERAL CATCH BASIN NOTES
- 6-8 STORMWATER TYPE 1 CATCH BASIN

CONTRACTOR TO OBTAIN A CURRENT CITY OF LEWISTON STANDARDS BOOKLET FROM THE PUBLIC WORKS DEPARTMENT.

NO.	DATE	BY	DESCRIPTION
1	08/22/18	MSR	CITY COMMENTS 08/16/18

CONSTRUCTION NOTES # 1
CRESTLINE CIRCLE DRIVE
VALLEY VISTA PUD
LEWISTON, ID 83501

KELTIC ENGINEERING, INC.
315 Adams Lane • Lewiston, Idaho 83501 • (208) 743-2135 • (208) 743-2136 fax
Development • Planning • Design • Construction Management

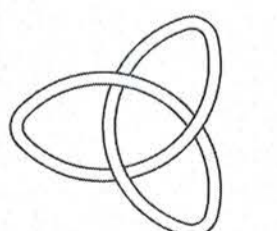

PROFESSIONAL ENGINEER
REGISTERED
6064
11/01/18
STATE OF IDAHO
ERIC HASENOERL

DRAWN BY: MSR | CHECKED BY: EFH
DESIGNED BY: EFH
DATE: 07/13/18
LAST REV: 08/22/18
PROJECT NO: 17-0089
SHEET NO: C2 OF C14

CONSTRUCTION NOTES

ACCESSIBILITY NOTES

- ACCESSIBILITY SHALL BE PROVIDED PER UNITED STATES ACCESS BOARD *PROPOSED ACCESSIBILITY GUIDELINES FOR PEDESTRIAN FACILITIES IN THE PUBLIC RIGHT-OF-WAY JULY 26, 2011.
- IF THE 5% MAXIMUM COUNTER SLOPE AT THE BOTTOM OF THE RAMP (AT STREET TRANSITION) CANNOT BE ACHIEVED DUE TO EXISTING CONDITIONS, THE RAMP SLOPE SHALL BE ADJUSTED SO THE SUM OF BOTH SLOPES DOES NOT EXCEED 13.3%.
 - WATER PONDING WITHIN THE CURB RAMP LIMITS IS NOT ALLOWED.
 - NO GRADE BREAK IS ALLOWED ALONG THE RAMP SURFACE.
 - THE DETECTABLE/TACTILE WARNING TILE SHALL BE SLIP RESISTANT AND CONSIST OF AN INLINE PATTERN OF RAISED TRUNCATED DOMES.
 - COLOR: THE DETECTABLE/TACTILE WARNING TILE SHALL BE YELLOW CONFORMING TO FEDERAL STANDARDS 595B TABLE IV, COLOR NO. 33558.
 - ANY DEVIATIONS FROM THESE PROVISIONS REQUIRES PRIOR APPROVAL BY THE ENGINEER.

FIRE DEPARTMENT NOTES

- ALL HYDRANTS SHALL BE THRUST BLOCKED OR RETAINED AND ALL FITTINGS SHALL BE THRUST BLOCKED. THRUST BLOCKS SHALL CONFORM TO THE CITY OF LEWISTON STANDARD DWG 4-4.
- FIRE HYDRANTS SHALL CONFORM TO AWWA C502 AND SHALL BE WATEROUS PACER OR MULLER CENTURIAN. HYDRANTS SHALL BE SO CONSTRUCTED THAT THE DIRECTION OF PUMPER CONNECTION MAY BE ROTATED TO FACE THE ROADWAY. A SIX (6) INCH MECHANICAL JOINT CONNECTION WITH LUGS AND SHACKLE RODS IS TO BE USED. A GATE VALVE SHALL BE INSTALLED AT EACH HYDRANT AS SHOWN ON CITY OF LEWISTON STANDARD DWG 4-12.
- ALL HYDRANTS USED FOR THIS PROJECT SHALL BE PROVIDED WITH A 5 INCH INTEGRAL HYDRANT STORZ NOZZLE. ALL NOZZLES SHALL BE PROVIDED WITH THE STORZ BLIND CAP WITH SUCTION SEAL AND AIRCRAFT CABLE.
- HYDRANTS SHALL BE SPACED AT A MAXIMUM OF 500' IN RESIDENTIAL AREAS. ALL HYDRANTS SHALL HAVE VALVES ON THE HYDRANT BRANCH LINE. HYDRANTS SHALL HAVE TWO, 2 1/2" PORTS AND ONE, 4 1/2" STEAMER PORT.
- ALL NEW FIRE HYDRANTS SHALL MEET THE FOLLOWING REQUIREMENTS:
 - NEW HYDRANT WILL BE WATEROUS PACER WITH 5" INTEGRAL HARRINGTON STORZ NOZZLE
 - 6" MINIMUM SUPPLY FOR FIRE HYDRANT
 - IF COMBUSTIBLE BUILDING MATERIALS ARE USED (INCLUDING FRAMING) THE WATER SUPPLY (INCLUDING MAINS AND HYDRANTS) SHALL BE DESIGNED, INSTALLED, TESTED AND APPROVED BY THE FIRE DEPARTMENT PRIOR TO STOCKPILING COMBUSTIBLE BUILDING MATERIALS.
 - WATER SUPPLY SYSTEMS FOR PHASED CONSTRUCTION SHALL PROVIDE REQUIRED FIRE FLOWS AT ALL PHASES
 - ALL EXISTING FIRE HYDRANTS WITHIN THE PROJECT SHALL BE PROVIDED WITH A 5" HARRINGTON HHS STORZ ADAPTERS WITH THE APPROVED ATTACHED SEAL CAP AND AIRCRAFT CABLE
 - ALL NEW AND EXISTING HYDRANTS SHALL BE INSTALLED AND/OR MODIFIED SO THE 5" PORT IS FACING TOWARD THE FIRE DEPARTMENT VEHICULAR ACCESS ROUTE
- FENCES, PLANTS, TREES AND/OR SHRUBS SHALL NOT BE PLACED OR KEPT NEAR FIRE HYDRANTS. FIRE DEPARTMENT INLET CONNECTIONS OR FIRE PROTECTION SYSTEM CONTROL VALVES IN A MANNER THAT WOULD PREVENT SUCH EQUIPMENT FROM BEING IMMEDIATELY DISCERNIBLE BY THE FIRE DEPARTMENT. IFC 508.5.4.
- ALL SITE INSPECTIONS REQUIRE A MINIMUM 24 HOURS NOTICE. ALL FIRE DEPARTMENT INSPECTIONS ARE TO BE REQUESTED THROUGH THE FIRE DEPARTMENT 208-743-3554. PLEASE BE SPECIFIC AS TO TYPE OF INSPECTION REQUESTED.

GENERAL NOTES

- THE CONTRACTOR SHALL PAY FOR ALL NECESSARY PERMITS AND FEES.
- THE CONTRACTOR SHALL INVESTIGATE ON SITE AND VERIFY ALL CONDITIONS AND DIMENSIONS OF THE PROJECT AND SHALL NOTIFY THE ENGINEER OF ANY DISCREPANCY IN THE CONTRACT DOCUMENTS REQUIRING MODIFICATION PRIOR TO PROCEEDING.
- THE CONTRACTOR SHALL TAKE ALL NECESSARY PREVENTATIVE MEASURES TO PROTECT THE EXISTING IMPROVEMENTS. ANY DAMAGE SHALL BE REPLACED AT NO COST TO THE OWNER.
- THE CONTRACTOR SHALL COORDINATE THE WORK SCHEDULE SO AS TO HAVE A MINIMUM IMPACT ON THE EXISTING TRAFFIC. CONTRACTOR SHALL PROVIDE TRAFFIC CONTROL PER IDAHO TRANSPORTATION DEPARTMENT STANDARD SPECIFICATIONS, AND ANY APPLICABLE CITY STANDARDS OR REQUIREMENTS.
- ALL SURVEY MARKERS RELATED IN ANY WAY TO THE PROJECT, AND ALL OWNERS PROPERTY CORNERS SHALL BE PROTECTED AT ALL TIMES, AND THE CONTRACTOR SHALL RETAIN THE SERVICES OF A PROFESSIONAL LAND SURVEYOR REGISTERED IN THE STATE OF IDAHO TO REFERENCE ALL CORNERS, UPON COMPLETION OF THE PROJECT, ALL EXISTING CORNERS DAMAGED BY CONSTRUCTION OR OTHER ACTIVITY SHALL BE REPLACED BY A PROFESSIONAL LAND SURVEYOR.
- ALL WORK SHALL CONFORM TO STATE AND LOCAL CODES AND CONFORM TO THE CITY OF LEWISTON STANDARD DRAWINGS AND THE IDAHO STANDARDS FOR PUBLIC WORKS CONSTRUCTION (ISPCWC), CURRENT EDITION. SPECIAL INSPECTIONS BY OWNER, NOT CONTRACTOR.
- SITE DISTANCES FOR ABUTTING PROPERTIES, DRIVEWAYS, AND INTERSECTIONS MUST BE MAINTAINED.
- IMPROVEMENTS CONSTRUCTED ON RIGHT-OF-WAY REQUIRE A STREET CUT PERMIT OBTAINED AT THE CONSTRUCTION MANAGEMENT SECTION OF THE PUBLIC WORKS DEPARTMENT.
- ALL CONSTRUCTION NOT SPECIFICALLY MENTIONED OR SHOWN SHALL CONFORM TO CITY ORDINANCES AND STANDARDS.
- SANITARY DISPOSAL TO BE PER CITY OF LEWISTON STANDARDS.
- SPECIAL INSPECTION IS REQUIRED FOR SOIL COMPACTION, BASE MATERIAL, CONCRETE, CURB & GUTTER, SIDEWALK, ASPHALTIC CONCRETE PAVING, WASTEWATER MAINS, WATER MAINS, AND STORM DRAIN MAINS IN RIGHT-OF-WAY, AND AS OTHERWISE REQUIRED BY THE CITY OF LEWISTON.
- UPON COMPLETION, CONTRACTOR SHALL PROVIDE AS-BUILT DRAWINGS, COMPLETE WITH ELEVATIONS, TO THE ENGINEER OF RECORD TO BE APPROVED.
- STREET NAME SIGNS ARE TO BE PAID FOR BY THE DEVELOPER AND INSTALLED BY THE CONTRACTOR.
- CITY TO PARTICIPATE ON PRE-CONSTRUCTION AND OTHER VARIOUS CONSTRUCTION MEETINGS AS NEEDED.
- WHEREVER THE PLANS OR OTHER CONTRACT DOCUMENTS CALL FOR CITY APPROVAL, THE SAME SHALL BE DEEMED TO ALSO REQUIRE ENGINEERS APPROVAL; CONTRACTOR SHALL CONFIRM CITY'S APPROVAL WITH ENGINEER PRIOR TO PROCEEDING.
- CONFLICTS IN PLANS OR SPECIFICATIONS, OR REFERENCE STANDARDS SHALL BE RESOLVED BY THE ENGINEER, WHO SHALL HAVE THE RIGHT TO IMPOSE THE MORE DIFFICULT AND EXPENSIVE INTERPRETATION.

GRADING NOTES

- ALL TOPSOIL SHALL BE STRIPPED AND STOCKPILED BEFORE EXCAVATION.
- ALL EXPOSED CUT/FILL SLOPES SHALL BE SEED TO PREVENT EROSION.
- ALL ASPHALTIC CEMENT PAVING REMOVAL SHALL BE SAW CUT AND WHEN REPLACED, TACKED TO EXISTING PAVEMENT.
- ALL CURB AND GUTTER SHALL BE HIGH BACK CURB AND GUTTER AS DEPICTED ON THE PLANS AND SHALL CONFORM TO CITY OF LEWISTON STANDARD DRAWINGS 2-8 AND 2-7.
- SIDEWALKS SHALL CONFORM TO CITY OF LEWISTON STANDARD DRAWINGS 2-8, WITH CROSS SLOPE = 1.5% MAX.
- EROSION AND DUST CONTROL MEASURES MUST BE USED DURING CONSTRUCTION TO REDUCE OR ELIMINATE BLOWING DUST, EXCESSIVE RUNOFF, AND SOIL EROSION ACROSS PROPERTY LINES AND INTO STREETS AND RIGHT-OF-WAY, AND TO ELIMINATE TRACKING SOIL AND MUD ONTO STREETS FROM CONSTRUCTION EQUIPMENT AND VEHICLES.
- UNLESS OTHERWISE NOTED, STREET CROSS SECTIONS SHALL CONFORM TO CITY OF LEWISTON STANDARD DRAWING D-1.
- ALL ROADWAY FILL SHALL BE AS A MINIMUM, CLEAN, UNIFORMLY GRADED, COMPACTED TO 95% OF THE MAX. DRY DENSITY DETERMINED BY MODIFIED PROCTOR, ASTM 1557. COMPACTION LAYERS SHALL BE 8" DEEP.
- ALL CUT-SLOPES SHALL BE CAREFULLY GRADED, DRESSED AND SCALED TO THE SATISFACTION OF THE ENGINEER AND THE CITY, SO AS TO MITIGATE FUTURE RAVELING.

ASPHALT PAVEMENT/AGGREGATE NOTES

- ALL ASPHALT PAVEMENT AND AGGREGATE SHALL CONFORM TO THE IDAHO TRANSPORTATION DEPARTMENT'S STANDARD SPECIFICATIONS FOR HIGHWAY CONSTRUCTION (SSFH), CURRENT EDITION.
- ASPHALTIC CONCRETE SHALL BE SUPERPAVE HMA, SP2, PG 64-28, CONFORMING TO SECTION 405 AND 703.05 OF ITS SSFH, CURRENT EDITION.
- CONTRACTOR TO SUBMIT A JOB MIX FORMULA (JMF) TO KELTIC ENGINEERING, INC FOR REVIEW AND APPROVAL A MINIMUM OF 7 WORKING DAYS PRIOR TO PAVING OPERATIONS. THE MINIMUM 7 WORKING DAYS MUST NOT INCLUDE WEEKENDS OR HOLIDAYS. IF REVIEW AND APPROVAL IS REQUIRED BY THE CITY, A LONGER TIME MAY BE REQUIRED.
- ASPHALT ACCEPTANCE TEST STRIP NOT REQUIRED. ACCEPTANCE FOR PAVEMENT DENSITY WILL BE BASED ON THE DENSITY OF CORES TAKEN FROM THE FINISHED PAVEMENT.
- 3/4" CRUSHED AGGREGATE BASE CONFORMING TO ITS SSFH SECTION 703.04 AGGREGATE FOR UNTREATED BASE, TREATED BASE AND ROAD MIX - TABLE 703.04-1, 1/2" IN B OR IDAHO STANDARDS FOR PUBLIC WORKS CONSTRUCTION (ISPCWC), 2015, SECTION 802 - CRUSHED AGGREGATES, TABLE 1, 1/2" IN, (TYPE 1).
- PAVING OPERATIONS SHALL NOT BEGIN UNTIL THE CITY OF LEWISTON HAS APPROVED VIDEO INSPECTION AND REPORTING OF ALL STORMWATER AND WASTEWATER MAINS.

WATER NOTES

- ALL WATER SYSTEMS ARE TO BE CONSTRUCTED IN ACCORDANCE WITH IDAPA AND ALL STATE CODES FOR PUBLIC DRINKING WATER SYSTEMS MUST BE FOLLOWED COUPLED WITH THE CITY OF LEWISTON STANDARDS.
- AN APPROVED BACKFLOW PREVENTION ASSEMBLY IS REQUIRED ON THE SUPPLY WATER LINE WHEN FILLING THE NEW WATER MAIN DURING DISINFECTION AND FLUSHING. THE BACKFLOW PREVENTION ASSEMBLY AND SUPPLY PIPING MUST BE REMOVED DURING HYDROSTATIC PRESSURE TESTING.
- GATE VALVES SHALL CONFORM TO AWWA C 515-99 RESILIENT SEATED GATE VALVES FOR WATER AND SEWAGE SYSTEMS AND SHALL BE IRON BODY BRONZE MOUNTED, DOUBLE DISC WITH BRONZE WEDGING AND O-RING STUFFING BOX.
- THE CONTRACTOR SHALL PROVIDE 4 FT MIN. COVER ON ALL WATER LINES AND PROVIDE 18" MINIMUM VERTICAL CLEARANCE BETWEEN POTABLE WATER LINE AND NON-POTABLE WATER LINE CROSSINGS. FOR ALL CROSSINGS LESS THAN 18" OF VERTICAL CLEARANCE, NON-POTABLE AND POTABLE LINES MUST BE A HORIZONTAL DISTANCE OF TEN FEET APART ON BOTH SIDES OF THE CROSSING, WITH NO JOINTS, AS SHOWN ON CITY OF LEWISTON STANDARD DETAIL 4-1.
- THE CONTRACTOR IS RESPONSIBLE FOR FLUSHING AND PRESSURE TESTING THE NEW WATER MAIN. THESE TESTS MUST BE COMPLETED AND APPROVED BEFORE DISINFECTION PROCEDURES MAY BEGIN.
- PROPOSED WATER LINES SHALL BE HYDROSTATICALLY TESTED AS PER AWWA C800-93. TESTS SHALL BE 1 1/2 TIMES THE HIGHEST WORKING PRESSURE, WITH A MINIMUM OF 150 PSI. PRESSURE SHALL BE HELD FOR 2 HOURS WITH NO DROP IN PRESSURE. ENGINEER OF RECORD SHALL WITNESS TEST. THE CITY OF LEWISTON WATER DIVISION, TO MAINTAIN THE INTEGRITY OF THE SYSTEM, SHALL OBSERVE THE FINAL TIE-IN.
- THE CONTRACTOR SHALL PROVIDE LOCATE WIRE AND BURY TAPE IN PVC WATER MAIN TRENCH PER CITY OF LEWISTON STANDARD DWG 1-8. IF COMBUSTIBLE BUILDING MATERIALS ARE USED (INCLUDING FRAMING) THE WATER SUPPLY (INCLUDING MAINS AND HYDRANTS) SHALL BE DESIGNED, INSTALLED, TESTED AND APPROVED BY THE FIRE DEPARTMENT PRIOR TO STOCKPILING COMBUSTIBLE BUILDING MATERIALS.
- WATER LINE CONNECTIONS TO MAINS AND LATERALS SHALL BE LEFT UNCOVERED UNTIL AFTER THE CITY ENGINEER AND THE ENGINEER ON RECORD HAVE INSPECTED AND APPROVED THE WORK. AFTER APPROVAL OF CONNECTION, THE TRENCH SHALL BE BACKFILLED AS SPECIFIED.
- WATER MAINS SHALL BE INSTALLED BY CONTRACTORS WITH EXPERIENCE INSTALLING PUBLIC WATER MAINS AND APPROVED BY THE CITY OF LEWISTON.
- ALL PIPING AND FITTING MATERIAL SHALL BE NEW UNLESS OTHERWISE APPROVED BY THE CITY OF LEWISTON WATER DIVISION AND THE IDAHO DEPARTMENT OF ENVIRONMENTAL QUALITY.
- WATER MAINS SHALL BE LAID ONLY IN DEDICATED STREETS ACCEPTED BY THE CITY OF LEWISTON.
- WATER MAIN SHALL BE PVC C-900 PIPE CONFORMING TO AWWA C900-16.
- WATER LINE FITTINGS SHALL BE CAST IRON OR DUCTILE IRON CONFORMING TO AWWA STANDARD C153.
- DISINFECTION OF WATER PIPES SHALL BE IN ACCORDANCE WITH AWWA C-651-92. ISOLATE NEW PIPE FROM EXISTING SYSTEM TO PREVENT POTENTIAL CROSS-CONNECTION. THE CITY OF LEWISTON WATER DIVISION SHALL PERFORM THE CHLORINATION AND BACTERIAL TESTING. ENGINEER OF RECORD SHALL WITNESS TEST.
- THE NUMBER OF WATER SAMPLES TAKEN WILL DEPEND UPON THE LENGTH AND NUMBER OF BRANCHES OF THE NEW MAIN BUT A MINIMUM OF TWO SAMPLES MUST BE TAKEN. THESE SAMPLES SHALL BE TAKEN FROM EACH END OF THE NEW WATER MAIN. TWO CONSECUTIVE SAMPLES AT LEAST TWENTY-FOUR HOURS APART MUST BE REPORTED AND DISPLAY NEGATIVE BACTERIOLOGICAL RESULTS. RESULTS FROM BACTERIOLOGICAL TESTING WILL BE AVAILABLE APPROXIMATELY 26 HOURS AFTER THE LAST SAMPLE IS TAKEN. THE CONTRACTOR SHALL PAY FOR ALL FEES ASSOCIATED WITH THE CHLORINATION AND BACTERIAL TESTING.

STORM DRAINAGE NOTES

- STORM DRAIN MAINS SHALL BE INSTALLED BY CONTRACTORS WITH EXPERIENCE INSTALLING PUBLIC STORM DRAIN MAINS AND APPROVED BY THE CITY OF LEWISTON.
- ALL EXISTING LIVE STORM DRAINS SHALL BE KEPT IN SERVICE AT ALL TIMES. PROVISIONS SHALL BE MADE FOR DISPOSAL OF STORM FLOW IF ANY EXISTING STORM DRAINS ARE DAMAGED. DAMAGE TO EXISTING STORM DRAINS SHALL BE REPAIRED BY THE CONTRACTOR, AT NO EXPENSE TO THE CITY, TO A CONDITION EQUAL TO OR BETTER THAN CONDITIONS PRIOR TO THE DAMAGE.
- STORM DRAIN MAIN SHALL BE LAID ONLY IN DEDICATED STREETS OR IN EASEMENTS WHICH HAVE BEEN GRANTED AND ACCEPTED BY THE CITY OF LEWISTON.
- STORM DRAIN PIPES SHALL BE ADS N-12 WT COLLECTION PIPE NOMINAL SIZES 4-36 INCH DIAMETER AND SHALL MEET OR EXCEED ALL THE REQUIREMENTS OF AASHTO M 252 OR AASHTO M 294, CURRENT EDITION.
- THE NOMINAL SIZE FOR THE PIPE AND FITTINGS IS BASED ON THE NOMINAL INSIDE DIAMETER OF THE PIPE. CORRUGATED FITTINGS MAY BE EITHER MOLDED OR FABRICATED BY THE MANUFACTURER. FITTINGS SUPPLIED BY MANUFACTURERS OTHER THAN THE SUPPLIER OF THE PIPE SHALL NOT BE PERMITTED WITHOUT THE APPROVAL OF THE PROJECT ENGINEER.
- STORM DRAIN LINE CONNECTIONS TO TRUNKS, MAINS, LATERALS, OR SIDE STORM DRAINS SHALL BE LEFT UNCOVERED UNTIL AFTER THE CITY ENGINEER HAS INSPECTED AND APPROVED THE WORK. AFTER APPROVAL OF CONNECTION, THE TRENCH SHALL BE BACKFILLED AS SPECIFIED.
- FINAL ADJUSTMENT AND GROUTING OF THE STORM DRAIN MANHOLE RINGS SHALL BE DONE BY THE PAVING CONTRACTOR.
- INSTALLATION SHALL BE IN ACCORDANCE WITH ASTM RECOMMENDED PRACTICE D 2321, OR AS SHOWN ON THE PROJECT PLANS.
- ALL STORM DRAIN LINES SHALL BE INSPECTED BY THE USE OF A TELEVISION CAMERA BEFORE FINAL ACCEPTANCE.


WASTEWATER NOTES

- SEWER MAINS SHALL BE INSTALLED BY CONTRACTORS WITH EXPERIENCE INSTALLING PUBLIC SEWER MAINS AND APPROVED BY THE CITY OF LEWISTON.
- ALL EXISTING LIVE SEWERS SHALL BE KEPT IN SERVICE AT ALL TIMES. PROVISIONS SHALL BE MADE FOR DISPOSAL OF SEWAGE FLOW IF ANY EXISTING SEWERS ARE DAMAGED. DAMAGE TO EXISTING SEWERS SHALL BE REPAIRED BY THE CONTRACTOR, AT NO EXPENSE TO THE CITY, OR TO THE OWNER, TO A CONDITION EQUAL TO OR BETTER THAN CONDITIONS PRIOR TO THE DAMAGE.
- SEWER MAIN SHALL BE LAID ONLY IN DEDICATED STREETS ACCEPTED BY THE CITY OF LEWISTON.
- GRAVITY SEWER PIPES SHALL BE P.V.C. POLYVINYL CHLORIDE PIPE AND SHALL CONFORM TO THE REQUIREMENTS OF ASTM D 3034 SDR 35 OR ASTM F 789. JOINTS FOR P.V.C. PIPE SHALL CONFORM TO ASTM D 3212 USING RESTRAINED GASKETS CONFORMING TO ASTM F477. FITTINGS FOR P.V.C. PIPE SHALL BE INJECTION MOLDED TEES OR FACTORY SOLVENT CEMENTED SADDLE TEES.
- PRESSURE SEWER PIPE SHALL BE HDPE DR 11 (MINIMUM) CONFORMING TO THE REQUIREMENTS OF ASTM D3035 OR ASTM F714. JOINTS SHALL BE FULLY WELDED.
- SEWER LINE CONNECTIONS TO TRUNKS, MAINS, LATERALS, OR SIDE SEWERS SHALL BE LEFT UNCOVERED UNTIL AFTER THE CITY ENGINEER HAS INSPECTED AND APPROVED THE WORK. AFTER APPROVAL OF CONNECTION, THE TRENCH SHALL BE BACKFILLED AS SPECIFIED.
- ALL WORK INVOLVED IN CLEANING AND TESTING SEWER LINES BETWEEN MANHOLES OR RODDING INLETS AS REQUIRED HEREIN SHALL BE COMPLETED WITHIN FIFTEEN DAYS AFTER BACKFILLING OF SEWER LINES AND STRUCTURES. ANY FURTHER DELAY WILL REQUIRE THE WRITTEN CONSENT OF THE ENGINEER OF RECORD.
- ALL SANITARY SEWER LINES SHALL BE INSPECTED BY THE USE OF A TELEVISION CAMERA BEFORE FINAL ACCEPTANCE.
- SEWER LINES SHALL BE AIR TESTED WITH A PRESSURE 4 PSI GREATER THAN AVERAGE GROUND WATER PRESSURE THAT MAY SUBMERGE THE PIPE. ALLOW A TWO MINUTE STABILIZATION TIME. AIR LOSS SHALL NOT EXCEED A TOTAL RATE OF 2 CFM OR 0.0030 CFM PER SQUARE FOOT OF INTERNAL PIPE SURFACE, WHICHEVER IS GREATER. ENGINEER OF RECORD SHALL WITNESS THE TEST.
- SANITARY SEWER STUBS SHALL HAVE THEIR TERMINATIONS PERMANENTLY MARKED WITH A 5" STEEL FENCE POST, FOR EASE OF FUTURE LOCATION.
- SEWER MANHOLES SHALL BE CONSTRUCTED IN CONFORMANCE WITH CITY OF LEWISTON STANDARD DWG 5-3. USE NON-SHRINK GROUT OR GASKETED MANHOLE COUPLERS FOR MANHOLE-PIPE CONNECTIONS.
- TIE-INS TO EXISTING MANHOLES SHALL INCLUDE THE CONSTRUCTION OF NEAT, NEW, WATERTIGHT INVERTS, AS APPROVED BY THE CITY ENGINEER.
- FINAL ADJUSTMENT AND GROUTING OF THE SANITARY SEWER AND STORM DRAIN MANHOLE RINGS SHALL BE DONE BY THE PAVING CONTRACTOR WHEN MANHOLE IS LOCATED IN A PAVED AREA. THE CONTRACTOR INSTALLING THE MAIN SHALL PROVIDE FINAL ADJUSTMENT AND GROUTING OF MANHOLE RINGS UNLESS IN PAVING.

NO.	DATE	BY	DESCRIPTION
1	08/22/18	MSR	CITY COMMENTS 08/16/18


CONSTRUCTION NOTES #2
CRESTLINE CIRCLE DRIVE
VALLEY VISTA PUD
LEWISTON, ID 83501

KELTIC ENGINEERING, INC.
315 Adams Lane • Lewiston, Idaho 83501 • (208) 743-2135 • (208) 743-2136 fax
• Development • Planning • Design • Construction Management

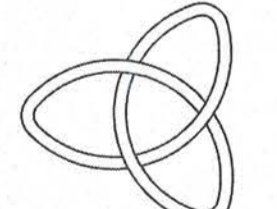

PROFESSIONAL ENGINEER
6064
1/16/19
STATE OF IDAHO
KELTIC HASENDEHL

DRAWN BY: MSR	CHECKED BY: EFH
DESIGNED BY: EFH	
DATE: 07/13/18	
LAST REV: 08/22/18	
PROJECT NO: 17-0089	
SHEET NO: C3	OF C14

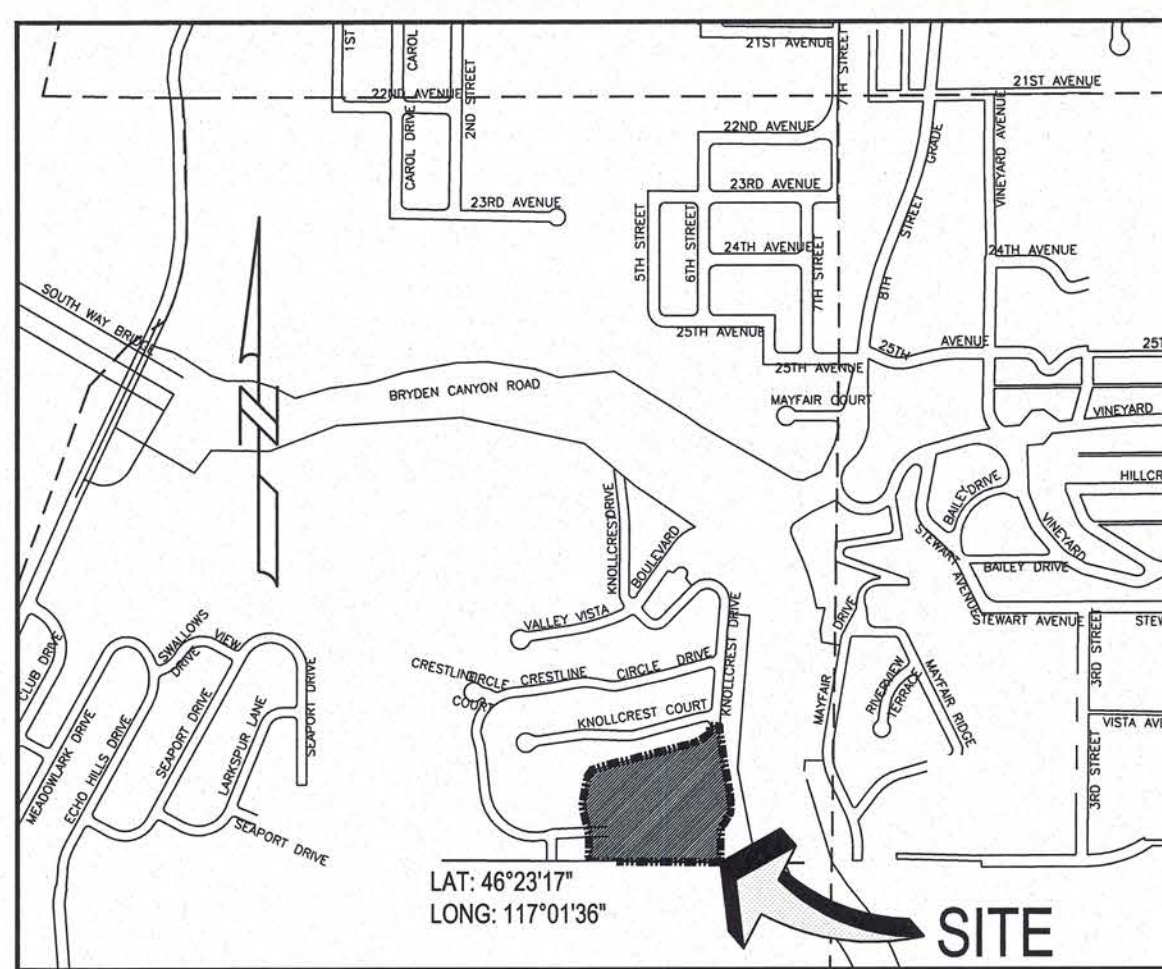


SITE LOCATION MAP

Not to Scale

AREA SUMMARY (IN ACRES)	
SITE AREA	9.6 AC ±
DISTURBED AREA	3.3 AC ±
IMPERVIOUS AREA	0 AC ±
PERVIOUS AREA	9.6 AC ±
TOTAL IMPERVIOUS AREA AT COMPLETION	0.4 AC ±
PERVIOUS / SEEDED AREA AT COMPLETION	2.9 AC ±

STORMWATER OUTFLOW	
RUNOFF THROUGH EXISTING DRAINAGEWAYS TO THE SNAKE RIVER	
SNAKE RIVER - 1.00 MILE WEST	

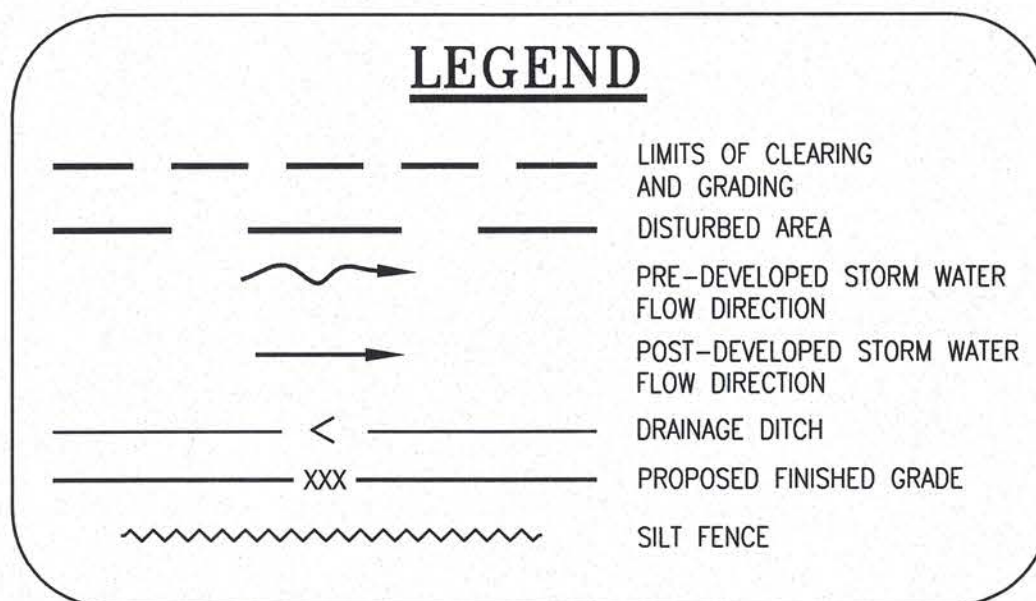

EROSION AND SEDIMENT CONTROL BEST MANAGEMENT PRACTICES

- From Stormwater Catalog of Stormwater BMPs for Idaho Cities and Counties*
- BMP 1 TIMING OF CONSTRUCTION
 - BMP 2 STAGING AREAS
 - BMP 3 PRESERVATION OF EXISTING VEGETATION
 - BMP 4 CLEARING LIMITS
 - BMP 5 STABILIZATION OF CONSTRUCTION ENTRANCE/EXIT
 - BMP 6 EROSION PREVENTION ON TEMPORARY ROADS
 - BMP 7 DUST CONTROL
 - BMP 8 COVER FOR MATERIALS AND EQUIPMENT
 - BMP 9 STOCKPILE MANAGEMENT
 - BMP 10 SPILL PREVENTION AND CONTROL
 - BMP 11 VEHICLE/EQUIPMENT WASHING AND MAINTENANCE
 - BMP 12 WASTE MANAGEMENT
 - BMP 13 CONCRETE WASTE MANAGEMENT
 - BMP 14 SANITARY / SEPTIC WASTE MANAGEMENT
 - BMP 15 MULCHING
 - BMP 16 HYDROMULCHING
 - BMP 18 MATTING
 - BMP 20 TOPSOILING
 - BMP 21 SEEDING
 - BMP 22 SODDING
 - BMP 30 RIPRAP SLOPE AND OUTLET PROTECTION
 - BMP 31 INLET PROTECTION
 - BMP 32 CHECK DAMS
 - BMP 36 SILT FENCE
 - BMP 37 VEGETATIVE BUFFER STRIP
 - BMP 38 SEDIMENTATION TRAP
 - BMP 40 TEMPORARY SWALE

BMP MAINTENANCE NOTES

ALL MEASURES STATED ON THIS EROSION AND SEDIMENT CONTROL PLAN AND IN THE STORM WATER POLLUTION PREVENTION EXPLANATION, SHALL BE MAINTAINED IN FULLY FUNCTIONAL CONDITION UNTIL NO LONGER REQUIRED FOR A COMPLETED PHASE OF WORK OR FINAL STABILIZATION OF THE SITE. ALL EROSION AND SEDIMENTATION CONTROL MEASURES SHALL BE CHECKED BY A QUALIFIED PERSON IN ACCORDANCE WITH THE CONTRACT DOCUMENTS OR THE APPLICABLE PERMIT, WHICHEVER IS MORE STRINGENT, AND REPAIRED IN ACCORDANCE WITH THE FOLLOWING:

- INLET PROTECTION DEVICES AND BARRIERS SHALL BE REPAIRED OR REPLACED IF THEY SHOW SIGNS OF UNDERMINING, OR DETERIORATION.
- ALL SEEDING AREAS SHALL BE CHECKED REGULARLY TO SEE THAT A GOOD STAND IS MAINTAINED. AREAS SHOULD BE FERTILIZED, WATERED, AND RESEED AS NEEDED.
- SILT FENCES SHALL BE REPAIRED TO THEIR ORIGINAL CONDITIONS IF DAMAGED. SEDIMENT SHALL BE REMOVED FROM THE SILT FENCES WHEN IT REACHES ONE-THIRD THE HEIGHT OF THE SILT FENCE.
- THE CONSTRUCTION EXITS SHALL BE MAINTAINED IN A CONDITION WHICH WILL PREVENT TRACKING OR FLOW OF MUD ONTO PUBLIC RIGHTS-OF-WAY. THIS MAY REQUIRE PERIODIC TOP DRESSING OF THE CONSTRUCTION EXITS AS CONDITIONS DEMAND.
- THE TEMPORARY PARKING AND STORAGE AREA SHALL BE KEPT IN GOOD CONDITION (SUITABLE FOR PARKING AND STORAGE). THIS MAY REQUIRE PERIODIC TOP DRESSING OF THE TEMPORARY PARKING AS CONDITIONS DEMAND.
- OUTLET STRUCTURES SHALL BE MAINTAINED IN OPERATIONAL CONDITIONS AT ALL TIMES.
- PRIOR TO LEAVING THE SITE, ALL VEHICLES SHALL BE CLEANED OF DEBRIS. ANY DEBRIS AND / OR SEDIMENT REACHING THE PUBLIC STREET SHALL BE CLEANED IMMEDIATELY BY A METHOD OTHER THAN FLUSHING.


BMP 1-SEQUENCE OF WORK

NOTE: UPON IMPLEMENTATION AND INSTALLATION OF THE FOLLOWING AREAS: TRAILER, PARKING, LAY DOWN, PORTABLE SANITARY UNIT, CONCRETE WASHOUT, FUEL AND MATERIAL STORAGE CONTAINERS, SOLID WASTE CONTAINERS, ETC., IMMEDIATELY DENOTE THEM ON THE SITE MAPS AND NOTE ANY CHANGES IN LOCATION AS THEY OCCUR THROUGHOUT THE CONSTRUCTION PROCESS.


- INSTALL STABILIZED CONSTRUCTION ENTRANCE AND SWPPP INFORMATION SIGN.
- INSTALL EROSION AND SEDIMENT CONTROLS (CLEAR ONLY THOSE AREAS NECESSARY TO INSTALL SILT FENCE).
- BEGIN CLEARING AND GRUBBING AND DEMOLITION THE SITE (STOCKPILE ALL TOPSOIL FOR LATER USE).
- BEGIN GRADING OF SITE.
- TEMPORARY STABILIZATION OF AREAS NOT WORKING ON.
- INSTALL UTILITIES, SANITARY SEWER, STORM DRAIN, WATER, JOINT UTILITIES.
- INSTALL CURB AND GUTTER.
- ROCK ROADWAY.
- FINAL PAVING OF ROAD.
- COMPLETE GRADING AND INSTALLATION OF PERMANENT STABILIZATION OVER ALL AREAS.
- REMOVE ALL REMAINING TEMPORARY EROSION AND SEDIMENT CONTROL DEVICES. STABILIZE ANY AREAS DISTURBED BY THE REMOVAL OF BMP'S.

EROSION CONTROL NOTES


- IF THE PROJECT DISTURBS OVER ONE (1) ACRE OF LAND A STORMWATER POLLUTION PREVENTION PLAN (SWPPP) AND NOTICE OF INTENT (NOI) ARE REQUIRED, ACCORDING TO THE EPA'S CONSTRUCTION GENERAL PERMIT, AND SHALL BE RETAINED EITHER ON SITE OR WITHIN REASONABLE ACCESS FROM THE SITE. ADDITIONALLY, IF A SITE DISCHARGES WATER DIRECTLY TO SURFACE WATERS OF THE UNITED STATES A SWPPP AND NOI ARE REQUIRED. DELAYS AND DISRUPTIONS RELATING IN WHOLE OR IN PART TO SATISFYING EROSION CONTROL STANDARDS, STATUTES, AND REGULATIONS, OR TO PROCURING ANY NECESSARY PERMITS OR APPROVALS, SHALL NOT BE A BASIS FOR ADJUSTMENT OF CONTRACT TIME OR PRICE. ALL EROSION CONTROL WORK SHALL BE INCIDENTAL TO OTHER BID ITEMS.
- APPROVAL OF THE EROSION CONTROL ELEMENT DOES NOT CONSTITUTE AN APPROVAL OF PERMANENT SITE OR DRAINAGE DESIGN.
- ALL CONTRACTORS AND SUBCONTRACTORS INVOLVED WITH STORM WATER POLLUTION PREVENTION SHALL OBTAIN A COPY OF THE STORM WATER POLLUTION PREVENTION PLAN AND THE STATE NATIONAL POLLUTANT DISCHARGE ELIMINATION SYSTEM GENERAL PERMIT (NPDES PERMIT) AND BECOME FAMILIAR WITH THEIR CONTENTS.
- BMP INSPECTIONS SHALL BE PERFORMED BY QUALIFIED PERSONNEL. QUALIFIED PERSONNEL MEANS A PERSON WHO POSSES THE SKILLS TO ASSESS CONDITIONS AT THE CONSTRUCTION SITE THAT COULD IMPACT STORMWATER QUALITY AND TO ASSESS THE EFFECTIVENESS OF ANY SEDIMENT AND EROSION CONTROL MEASURES SELECTED TO CONTROL THE QUALITY OF STORMWATER DISCHARGES FROM THE CONSTRUCTION ACTIVITY.
- INSPECTIONS SHALL INCLUDE ALL AREAS OF THE SITE DISTURBED BY CONSTRUCTION ACTIVITY AND AREAS USED FOR THE STORAGE OF MATERIALS THAT ARE EXPOSED TO PRECIPITATION. THE INSPECTOR SHALL LOOK FOR EVIDENCE OF, OR THE POTENTIAL FOR, POLLUTANTS ENTERING THE STORMWATER CONVEYANCE SYSTEM. SEDIMENTATION AND EROSION CONTROL MEASURES MUST BE OBSERVED TO ENSURE PROPER OPERATION.
- THE TEMPORARY EROSION AND SEDIMENT CONTROL PLAN SHALL BE MODIFIED TO MATCH THE ACTUAL LOCATIONS OF BMP'S AT THE SITE. MODIFICATIONS TO THE PLAN CAN ALSO BE MADE IN THE EVENT THAT THE CONTRACTOR OR INSPECTOR DETERMINES THAT ANY BMP IS INEFFECTIVE, OR THAT A DIFFERENT BMP IS MORE EFFECTIVE.
- IMPLEMENTATION, CONSTRUCTION, MAINTENANCE, REPLACEMENT AND UPGRADING OF ALL EROSION CONTROL MEASURES IS THE RESPONSIBILITY OF THE CONTRACTOR UNTIL ALL CONSTRUCTION IS COMPLETED AND APPROVED AND ALL VEGETATION / LANDSCAPING IS ESTABLISHED.
- THE EROSION CONTROL FACILITIES ON THIS PLAN MUST BE CONSTRUCTED IN CONJUNCTION WITH ALL CLEARING AND GRADING ACTIVITIES TO ENSURE THAT SEDIMENT-LADEN WATER DOES NOT ENTER THE DRAINAGE SYSTEM OR VIOLATE APPLICABLE WATER STANDARDS.
- ALL EROSION CONTROL FACILITIES SHALL BE INSPECTED DAILY BY THE CONTRACTOR AND MAINTAINED AS NECESSARY TO ENSURE THEIR CONTINUED FUNCTIONING.
- SUFFICIENT OIL AND GREASE ABSORBING MATERIALS SHALL BE MAINTAINED ON SITE OR READILY AVAILABLE TO CONTAIN AND CLEAN-UP FUEL OR CHEMICAL SPILLS AND LEAKS.
- ALL WASH WATER (CONCRETE TRUCKS, VEHICLE CLEANING, EQUIPMENT CLEANING, ETC.) SHALL BE DETAINED AND PROPERLY TREATED OR DISPOSED.
- DURING PERIODS OF ACTIVE CONSTRUCTION BMP INSPECTIONS SHALL BE PERFORMED ONCE EVERY SEVEN DAYS AND WITHIN 24 HOURS OF ANY SIGNIFICANT STORM EVENT (1/2 INCH OR GREATER).
- DURING PERIODS OF INACTIVITY BMP INSPECTIONS SHALL BE PERFORMED ONCE MONTHLY AND WITHIN 48 HOURS OF ANY SIGNIFICANT STORM EVENT (1/2 INCH OR GREATER).
- FILTER FABRIC SHALL BE PLACED UNDER THE GRATES OF NEWLY INSTALLED CATCH BASINS UNTIL PAVING OPERATIONS ARE COMPLETE. ALL CATCH BASINS AND CONVEYANCE LINES SHALL BE CLEANED PRIOR TO PAVING. THE CLEANING OPERATION SHALL NOT FLUSH SEDIMENT LADEN WATER INTO THE DOWNSTREAM SYSTEM.
- STABILIZED CONSTRUCTION ENTRANCES SHALL BE INSTALLED AT THE BEGINNING OF CONSTRUCTION AND SHALL BE MAINTAINED FOR THE DURATION OF THE PROJECT. ADDITIONAL MEASURES MUST BE TAKEN BY THE CONTRACTOR, IF NECESSARY, TO ENSURE THAT ALL EXISTING PAVED AREAS ARE KEPT CLEAN FOR THE DURATION OF THE PROJECT.
- SEED, MULCH, AND FERTILIZE ALL DISTURBED GROUND NOT RECEIVING HARD SURFACE AT THE EARLIEST POSSIBLE TIME. USE SEED MIXES AND RATES AS PER LANDSCAPE DESIGNER.
- EROSION AND DUST CONTROL MEASURES MUST BE USED DURING CONSTRUCTION TO REDUCE OR ELIMINATE BLOWING DUST, EXCESSIVE RUNOFF, AND SOIL EROSION ACROSS PROPERTY LINES AND INTO STREETS AND RIGHT-OF-WAY, AND TO ELIMINATE TRACKING SOIL AND MUD ONTO STREETS FROM CONSTRUCTION EQUIPMENT AND VEHICLES. THE USE OF MOTOR OILS AND OTHER PETROLEUM BASED OR TOXIC LIQUIDS FOR DUST SUPPRESSION OPERATIONS IS PROHIBITED.
- ALL ENTRANCES NOT PROTECTED WITH A CONSTRUCTION ENTRANCE FEATURE SHALL BE BLOCKED.
- MATERIAL TRACKED ONTO THE ROADWAY CANNOT BE WASHED INTO THE STORM SYSTEM.
- STREETS SHALL BE SWEEPED PRIOR TO A STORM EVENT OR AT THE REQUEST OF THE ENGINEER OR THE CITY.
- ALL DENUDE AREAS THAT WILL BE INACTIVE FOR 10 DAYS DURING DRY SEASON (JULY 1 - SEPTEMBER 30) AND 5 DAYS DURING WET SEASON (OCTOBER 1 - JUNE 30) OR MORE, MUST BE STABILIZED TEMPORARILY WITH THE USE OF FAST-GERMINATING ANNUAL GRASS / GRAIN VARIETIES, STRAW / HAY MULCH, WOOD CELLULOSE FIBERS, TACKIFIERS, NETTING OR BLANKETS AS SHOWN ON SITE MAP.
- DISTURBED PORTIONS OF THE SITE WHERE CONSTRUCTION ACTIVITY HAS PERMANENTLY STOPPED SHALL BE PERMANENTLY STABILIZED AS SHOWN ON THE PLANS. THESE AREAS SHALL BE SEED, SODDED, AND / OR VEGETATED NO LATER THAN 14 DAYS AFTER THE LAST CONSTRUCTION ACTIVITY OCCURRING IN THESE AREAS. REFER TO THE GRADING PLAN AND / OR LANDSCAPE PLAN.
- ALL MATERIALS SPILLED, DROPPED, WASHED, OR TRACKED FROM VEHICLES ONTO ROADWAYS OR INTO STORM DRAINS MUST BE REMOVED IMMEDIATELY.
- CONTRACTORS OR SUBCONTRACTORS WILL BE RESPONSIBLE FOR REMOVING SEDIMENT IN THE DETENTION POND AND ANY SEDIMENT THAT MAY HAVE COLLECTED IN THE STORM DRAINAGE SYSTEMS IN CONJUNCTION WITH STABILIZATION OF THE SITE.
- ON-SITE & OFF-SITE SOIL STOCKPILE AND BORROW AREAS SHALL BE PROTECTED FROM EROSION AND SEDIMENTATION THROUGH IMPLEMENTATION OF BEST MANAGEMENT PRACTICES. STOCKPILE AND AREA LOCATIONS SHALL BE NOTED ON THE SITE MAP AND PERMITTED IN ACCORDANCE WITH GENERAL PERMIT REQUIREMENTS.
- SLOPES SHALL BE LEFT IN A ROUGHENED CONDITION DURING THE GRADING PHASE TO REDUCE RUNOFF VELOCITIES AND EROSION.
- DUE TO THE GRADE CHANGES DURING THE DEVELOPMENT OF THE PROJECT, THE CONTRACTOR SHALL BE RESPONSIBLE FOR ADJUSTING THE EROSION CONTROL MEASURES (SILT FENCES, ETC.) TO PREVENT EROSION AND POLLUTANT DISCHARGE.
- INSPECTIONS SHALL INCLUDE ALL AREAS OF THE SITE DISTURBED BY CONSTRUCTION ACTIVITY AND AREAS USED FOR THE STORAGE OF MATERIALS THAT ARE EXPOSED TO PRECIPITATION. THE INSPECTOR SHALL LOOK FOR EVIDENCE OF, OR THE POTENTIAL FOR, POLLUTANTS ENTERING THE STORMWATER CONVEYANCE SYSTEM. SEDIMENTATION AND EROSION CONTROL MEASURES MUST BE OBSERVED TO ENSURE PROPER OPERATION.
- GENERAL CONTRACTOR IS TO DESIGNATE / IDENTIFY AREAS ON THE SITE MAPS, INSIDE OF THE LIMITS OF DISTURBANCE, FOR WASTE DISPOSAL AND DELIVERY AND MATERIALS STORAGE.
- REFER TO THE SWPPP FOR REPORTABLE SPILL QUANTITIES OF PETROLEUM PRODUCTS AND / OR HAZARDOUS WASTES.
- THE CONTRACTOR MUST COMPLY WITH A SITE SWEEPING PLAN WITH A MINIMUM SWEEPING FREQUENCY OF ONCE PER WEEK IN DRY WEATHER CONDITIONS AND ONCE PER DAY WHEN RAINFALL OCCURS.
- SEDIMENT OR OTHER POLLUTION-LADEN STORM WATER TO BE CONTAINED AND NOT ALLOWED TO DISCHARGE TO A STORM DRAIN.

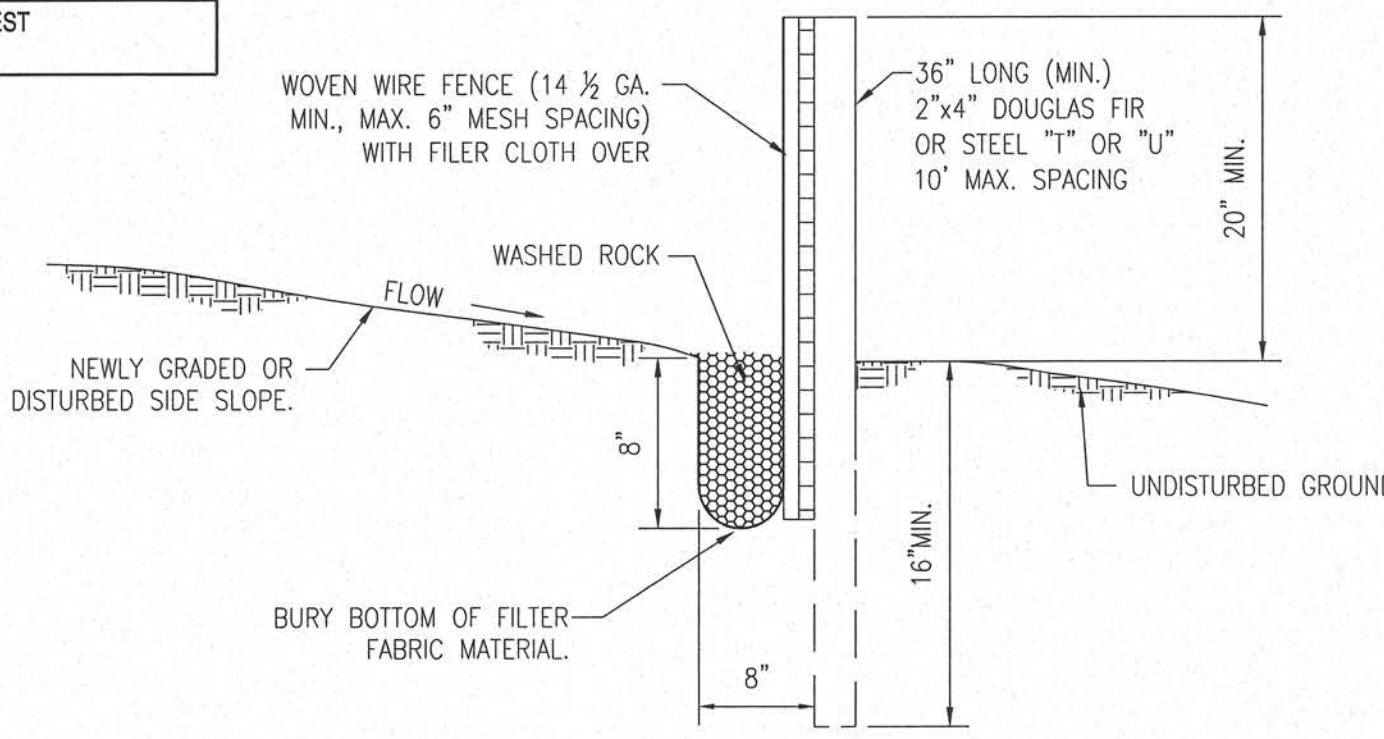


SILT FENCE
NTS

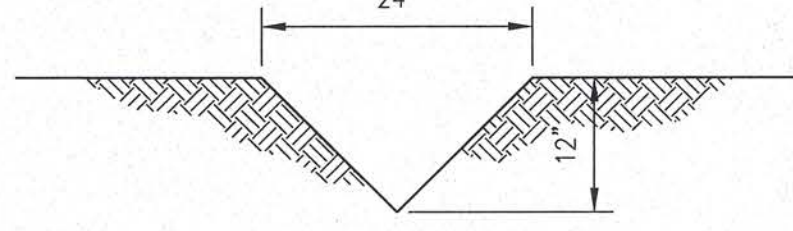


V-DITCH
BMP 40
NTS

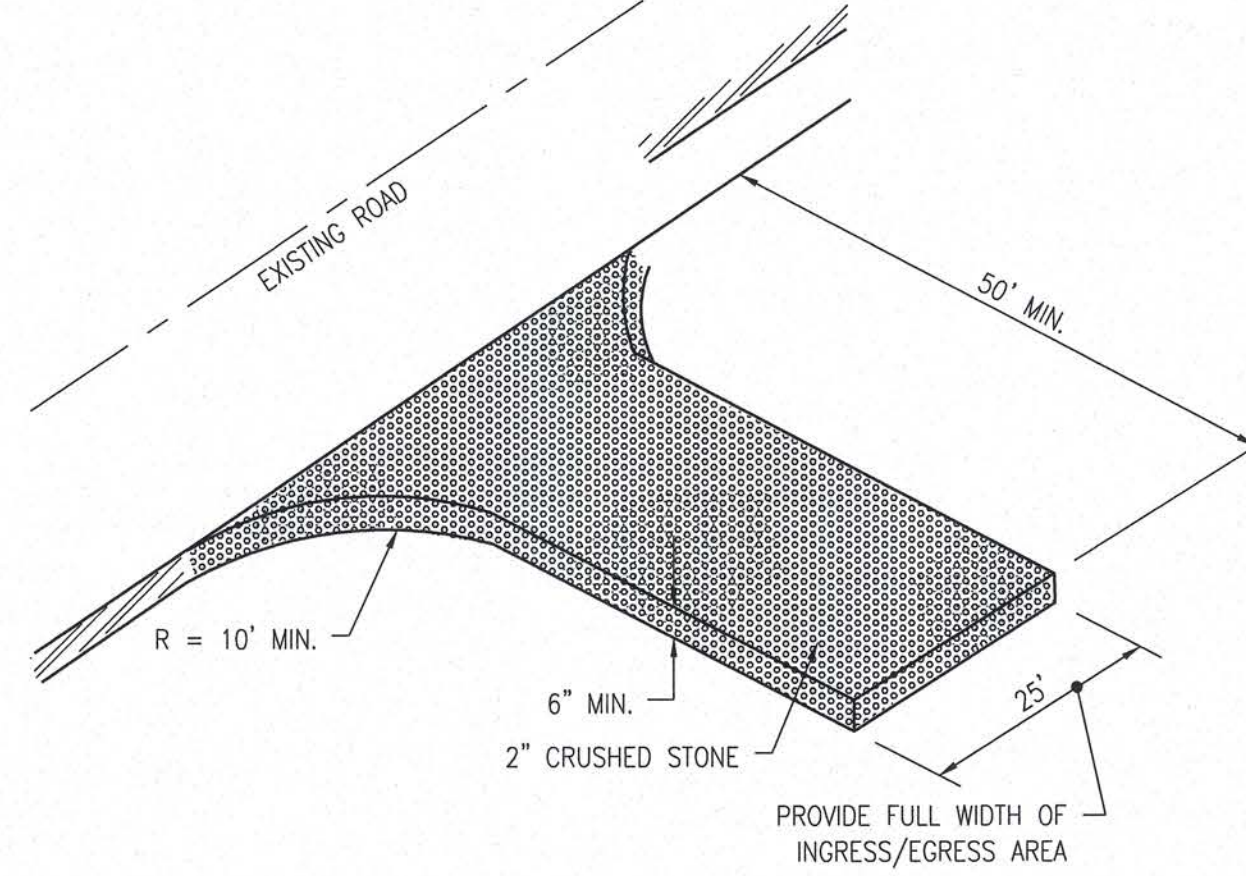

STABILIZED CONSTRUCTION ENTRANCE
NTS

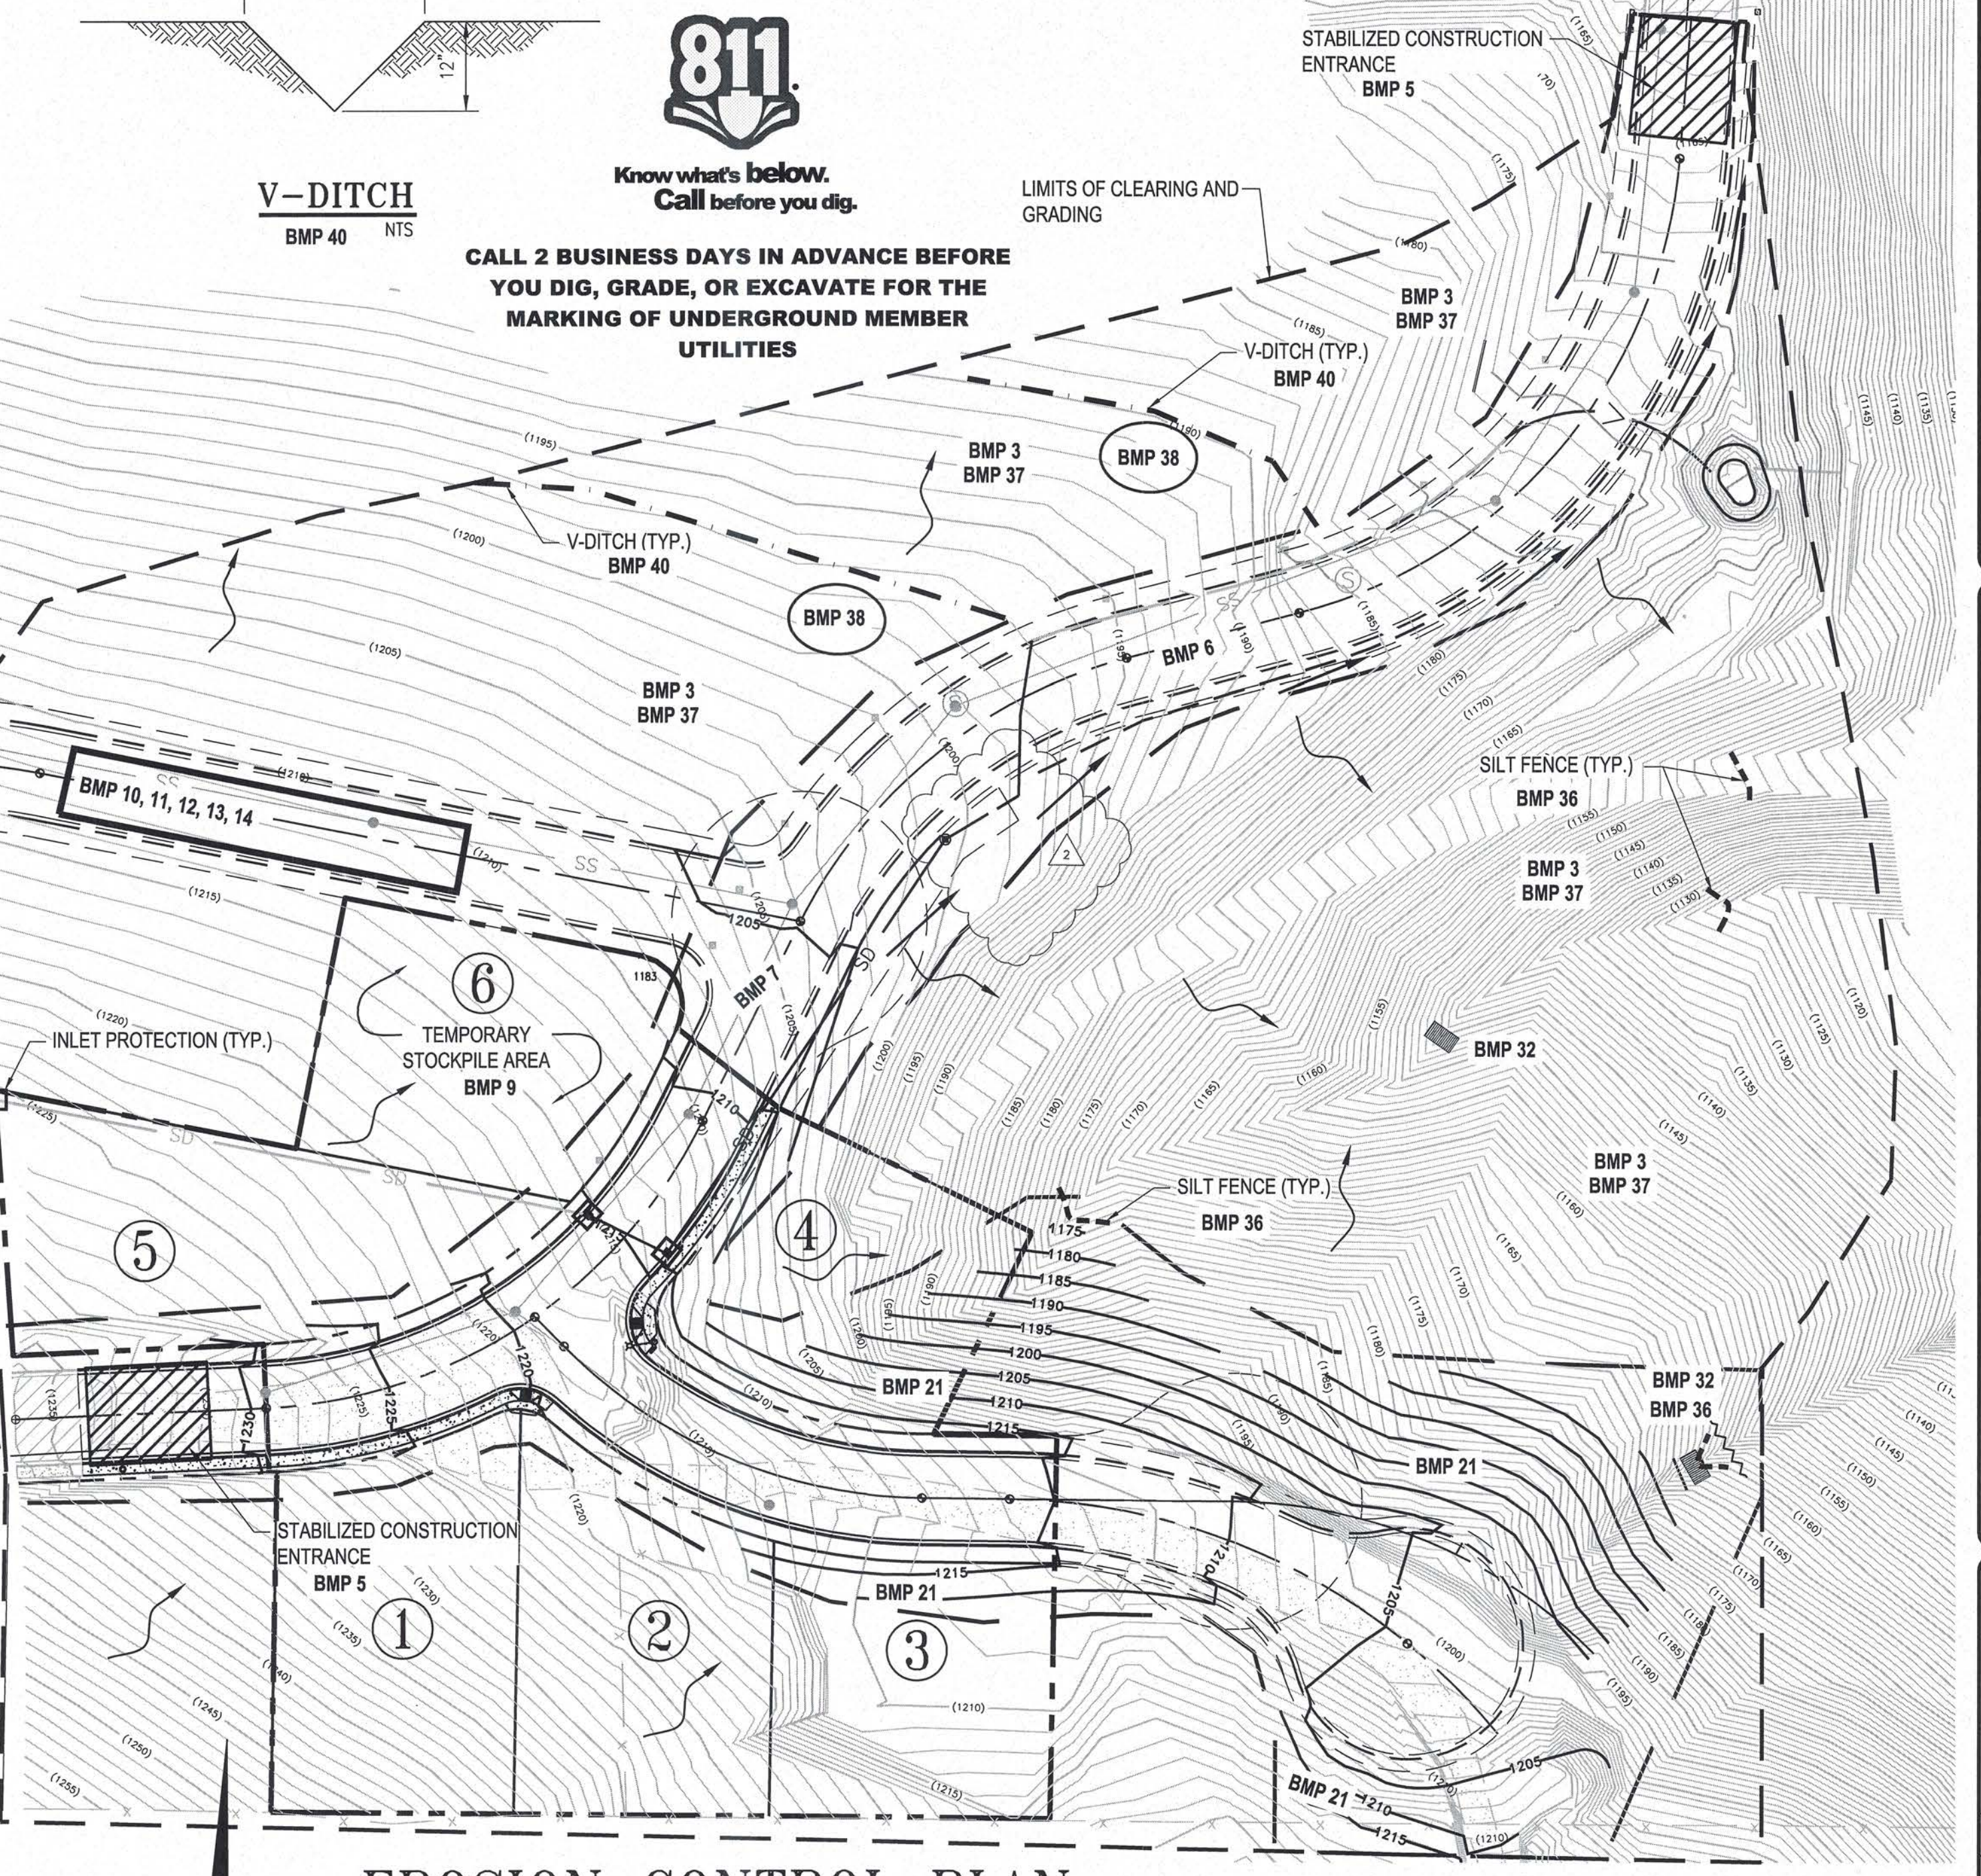

EROSION CONTROL PLAN

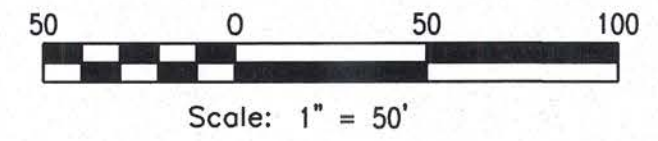

CALL 2 BUSINESS DAYS IN ADVANCE BEFORE YOU DIG, GRADE, OR EXCAVATE FOR THE MARKING OF UNDERGROUND MEMBER UTILITIES



NO.	DATE	BY	DESCRIPTION
1	08/22/18	MSR	CITY COMMENTS 08/16/18
2	09/14/18	MSR	REVISED STORMWATER - ADDED DETENTION POND
3	11/08/18	MSR	CITY COMMENTS

EROSION CONTROL PLAN
CRESTLINE CIRCLE DRIVE
VALLEY VISTA PUD
LEWISTON, ID. 83501

KELTIC ENGINEERING, INC.
315 Adams Lane • Lewiston, Idaho 83501 • (208) 743-2135 • (208) 743-2136 fax
• Development • Planning • Design • Construction Management

DRAWN BY: MSR
DESIGNED BY: EFH
DATE: 07/13/18
LAST REV: 11/08/18
PROJECT NO: 17-0089
SHEET NO: **C4 OF C14**

CHECKED BY: EFH
REGISTERED PROFESSIONAL ENGINEER
6064
STATE OF IDAHO
ERIC HASENBERG

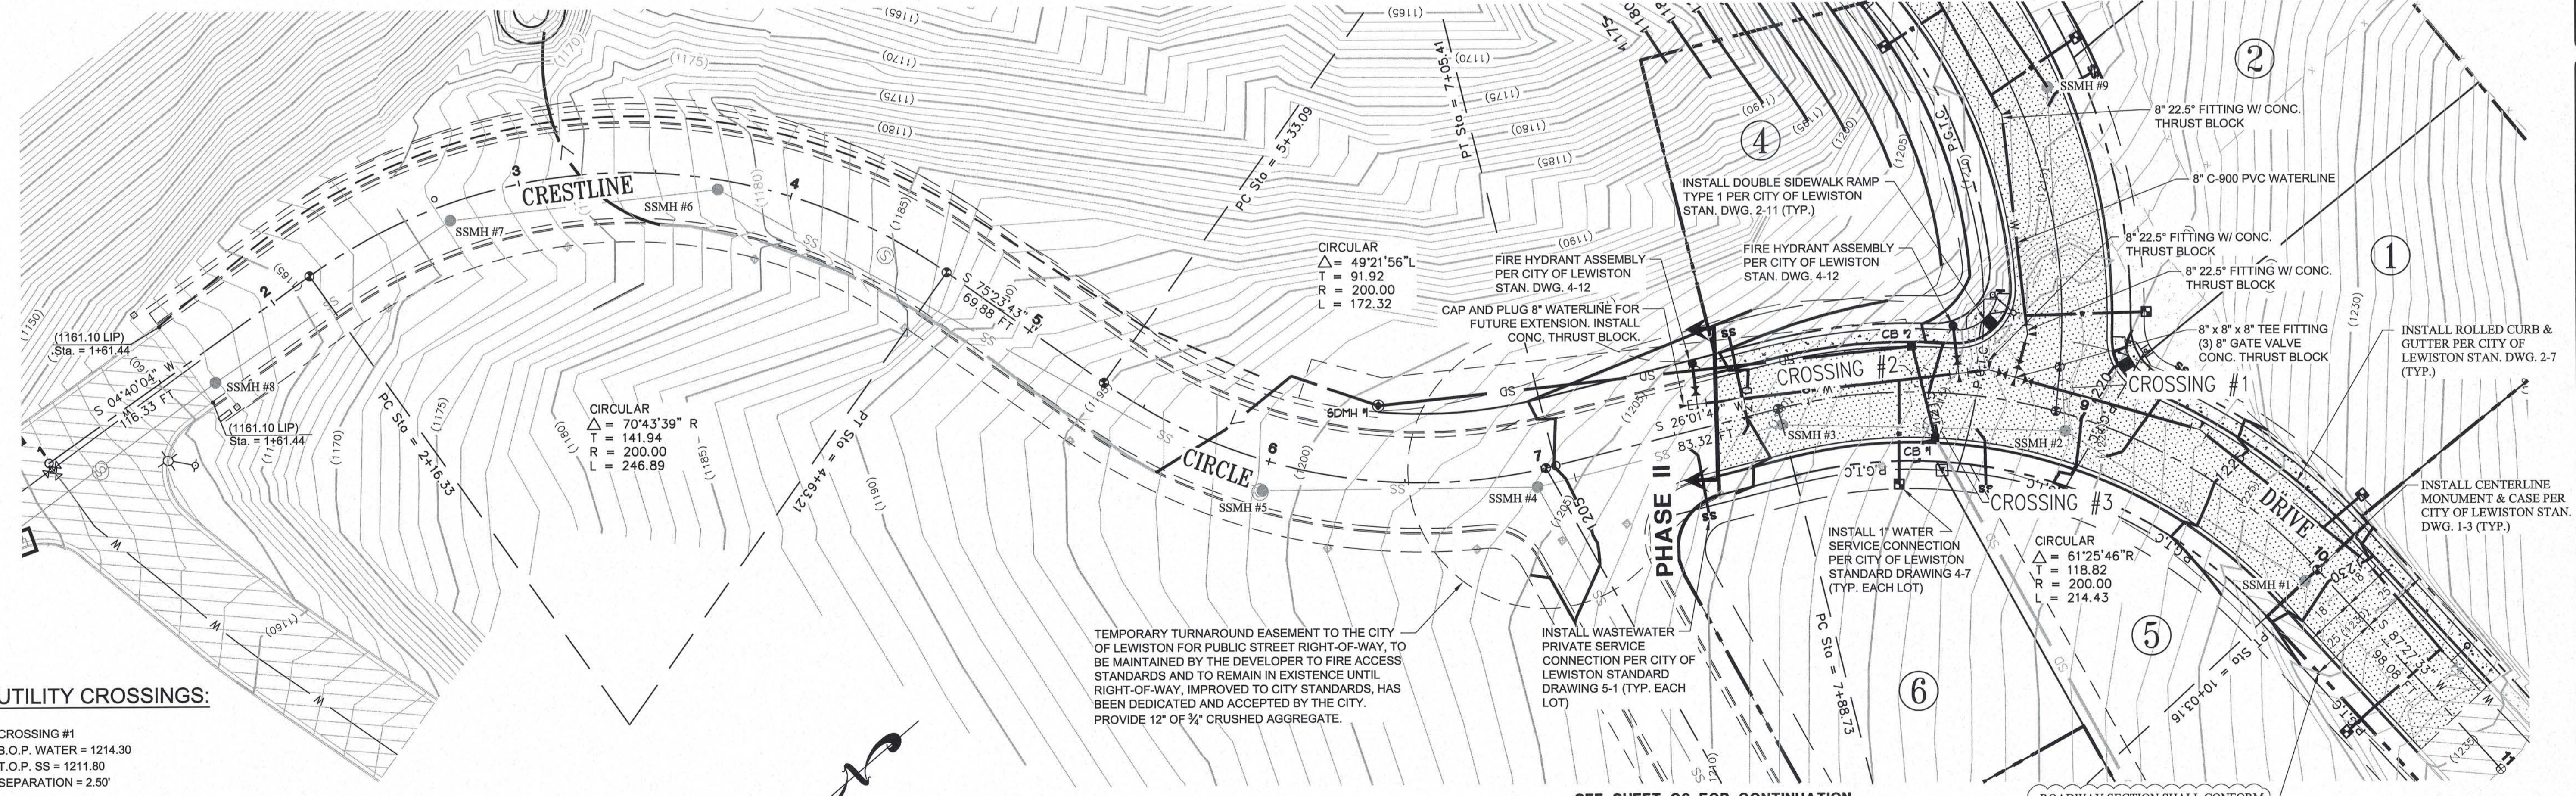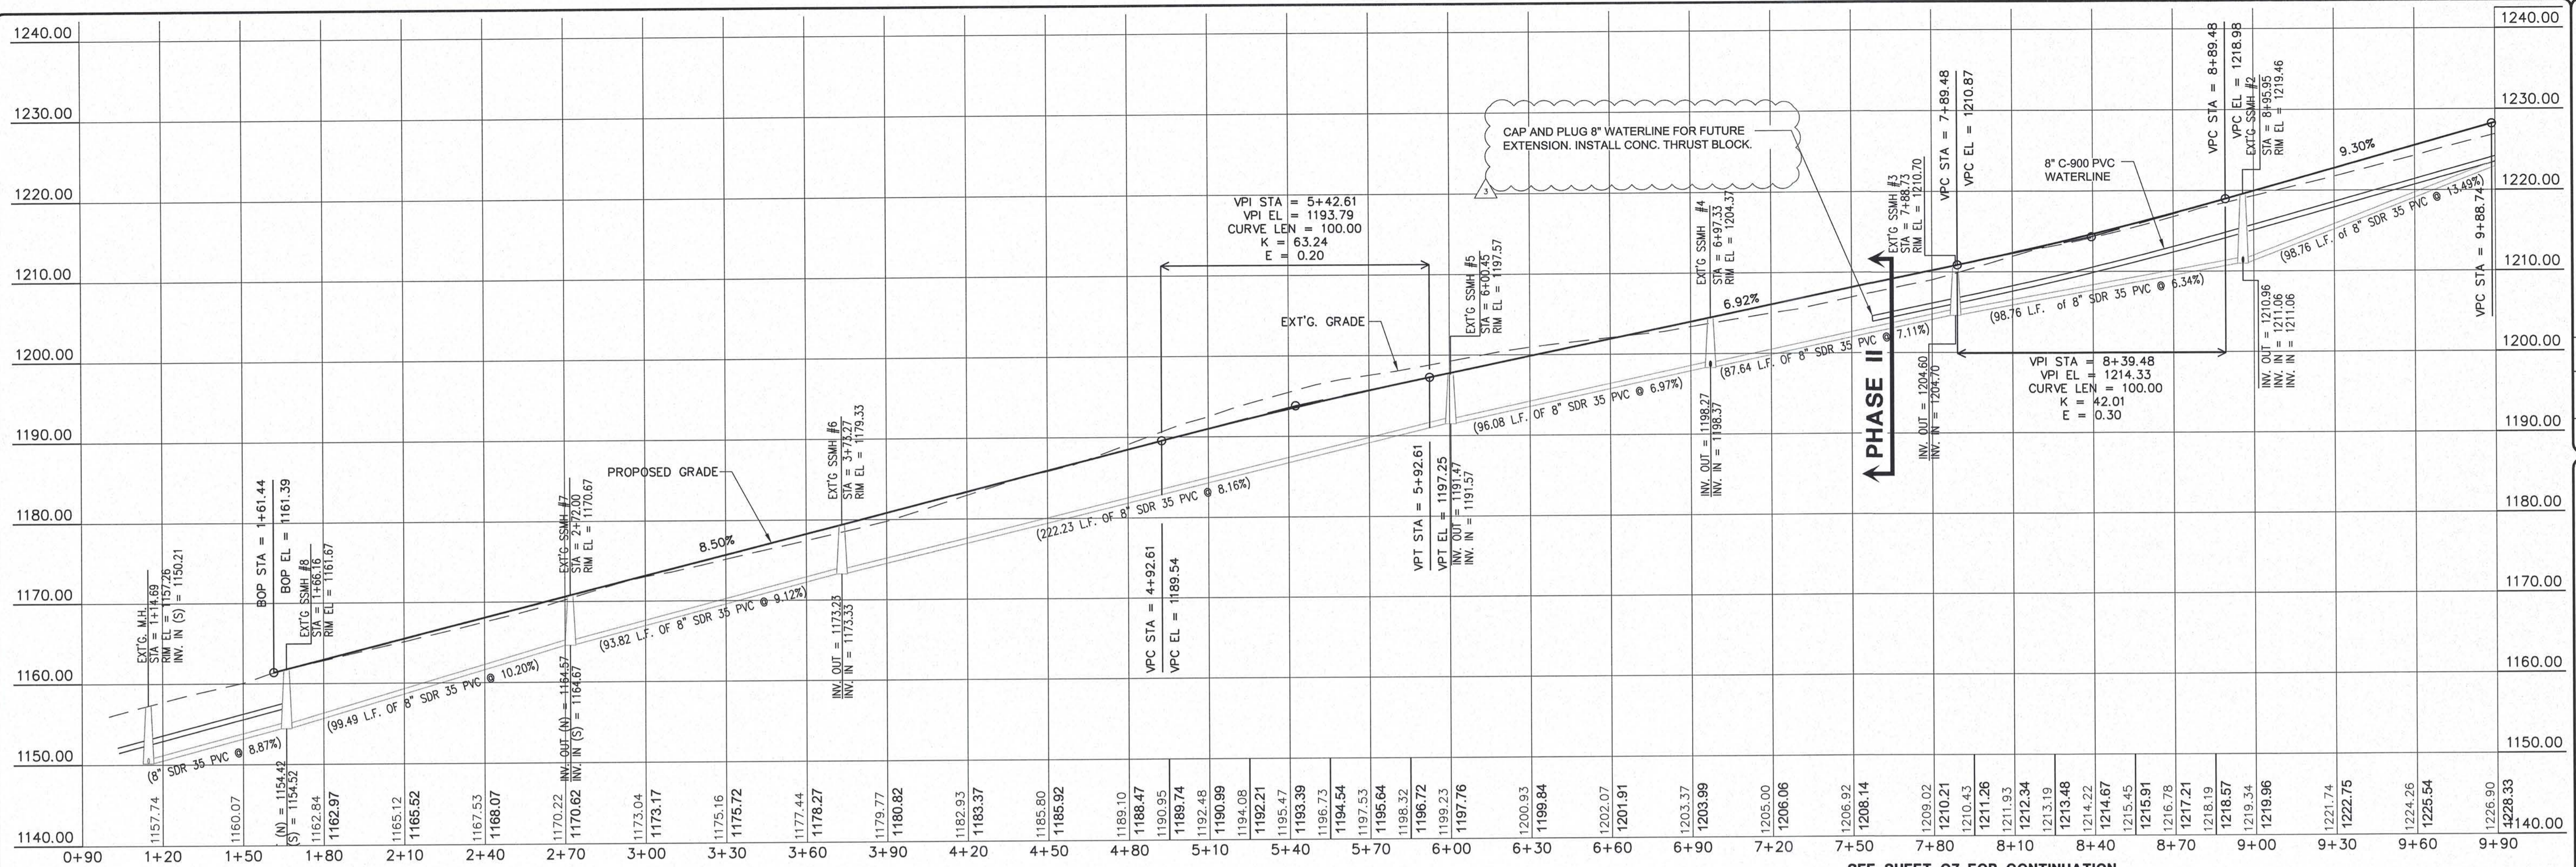


UTILITY CROSSINGS:

CROSSING #1
 B.O.P. WATER = 1214.30
 T.O.P. SS = 1211.80
 SEPARATION = 2.50'

CROSSING #2
 T.O.P. WATER = 1210.74
 B.O.P. S/D = 1211.36
 SEPARATION = 0.62'

CROSSING #3
 T.O.P. SS = 1208.58
 B.O.P. S/D = 1211.72
 SEPARATION = 3.14'

CRESTLINE CIRCLE DRIVE STA. 1+00 TO 9+60

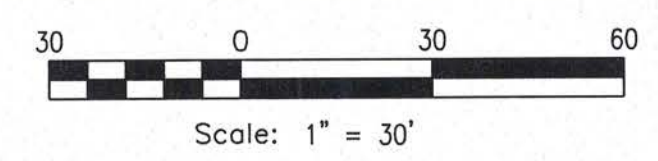

WATER & SEWER LATERAL NOTE:
 WATER AND SEWER LATERALS TO EACH LOT SHALL BE LOCATED 5' MIN. FROM PROPERTY LINE.



NO.	DATE	BY	DESCRIPTION
1	09/22/18	MSR	CITY COMMENTS 09/16/18
2	11/08/18	MSR	CITY COMMENTS

CRESTLINE CIRCLE DRIVE PLAN & PROFILE
CRESTLINE CIRCLE DRIVE
VALLEY VISTA PUD
LEWISTON, ID. 83501


KELTIC ENGINEERING, INC.
 315 Adams Lane • Lewiston, Idaho 83501 • (208) 743-2135 • (208) 743-2136 fax
 • Development • Planning • Design • Construction Management

PROFESSIONAL ENGINEER
 REGISTERED
6064
 11/09/18
 STATE OF IDAHO
 ERIC HASENOHR

DRAWN BY: MSR
 CHECKED BY: EFH
 DESIGNED BY: EFH
 DATE: 07/13/18
 LAST REV: 11/08/18
 PROJECT NO: 17-0089
 SHEET NO: **C5 OF C14**

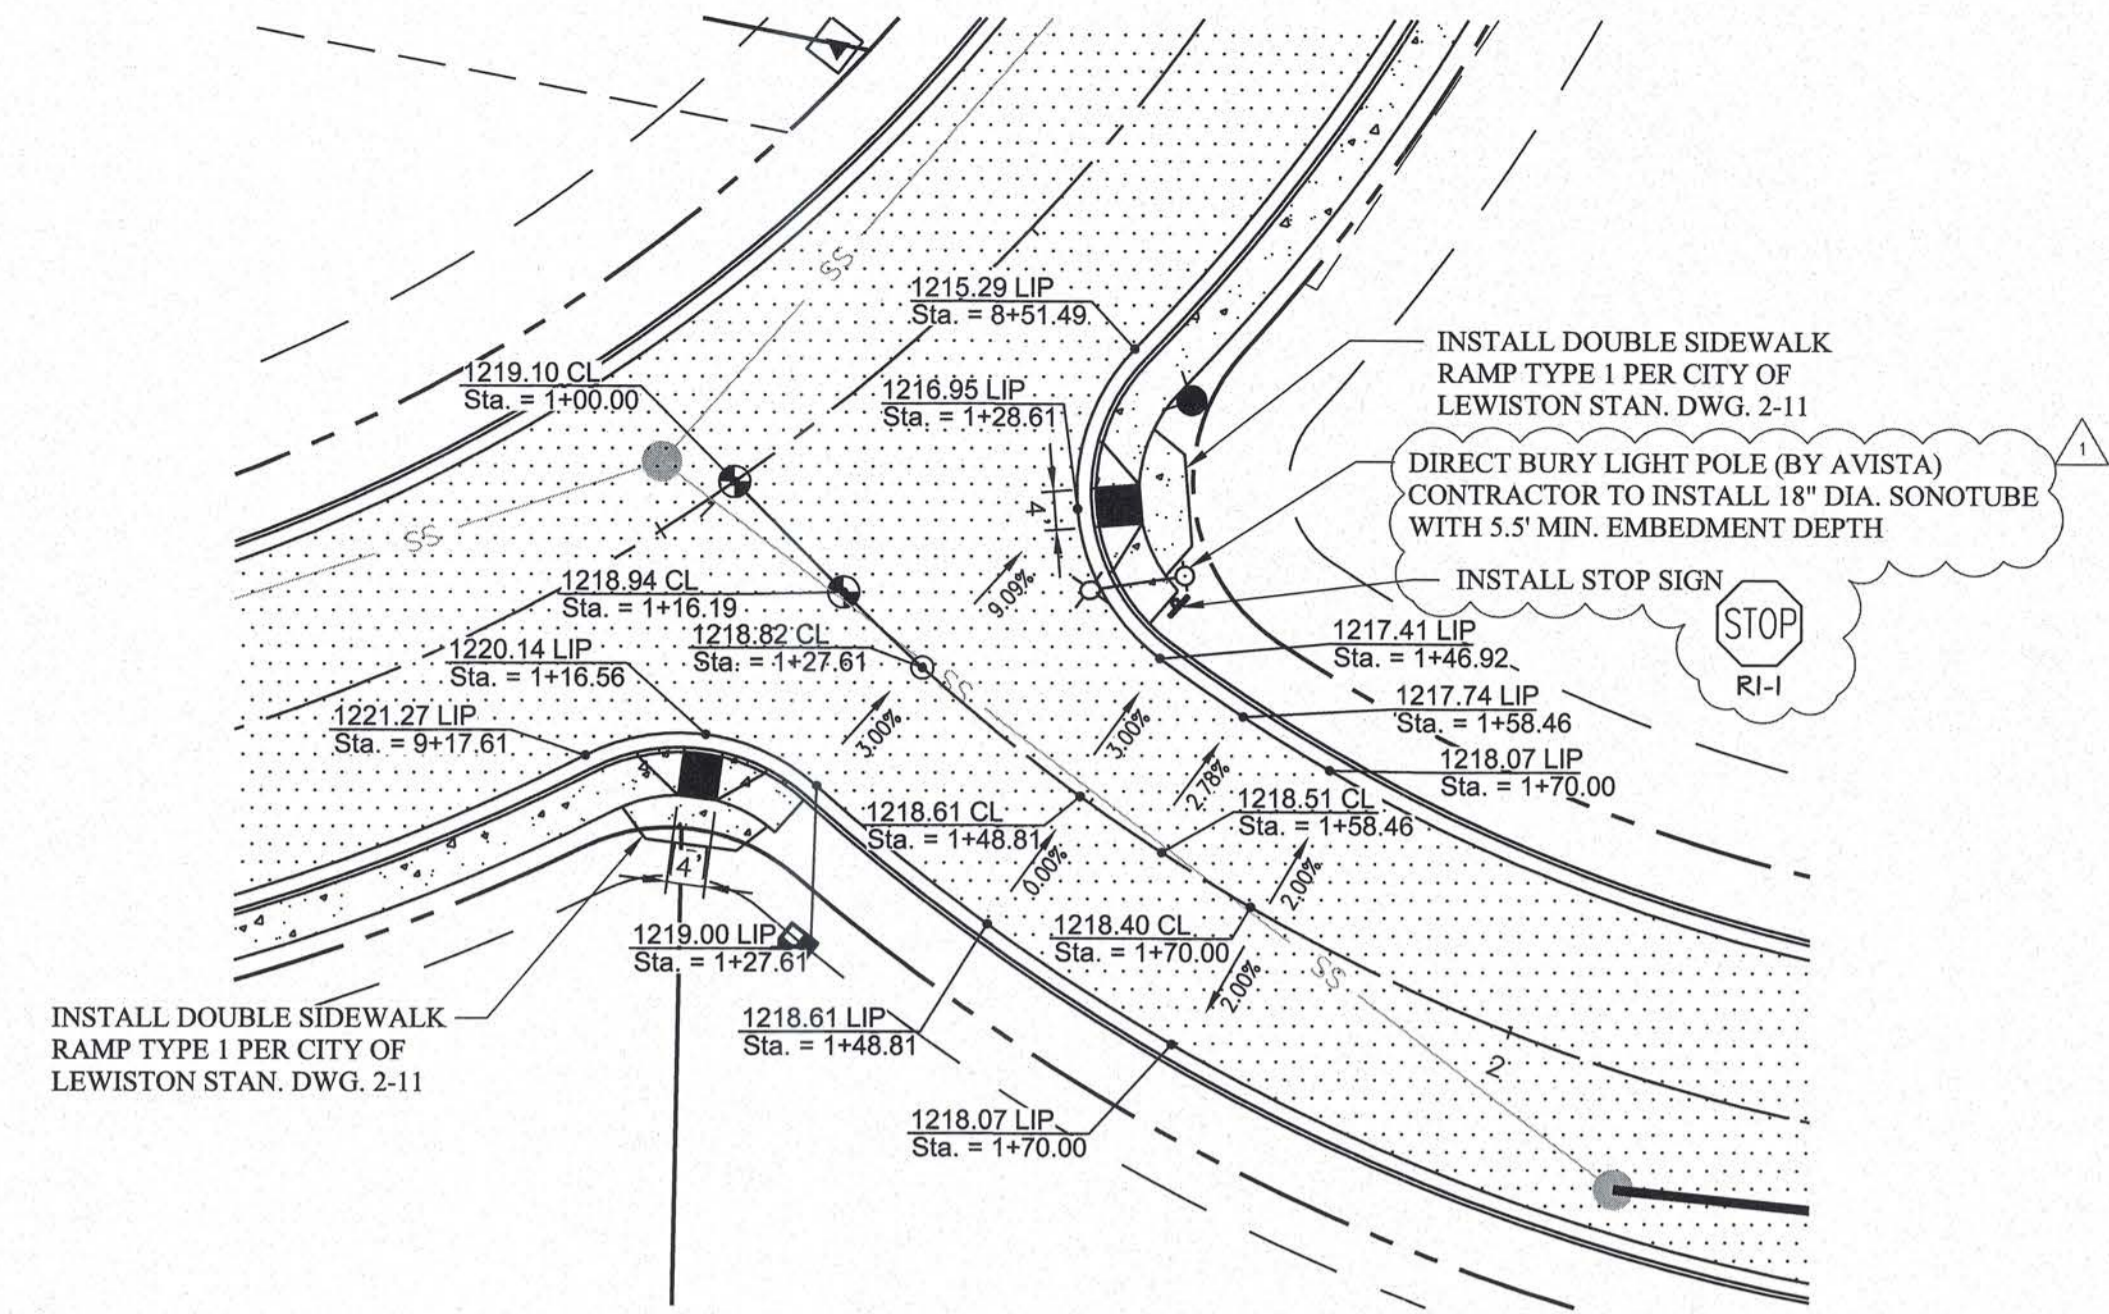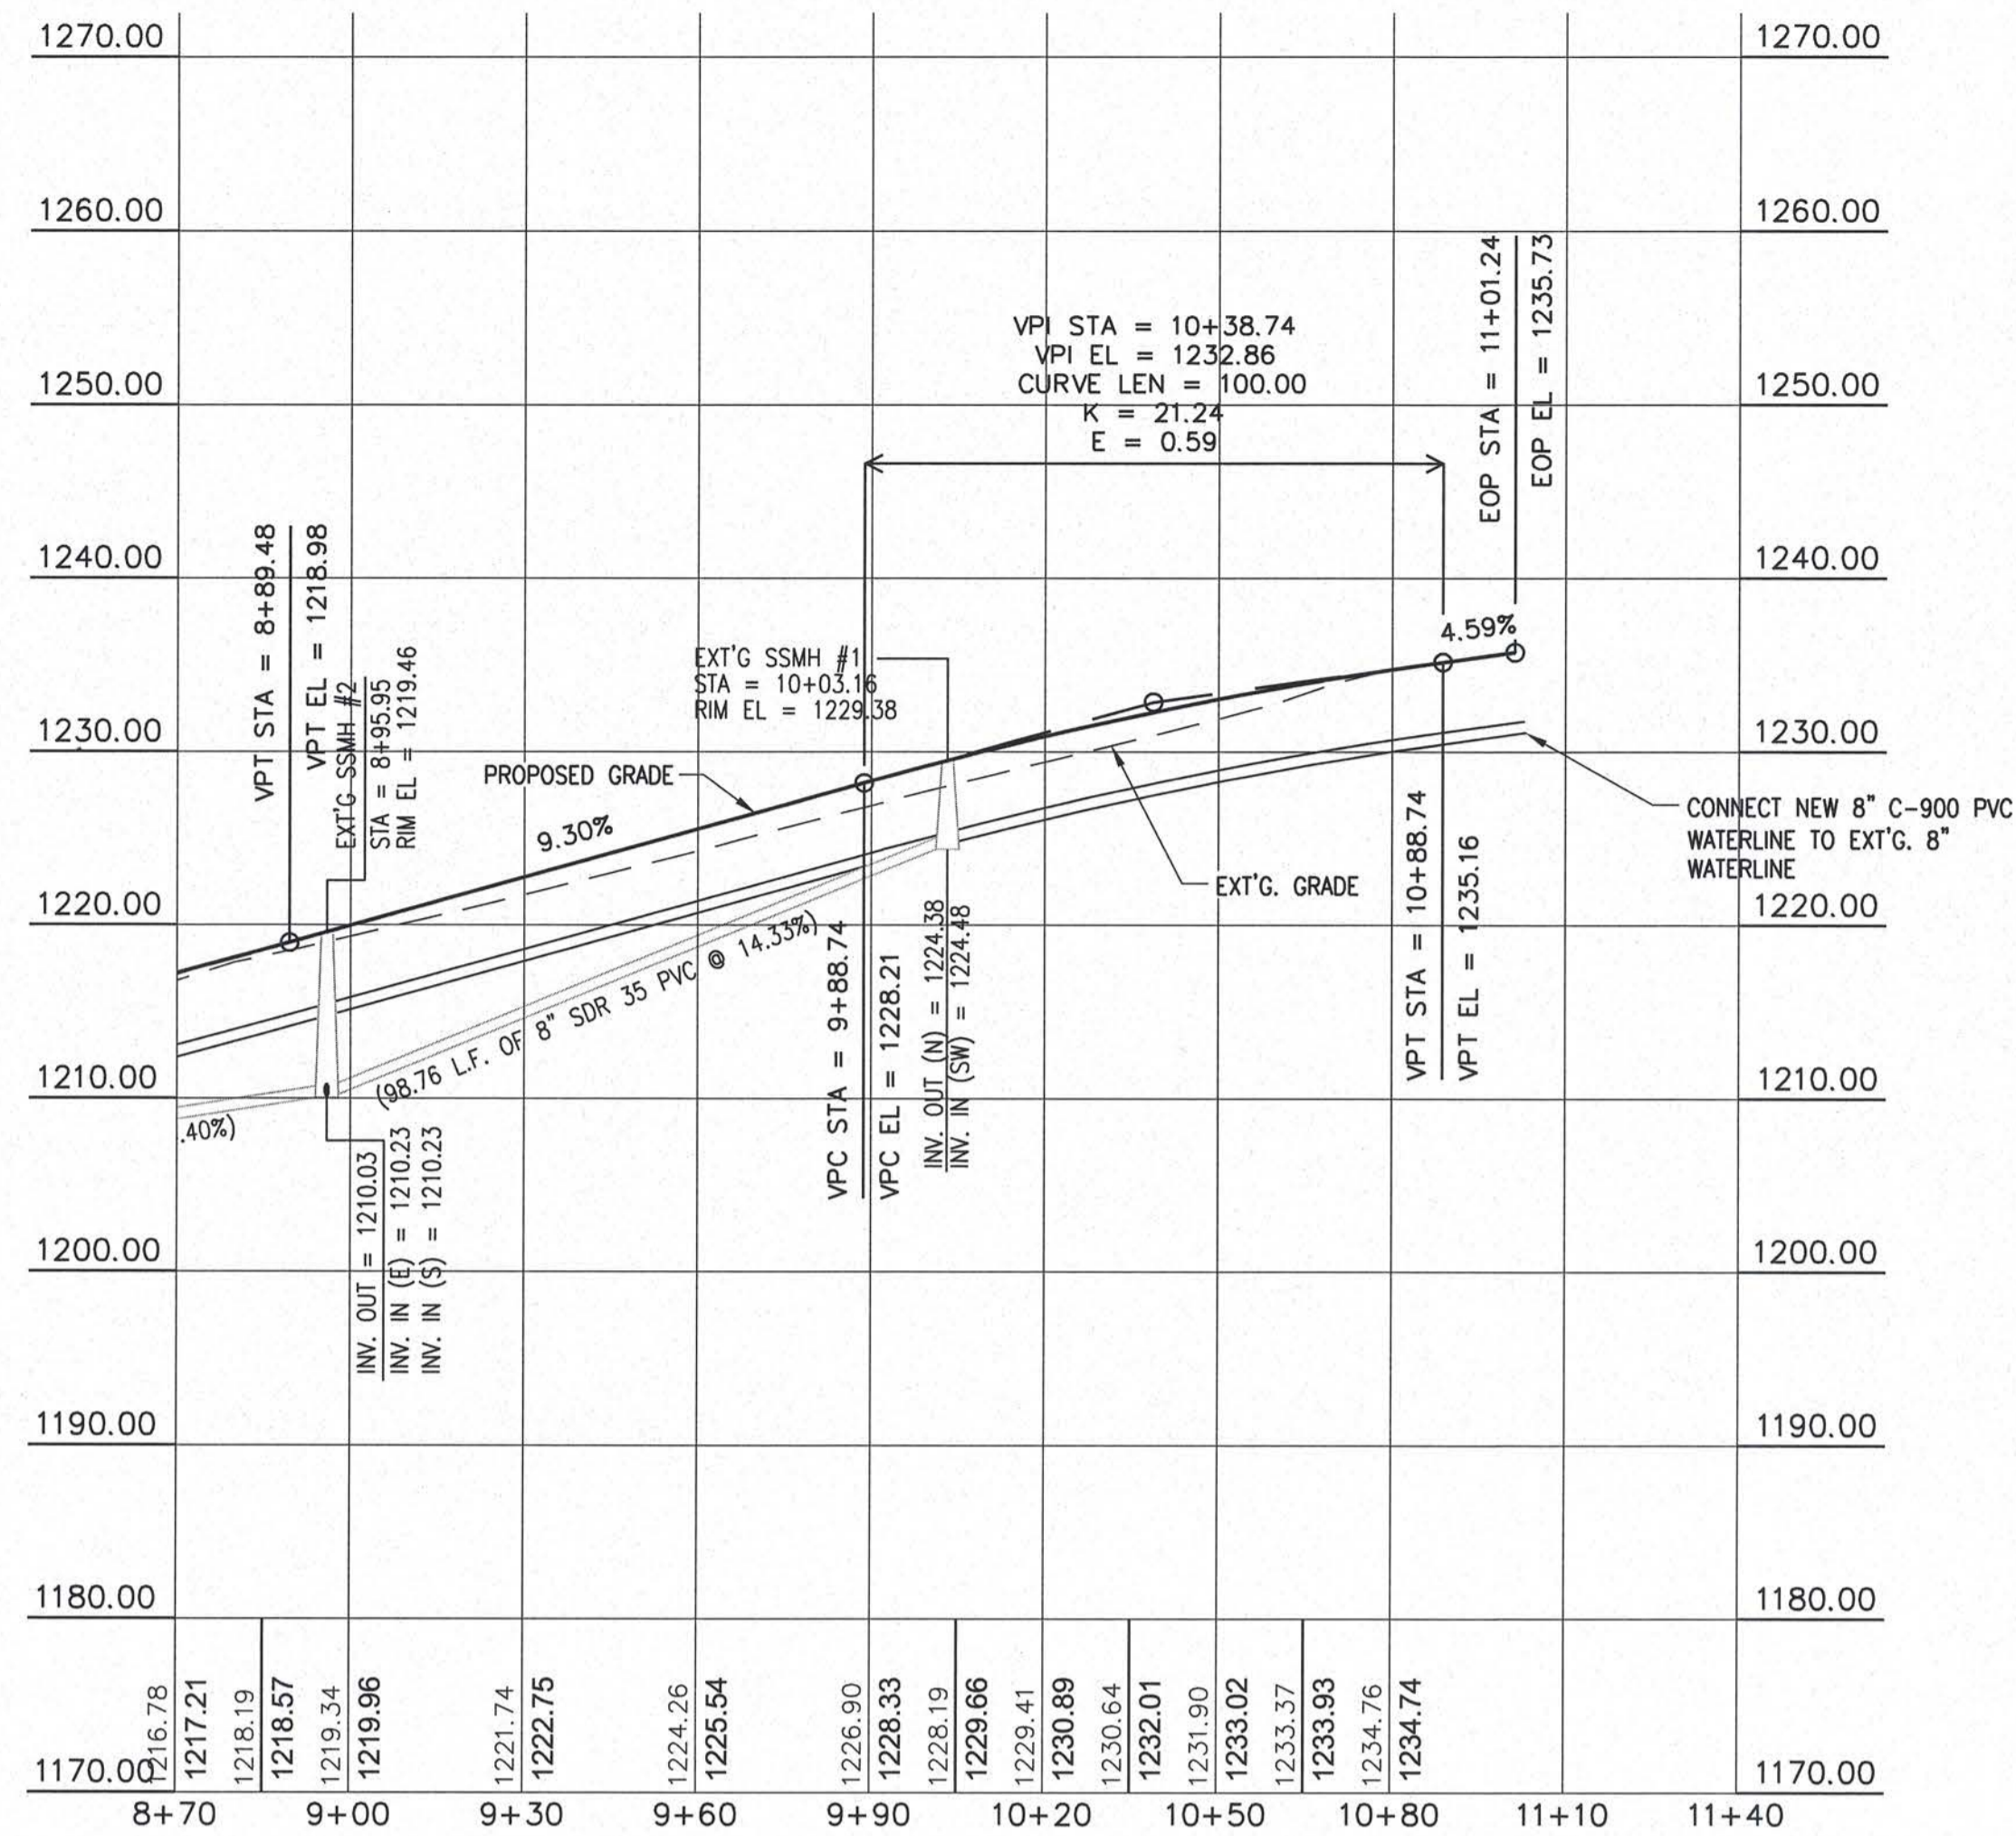

CRESTLINE CIRCLE DRIVE - EASTWAY COURT

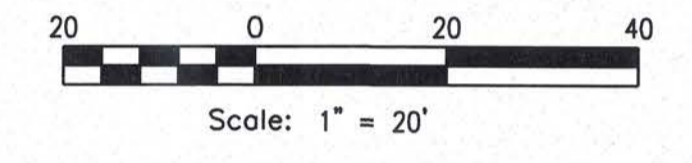


No.	DATE	BY	DESCRIPTION
1	09/22/18	MSR	CITY COMMENTS 08/16/19
2	11/08/18	ML	CITY COMMENTS

CRESTLINE CIRCLE DRIVE INTERSECTIONS
CRESTLINE CIRCLE DRIVE
VALLEY VISTA PUD
LEWISTON, ID. 83501


KELTIC ENGINEERING, INC.
 315 Adams Lane • Lewiston, Idaho 83501 • (208) 743-2135 • (208) 743-2136 fax
 • Development • Planning • Design • Construction Management



PROFESSIONAL ENGINEER
 REGISTERED
 6064
 STATE OF IDAHO
 ERIC HASENGRUB

DRAWN BY: MSR
 CHECKED BY: EFH
 DESIGNED BY: EFH
 DATE: 07/13/18
 LAST REV: 11/03/18
 PROJECT NO: 17-0089
 SHEET NO: **C6 OF C14**

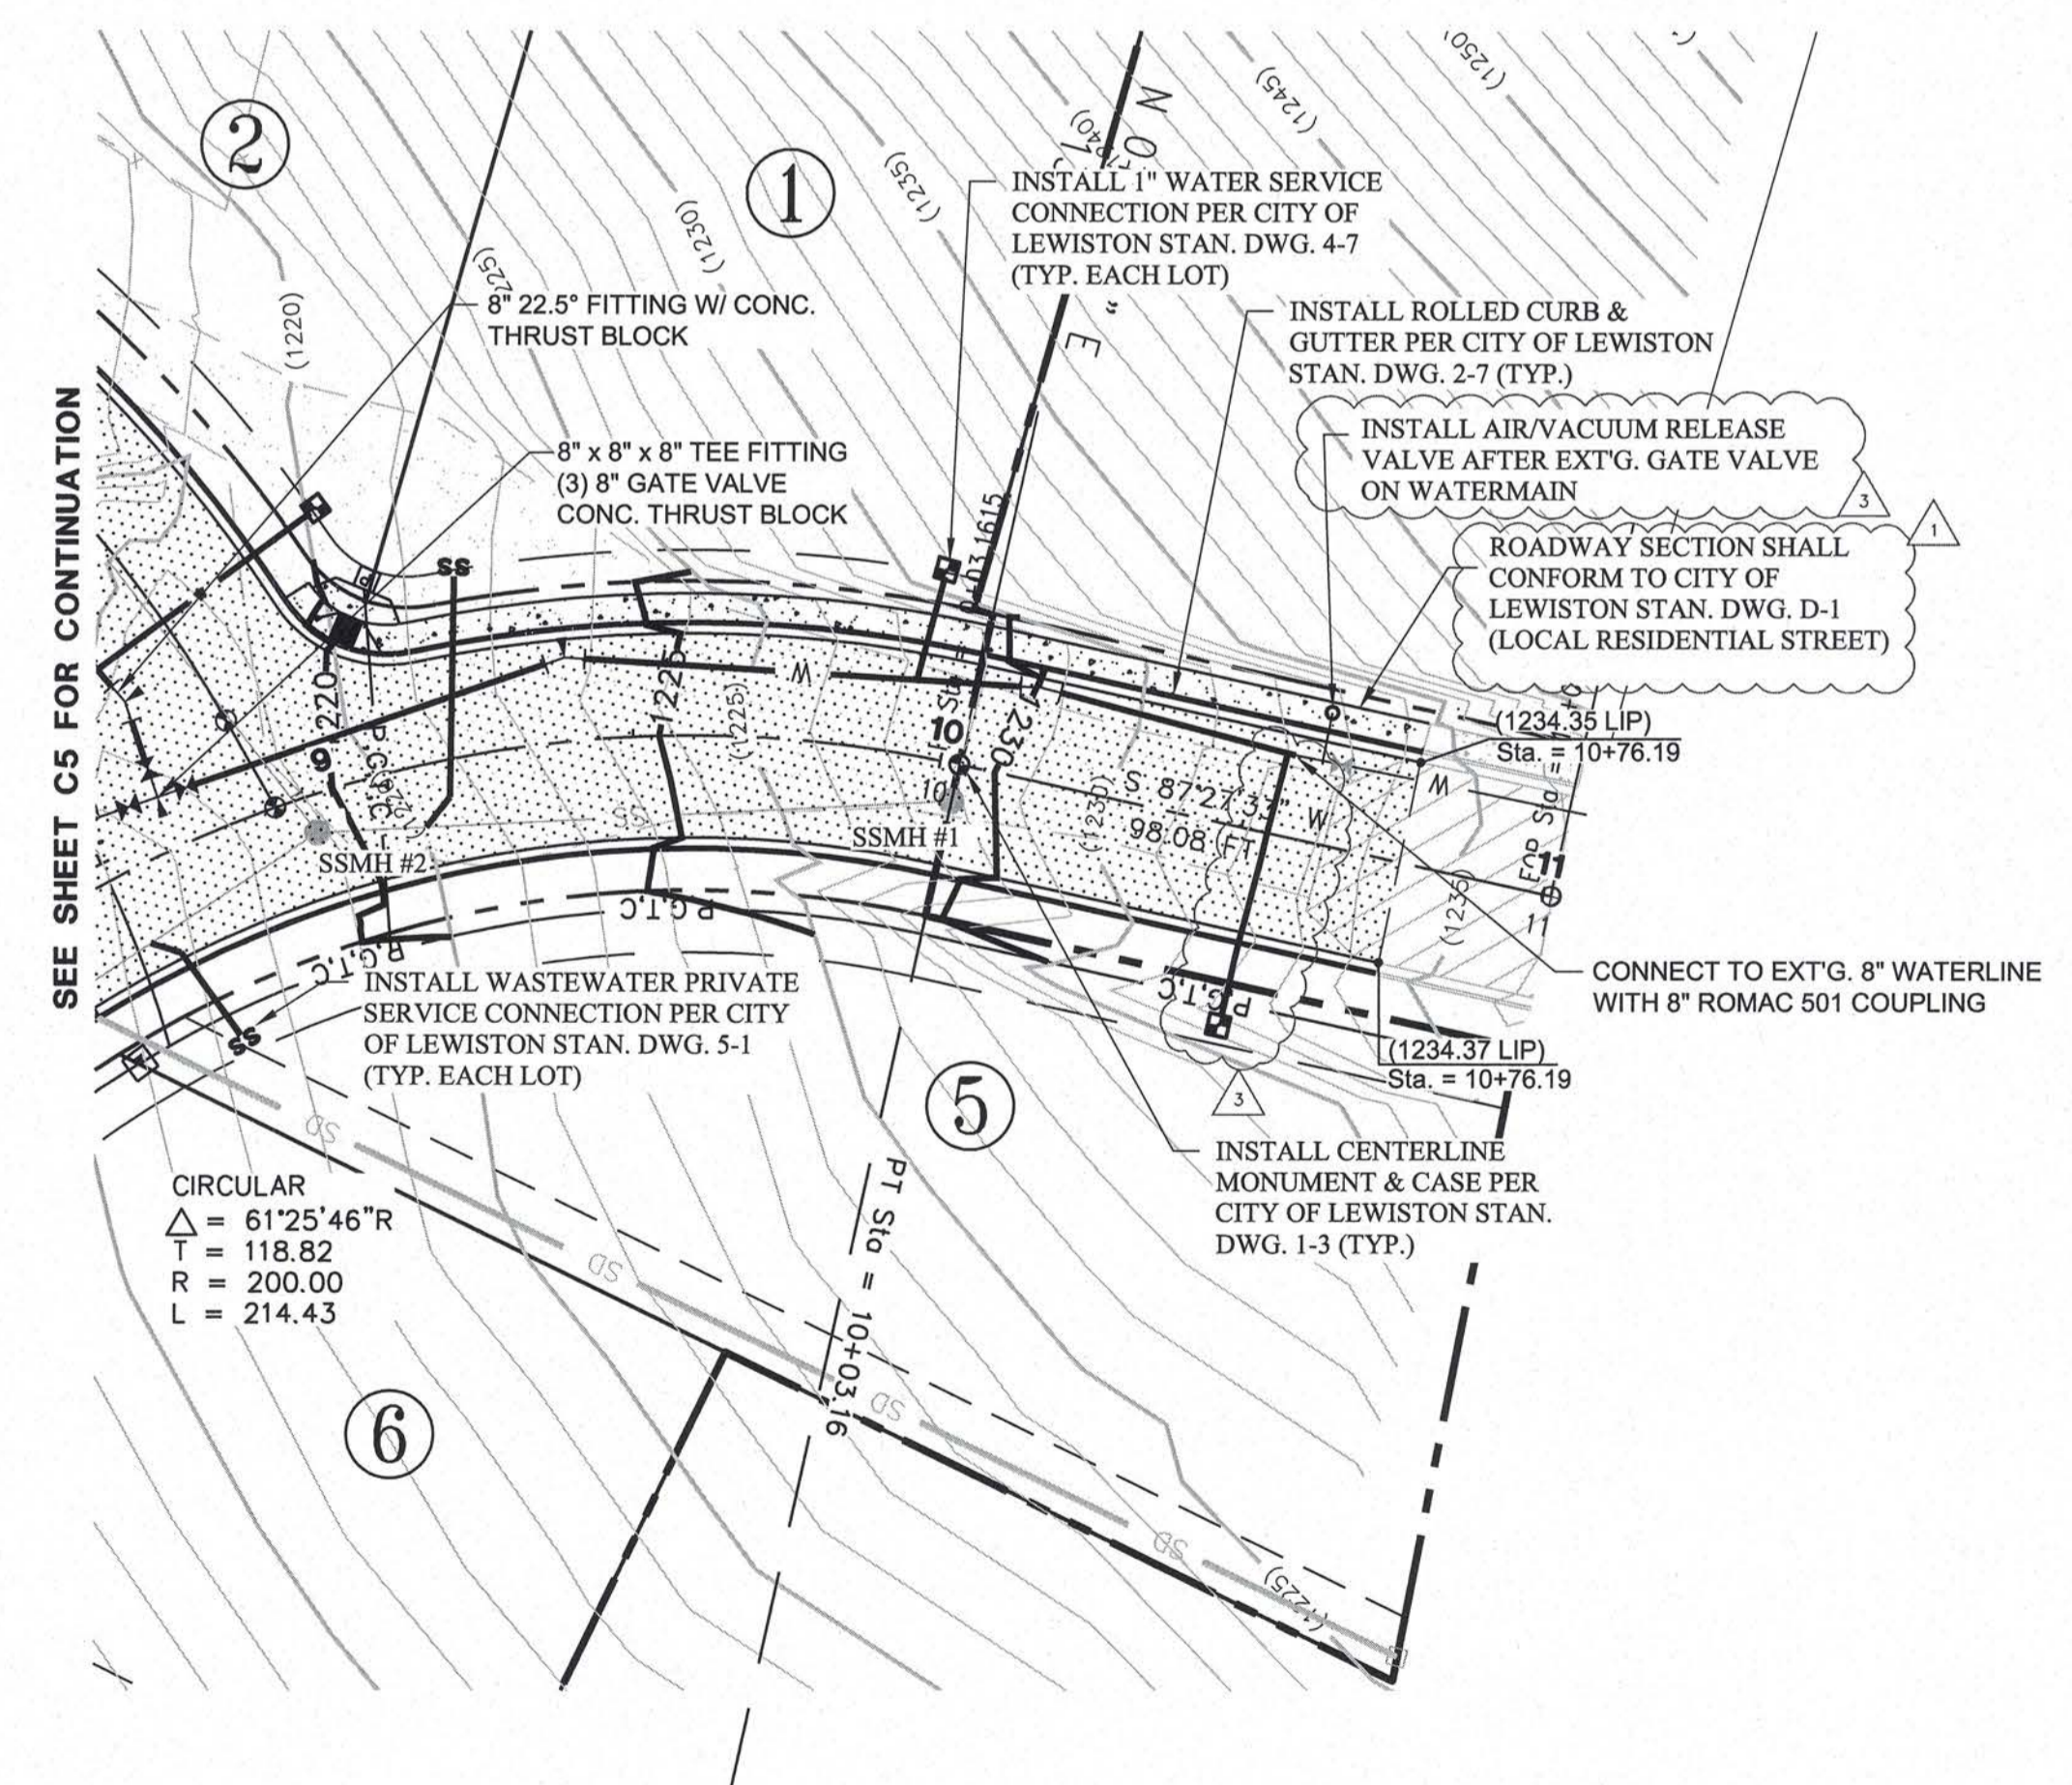


CRESTLINE CIRCLE DRIVE STA. 8+70 TO 11+01.24

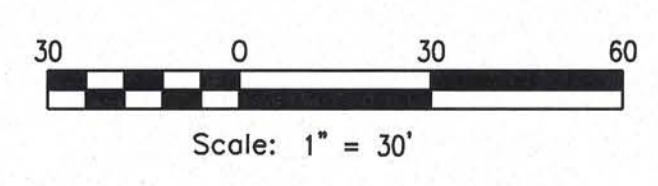

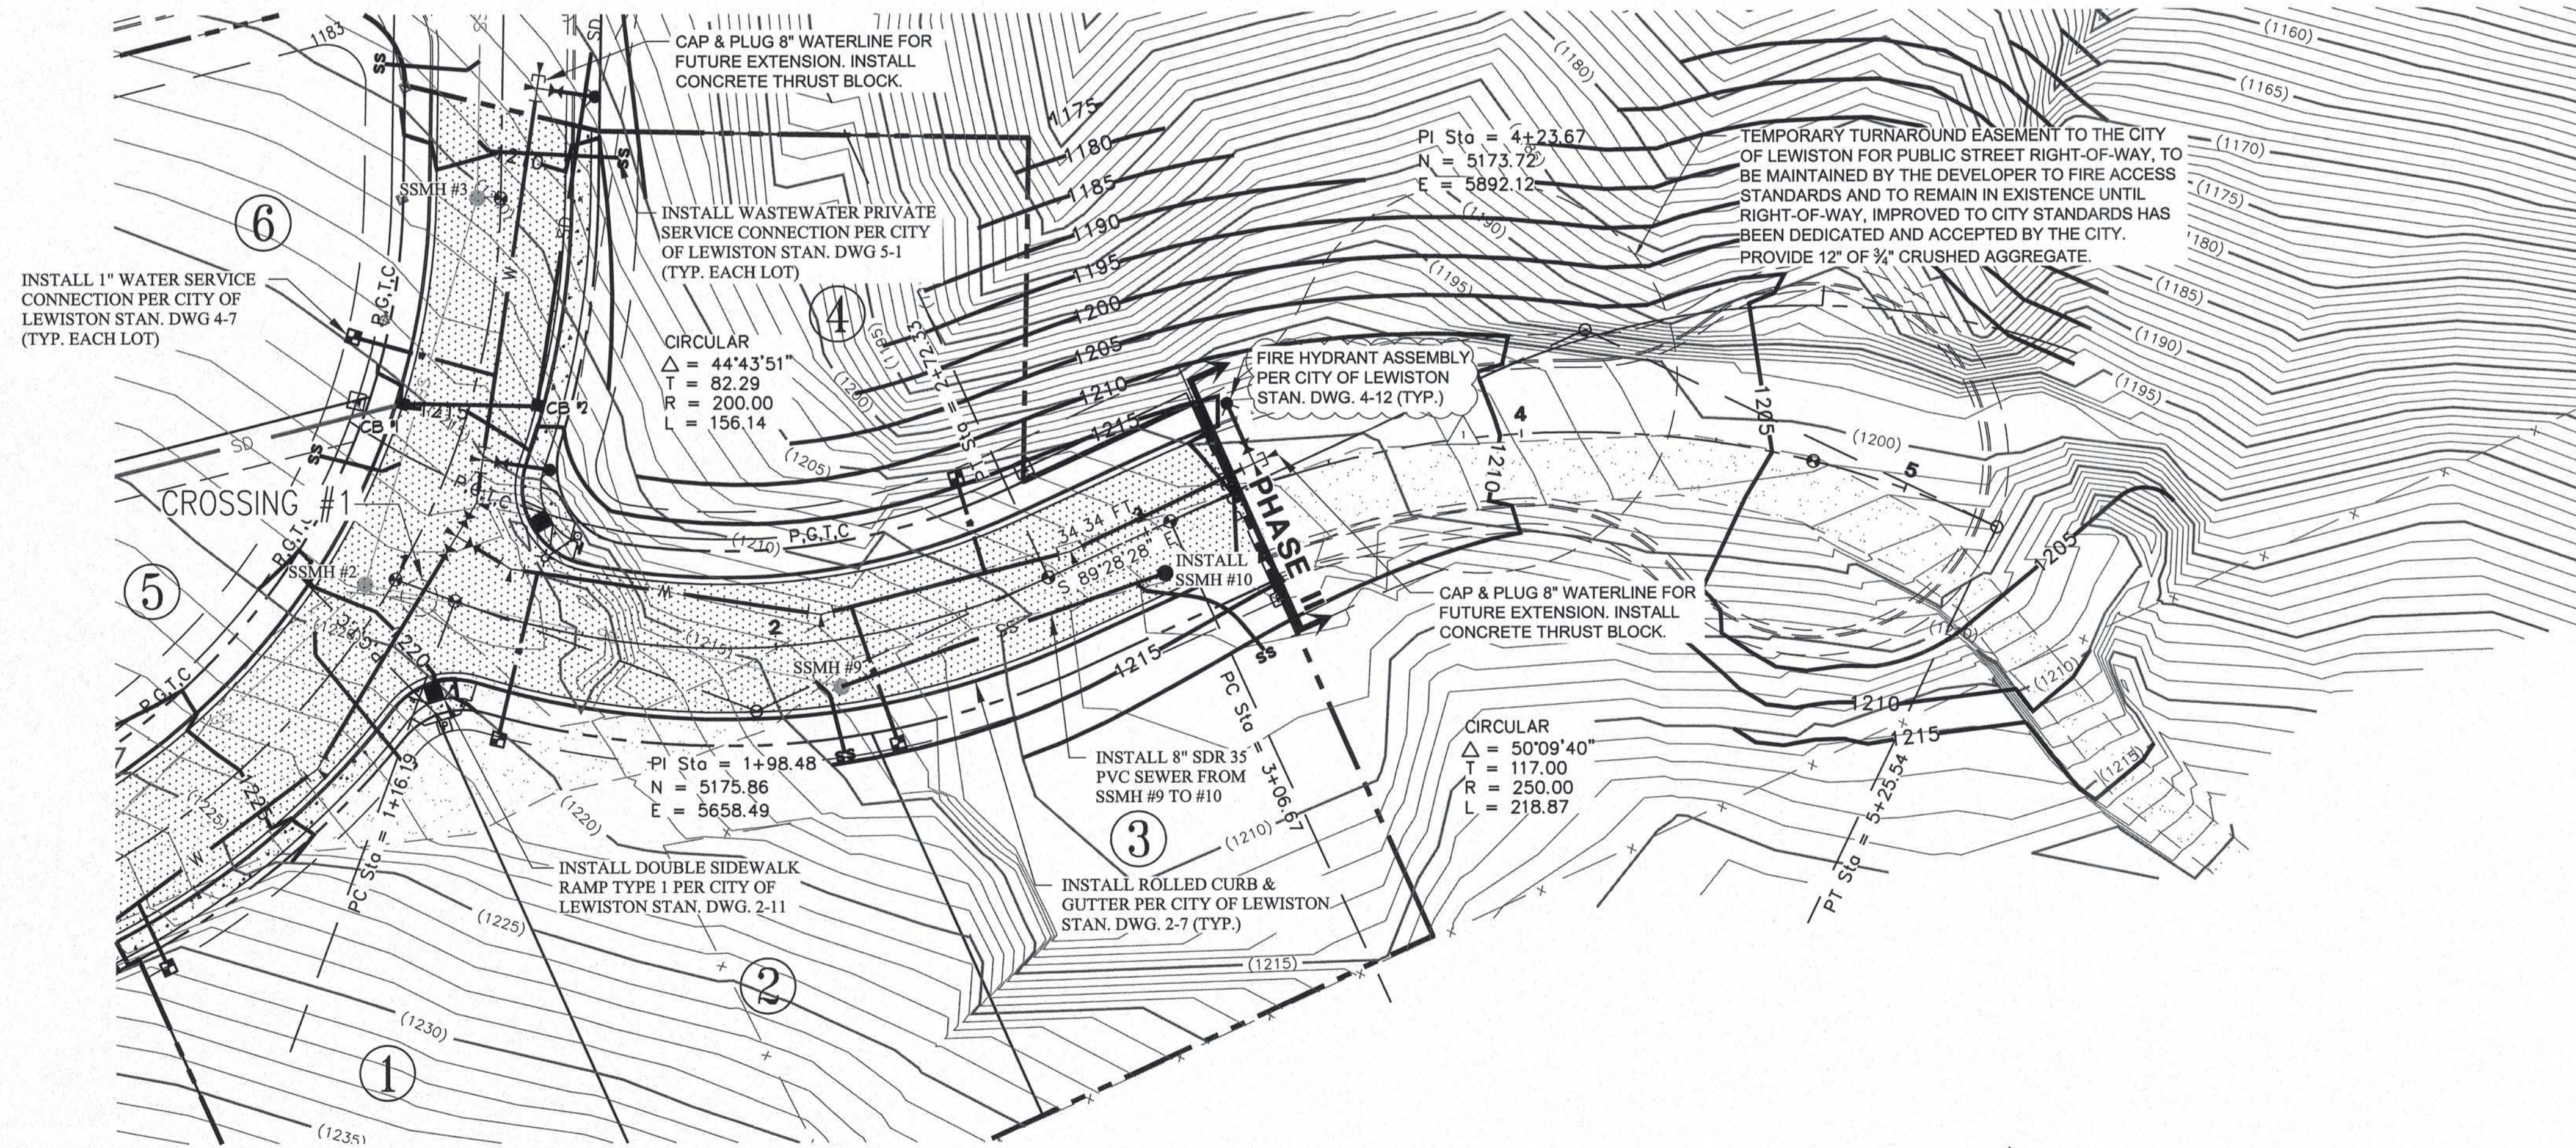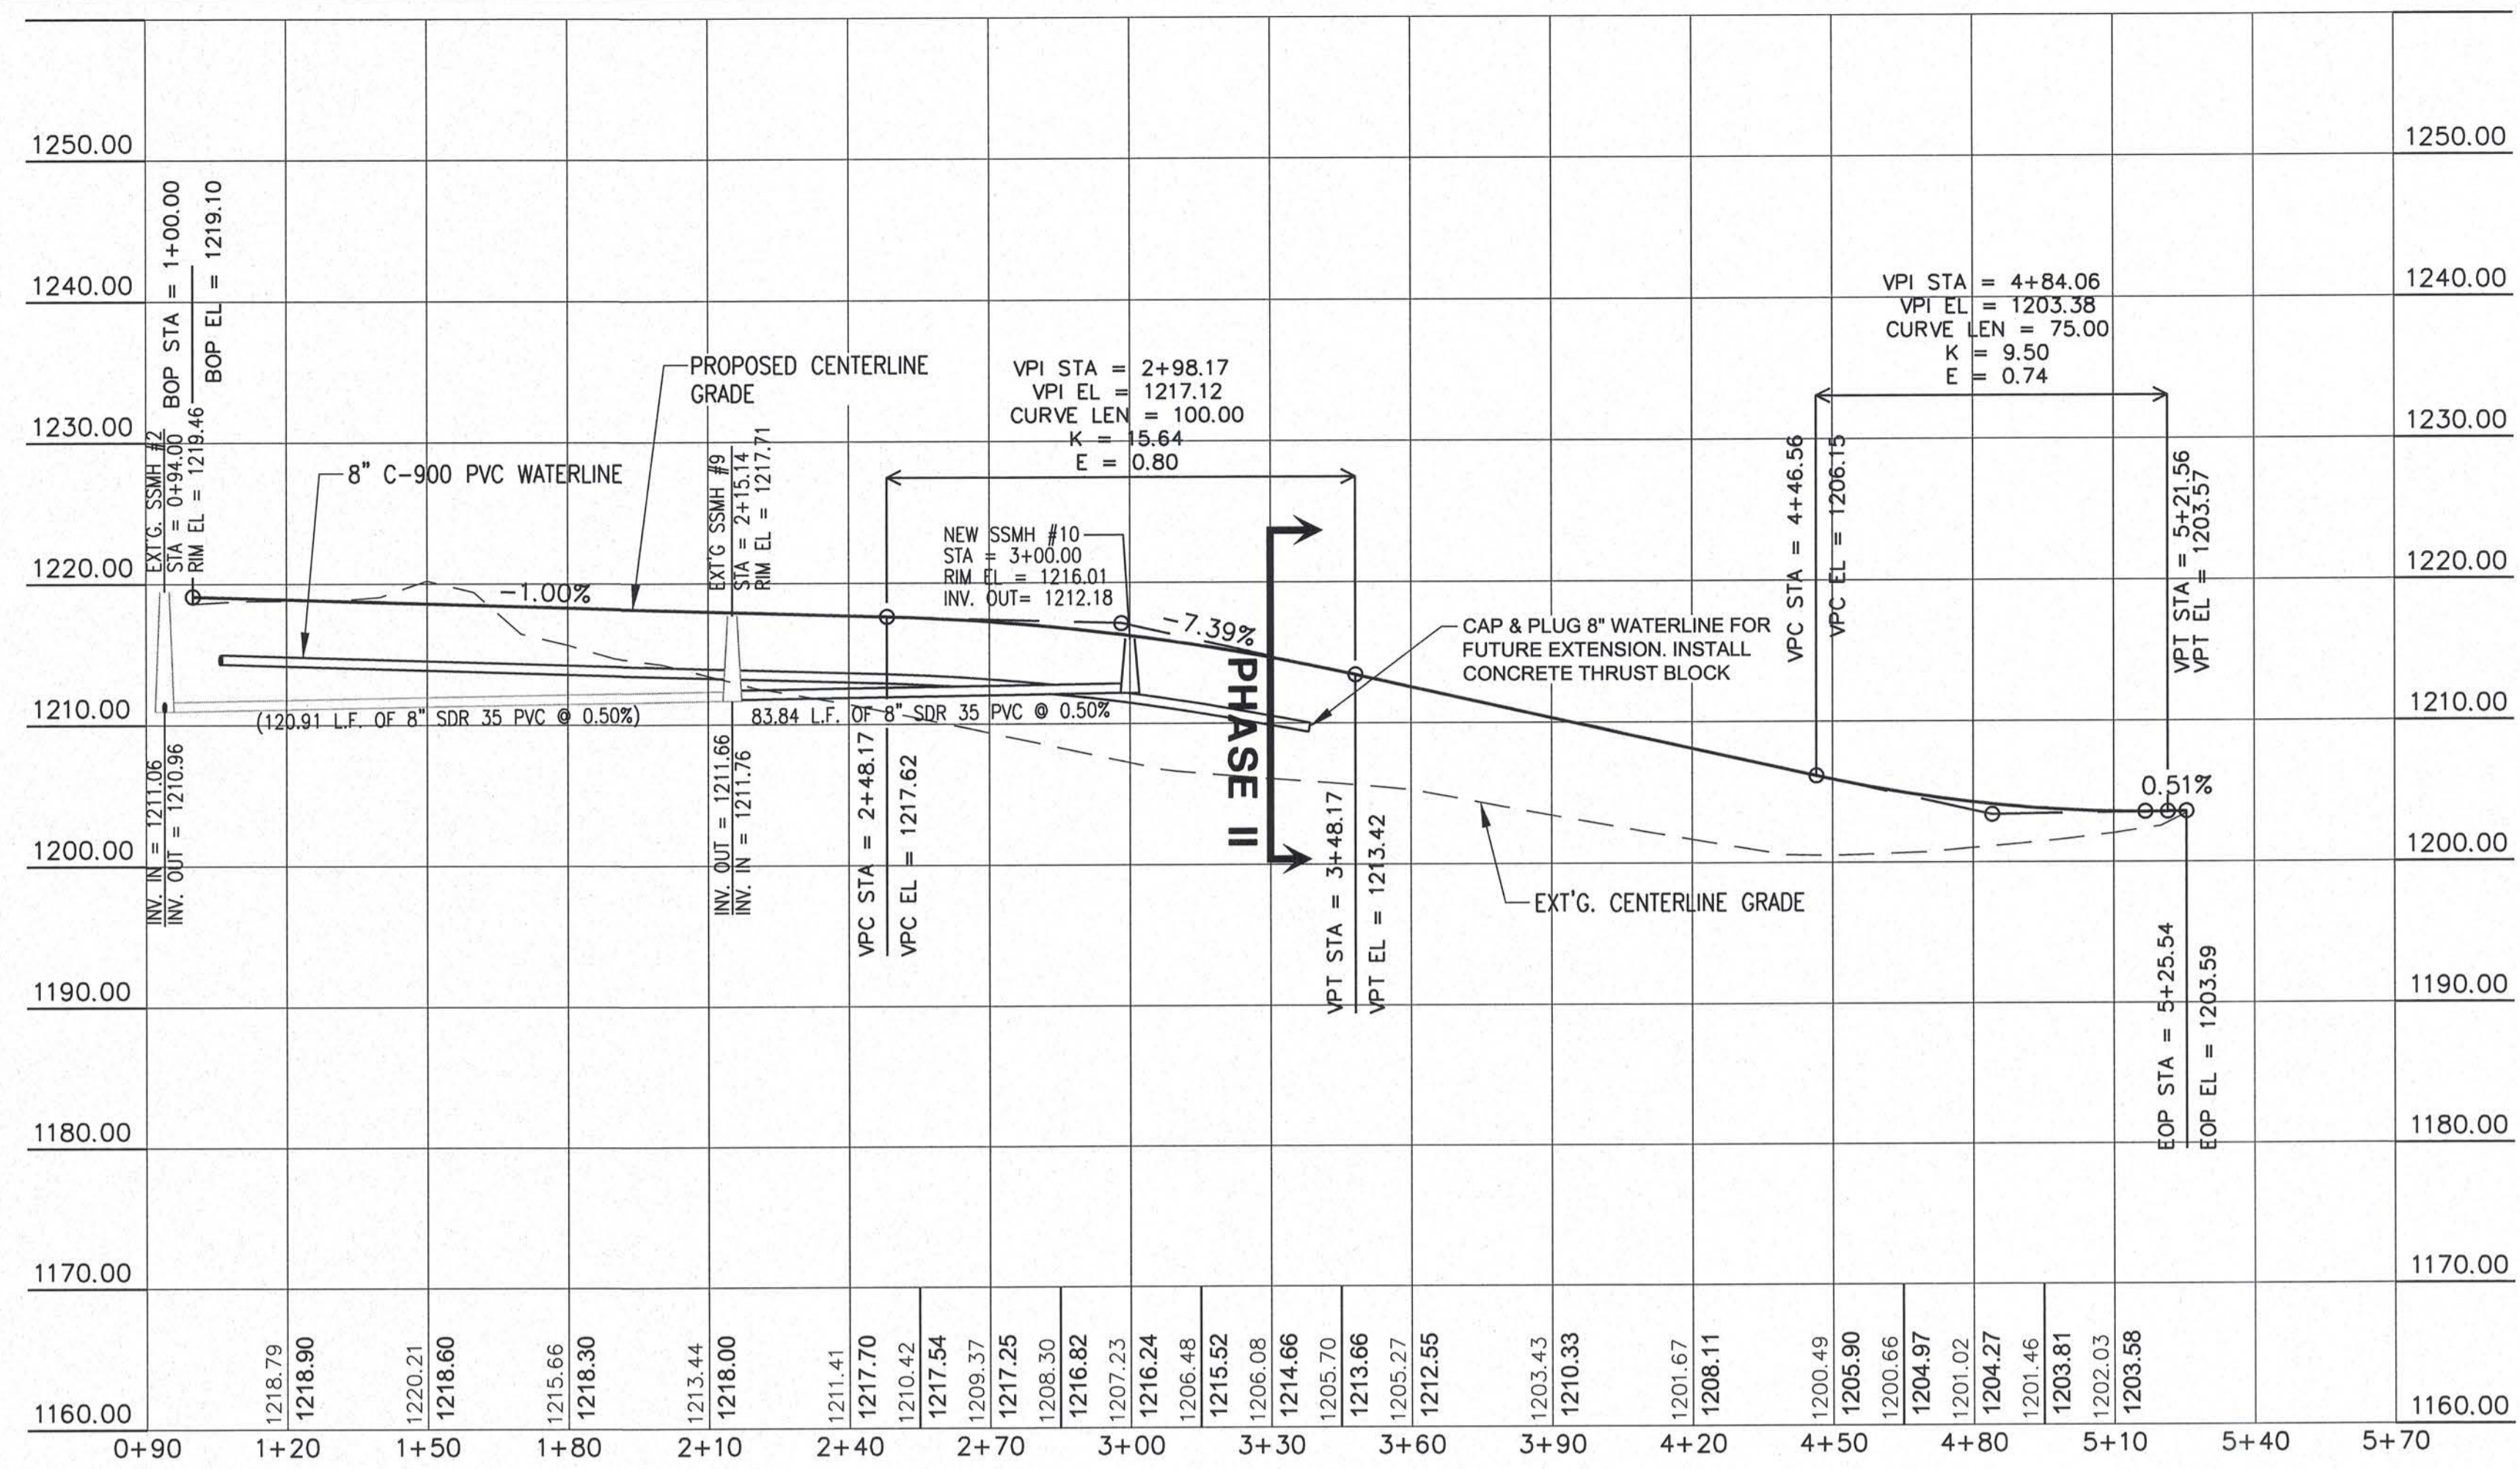

WATER & SEWER LATERAL NOTE:

WATER AND SEWER LATERALS TO EACH LOT SHALL BE LOCATED 5' MIN. FROM PROPERTY LINE. WHERE TRANSFORMERS OR UTILITY BOXES AREA SHOWN, LATERALS SHALL BE LOCATED 10' MIN. FROM PROPERTY LINE.

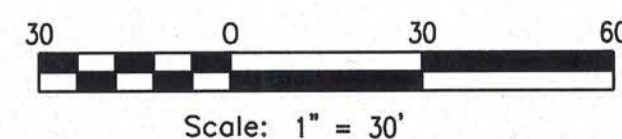

UTILITY CROSSING:
 CROSSING #1
 B.O.P. WATER = 1214.30
 T.O.P. SS = 1211.80
 SEPARATION = 2.50'



EASTWAY COURT PLAN & PROFILE
CRESTLINE CIRCLE DRIVE
VALLEY VISTA PUD
LEWISTON, ID. 83501

KELTIC ENGINEERING, INC.
 315 Adams Lane • Lewiston, Idaho 83501 • (208) 743-2135 • (208) 743-2136 fax
 Development • Planning • Design • Construction Management




DRAWN BY:	CHECKED BY:
MSR	EFH
DESIGNED BY:	EFH
DATE:	07/13/18
LAST REV:	11/08/18
PROJECT NO.	17-0089
SHEET NO.	C7 OF C14

No.	DATE	BY	DESCRIPTION
1	06/22/18	MSR	CITY COMMENTS 06/16/18

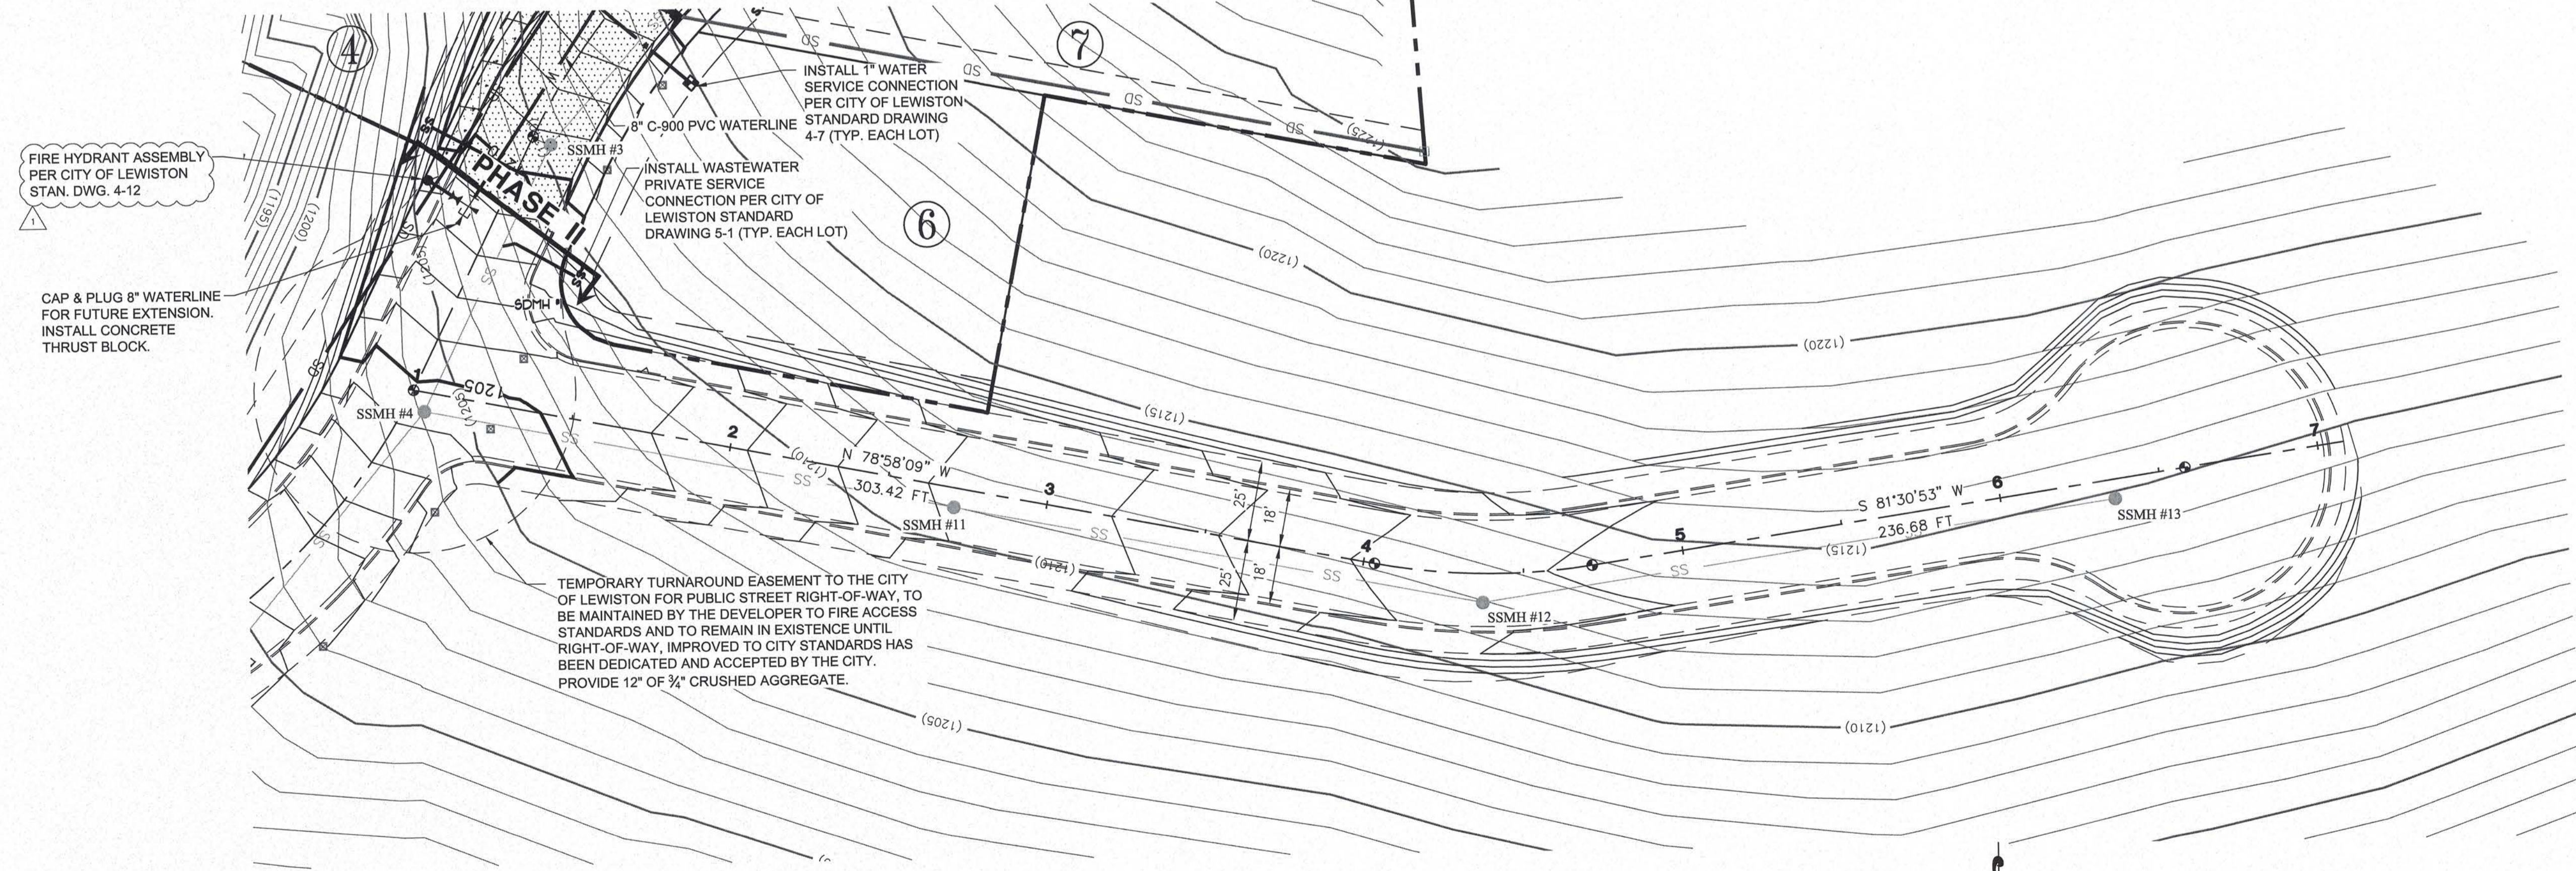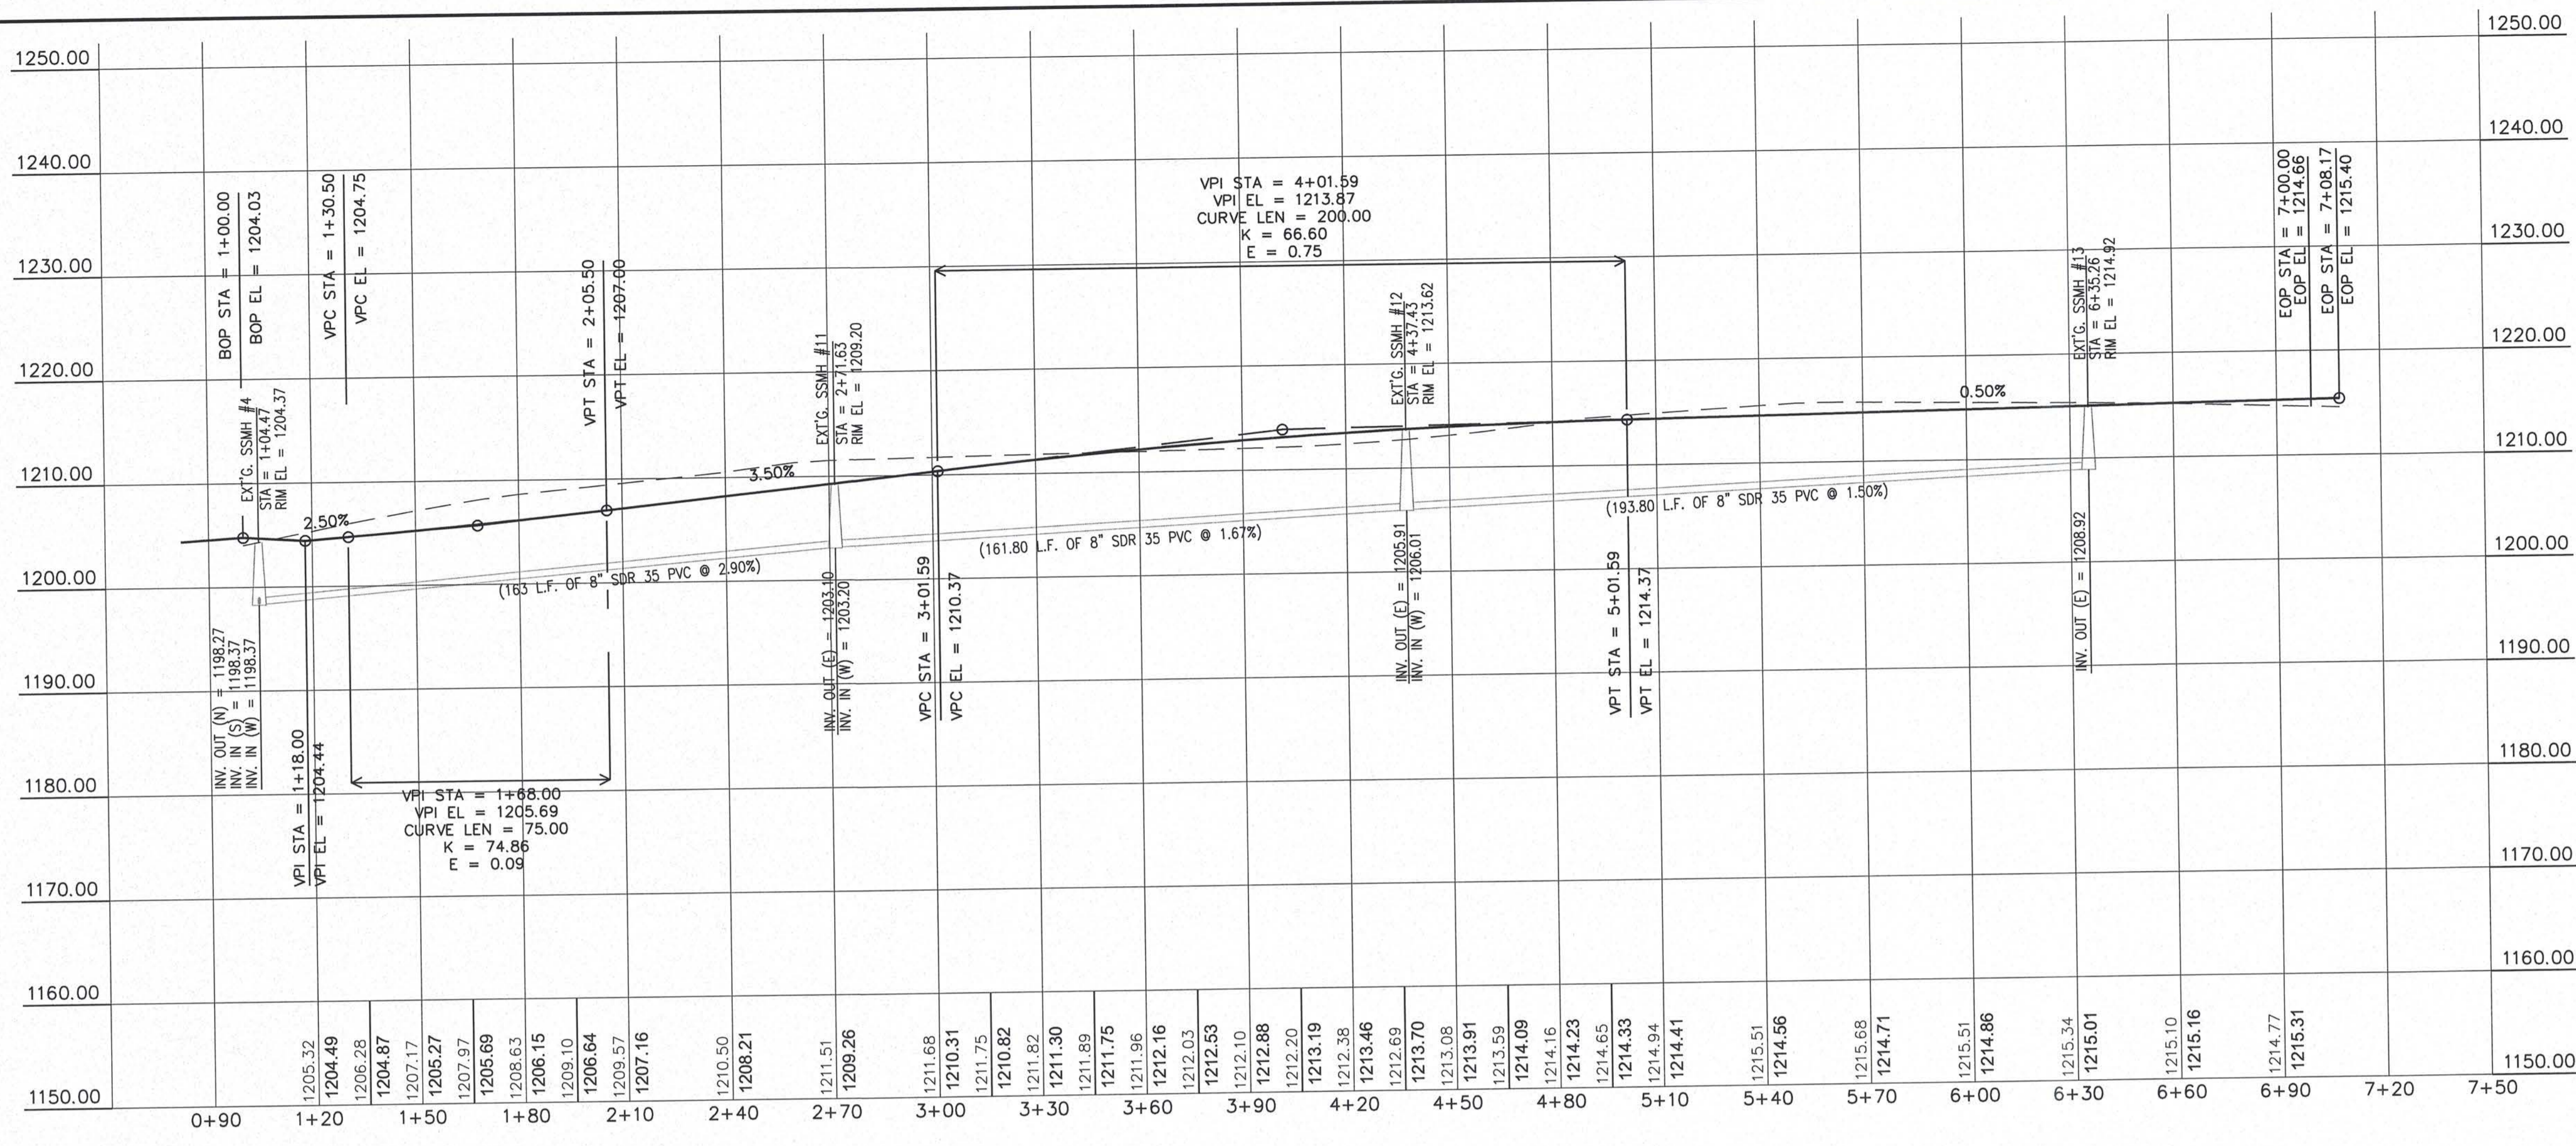

WESTWAY COURT STA. 1+00 TO 7+08.17

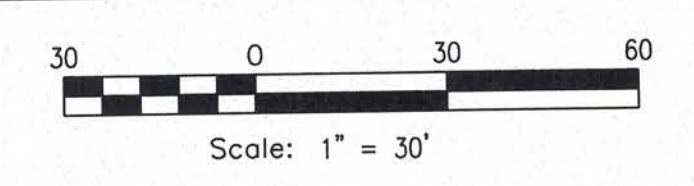



No.	DATE	BY	DESCRIPTION
1	08/22/18	MSR	CITY COMMENTS 08/16/18

WESTWAY COURT PLAN & PROFILE
 CRESTLINE CIRCLE DRIVE
 VALLEY VISTA PUD
 LEWISTON, IDAHO 83501


KELTIC ENGINEERING, INC.
 315 Adams Lane • Lewiston, Idaho 83501 • (208) 743-2135 • (208) 743-2136 fax
 ☐ Development ☐ Planning ☐ Design ☐ Construction Management

PROFESSIONAL ENGINEER
 REGISTERED
 6064
 STATE OF IDAHO
 ERIC HASENBERG


DRAWN BY: MSR	CHECKED BY: EFH
DESIGNED BY: EFH	
DATE: 07/13/18	
LAST REV: 11/08/18	
PROJECT NO: 17-0089	
SHEET NO: C8 OF C14	

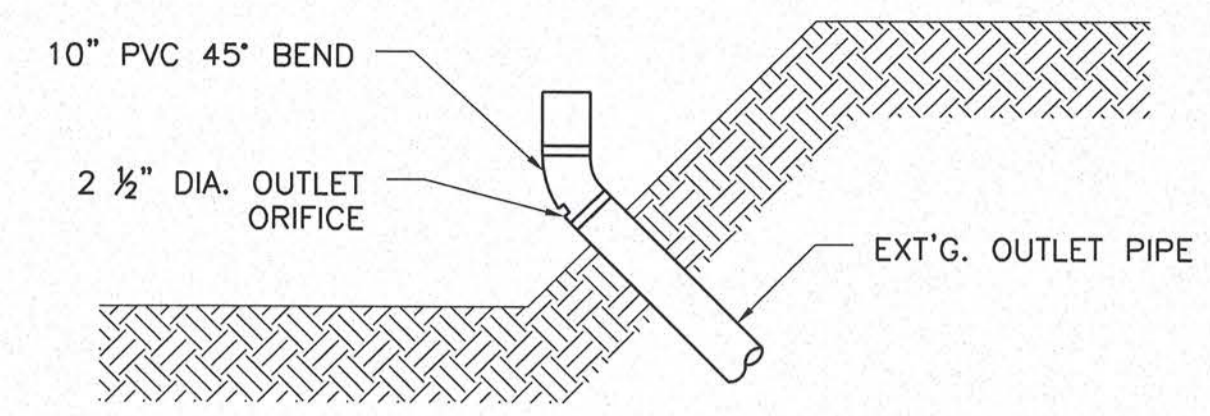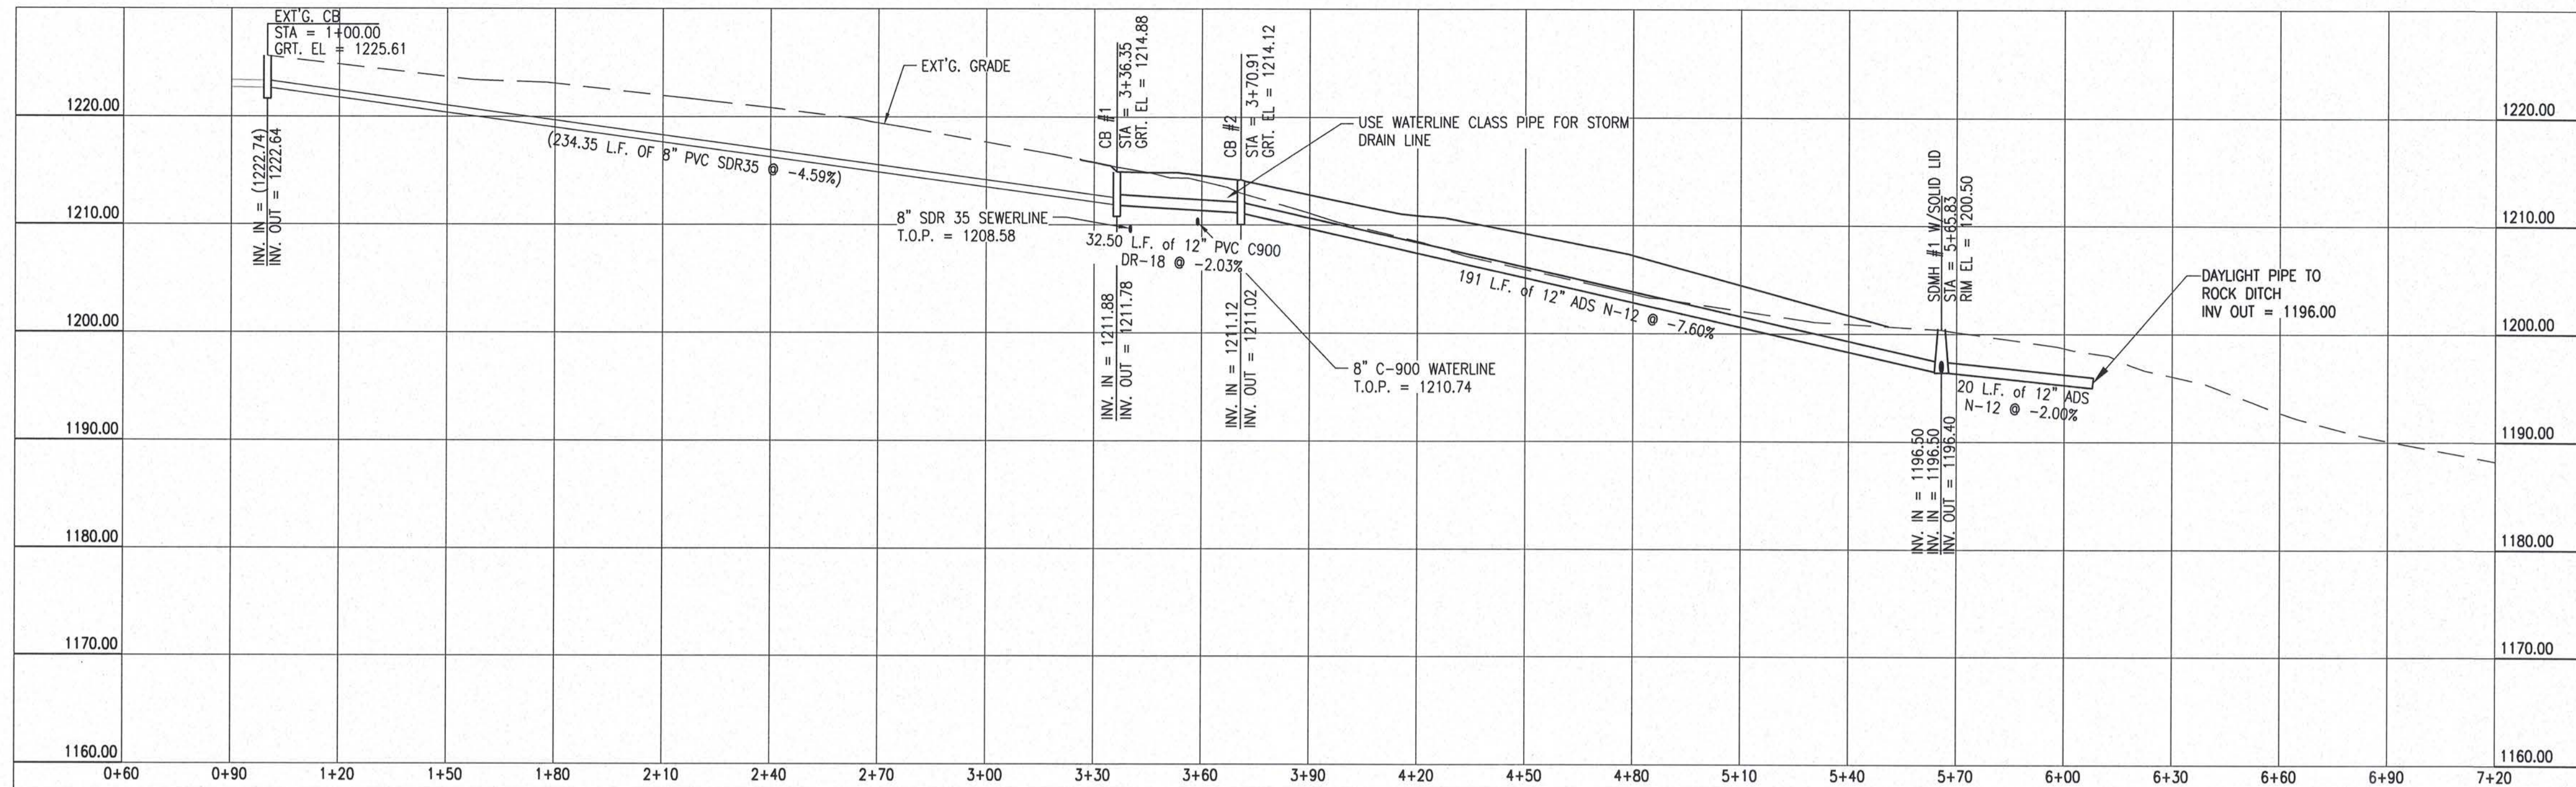


POND OUTLET DETAIL
NOT TO SCALE

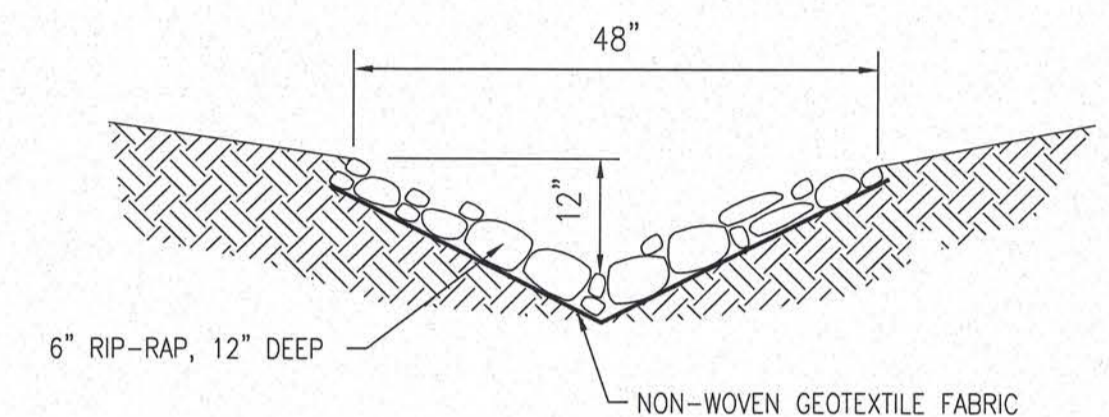

ROCK DITCH
NOT TO SCALE

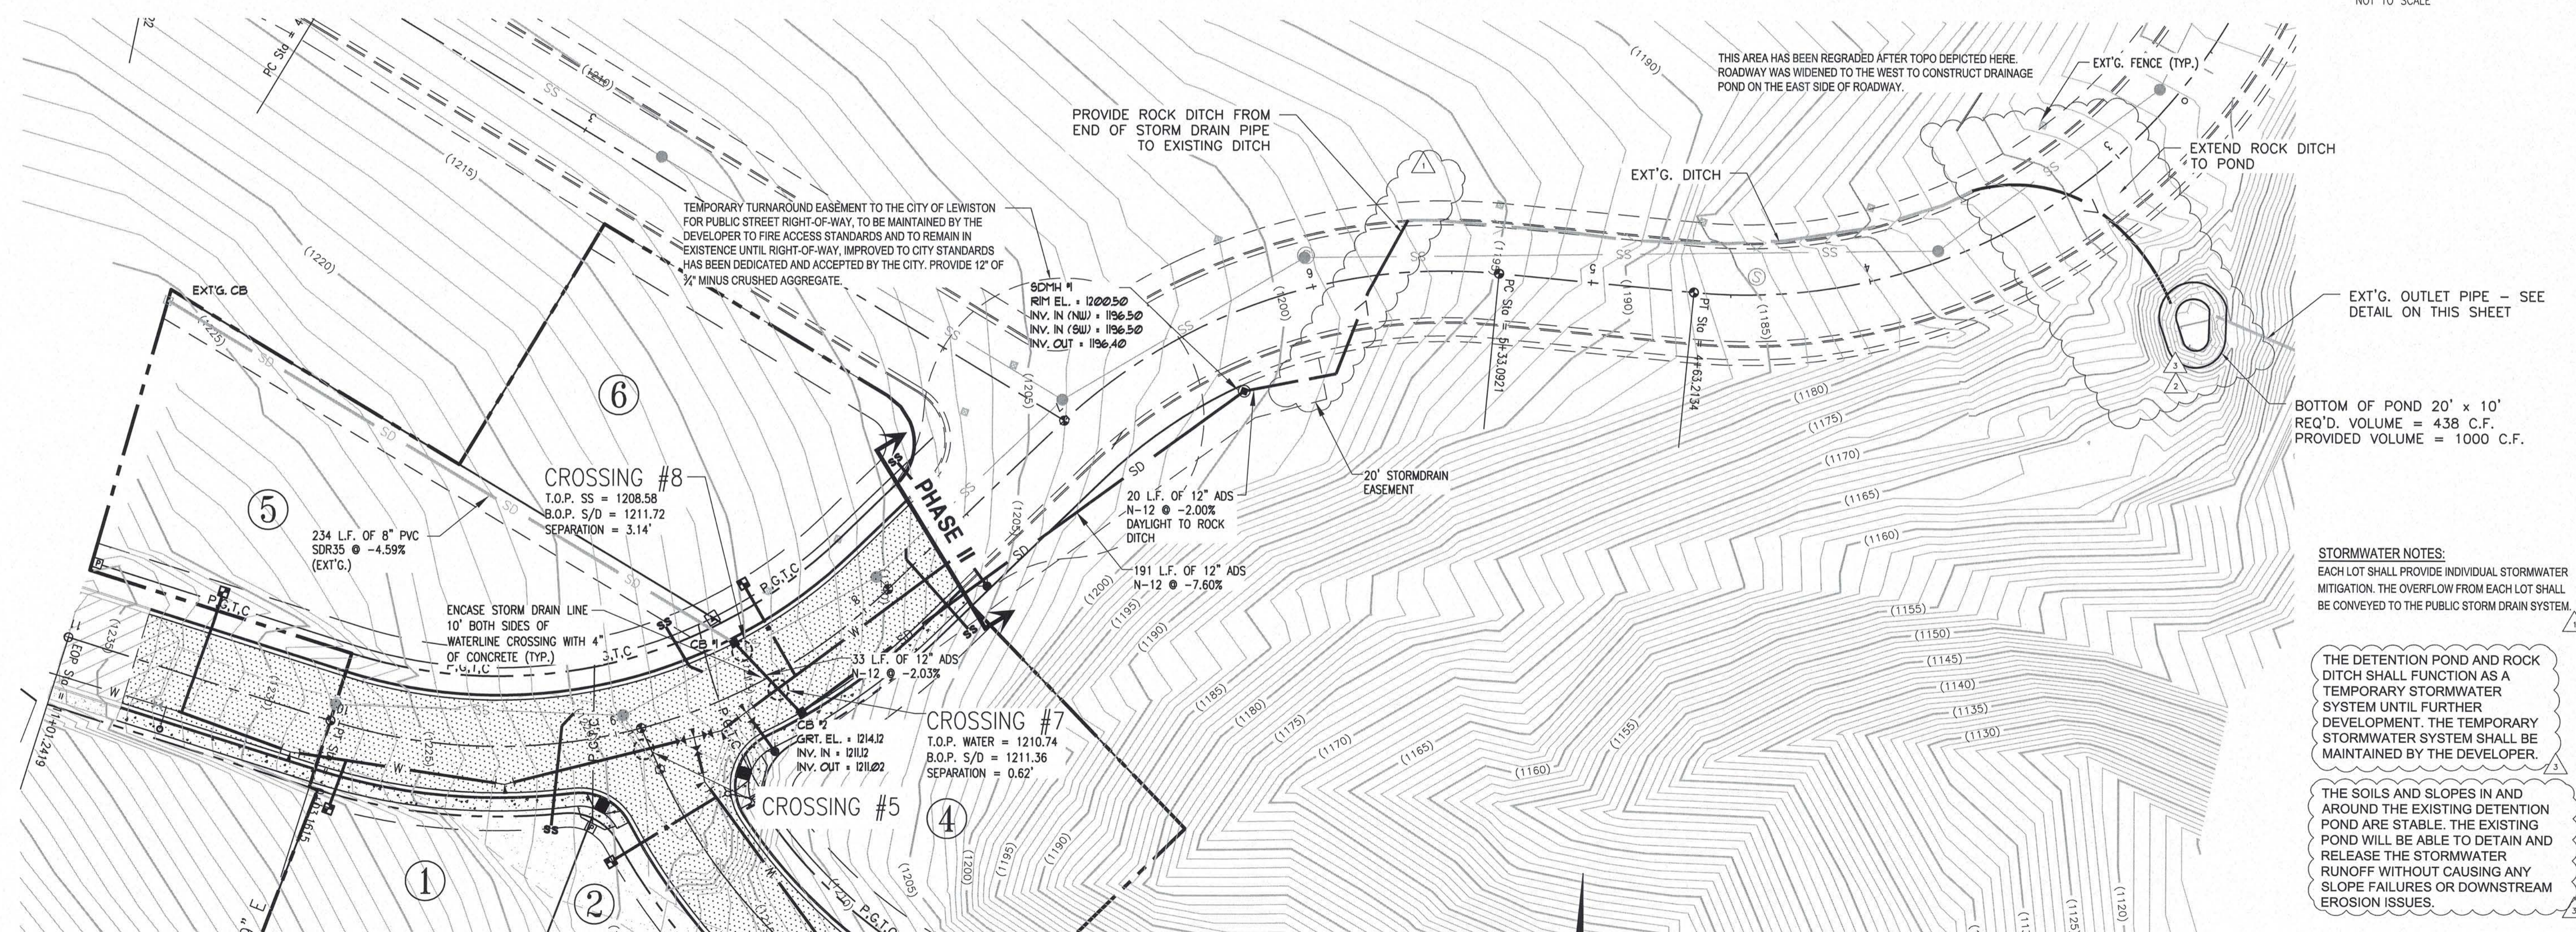

**STORMDRAIN PLAN AND PROFILES
EXT'G. CB TO AREA DRAIN TYPE III**

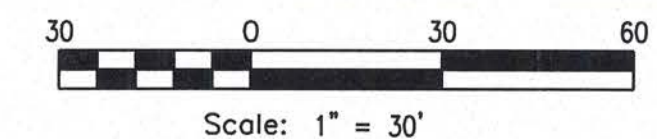

STORMWATER NOTES:
EACH LOT SHALL PROVIDE INDIVIDUAL STORMWATER MITIGATION. THE OVERFLOW FROM EACH LOT SHALL BE CONVEYED TO THE PUBLIC STORM DRAIN SYSTEM.

THE DETENTION POND AND ROCK DITCH SHALL FUNCTION AS A TEMPORARY STORMWATER SYSTEM UNTIL FURTHER DEVELOPMENT. THE TEMPORARY STORMWATER SYSTEM SHALL BE MAINTAINED BY THE DEVELOPER.

THE SOILS AND SLOPES IN AND AROUND THE EXISTING DETENTION POND ARE STABLE. THE EXISTING POND WILL BE ABLE TO DETAIN AND RELEASE THE STORMWATER RUNOFF WITHOUT CAUSING ANY SLOPE FAILURES OR DOWNSTREAM EROSION ISSUES.


No.	DATE	BY	DESCRIPTION
1	09/22/18	MSR	CITY COMMENTS 08/16/18
2	09/14/18	MSR	REVISED STORMWATER - ADDED DETENTION POND
3	11/09/18	MSR	CITY COMMENTS

STORMDRAIN PLAN & PROFILES
CRESTLINE CIRCLE DRIVE
VALLEY VISTA PUD
LEWISTON, IDAHO 83501


KELTIC ENGINEERING, INC.
315 Adams Lane ◊ Lewiston, Idaho 83501 ◊ (208) 745-2135 ◊ (208) 745-2136 fax
◊ Development ◊ Planning ◊ Design ◊ Construction Management

PROFESSIONAL ENGINEER
REGISTERED
6064
STATE OF IDAHO
ERIC HASENBERG

DRAWN BY: MSR
DESIGNED BY: EFH
CHECKED BY: EFH
DATE: 07/13/18
LAST REV.: 11/09/18
PROJECT NO.: 17-0089
SHEET NO.: **C9 OF C14**

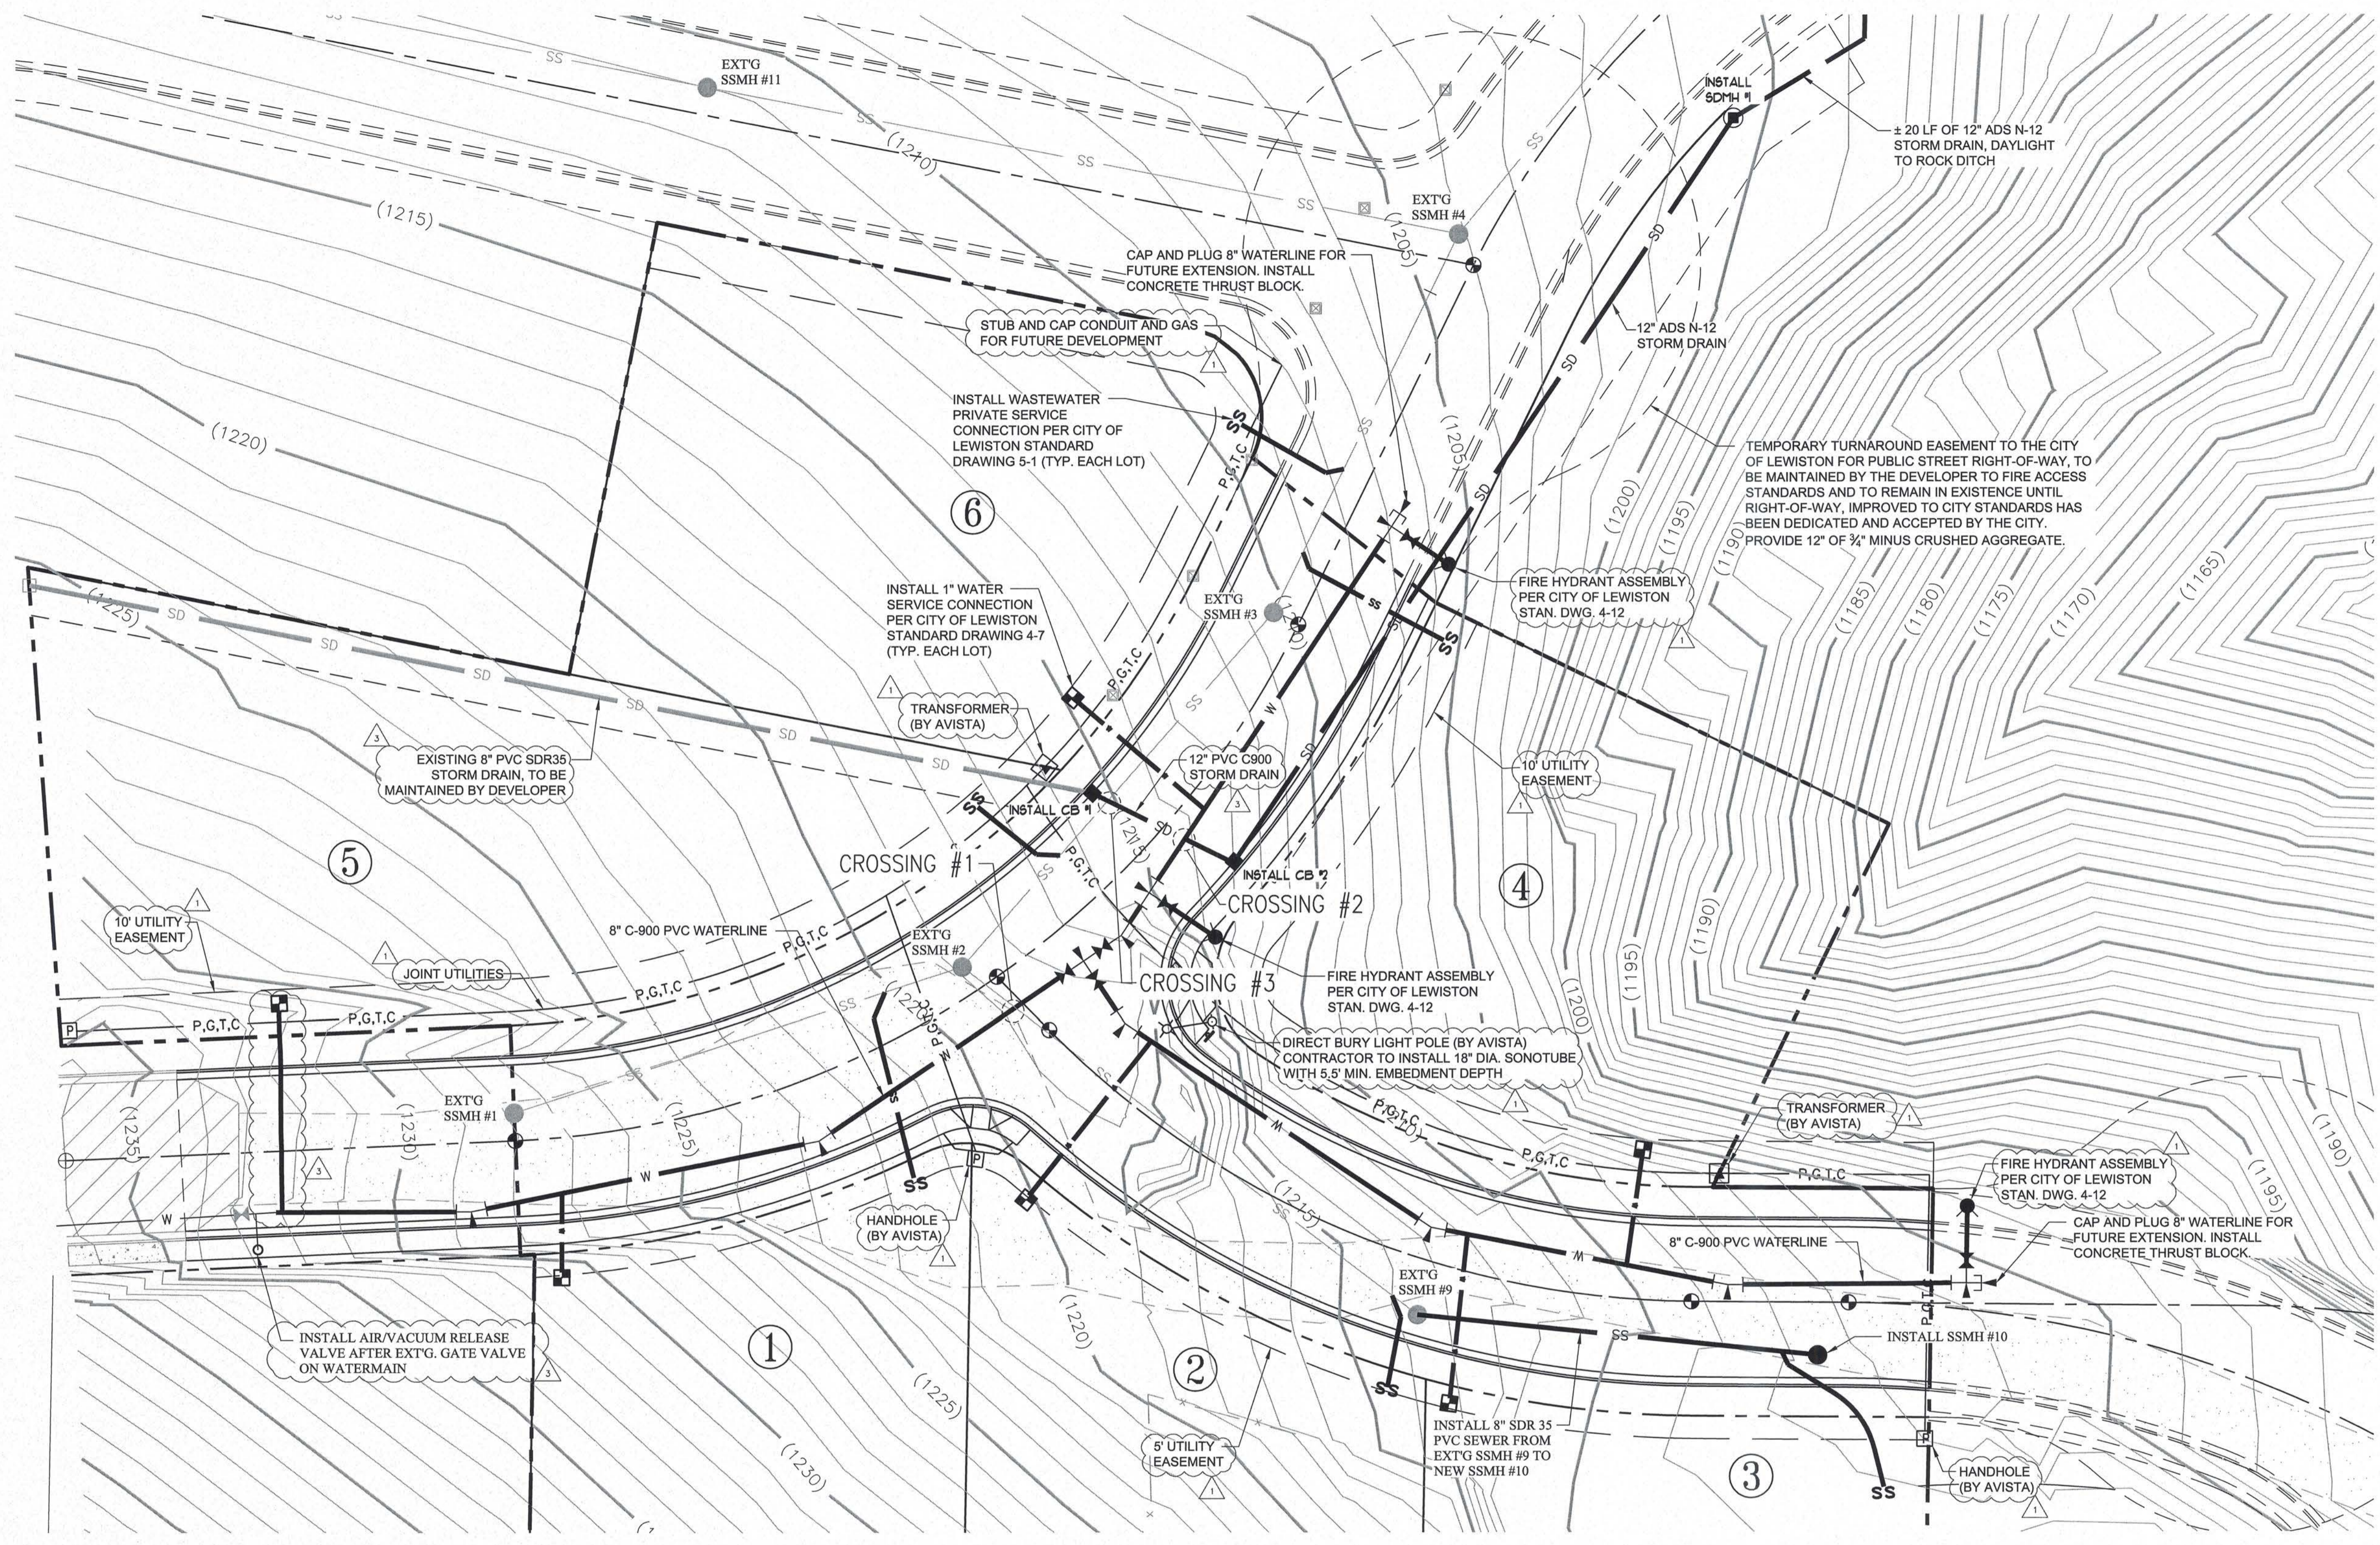

OVERALL UTILITIES

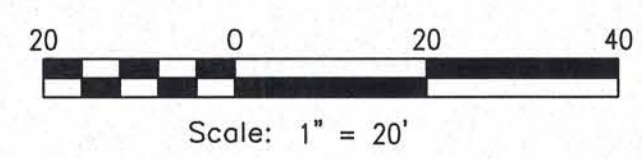

UTILITY CROSSINGS:

- CROSSING #1
B.O.P. WATER = 1214.30
T.O.P. SS = 1211.80
SEPARATION = 2.50'
- CROSSING #2
T.O.P. WATER = 1210.74
B.O.P. S/D = 1211.36
SEPARATION = 0.62'
- CROSSING #3
T.O.P. SS = 1208.58
B.O.P. S/D = 1211.72
SEPARATION = 3.14'


WATER & SEWER LATERAL NOTE:

WATER AND SEWER LATERALS TO EACH LOT SHALL BE LOCATED 5' MIN. FROM PROPERTY LINE. WHERE TRANSFORMERS OR UTILITY BOXES ARE SHOWN, LATERALS SHALL BE LOCATED 10' MIN. FROM PROPERTY LINE.

No.	DATE	BY	DESCRIPTION
1	08/22/18	MSF	CITY COMMENTS 08/16/18
2	11/08/18	TML	CITY COMMENTS

OVERALL UTILITIES
 CRESTLINE CIRCLE DRIVE
 VALLEY VISTA PUD
 LEWISTON, ID. 83501








KELTIC ENGINEERING, INC.
 141 9th Street • Suite 2 • Lewiston, Idaho 83501 • (208) 743-2135 • (208) 743-2136 fax
 ☛ Development ☛ Planning ☛ Design ☛ Construction Management

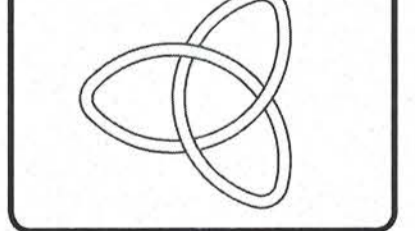

DRAWN BY:	TMVL	CHECKED BY:	EFH
DESIGNED BY:	EFH	DATE:	07/13/18
LAST REV:	11/08/18	PROJECT NO.:	17-0089
SHEET NO.:	C10	OF	C14



CALL 2 BUSINESS DAYS IN ADVANCE BEFORE YOU DIG, GRADE, OR EXCAVATE FOR THE MARKING OF UNDERGROUND MEMBER UTILITIES

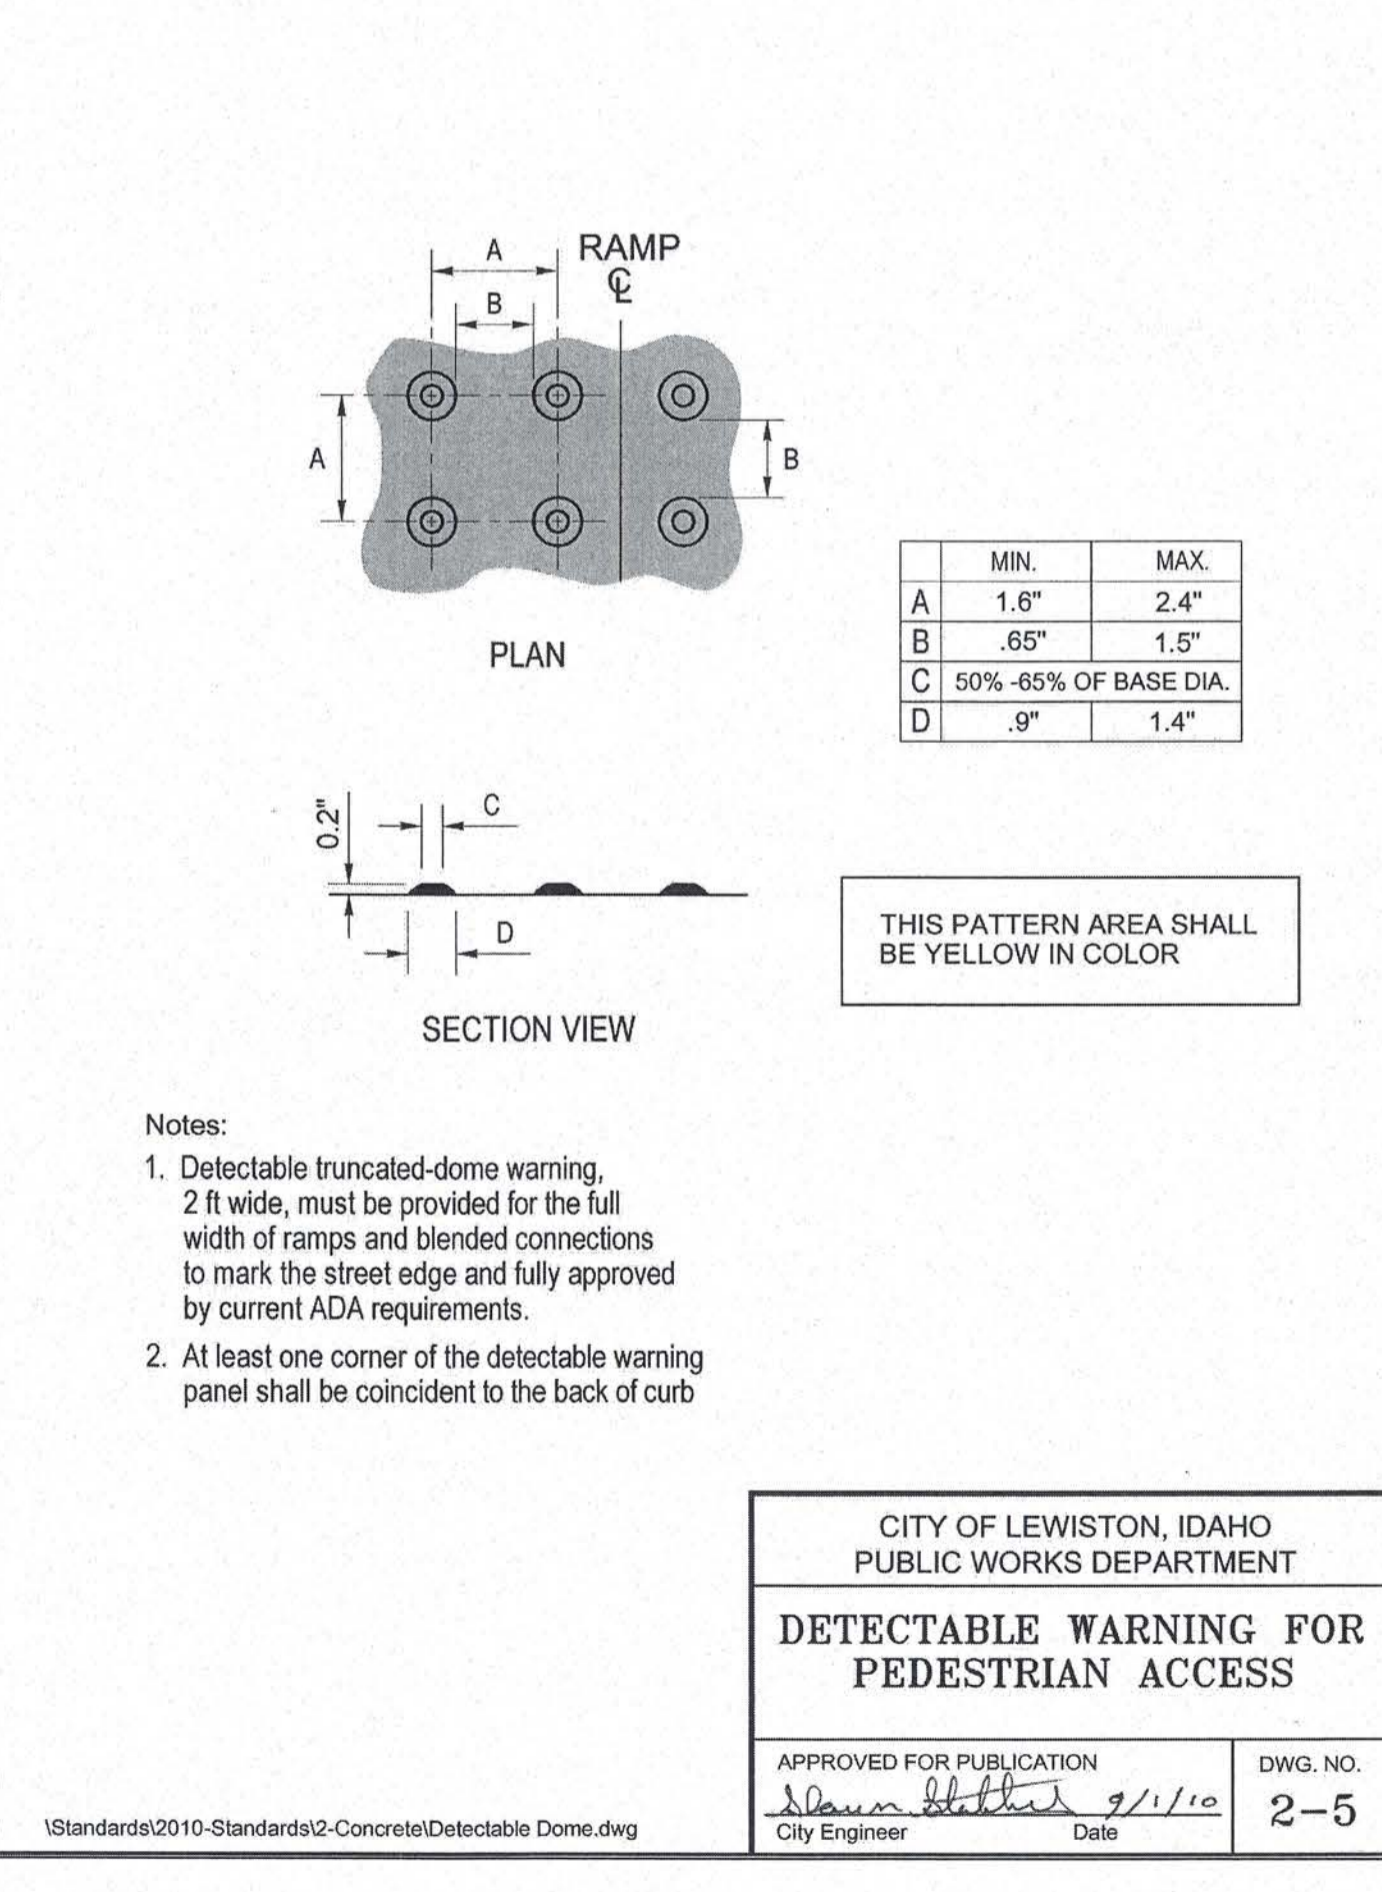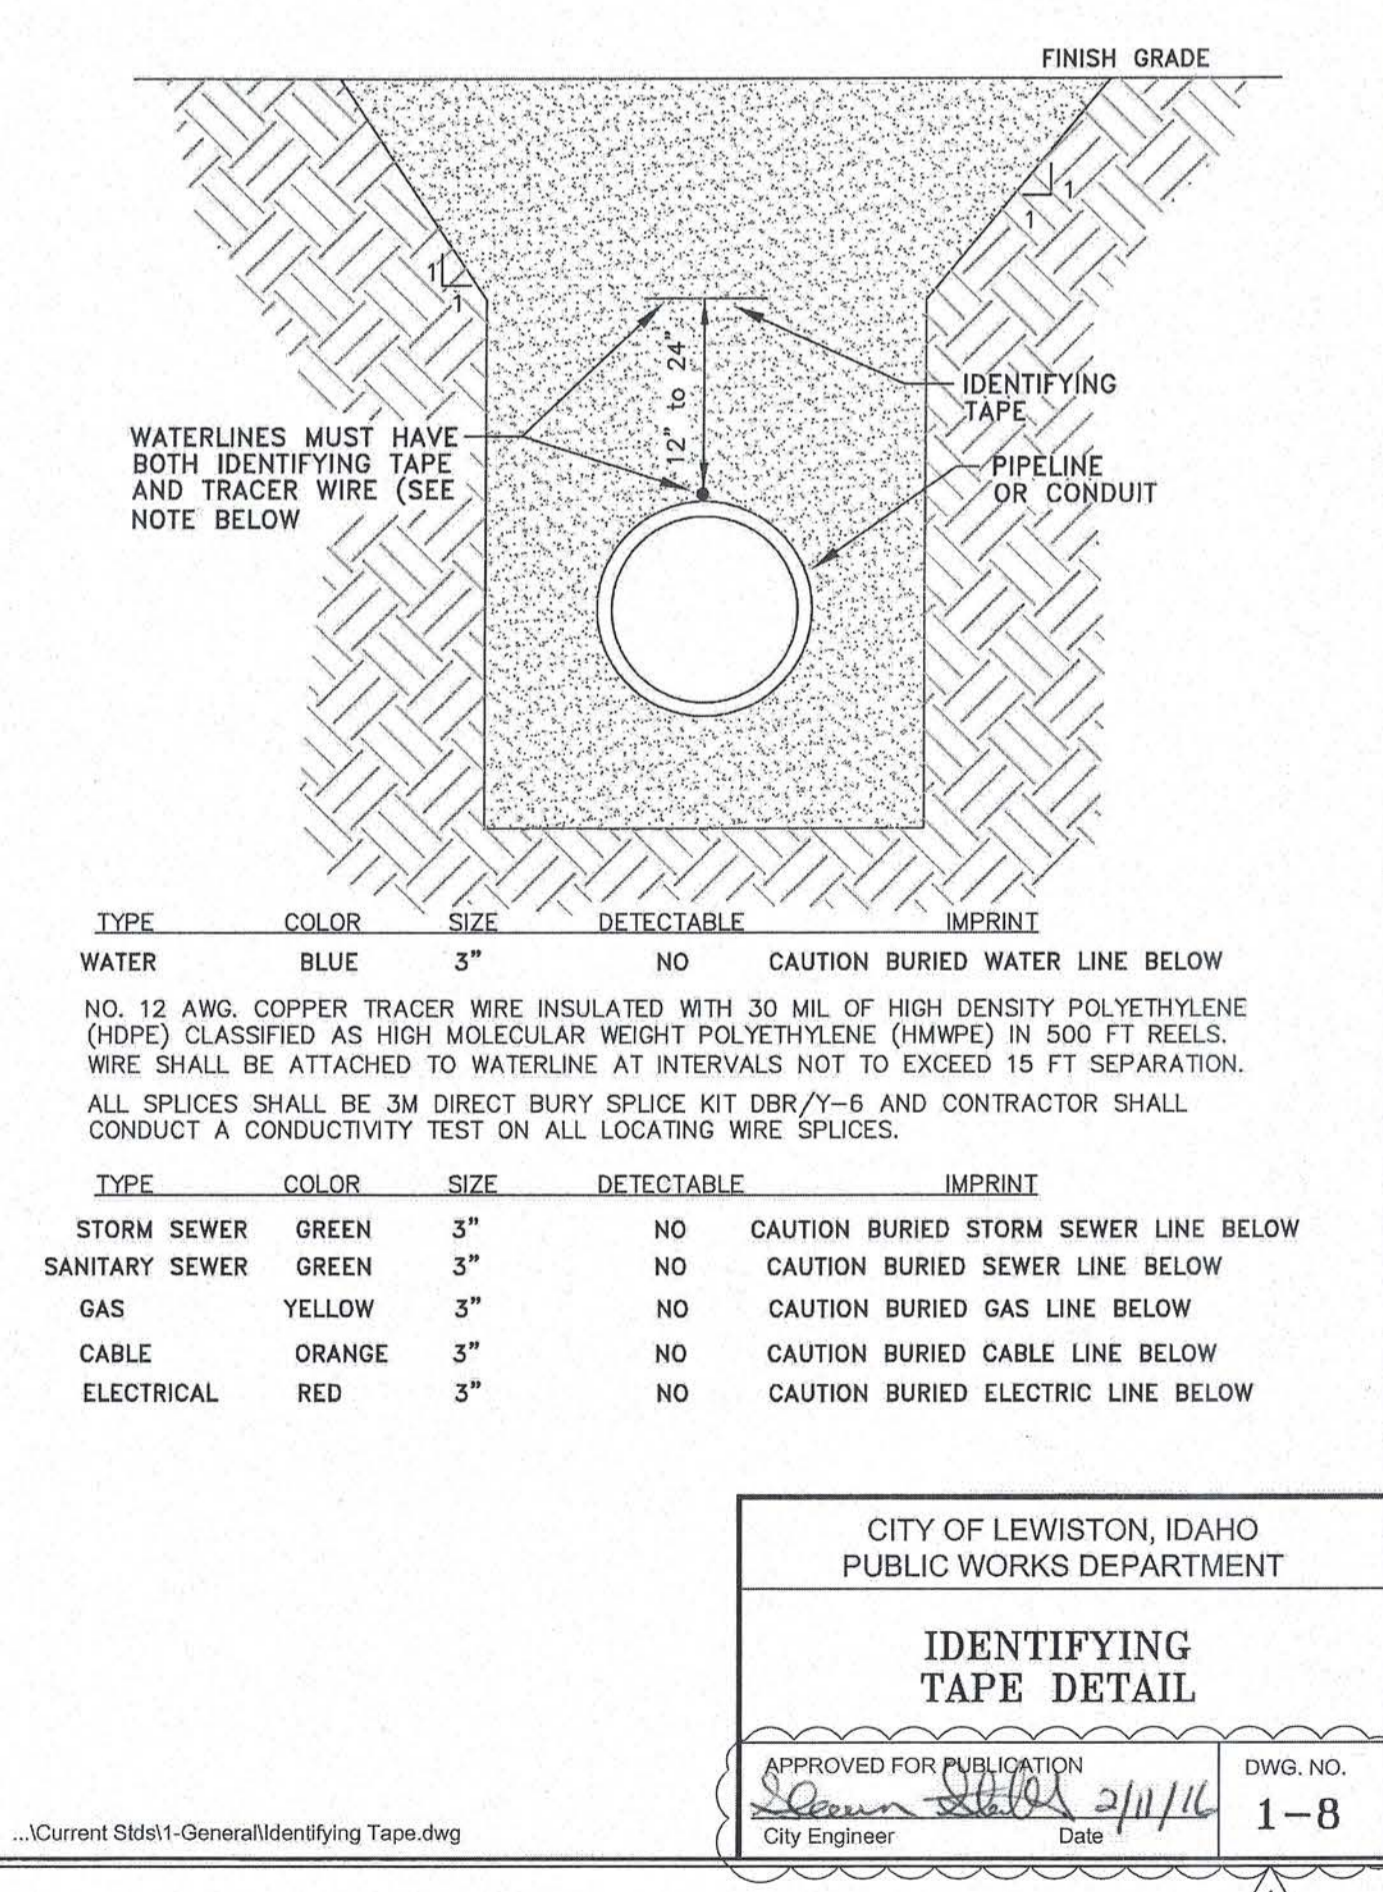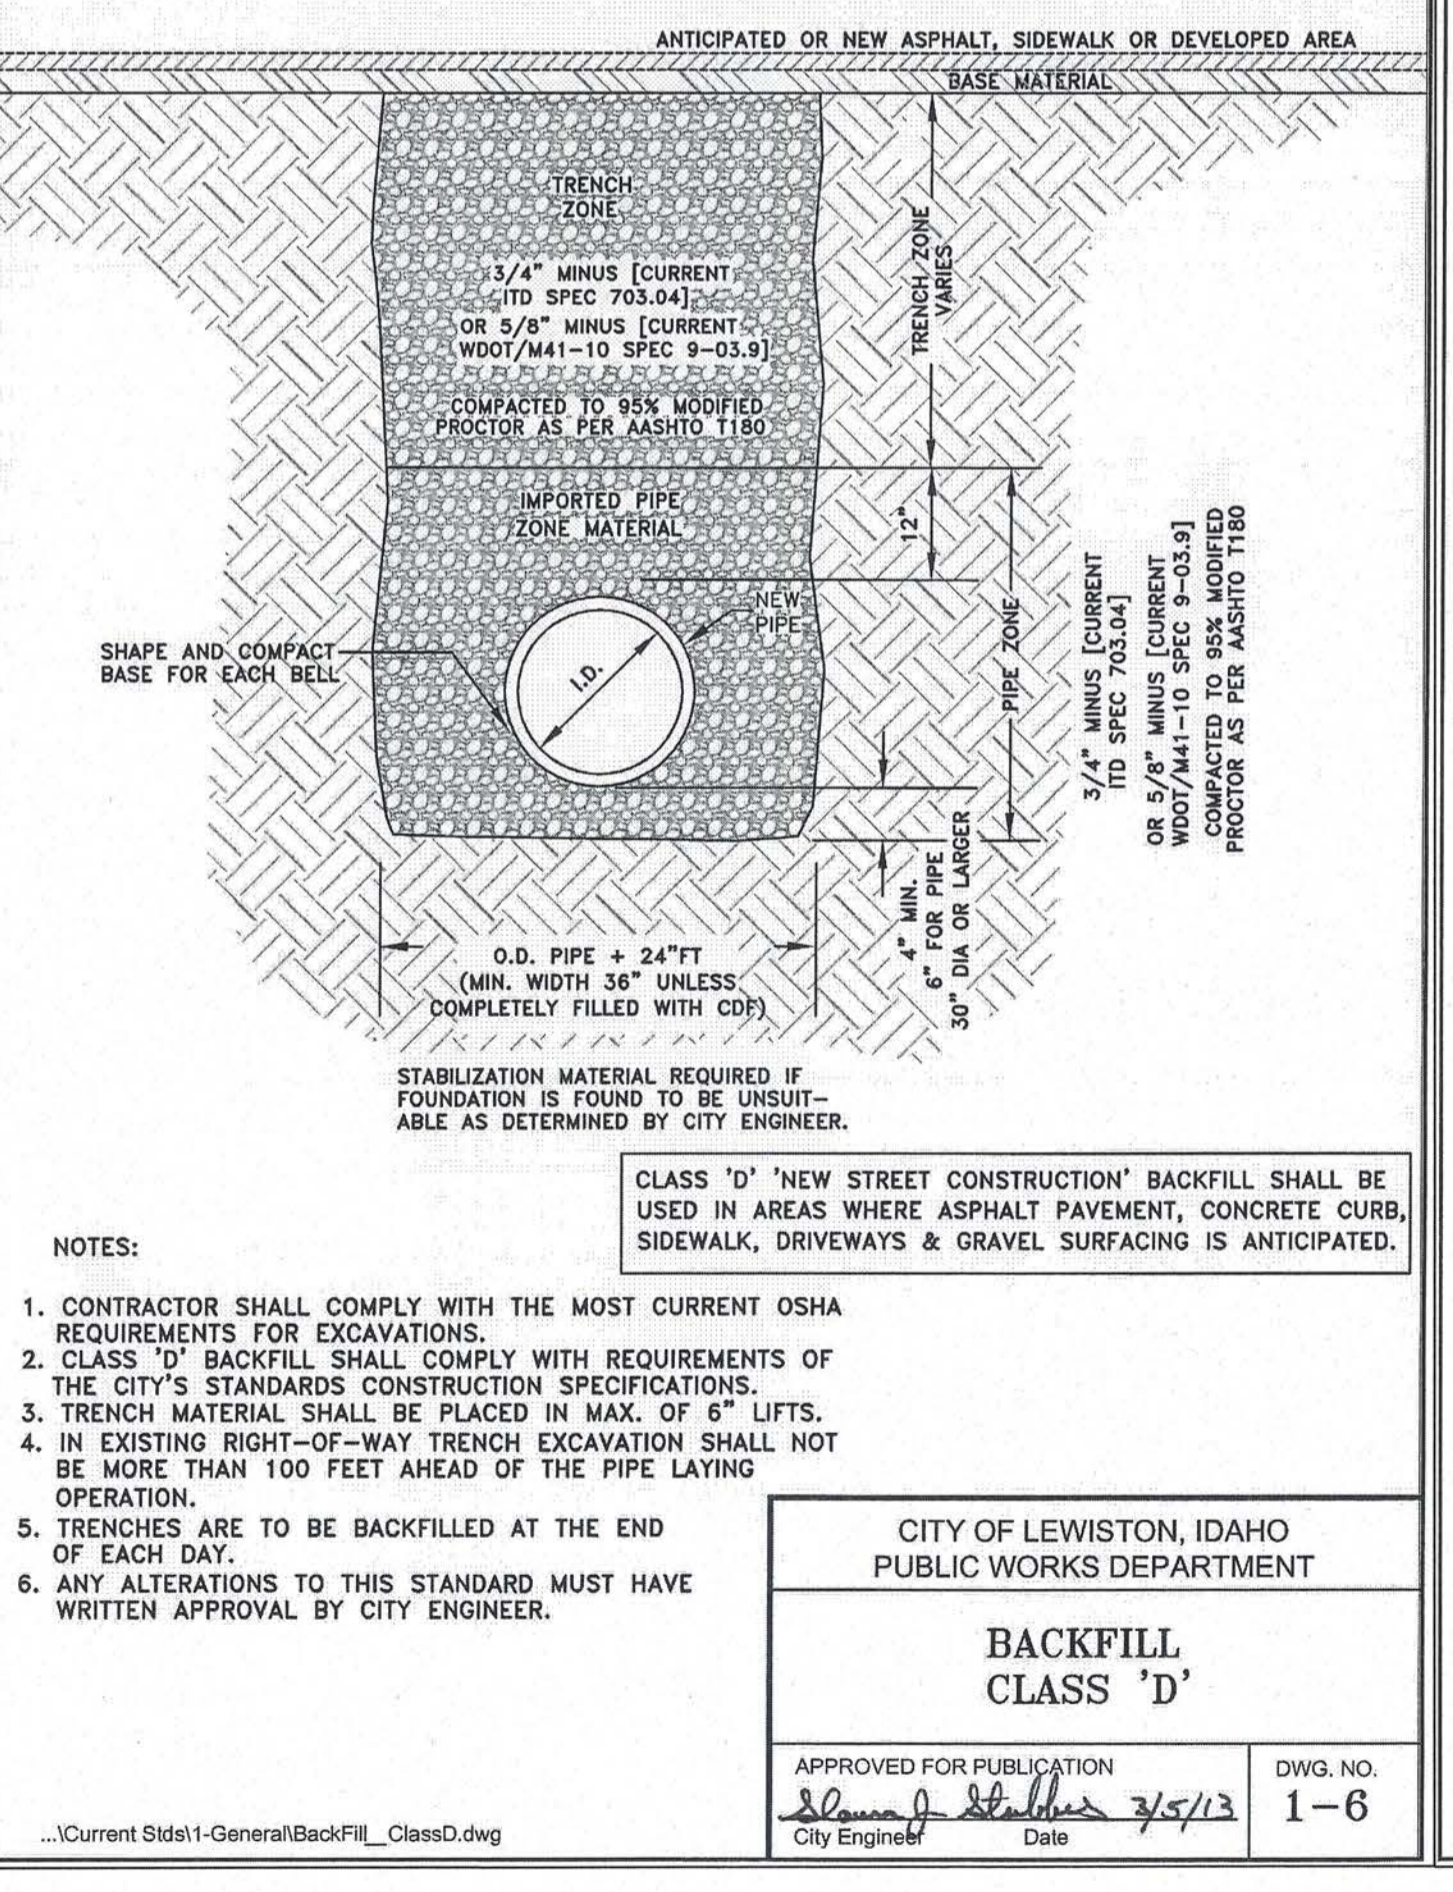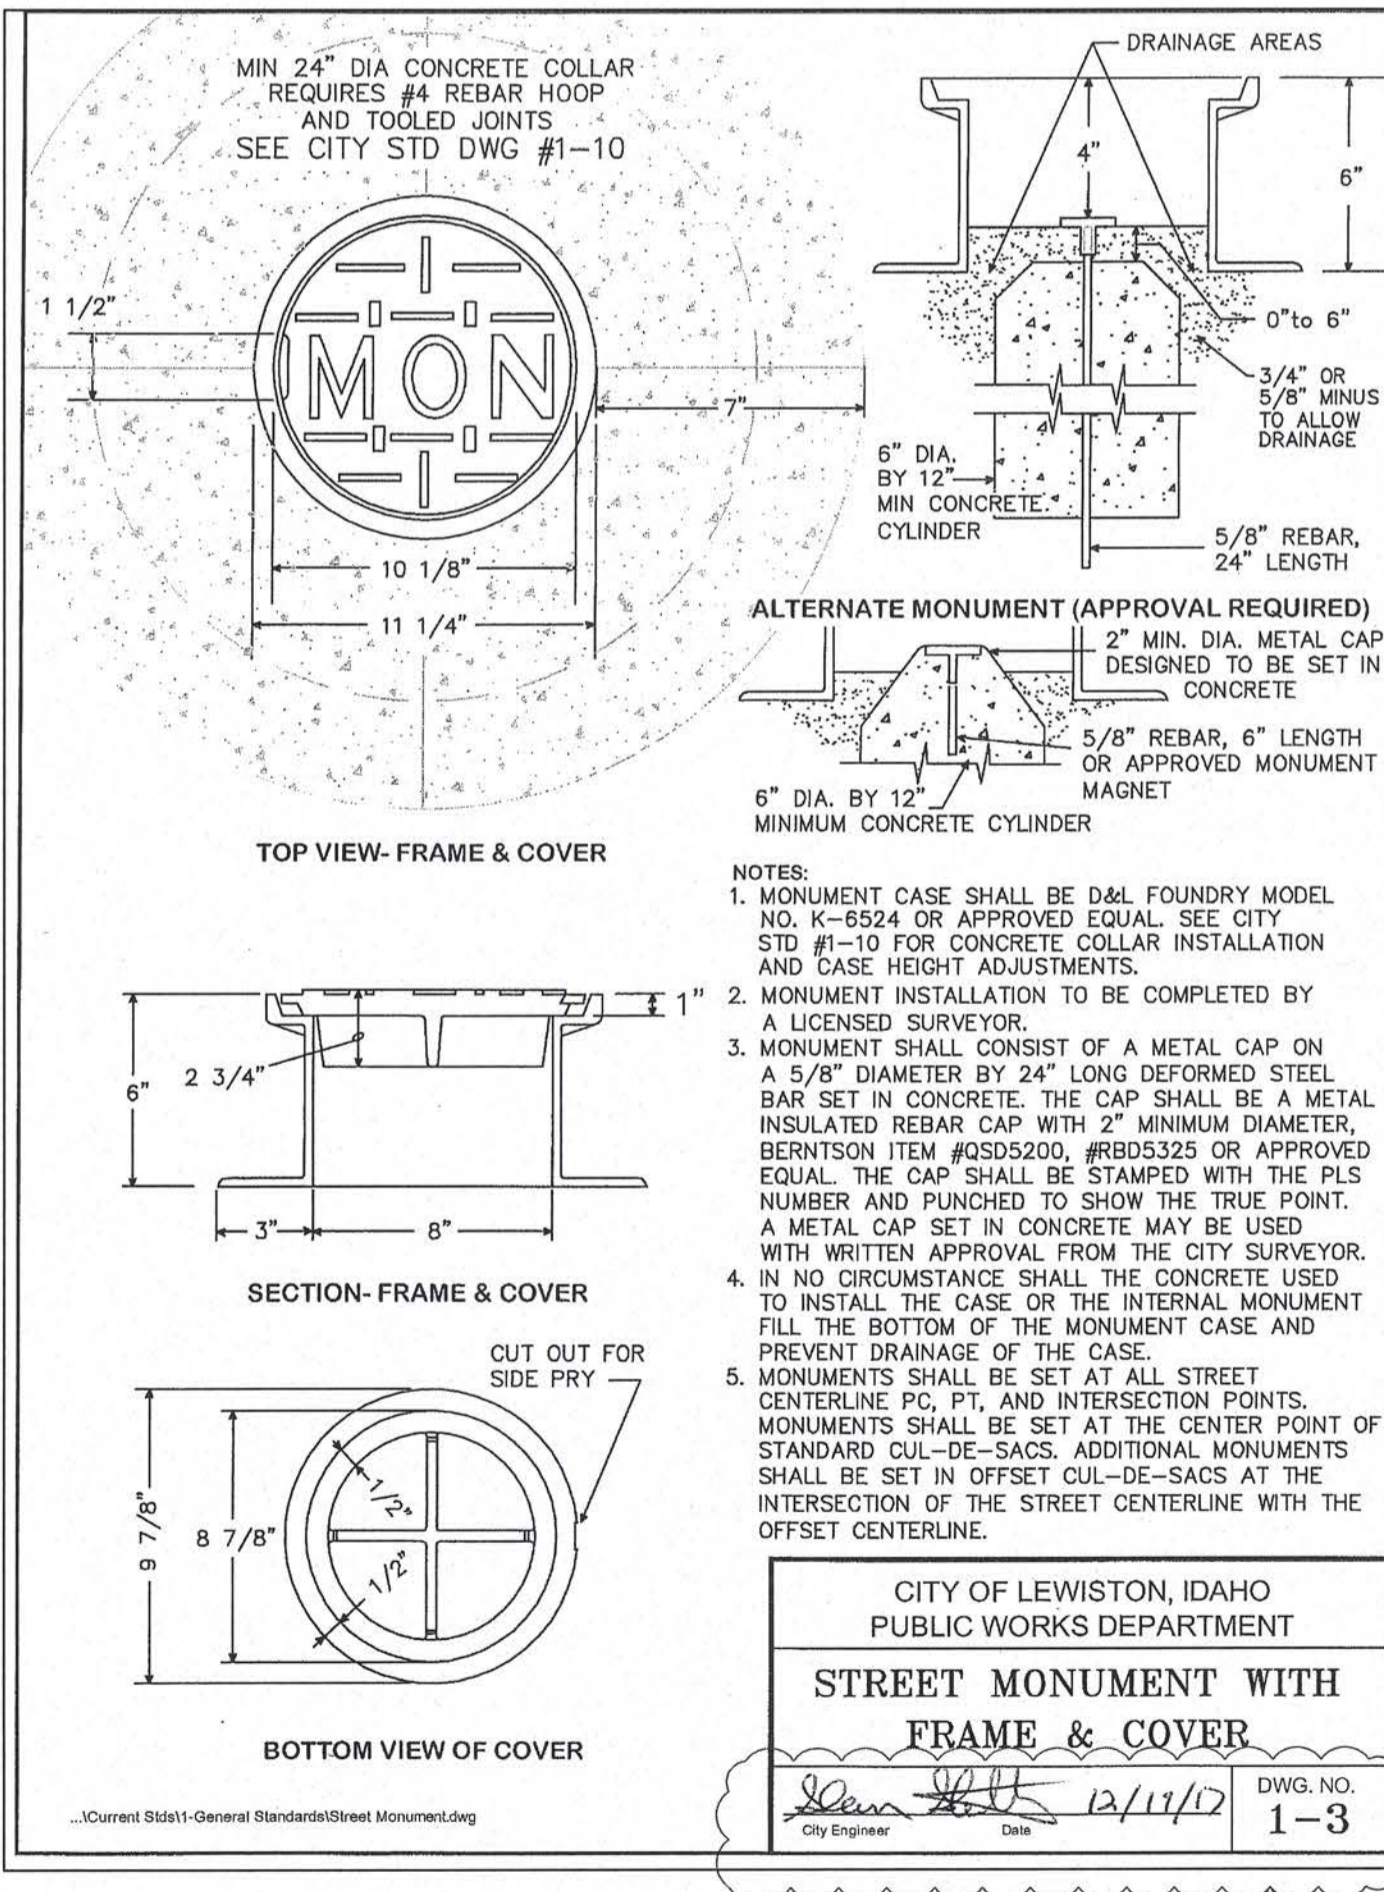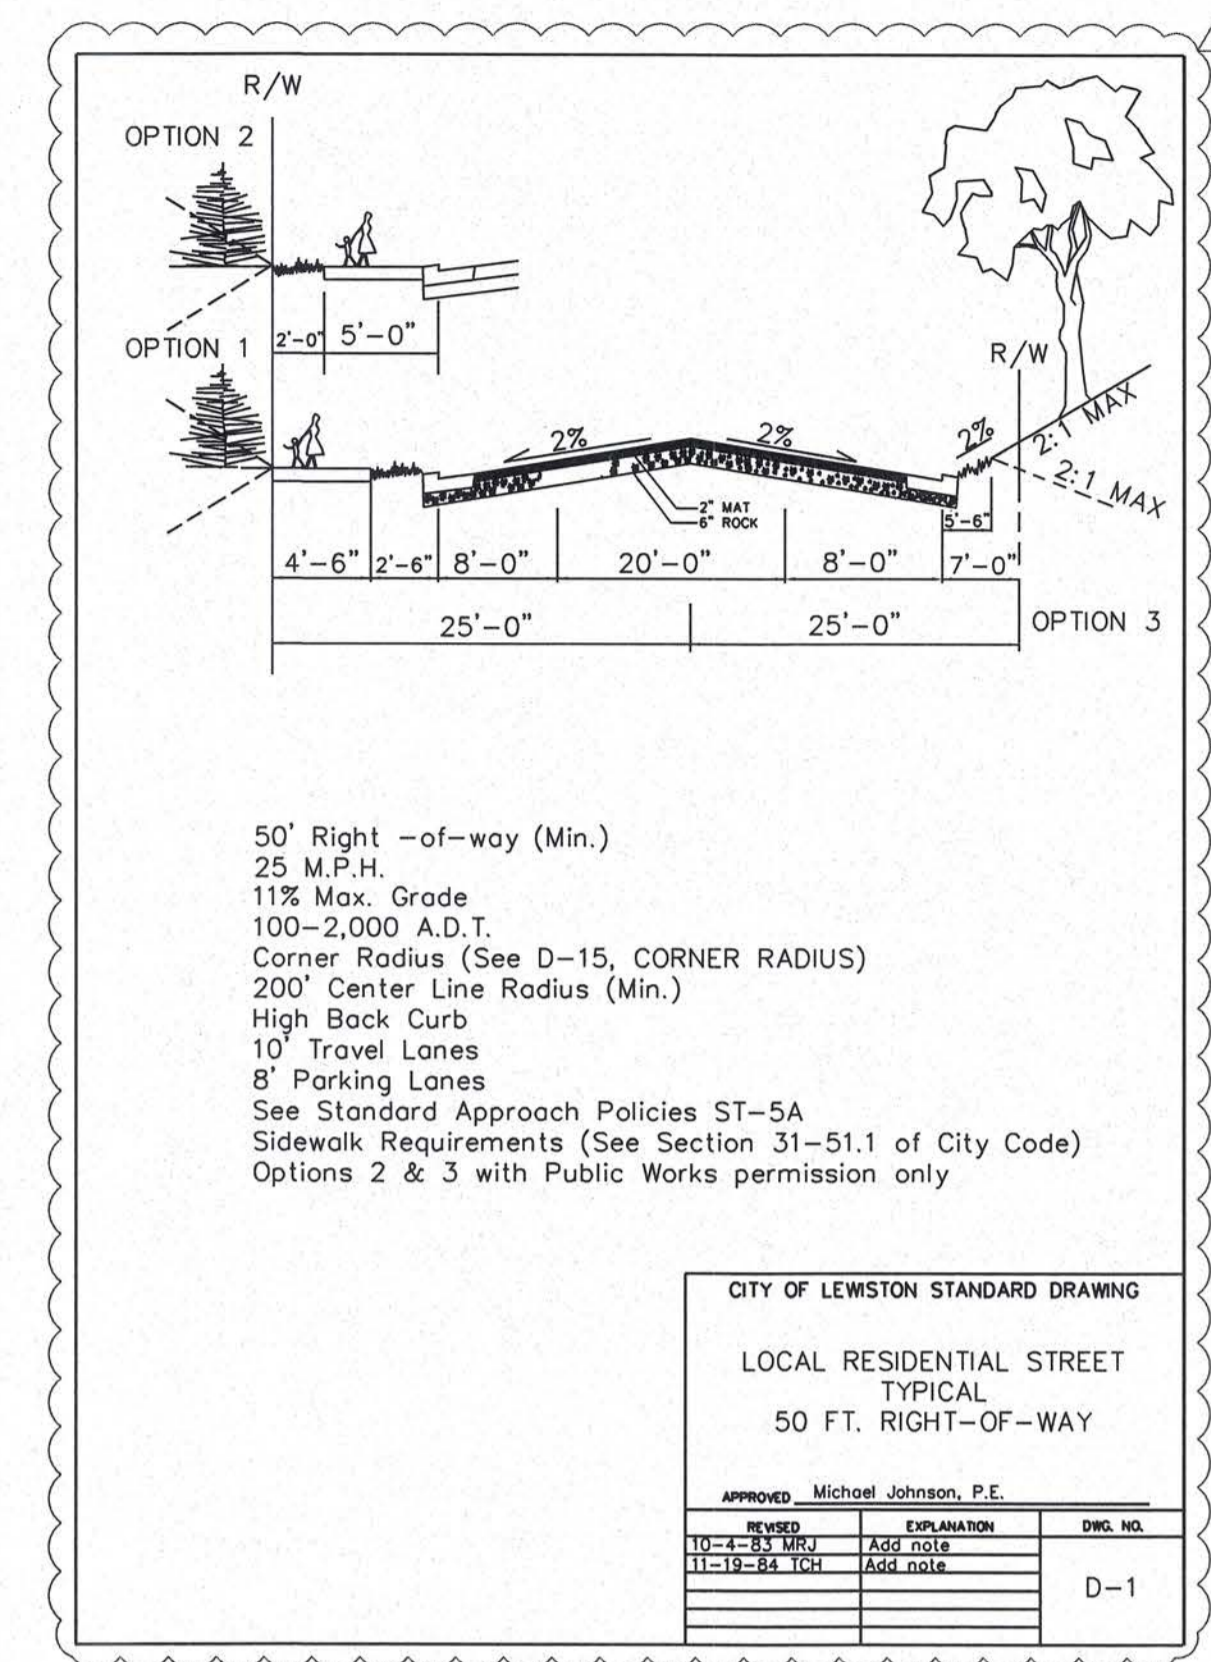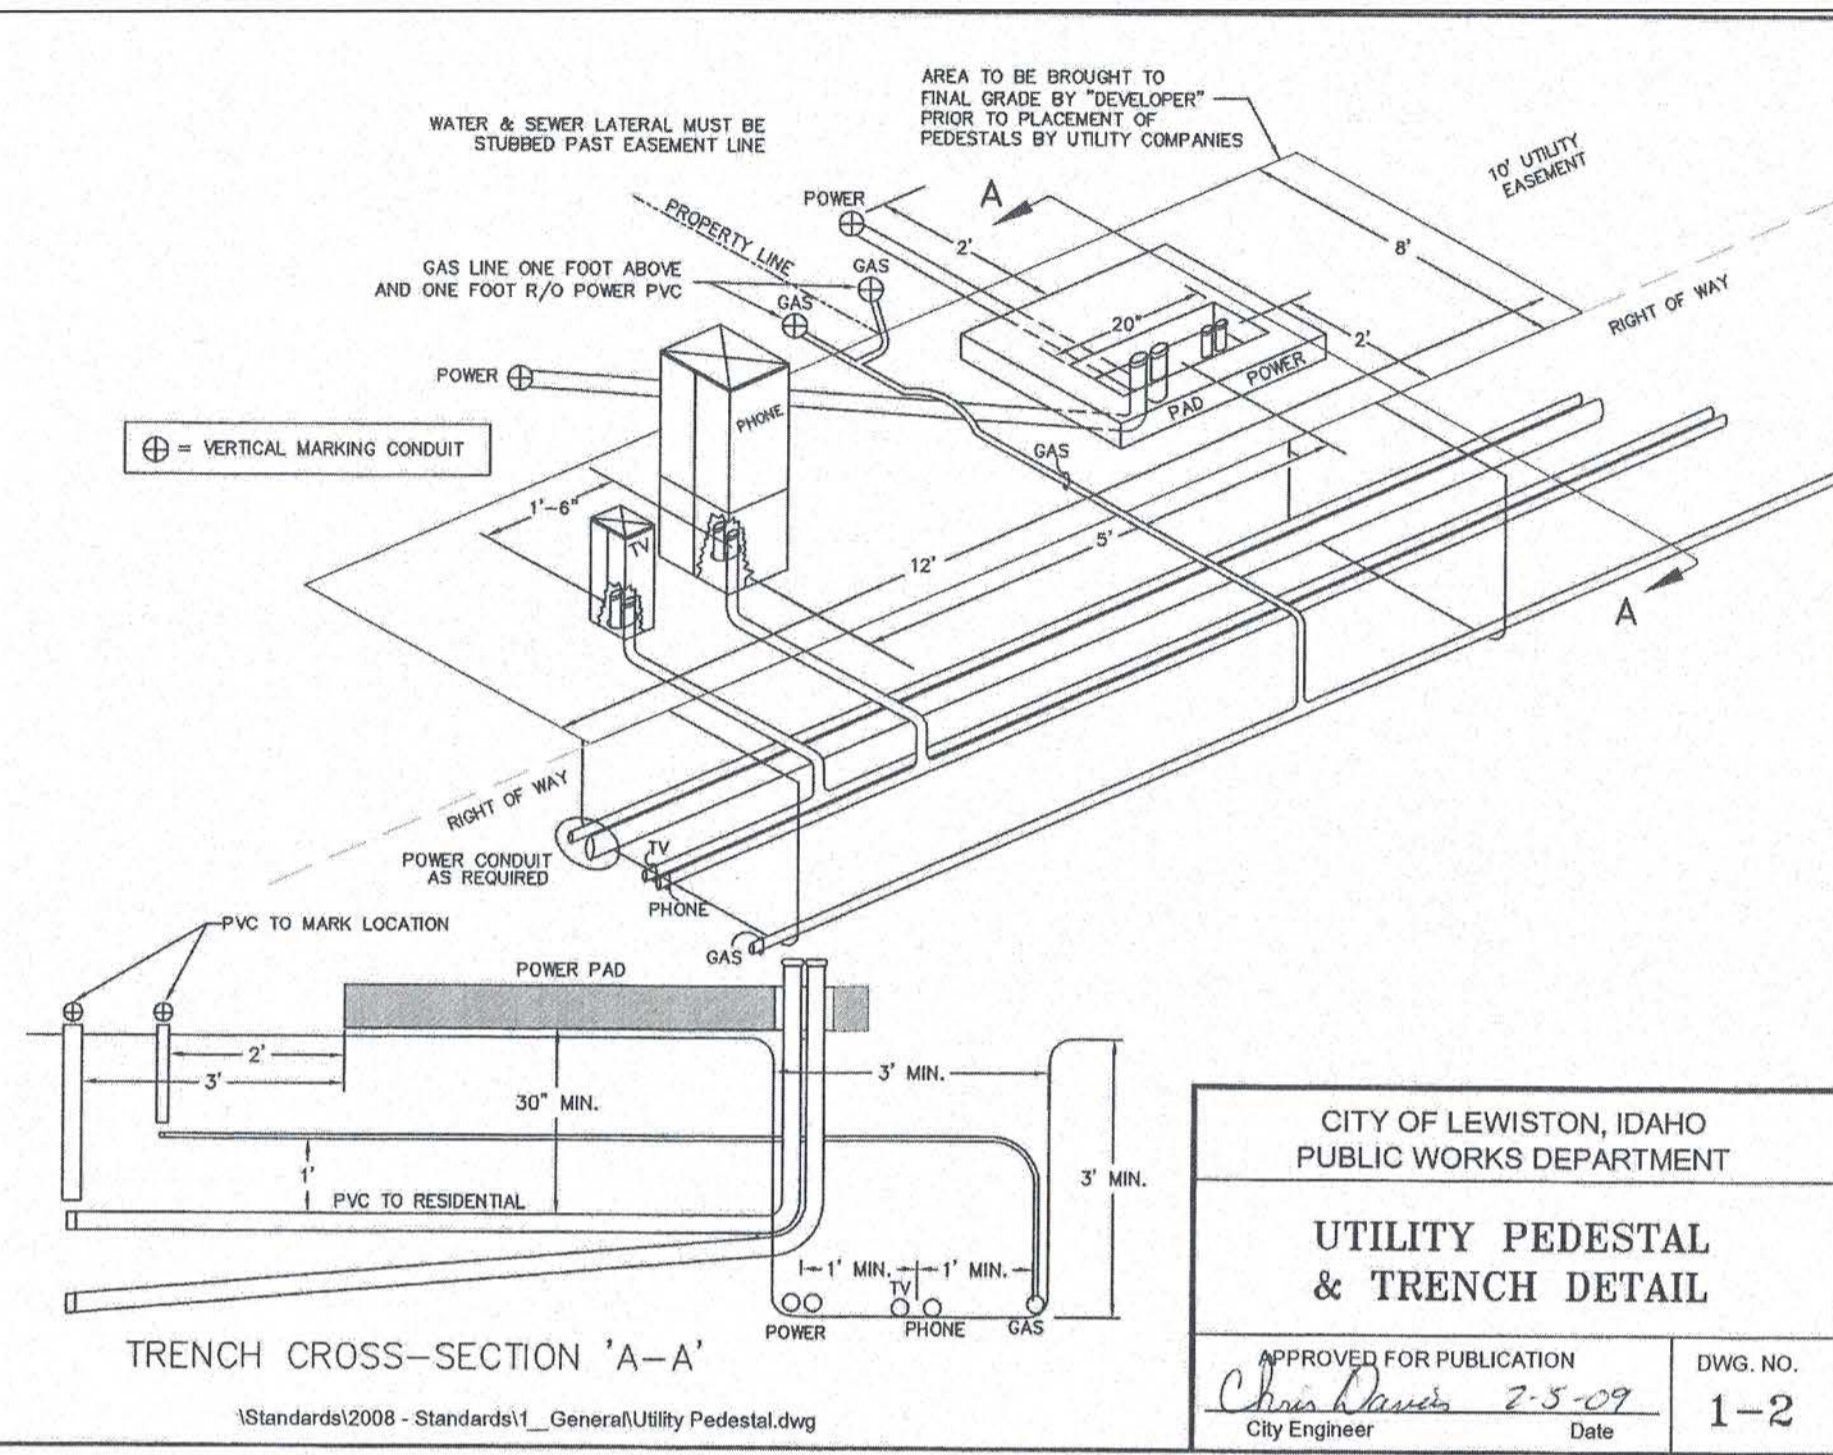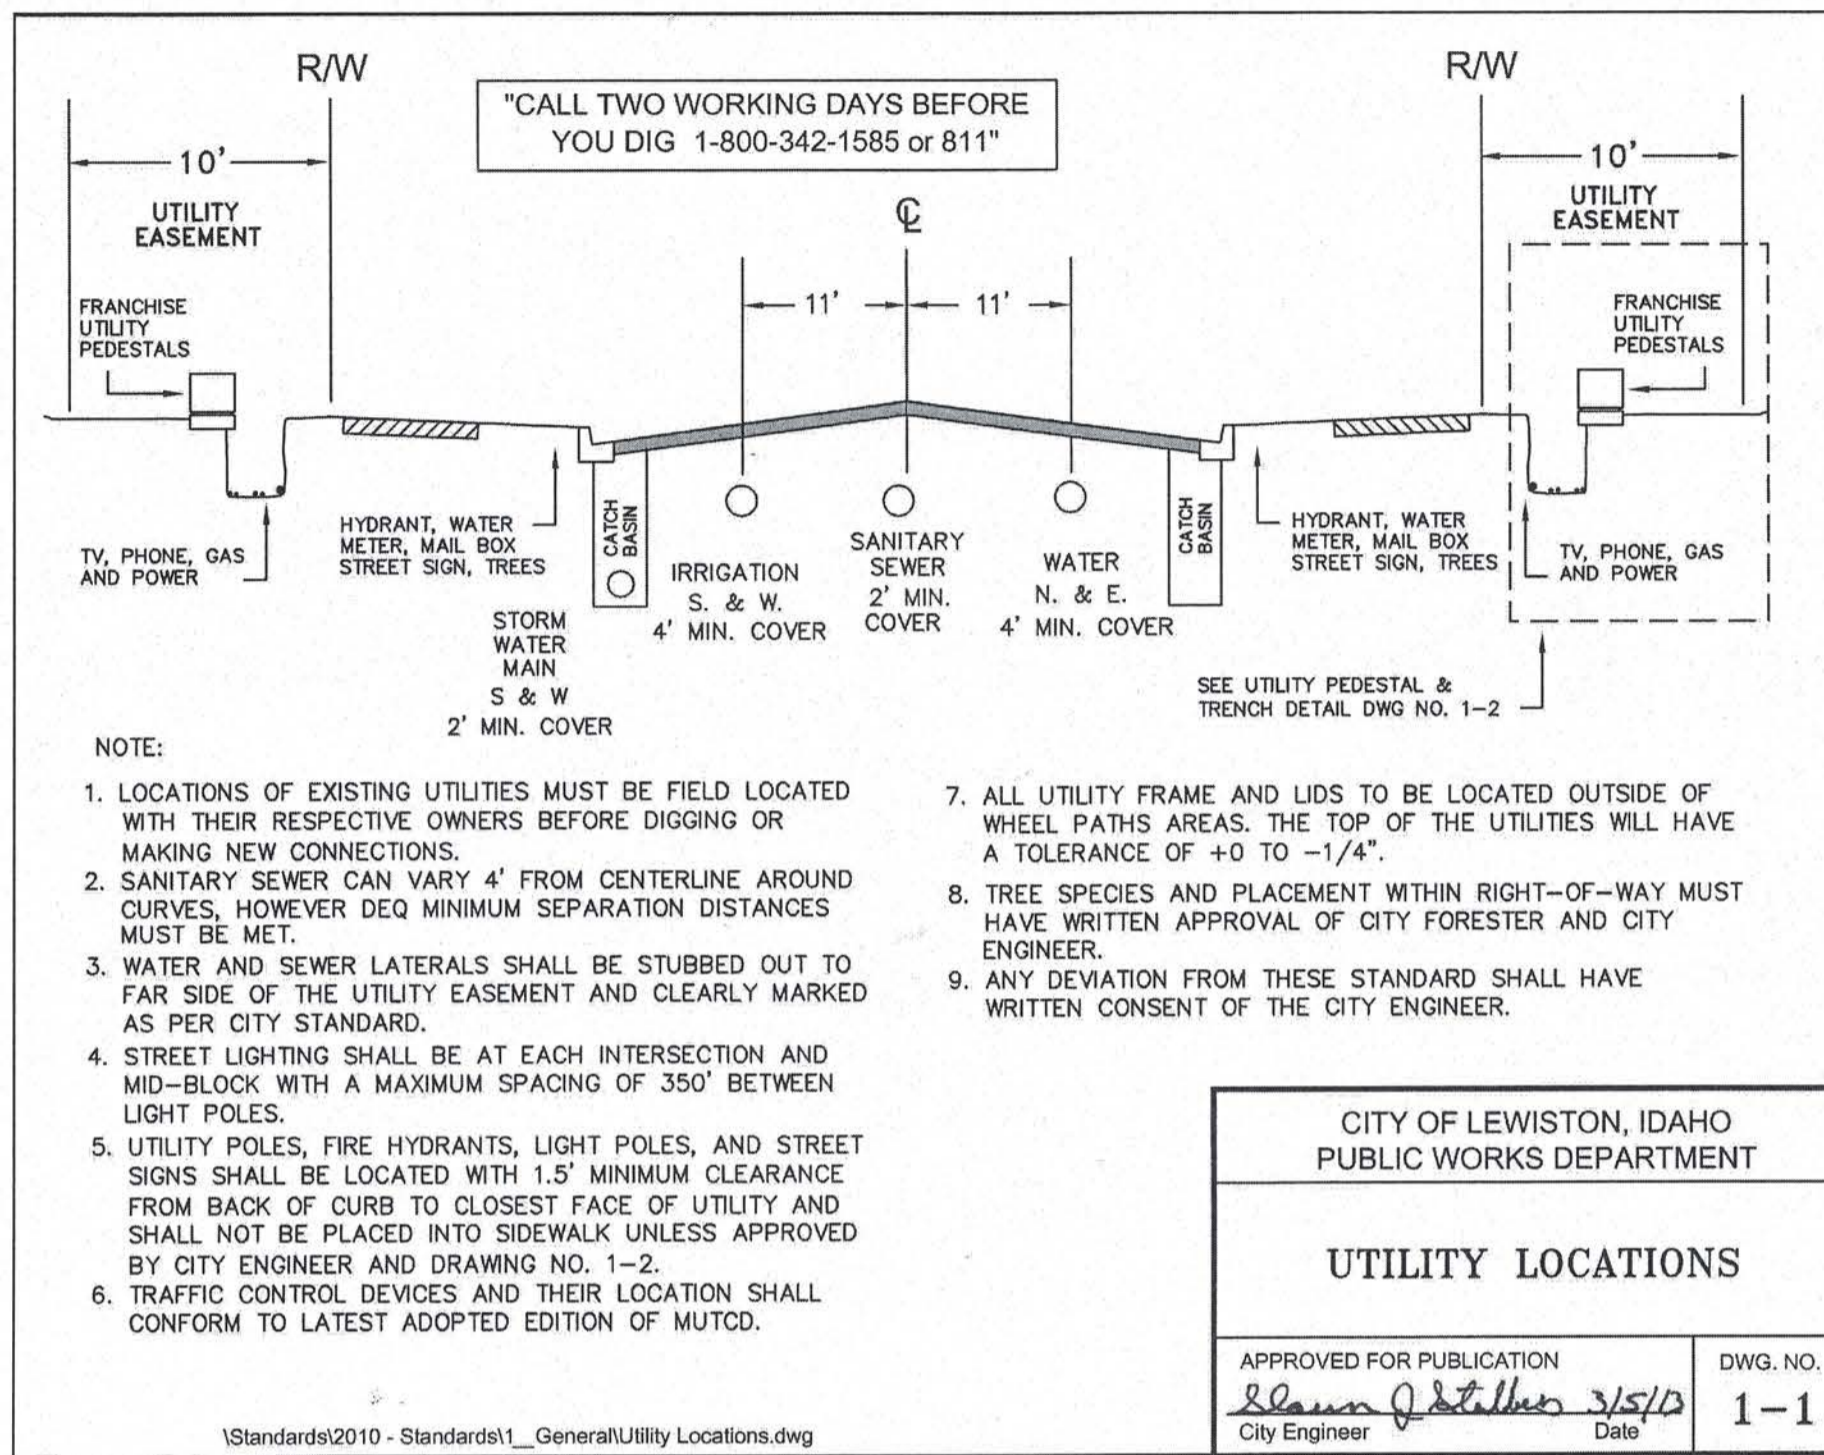

NO.	DATE	BY	DESCRIPTION
1	08/22/18	MSR	CITY COMMENTS 08/16/18


CITY STANDARD DETAILS
CRESTLINE CIRCLE DRIVE
VALLEY VISTA PUD
LEWISTON, ID 83501

KELTIC ENGINEERING, INC.
315 Adams Lane • Lewiston, Idaho 83501 • (208) 745-2135 • (208) 745-2136 fax
• Development • Planning • Design • Construction Management


DRAWN BY:	CHECKED BY:
MSR	EFH
DESIGNED BY:	EFH
DATE:	07/13/18
LAST REV:	08/22/18
PROJECT NO.	17-0089
SHEET NO.	C11 OF C14

GENERAL NOTES FOR ALL TYPES OF CURB AND GUTTER

1. SECURE A PERMIT FOR CONSTRUCTION, BEFORE BEGINNING CONSTRUCTION IN PUBLIC RIGHT-OF-WAY.
2. GRADE ALIGNMENT AND CURB TYPE SHALL BE AS APPROVED BY THE CITY ENGINEER.
3. ALIGNMENT AND GRADE STAKED TO LIP OF GUTTER (LIP) SHALL BE ESTABLISHED OR APPROVED BY THE CITY ENGINEER.
4. THE TOLERANCE FOR FINISHED CURB AND GUTTER - MAX. VARIATION OF SURFACE FLATNESS: 1/4" INCH IN 10 FEET.
5. BASE MATERIAL SHALL BE 4" OF 3/4" INCH MINUS [CURRENT ITD SPEC 703.04] OR 5/8" INCH MINUS [CURRENT WDOT/M41-10 SPEC 9-03.9] CRUSHED AGGREGATE BASE MATERIAL COMPACTED TO 95% MAXIMUM DENSITY AS DETERMINED BY MODIFIED PROCTOR AS PER AASHTO T180. ALL FILL OR BACKFILL AREAS SHALL BE PLACED IN 6" TO 8" MAXIMUM LIFTS. IN AREAS OF SMALL PROJECTS, LIMITED HEAVY TRUCK TRAFFIC OR WHERE COMPACTION EQUIPMENT HAS LIMITED ACCESS A REDUCED % COMPACTION MAY BE ALLOWED WITH WRITTEN APPROVAL FROM PUBLIC WORKS DIRECTOR.
6. CONCRETE SHALL BE 3,000 PSI MINIMUM AT 28 DAYS, MAXIMUM WATER/CEMENT RATIO SHALL BE 0.5 (LB/LB), 5" MAX. SLUMP, AIR CONTENT (%) 6.5 ±1.5.
7. DUMMY JOINTS AT 10 FOOT INTERVALS AND AT CURB RADII, 3/4" TO 1" DEEP. CONSTRUCTION JOINTS LOCATIONS AS DIRECTED BY CITY ENGINEER. DIFFERENTIAL ELEVATION BETWEEN ADJACENT SECTIONS SHALL NOT EXCEED 1/4".
8. THE CONTRACTOR ARE REQUIRED BY THE PUBLIC WORKS DEPARTMENT TO MARK STUB-OUTS AND VALVES IN THE UNCURED CONCRETE.
9. THE CONTRACTOR OR OWNER SHALL NOTIFY THE PUBLIC WORKS DEPARTMENT FOR INSPECTION AFTER THE FORMS ARE SET AND THE PUBLIC WORKS DEPARTMENT SHALL BE NOTIFIED NO LESS THAN 2 WORKING DAYS BEFORE PLACEMENT OF CONCRETE FOR A FINAL INSPECTION. FAILURE TO NOTIFY THE PUBLIC WORKS DEPARTMENT IS GROUNDS FOR REJECTION OF CURB AND GUTTER.
10. CONCRETE SURFACE TO HAVE A LIGHT BROOM FINISH PARALLEL WITH THE LENGTH OF THE CURB.
11. APPLY UNIFORM COAT OF REZ-SEAL OR APPROVED EQUIVALENT CURING COMPOUND TO EXPOSED CONCRETE IMMEDIATELY AFTER FINISHING.
12. ROLLED CURB AND GUTTER SHALL NOT BE USED:
 - A. ON STREETS IN COMMERCIAL AND INDUSTRIAL ZONED AREAS.
 - B. ON STREETS WITH LONGITUDINAL (LENGTHWISE) GRADES IN EXCESS OF 6%.
 - C. ON ANY ARTERIAL OR COLLECTOR.
 - D. WITHOUT PRIOR APPROVAL OF THE CITY ENGINEER.
 - E. WHEN SIDEWALK IS LOCATED AT THE BACK OF CURB.

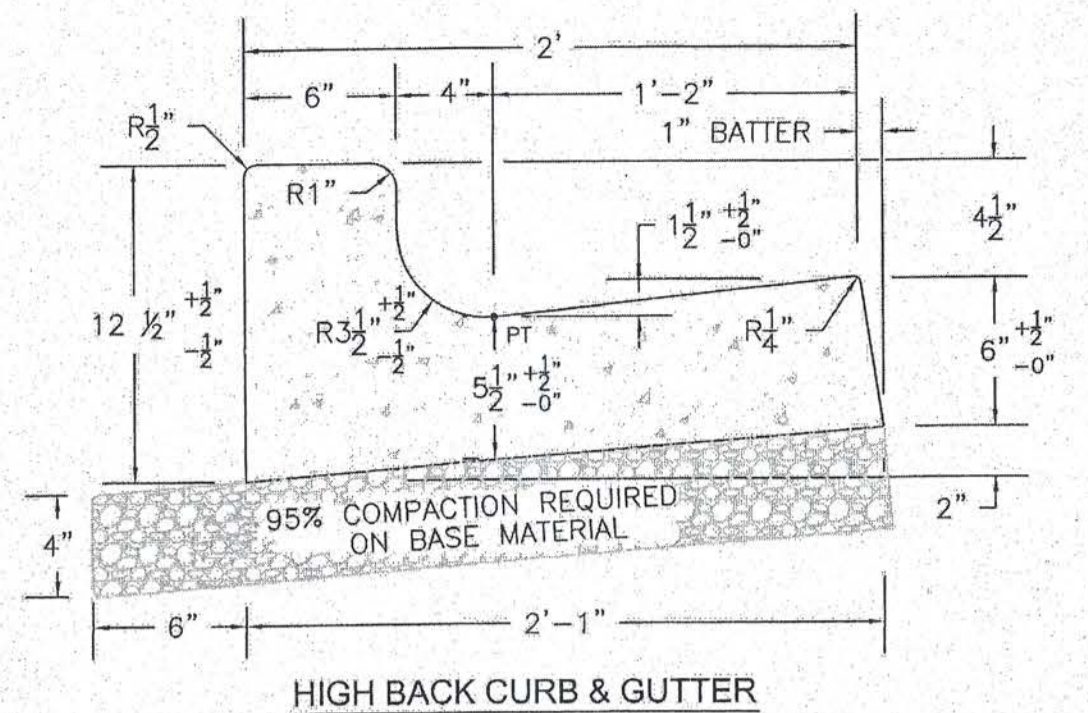

HIGH BACK CURB & GUTTER

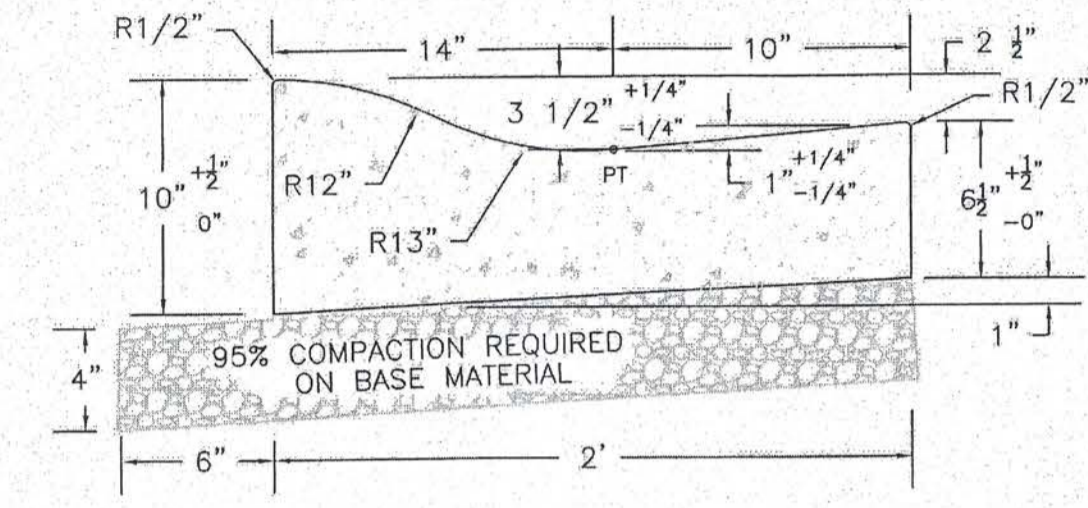

ROLLED CURB & GUTTER

ALL TOLERANCES ARE ±1/4" UNLESS OTHERWISE NOTED

CITY OF LEWISTON, IDAHO
PUBLIC WORKS DEPARTMENT

GENERAL NOTES FOR ALL TYPES OF CURB AND GUTTER

APPROVED FOR PUBLICATION: [Signature] Date: 11/2/09
City Engineer Date

DWG. NO. 2-6

CITY OF LEWISTON, IDAHO
PUBLIC WORKS DEPARTMENT

HIGH BACK CURB & GUTTER ROLLED CURB & GUTTER

APPROVED FOR PUBLICATION: [Signature] Date: 2-5-09
City Engineer Date

DWG. NO. 2-7

CITY OF LEWISTON, IDAHO
PUBLIC WORKS DEPARTMENT

CONCRETE SIDEWALK

APPROVED FOR PUBLICATION: [Signature] Date: 8/27/15
City Engineer Date


DWG. NO. 2-8

CITY OF LEWISTON, IDAHO
PUBLIC WORKS DEPARTMENT


DOUBLE SIDEWALK RAMPS - TYPE 1

APPROVED FOR PUBLICATION: [Signature] Date: 9/1/10
City Engineer Date


DWG. NO. 2-11

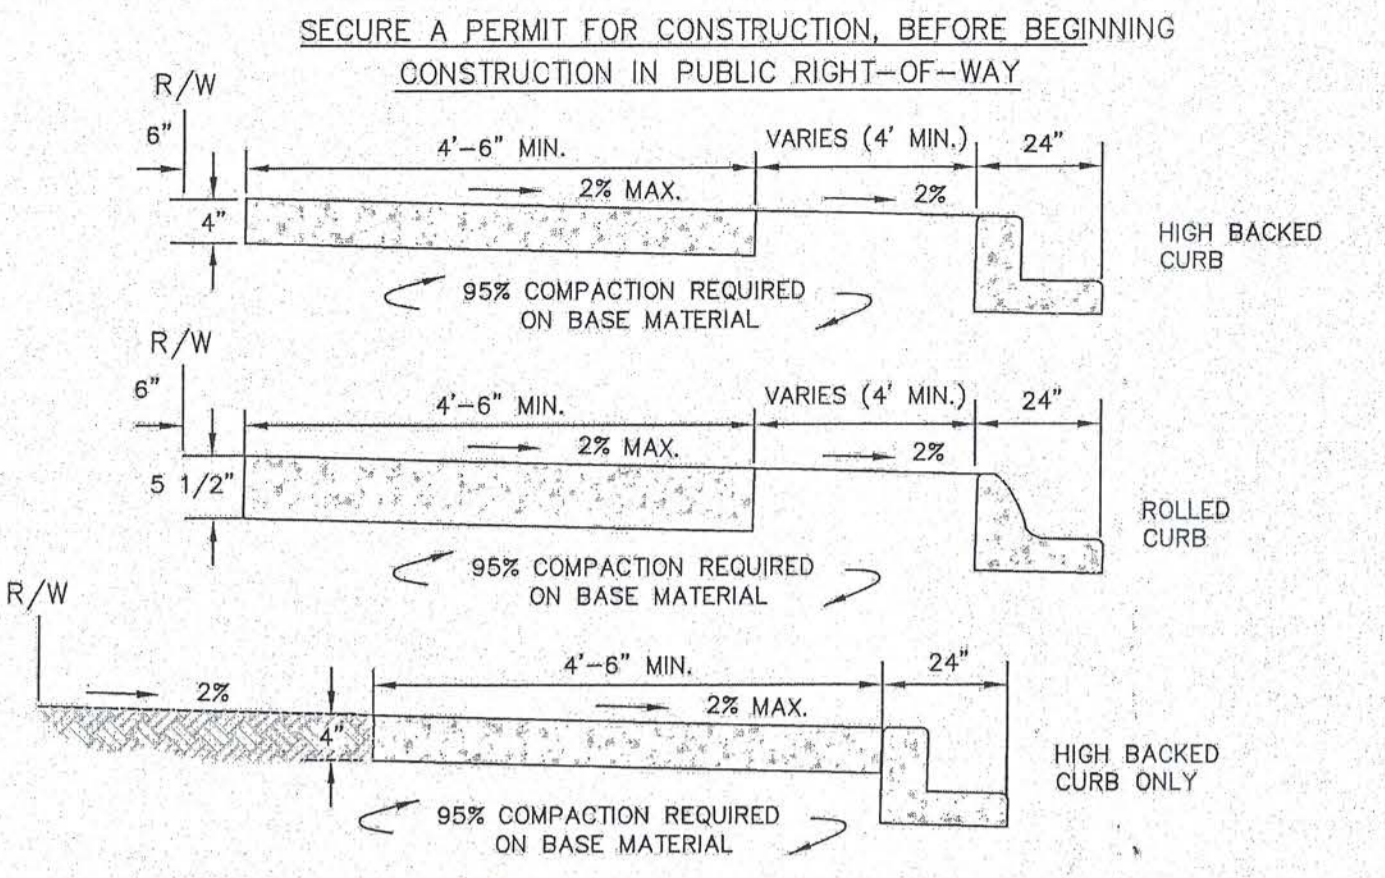

- GENERAL NOTES FOR ALL SIDEWALK:**
1. LINE AND GRADE STAKED T.S., TOP OF SIDEWALK, B.S., BACK OF SIDEWALK.
 2. GRADE AND ALIGNMENT TO BE APPROVED BY THE CITY ENGINEER.
 3. THE TOLERANCE FOR FINISHED SIDEWALK - MAX. VARIATION OF SURFACE FLATNESS: 1/4" INCH IN 10 FEET.
 4. BASE MATERIAL SHALL BE 4" OF 3/4" INCH MINUS [CURRENT ITD SPEC 703.04] OR 5/8" MINUS [CURRENT WDOT/M41-10 SPEC 9-03.9] CRUSHED AGGREGATE BASE MATERIAL COMPACTED TO 95% MAXIMUM DENSITY AS DETERMINED BY MODIFIED PROCTOR AS PER AASHTO T180. ALL FILLS OR BACKFILL AREAS SHALL BE PLACED IN 6" MAX. LIFTS.
 5. CONTRACTION/DUMMY JOINTS SHALL BE PLACED AT 5' INTERVALS, 3/4" TO 1" DEEP; INSTALL A PERFORMED EXPANSION JOINT FILLER TO THE FULL DEPTH & WIDTH EVERY 100 FEET.
 6. CONCRETE SHALL BE 3,000 PSI MIN. AT 28 DAYS, MAX. WATER/CEMENT RATIO SHALL BE 0.5 (LB/LB), 5" MAX. SLUMP, AIR CONTENT (%) 6.5 ±1.5.
 7. THE CONTRACTOR OR OWNER SHALL NOTIFY THE PUBLIC WORKS DEPT. FOR INSPECTION OF BASE MATERIAL AFTER FORMS ARE SET AND THE PUBLIC WORKS DEPT. WILL BE NOTIFIED NO LESS THAN 2 WORKING DAYS BEFORE PLACEMENT OF CONCRETE, FOR FINAL INSPECTION.
 8. CONCRETE SURFACE SHALL HAVE LIGHT BROOM FINISH PERPENDICULAR TO LENGTH OF S/W.
 9. APPLY UNIFORM COAT OF REZ-SEAL OR APPROVED EQUIVALENT CURING COMPOUND TO EXPOSED CONCRETE IMMEDIATELY AFTER FINISHING.
 10. NAME OF CONTRACTOR AND YEAR TO BE STAMPED AT EACH END OF WORK AND AT INTERVALS OF 300 FT.
 11. CONCRETE SURFACE SHALL BE FREE OF SURFACE BLEMISHES OR VOIDS GREATER THAN 1/4". JOINTS AND EDGES SHALL BE CLEAN AND FREE OF EXCESS SPALLING OR VOIDS.
 12. A 6" STRIP TO BE LOCATED BETWEEN RIGHT-OF-WAY LINE AND SIDEWALK FOR PLACEMENT OF PROPERTY PINS WHEN PLANTING STRIP OR RETENTION SWALES ARE PLACED BEHIND CURB AND GUTTER.

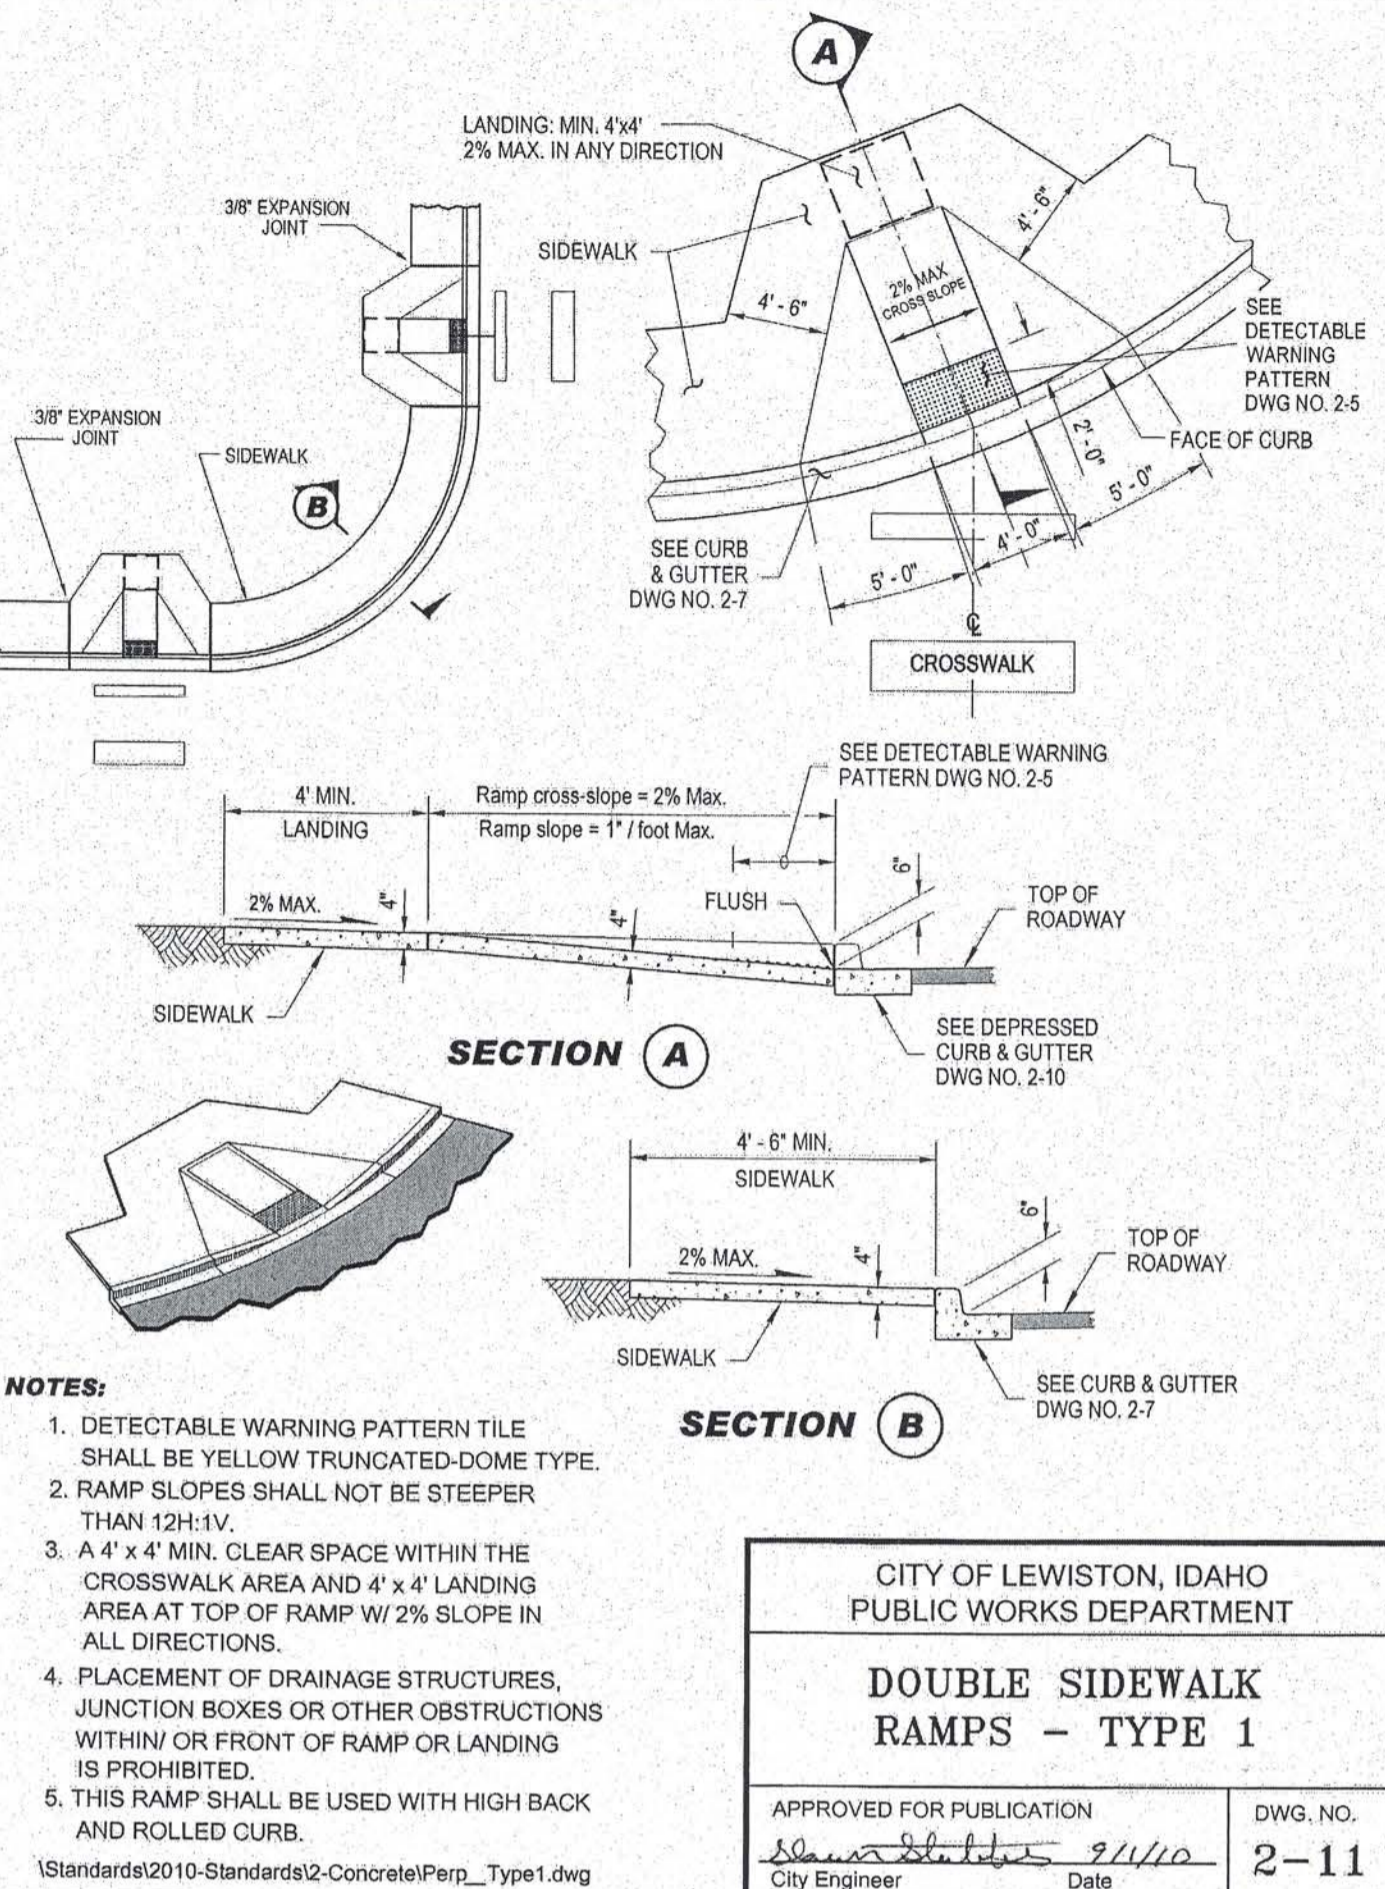

- NOTES:**
1. DETECTABLE WARNING PATTERN TILE SHALL BE YELLOW TRUNCATED-DOME TYPE.
 2. RAMP SLOPES SHALL NOT BE STEEPER THAN 12H:1V.
 3. A 4' x 4' MIN. CLEAR SPACE WITHIN THE CROSSWALK AREA AND 4' x 4' LANDING AREA AT TOP OF RAMP W/ 2% SLOPE IN ALL DIRECTIONS.
 4. PLACEMENT OF DRAINAGE STRUCTURES, JUNCTION BOXES OR OTHER OBSTRUCTIONS WITHIN OR FRONT OF RAMP OR LANDING IS PROHIBITED.
 5. THIS RAMP SHALL BE USED WITH HIGH BACK AND ROLLED CURB.

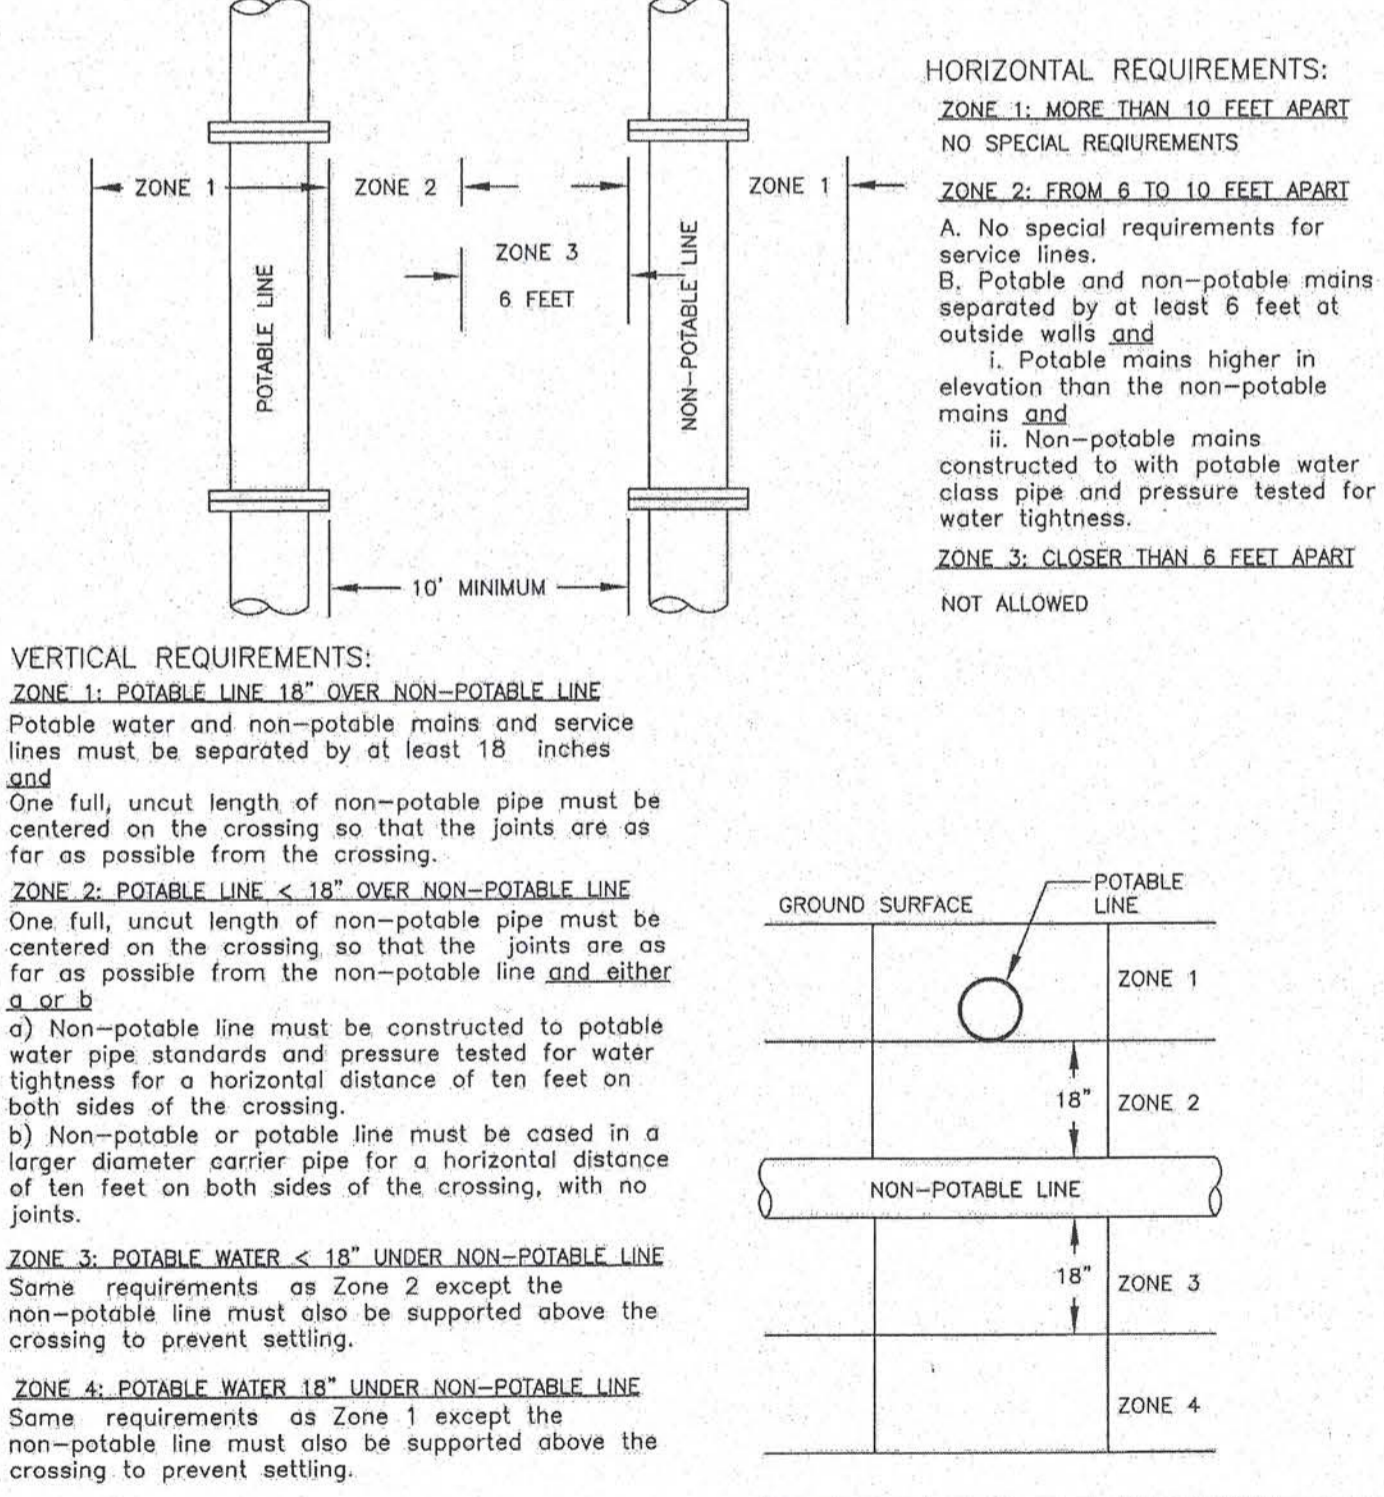


CITY OF LEWISTON, IDAHO
PUBLIC WORKS DEPARTMENT

POTABLE & NON-POTABLE WATERLINE SEPARATION

APPROVED FOR PUBLICATION: [Signature] Date: 11-9-09
City Engineer Date

DWG. NO. 4-1

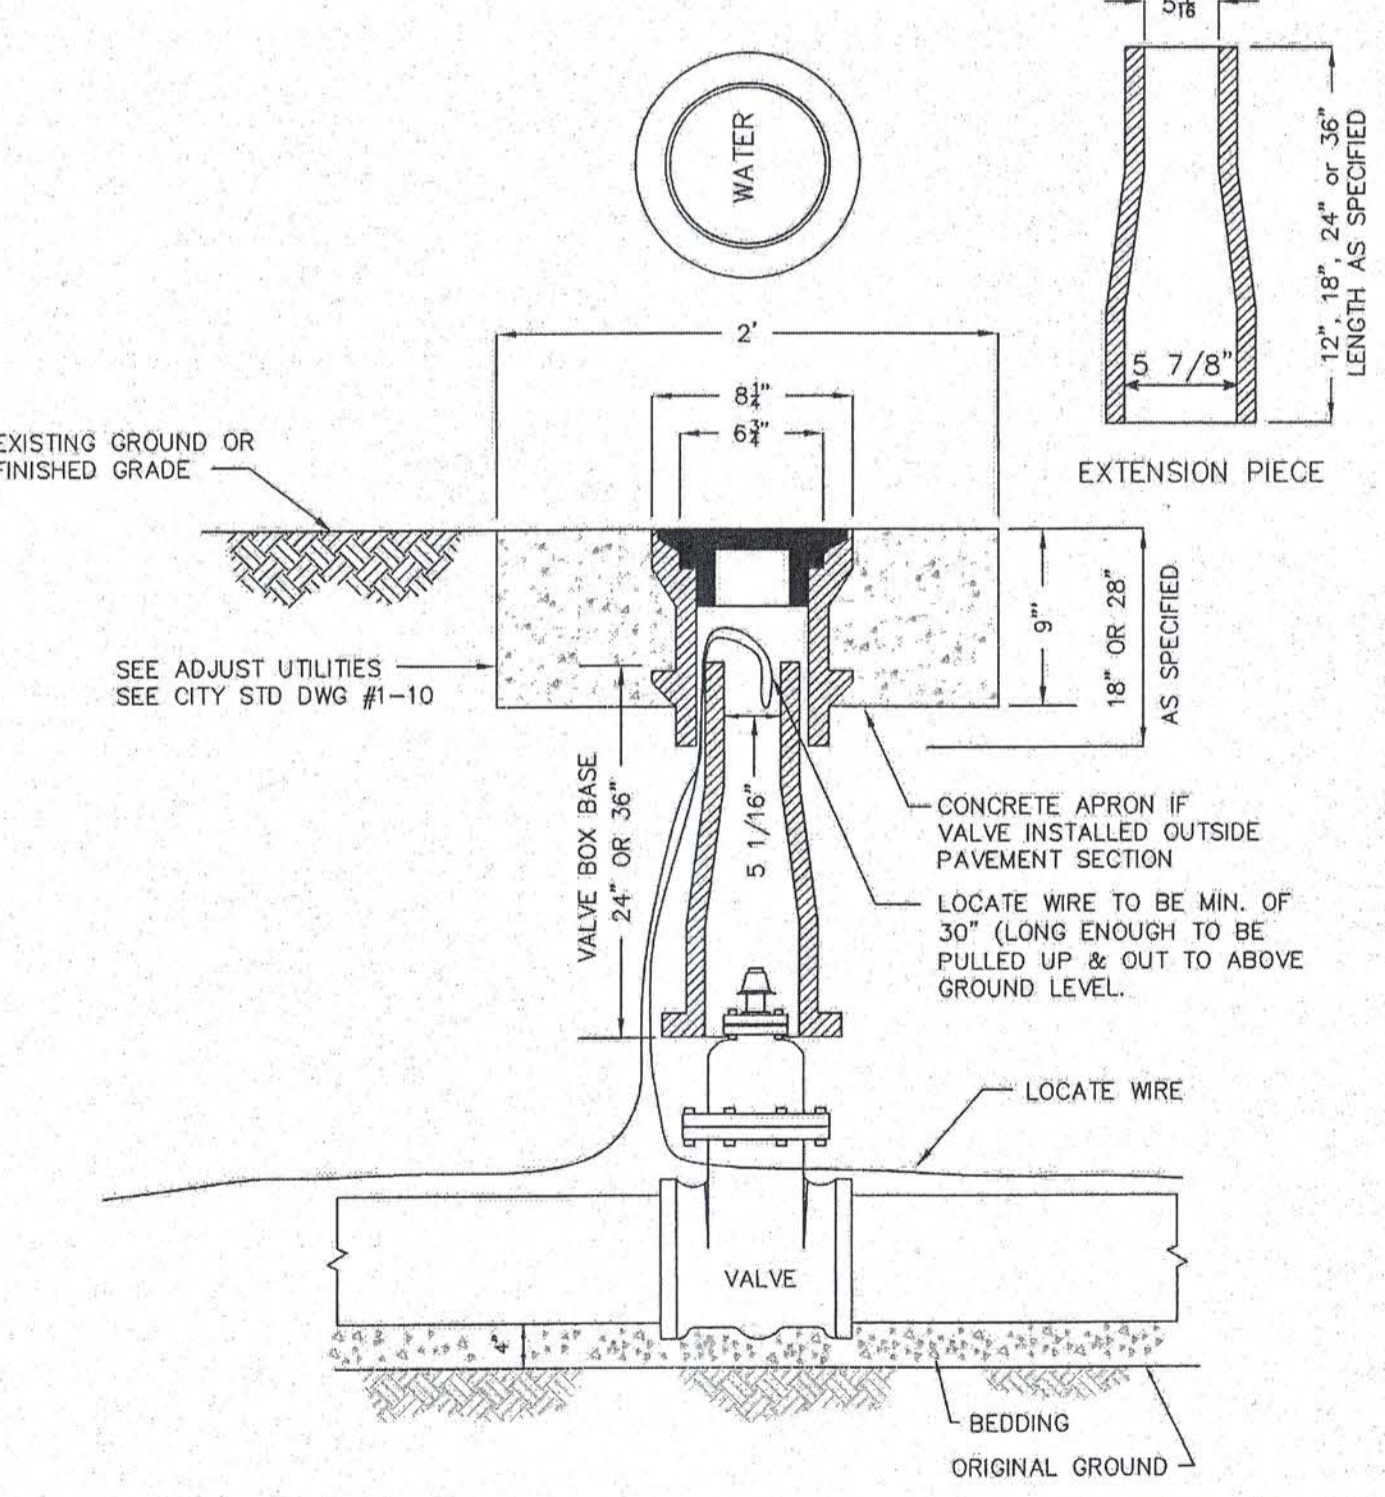


CITY OF LEWISTON, IDAHO
PUBLIC WORKS DEPARTMENT

GATE VALVE BOX WITH ASSEMBLY

APPROVED FOR PUBLICATION: [Signature] Date: 11-9-09
City Engineer Date

DWG. NO. 4-2

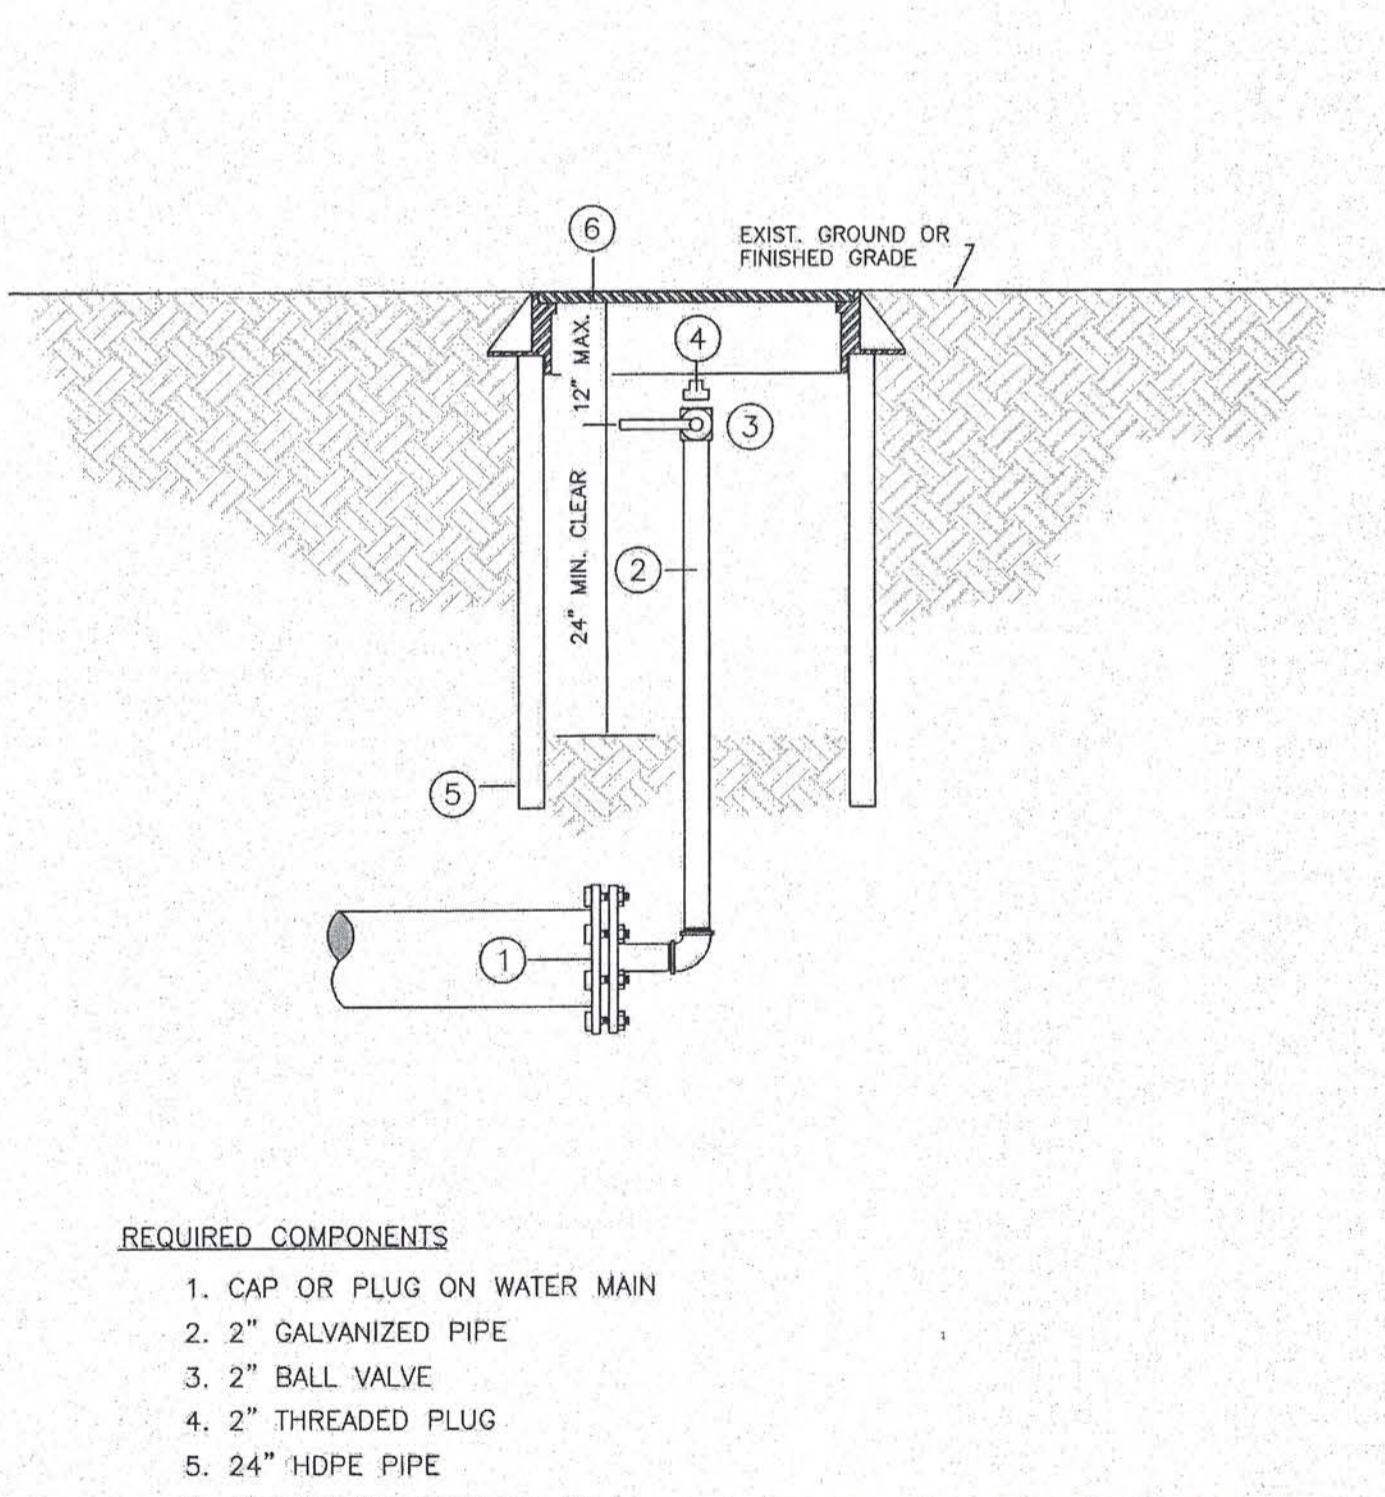


CITY OF LEWISTON, IDAHO
PUBLIC WORKS DEPARTMENT

COMBINATION BLOWOFF AND SAMPLING TAP

APPROVED FOR PUBLICATION: [Signature] Date: 11-9-09
City Engineer Date

DWG. NO. 4-3

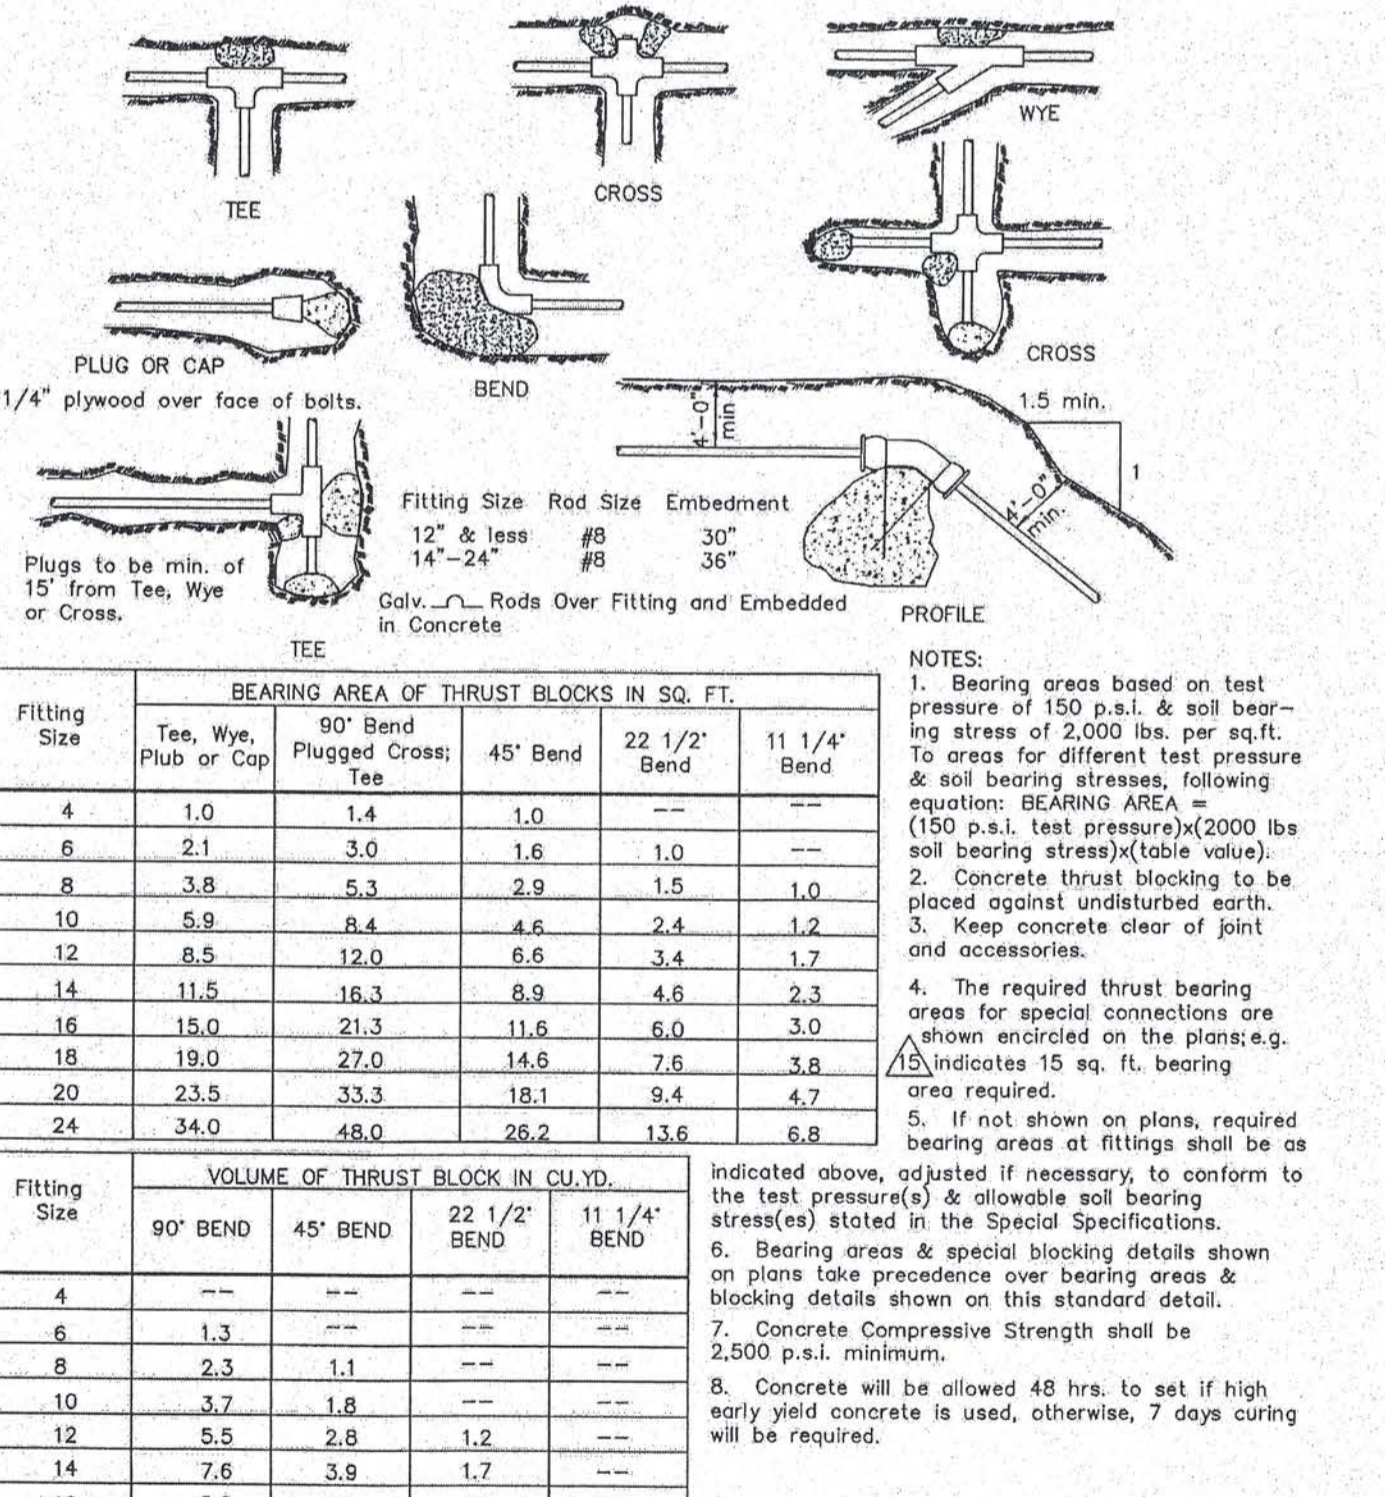

CITY OF LEWISTON, IDAHO
PUBLIC WORKS DEPARTMENT

THRUST BLOCKING DETAIL

APPROVED FOR PUBLICATION: [Signature] Date: 11-9-09
City Engineer Date

DWG. NO. 4-4

Fitting Size	BEARING AREA OF THRUST BLOCKS IN SQ. FT.				
	90° Bend Tee, Wye, Plug or Cap	45° Bend Tee	22 1/2° Bend Tee	11 1/4° Bend Tee	11 1/4° Bend Tee
4	1.0	1.4	1.0	---	---
6	2.1	3.0	1.6	1.0	---
8	3.8	5.3	2.9	1.5	1.0
10	5.9	8.4	4.6	2.4	1.2
12	8.5	12.0	6.6	3.4	1.7
14	11.5	16.3	8.9	4.6	2.3
16	15.0	21.3	11.6	6.0	3.0
18	19.0	27.0	14.6	7.6	3.8
20	23.5	33.3	18.1	9.4	4.7
24	34.0	48.0	26.2	13.6	6.8

Fitting Size	VOLUME OF THRUST BLOCK IN CU.YD.			
	90° BEND	45° BEND	22 1/2° BEND	11 1/4° BEND
4	---	---	---	---
6	1.3	---	---	---
8	2.3	1.1	---	---
10	3.7	1.8	---	---
12	5.5	2.6	1.2	---
14	7.6	3.9	1.7	---
16	9.9	5.1	2.3	0.9
18	---	6.3	3.2	1.4
20	---	7.7	4.0	1.8
24	---	11.1	5.7	2.6

NO.	DATE	BY	DESCRIPTION
1	08/22/18	MSR	CITY COMMENTS 08/16/18

CITY STANDARD DETAILS
CRESTLINE CIRCLE DRIVE
VALLEY VISTA PUD
LEWISTON, ID 83501

KELTIC ENGINEERING, Inc.

315 Adams Lane • Lewiston, Idaho 83501 • (208) 745-2135 • (208) 745-2136 fax

Development • Planning • Design • Construction Management

DRAWN BY: MSR	CHECKED BY: EFH
DESIGNED BY: EFH	
DATE: 07/13/18	
LAST REV: 08/22/18	
PROJECT NO: 17-0089	
SHEET NO: C12 OF C14	

UTILITY MARKER LOCATION OPTIONS

IN SUBDIVISIONS RESIDENTIAL LOTS SHALL INSTALL METER SETTINGS.
IN COMMERCIAL LOTS SHALL BE BEHIND SIDEWALK WITH UTILITY MARKER.

IF NO SIDEWALK IS INSTALLED:
18" FROM BACK OF CURB
18" FROM EDGE OF RETENTION SWALE

PLAN VIEW
PROFILE VIEW

4" MIN. COVER
TAP BY CONTRACTOR OR BY WATER DEPT.
SERVICE SADDLE
CORPORATION STOP
SERVICE LINE
STREET SURFACE
STEEL POST PAINTED BLUE
CURB STOP
1" SERVICE - CURVED
1 1/2" & 2" SERVICES - STRAIGHT FOR COPPER

PEX TYPE 'A' TO BE INSTALLED CURVED TO MAIN (SIMILAR TO 1" SERVICE)

METER TO BE INSTALLED BY CITY DEVELOPER TO INSTALL COPPER SETTER, CURB STOP AND METER BOX. REFER ALL QUESTIONS IN RIGHT-OF-WAY TO CITY WATER DEPARTMENT (208) 791-2032.

RIGHT-OF-WAY R/W 10'
SWALE AREA OR BUFFER ZONE
SIDEWALK
UTILITY EASEMENT
3" MIN. COVER
ROADWAY SURFACE
4" MIN. COVER
TAP BY CONTRACTOR OR BY WATER DEPT.
1" SERVICE - CURVED
CURB STOP
WATERMAIN
1 1/2" & 2" SERVICES - STRAIGHT FOR COPPER

PEX TYPE 'A' TO BE INSTALLED CURVED TO MAIN (SIMILAR TO 1" SERVICE)

REFER ALL QUESTIONS IN PRIVATE PROPERTY AREA TO THE CITY PLUMBING INSPECTOR AND CITY BUILDING OFFICIAL (208) 749-1318.

SHEET 1 OF 2
CITY OF LEWISTON, IDAHO
PUBLIC WORKS DEPARTMENT
TYPICAL WATER METER or UTILITY MARKER LOCATION
APPROVED FOR PUBLICATION: *Deanna Hillman* 12/17/15
City Engineer Date
DWG. NO. 4-5

TYPICAL WATER METER LOCATION

IF THE SIDEWALK IS TOUCHING THE CURB THE METER SHALL BE INSTALLED 12" TO 18" BEHIND THE SIDEWALK.
METER SHALL NOT BE INSTALLED IN DRIVEWAY AND WILL ONLY BE ALLOWED IN THE SIDEWALK WHEN PROPERTY'S FRONTAGE IS CONCRETE (I.E. DOWNTOWN MAIN STREET).

VARIES
RIGHT-OF-WAY R/W 10'
SWALE AREA OR BUFFER ZONE
SIDEWALK
UTILITY EASEMENT
3" MIN. COVER
ROADWAY SURFACE
4" MIN. COVER
TAP BY CONTRACTOR OR BY WATER DEPT.
1" SERVICE - CURVED
WATERMAIN
1 1/2" & 2" SERVICES - STRAIGHT FOR COPPER

IF NO SIDEWALK IS INSTALLED:
18" FROM BACK OF CURB
18" FROM EDGE OF RETENTION SWALE
3" MIN. COVER
ROADWAY SURFACE
4" MIN. COVER
TAP BY CONTRACTOR OR BY WATER DEPT.
1" SERVICE - CURVED
CURB STOP
WATERMAIN
1 1/2" & 2" SERVICES - STRAIGHT FOR COPPER

PEX TYPE 'A' TO BE INSTALLED CURVED TO MAIN (SIMILAR TO 1" SERVICE)

METER TO BE INSTALLED BY CITY DEVELOPER TO INSTALL COPPER SETTER, CURB STOP AND METER BOX. REFER ALL QUESTIONS IN RIGHT-OF-WAY TO CITY WATER DEPARTMENT (208) 791-2032.

REFER ALL QUESTIONS IN PRIVATE PROPERTY AREA TO THE CITY PLUMBING INSPECTOR AND CITY BUILDING OFFICIAL (208) 749-1318.

GENERAL NOTES:
1. WATER SERVICE LINES SHALL HAVE A MINIMUM COVER OF (3) THREE FEET MEASURED FROM THE FINISHED GROUND SURFACE.
2. SERVICE LINE SHALL BE BACKFILLED AND BEDDED WITH 3" OF SAND OR SOIL FREE OF ORGANIC MATERIAL, ROCK OR OTHER MATERIAL THAT COULD DAMAGE SERVICE LINE.
3. THE TOP OF THE METER SHALL BE 12" TO 18" DEEP.

MAINTAIN CLEAR VERTICAL ACCESS TO CURB STOP AND COPPER SETTER

PLAN VIEW
TO WATER MAIN
TO PROPERTY
COPPER SETTER SHALL BE PARALLEL TO STREET AND METER INSTALLED BY WATER DEPT UNLESS OTHERWISE INDICATED

SHEET 2 OF 2
CITY OF LEWISTON, IDAHO
PUBLIC WORKS DEPARTMENT
TYPICAL WATER METER or UTILITY MARKER LOCATION
APPROVED FOR PUBLICATION: *Deanna Hillman* 12/17/15
City Engineer Date
DWG. NO. 4-5

STANDARD 1" WATER SERVICE CONNECTION

GENERAL NOTES:
A. APPLICABLE FORD METER BOX PART #S INDICATED; EQUIVALENT ITEMS BY OTHER MANUFACTURER ARE ALLOWED PROVIDED WITH WRITTEN APPROVAL FROM THE WATER DEPARTMENT (208) 791-2032.
B. ALL COMPONENTS OF THE NEW WATER SERVICE CONNECTION SHALL BE IDENTIFIED COMPLIANT WITH NSF OR STANDARD.
C. SEE CITY STD # 4-5 FOR TYPICAL WATER METER LOCATION.
D. METER SHALL BE INSTALLED IN SIDEWALK AND BEDDED WITH 3" OF SAND OR SOIL FREE OF ORGANIC MATERIAL, ROCK OR OTHER MATERIAL THAT COULD DAMAGE SERVICE LINE.

1" SERVICE COMPONENTS:
1. 1" US & COPPER OR PEX TYPE 'A' PIPE
2. 2" DIA. HOPE PIPE - 30" DEEP
3. 2" DIA. HOPE PIPE - 30" DEEP
4. 2" DIA. HOPE PIPE - 30" DEEP
5. 2" DIA. HOPE PIPE - 30" DEEP
6. 2" DIA. HOPE PIPE - 30" DEEP
7. 2" DIA. HOPE PIPE - 30" DEEP
8. 2" DIA. HOPE PIPE - 30" DEEP
9. 2" DIA. HOPE PIPE - 30" DEEP
10. 2" DIA. HOPE PIPE - 30" DEEP
11. 2" DIA. HOPE PIPE - 30" DEEP
12. 2" DIA. HOPE PIPE - 30" DEEP

NO LEAD FITTINGS OR COMPONENTS. NO COPPER SHALL BE USED ON COPPER FRANCHISE. 12 GAUGE TRACER WIRE SHALL BE INSTALLED AT 90° FROM WATER MAIN.

NO FITTING REQUIRED
PUBLIC PRIVATE

CITY OF LEWISTON, IDAHO
PUBLIC WORKS DEPARTMENT
STANDARD 1" WATER SERVICE CONNECTION
APPROVED FOR PUBLICATION: *Deanna Hillman* 12/17/15
City Engineer Date
DWG. NO. 4-7

FIRE HYDRANT W/ SHUT-OFF VALVE

TWO 2 1/2" HOSE CONNECTION W/ THREADS
HYDRANT OFFSET
MIN. 20"
FLANGE EXIST
SEE NOTE 2
SEE VALVE BOX AND ASSEMBLY DETAIL #4-2
GROUND
4" TO 6" TRENCH DEPTH
STANDPIPE
3" MINIMUM
1" TAP FOR SAMPLING CHLORINATION
6" FLANGED FIRE HYDRANT TEE
THRUST BLOCK
6" CLASS 50 DUCTILE IRON PIPE CUT TO LENGTH; IF OVER 100' IN LENGTH, 8" PIPE REQUIRED
6" GATE VALVE, FL X MJ
4"x8"x16" CONCRETE BLOCK
PLASTIC BARRIER BETWEEN THRUST BLOCK & TEE
BACKFILL TO TOP OF DRAIN RING HOUSING BOLTS WITH 3 CUBIC FEET OF WASHED ROCK
CONCRETE THRUST BLOCK CAST-IN-PLACE AGAINST FITTING ONLY
6' x 6' SHEET OF 11 MIL. PLASTIC OR CONSTRUCTION FABRIC, COVERING 2" WASHED ROCK

NOTES:
1. FIRE HYDRANT SHALL BE WUELLER SUPER CENTURION, WATEROUS PACER WITH 16" UPPER STANDPIPE OR EAST JORDAN IRON WORKS WATERMASTER.
2. HARRINGTON STORZ ADAPTER (4 1/2" NH x 5" STORZ) AND BLIND CAP (5" STORZ) W/ AIRCRAFT CABLE AT THE 4 1/2" PUMPER NOZZLE.
3. FIRE HYDRANT SHALL BE SPACED AT A MAX. OF 500 FEET IN RESIDENTIAL AREAS AND 300 FEET IN COMMERCIAL AREAS.
4. A MINIMUM 3 FOOT RADIUS OF UNOBSTRUCTED WORKING AREA SHALL BE PROVIDED AROUND ALL HYDRANTS.
5. GRIP PACKS OR ALL THREAD REQUIRED WITH THRUST BLOCK.

CITY OF LEWISTON, IDAHO
PUBLIC WORKS DEPARTMENT
FIRE HYDRANT W/ SHUT-OFF VALVE
APPROVED FOR PUBLICATION: *Deanna Hillman* 5/4/15
City Engineer Date
DWG. NO. 4-12

WASTEWATER PRIVATE SERVICE CONNECTION

PROPERTY OWNER IS RESPONSIBLE FOR THE WASTEWATER LATERAL INCLUDING THE TAP TO THE MAIN.

GENERAL LAYOUT
CLEANOUT
HOUSE BASEMENT
COMPACTED BACKFILL (SEE SPECS.)
45° BEND
TAP INTO TOP HALF OF PIPE
SLOPE: 1/4" PER FT RECOMMENDED [1/8" PER FT MIN.]
TAP OPTIONS FOR EXISTING MAIN, SEE DWG NO. 5-2
PRIVATE WASTEWATER LATERAL TO THE MAIN
UTILITY MARKER LOCATION
WITHIN R/W AREA 5' MIN. 3'-6" MIN.
STEEL POST PAINTED GREEN
MIN. 3' MIN.
COMPACTED BACKFILL (SEE SPECS.)
45° BEND
INSTALL APPROVED REMOVABLE PLUG
TAP INTO TOP HALF OF PIPE
SLOPE: 1/4" PER FT RECOMMENDED [1/8" PER FT MIN.]
SEE DWG NO. 5-2 FOR TAP OPTIONS

NOTE:
1. WASTEWATER SERVICE LATERALS SHALL BE CONNECTED TO SANITARY MAIN AT A POINT ABOVE THE HORIZONTAL CENTERLINE OF THE PIPE BUT NOT DIRECTLY TO THE TOP OF THE MAIN.
2. ALL CONNECTIONS AND WASTEWATER LINES CONNECTING WITH THE PUBLIC SYSTEM SHALL BE WATERTIGHT AND NO LESS THAN 4" IN DIAMETER FOR ALL NEW CONNECTIONS EXCEPT FOR 2" DIAMETER PRESSURE CONNECTIONS TO GRAVITY MAINS.
3. FLOOR DRAINS SUBJECT TO BACK PRESSURE OR BASEMENT DRAINS LESS THAN 1" ABOVE THE NEAREST ADJACENT SEWER MANHOLE SHALL BE EQUIPPED WITH AN APPROVED BACKWATER VALVE (SEE CITY SEC. 36-43).

CITY OF LEWISTON, IDAHO
PUBLIC WORKS DEPARTMENT
WASTEWATER PRIVATE SERVICE CONNECTION
APPROVED FOR PUBLICATION: *Deanna Hillman* 12/17/15
City Engineer Date
DWG. NO. 5-1

WASTEWATER SERVICE TAP OPTIONS DETAIL

EXISTING WASTEWATER
TRANSITION COUPLINE (2 REQ'D)
PVC SHORT COUPLING (2 REQ'D)
45° PVC WYE
FOR ANY PIPE MATERIAL 6" DIAMETER OR LESS

EXISTING WASTEWATER
PVC SADDLE WYE WITH STAINLESS STEEL CLAMPS
FOR SMOOTH WALL PVC AND POLYETHYLENE PIPE PIPE THROUGH 18" DIAMETER. OBTAIN CITY ENGINEER'S WRITTEN APPROVAL FOR LARGER PIPE.

NOTES:
1. WASTEWATER SERVICE LATERALS SHALL BE CONNECTED TO SANITARY MAIN AT A POINT ABOVE THE HORIZONTAL CENTERLINE OF THE PIPE BUT NOT DIRECTLY TO THE TOP OF THE MAIN.
2. FOR SANITARY MAIN PIPE OF 6" DIAMETER AND LARGER USE ROMAC STYLE 'CB' WASTEWATER SADDLE.

CITY OF LEWISTON, IDAHO
PUBLIC WORKS DEPARTMENT
WASTEWATER SERVICE TAP OPTIONS DETAIL
APPROVED FOR PUBLICATION: *Deanna Hillman* 12/17/15
City Engineer Date
DWG. NO. 5-2

WASTEWATER TYPE 1 MANHOLE

SEE CONCRETE MANHOLE COLLAR DETAIL, DWG NO. 5-6
SEE MH FRAME & COVER, DWG NO. 5-7
VERIFY "SEWER" UTILITY LABEL LETTERING ON COVER.
GRADE RINGS
INSTALL AS PER MANUFACTURER'S RECOMMENDATION
PRECAST MONOLITHIC ECCENTRIC CONE; USE OF CONCENTRIC CONE ONLY WITH PRIOR APPROVAL
PRECAST RISER SECTIONS
INSTALL AS PER MANUFACTURER'S RECOMMENDATION AND SPECIAL CONDITIONS FOR LOCATION
SHELF SLOPE 1" PER FOOT
PRECAST BASE & INTEGRAL RISER
6" OF 3/4" MINUS COMPACTED AGGREGATE

12 FEET MAXIMUM WITHOUT WRITTEN APPROVAL FROM PUBLIC WORKS DIRECTOR

NOTES:
1. ALL UNITS TO MEET OR EXCEED THE REQUIREMENTS OF ASTM C478/AASHTO M199. JOINTS SHALL BE RUBBER GASKET CONFORMING TO ASTM C443 AND SHALL BE GROUDED FROM THE INSIDE. LIFT HOLES SHALL BE GROUDED FROM THE OUTSIDE AND INSIDE OF THE MANHOLE.
2. PRECAST BASES SHALL BE FURNISHED WITH CUTOUTS OR KNOCKOUTS. KNOCKOUTS SHALL HAVE A WALL THICKNESS OF 2" MINIMUM.
3. CONNECTION TO MANHOLE SHALL BE MADE USING RESILIENT CONNECTOR CONFORMING TO ASTM C-923 SUCH AS KOR-N-SEAL, A-LOK OR APPROVED EQUAL.
4. RISERS, UNIT SECTIONS AND THE FRAME SHALL NOT BE MORE THAN ONE INCH OUT OF ALIGNMENT WITH THE MANHOLE BASE; PIPES SHALL BE FLUSH WITH INSIDE EDGE OF MANHOLE.
5. PRESSURE TESTING IS REQUIRED FOR ALL INSTALLATIONS.
6. SEE DWG NO 5-6 FOR CONCRETE MANHOLE COLLAR.
7. MAXIMUM SPACING BETWEEN MANHOLES IS 400 FEET.

CITY OF LEWISTON, IDAHO
PUBLIC WORKS DEPARTMENT
WASTEWATER TYPE 1 MANHOLE
APPROVED FOR PUBLICATION: *Deanna Hillman* 11/21/14
City Engineer Date
DWG. NO. 5-3

WASTEWATER CONCRETE MANHOLE COLLAR

SINGLE #4 REBAR HOOP
TOOLED JOINTS
8" DEEP CONCRETE COLLAR - FLUSH WITH ASPHALT SURFACE W/ SURFACE TOLERANCE OF +0 TO -1/4"
MH FRAME & COVER SEE CITY DWG 5-6
UNIMPROVED AREA
PAVED AREA
6" MIN. ONE ADJUSTMENT RING
CONCRETE COLLAR
GROUT BETWEEN RING AND COVER AND GRADE RINGS
COMPACTED FILL MIN. OF 92% TO 95% DRY DENSITY TEST

NOTES:
1. A CIRCULAR-SHAPED CONCRETE COLLAR IS REQUIRED ON ALL INSTALLATIONS; IN BOTH PAVED OR UNIMPROVED AREAS. INSTALL A 8" THICK CONCRETE COLLAR THAT SHALL BE FLUSH WITH THE ASPHALT SURFACE WITH A SURFACE TOLERANCE OF +0 TO -1/4".
2. CONCRETE SHALL BE 3,000 PSI MIN. AT 28 DAYS, WATER/CEMENT RATIO SHALL BE 0.5, 3" MAX. SLUMP AND 3% TO 6% ENTRAINED AIR WITH ONE #4 REBAR HOOP. FIBER-REINFORCED CONCRETE (ADDED PER MANUFACTURER'S RECOMMENDATIONS) MAY BE USED IN LIEU OF #4 REBAR.
3. ALL EDGES WILL BE SEALED WITH CSSI OR APPROVED EQUAL; ALL TOP EDGES WILL BE TACKED AND SAND SEALED.
4. UTILITY FRAMES AND LIDS ARE PREFERRED OUTSIDE OF WHEEL PATH, WHERE POSSIBLE.

CITY OF LEWISTON, IDAHO
PUBLIC WORKS DEPARTMENT
WASTEWATER CONCRETE MANHOLE COLLAR
APPROVED FOR PUBLICATION: *Deanna Hillman* 12/17/15
City Engineer Date
DWG. NO. 5-6


NO.	DATE	BY	DESCRIPTION
1	08/22/18	MCR	CITY COMMENTS 08/16/18

CITY STANDARD DETAILS
CRESTLINE CIRCLE DRIVE
VALLEY VISTA PUD
LEWISTON, ID 83501

KELTIC ENGINEERING, INC.

315 Adams Lane • Lewiston, Idaho 83501 • (208) 743-2135 • (208) 743-2136 fax
Development • Planning • Design • Construction Management

DRAWN BY:	CHECKED BY:
DESIGNED BY:	EFP
DATE:	07/13/18
LAST REV:	08/22/18
PROJECT NO.	17-0089
SHEET NO.	C13 OF C14

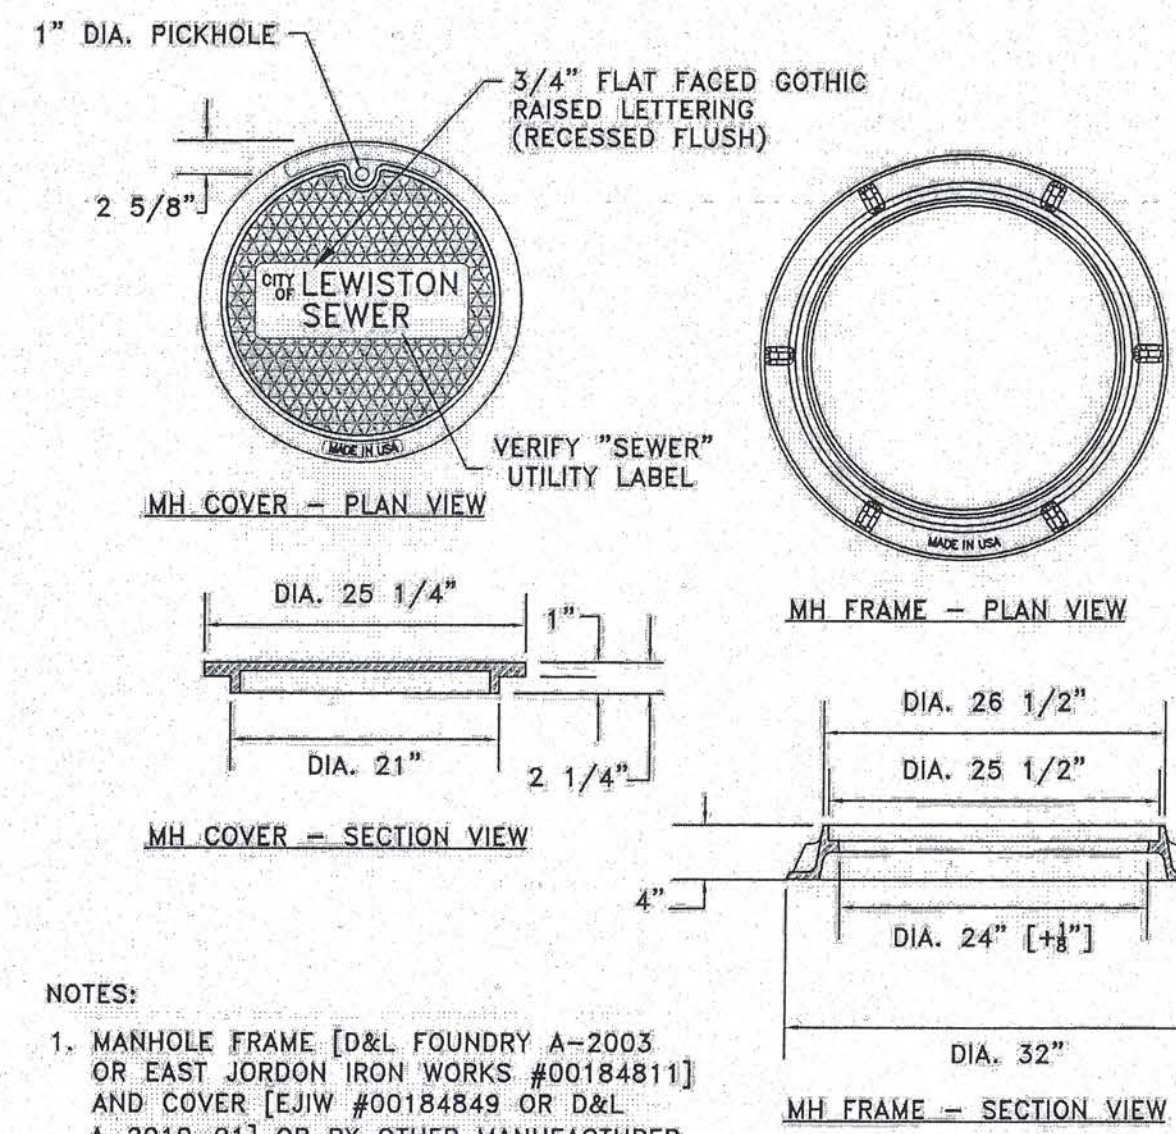


- NOTES:
- MANHOLE FRAME [D&L FOUNDRY A-2003 OR EAST JORDAN IRON WORKS #00184811] AND COVER [EJW #00184849 OR D&L A-2010-01] OR BY OTHER MANUFACTURER WILL BE ACCEPTABLE ONLY WITH WRITTEN APPROVAL FROM PUBLIC WORKS DEPT.; VERIFY "SEWER" UTILITY LABEL LETTERING ON COVER.
 - COVER MATERIAL SPECIFICATION GRAY IRON (ASTM A48 CL35B)
 - IN AREAS OF HIGH STORMWATER INFILTRATION, LIDS SHALL HAVE GASKETED AND BOLTED.

CITY OF LEWISTON, IDAHO
PUBLIC WORKS DEPARTMENT

WASTEWATER
MANHOLE FRAME
AND COVER

APPROVED FOR PUBLICATION
Sean Stiller 11/11/10
City Engineer Date

DWG. NO.
5-7

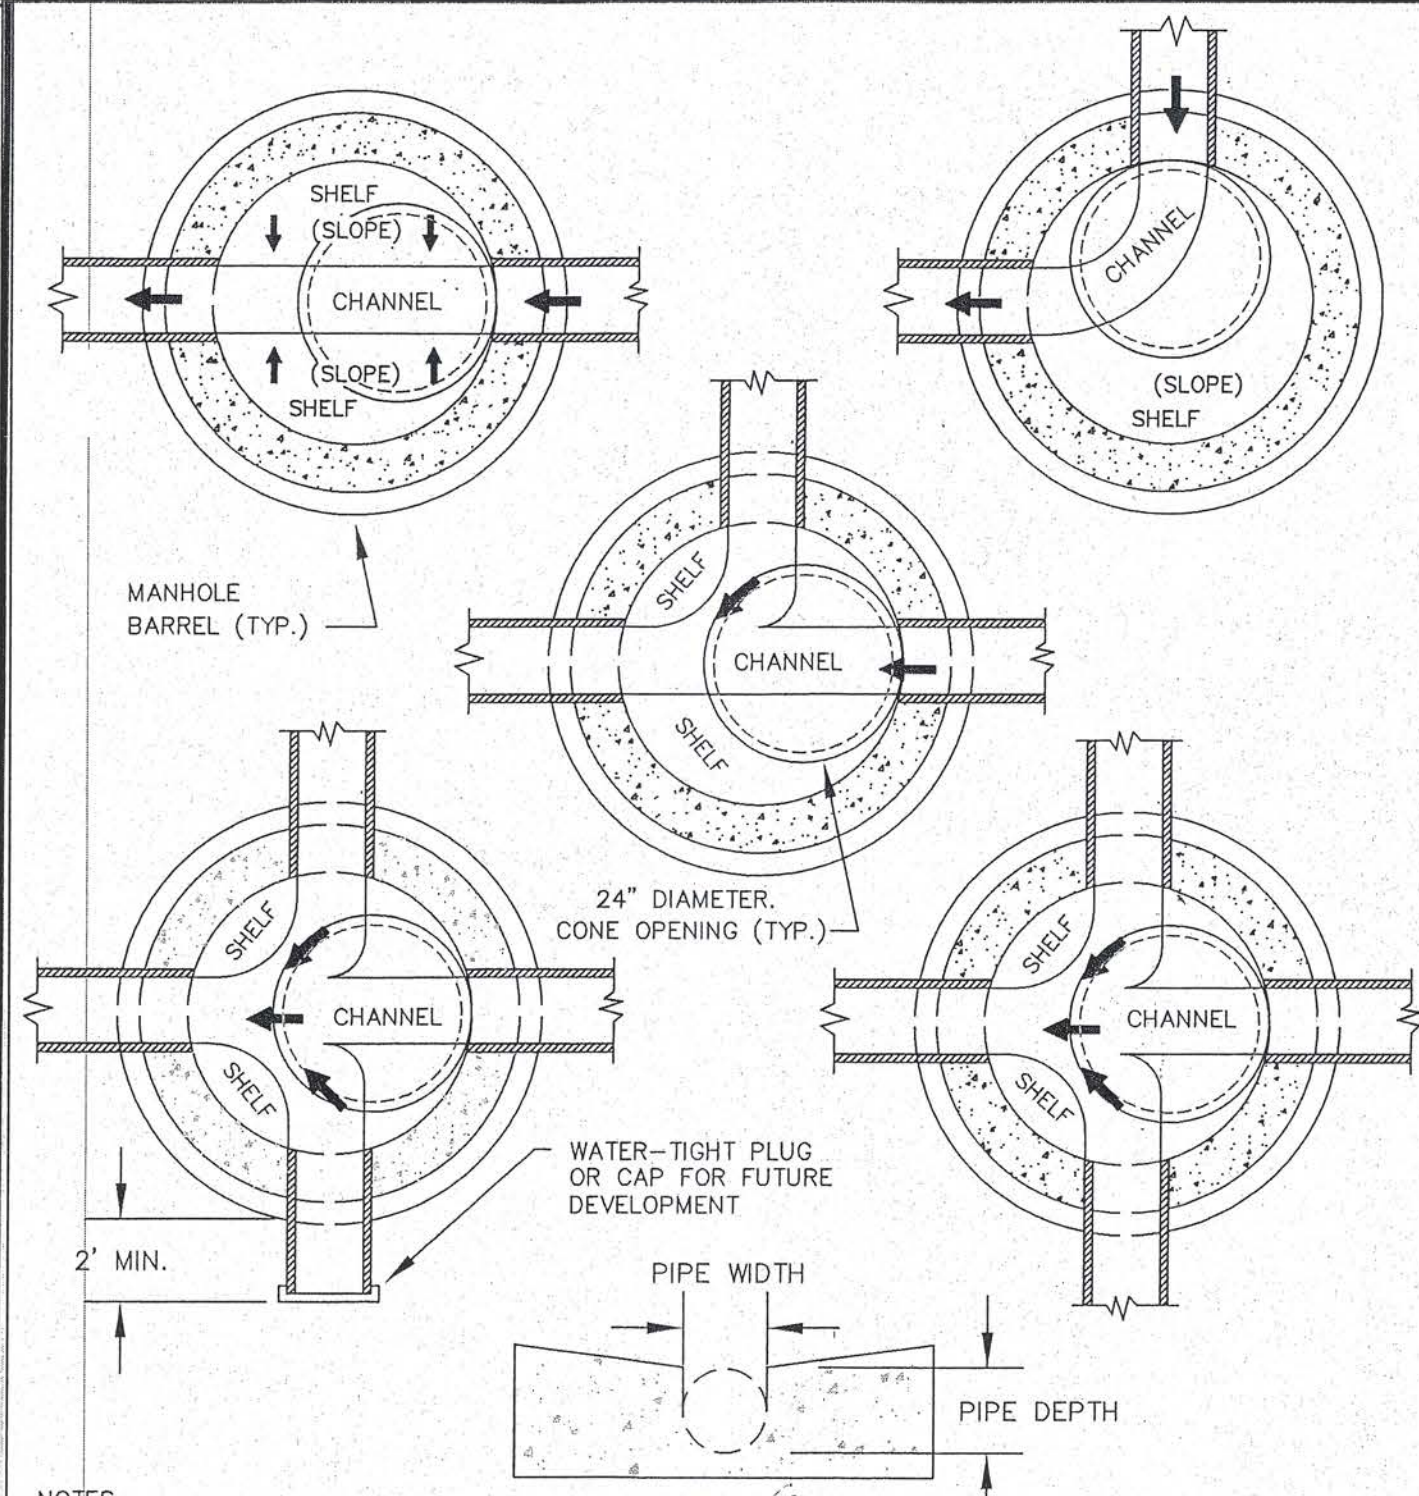

- NOTES:
- SLOPE ALL SHELVES TO CHANNEL AT 1:12.
 - SEE PLAN & PROFILE SHEETS FOR SLOPE OF CHANNEL.
 - FOR PIPES OF DIFFERENT SIZES, THE TOP OF PIPE (CROWN) SHALL BE AT THE SAME ELEVATION.
 - OFFSET CONE 24" DIAMETER OPENING CENTERED OVER UPSTREAM PIPE INVERT.

CITY OF LEWISTON, IDAHO
PUBLIC WORKS DEPARTMENT

WASTEWATER
MANHOLE CHANNEL
DETAIL

APPROVED FOR PUBLICATION
Sean Stiller 9-22-15
City Engineer Date

DWG. NO.
5-8


- GENERAL NOTES FOR STORMWATER SYSTEMS
- ALL WORK SHALL CONFORM TO CURRENT IDAHO STANDARDS FOR PUBLIC WORKS CONSTRUCTION (ISPCW) SPECIFICATIONS AND THE CITY OF LEWISTON STANDARDS AND SPECIFICATIONS. IN THE CASE OF CONFLICT, CITY STANDARDS SHALL PREVAIL. THE LEWISTON STORMWATER POLICY AND DESIGN MANUAL DEFINES THE POLICIES, MINIMUM STANDARDS, REQUIREMENTS, AND PROCEDURES FOR THE DESIGN, CONSTRUCTION, AND MAINTENANCE OF PRIVATE STORMWATER SYSTEMS.
 - ANY REPAIR, MAINTENANCE OR ALTERATION OF A PUBLIC STORM LINE OR DRAINAGE MUST BE APPROVED BY CITY ENGINEER.
 - THE CONTRACTOR MUST SECURE APPROVAL FROM THE CITY ENGINEER PRIOR TO ADDING OR REMOVING FILL BACKFILL OVER PUBLIC STORM DRAIN MAINLINE.
 - THE ENGINEERING INSPECTOR SHALL BE NOTIFIED AT LEAST FORTY-EIGHT (48) HOURS PRIOR TO COMMENCING WORK ON STORM DRAINS.
 - ALL PUBLIC STORM DRAIN LINES SHALL BE VIDEO TAPED AND SUBMITTED TO THE PUBLIC WORKS DEPARTMENT [AS PER PUBLIC WORKS POLICY NO. 2012-2] AND APPROVAL PRIOR TO PAVING. CITY SHALL HAVE FORTY-EIGHT (48) HOURS FOR REVIEW.
 - ALL MANHOLES AND CATCH BASINS SHALL BE INSPECTED TWICE BY THE ENGINEERING INSPECTOR - ONCE PRIOR TO BACKFILL AND THEN PRIOR TO ACCEPTANCE OF IMPROVEMENTS. CALL PWD MAIN OFFICE (208) 746-1316 FOR INSPECTION SCHEDULING.
 - CLOSED CONDUITS (OR PIPELINES) FOR STORMWATER CONVEYANCE IN THE CITY'S STORMWATER SYSTEM MUST BE A MINIMUM OF 12 INCH DIAMETER. THE PIPE MATERIAL MAY BE PLASTIC, STEEL, REINFORCED CONCRETE OR AN APPROVED MATERIAL.
 - MINIMUM PIPE SLOPE SHALL BE 0.5% AND MINIMUM DESIGN VELOCITY WHEN FLOWING FULL SHALL BE NOT LESS THAN 2 FEET PER SECOND AND MAXIMUM VELOCITY SHALL NOT BE MORE THAN 8 FEET PER SECOND.
 - JUNCTIONS OF 3 OR MORE PIPES, CHANGES IN ALIGNMENT, SLOPE AND/OR CHANGES IN PIPE DIAMETER SHALL BE MADE ONLY AT CATCH BASINS OR MANHOLES.
 - STEEP SLOPE INSTALLATION SHALL BE INSTALLED AS PER MANUFACTURERS PIPE SPECIFICATIONS.
 - MANHOLE SHALL BE INSTALLED AT THE END OF EACH LINE. AT ALL CHANGE IN SIZE OR ALIGNMENT, AT DISTANCE NOT GREATER THAN 400 FEET OR AT CITY ENGINEER'S REQUIRED SPACING. ALL OTHER CHANGES IS SPACING MUST HAVE WRITTEN APPROVAL FROM PUBLIC WORKS DEPARTMENT.
 - LOCATING WIRE SHALL BE INSTALLED WITH ALL PUBLIC STORM PIPE INSTALLATIONS. SEE CITY DWG 1-8, "IDENTIFYING TAPE DETAIL".
 - CATCH BASINS AND MANHOLES SHALL BE ACCESSIBLE TO VEHICLES AND EQUIPMENT FOR MAINTENANCE AND BE WITHIN RIGHT-OF-WAY OF A MINIMUM EASEMENT WIDTH OF 20 FEET. PROPOSED ACCESS ROUTE MUST BE APPROVED BY CITY ENGINEER. MAINTENANCE ACCESS ROUTE THAT DO NOT FOLLOW THE STORMLINE MUST HAVE A MINIMUM 12' EASEMENT.

CITY OF LEWISTON, IDAHO
PUBLIC WORKS DEPARTMENT

STORMWATER SYSTEM
GENERAL NOTES

APPROVED FOR PUBLICATION
Sean Stiller 11/21/16
City Engineer Date

DWG. NO.
6-1

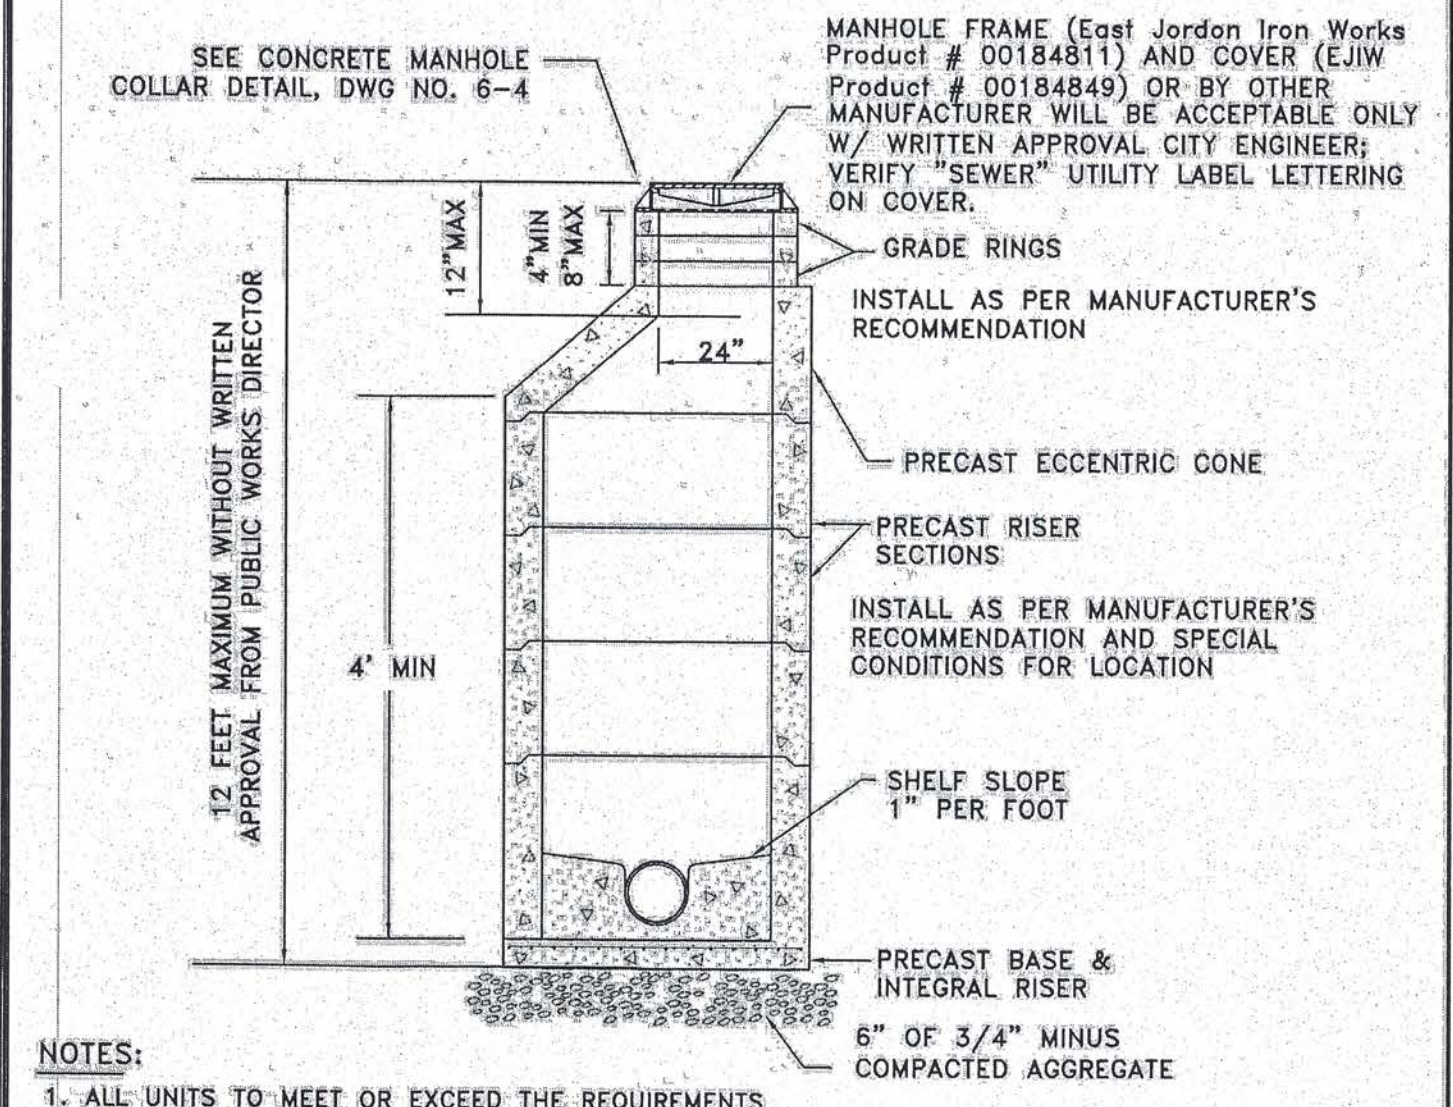


- NOTES:
- ALL UNITS TO MEET OR EXCEED THE REQUIREMENTS OF ASTM C478/AASHTO M199. JOINTS SHALL BE RUBBER GASKET CONFORMING TO ASTM C443 AND SHALL BE GROUDED FROM THE INSIDE. LIFT HOLES BE GROUDED FROM THE OUTSIDE AND INSIDE OF THE MANHOLE.
 - PRECAST BASES SHALL BE FURNISHED WITH CUTOUTS OR KNOCKOUTS. KNOCKOUTS SHALL HAVE A WALL THICKNESS OF 2" MINIMUM.
 - CONNECTION TO MANHOLE SHALL BE MADE USING RESILIENT CONNECTOR CONFORMING TO ASTM C-923 SUCH AS KOR-N-SEAL, A-LOK OR APPROVED EQUAL. HAVE A WALL THICKNESS OF 2" MINIMUM.
 - USE A MINIMUM OF 1/2" OF NON-SHRINK GROUT BETWEEN RISERS, CONE AND FRAME.
 - RISERS, UNIT SECTIONS AND THE FRAME SHALL NOT BE MORE THAN ONE INCH OUT OF ALIGNMENT WITH THE MANHOLE BASE; PIPES SHALL BE FLUSH WITH INSIDE EDGE OF MANHOLE.
 - SEE DWG NO 6-4 FOR CONCRETE MANHOLE COLLAR.

CITY OF LEWISTON, IDAHO
PUBLIC WORKS DEPARTMENT

STORMWATER
TYPE 1 MANHOLE

APPROVED FOR PUBLICATION
Sean Stiller 12/13/10
City Engineer Date

DWG. NO.
6-2

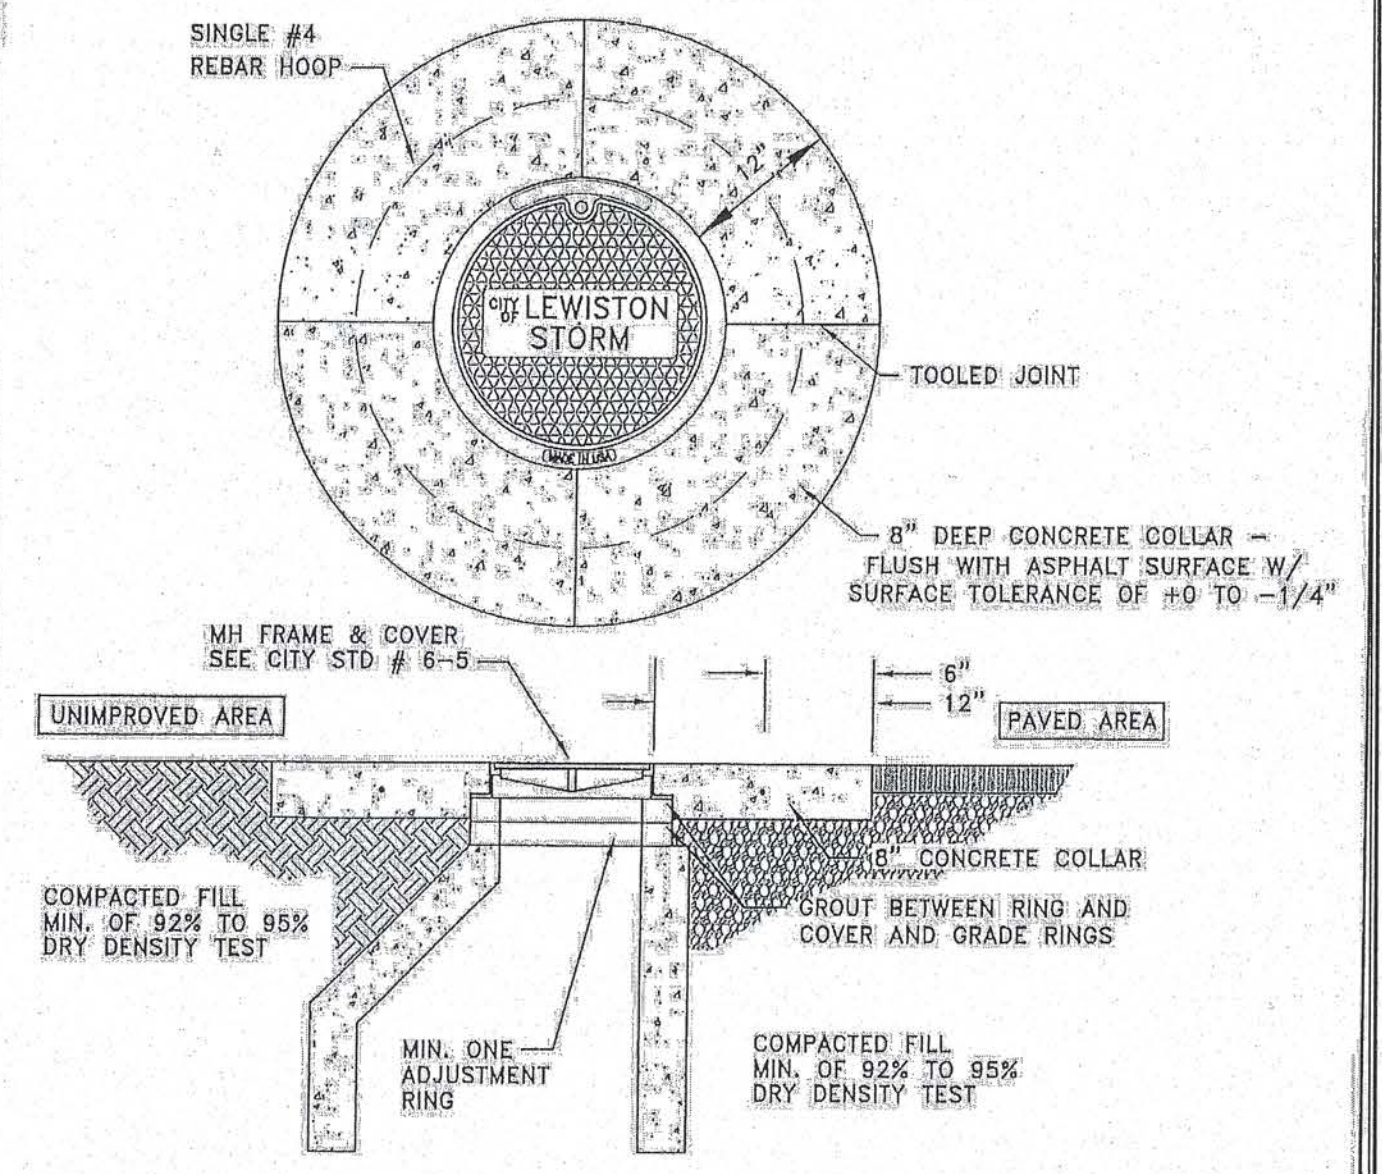


- NOTES:
- A CIRCULAR-SHAPED CONCRETE COLLAR IS REQUIRED ON ALL INSTALLATIONS; IN BOTH PAVED OR UNIMPROVED AREAS, INSTALL A 8" THICK CONCRETE COLLAR THAT SHALL BE FLUSH WITH THE ASPHALT SURFACE WITH A SURFACE TOLERANCE OF +0 TO -1/4".
 - CONCRETE SHALL BE 3,000 PSI MIN. AT 28 DAYS, WATER/CEMENT RATIO SHALL BE 0.5, 3" MAX. SLUMP AND 3% TO 6% ENTRAINED AIR WITH ONE #4 REBAR HOOP, FIBER-REINFORCED CONCRETE (ADDED PER MANUFACTURER'S RECOMMENDATIONS) MAY BE USED IN LIEU OF #4 REBAR.
 - ALL EDGES WILL BE SEALED WITH CSSI OR APPROVED EQUAL; ALL TOP EDGES WILL BE TACKED AND SAND SEALED.
 - UTILITY FRAMES AND LIDS ARE PREFERRED OUTSIDE OF WHEEL PATH, WHERE POSSIBLE.

CITY OF LEWISTON, IDAHO
PUBLIC WORKS DEPARTMENT

CONCRETE
MANHOLE COLLAR

APPROVED FOR PUBLICATION
Sean Stiller 1/27/15
City Engineer Date

DWG. NO.
6-4

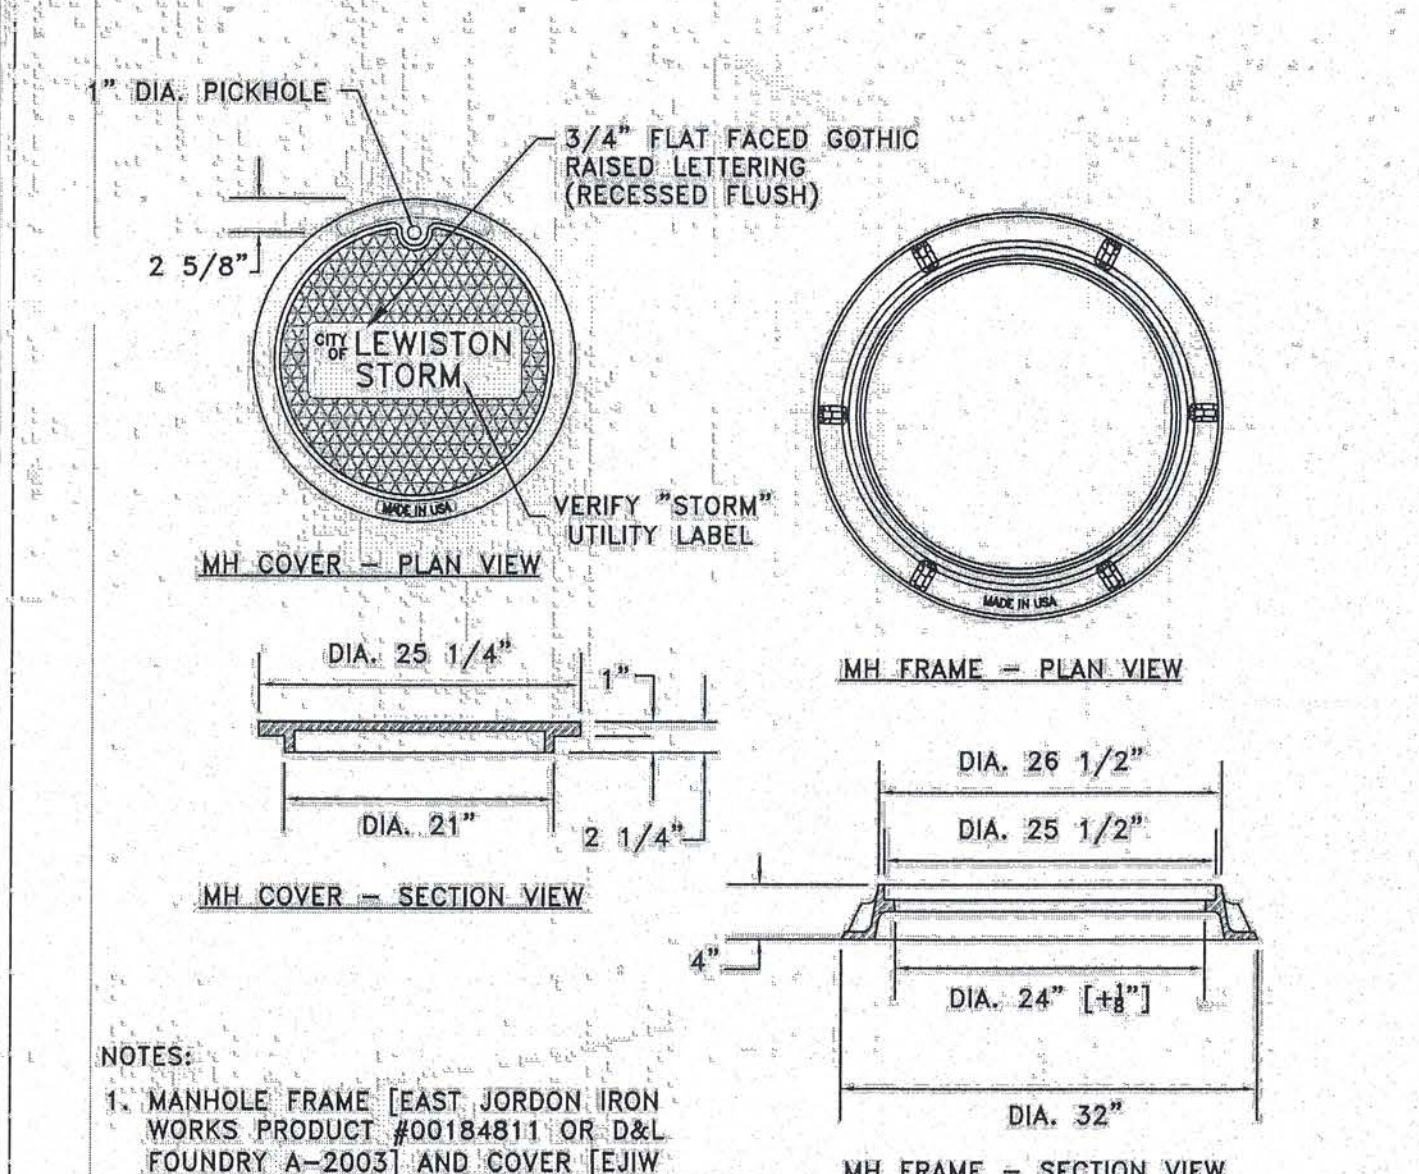

- NOTES:
- MANHOLE FRAME [EAST JORDAN IRON WORKS PRODUCT #00184811 OR D&L FOUNDRY A-2003] AND COVER [EJW #00184849 OR D&L A-2010-01] OR OTHER MANUFACTURER WILL BE ACCEPTABLE ONLY WITH WRITTEN APPROVAL FROM PUBLIC WORKS DEPT.; VERIFY "STORM" UTILITY LABEL LETTERING ON COVER.
 - COVER MATERIAL SPECIFICATION GRAY IRON (ASTM A48 CL35B)

CITY OF LEWISTON, IDAHO
PUBLIC WORKS DEPARTMENT

STORMWATER
MANHOLE FRAME
AND COVER

APPROVED FOR PUBLICATION
Sean Stiller 12/13/10
City Engineer Date

DWG. NO.
6-5


- GENERAL NOTES FOR CATCH BASINS
- ALL UNITS TO MEET OR EXCEED THE REQUIREMENTS OF ASTM C478/AASHTO M199.
 - ALL CURB INLET STRUCTURES SHALL HAVE A MINIMUM 12" SUMP WITH THREE 1 1/2" DIA. WEEP HOLES IN BASE AND MINIMUM OF 12" OF COMPACTED 5/8" MINUS UNDER BASE, CRUSHED AGGREGATE MATERIAL COMPACTED TO 95% MODIFIED PROCTOR AS PER AASHTO T192.
 - A CATCH BASIN SHALL BE INSTALLED UPHILL TO EACH INTERSECTION CORNER RADIUS AND SPACED NO MORE THAN 400 FEET ALONG THE LENGTH OF THE STREET OR AT CITY ENGINEER'S REQUIRED SPACING. ADJUSTMENTS TO SPACING SHALL REQUIRE CALCULATIONS TO VERIFY THE CHANGES HAVE MET CITY SPECIFICATIONS.
 - PRECAST BASES SHALL BE FURNISHED WITH CUTOUTS OR KNOCKOUTS. KNOCKOUTS SHALL HAVE A WALL THICKNESS OF 2" MINIMUM.
 - ALL PIPES SHALL BE FLUSH WITH BASIN WALL AND SHALL BE MORTARED ALL AROUND.
 - USE CITY STD DWG NO. 6-7 FOR CATCH BASIN FRAME AND GRATE.
 - REDUCTION SLAB, RISERS, AND FRAME & GRATE SHALL NOT BE MORE THAN ONE INCH OUT OF VERTICAL ALIGNMENT WITH CATCH BASIN BASE.
 - MAXIMUM DEPTH FROM FINISHED GRADE TO PIPE INVERT IS 5 FEET.
 - USE A MINIMUM OF 1/2" NON-SHRINK GROUT BETWEEN RISERS, BASE AND FRAME.
 - CURB INLET TO BE PLACED WITHIN A TOLERANCE OF 1/2" HORIZONTAL ALIGNMENT FROM CURB LINE.
 - SET GRATE 1" LOWER THAN PROPOSED FLOWLINE TO ENSURE POSITIVE DRAINAGE INTO CATCH BASIN; CURB FLOWLINE SHALL BE TRANSITION TO 3" ON EACH SIDE OF THE CATCH BASIN TO ADJUST FOR 1" DROP. GUTTER LIP AND TOP OF CURB ARE NOT TO BE DEPRESSED.

CITY OF LEWISTON, IDAHO
PUBLIC WORKS DEPARTMENT

STORMWATER
GENERAL CATCH BASIN
NOTES

APPROVED FOR PUBLICATION
Sean Stiller 12/13/10
City Engineer Date

DWG. NO.
6-6

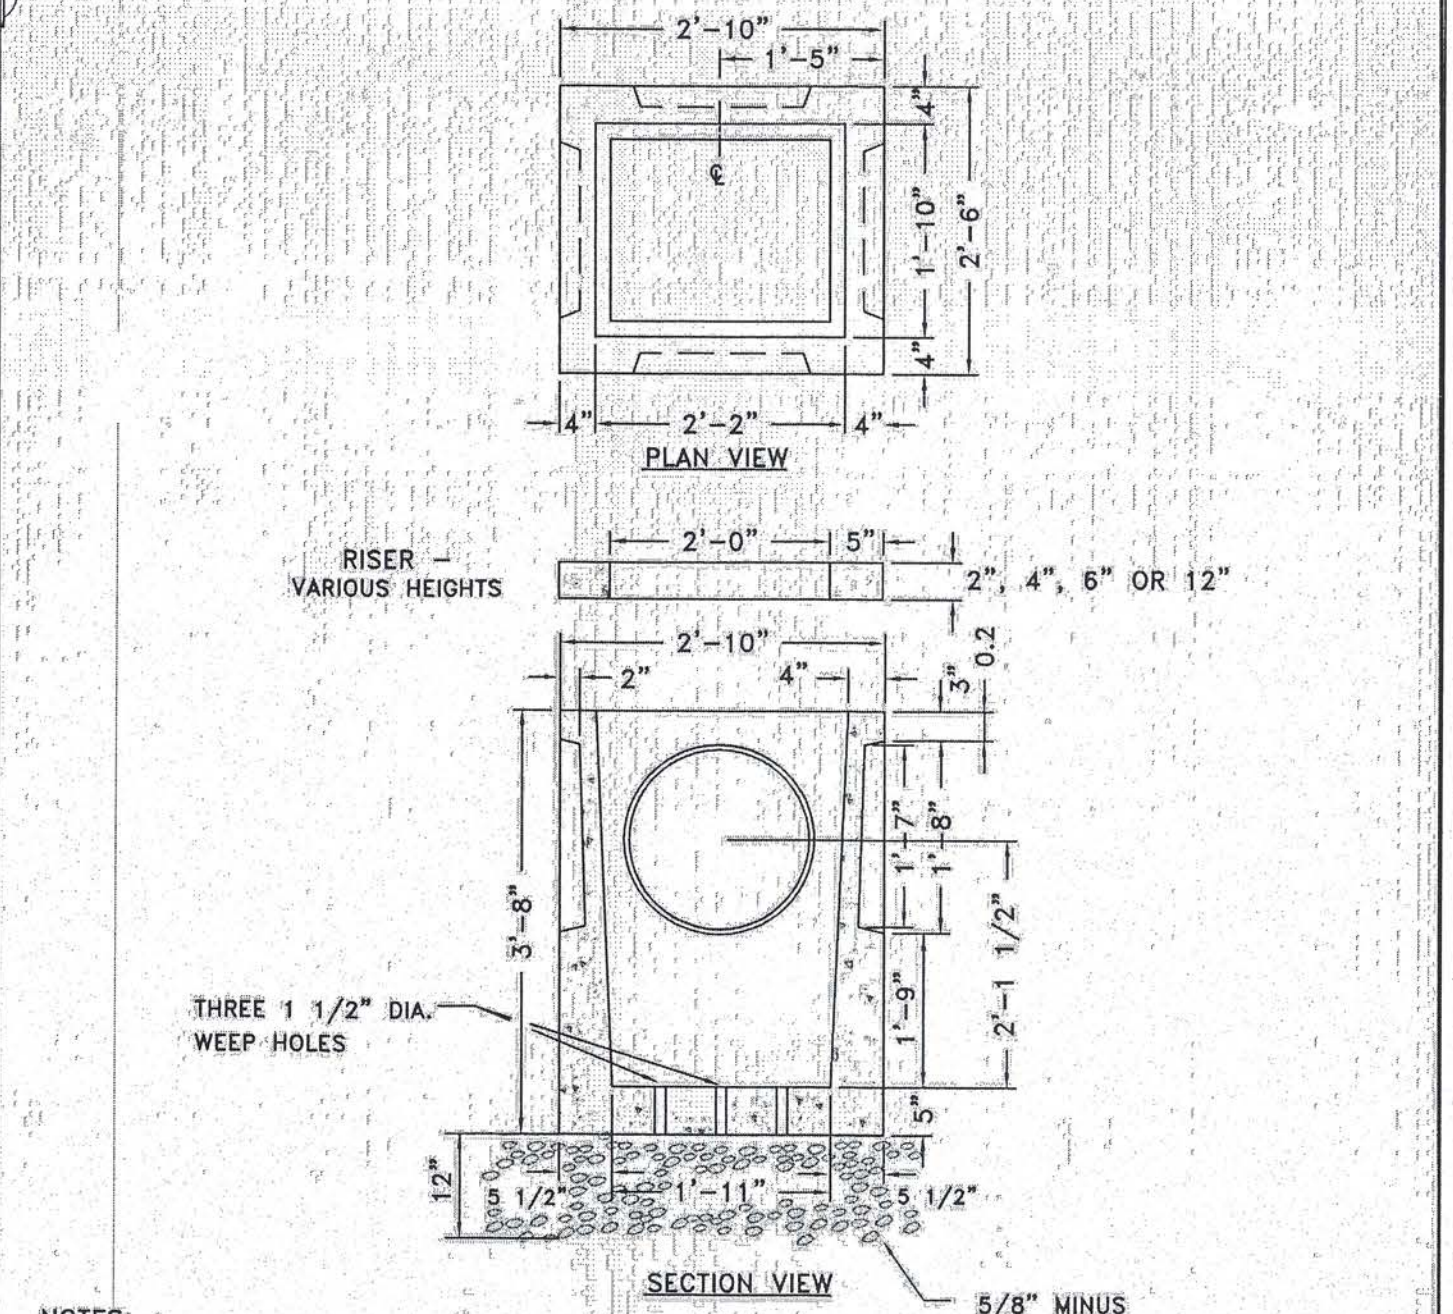

- NOTES:
- TYPICAL CATCH BASIN [WILBERT PRECAST PRODUCT #1827] AND RISERS [WILBERT PRECAST #1830 (FOR 12") OR #1831-2,4,6 (FOR 2", 4" OR 6")] OR BY OTHER MANUFACTURER WILL BE ACCEPTABLE ONLY WITH WRITTEN APPROVAL FROM PUBLIC WORKS DEPT.
 - SEE CITY DWG 6-6 "GENERAL NOTES FOR CATCH BASINS".

CITY OF LEWISTON, IDAHO
PUBLIC WORKS DEPARTMENT

STORMWATER
TYPE 1 CATCH BASIN

APPROVED FOR PUBLICATION
Sean Stiller 12/13/10
City Engineer Date

DWG. NO.
6-8

DESCRIPTION	CITY COMMENTS 08/16/18
BY	
DATE	08/22/18
NO.	

CITY STANDARD DETAILS
CRESTLINE CIRCLE DRIVE
VALLEY VISTA PUD
LEWISTON, ID 83501

KELTIC ENGINEERING, INC.

315 Adams Lane • Lewiston, Idaho 83501 • (208) 745-2155 • (208) 745-2156 fax
• Development • Planning • Design • Construction Management

DRAWN BY:	CHECKED BY:
MSR	EFH
DESIGNED BY:	EFH
DATE:	07/13/18
LAST REV:	08/22/18
PROJECT NO.	17-0089
SHEET NO.	C14 OF C14