


City of Lewiston

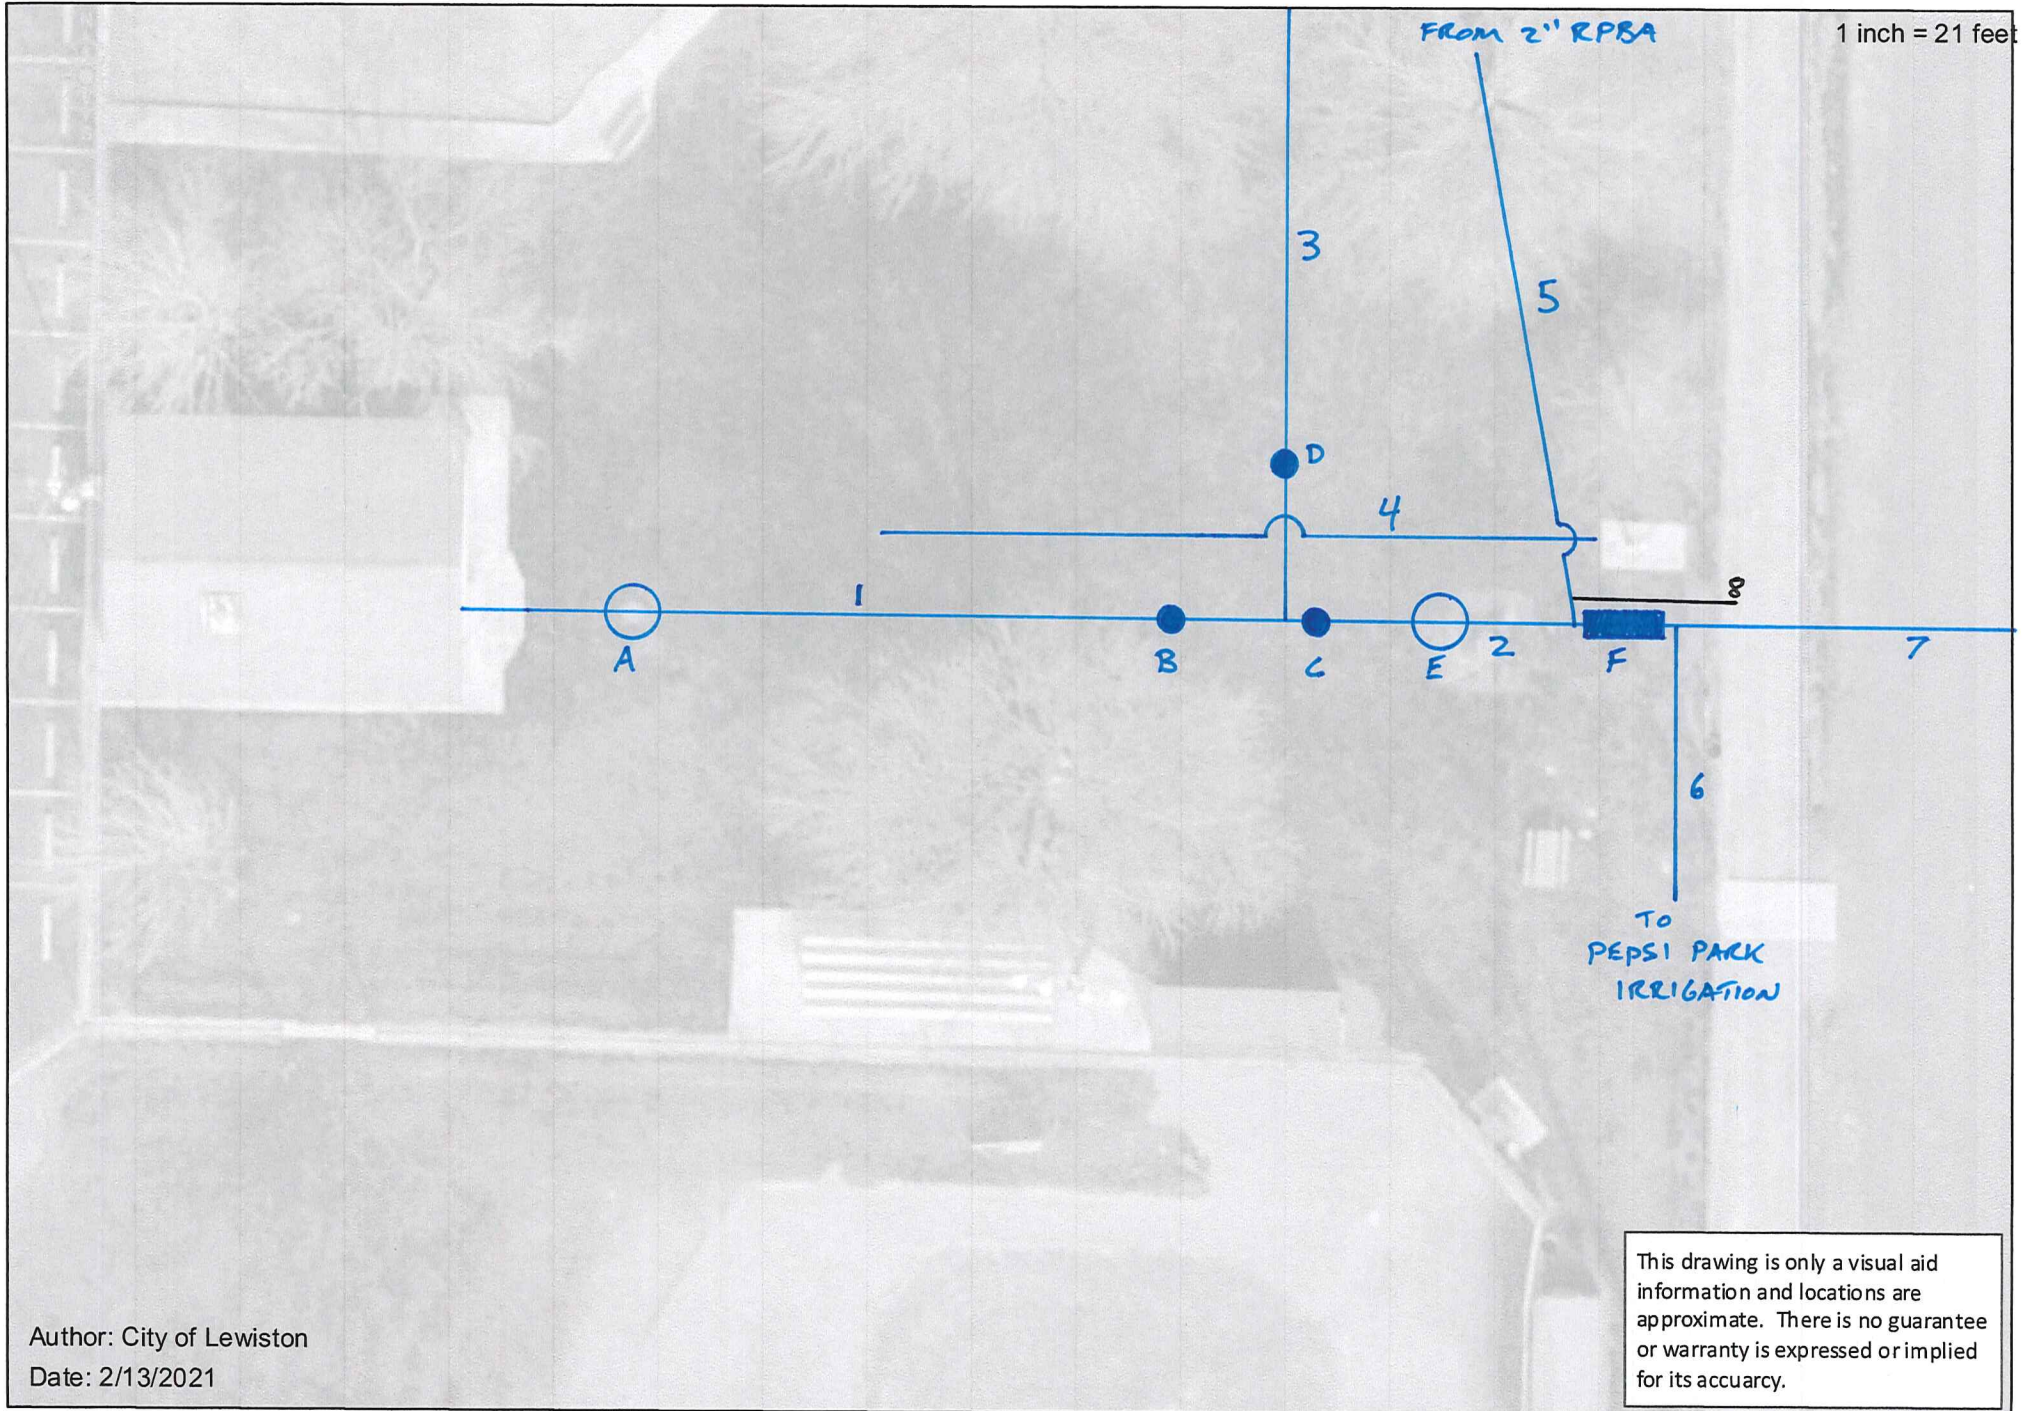

Author: City of Lewiston
Date: 2/13/2021

This drawing is only a visual aid information and locations are approximate. There is no guarantee or warranty is expressed or implied for its accuracy.