
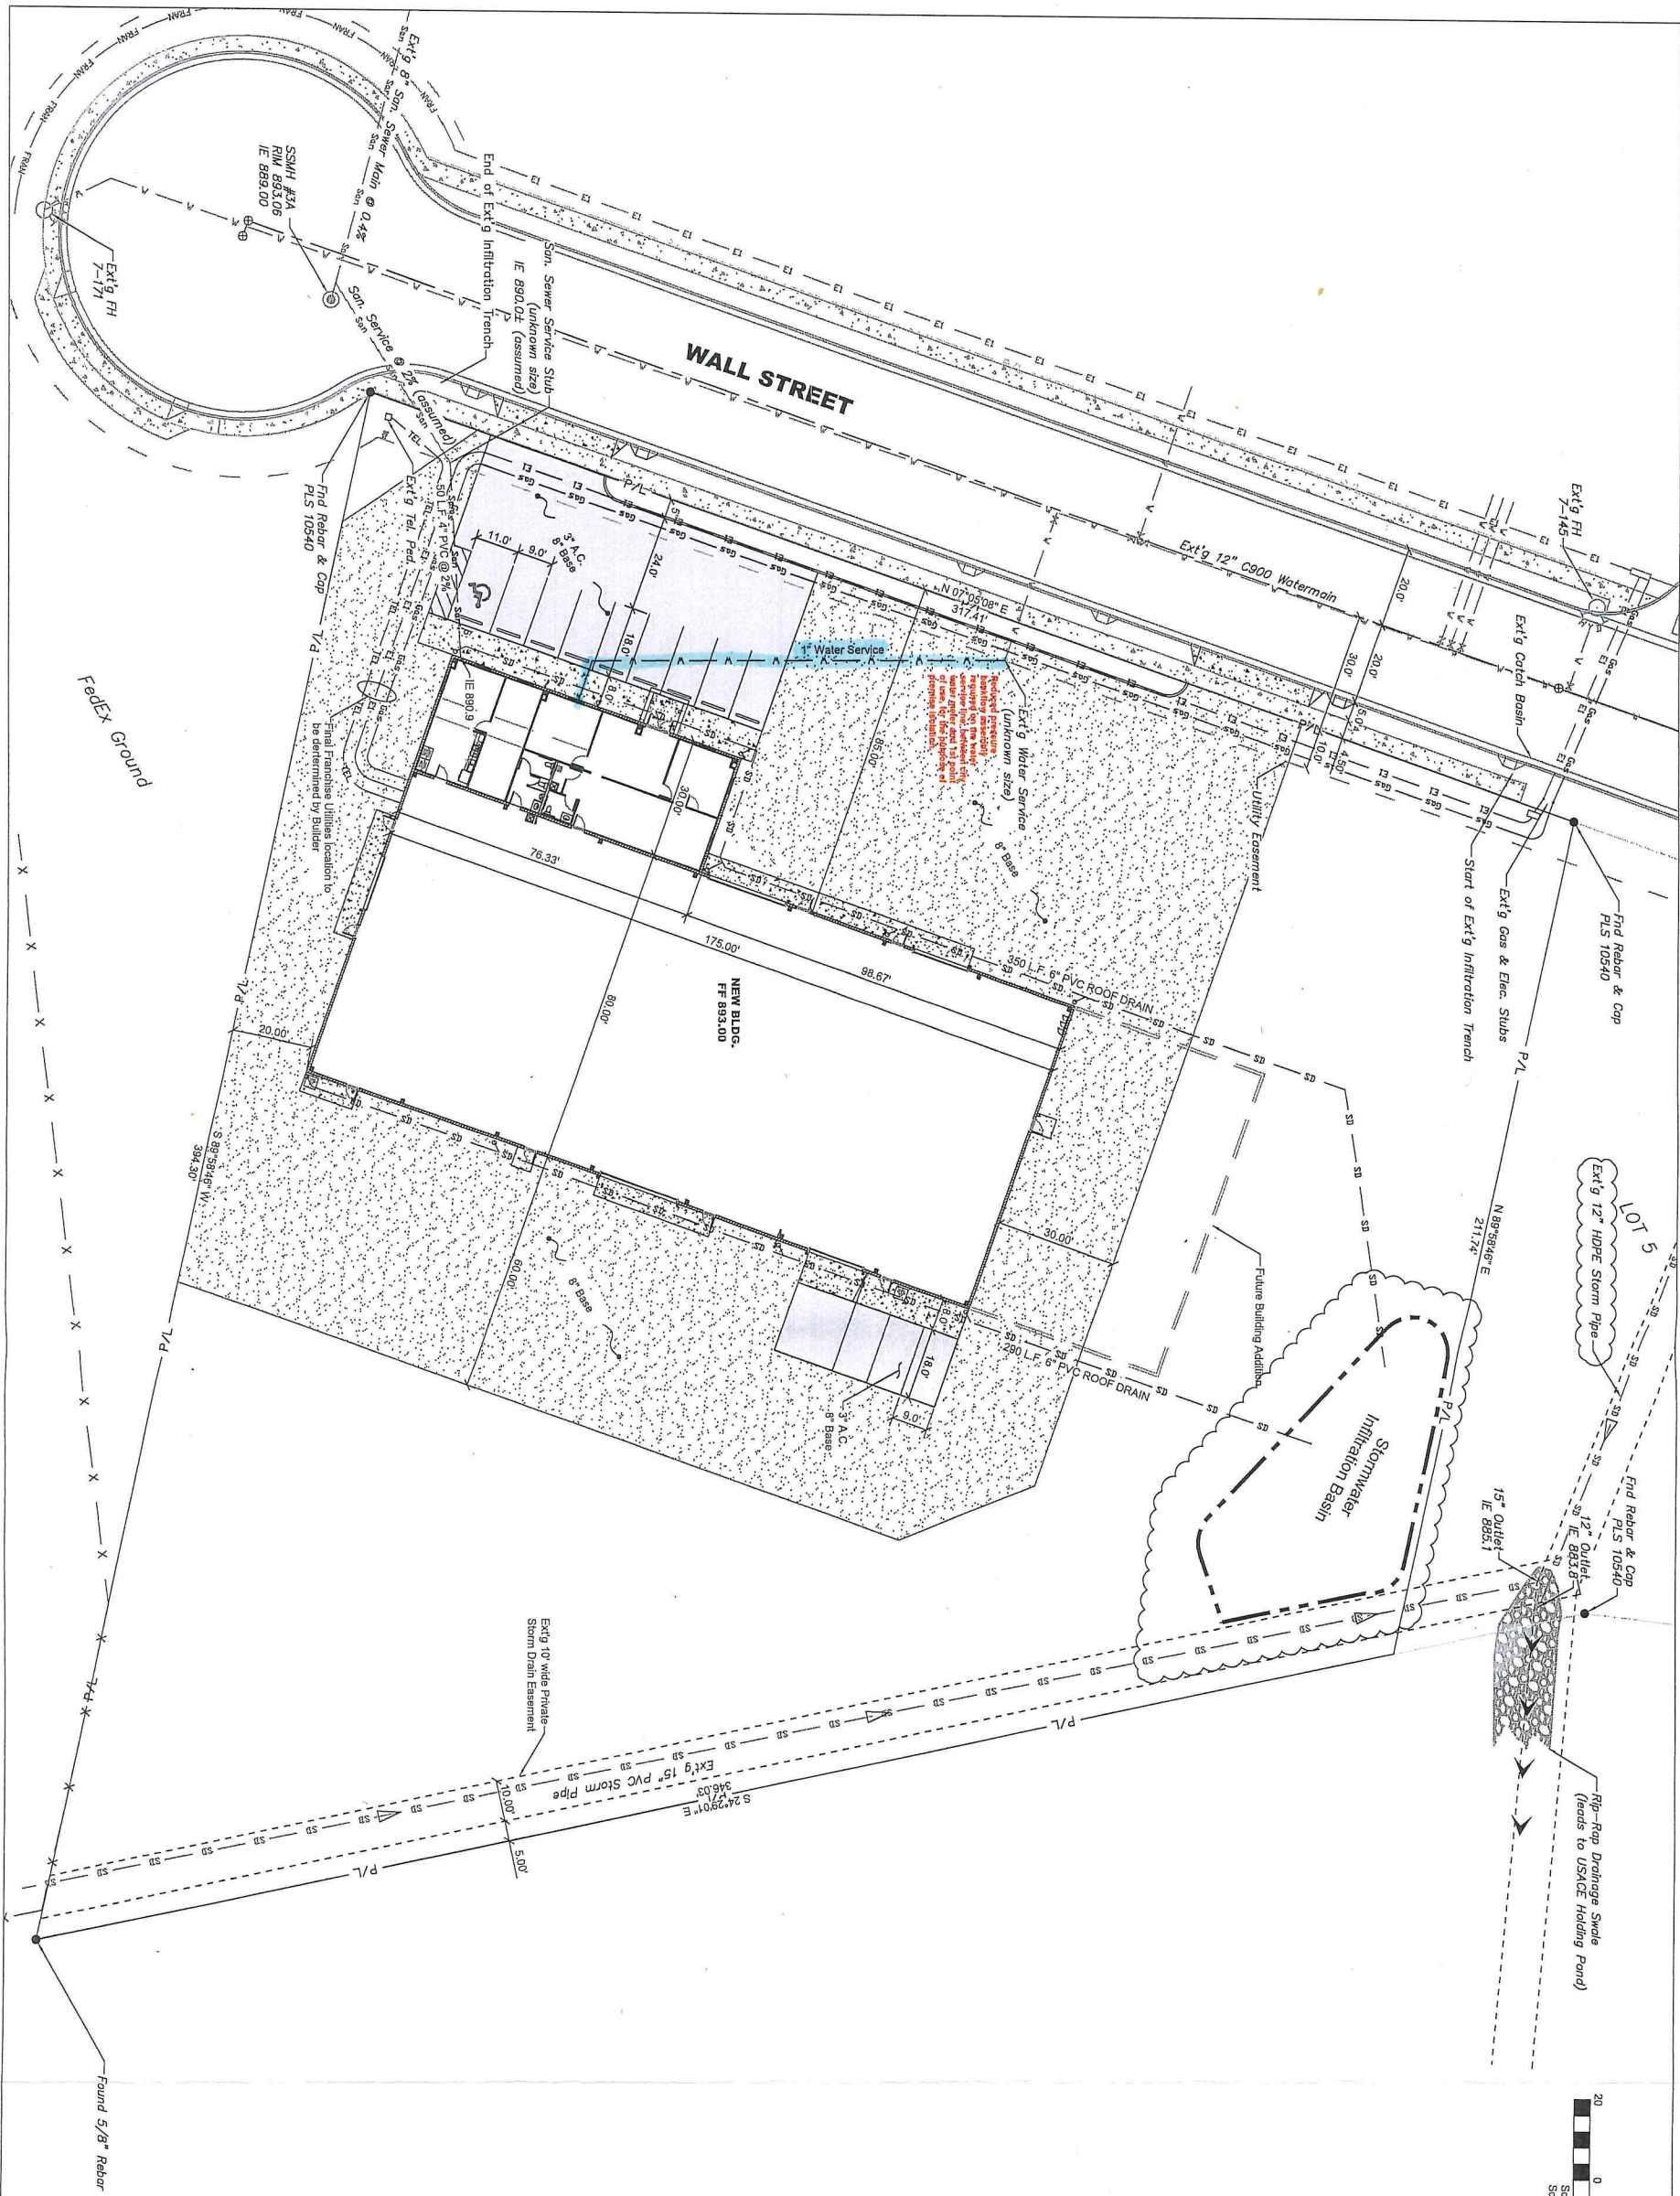


HAMMOND ENGINEERING & DEVELOPMENT CO.
528 BRYDEN AVENUE LEWISTON, IDAHO 83501
(208) 798-5422

**BSM, INC. - FAB SHOP
SITE DEVELOPMENT PLAN
LEWISTON, IDAHO**

SCALE	1"=20'
SHEET SIZE	D
DRAWN BY	MEE
CHECKED BY	JSH
DATE	10-04-16
JOB #	1611
SHEET	C4
DRAWING #	1611-C4

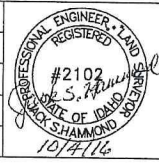

REVISION		CHECKED	APPD.
REV	DATE		
A	12-08-16		
Revised Prop. Boundary & Stormwater Basin			