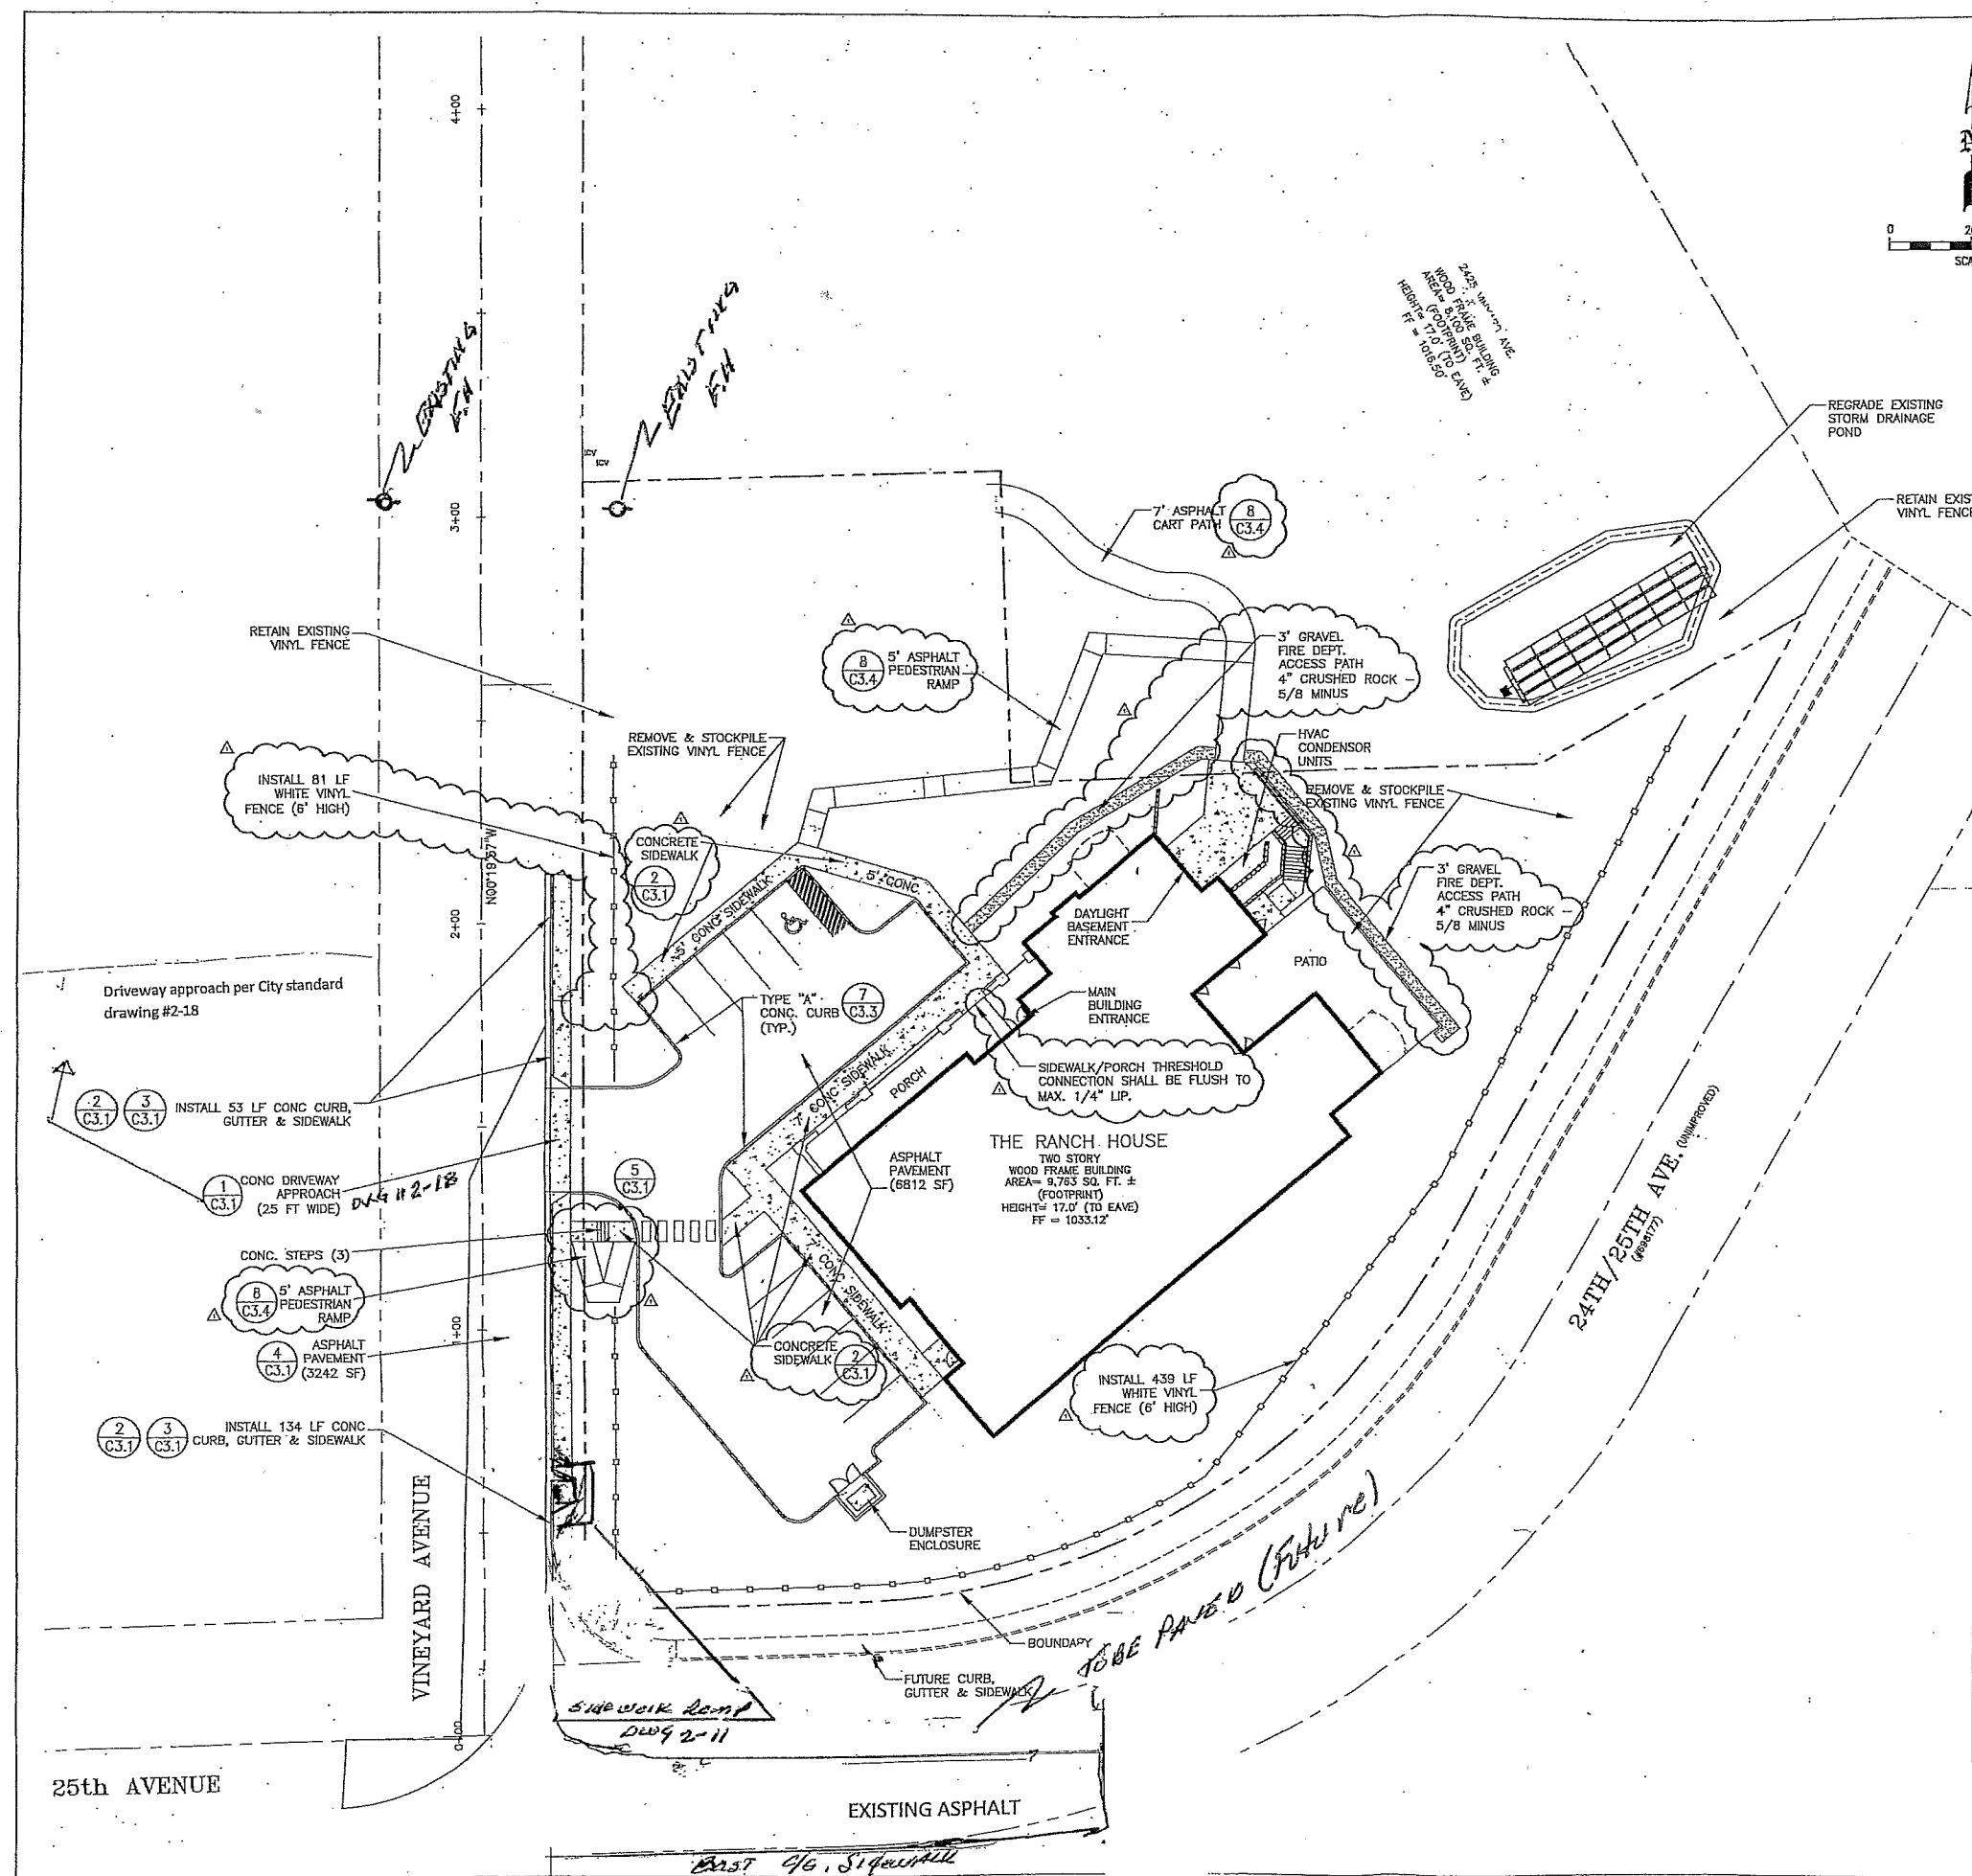


SECTION A

SECTION B

NOTES:

1. BASE MATERIAL SHALL BE 4" OF 3/4" INCH MINUS CRUSHED AGGREGATE BASE MATERIAL COMPACTED 95% MAXIMUM DENSITY AS DETERMINED BY MODIFIED PROCTOR AS PER AASHTO T180. ALL FILL OR BACKFILL AREAS SHALL BE PLACED IN 6" LIFTS.
2. PLACEMENT OF DRAINAGE STRUCTURES JUNCTION BOXES OR OTHER OBSTRUCTIONS IN FRONT OF DRIVEWAY ENTRANCES IS PROHIBITED.
3. THIS RAMP SHALL BE USED WITH HIGH BACK AND ROLLED CURB.
4. ALL ALLEYS, COMMERCIAL DRIVEWAYS AND PRIVATE ROADWAYS ACCESSING MORE THAN THREE DWELLING UNITS WILL BE REQUIRED TO PLACE 3-#4 REBARS WITHIN CURB & GUTTER (CENTER AND 8" OFF CENTER) OF THE DRIVEWAY APPROACH.

**CITY OF LEWISTON, IDAHO
PUBLIC WORKS DEPARTMENT**

**DRIVEWAY APPROACH
JOGGED SIDEWALK**

APPROVED FOR PUBLICATION
City Engineer: *[Signature]* Date: 11/15/2017

DWG. NO.
2-18

GUARDIAN ANGEL HOMES
LEWISTON ASSISTED LIVING PHASE 2

SITE IMPROVEMENT PLAN

2435 VINEYARD AVE
LEWISTON ID 83501

Permit #B17-000375
File #17-001803

Sundog Engineering LLC
P.O. Box 374
Colfax, WA 99111
(509) 869-1779
Email: jsundog@sundogeng.com

NO.	DATE	DESCRIPTION
1	11/15/2017	Plan Review
2	11/15/2017	Revision #2

CHECKED BY: JAK
DRAWN BY: DAK
PROJ. NO.:
DATE: JAN 2009

C2.1
HUD Sheet 9

CALL BEFORE YOU DIG:
1-800-428-4950