

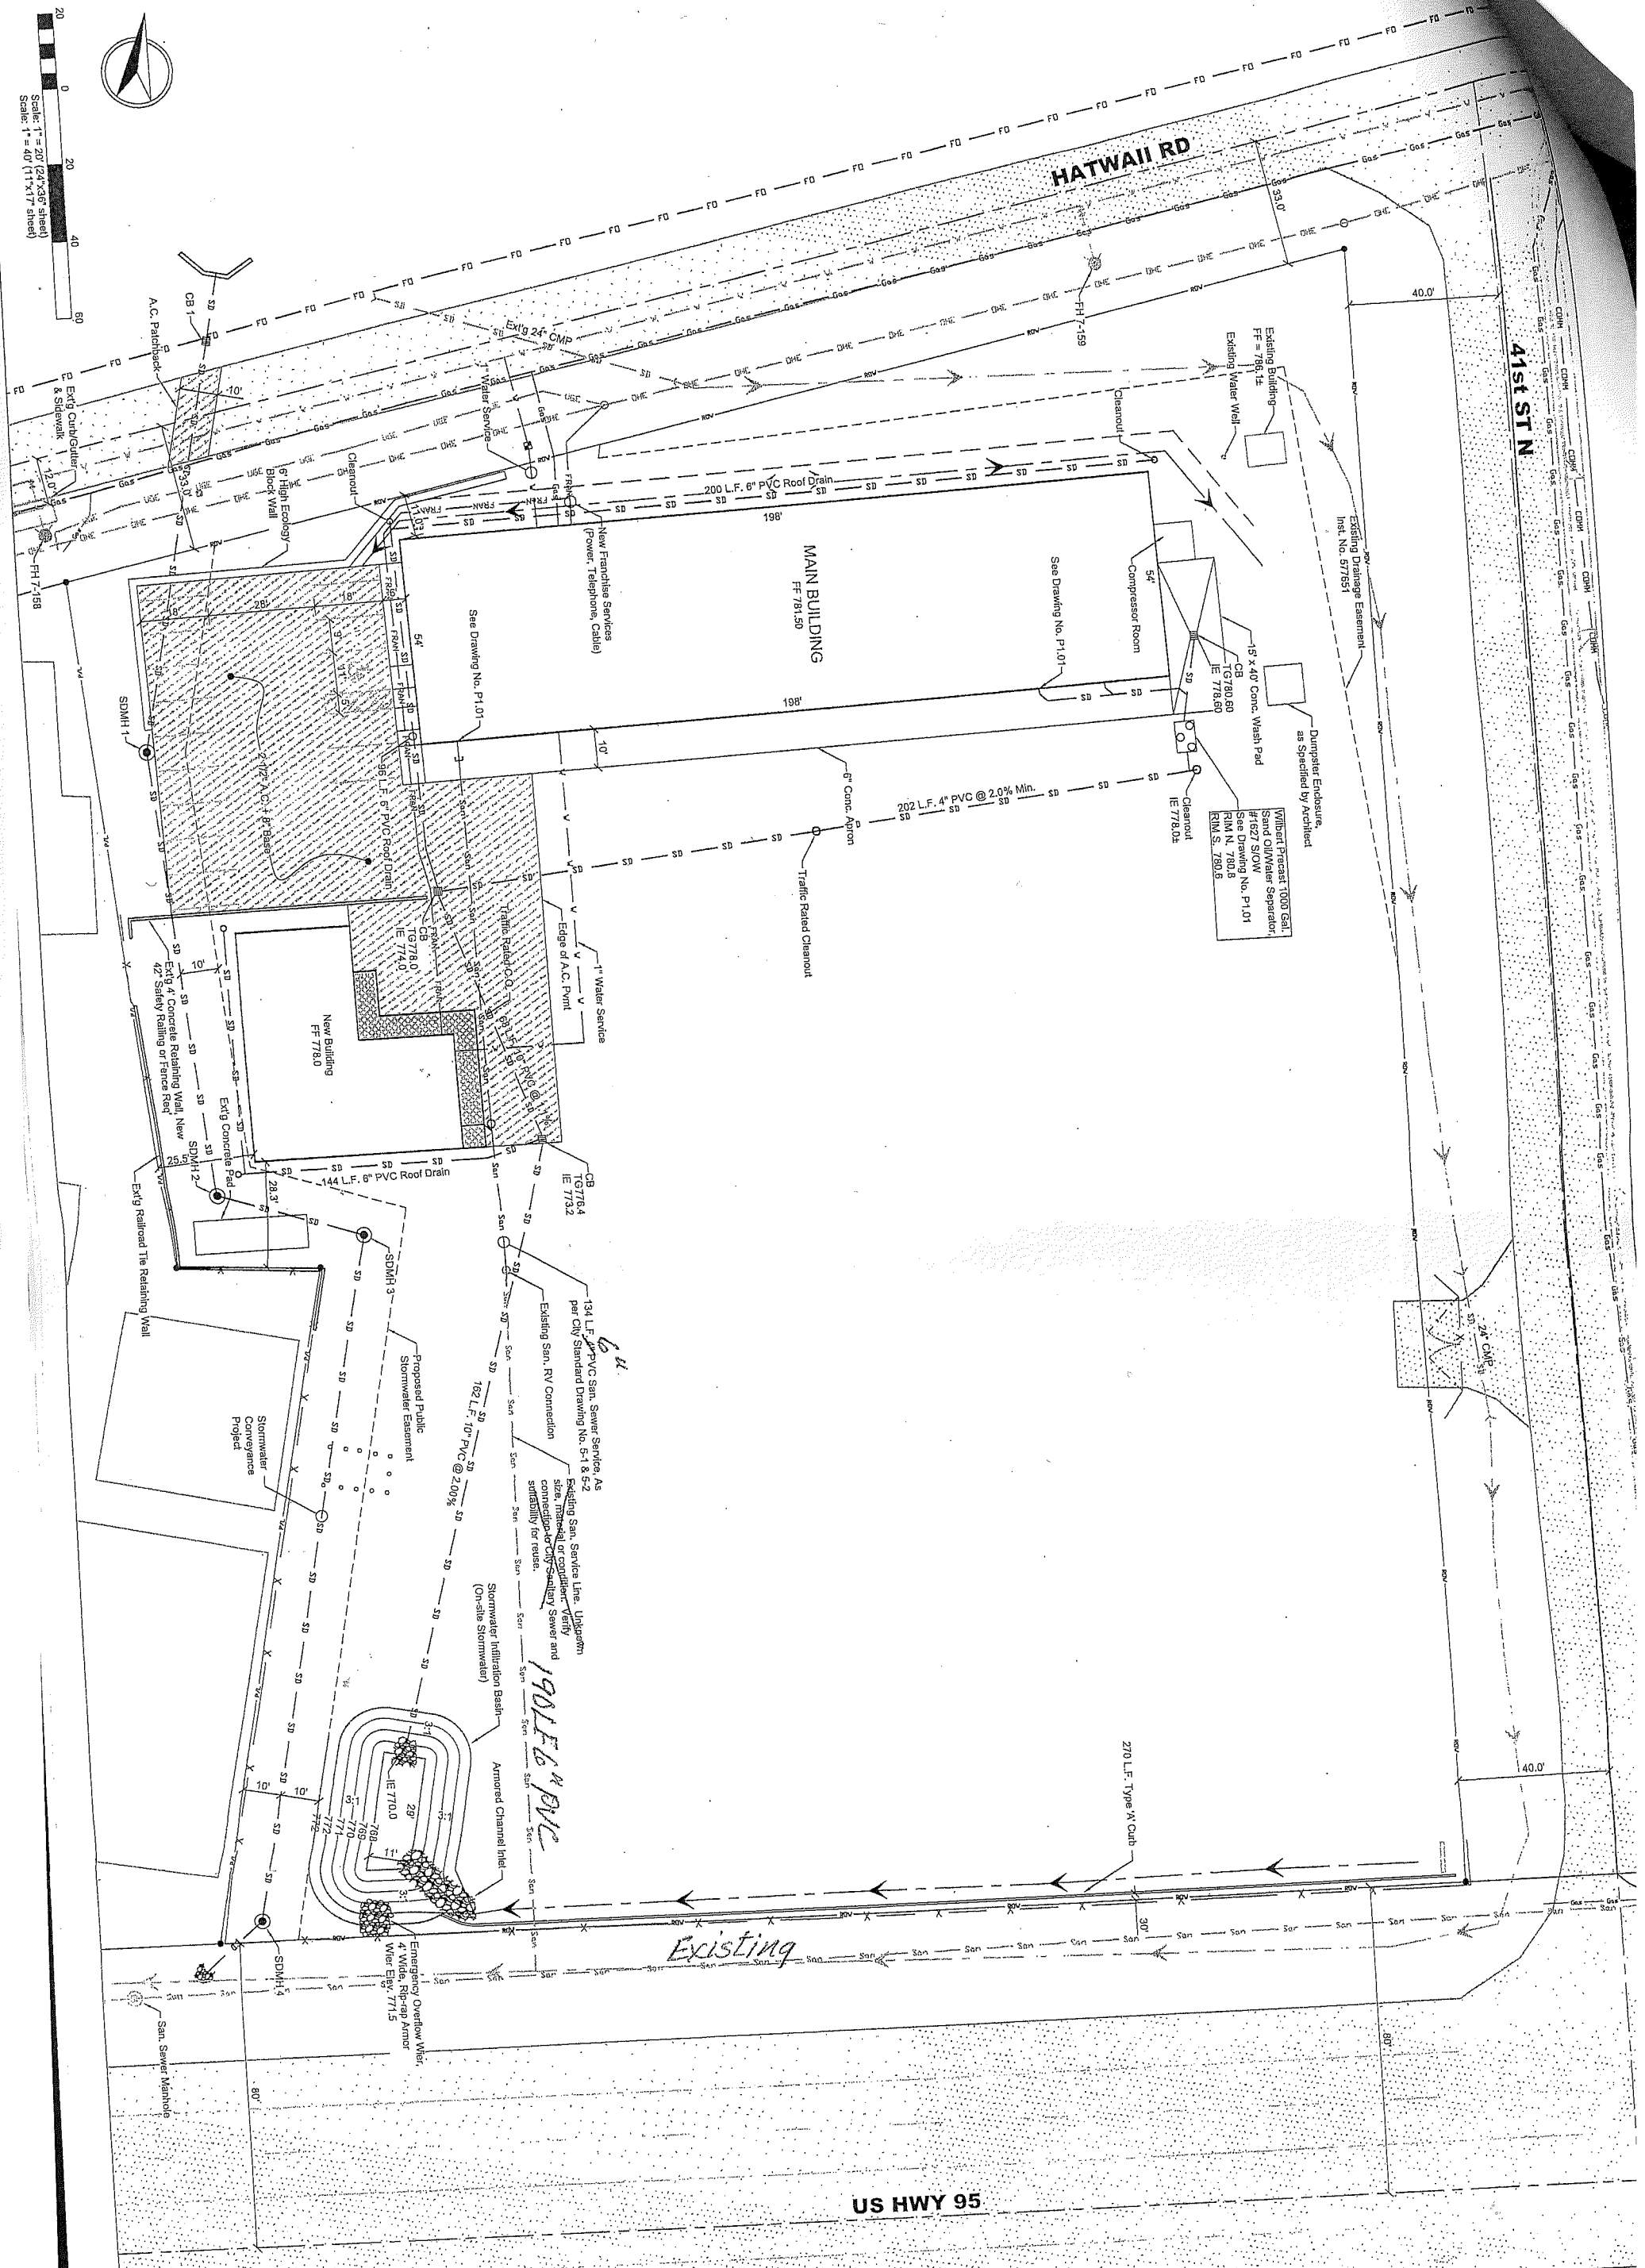


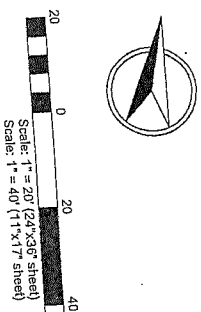

HEDCO
HAMMOND ENGINEERING & DEVELOPMENT CO.
528 BRYDEN AVENUE LEWISTON, IDAHO 83501
(208) 788-5422

**RnR RV - SERVICE DEPT.
SITE DEVELOPMENT PLAN
4040 N&S HWY
LEWISTON, IDAHO**

SCALE	1"=20'
DRAWN BY	MEE
CHECKED BY	JSH
DATE	10-22-15
JOB #	1508
SHEET	C2
DRAWING #	1508-C2

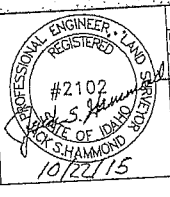

REVISION		DESCRIPTION
REV	DATE	
A	01-04-16	New Building, Rev. Surface Grades & Storm Sewer



M.L. ALBRIGHT & SONS, INC.
General & Excavation Contractors

6182 Lapwai Road
P.O. Box 603
Lewiston, ID 83501

Phone: (208) 743-2100
Fax: (208) 743-2166
Email: mlasons@cableone.net

PROPOSAL

To: R n R RV

Quote #: 2012

Phone #: _____

Fax #: _____

Project: 36" storm pipe
Location: Lewiston Id

Date: July 13, 2015
<

We hereby submit an estimate for the following:

As per HEDCO preliminary design

Preliminary cost Est. for the following: 450' of 36" Hdpe culvert, 2 manhole-C.B structures,
Head wall and road crossing.

\$76,000.00

WE PROPOSE hereby to complete the above described work for the sum of: **\$76,000.00**

****Payment To Be Made As Follows: Within Thirty (30) Days Of Date On Invoice****

Prepared By: **Mike Albright**

Mike Albright

This proposal may be withdrawn


by us if not accepted within

30 days.

ID Public Works # PWC-C-12040-AAA-1-2-3 WA Contractor's License # MLALBSI054L9 Federal Tax ID # 82-0476430

ACCEPTANCE OF PROPOSAL - The above prices, specifications and conditions are satisfactory and
are hereby accepted. You are authorized to do the work as specified. Payment will be made as outlined above.

Signature: _____ Date Of Acceptance: _____

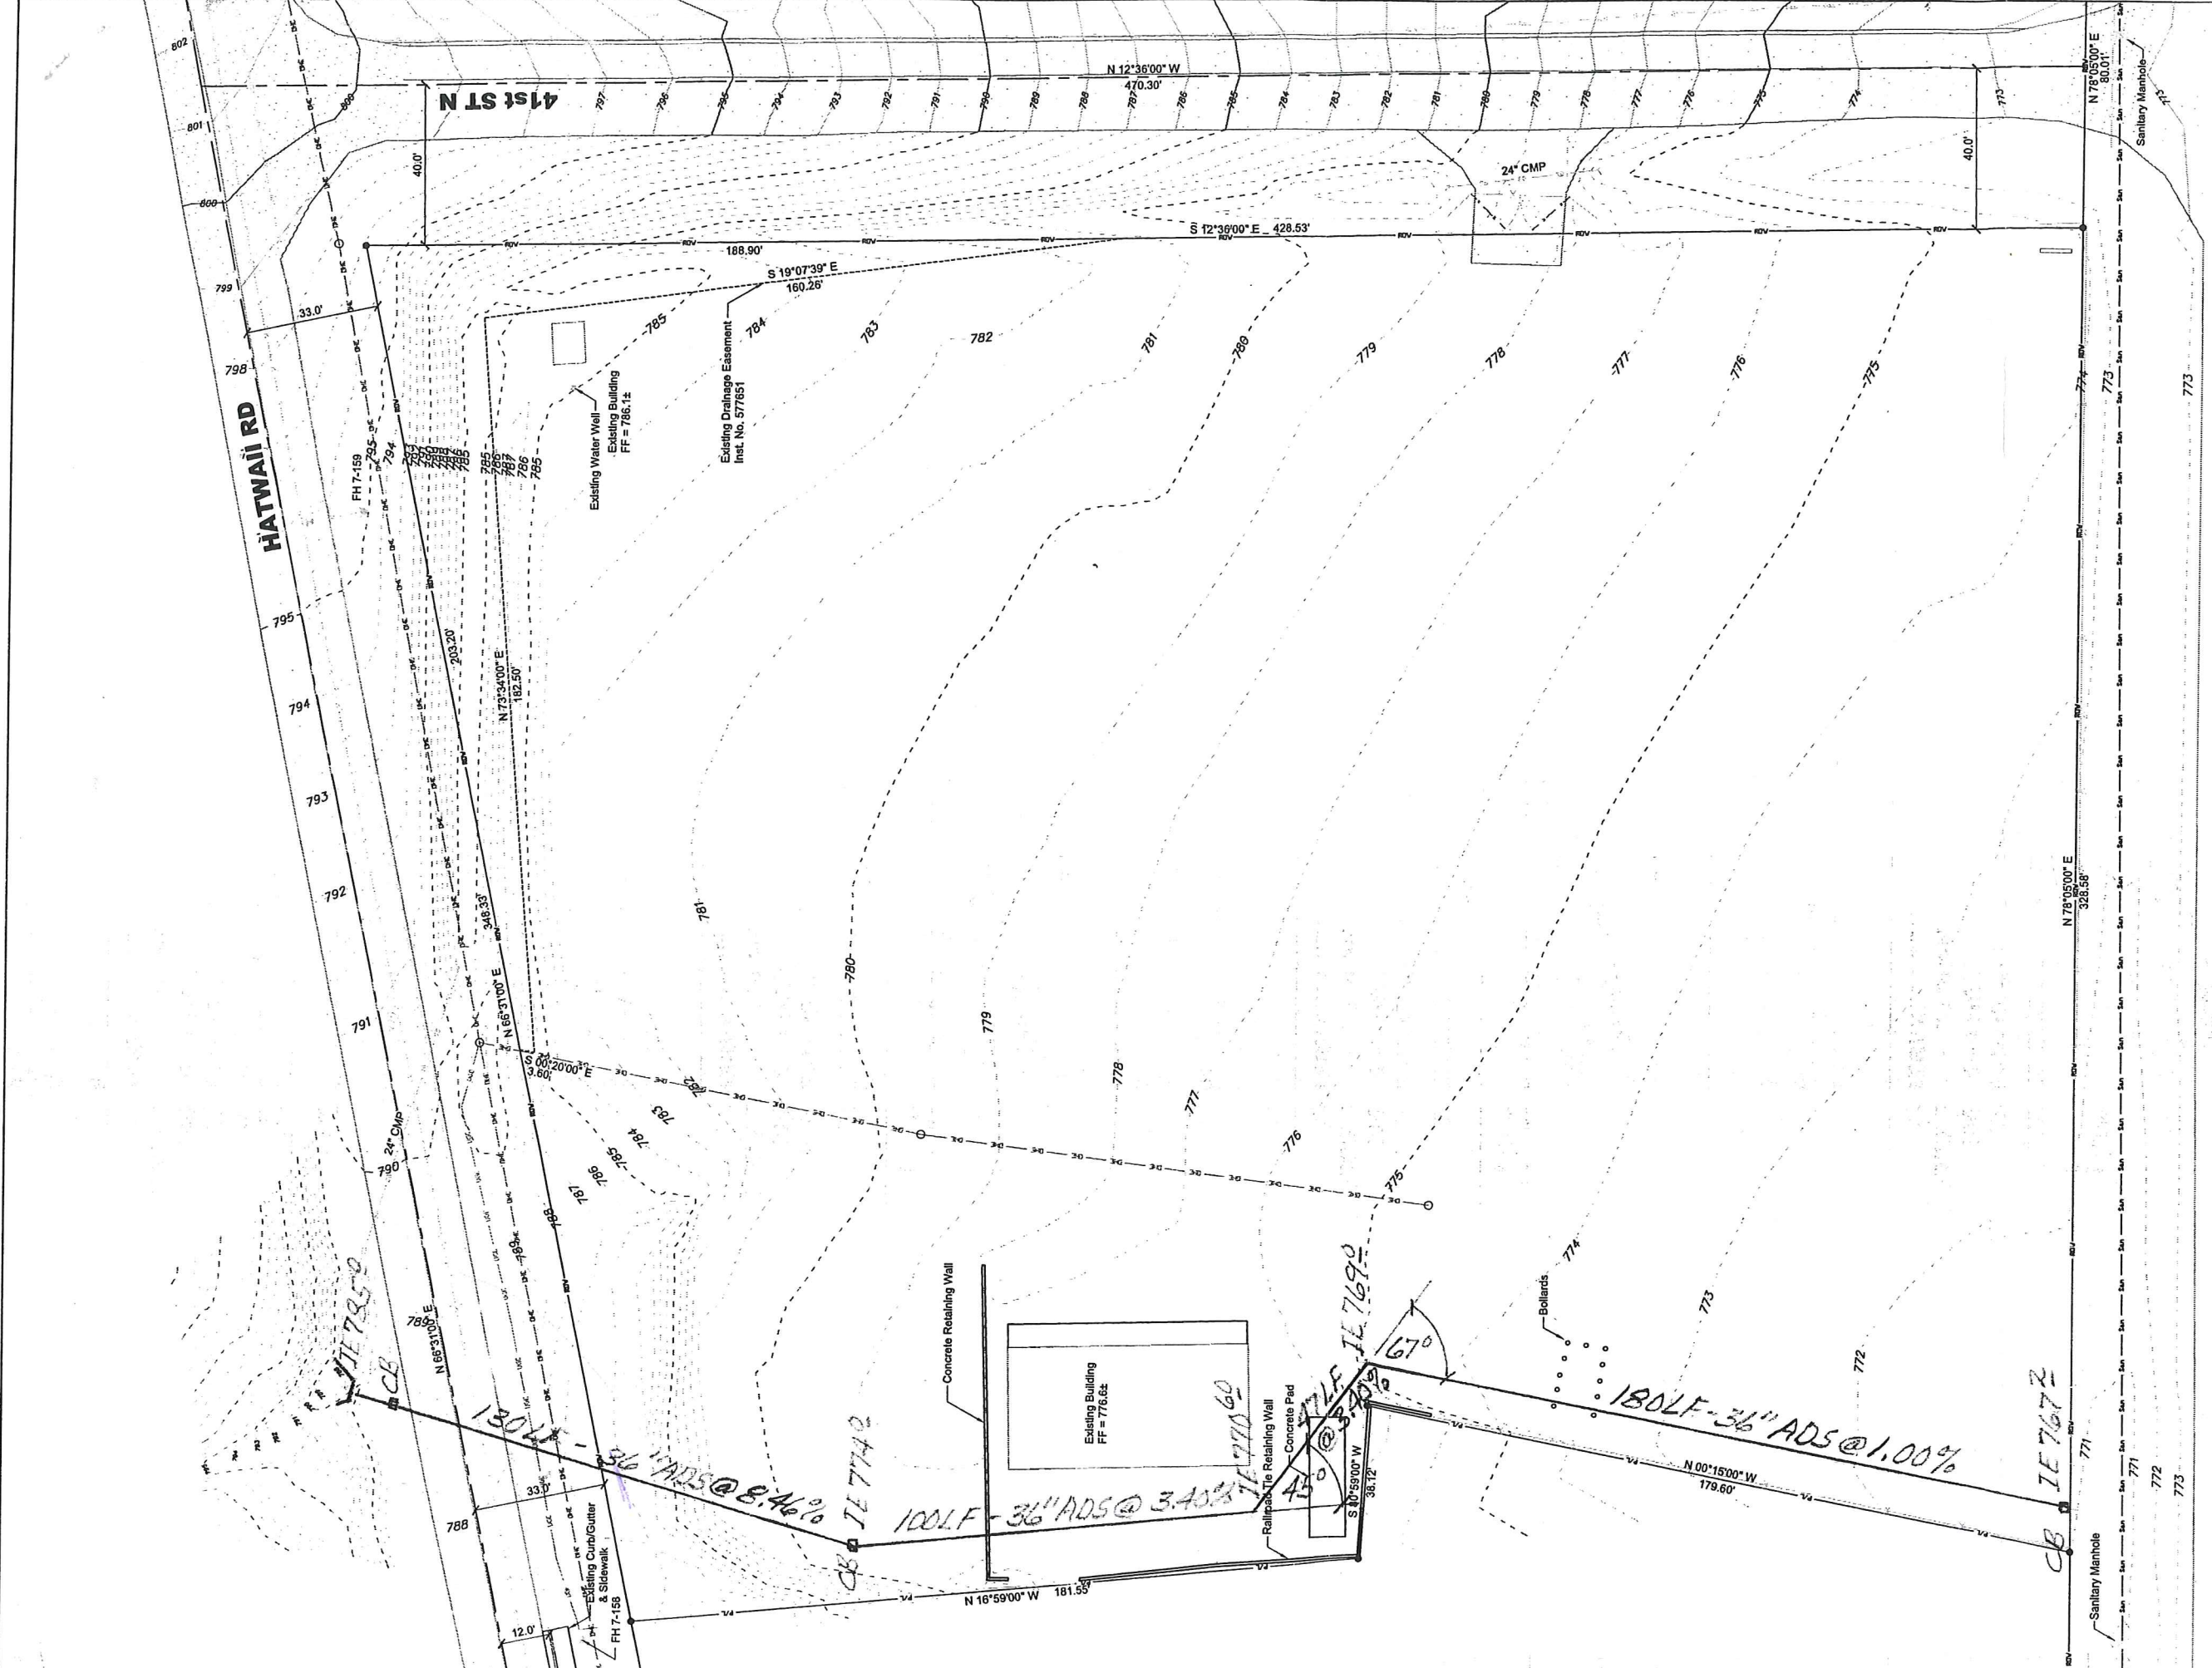

HWY 95/US 12

DRAFT





HAMMOND ENGINEERING & DEVELOPMENT CO.
528 BRYDEN AVENUE, LEWISTON, IDAHO 83501
(208) 786-5422

**RnR RV - SERVICE DEPT.
EXISTING SITE PLAN
4040 N&S HWY
LEWISTON, IDAHO**

SHEET **T1**

SCALE	SHEET SIZE	DRAWN BY	CHECKED BY	DATE	JOB #	SHEET	DRAWING #
1"=20'	D	MEE	JSH	07-14-15	1508	1	1508-T1

REV	DATE	DESCRIPTION	CHECKED	APPRO.

