



2 DETAIL N.T.S.
VALVE BOX PLACEMENT

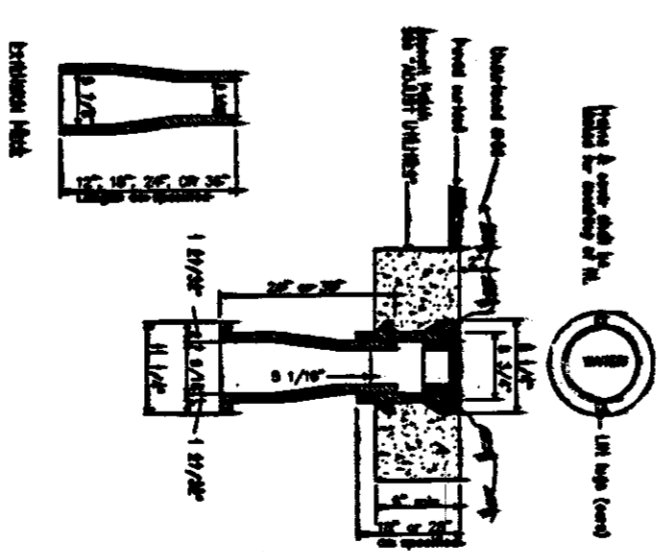

1 2 DETAIL N.T.S.
HYDRANT SETTING

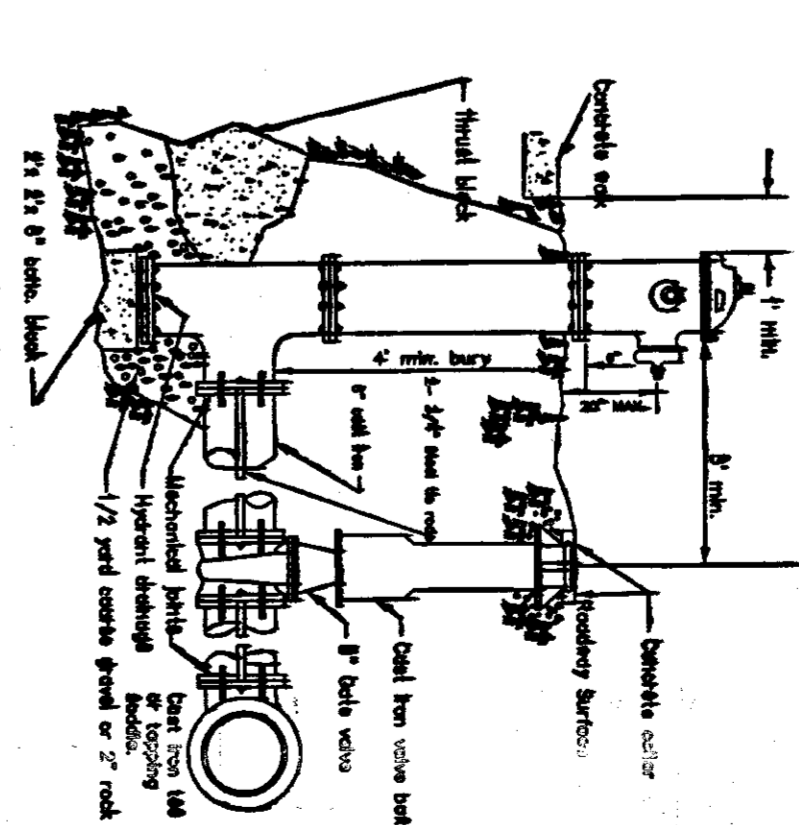

CITY OF LEWISTON





ENGINEERING DEPARTMENT
1134 "F" STREET, LEWISTON, ID 83501
208-746-1316



AIRPORT WATER LINE EXTENSION

REVISIONS			
NUMBER	DATE	BY	REVISION
1	07/25/97	JE	Add FH, 2 GVs & Correct line size

DRAWN BY:	JE	DATE:	03/17/97
CHECKED BY:	KJH	DRAWING NO.:	01APWATL
JOB NO.:	01-97-03-17	SHEET	2 OF 8

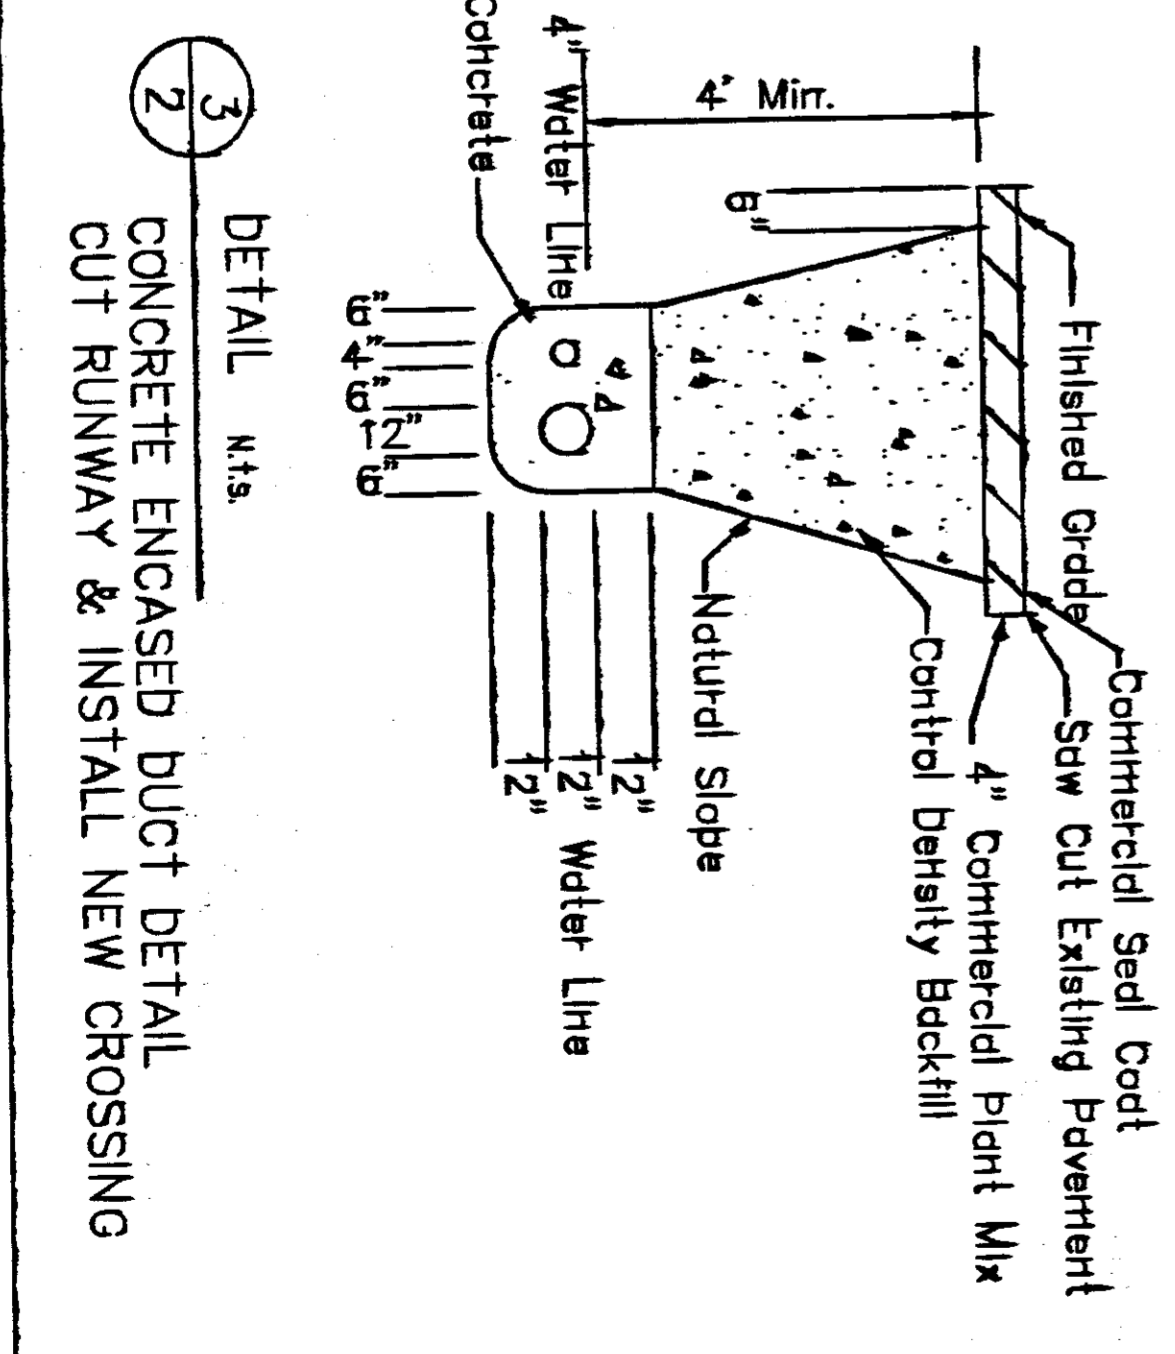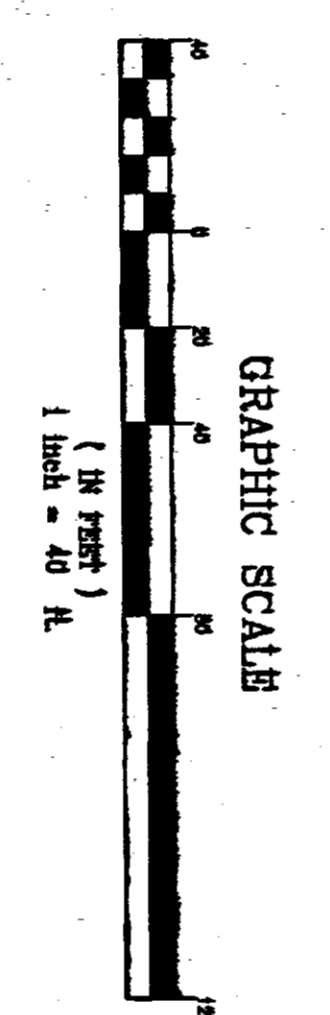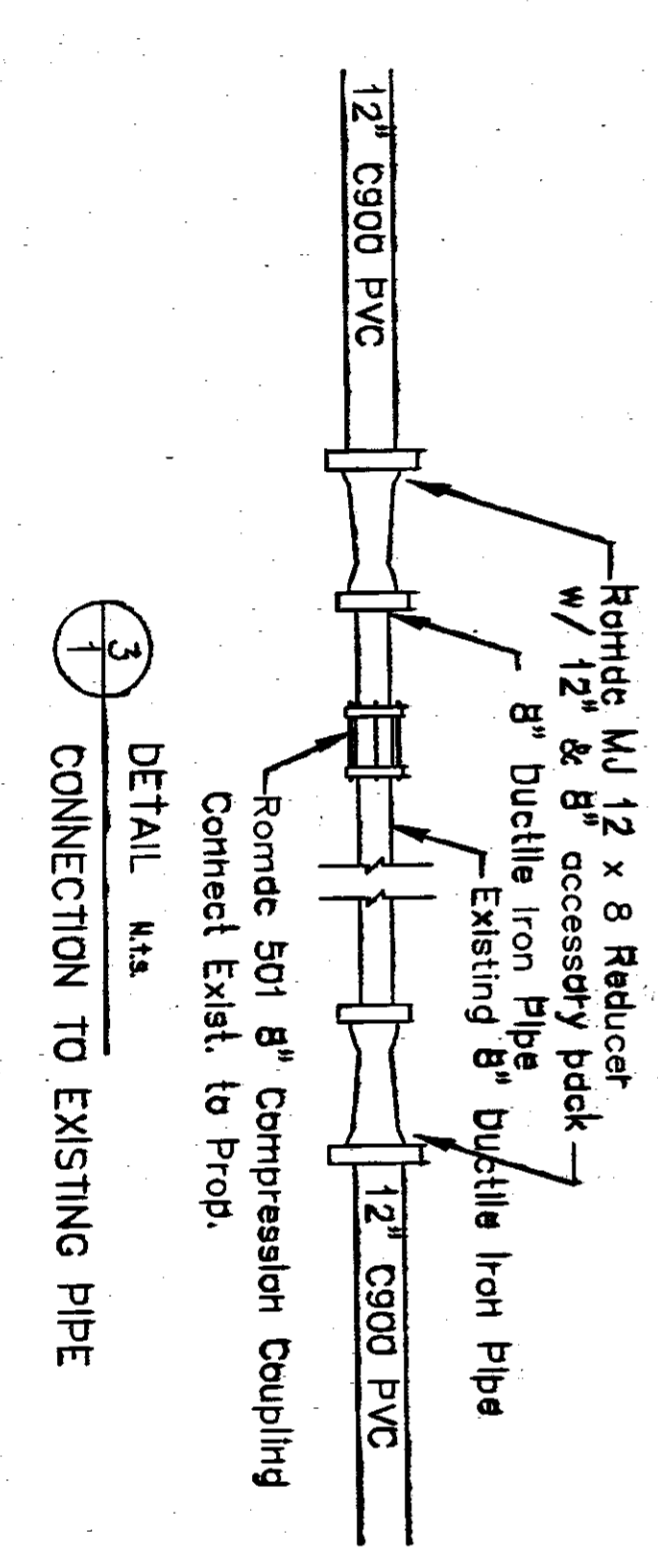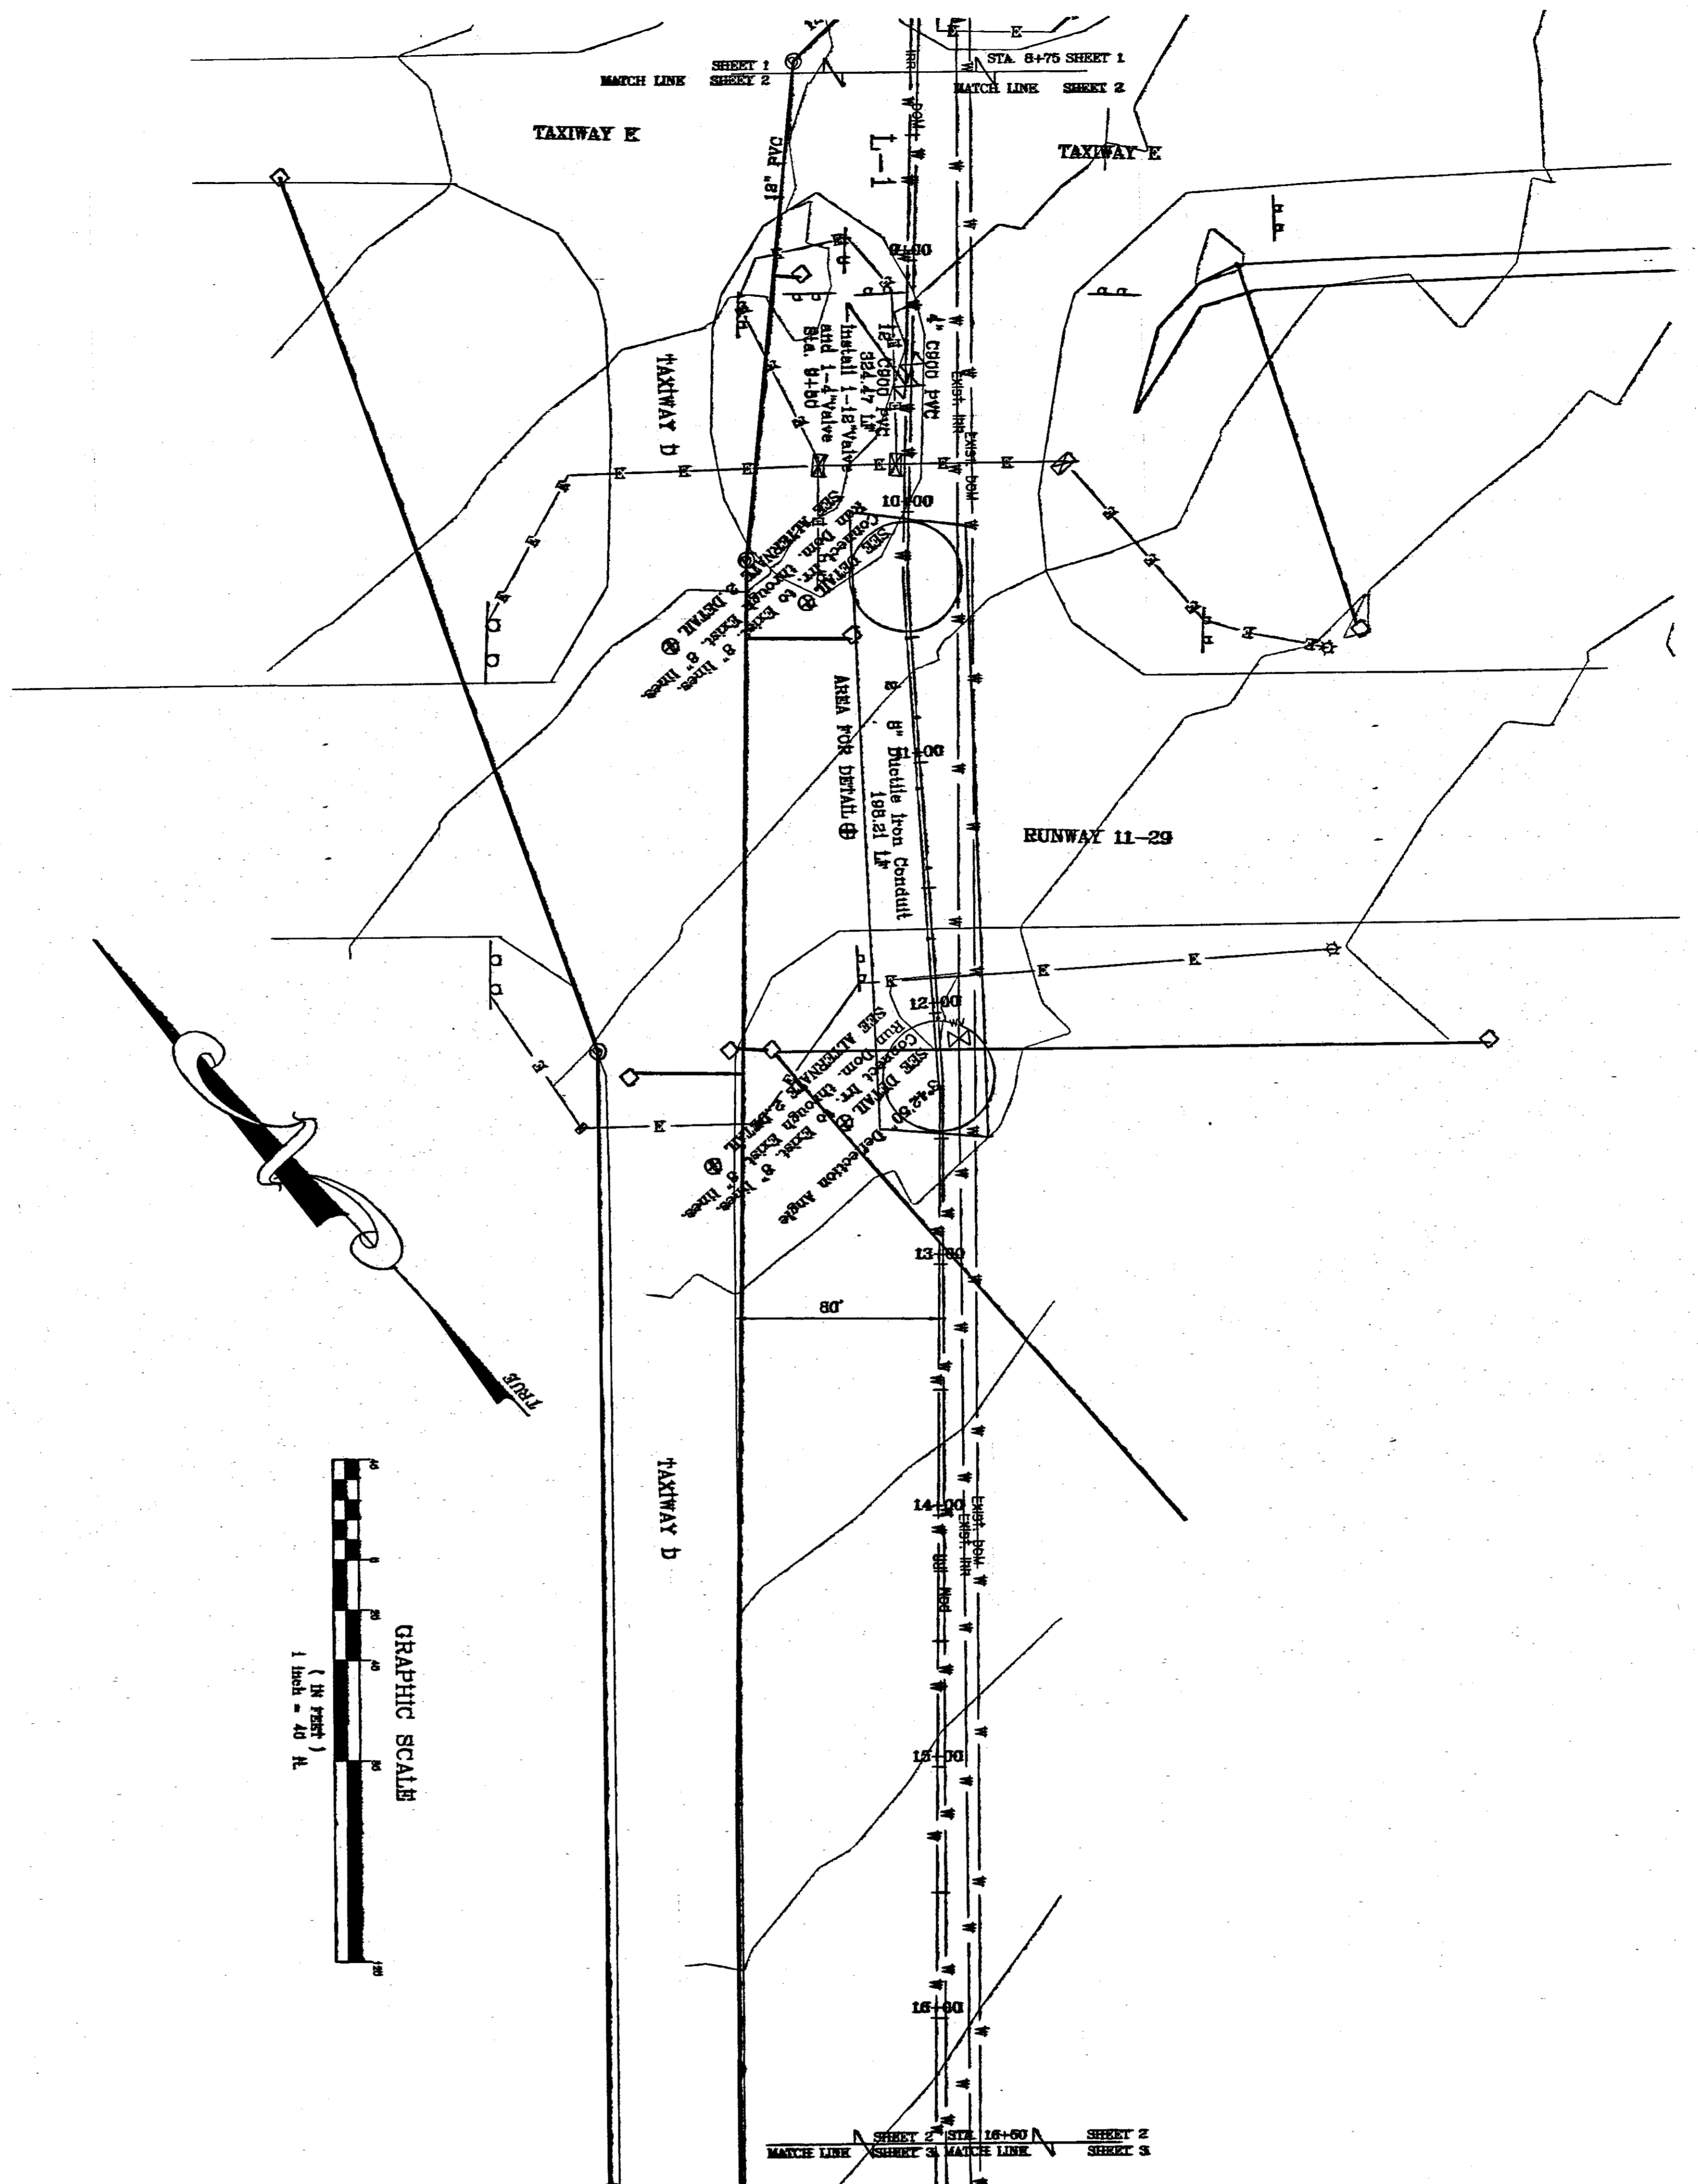

City Engineer shall be contacted at time of construction once existing 8\"/>




CITY OF LEWISTON
 ENGINEERING DEPARTMENT
 1134 "F" STREET, LEWISTON, ID 83501
 208-746-1316



AIRPORT WATER LINE EXTENSION

DRAWN BY: JE	DATE: 03/17/97
CHECKED BY: KJH	DRAWING NO.: QTAPWATL
JOB NO.: 01-97-03-17	SHEET 3 OF 8



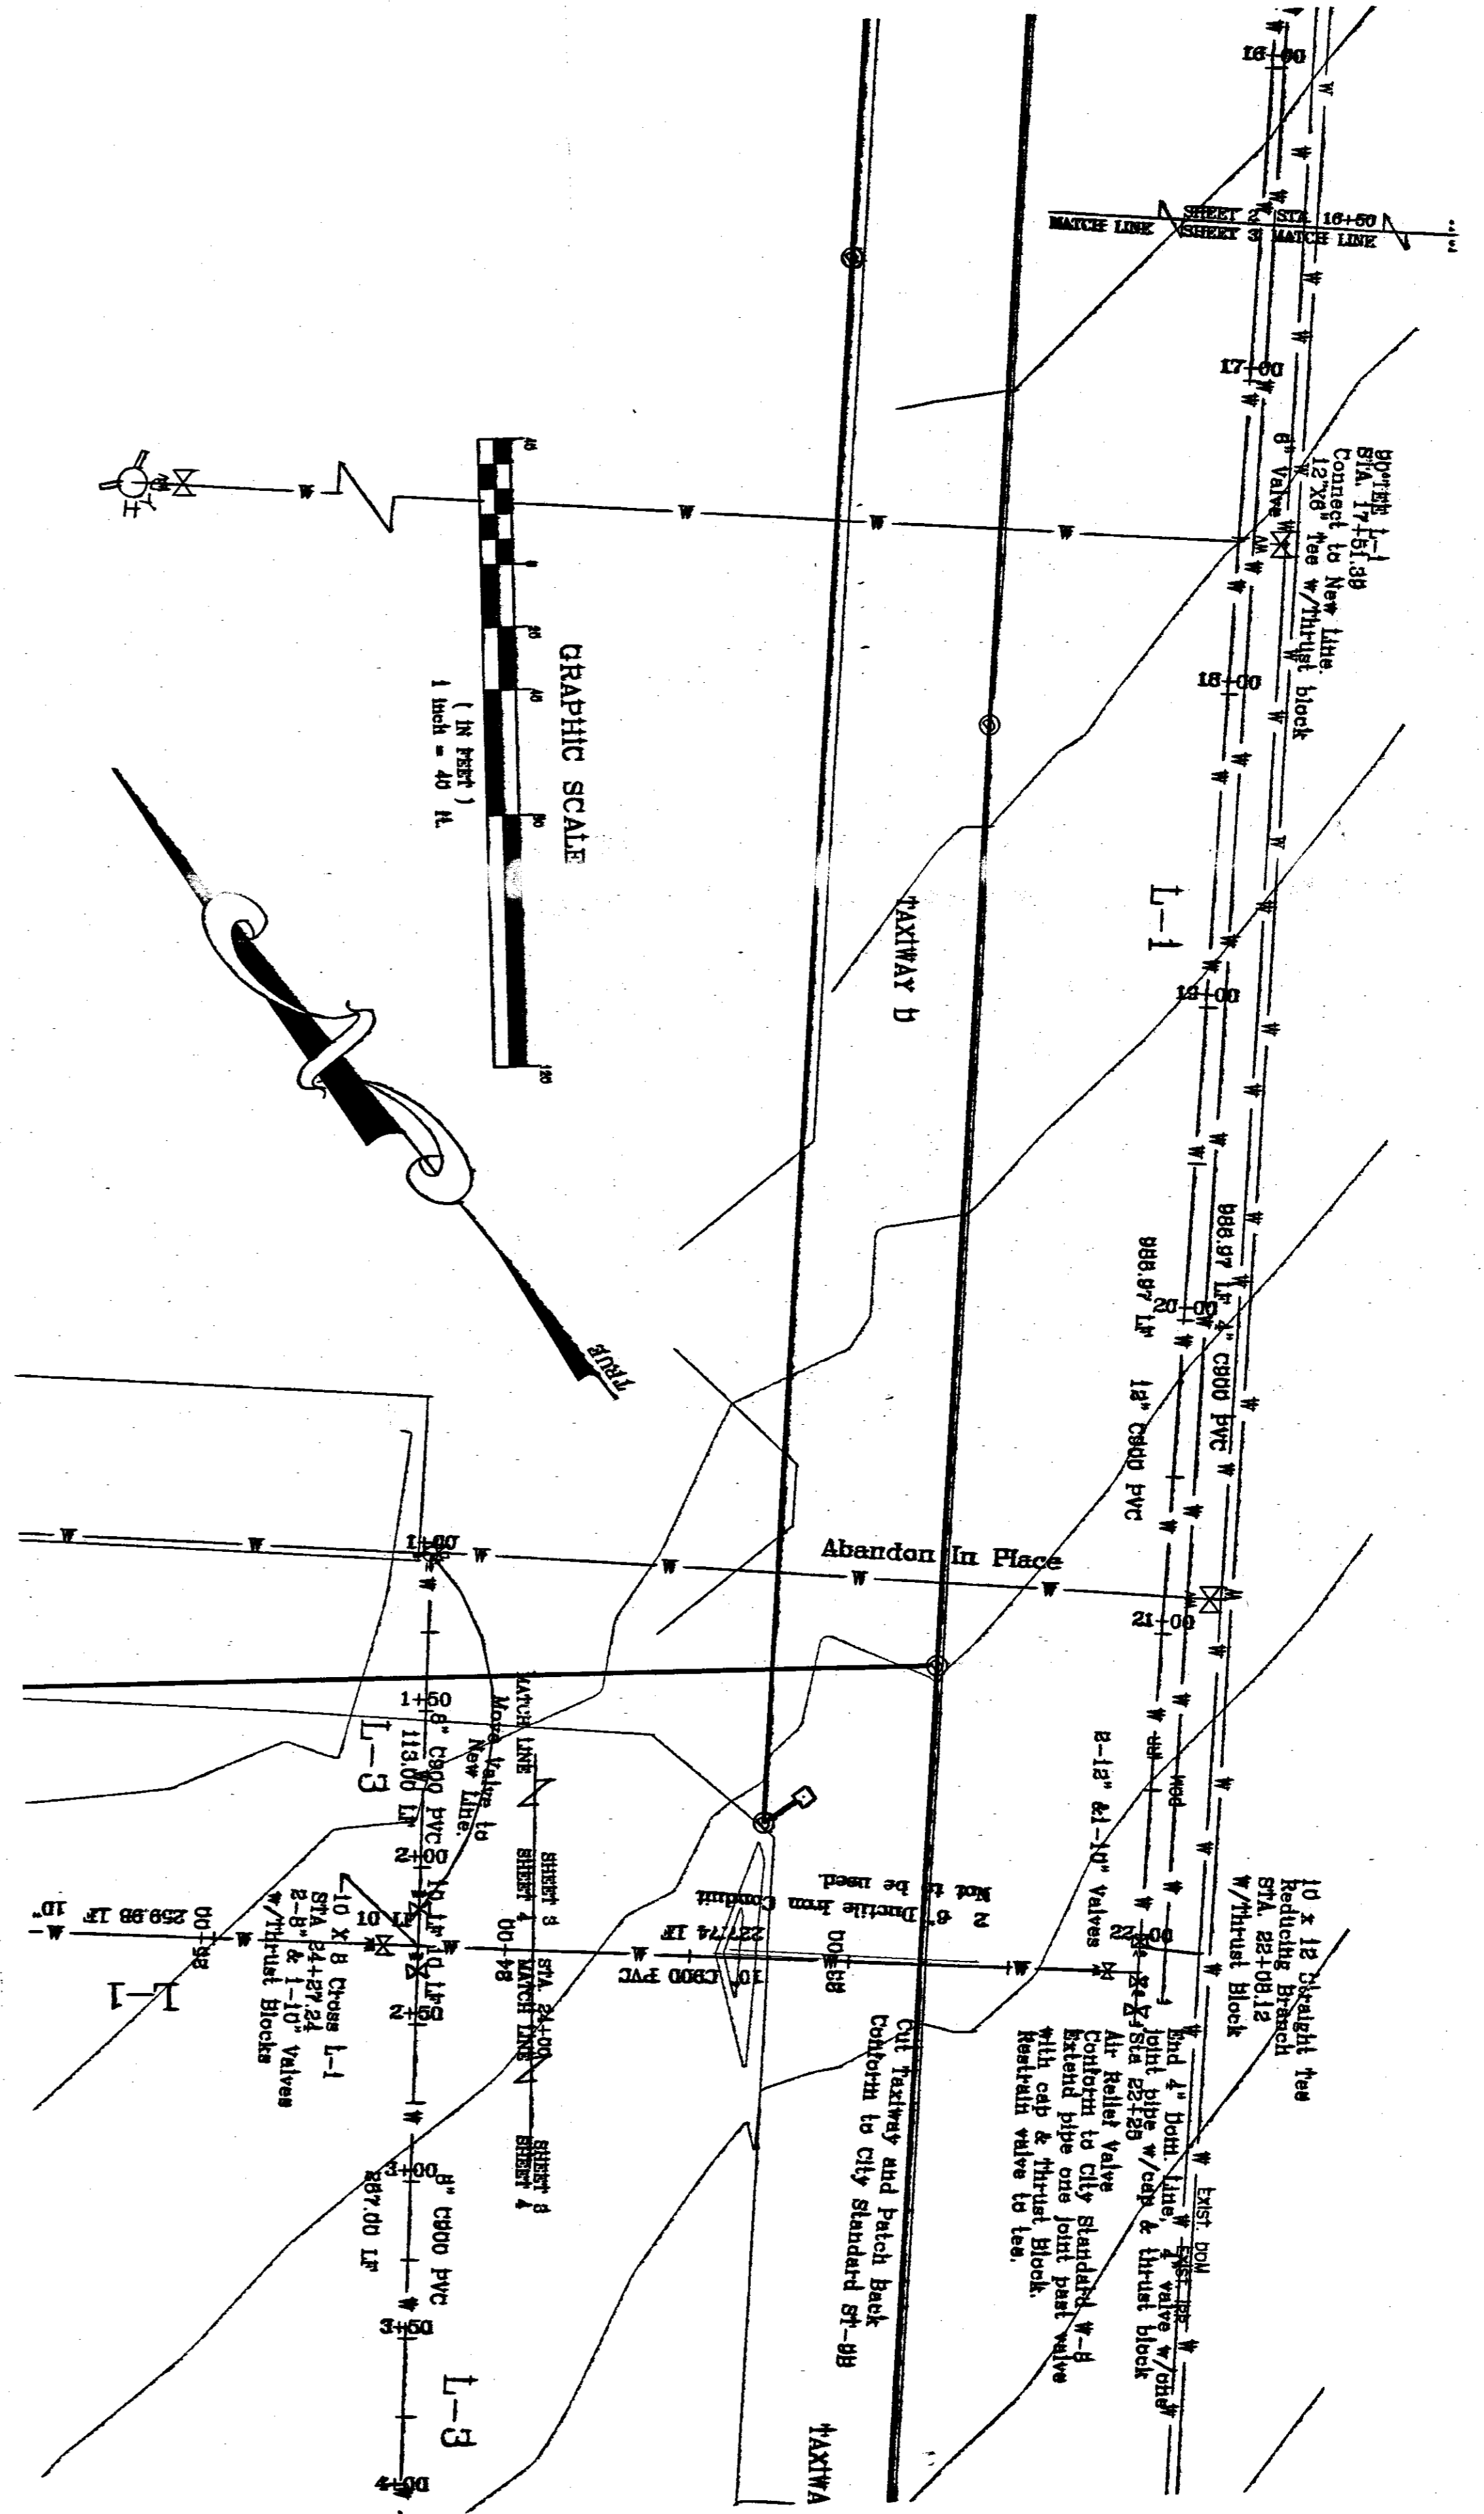


CITY OF LEWISTON
 ENGINEERING DEPARTMENT
 1134 "F" STREET, LEWISTON, ID 83501
 208-746-1316



AIRPORT WATER LINE EXTENSION

DRAWN BY:	JE	DATE:	03/17/97
CHECKED BY:	KJH	DRAWING NO.:	01APWATL
JOB NO.:	01-97-03-17	SHEET	4 OF 8

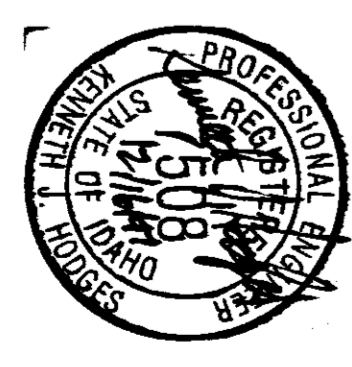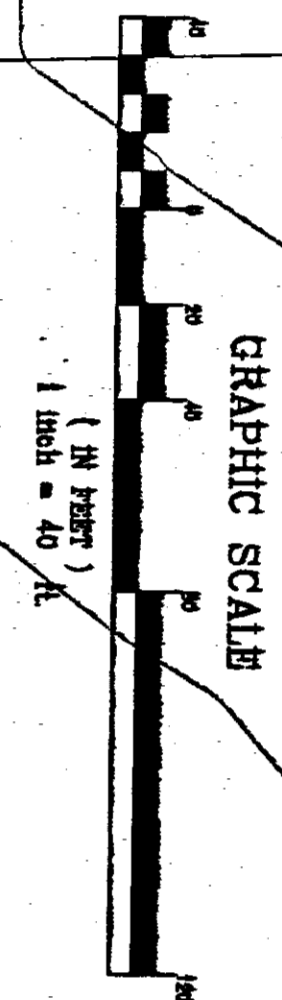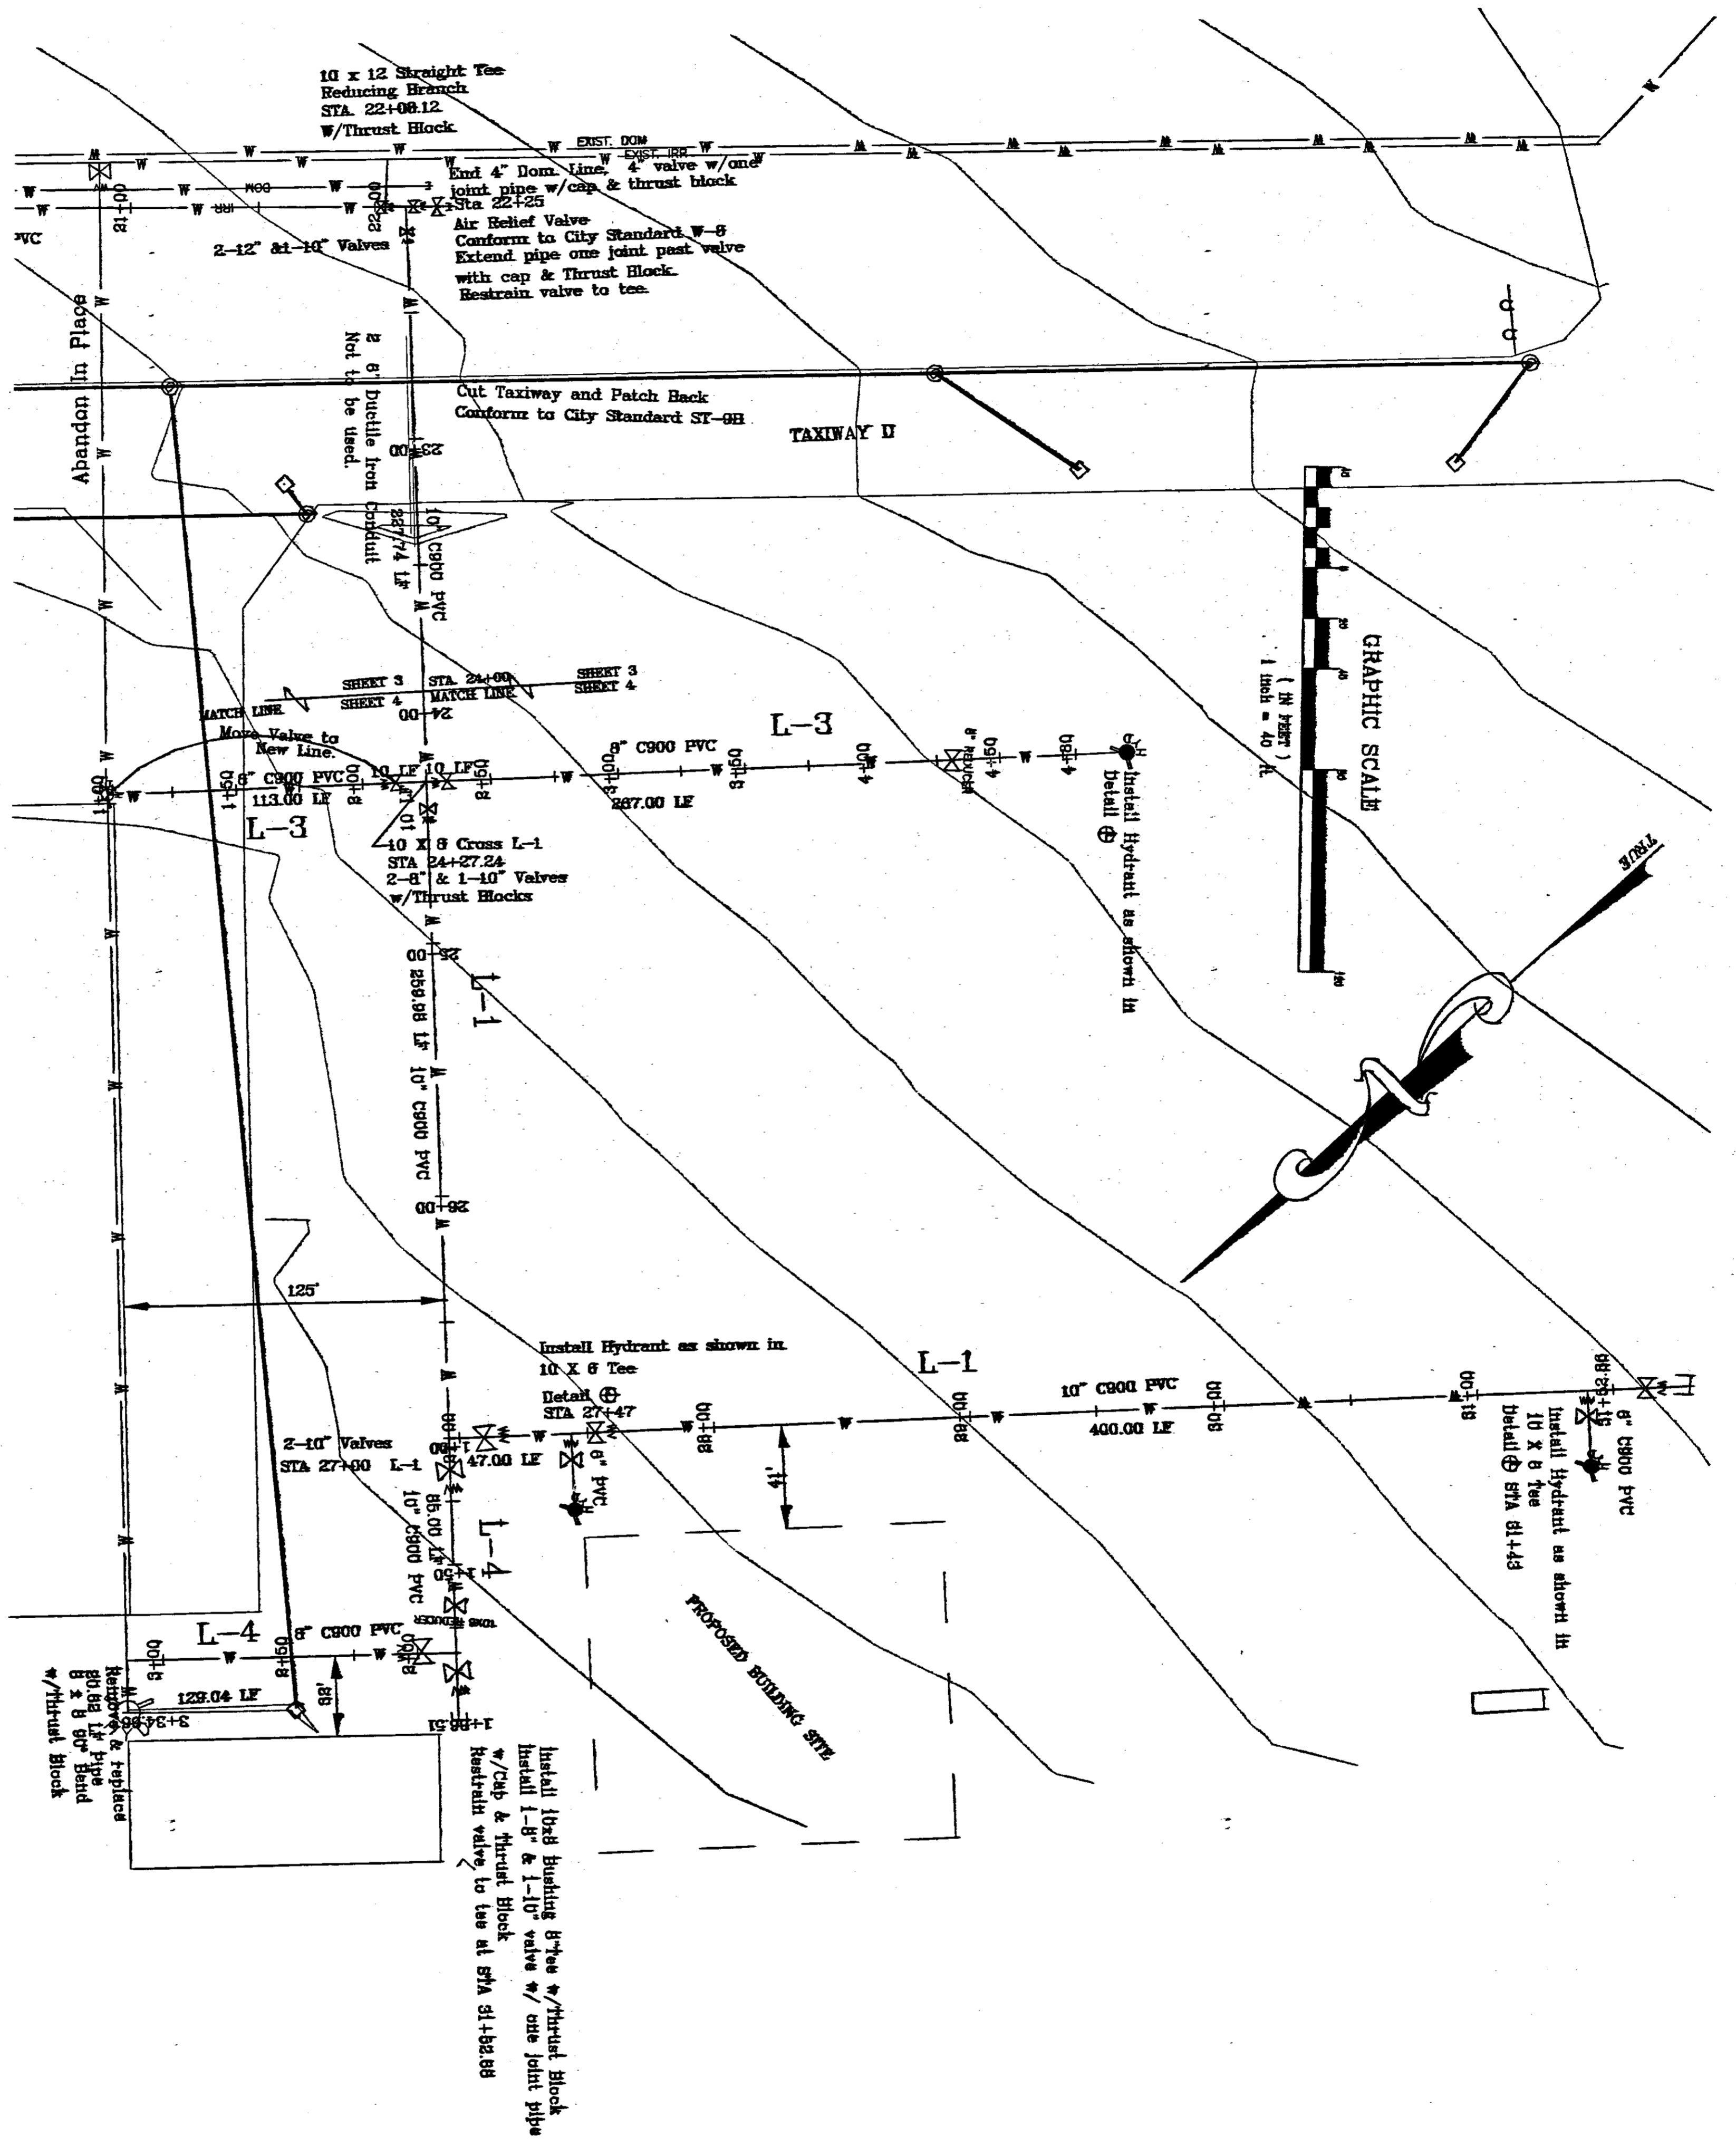

CITY OF LEWISTON
 ENGINEERING DEPARTMENT
 1134 "F" STREET, LEWISTON, ID 83501
 208-746-1316



AIRPORT WATER LINE EXTENSION

DRAWN BY:	JE	DATE:	03/17/97
CHECKED BY:	KJH	DRAWING NO.:	01APWATL
JOB NO.:	01-97-03-17	SHEET:	5 OF 5