




SITE PLAN

1 Site Plan
1" = 20'-0"

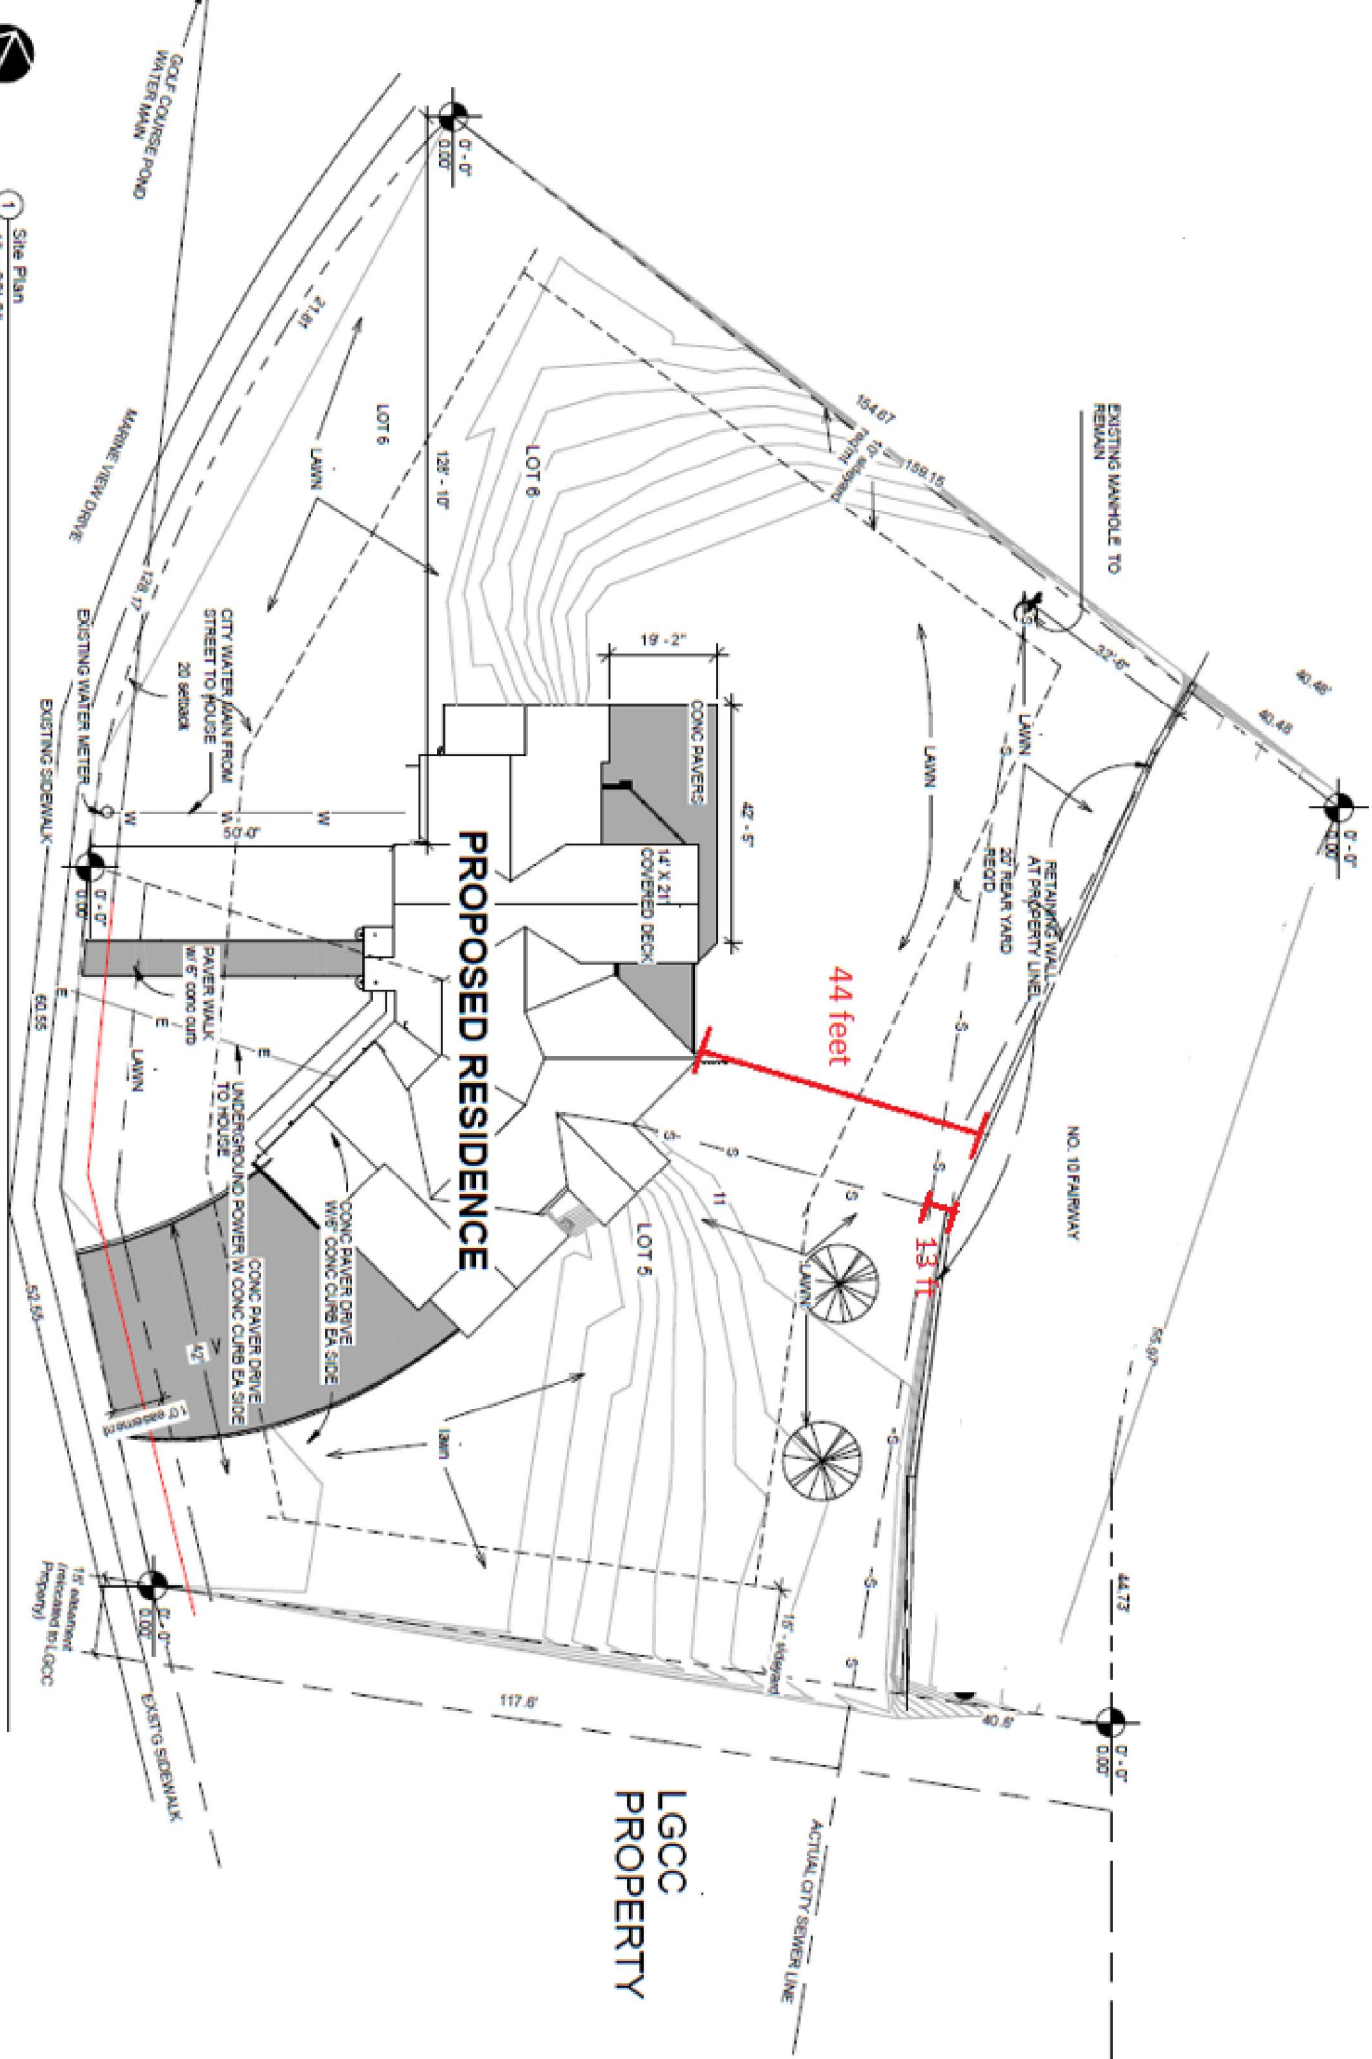


PROPOSED RESIDENCE

**LGCC
PROPERTY**

44 feet

13 ft

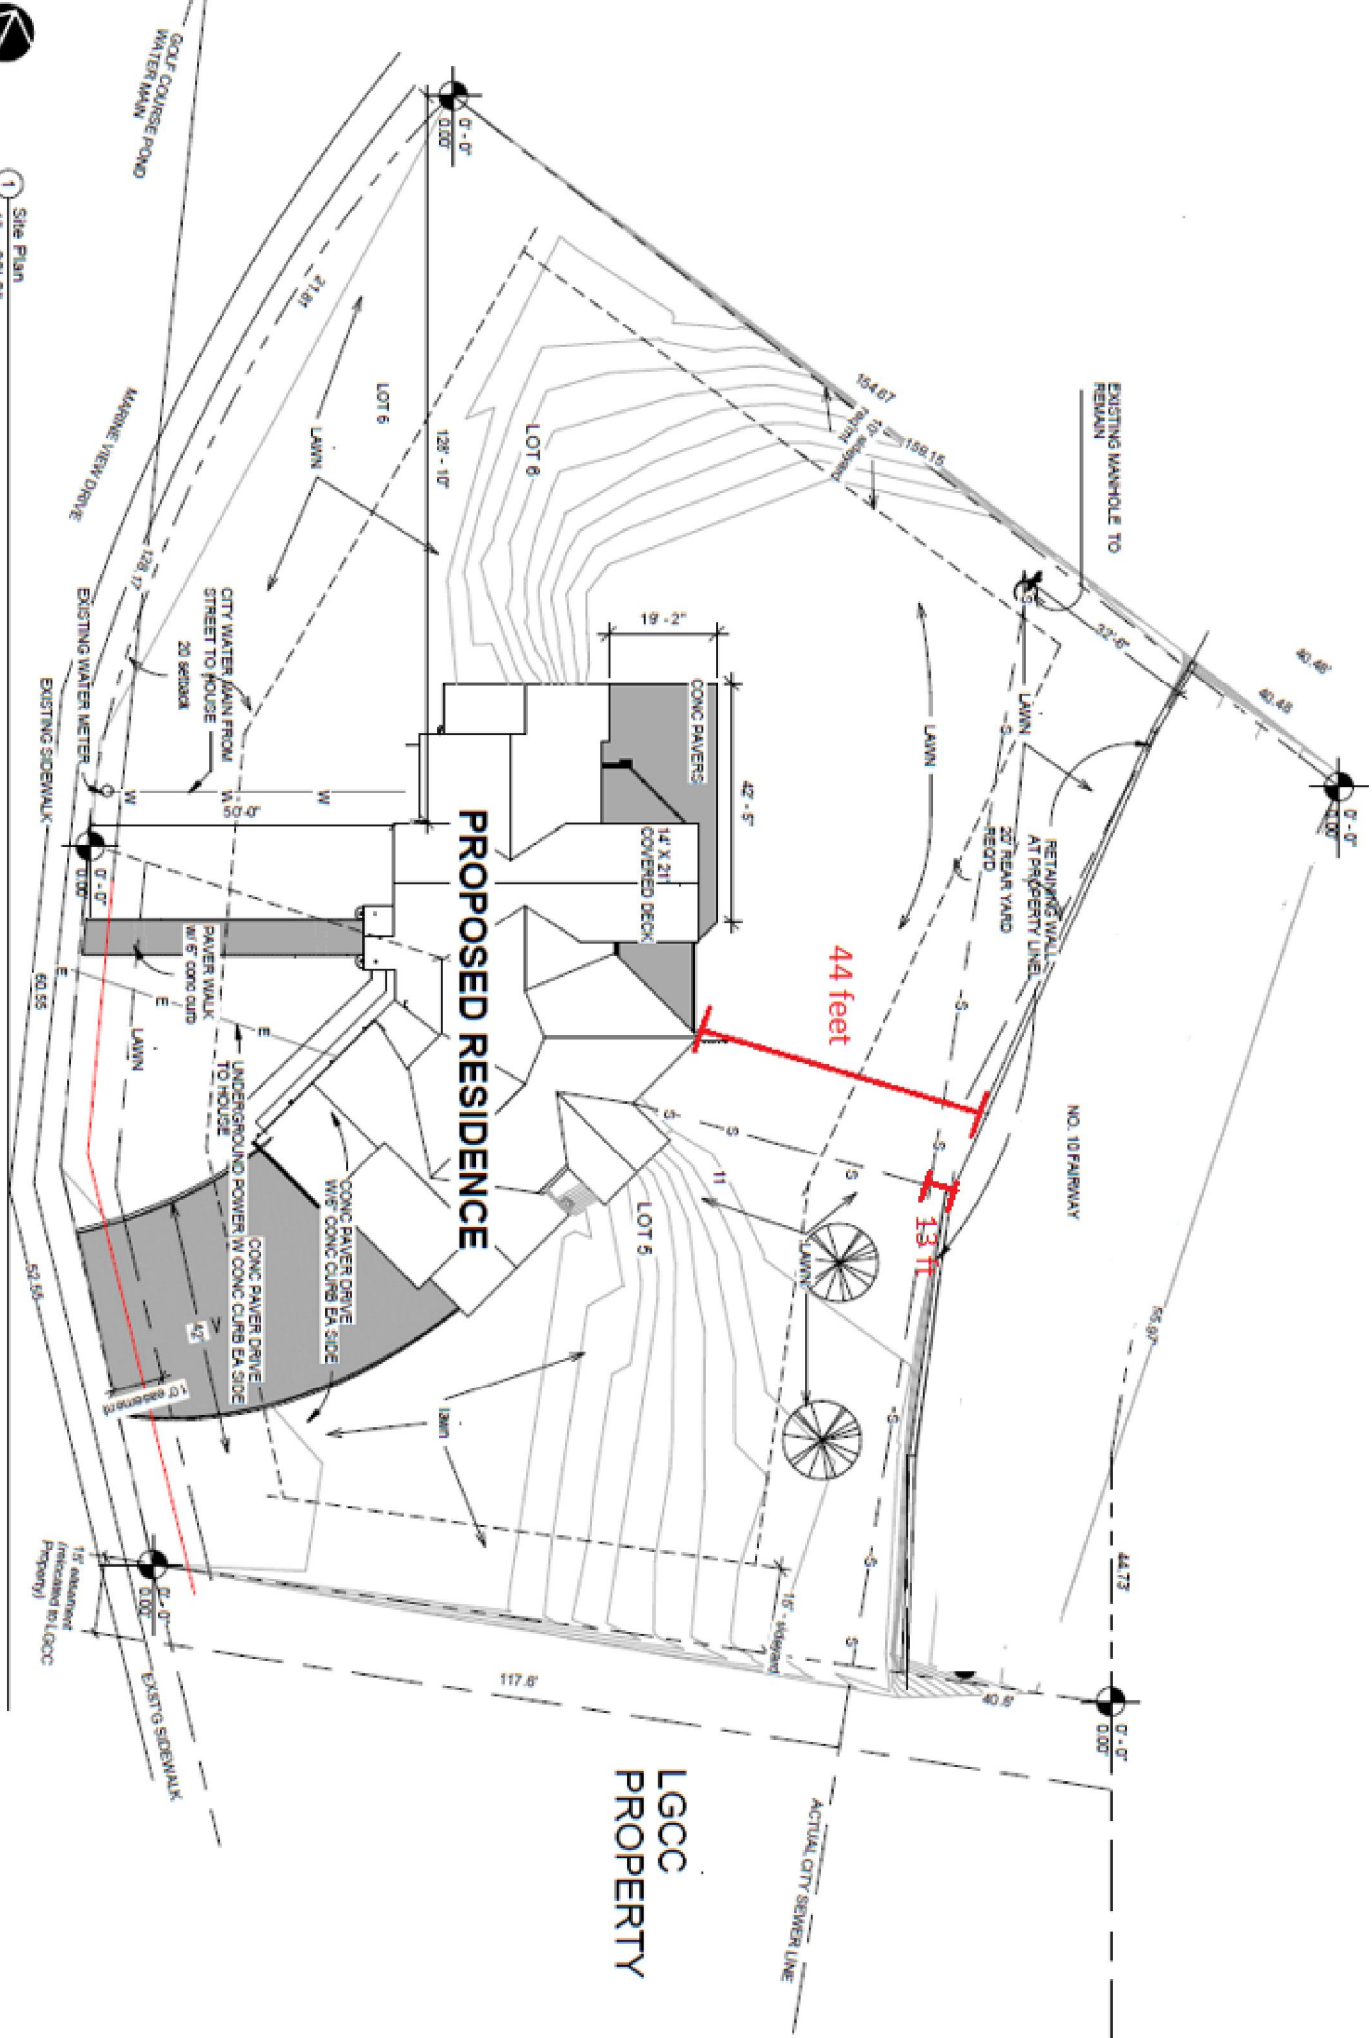

PROPOSED RESIDENCE

**LGCC
PROPERTY**

44 feet

13 ft